




FED. ROAD DIST. NO.	STATE	FED. AID PROJ. NO.	FISCAL YEAR	SHEET NO.	TOTAL SHEETS
HAWAII	HAW.	STP-019-2(35)	1995	28	39

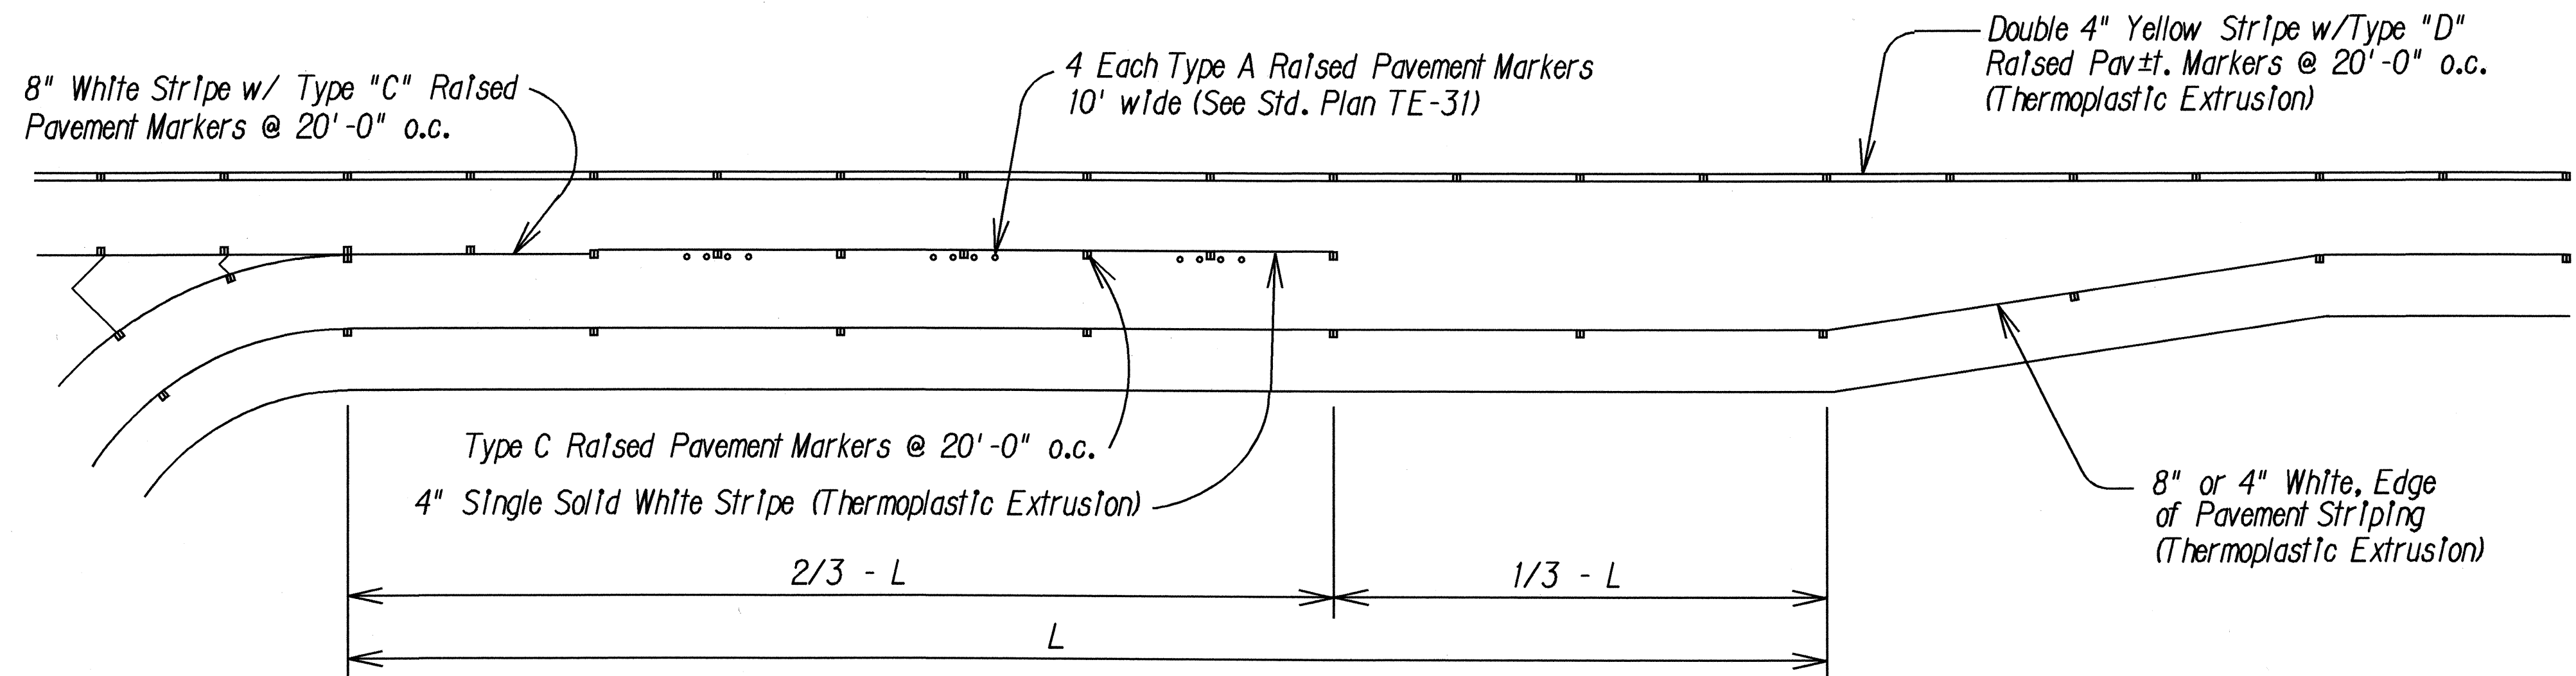


TYPICAL ACCELERATION LANE PAVEMENT MARKING
Not to Scale

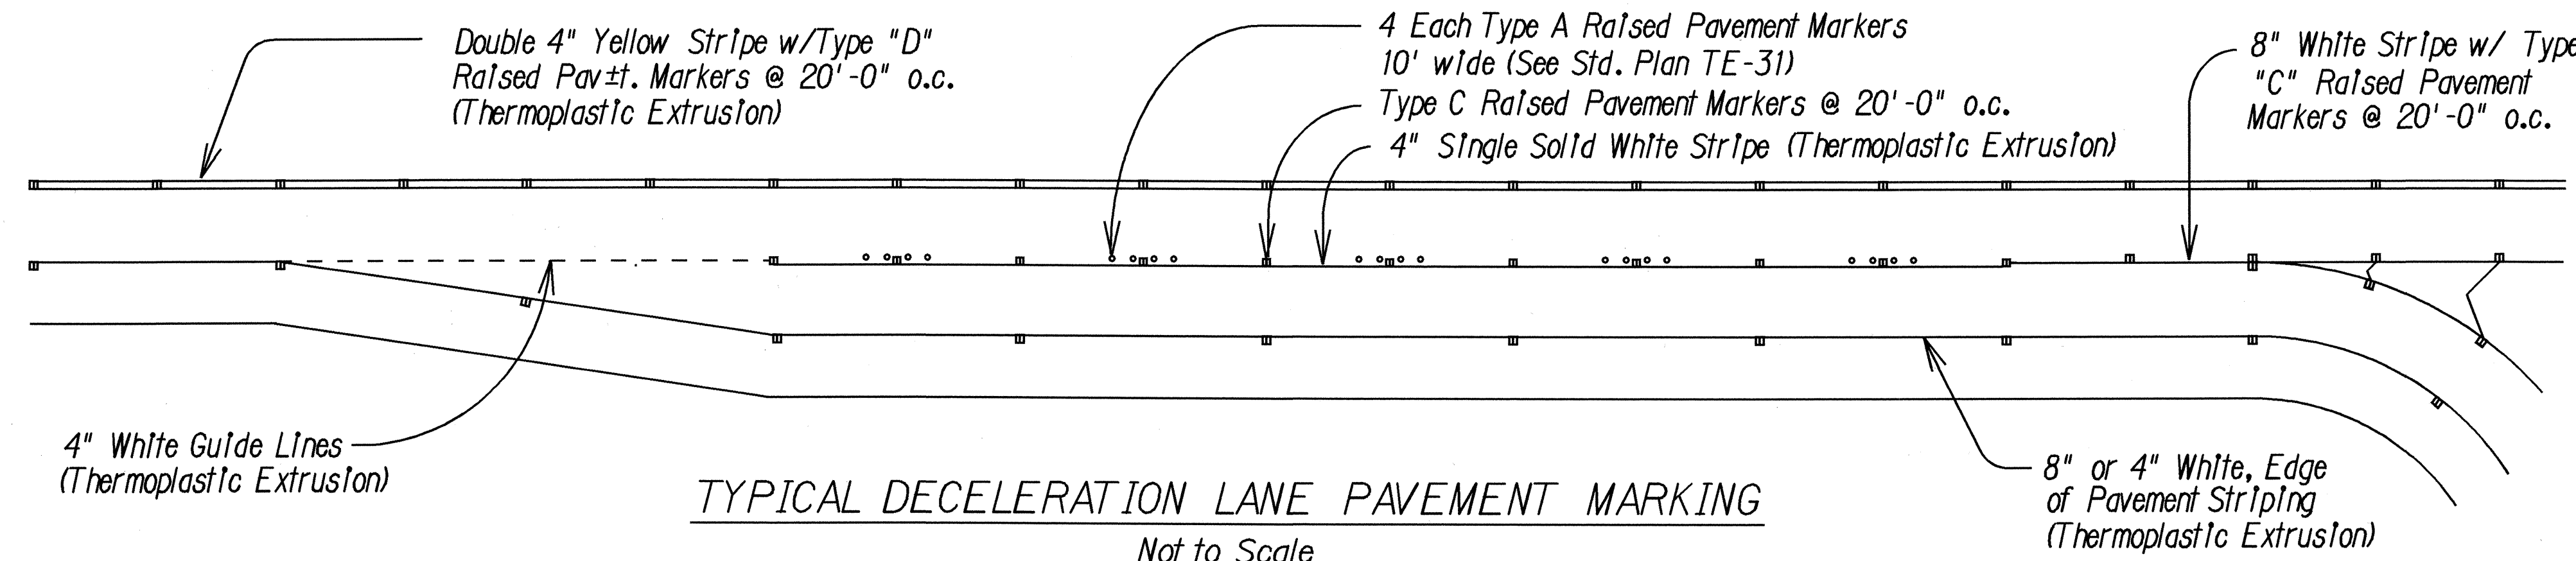

TYPICAL DECELERATION LANE PAVEMENT MARKING
Not to Scale

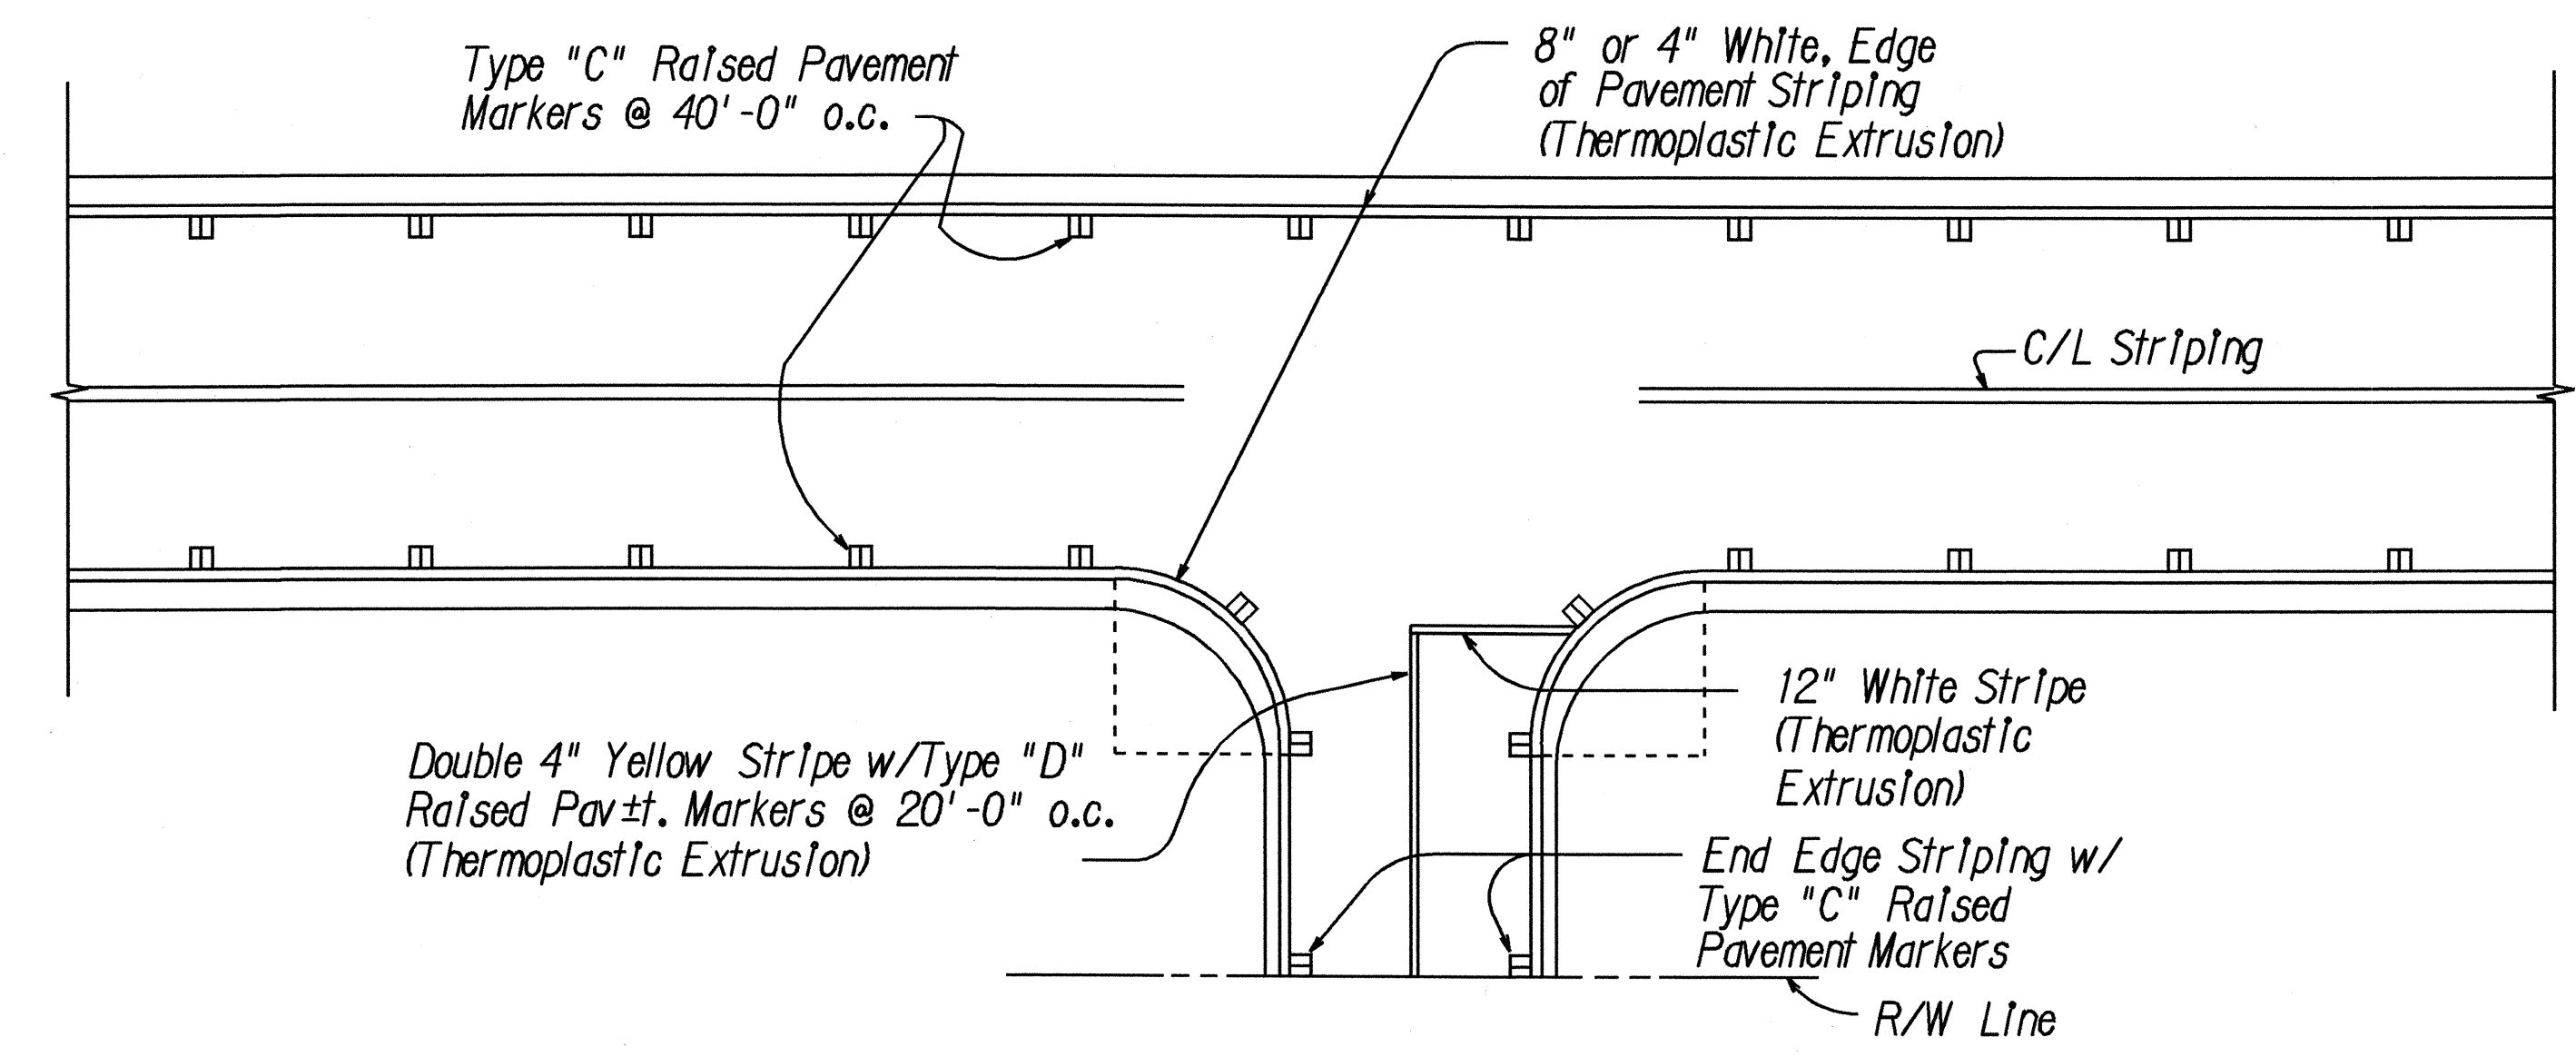

TYPICAL EDGE OF PAVEMENT MARKING
Not to Scale

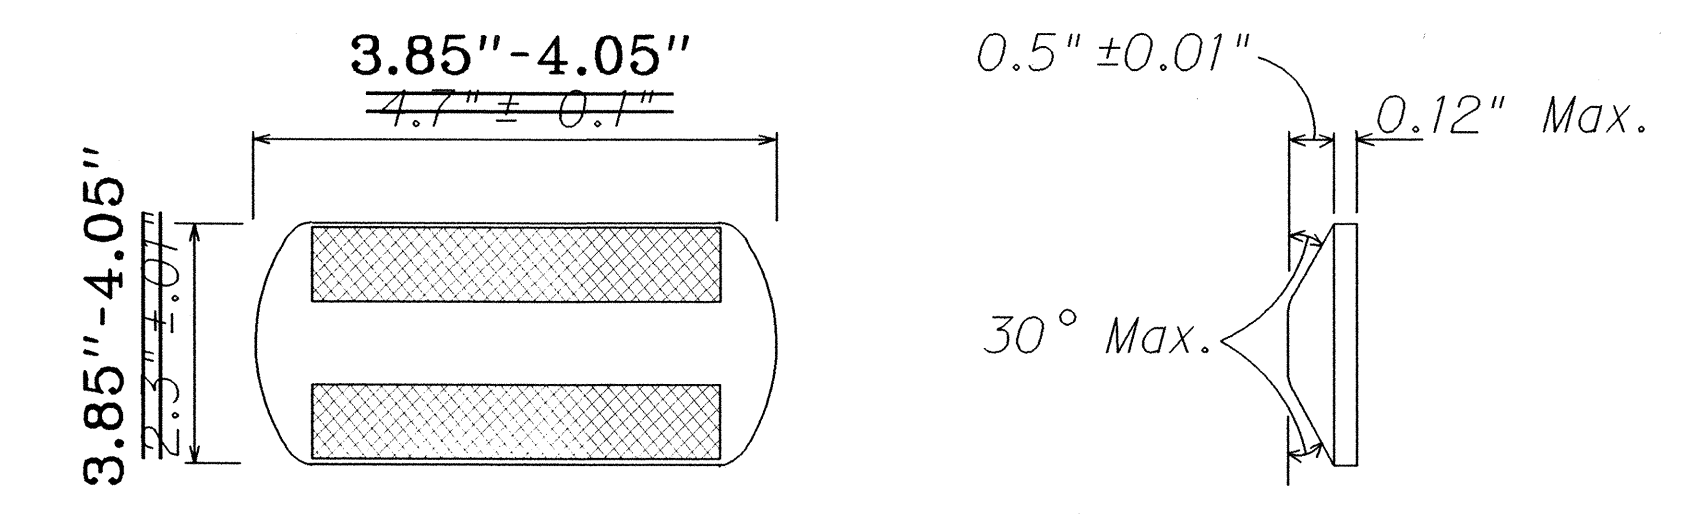

- TYPE C**
Red-Clear Reflective Marker
or
TYPE D
Two-Way Yellow Reflective Marker
or
TYPE H
One-Way Yellow Reflective Marker

RAISED PAVEMENT MARKER DETAILS
Not to Scale

LEGEND FOR AS-BUILT POSTINGS	
	Squiggly line for as-built deletion
	Double line for as-built deletion
Roadway	Text for as-built posting

STATE OF HAWAII
DEPARTMENT OF TRANSPORTATION
HIGHWAYS DIVISION

PAVEMENT MARKING DETAILS

HAWAII BELT ROAD RESURFACING
PAPAIIKOU TO PEPEEKEO
F.A. PROJECT NO. STP-019-2(35)

Scale: As Shown Date: April, 1995

SHEET No. 1 OF 2 SHEETS

ORIGINAL PLAN	DATE
NOTE BOOK	DESIGNED BY
QUANTITIES BY	CHECKED BY
NE/10/20/02	