



FED. ROAD DIST. NO.	STATE	FED. AID PROJ. NO.	FISCAL YEAR	SHEET NO.	TOTAL SHEETS
HAWAII	HAW.	STP-019-2(35)	1995	5	39

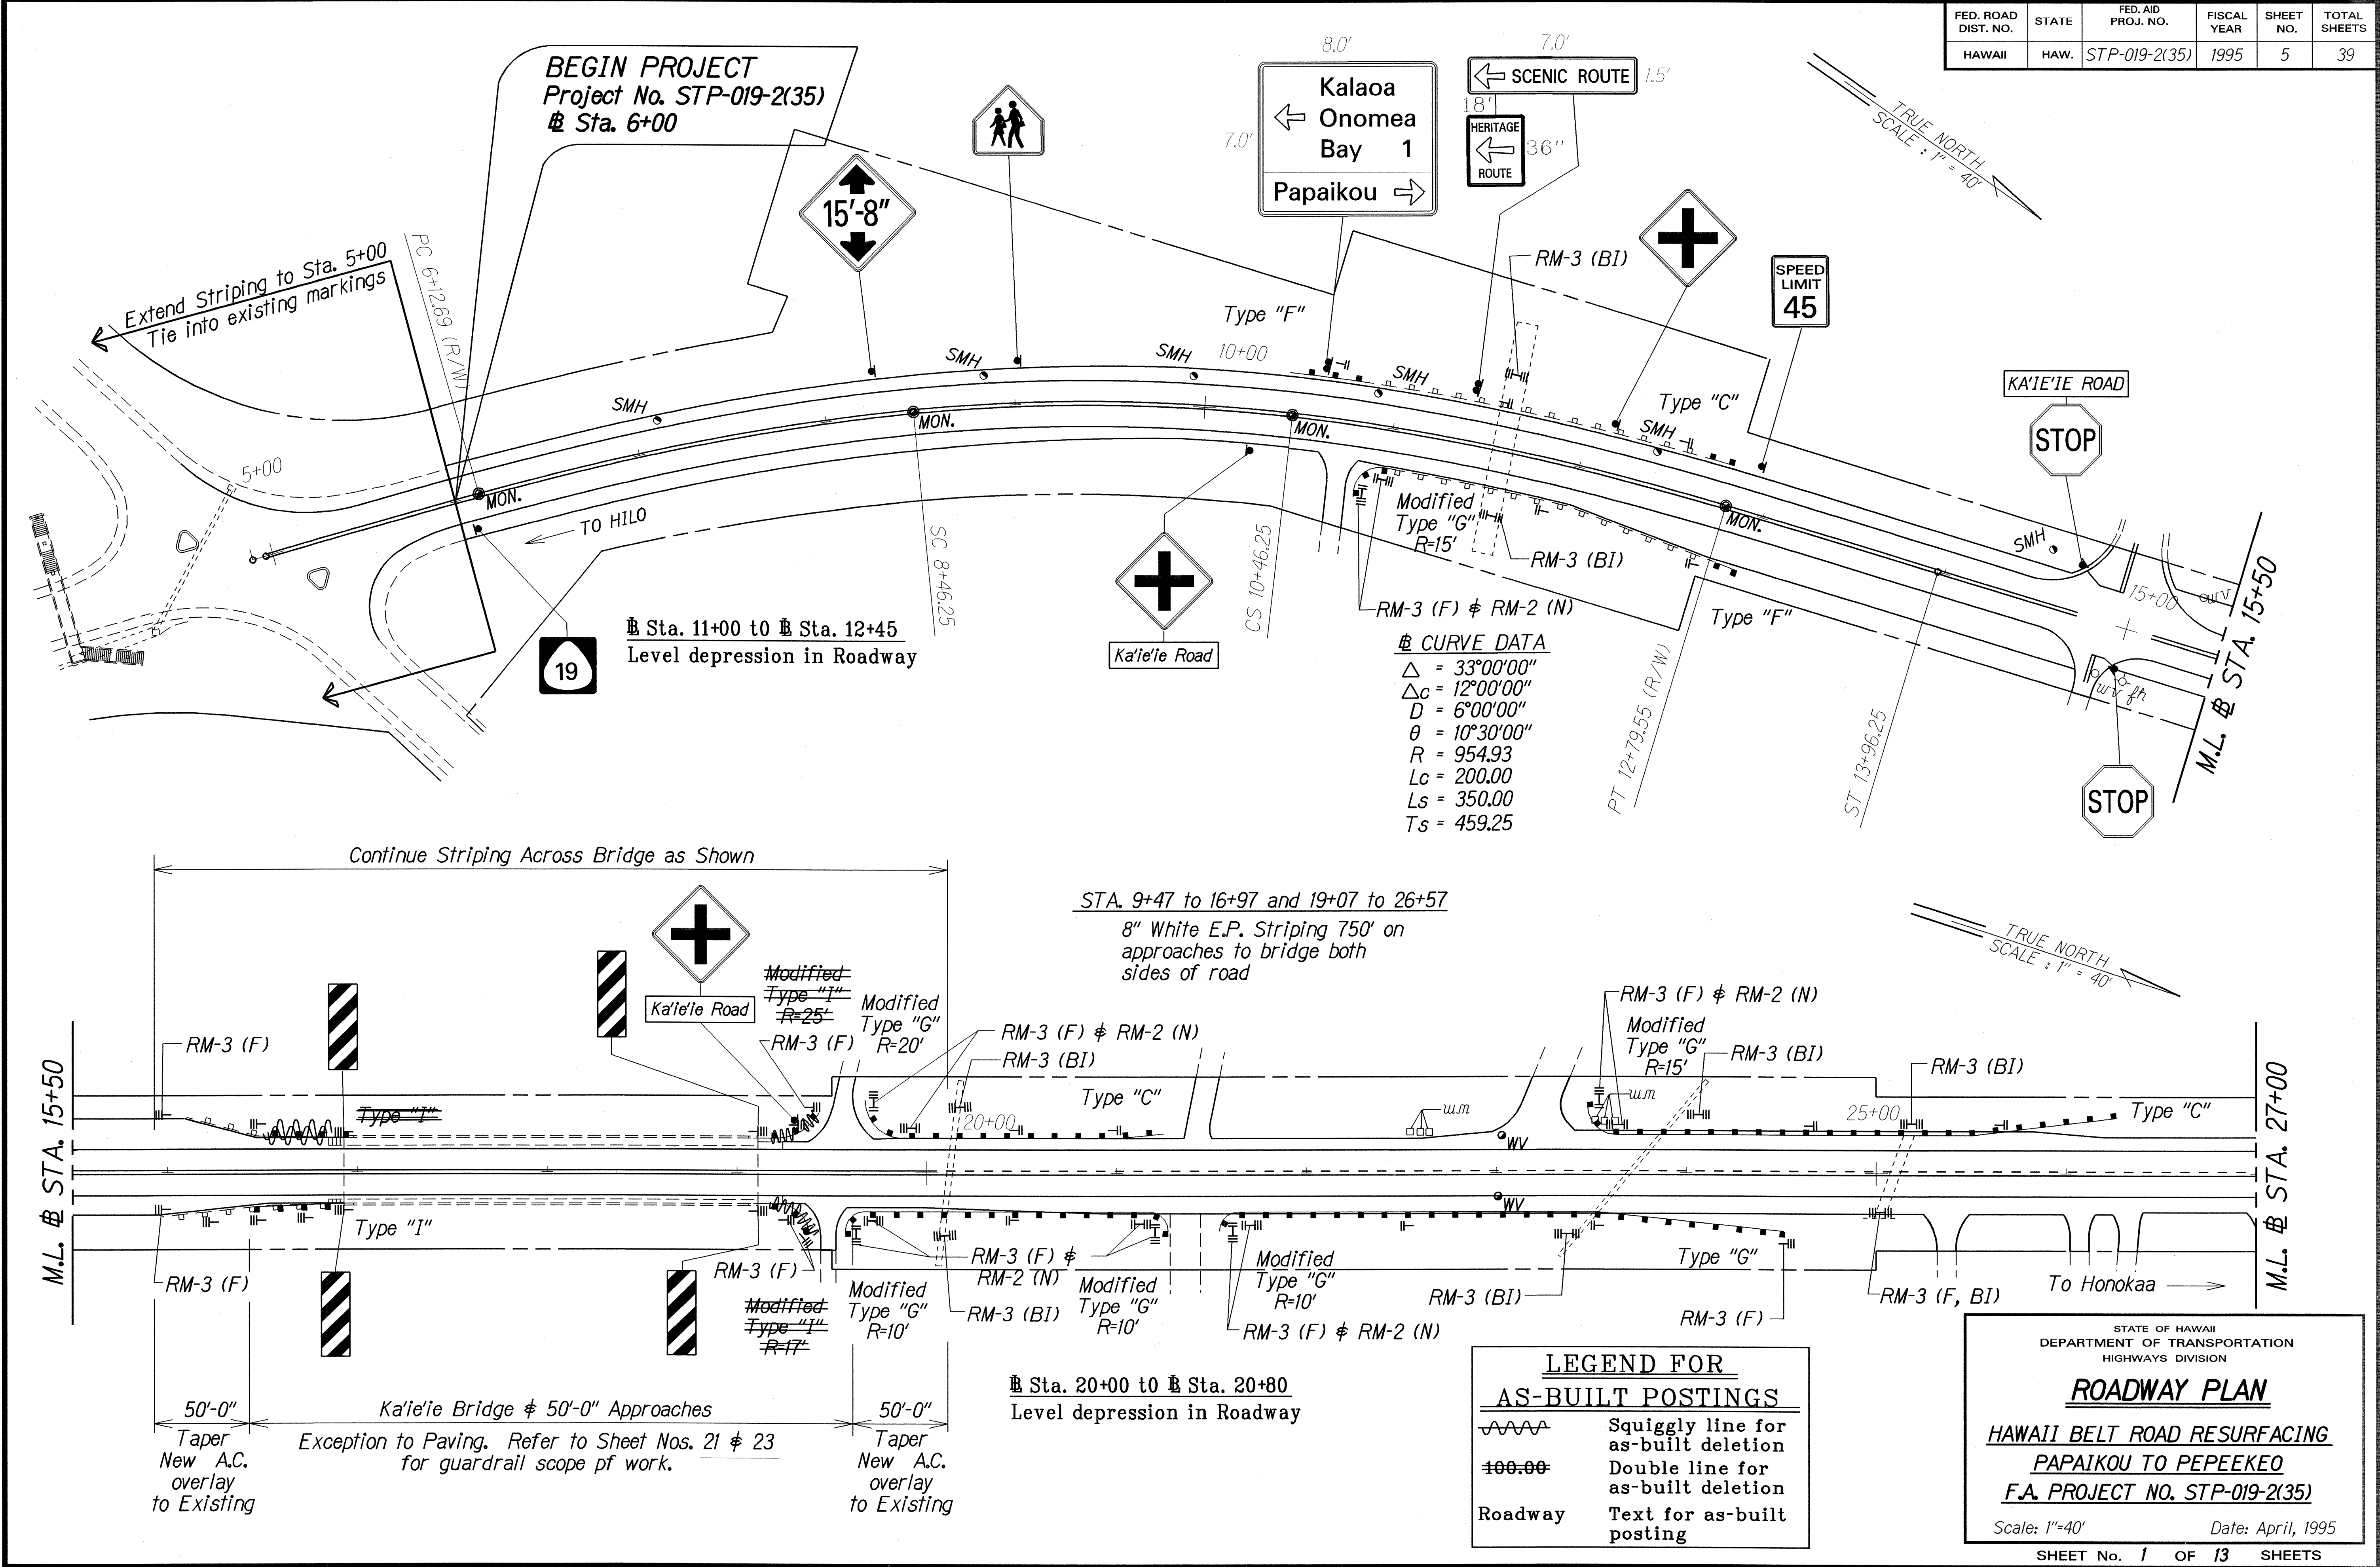

"AS-BUILT"


Sta. 28+75 to Sta. 29+70
Level depression in Roadway


SCALE : 1" = 40'

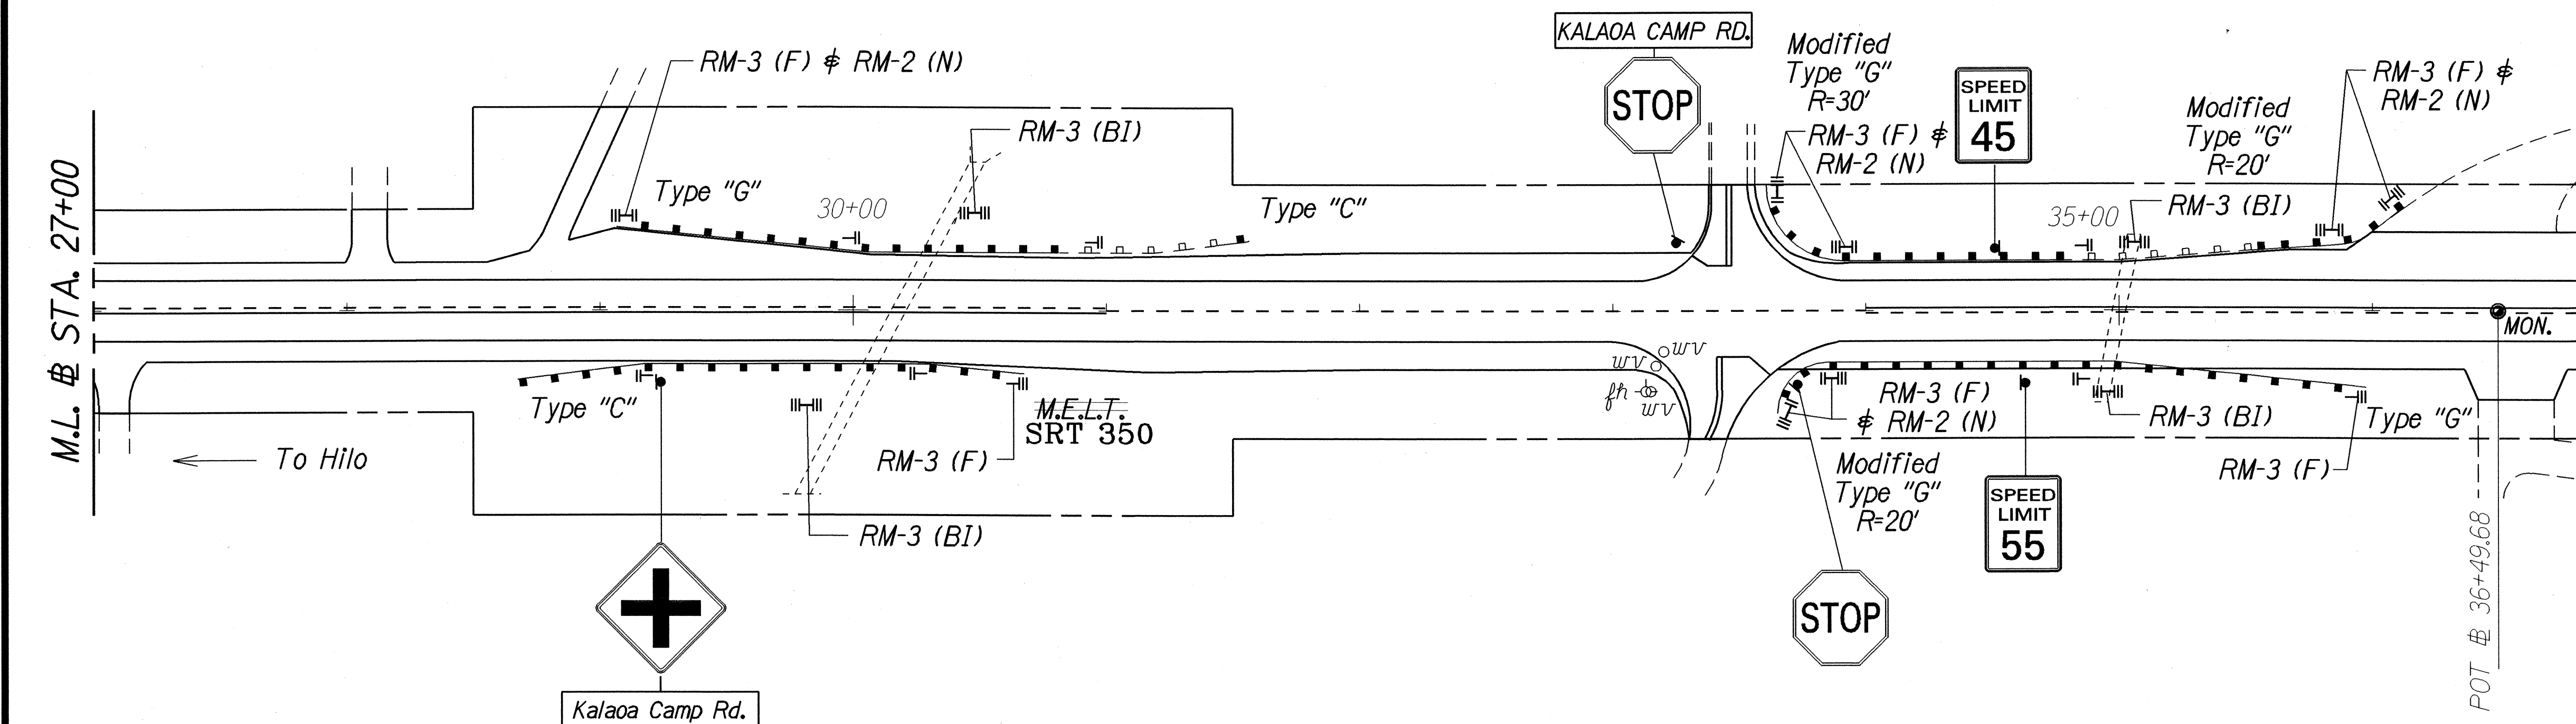

Continue Striping Across Bridge as Shown

 8" White E.P. Striping 750' on approaches to bridge both

				<i>sides of road</i>
---	---	---	---	----------------------

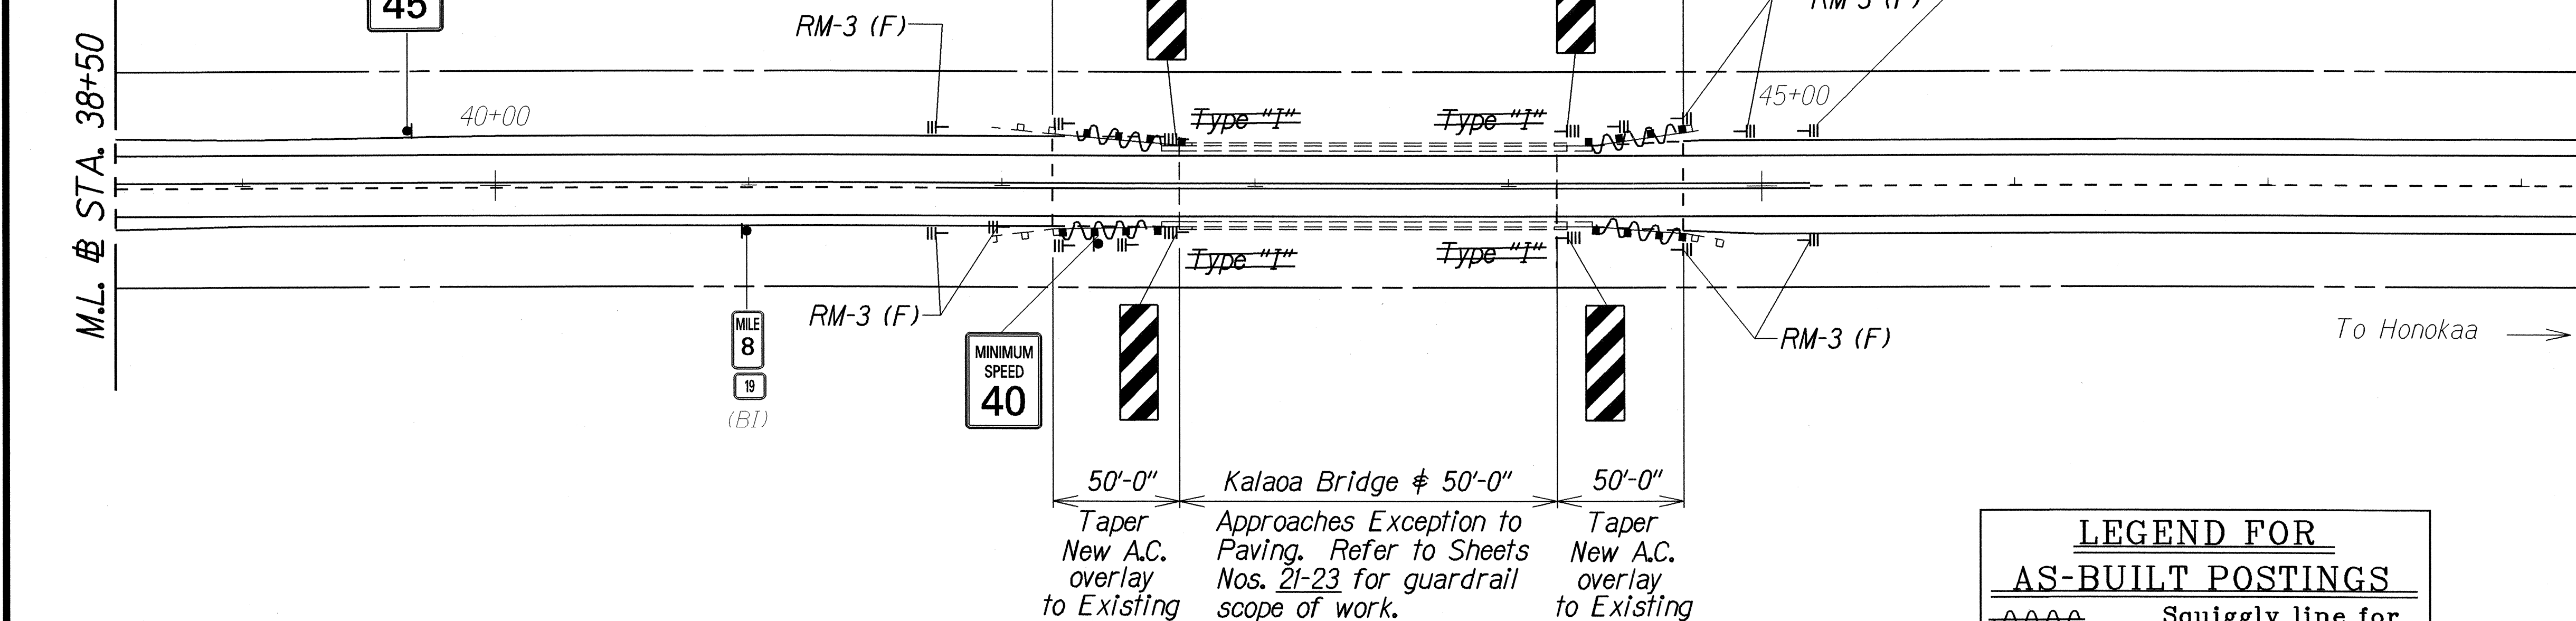

<i>Taper New A.C. overlay to Existing</i>	<i>Approaches Exception to Paving. Refer to Sheets Nos. 21-23 for guardrail scope of work.</i>	<i>Taper New A.C. overlay to Existing</i>	<u>LEGEND FOR</u> <u>AS-BUILT POSTINGS</u>  Squiggly line for as-built deletion 100.00 Double line for as-built deletion Roadway Text for as-built posting
--	---	--	--


50'-0"	Kalaoa Bridge & 50'-0"	50'-0"
Taper New A.C. overlay to Existing	Approaches Exception to Paving. Refer to Sheets Nos. 21-23 for guardrail scope of work.	Taper New A.C. overlay to Existing

LEGEND FOR
AS-BUILT POSTINGS


	Squiggly line for as-built deletion
100.00	Double line for as-built deletion
Roadway	Text for as-built posting

			"AS-BUILT"
--	--	--	------------

FED. ROAD DIST. NO.	STATE	FED. AID PROJ. NO.	FISCAL YEAR	SHEET NO.	TOTAL SHEETS
HAWAII	HAW.	STP-019-2(35)	1995	7	39

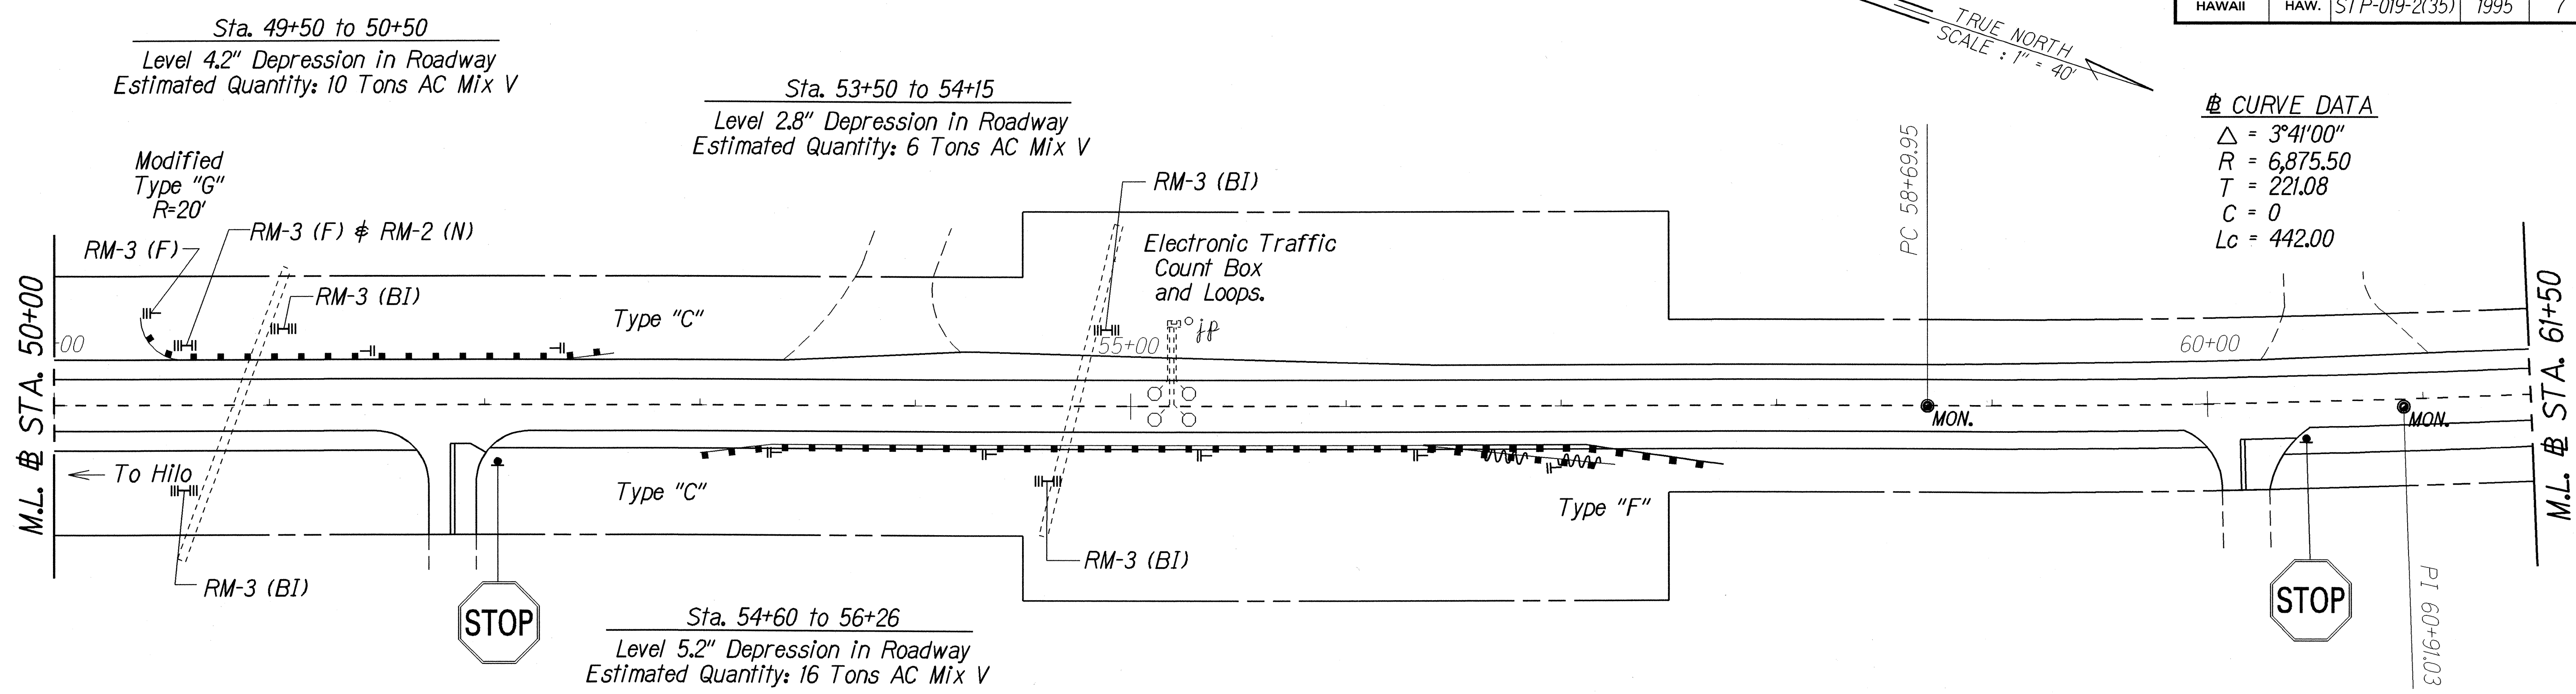

CURVE DATA
 $\Delta = 3^\circ 41' 00''$
 $R = 6,875.50$
 $T = 221.08$
 $C = 0$
 $Lc = 442.00$

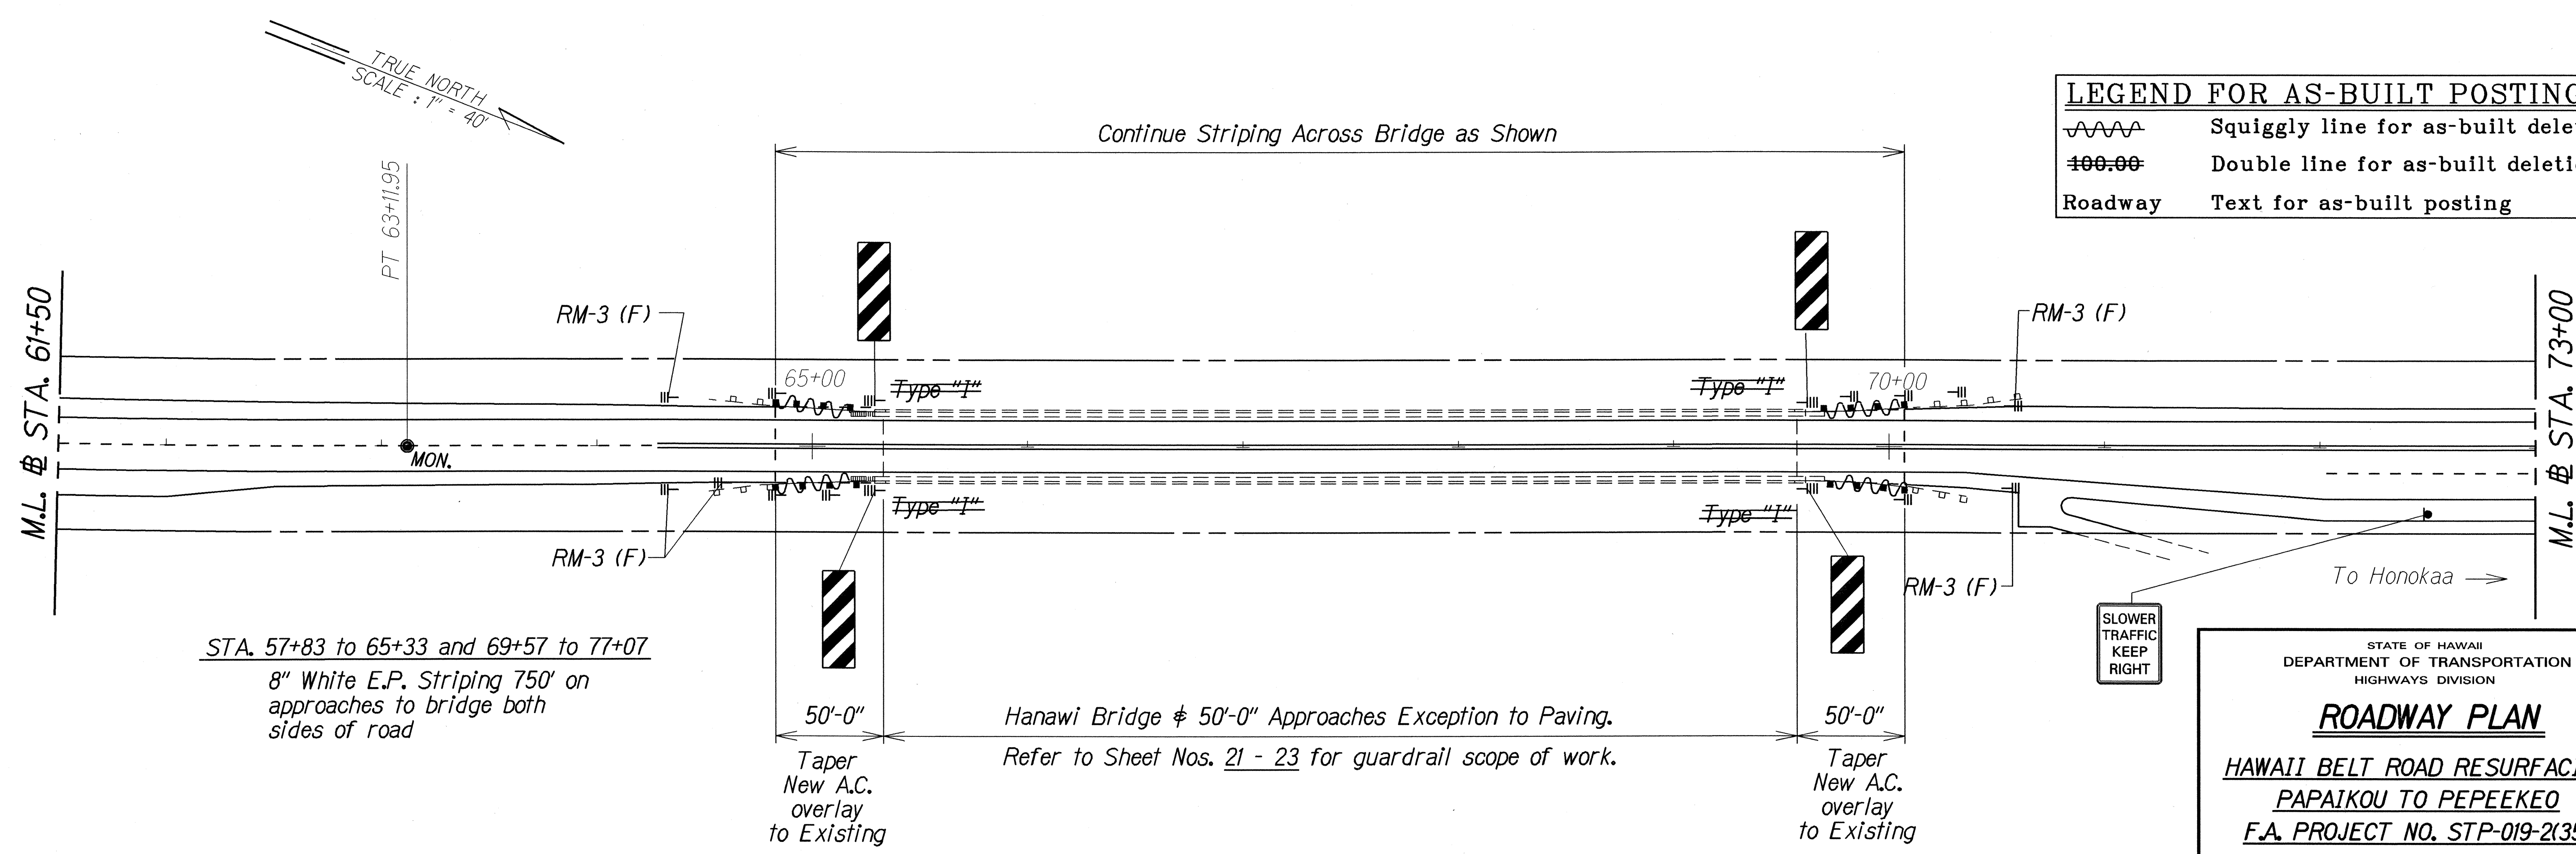

LEGEND FOR AS-BUILT POSTINGS

	Squiggly line for as-built deletion
	Double line for as-built deletion
Roadway	Text for as-built posting

STATE OF HAWAII
DEPARTMENT OF TRANSPORTATION
HIGHWAYS DIVISION

ROADWAY PLAN

HAWAII BELT ROAD RESURFACING
PAPA'IKOU TO PEPEEKEO
F.A. PROJECT NO. STP-019-2(35)

Scale: 1"=40' Date: April, 1995

SHEET No. 3 OF 13 SHEETS


SURVEY PLOTTED BY	DATE
DESIGNED BY	
NOTED BY	
QUANTITIES BY	
CHECKED BY	

"AS-BUILT"

FED. ROAD DIST. NO.	STATE	FED. AID PROJ. NO.	FISCAL YEAR	SHEET NO.	TOTAL SHEETS
HAWAII	HAW.	STP-019-2(35)	1995	8	39

Sta. 75+75 to Sta. 76+70
Level depression in Roadway

Sta. 77+04 to Sta. 78+15
Level depression in Roadway

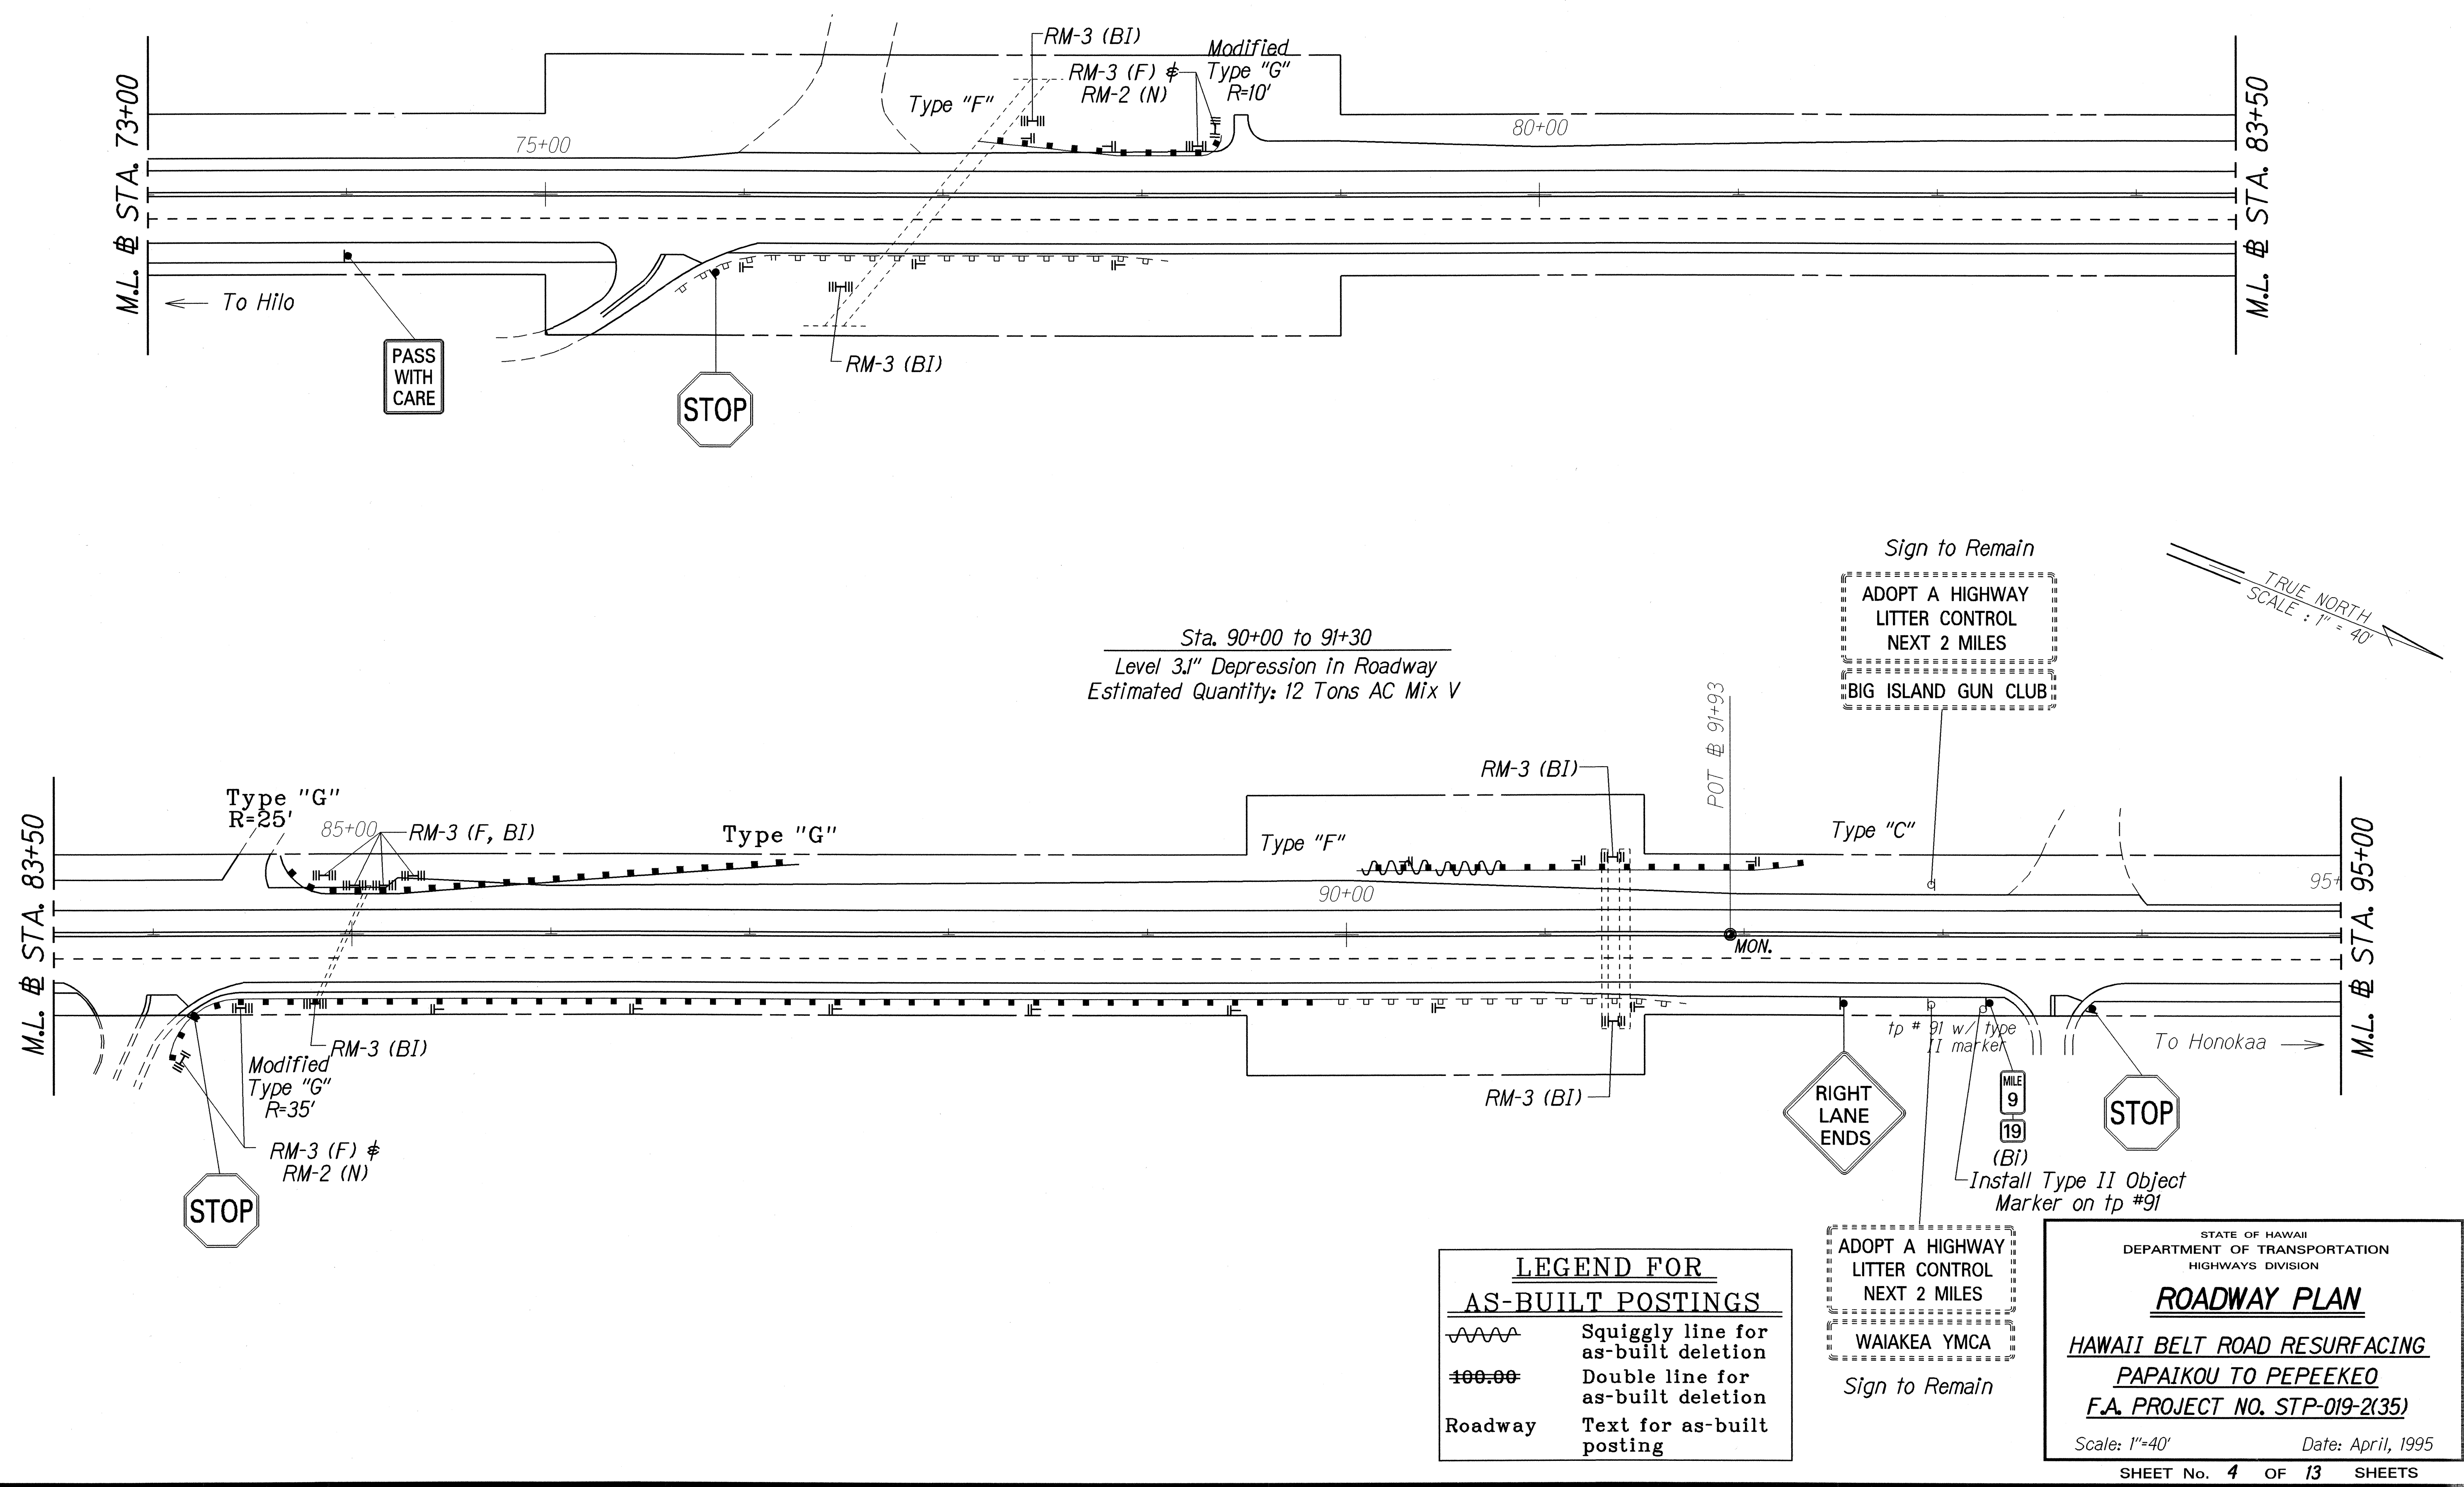

LEGEND FOR AS-BUILT POSTINGS

	Squiggly line for as-built deletion
	Double line for as-built deletion
Roadway	Text for as-built posting

ADOPT A HIGHWAY
LITTER CONTROL
NEXT 2 MILES
WAIKAEKA YMCA
Sign to Remain

STATE OF HAWAII
DEPARTMENT OF TRANSPORTATION
HIGHWAYS DIVISION

ROADWAY PLAN

HAWAII BELT ROAD RESURFACING
PAPAIOU TO PEPEEKEO
F.A. PROJECT NO. STP-019-2(35)


Scale: 1"=40' Date: April, 1995

SHEET No. 4 OF 13 SHEETS

"AS-BUILT"

FED. ROAD DIST. NO.	STATE	FED. AID PROJ. NO.	FISCAL YEAR	SHEET NO.	TOTAL SHEETS
HAWAII	HAW.	STP-019-2(35)	1995	9	39

Sta. 95+80 to Sta. 96+40
Level depression in Roadway

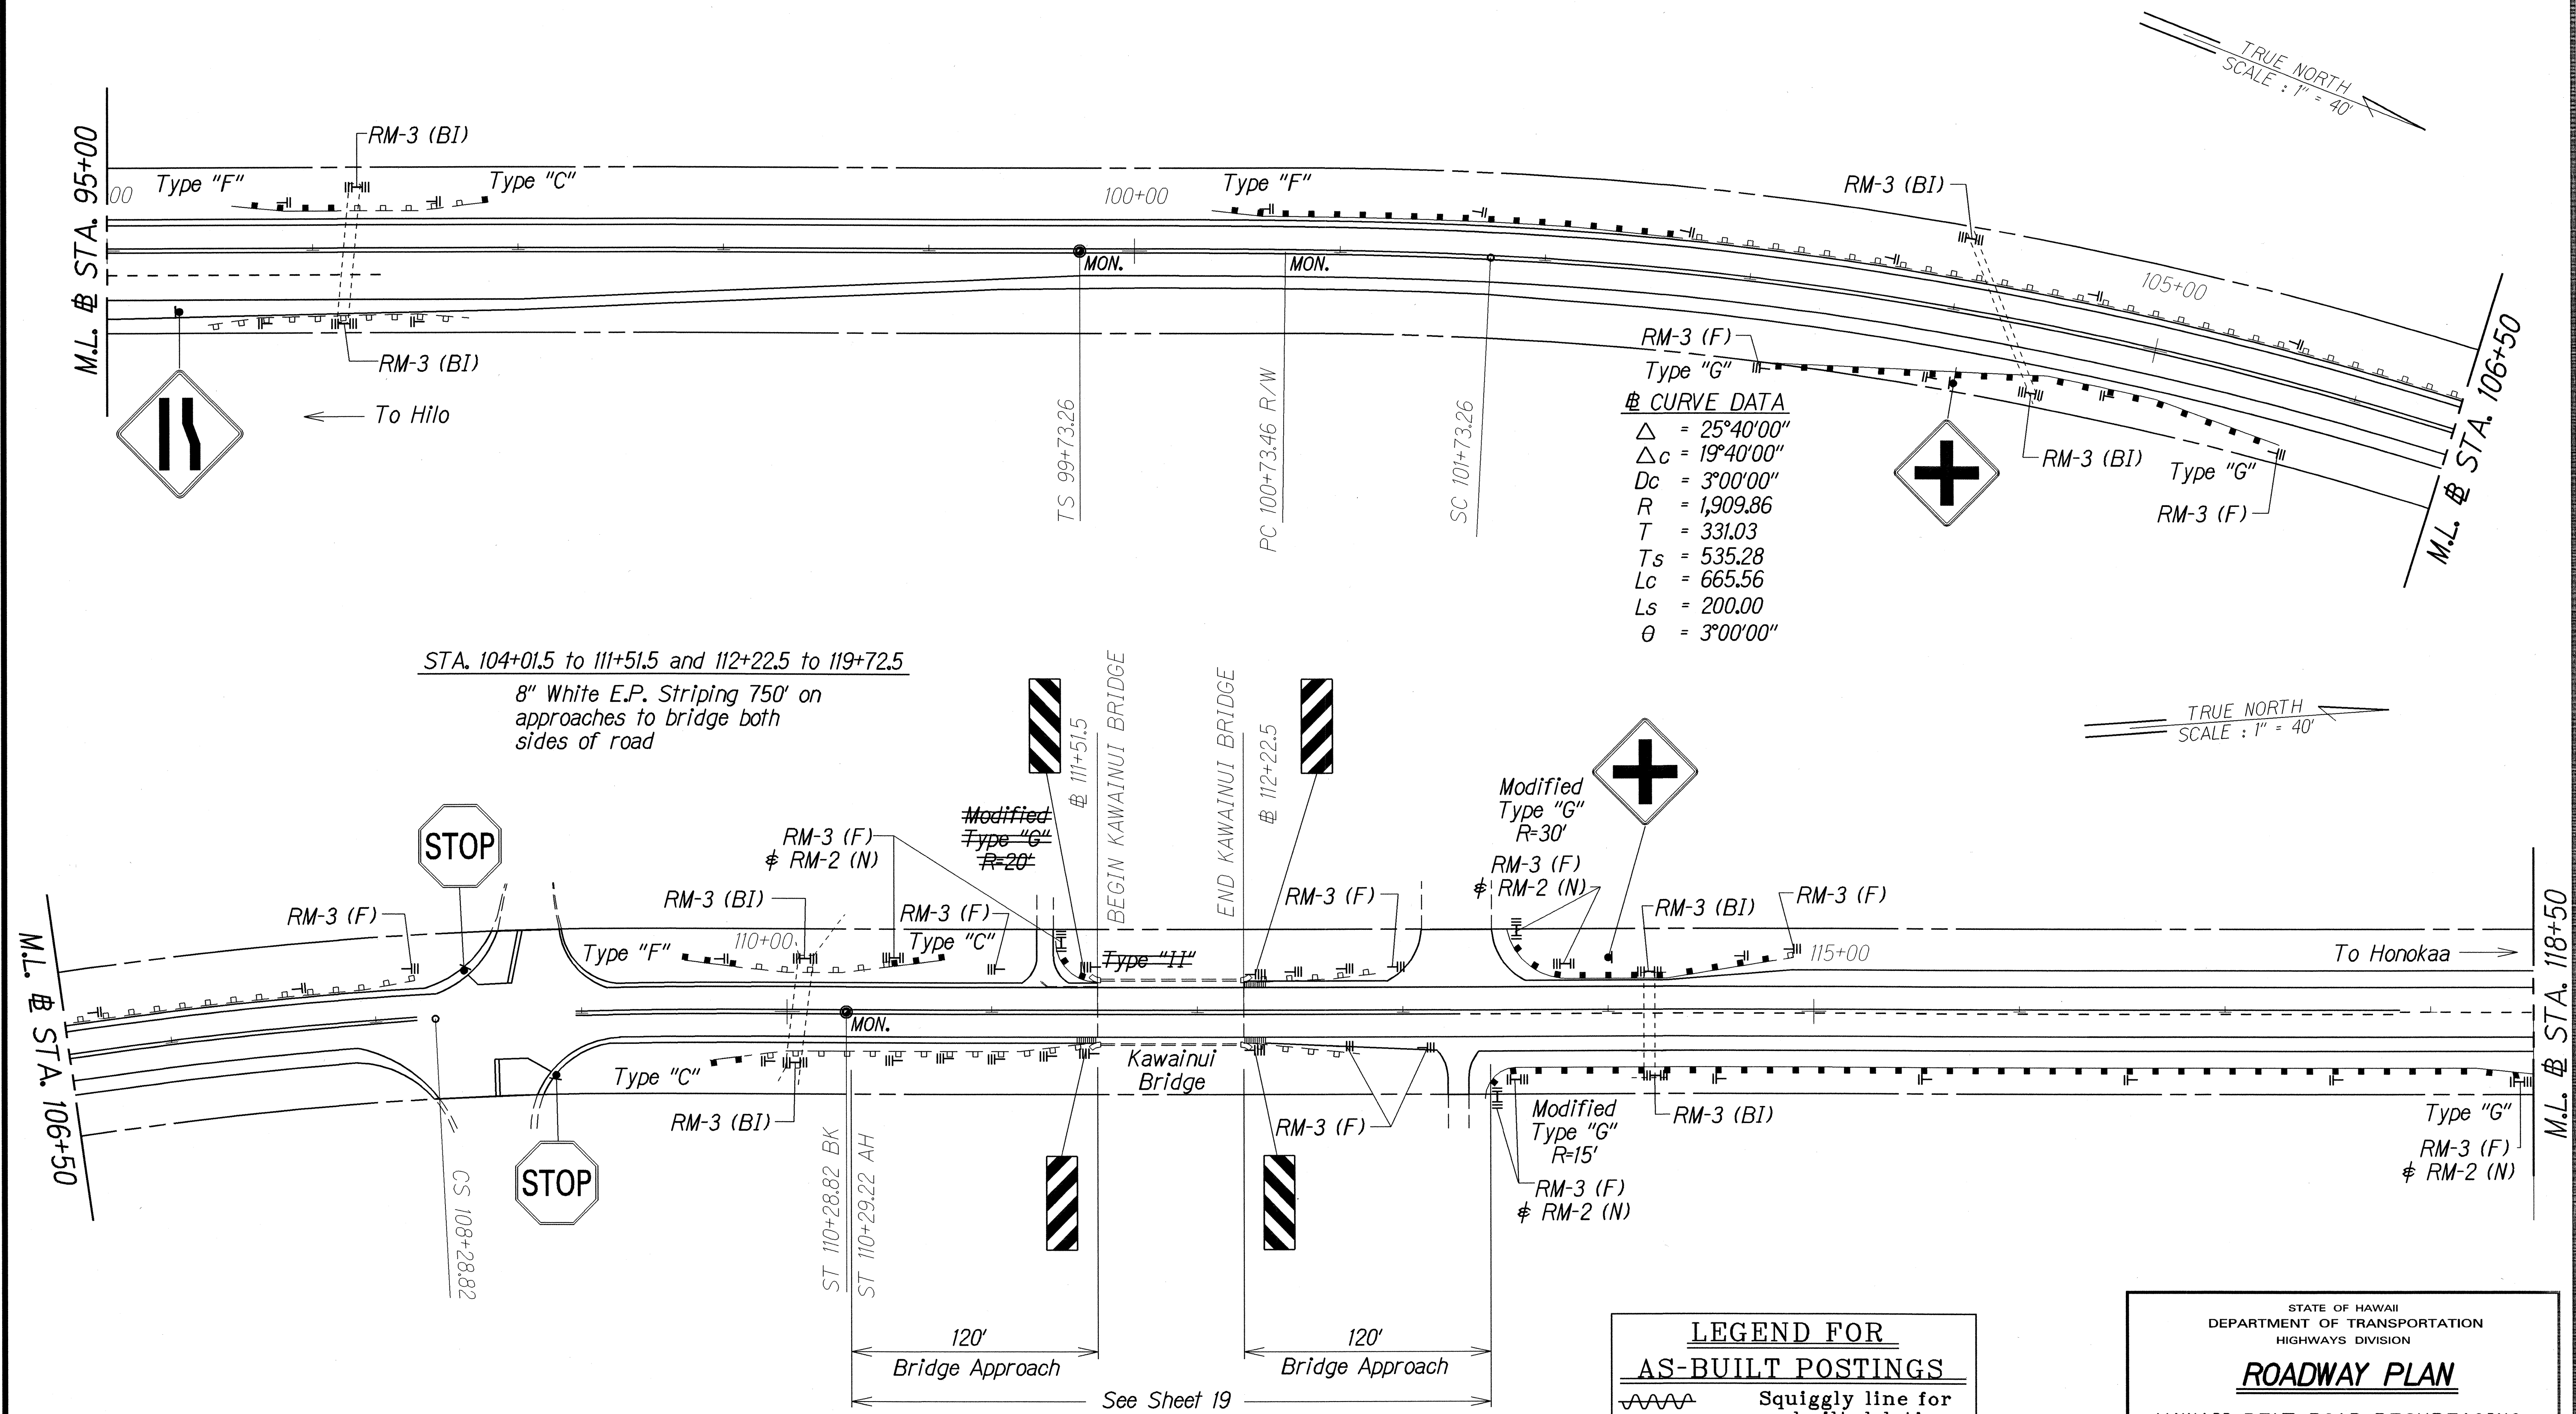

DATE	_____
SURVEY PLOTTED BY	_____
DESIGNED BY	_____
QUANTITIES BY	_____
CHECKED BY	_____
ORIGINAL PLAN	_____
NOTE BOOK	_____
DATE	_____
BY	_____

STATE OF HAWAII
DEPARTMENT OF TRANSPORTATION
HIGHWAYS DIVISION

ROADWAY PLAN

HAWAII BELT ROAD RESURFACING
PAPAIKOU TO PEPEEKEO
F.A. PROJECT NO. STP-019-2(35)

Scale: 1"=40' Date: April, 1995


SHEET No. 5 OF 13 SHEETS

"AS-BUILT"

FED. ROAD DIST. NO.	STATE	FED. AID PROJ. NO.	FISCAL YEAR	SHEET NO.	TOTAL SHEETS
HAWAII	HAW.	STP-019-2(35)	1995	10	39


TRUE NORTH
SCALE : 1" = 40'

Sta. 126+20 to 127+20
Level 3.6" Depression in Roadway
Estimated Quantity: 10 Tons AC Mix V

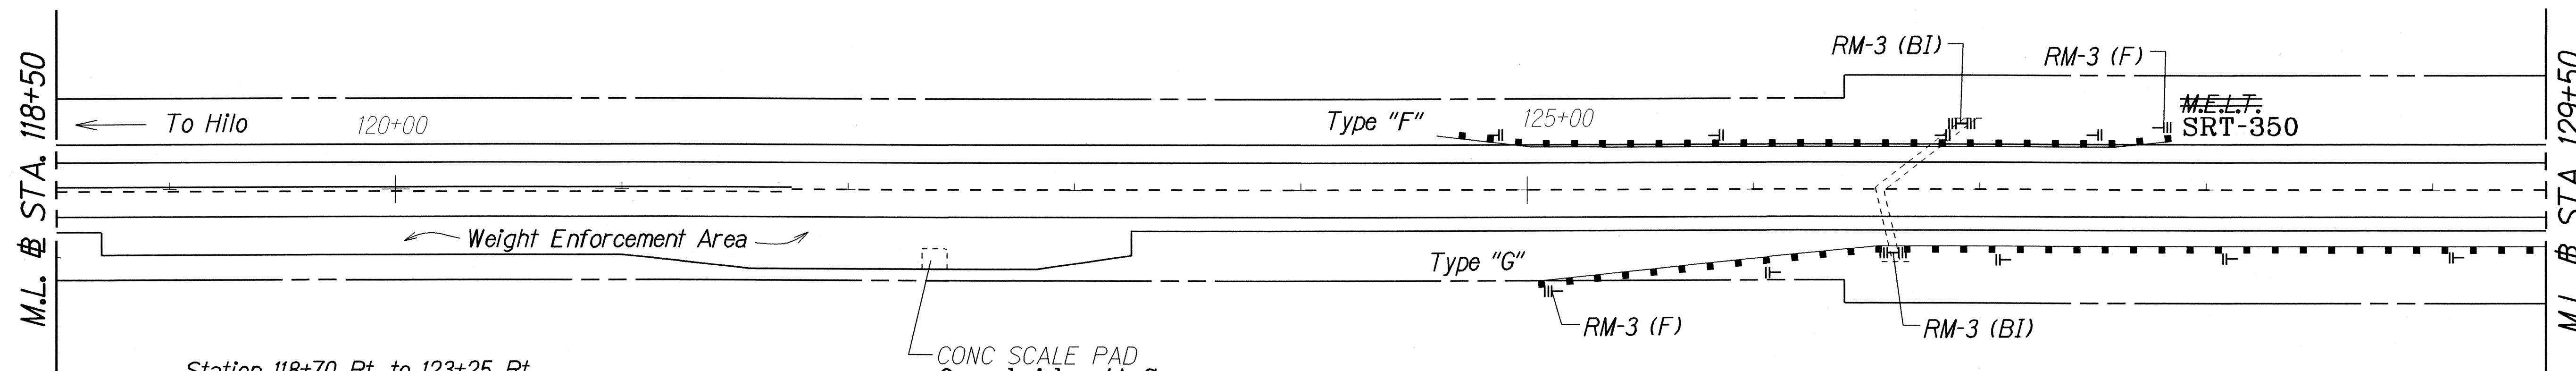

Station 118+70 Rt. to 123+25 Rt.
Reconstruct Weight Enforcement Area. Estimated Quantities:
Excavation for Reconstruction of Weakened Pavement Areas: 110 C.Y.
4" A.C. Base Course: 230 Tons
3" A.C. Mix No. IV: 173 Tons
Payment shall be made under respective pay items.

Sta. 132+70 to Sta. 133+95
Level depression in Roadway

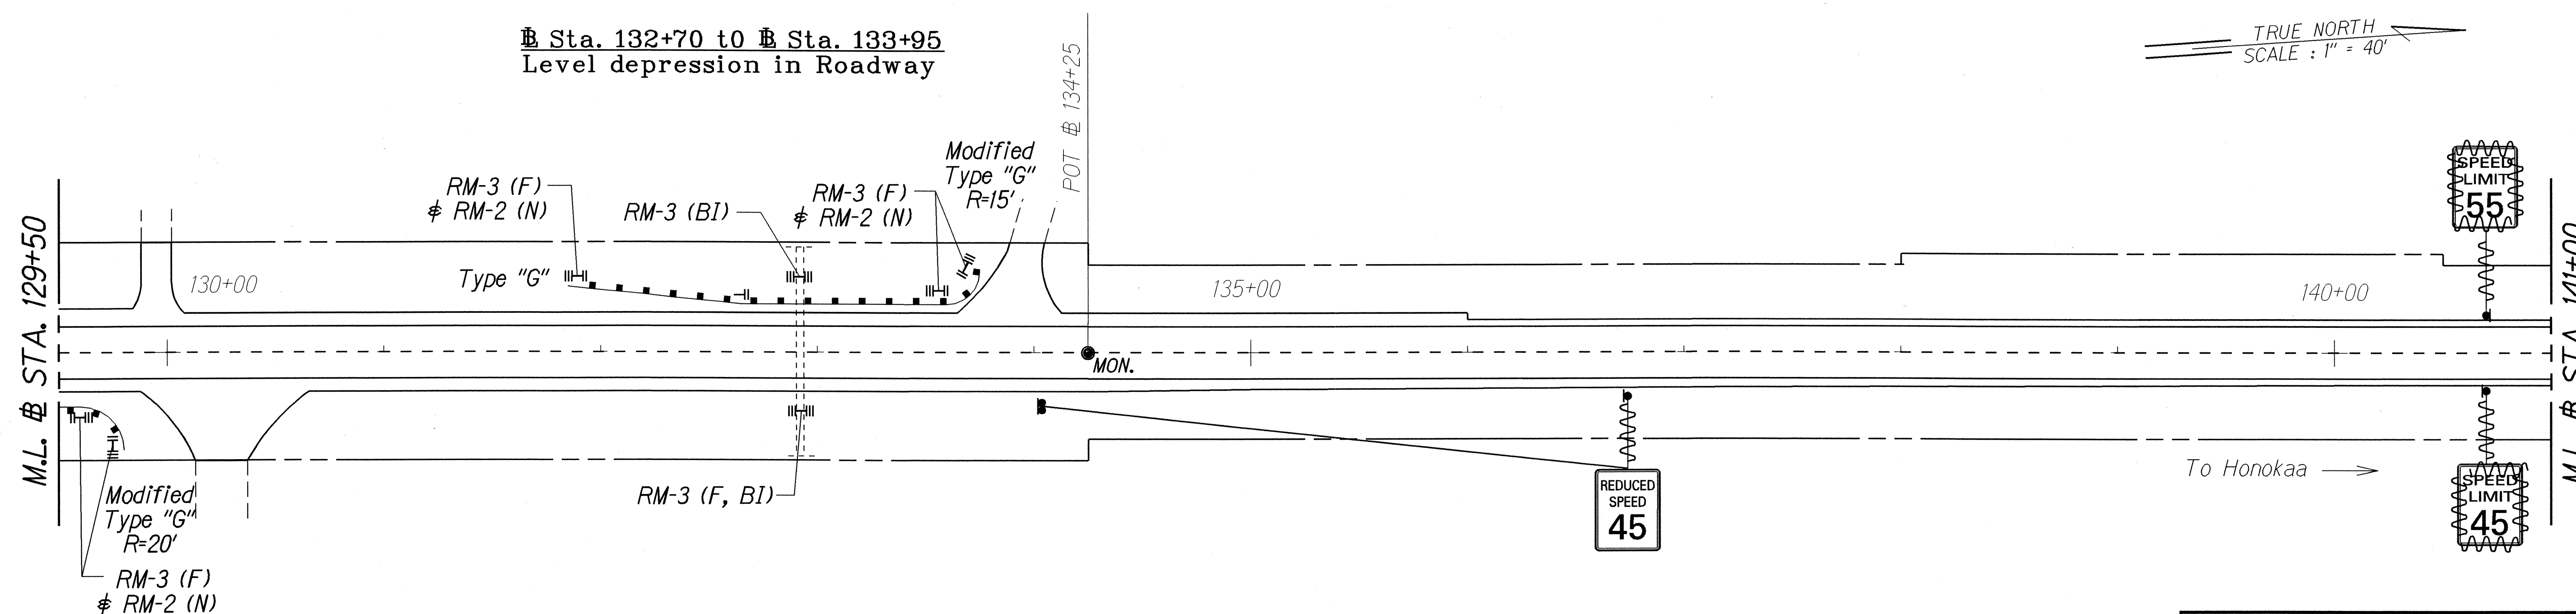

LEGEND FOR AS-BUILT POSTINGS	
	Squiggly line for as-built deletion
	Double line for as-built deletion
Roadway	Text for as-built posting


STATE OF HAWAII DEPARTMENT OF TRANSPORTATION HIGHWAYS DIVISION	
ROADWAY PLAN	
HAWAII BELT ROAD RESURFACING PAPAIOU TO PEPEEKEO F.A. PROJECT NO. STP-019-2(35)	
Scale: 1"=40'	Date: April, 1995
SHEET No. 6 OF 13 SHEETS	

"AS-BUILT"

10

ORIGINAL PLAN	DATE
DESIGNED BY	
CHECKED BY	
NOTED BY	
QUANTITIES BY	
CHECKED BY	

FED. ROAD DIST. NO.	STATE	FED. AID PROJ. NO.	FISCAL YEAR	SHEET NO.	TOTAL SHEETS
HAWAII	HAW.	STP-019-2(35)	1995	11	39

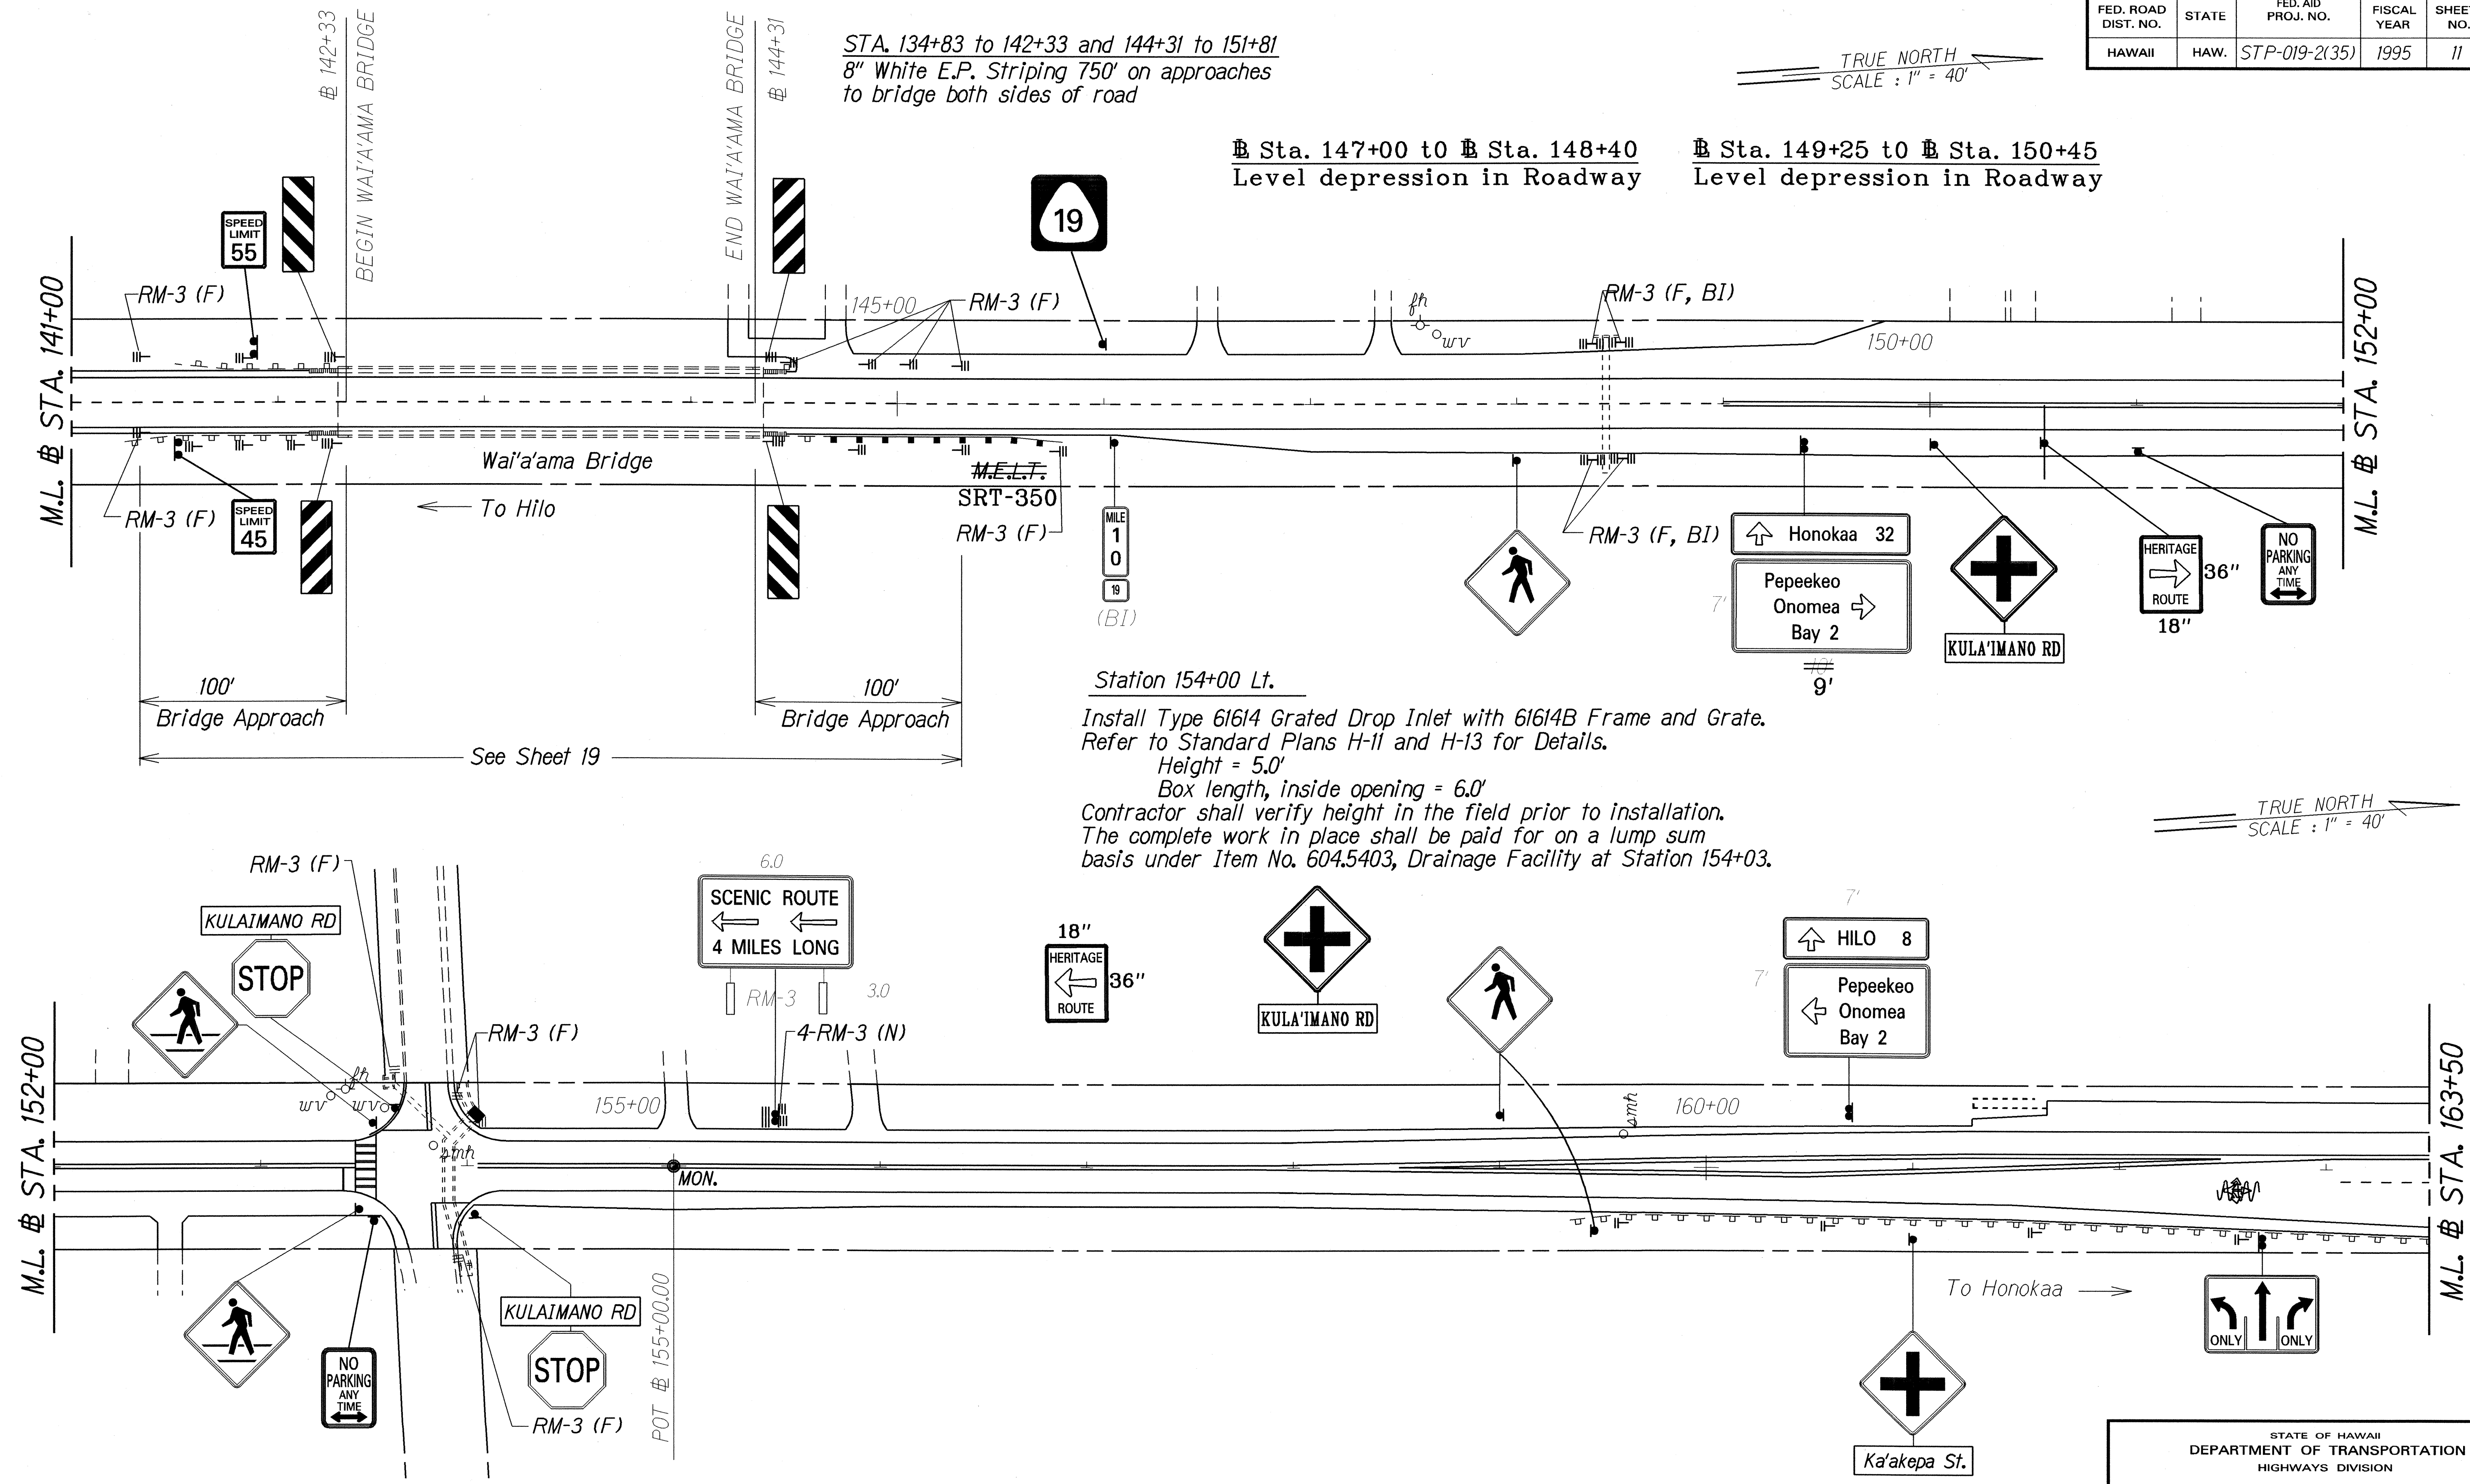

STA. 134+83 to 142+33 and 144+31 to 151+81
8" White E.P. Striping 750' on approaches
to bridge both sides of road

TRUE NORTH
SCALE : 1" = 40'

Sta. 147+00 to Sta. 148+40 Level depression in Roadway
Sta. 149+25 to Sta. 150+45 Level depression in Roadway

Station 154+00 Lt.
Install Type 61614 Grated Drop Inlet with 61614B Frame and Grate.
Refer to Standard Plans H-11 and H-13 for Details.
Height = 5.0'
Box length, inside opening = 6.0'
Contractor shall verify height in the field prior to installation.
The complete work in place shall be paid for on a lump sum basis under Item No. 604.5403, Drainage Facility at Station 154+03.

TRUE NORTH
SCALE : 1" = 40'

LEGEND FOR AS-BUILT POSTINGS	
	Squiggly line for as-built deletion
	Double line for as-built deletion
Roadway	Text for as-built posting

STATE OF HAWAII
DEPARTMENT OF TRANSPORTATION
HIGHWAYS DIVISION

ROADWAY PLAN

HAWAII BELT ROAD RESURFACING
PAPA'IKOU TO PEPEEKEO
F.A. PROJECT NO. STP-019-2(35)


Scale: 1"=40' Date: April, 1995

SHEET No. 7 OF 13 SHEETS

"AS-BUILT"


ORIGINAL PLAN	DATE
DESIGNED BY	
CHECKED BY	
NOTED BY	
QUANTITIES BY	
CHECKED BY	

FED. ROAD DIST. NO.	STATE	FED. AID PROJ. NO.	FISCAL YEAR	SHEET NO.	TOTAL SHEETS
HAWAII	HAW.	STP-019-2(35)	1995	12	39

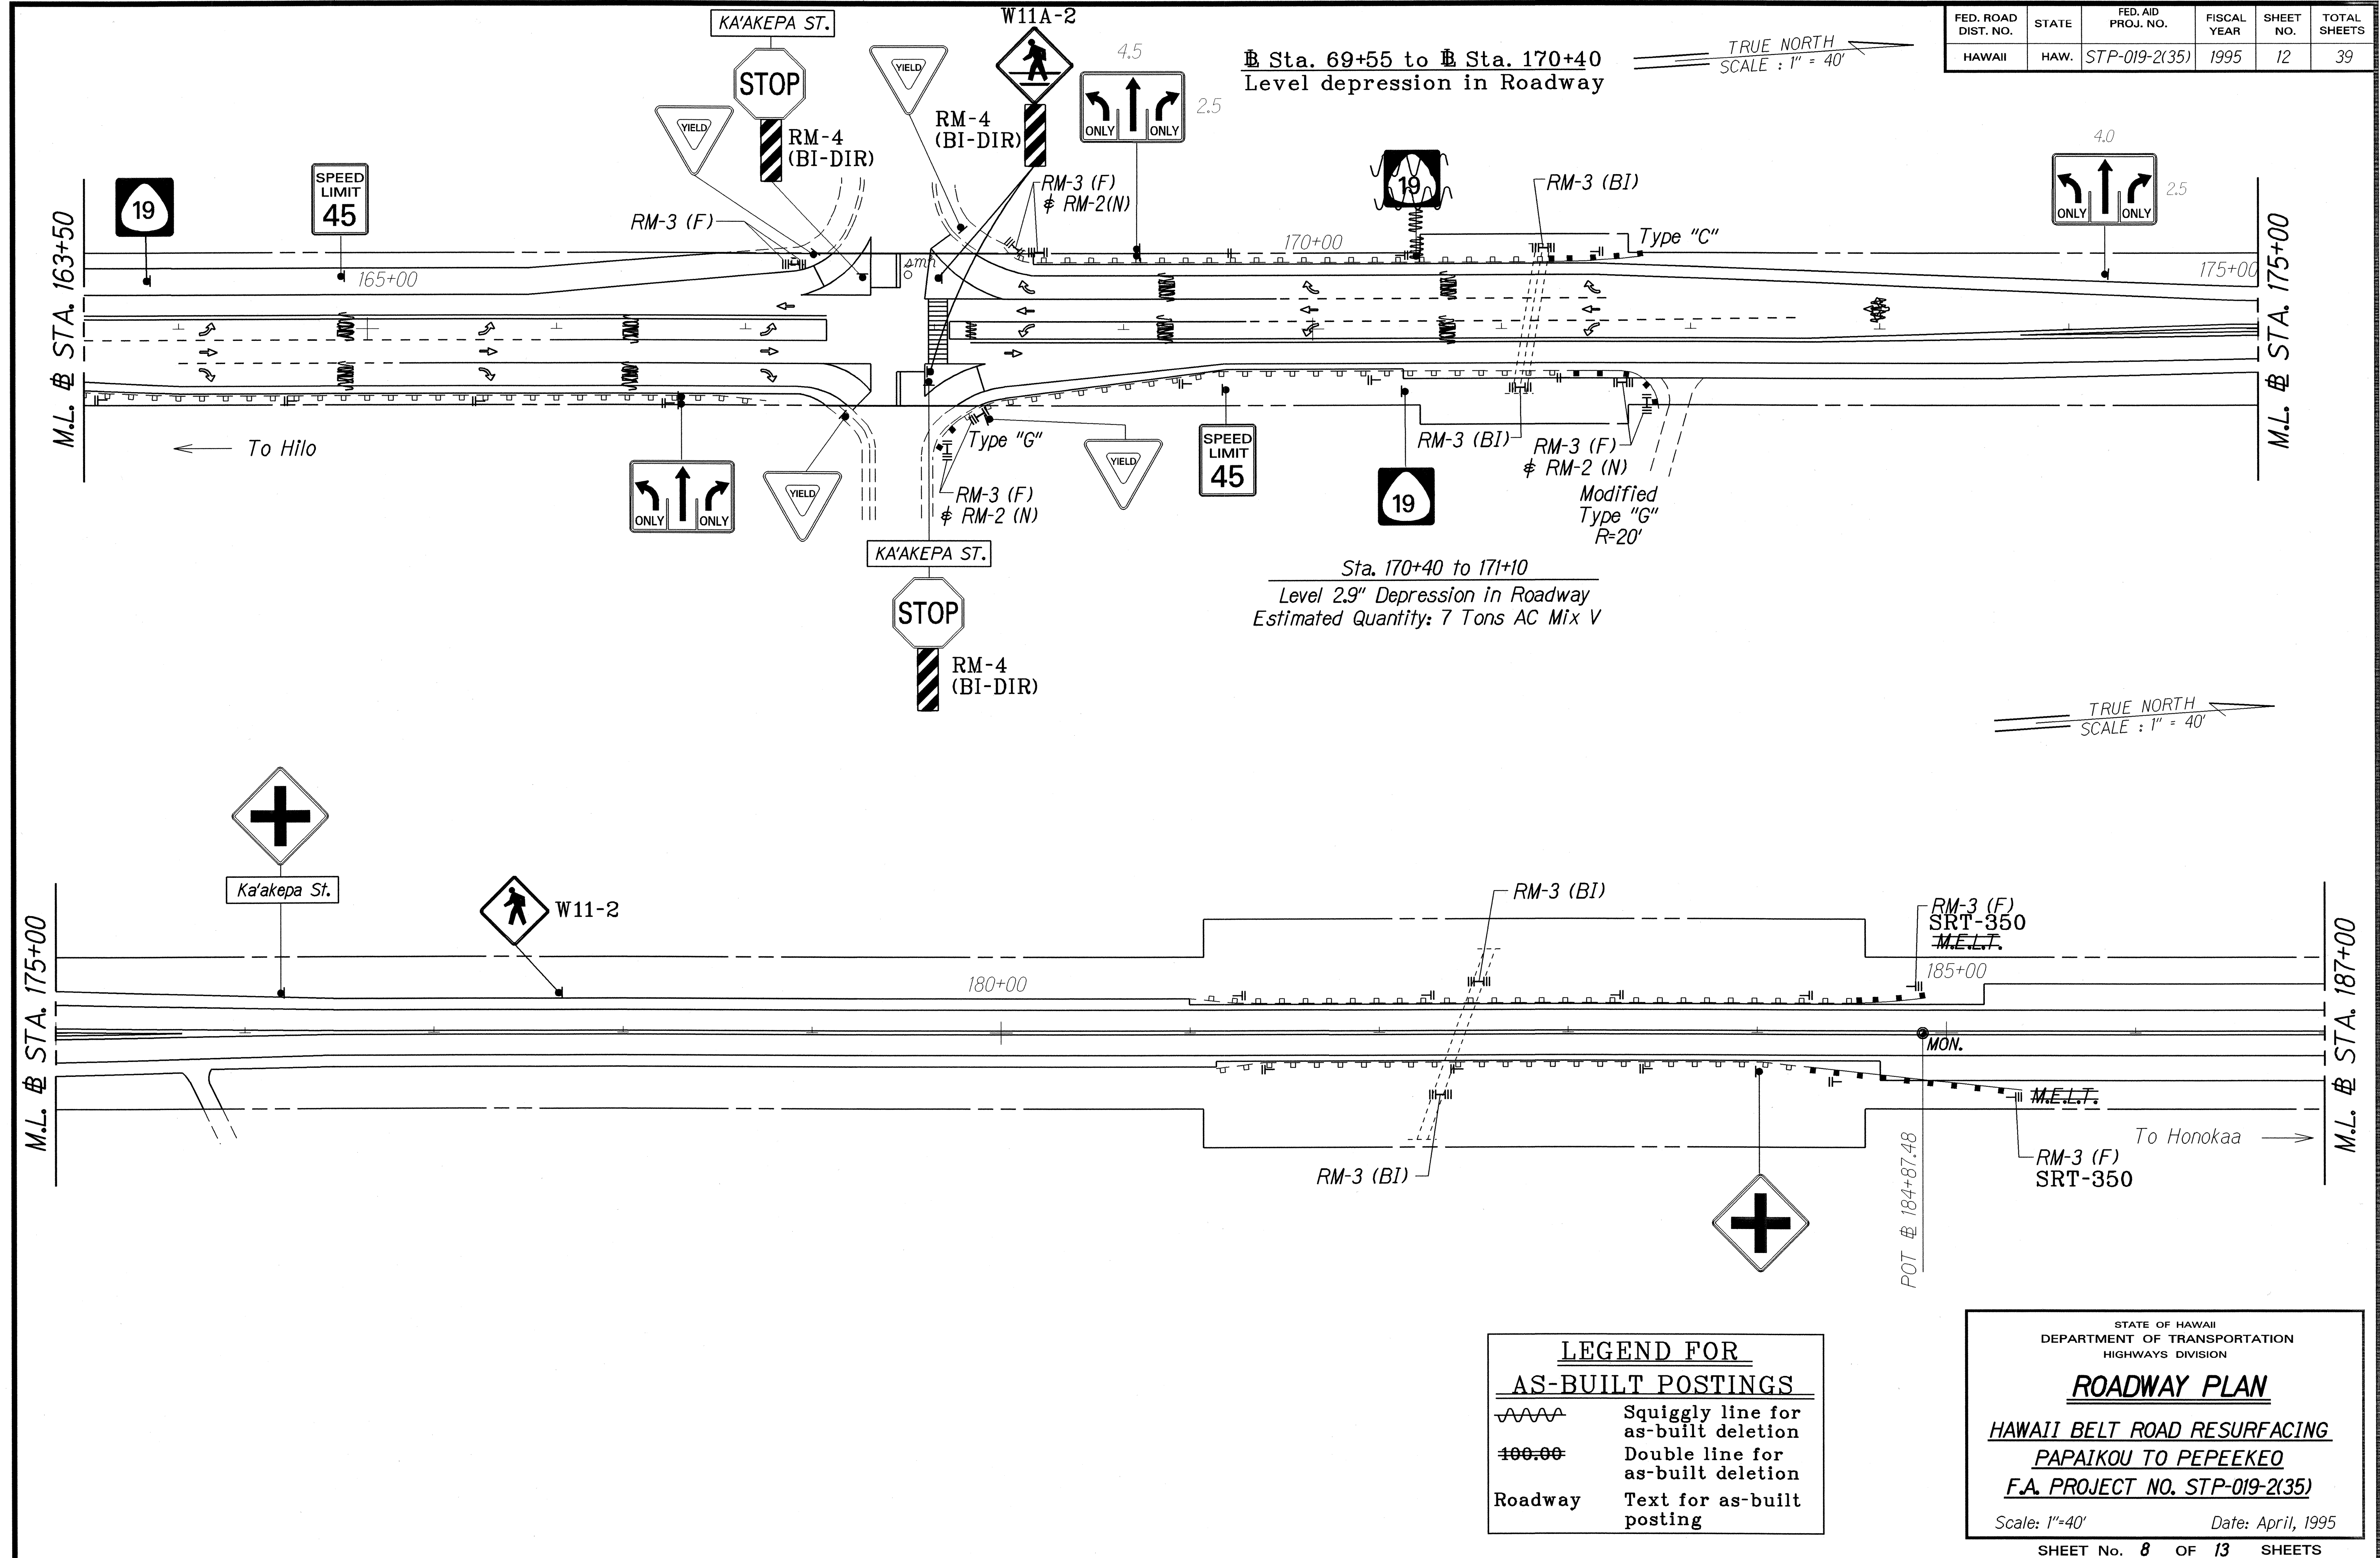

"AS-BUILT"

TRUE NORTH
SCALE : 1" = 40'

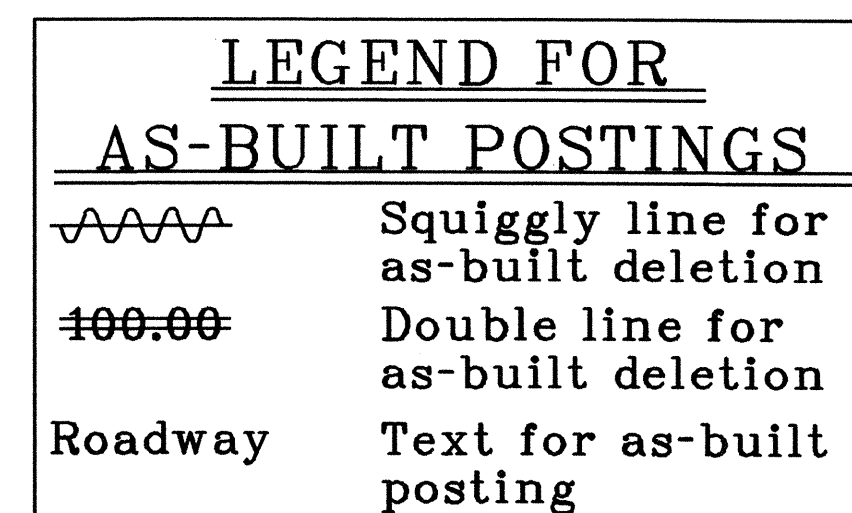

STATE OF HAWAII
DEPARTMENT OF TRANSPORTATION
HIGHWAYS DIVISION

ROADWAY PLAN

HAWAII BELT ROAD RESURFACING
PAPAIOU TO PEPEEKEO
F.A. PROJECT NO. STP-019-2(35)


Scale: 1"=40' Date: April, 1995

SHEET No. 9 OF 13 SHEETS

FED. ROAD DIST. NO.	STATE	FED. AID PROJ. NO.	FISCAL YEAR	SHEET NO.	TOTAL SHEETS
HAWAII	HAW.	STP-019-2(35)	1995	14	39


Sta. 12+20 to 13+00
Level 2.6" Depression in Roadway
Estimated Quantity: 8 Tons AC Mix V

TRUE NORTH
SCALE: 1" = 40'

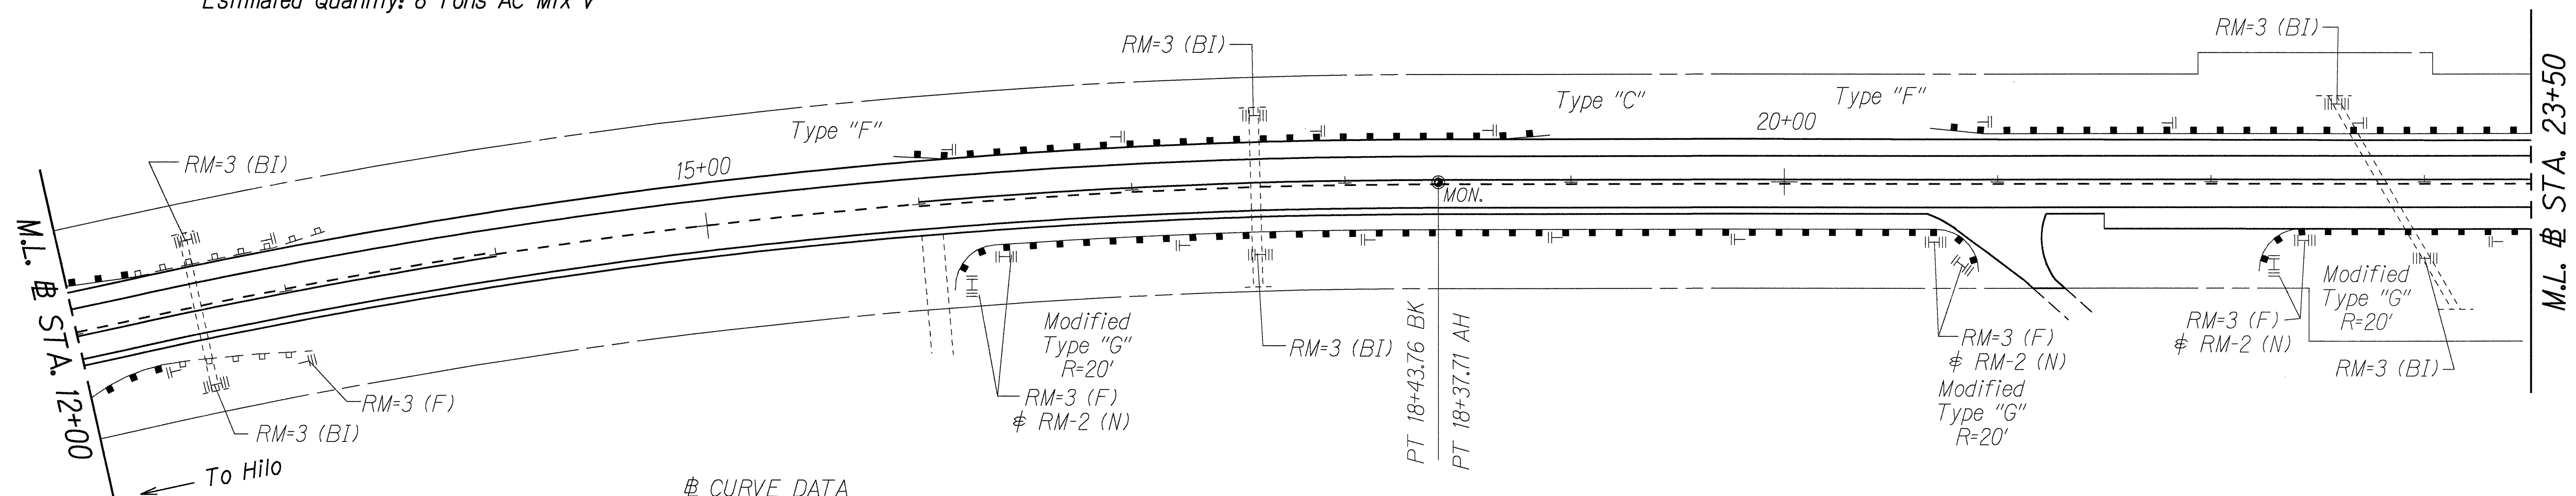

△ CURVE DATA
 $\Delta = 13^\circ 43' 00''$
 $R = 2,864.79$
 $T = 344.56$
 $C = 0$
 $L_c = 685.83$
 $S. E. = 0.05 \text{ ft/ft}$

TRUE NORTH
SCALE: 1" = 40'

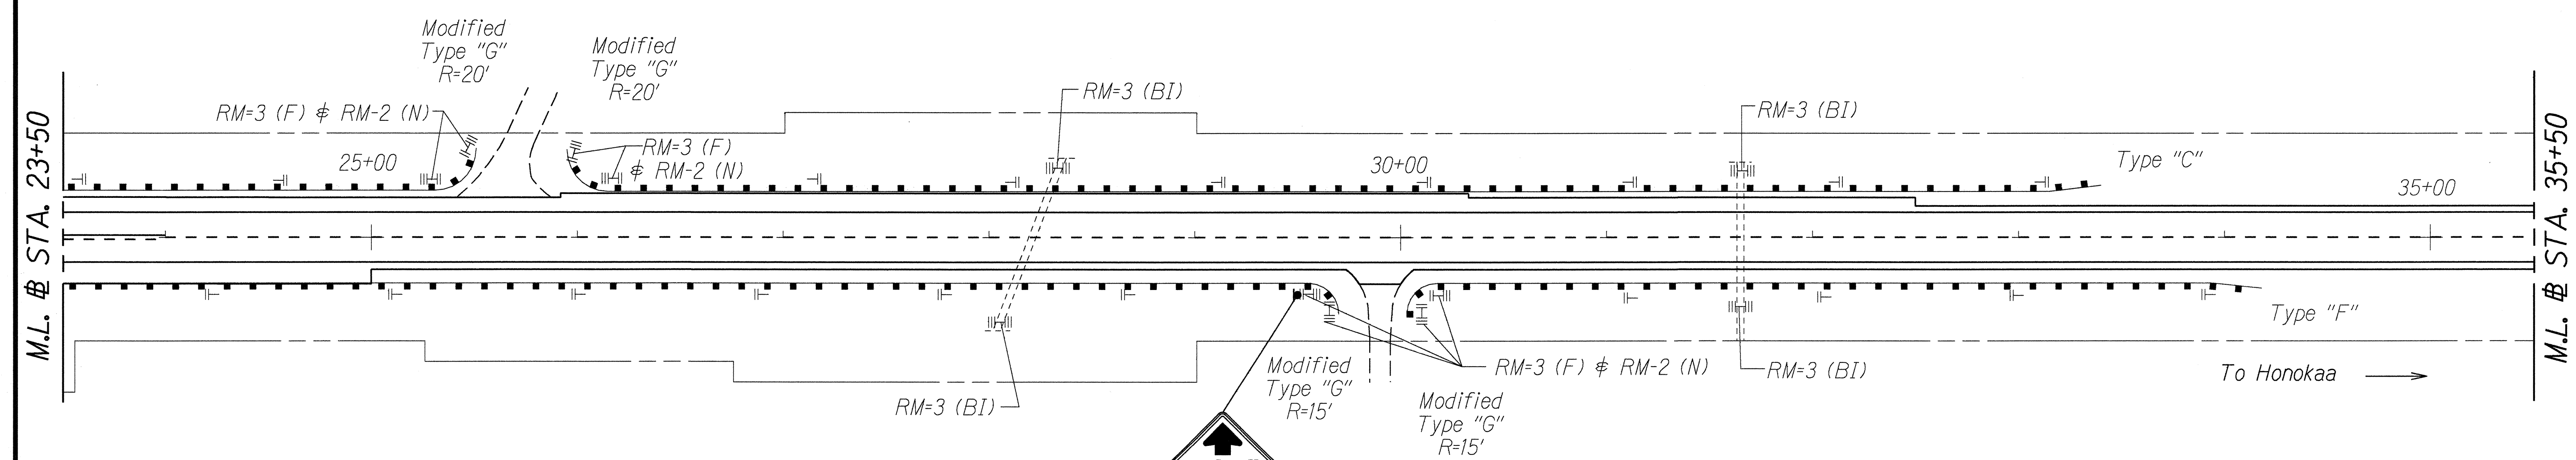

ORIGINAL PLAN	DATE	Y
DESIGNED BY		
DESIGNED BY		
QUANTITIES BY		
CHECKED BY		

STATE OF HAWAII
DEPARTMENT OF TRANSPORTATION
HIGHWAYS DIVISION

ROADWAY PLAN


HAWAII BELT ROAD RESURFACING
PAPAIKOU TO PEPEEKEO
F.A. PROJECT NO. STP-019-2(35)

Scale: 1"=40' Date: April, 1995

SHEET No. 10 OF 13 SHEETS

Station 34+82 to Station 38+40
Reconstruct approaches for Pepeekeo Truck Overpass,
Sta 36+61.60. For details, see Sheet No. 18.

FED. ROAD DIST. NO.	STATE	FED. AID PROJ. NO.	FISCAL YEAR	SHEET NO.	TOTAL SHEETS
HAWAII	HAW.	STP-019-2(35)	1995	15	39

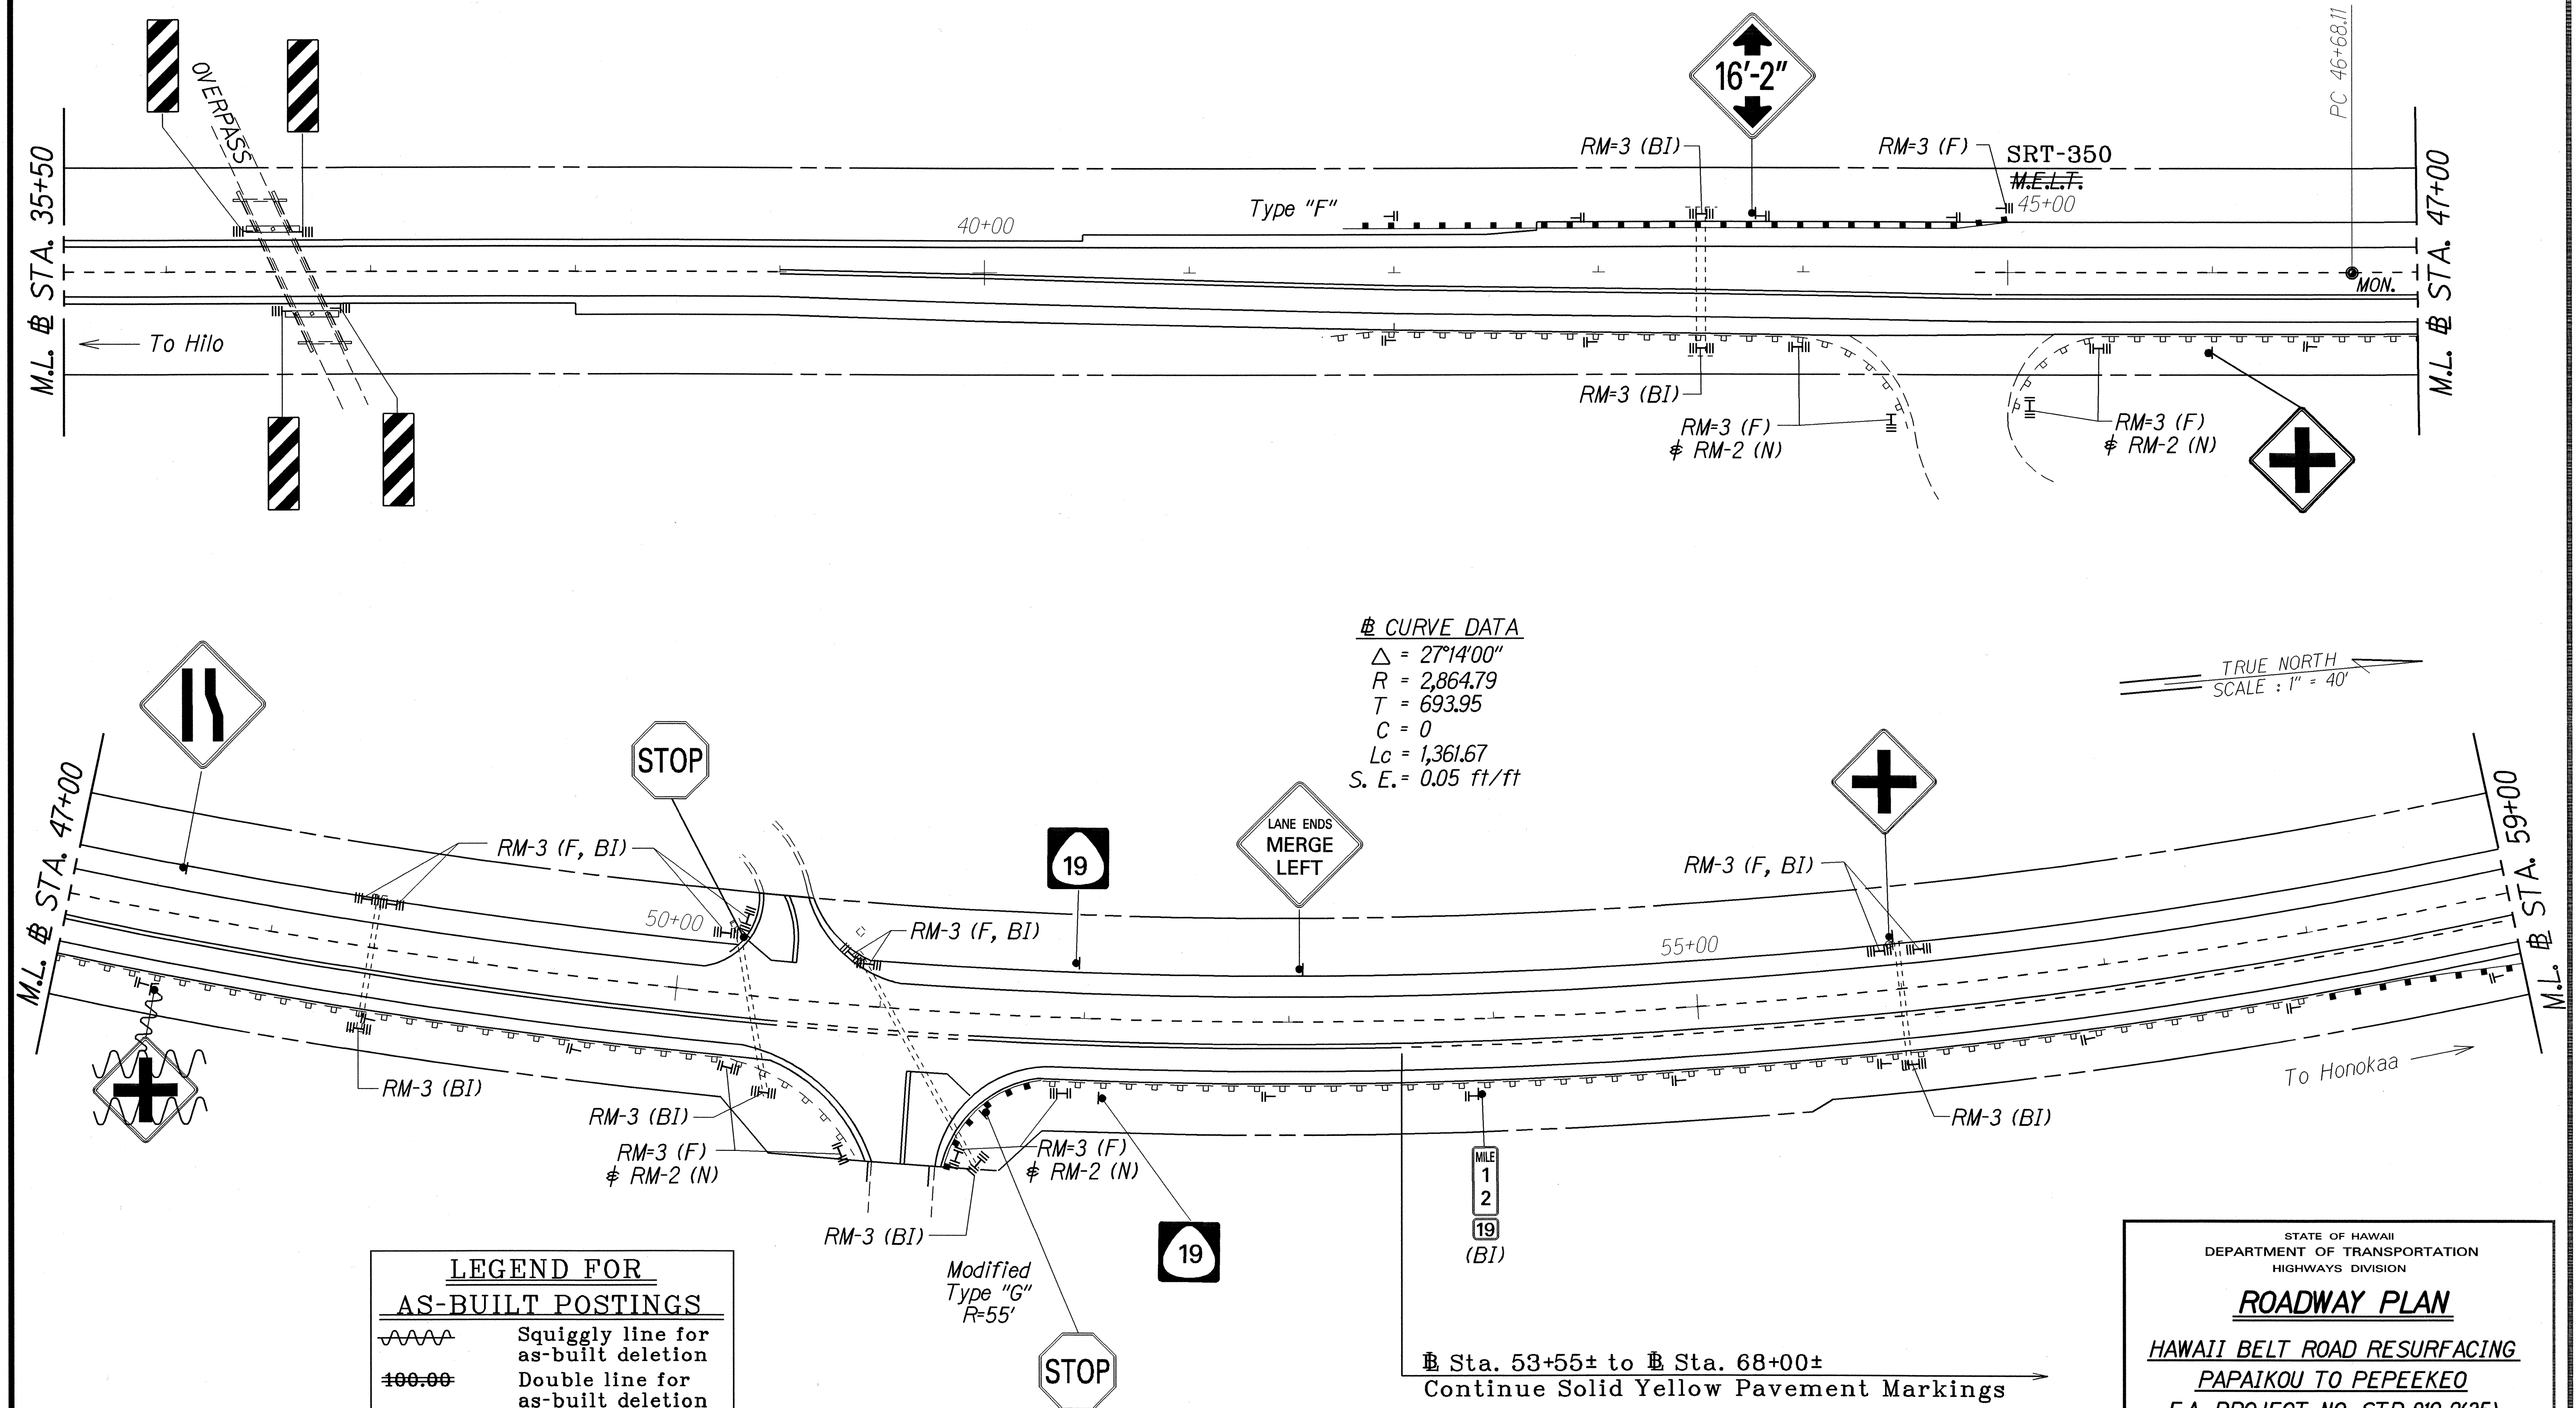

ORIGINAL PLAN	DATE
DESIGNED BY	
NOTED BY	
CHECKED BY	
DATE	

LEGEND FOR AS-BUILT POSTINGS	
	Squiggly line for as-built deletion
	Double line for as-built deletion
Roadway	Text for as-built posting

STATE OF HAWAII
DEPARTMENT OF TRANSPORTATION
HIGHWAYS DIVISION

ROADWAY PLAN



HAWAII BELT ROAD RESURFACING
PAPAIOU TO PEPEEKEO
F.A. PROJECT NO. STP-019-2(35)

Scale: 1"=40' Date: April, 1995

SHEET No. 11 OF 13 SHEETS

"AS-BUILT"

FED. ROAD DIST. NO.	STATE	FED. AID PROJ. NO.	FISCAL YEAR	SHEET NO.	TOTAL SHEETS
HAWAII	HAW.	STP-019-2(35)	1995	16	39

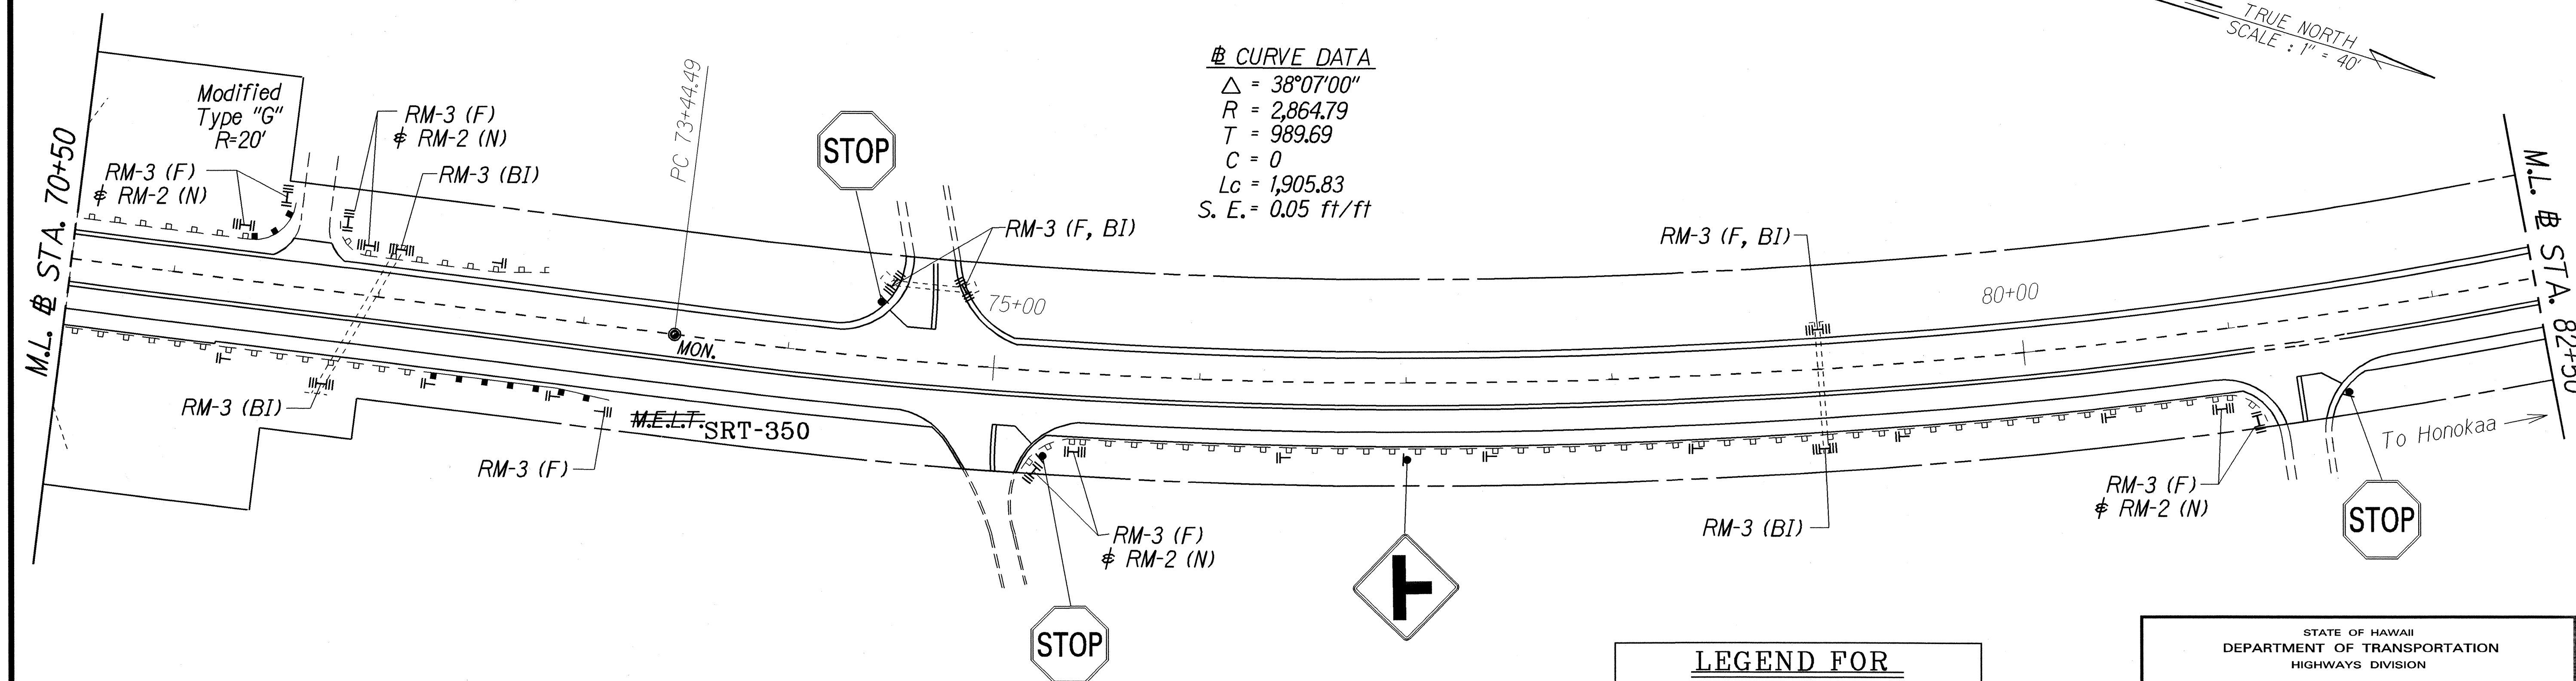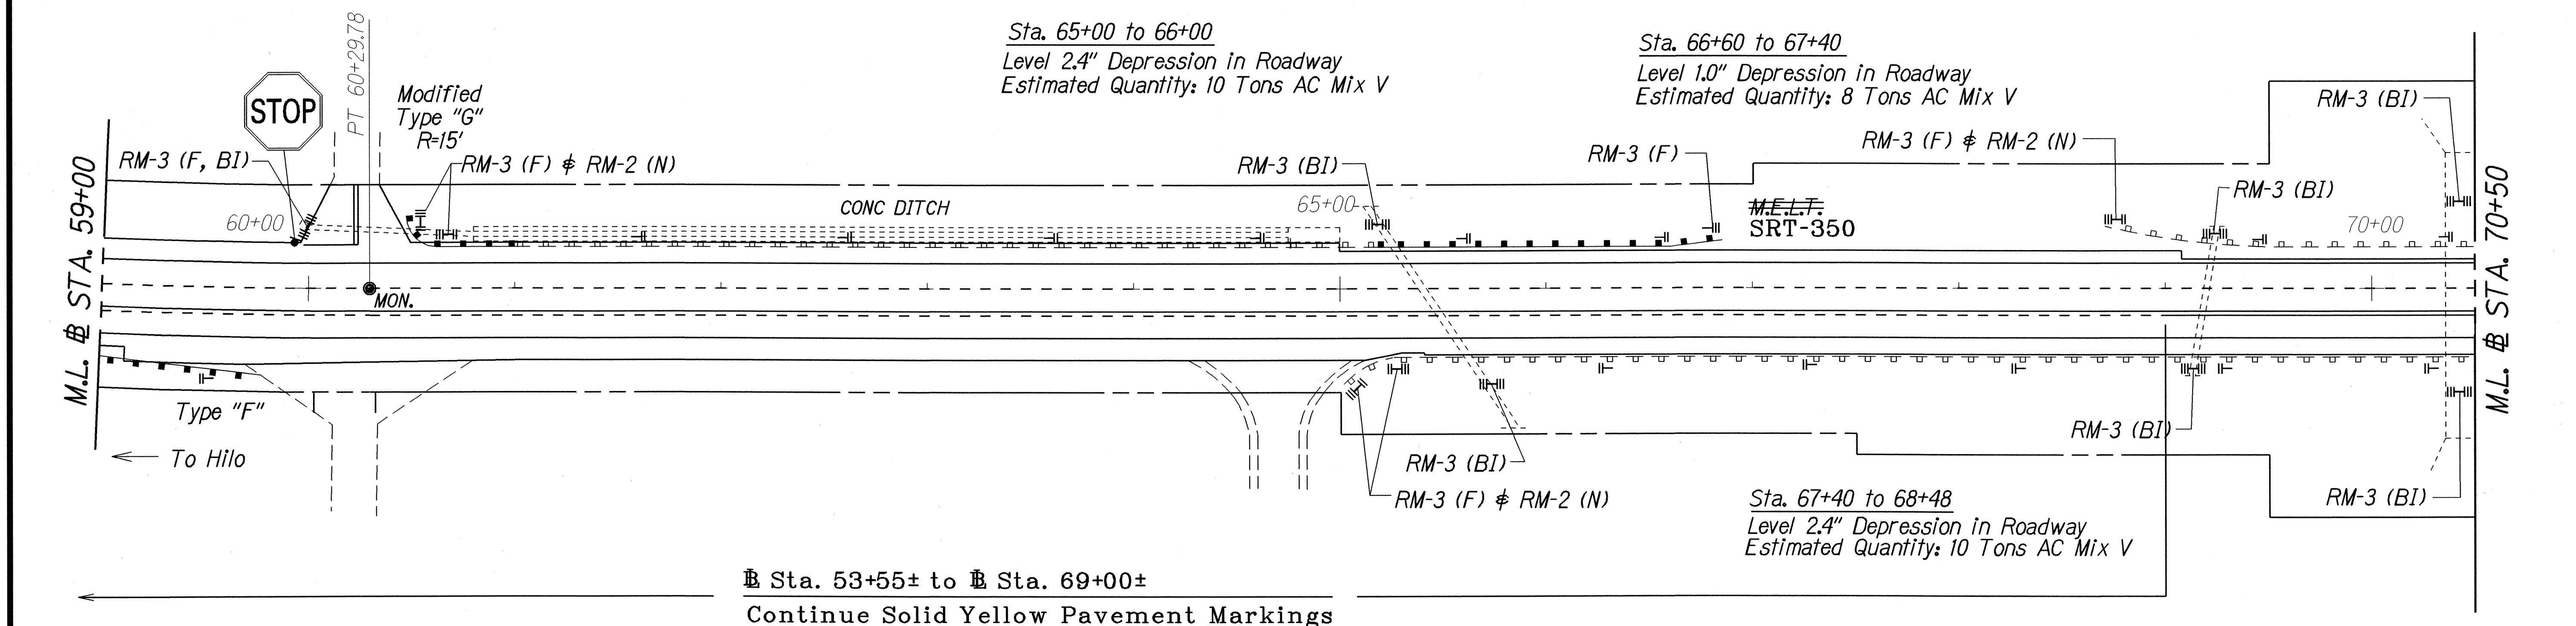

CURVE DATA
 $\Delta = 38^{\circ}07'00''$
 $R = 2,864.79$
 $T = 989.69$
 $C = 0$
 $L_c = 1,905.83$
 $S. E. = 0.05 \text{ ft/ft}$

LEGEND FOR AS-BUILT POSTINGS	
	Squiggly line for as-built deletion
	Double line for as-built deletion
Roadway	Text for as-built posting

STATE OF HAWAII
DEPARTMENT OF TRANSPORTATION
HIGHWAYS DIVISION

ROADWAY PLAN


HAWAII BELT ROAD RESURFACING
PAPAIKOU TO PEPEEKEO
F.A. PROJECT NO. STP-019-2(35)

Scale: 1"=40' Date: April, 1995

SHEET No. 12 OF 13 SHEETS

ORIGINAL PLAN	DATE
DESIGNED BY	
CHECKED BY	
NOTED BY	
DESIGNED BY	
CHECKED BY	
NOTED BY	
DESIGNED BY	
CHECKED BY	
NOTED BY	

FED. ROAD DIST. NO.	STATE	FED. AID PROJ. NO.	FISCAL YEAR	SHEET NO.	TOTAL SHEETS
HAWAII	HAW.	STP-019-2(35)	1995	17	39

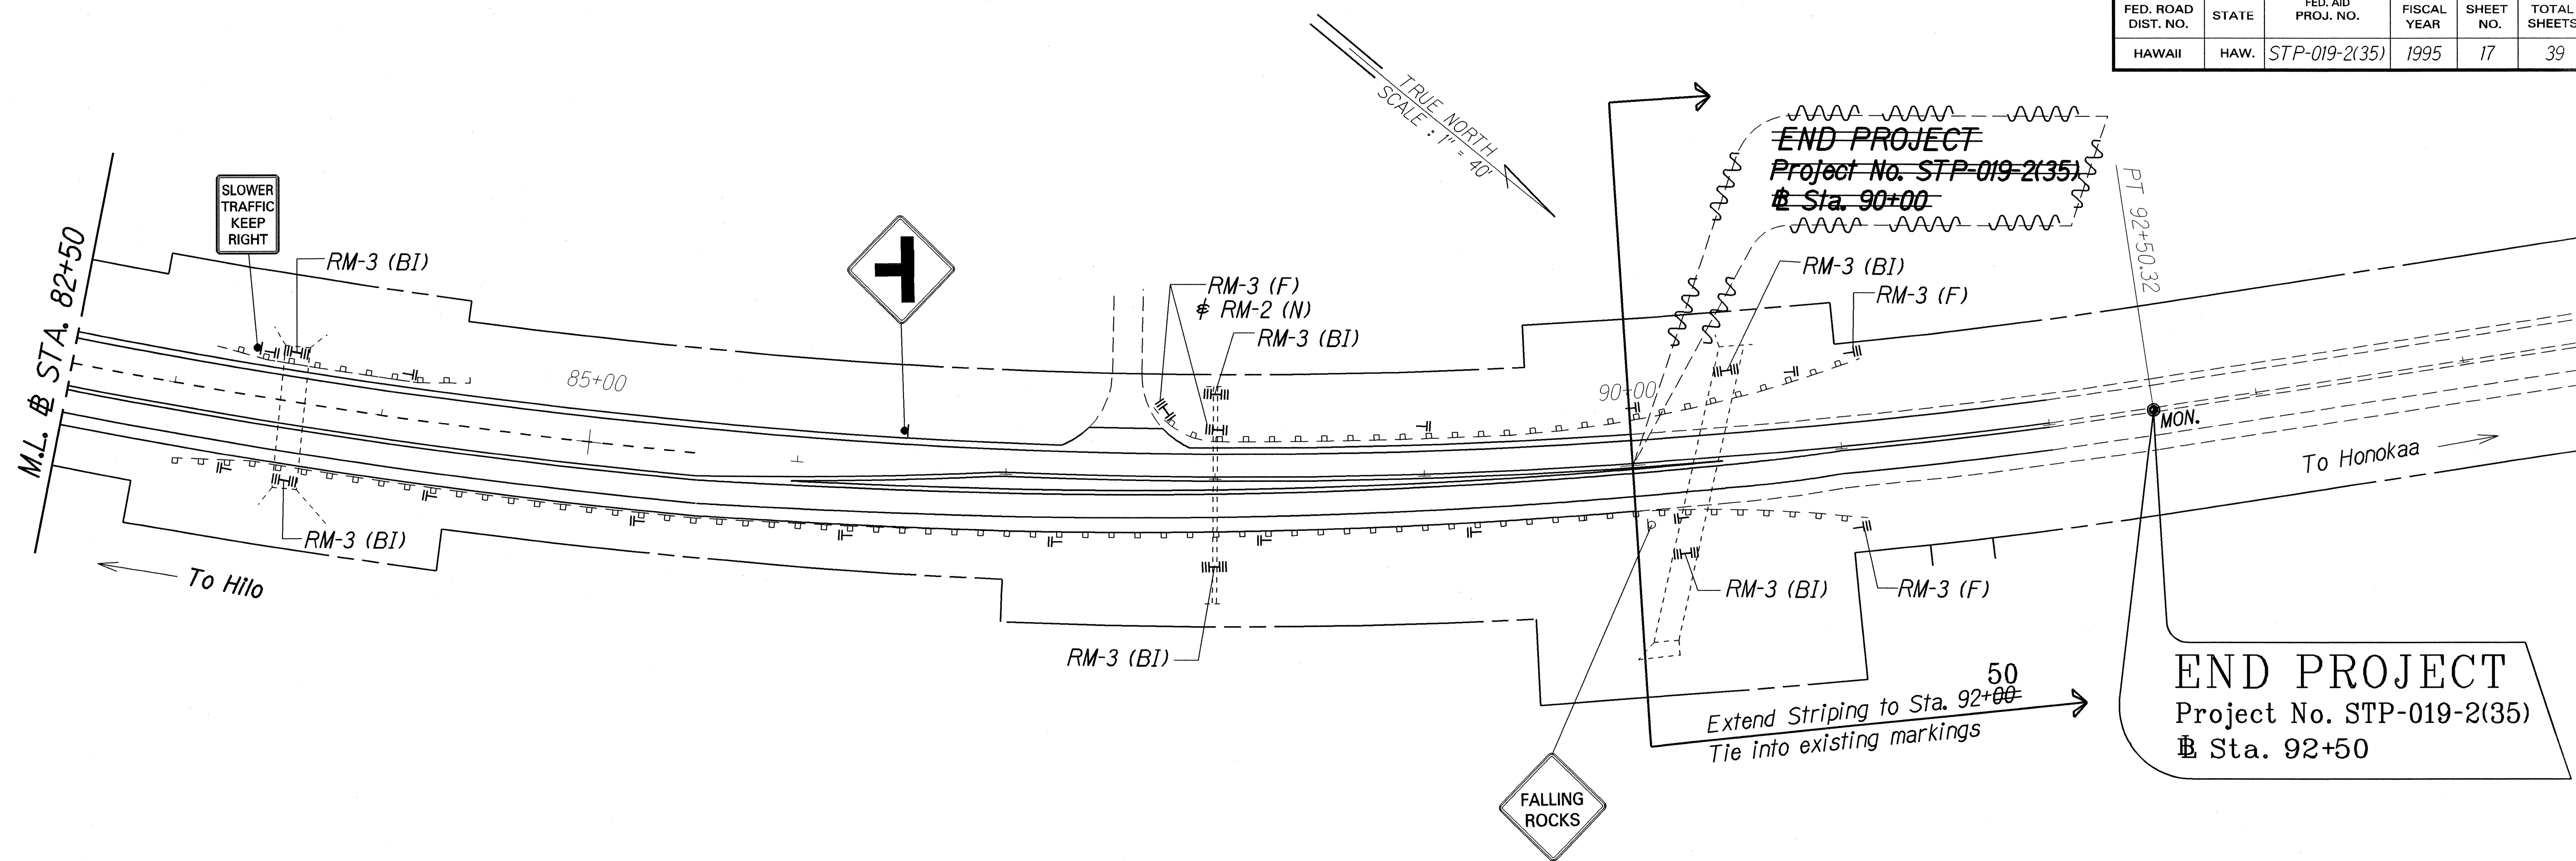

LEGEND FOR AS-BUILT POSTINGS	
	Squiggly line for as-built deletion
	Double line for as-built deletion
Roadway	Text for as-built posting

STATE OF HAWAII
DEPARTMENT OF TRANSPORTATION
HIGHWAYS DIVISION

ROADWAY PLAN

HAWAII BELT ROAD RESURFACING
PAPAIOU TO PEPEEKEO
F.A. PROJECT NO. STP-019-2(35)

Scale: 1"=40' Date: April, 1995

SHEET No. 13 OF 13 SHEETS

"AS-BUILT"

ORIGINAL PLAN	SURVEY PLOTTED BY	DATE
NOTE BOOK	DRAWN BY	
delivered	DESIGNED BY	
STP-019-2(35)	CHECKED BY	