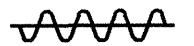
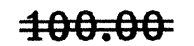


FED. ROAD DIST. NO.	STATE	FED. AID PROJ. NO.	FISCAL YEAR	SHEET NO.	TOTAL SHEETS
HAWAII	HAW.	STP-019-2(35)	1995	36	39

SIGN SCHEDULES										
STATION	LEFT	RIGHT	TYPE	SIGN TO REMAIN	REMOVE	INSTALL (10 SQ. FT. OR LESS)		INSTALL (GREATER THAN 10 SQ. FT.)		DESTINATION SIGN PANEL (S.F.)
						W/POST	WO/POST	W/POST	WO/POST	
FA-F14B(1)										
8+27	●		W12-2 (15'x8")		1	1				
9+02	●		SI-1		1	1				
10+25		●	W2-1			1				
10+25		●	S (Ka'ie'ie Road)				1			
10+61	●		D-1 (Kalaoa, Papaikou & Onomea Bay) (7'x8')		1					56.0
11+40	●		D-2 (Scenic Route) (1.5'x7')		1					10.5 10.0
12+13	●		W2-1 *		1		1			
12+92	●		R2-1 (45) (36"x48")		1			1		
14+77	●		D-3 (Kaieie Hmstd Road)		1		1			
14+77	●		RI-1		1	1				
14+99		●	RI-1		1	1				
19+30	●		W2-1			1				
19+30	●		S (Ka'ie'ie Road)				1			
29+24		●	W2-1		1	1				
29+24		●	S (Kalaoa Camp Road)				1			
33+25	●		RI-1		1	1				
33+25	●		D (Kalaoa Camp Road)				1			
33+61		●	RI-1		1	1				
34+63		●	R2-1 (55) (36"x48")		1			1		
34+51	●		R2-1 (45) (36"x48")		1			1		
37+39	●		W2-1		1	1				
37+39	●		S (Kalaoa Camp Road)				1			
39+65	●		R2-5B (45) (36"x48")		1			1		
42+38		●	R2-4 (40) (36"x48")		1			1		
52+06		●	RI-1		1	1				
60+45		●	R1-1			1				
69+74		●	R4-3		1					
72+50		●	R4-3			1				
74+00		●	R4-2			1				
75+59		●	RI-1		1	1				
84+16		●	RI-1		1	1				
92+25	●		R4-1		1					
92+50		●	W9-1 (R)		1	1				

STATION	LEFT	RIGHT	TYPE	SIGN TO REMAIN	REMOVE	INSTALL (10 SQ. FT. OR LESS)		INSTALL (GREATER THAN 10 SQ. FT.)		DESTINATION SIGN PANEL (S.F.)
						W/POST	WO/POST	W/POST	WO/POST	
92+94		●	"Adopt-a-Highway"	1						
92+94	●		"Adopt-a-Highway"	1						
93+69		●	RI-1		1	1				
95+35		●	W4-2(R)		1	1				
104+06		●	W2-1		1	1				
108+47	●		RI-1		1	1				
108+82		●	RI-1		1	1				
114+00	●		W2-1			1				
117+66	●		W2-1		1					
134+00	136+74	●	R2-5b (45) (36"x48)		1			1		
141+86	140+70	●	R2-1 (55) (36"x48)		1			1		
141+48	140+70	●	R2-1 (45) (36"x48)		1			1		
145+53		●	W11-2		1					
148+00		●	W11-2			1				
149+39		●	D-4 (Honokaa, Pepeekeo & Onomea Bay (18'x7"))		1					70.0 63.0
150+00		●	W2-1/5 (Kula'imano Rd.)			1	1			
150+60		●	Heritage Drive	1						
153+15		●	W11-2-A		1					
153+50	●		W11-2-A			1				
153+50		●	W11-2-A			1				
153+63	●		D-3 (Hawaii Belt Road)		1					
153+63	●		D-3 (Kulaimano Road)		1		1			
153+63	●		RI-1		1	1				
154+01		●	D-3 (Kulaimano Road)		1		1			
154+01		●	RI-1		1	1				
154+20		●	W11-2-A		1					
155+49	●		D-5 (Scenic Route, 4 Miles) (6'x3')		1					18.0
157+00	●		↔ Heritage Drive	1						
157+60	●		W2-1/5 (Kula'imano Rd.)			1	1			
159+00	●		W11-2			1				
159+50		●	W11-2			1				

* On Pole with Flashing Light

LEGEND FOR AS-BUILT POSTINGS	
	Squiggly line for as-built deletion
	Double line for as-built deletion
Roadway	Text for as-built posting

STATE OF HAWAII DEPARTMENT OF TRANSPORTATION HIGHWAYS DIVISION	
SIGN SCHEDULE	
HAWAII BELT ROAD RESURFACING PAPAIKOU TO PEPEKEO F.A. PROJECT NO. STP-019-2(35)	
Scale: None	Date: April, 1995
SHEET No. 1 OF 2 SHEETS	

"AS-BUILT"



SURVEY PLOTTED BY	DATE
DESIGNED BY	
NOTED BY	
CHECKED BY	
ORIGINAL PLAN	
NOTE BOOK	
add/erase	
no. erase	

FED. ROAD DIST. NO.	STATE	FED. AID PROJ. NO.	FISCAL YEAR	SHEET NO.	TOTAL SHEETS
HAWAII	HAW.	STP-019-2(35)	1995	37	39

SIGN SCHEDULES

STATION	LEFT	RIGHT	TYPE	SIGN TO REMAIN	REMOVE	INSTALL (10 SQ. FT. OR LESS)		INSTALL (GREATER THAN 10 SQ. FT.)		DESTINATION SIGN PANEL (S.F.)
						W/POST	WO/POST	W/POST	WO/POST	
159+08		●	W2-1		1					
160+69	●		D-6 (Hilo, Pepeekeo & Onomea Bay (4'x7')		1					70.0 49.0
161+00		●	W2-1			1				
161+00		●	S (Ka'akepa Street)				1			
161+55	●		W11-2		1					
162+69		●	R (Directional) (4'x2.5')		1			1		
164+86	●		R2-1 (45) (36"x48")		1			1		
166+66		●	R (Directional) (4'x2.5')		1			1		
167+36	●		RI-2		1	1				
167+44		●	RI-2		1	1				
167+62	●		RI-1		1	1				
167+62	●		D (Ka'akepa Street)				1			
167+97		●	RI-1		1	1				
167+97		●	D (Ka'akepa Street)				1			
168+00	●	●	W11A-2				2			
168+14	●		RI-2			1				
168+16	●		RI-2		1					
168+30	●		RI-2			1				
168+37	●		RI-2		1					
169+07	●		R (Directional) (4'x2.5')		1			1		
169+54		●	R2-1 (45) (36"x48")		1			1		
174+19	●		R (Directional) (4'x2.5')		1			1		
176+19	●		W2-1		1	1				
177+70	●		W11-2			1				
176+19	●		S (Ka'akepa Street)				1			
184+01		●	W2-1		1	1				
187+90	●		RI-1		1	1				
188+39		●	RI-1		1	1				
191+00	192+00	●	W2-1			1				
	193+05	●	W2-1		1					
192+28	194+87	●	R2-1 (55) (36"x48")		1			1		
SDR 3 (2)										
192+15	194+87	●	R2-1 (45) (36"x48")		1			1		
	197+60	●	R2-5b (45) (36"x48")		1			1		
	1+05	●	"ADOPT-A-HIGHWAY"	1						

STATION	LEFT	RIGHT	TYPE	SIGN TO REMAIN	REMOVE	INSTALL (10 SQ. FT. OR LESS)		INSTALL (GREATER THAN 10 SQ. FT.)		DESTINATION SIGN PANEL (S.F.)
						W/POST	WO/POST	W/POST	WO/POST	
1+05		●	"ADOPT-A-HIGHWAY"	1						
9+46	●		RI-1			1				
29+50		●	W12-2 (16'-0")			1				
30+33		●	W12-2 (16'-0")		1					
42+28	●		W12-2 (16'-2")		1					
43+75	●		W12-2 (16'-2")			1				
46+00		●	W2-1			1				
47+49		●	W2-1		1					
47+52	●		W4-2(R)		1	1				
50+27	●		RI-1		1	1				
51+54		●	RI-1			1				
53+05	●		W9-2(L)		1	1				
53+93	●		W2-1		1					
56+00	●		W2-1			1				
60+10	●		RI-1		1	1				
60+96		●	RI-1		1					
74+51	●		RI-1		1	1				
75+22		●	RI-1		1	1				
76+04		●	W2-2		1					
77+00		●	W2-2			1				
81+56		●	RI-1		1	1				
83+36	●		R4-3		1	1				
86+50	●		W2-2			1				
87+35	●		RI-1		1					
89+13	●		W2-2		1					
90+07		●	W15-3		1	1				
TOTALS				6 4	82	64 57	64 13	17	---	196.5 225

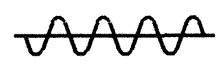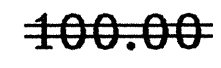LEGEND FOR AS-BUILT POSTINGS	
	Squiggly line for as-built deletion
	Double line for as-built deletion
Roadway	Text for as-built posting

STATE OF HAWAII DEPARTMENT OF TRANSPORTATION HIGHWAYS DIVISION
SIGN SCHEDULE
HAWAII BELT ROAD RESURFACING PAPAIOU TO PEPEEKEO F.A. PROJECT NO. STP-019-2(35)
Scale: None Date: April, 1995
SHEET No. 2 OF 2 SHEETS

"AS-BUILT"