
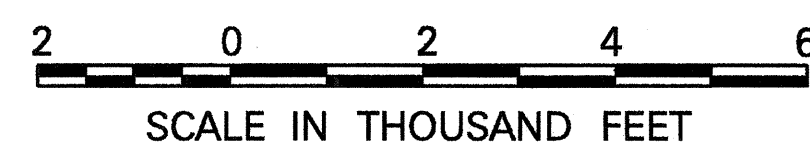


INDEX TO DRAWINGS	
SHEET NO.	DESCRIPTION
1	TITLE SHEET
2	STANDARD PLANS SUMMARY
3	GENERAL NOTES
4	TYPICAL SECTION AND DETAILS
5 - 17	ROADWAY PLANS
18	PAVEMENT RECONSTRUCTION DETAILS
19	BRIDGE RECONSTRUCTION DETAILS
20	GUARDRAIL REFLECTOR MARKER DETAIL
21	END POST CONNECTION DETAIL TYPE I
22	END POST CONNECTION DETAIL TYPE II
23	END POST CONNECTION SPECIAL DETAILS AND NOTES
24-26	"MELT" DETAILS
27	PAVEMENT MARKING LEGEND AND NOTES
28	PAVEMENT MARKING DETAILS
29	SIGN DETAILS AND NOTES
30	RECONSTRUCTION AREA SCHEDULE
31	RECONSTRUCTION AREA AND REFLECTOR MARKER SCHEDULES
32-34	GUARDRAIL SCHEDULES
35	MISCELLANEOUS SCHEDULES
36-37	SIGN SCHEDULES
38	CONSTRUCTION SIGN PLAN AND SCHEDULE
39	NPDES GENERAL NOTES

① SHEET NO. 30S-1 IS A SUPPLEMENTARY SHEET TO THIS PROJECT. TOTAL SHEET COUNT AFTER AS-BUILT POSTING 40 SHTS.

HAWAII DISTRICT DESIGNED BY
A. NISHIMURA
P.S. & E. BY
587-2244
PHONE
APRIL, 1995
DATE

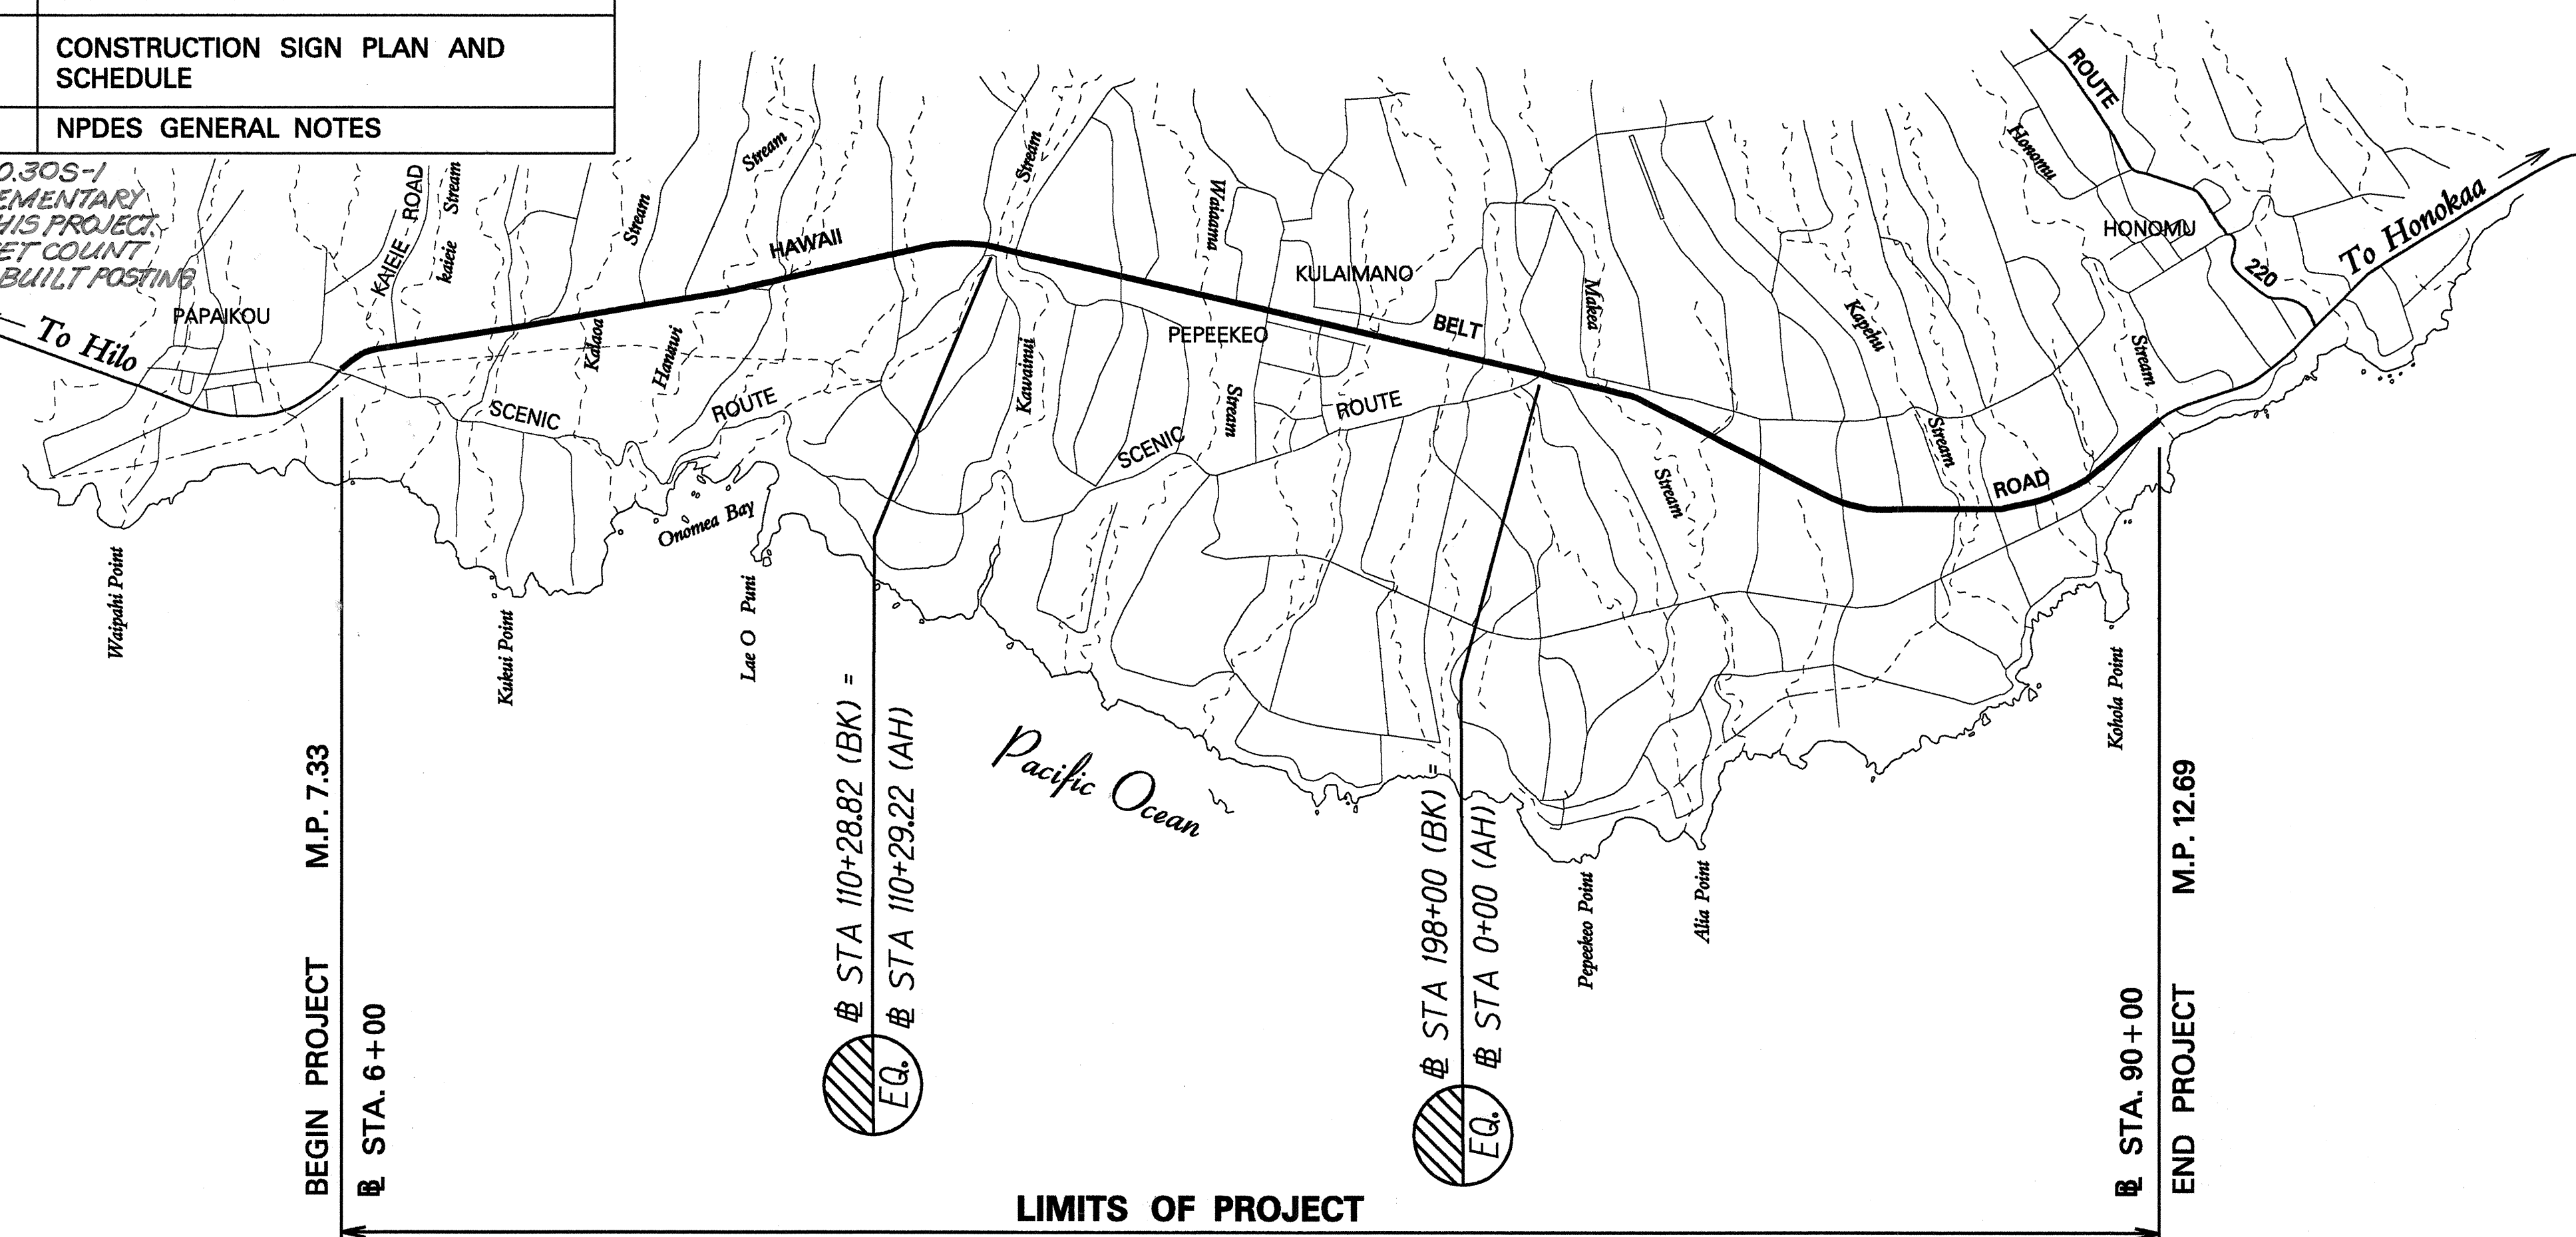



GROSS LENGTH OF PROJECT..... 5.34 MILES
NET LENGTH OF PROJECT..... 5.05 MILES

STATE OF HAWAII

DEPARTMENT OF TRANSPORTATION HIGHWAYS DIVISION HONOLULU, HAWAII "AS-BUILT" PLANS FOR HAWAII BELT ROAD RESURFACING PAPA KOU TO PEPEEKEO F. A. PROJECT NO. STP-019-2(35)

DISTRICT OF SOUTH HILO
ISLAND OF HAWAII

FED. ROAD DIST. NO.	STATE	FED. AID PROJ. NO.	FISCAL YEAR	SHEET NO.	TOTAL SHEETS
HAWAII	HAW.	STP-019-2(35)	1995	1	39

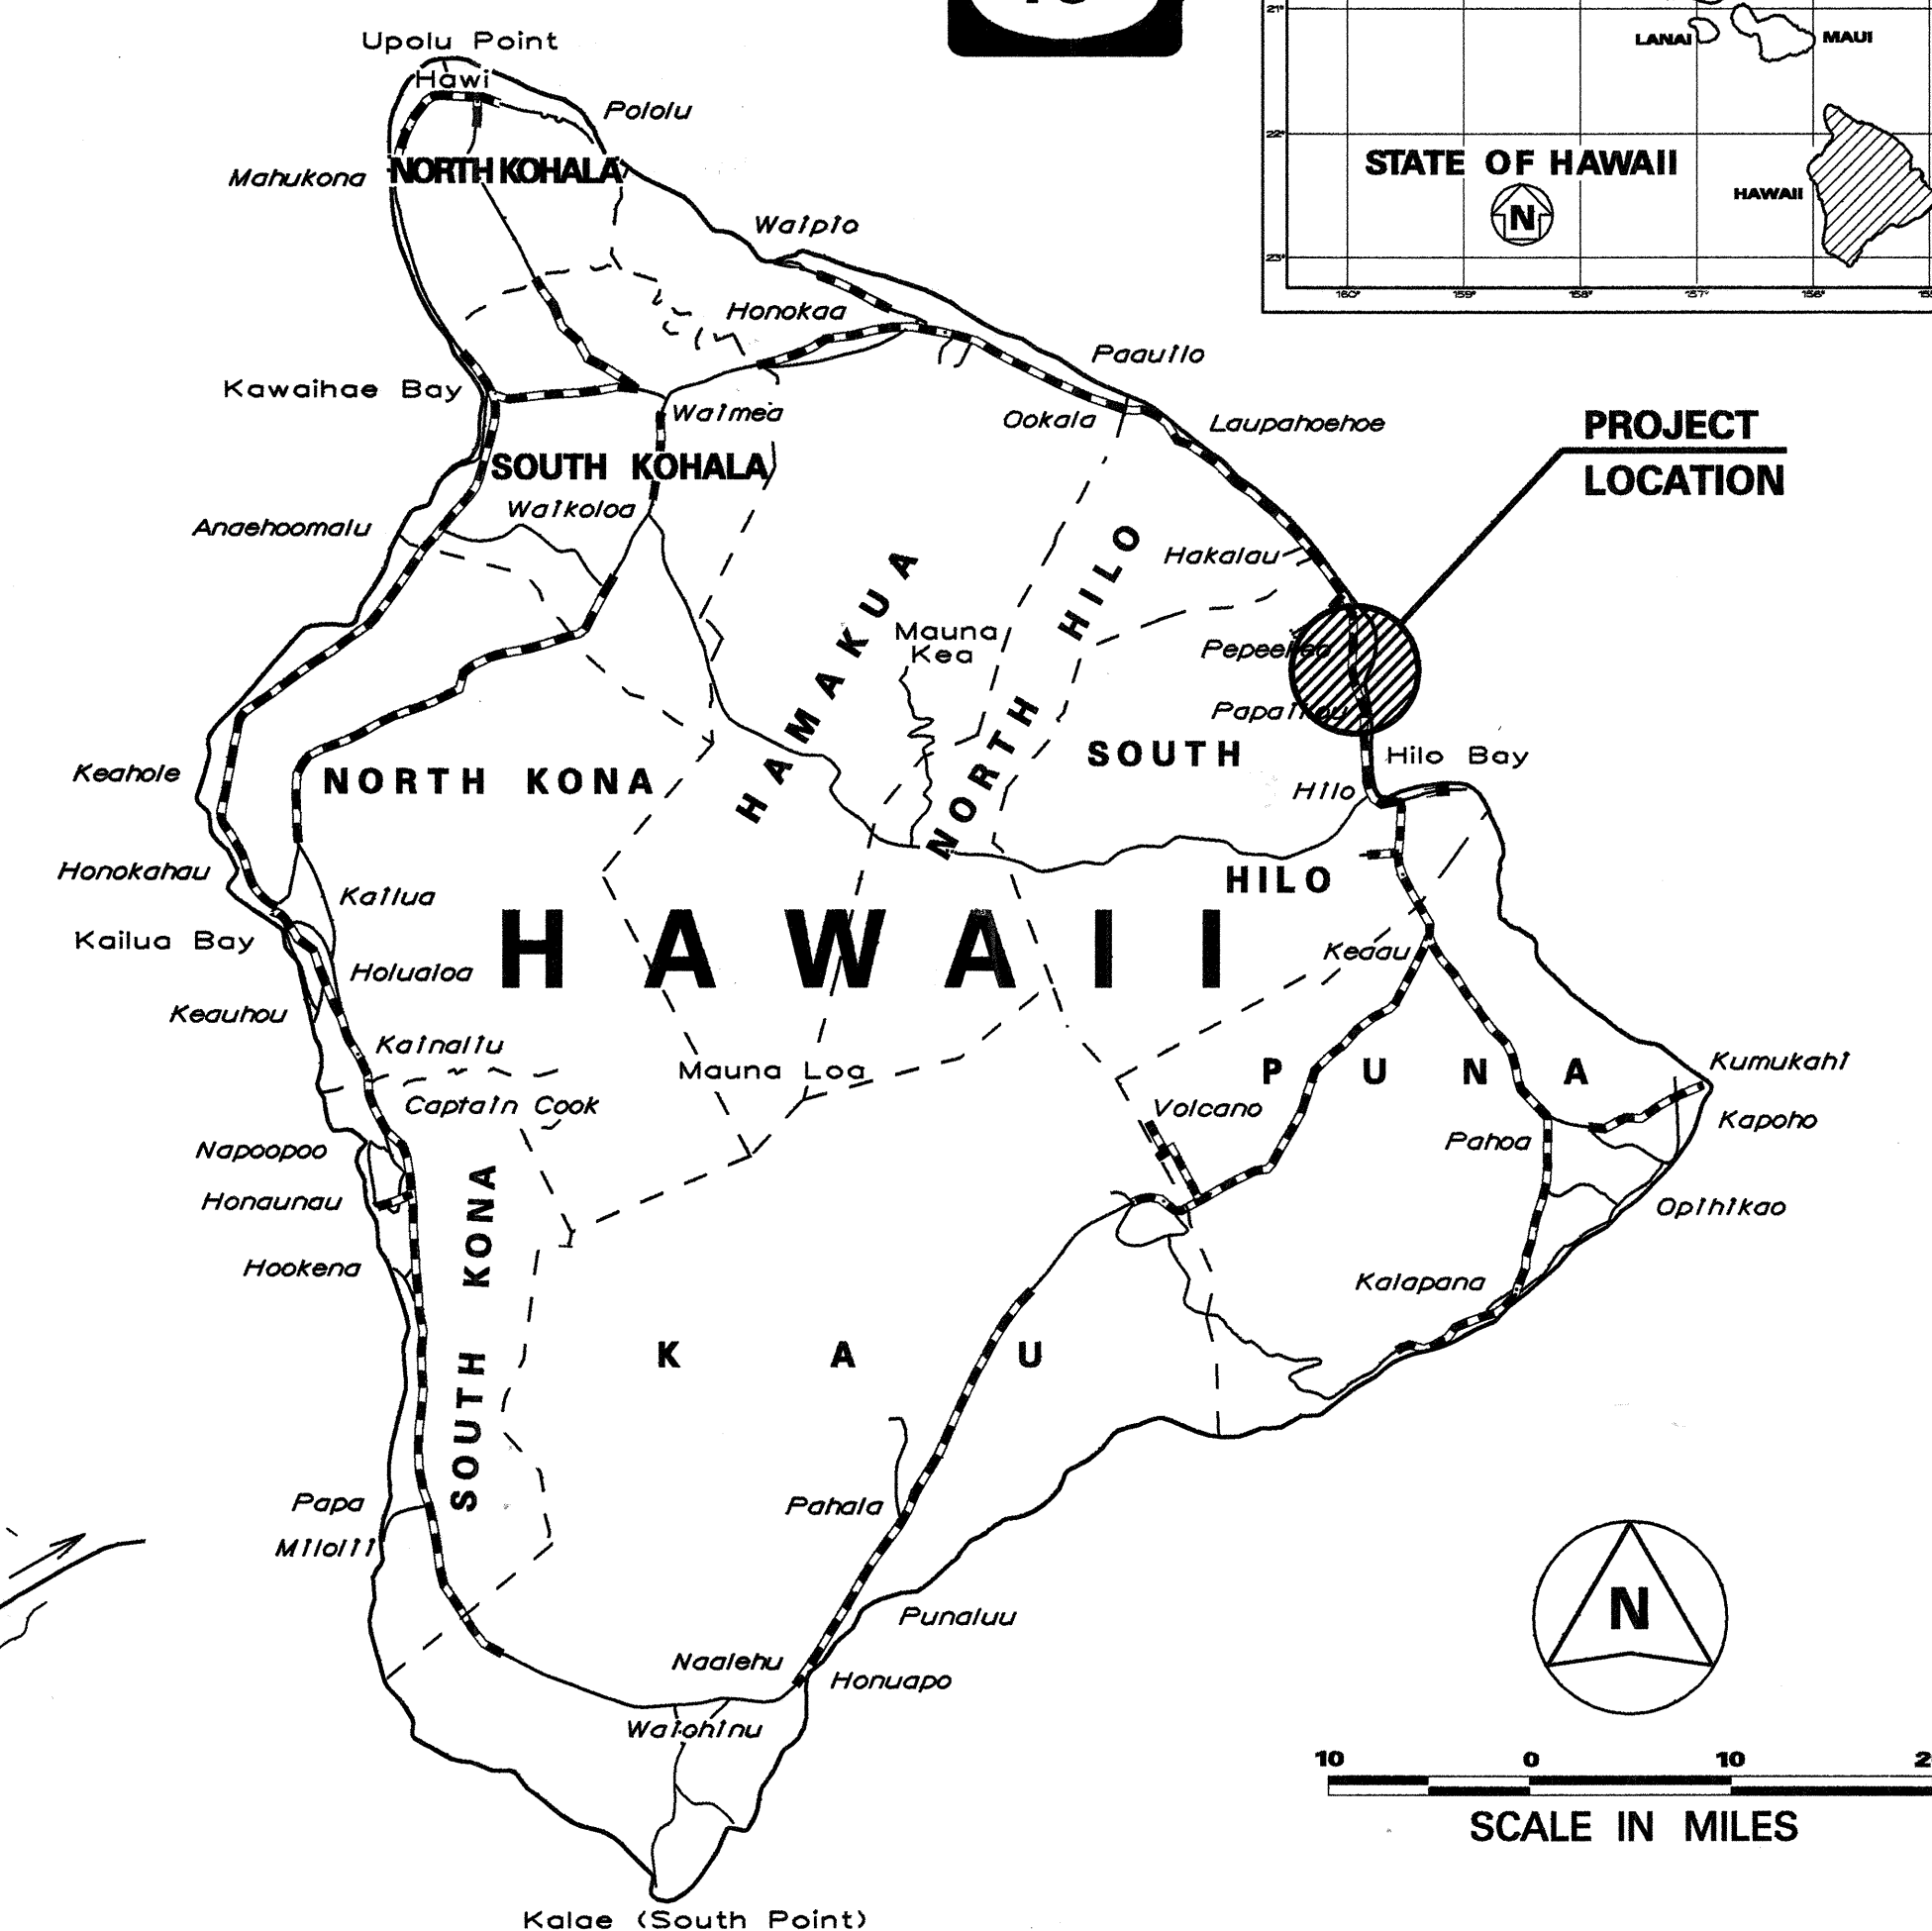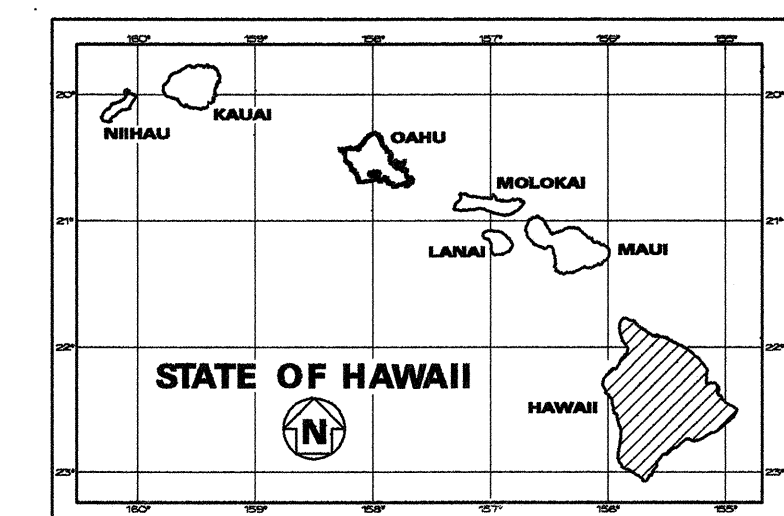

— FEDERAL AID PROJECTS PREVIOUSLY CONSTRUCTED OR UNDER CONSTRUCTION

MILE POST 7.33 TO MILE POST 12.69

DESIGN DESIGNATION

ADT (1995)..... 10,100
ADT (2005)..... 12,100
DHV 980
D 55/45
T 4.9 %
V 60/50 M.P.H.

CHANGES MADE DURING CONSTRUCTION HAVE BEEN INCORPORATED ON THESE PLANS EXCEPT CHANGES IN THE ORIGINAL THEORETICAL QUANTITIES. FOR ACTUAL QUANTITIES, REFER TO PROJECT LEDGER AND/OR COMPUTATION BOOK.

7-12-01
DATE

DEPARTMENT OF TRANSPORTATION STATE OF HAWAII	
APPROVED:	5/23/95 DATE
DIR. OF TRANSPORTATION	