



FED. ROAD DIST. NO.	STATE	FED. AID PROJ. NO.	FISCAL YEAR	SHEET NO.	TOTAL SHEETS
HAWAII	HAW.	STP-019-2(35)	1995	4	39

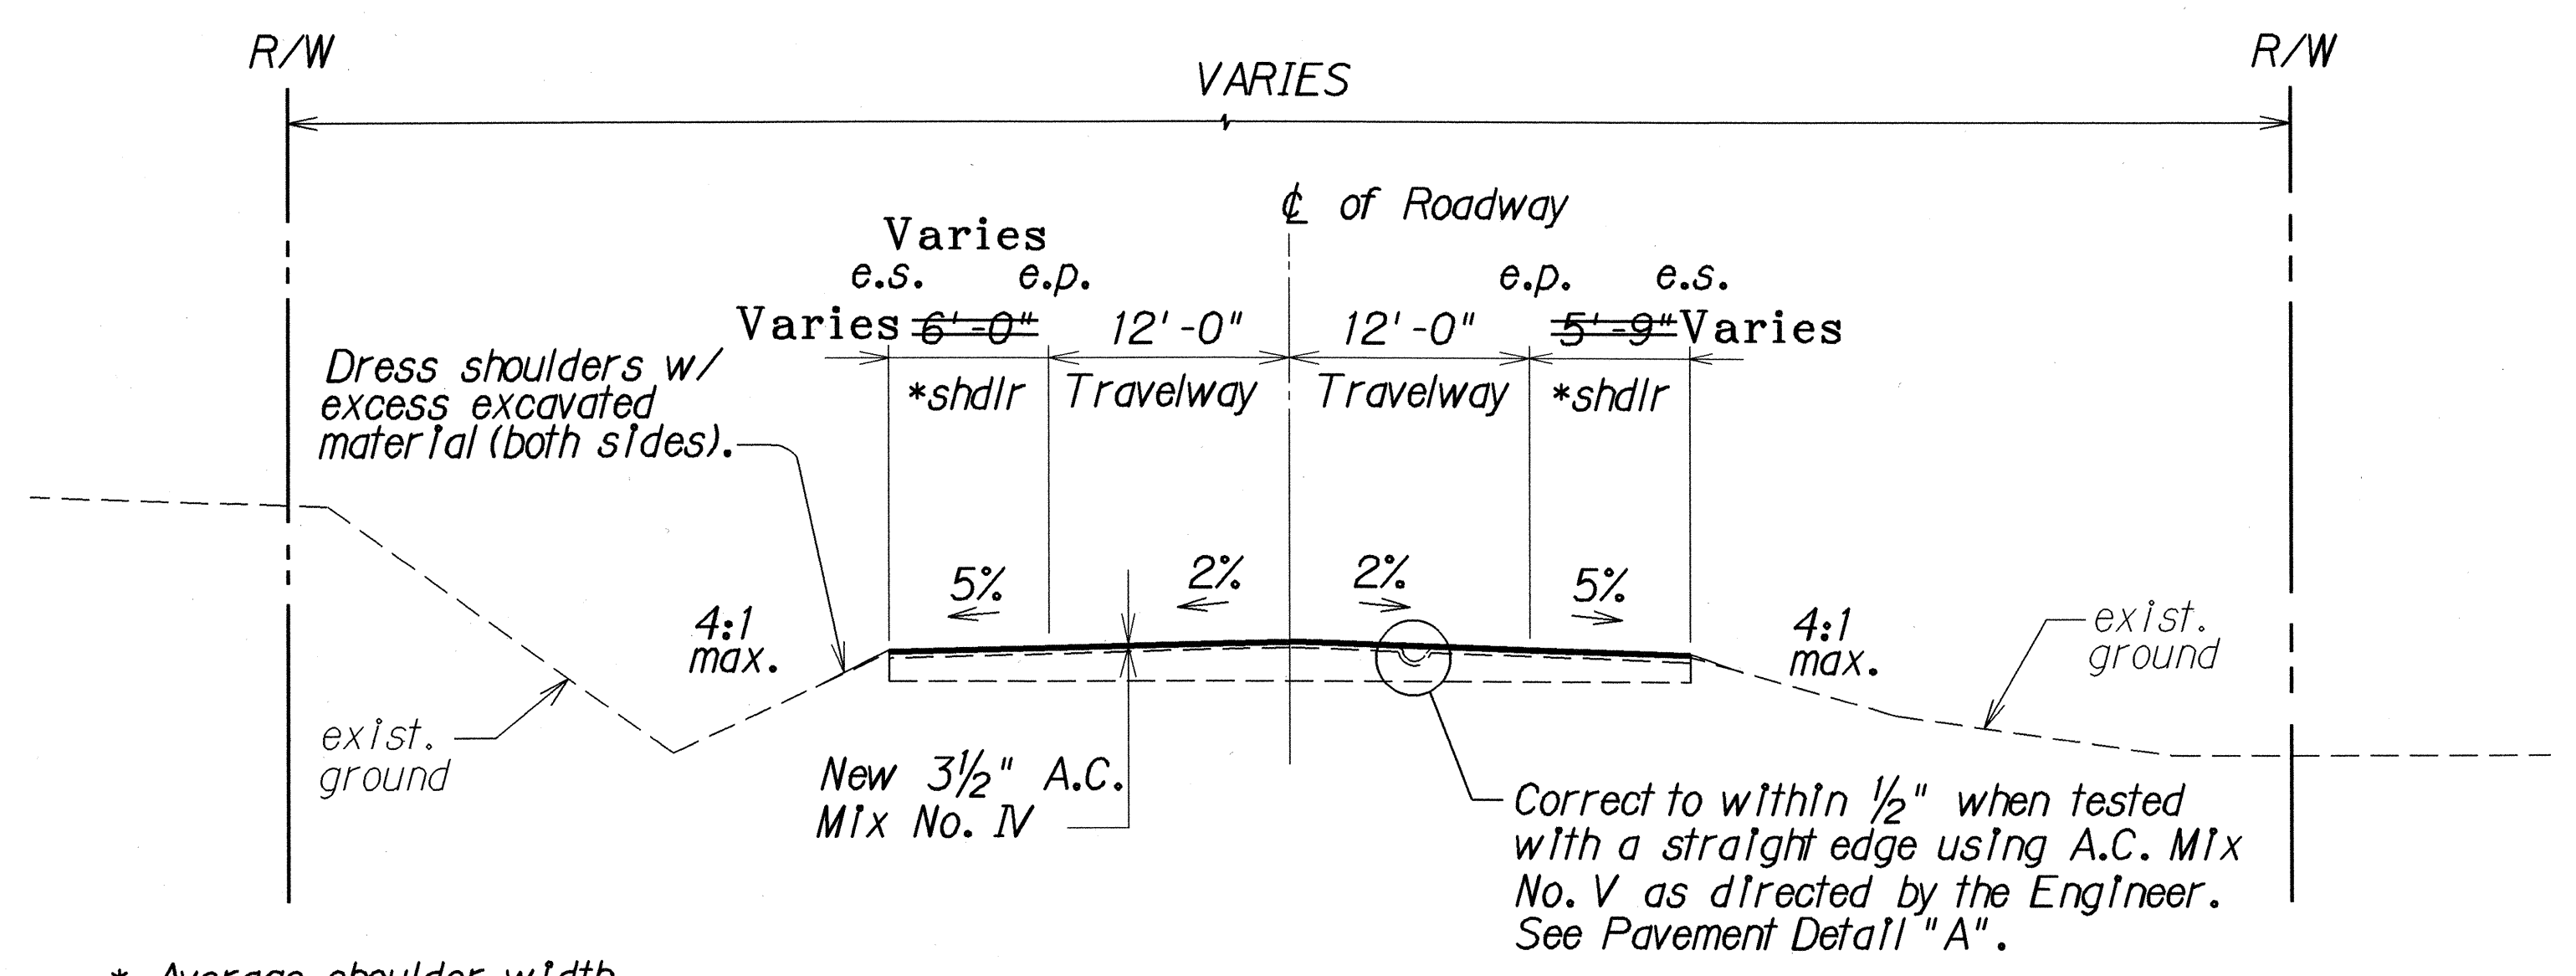


* Average shoulder width over length of project. See Plan Sheets for shoulder width information.

TYPICAL SECTION
Not To Scale


Note: Contractor shall Pave Stabilized Shoulders and 2'-0" wide Strip under Guardrails, See Detail, Sheet 20.

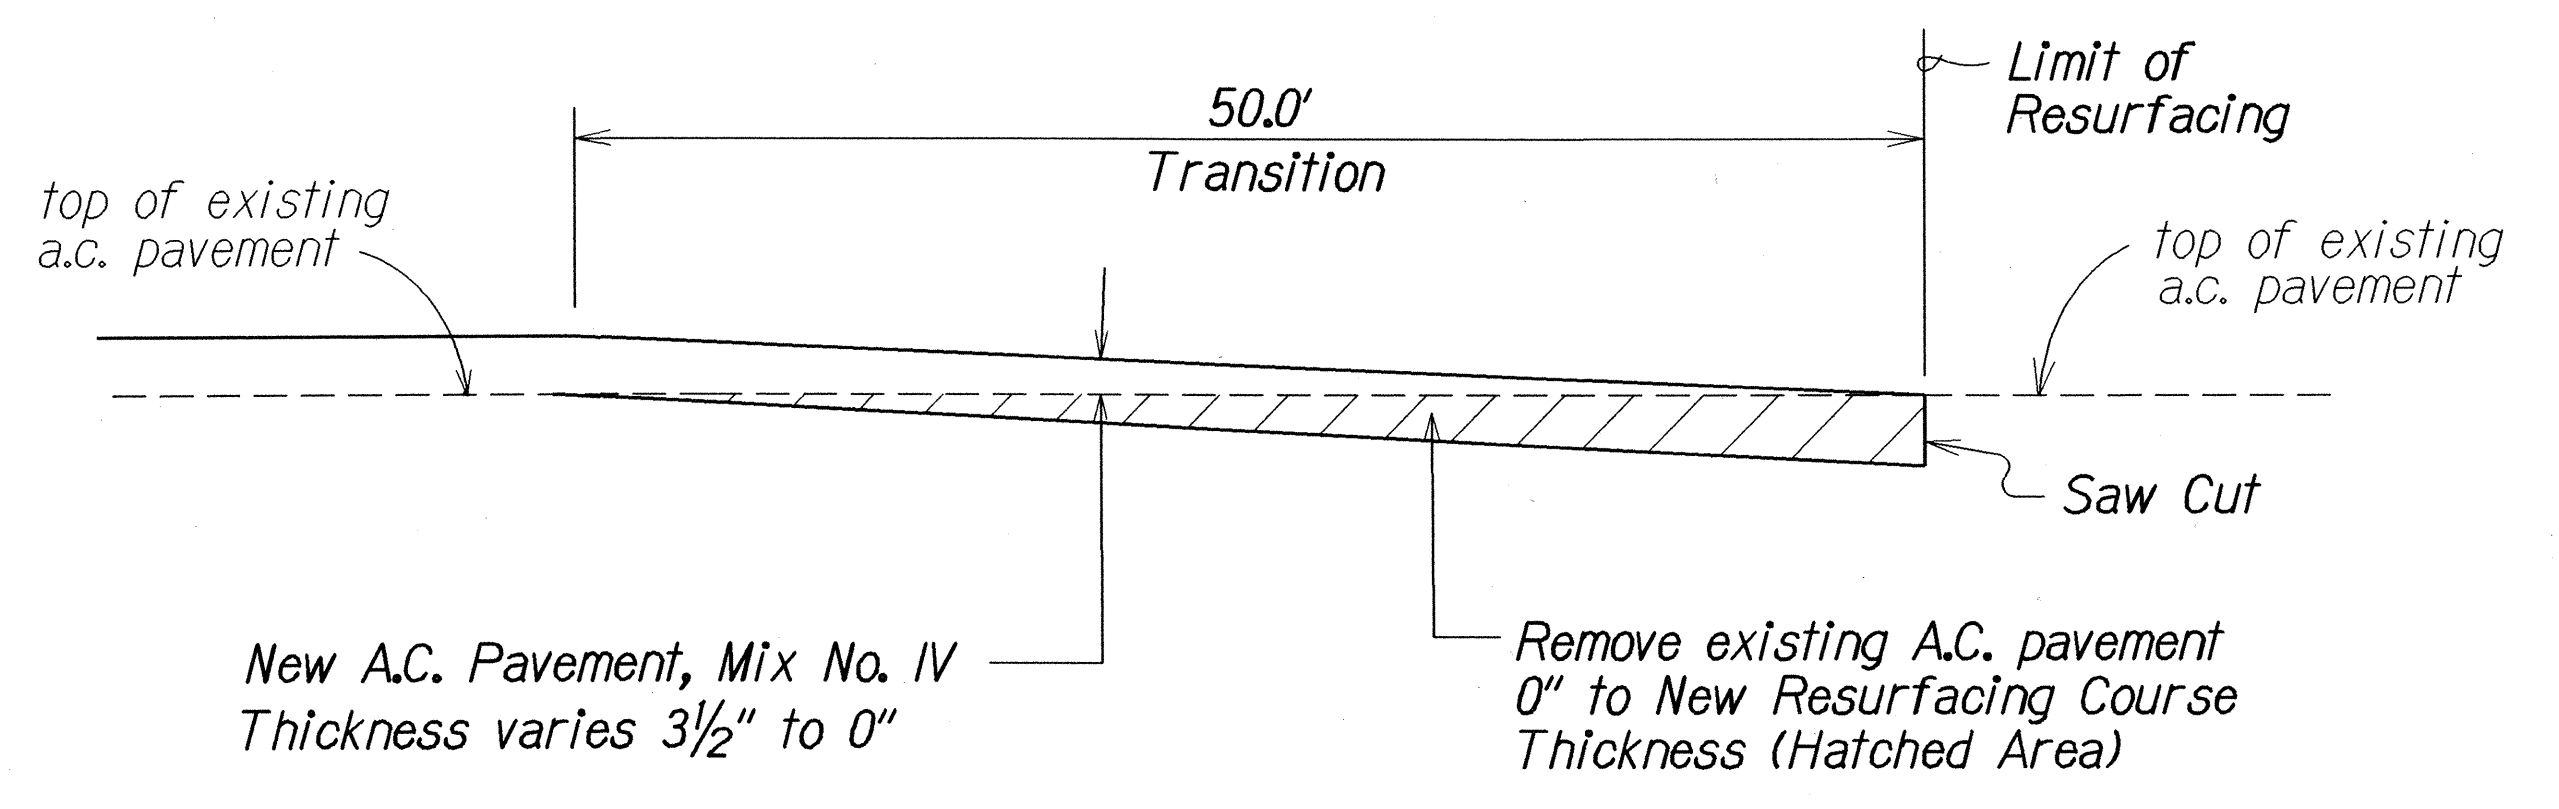

COLD PLANED TRANSITION TO EXISTING A.C. PAVEMENT @ BEGIN AND END PROJECT LIMITS
Not To Scale

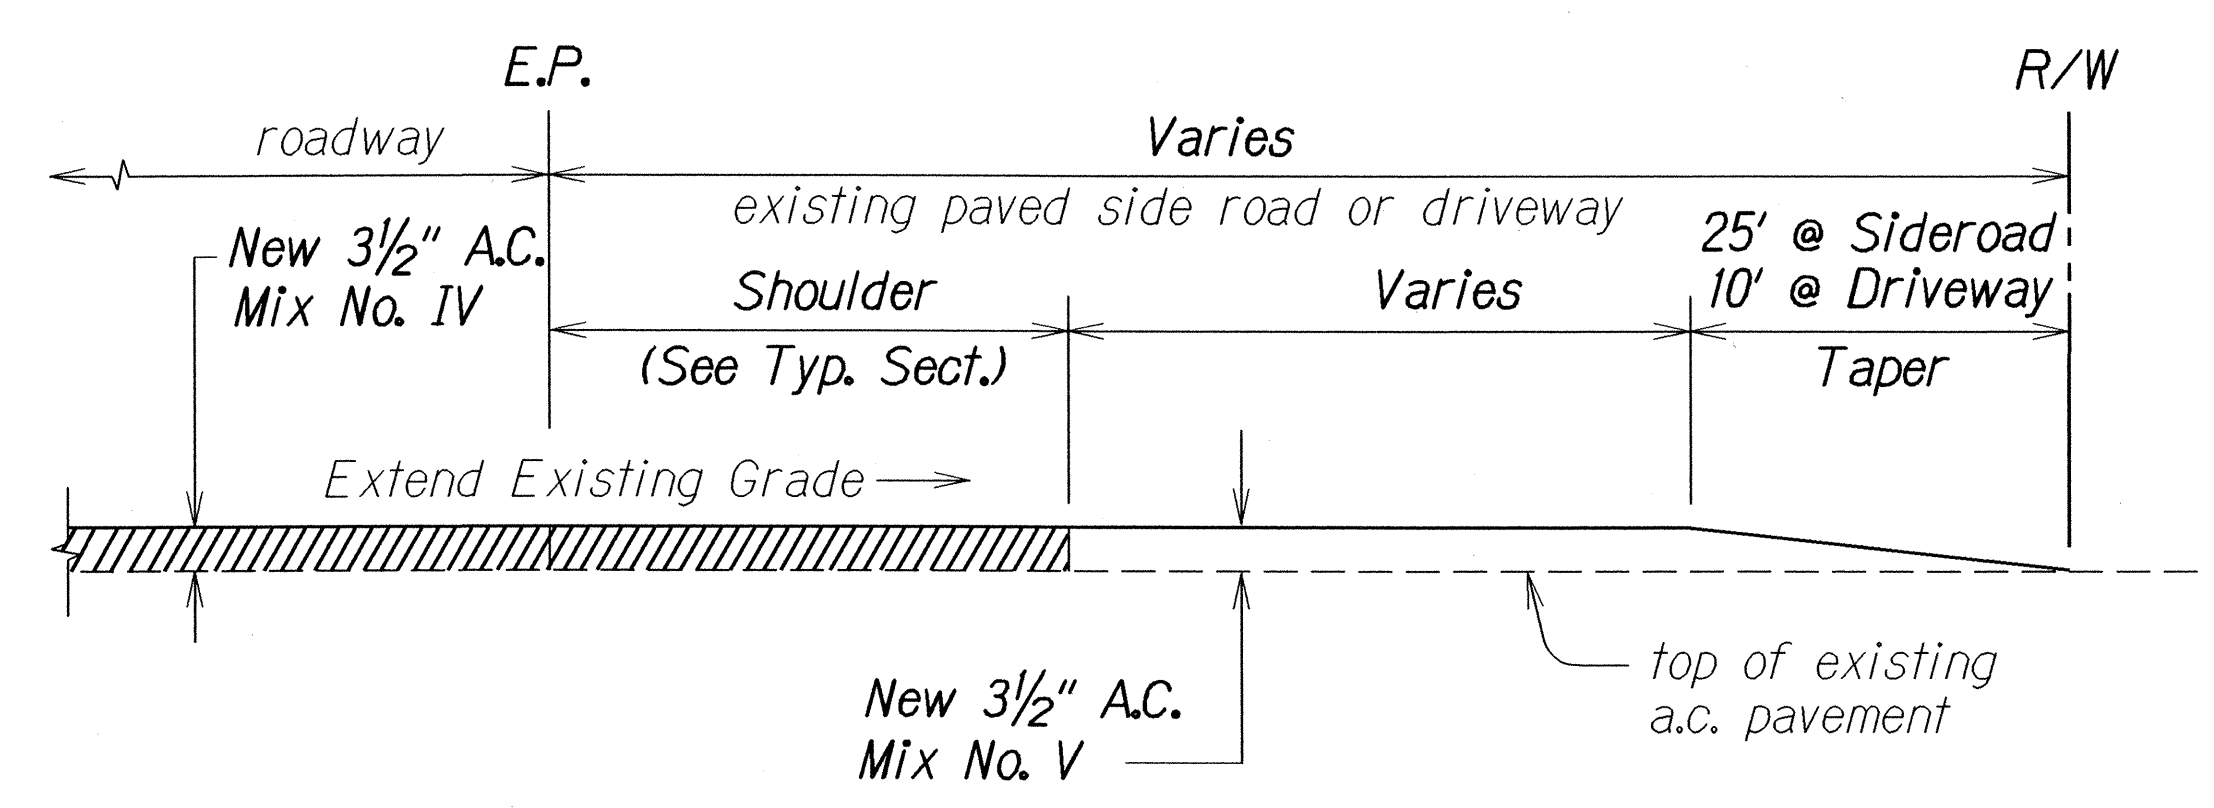

A. C. RESURFACING AT PAVED SIDEROAD OR PAVED DRIVEWAY DETAIL
Not To Scale

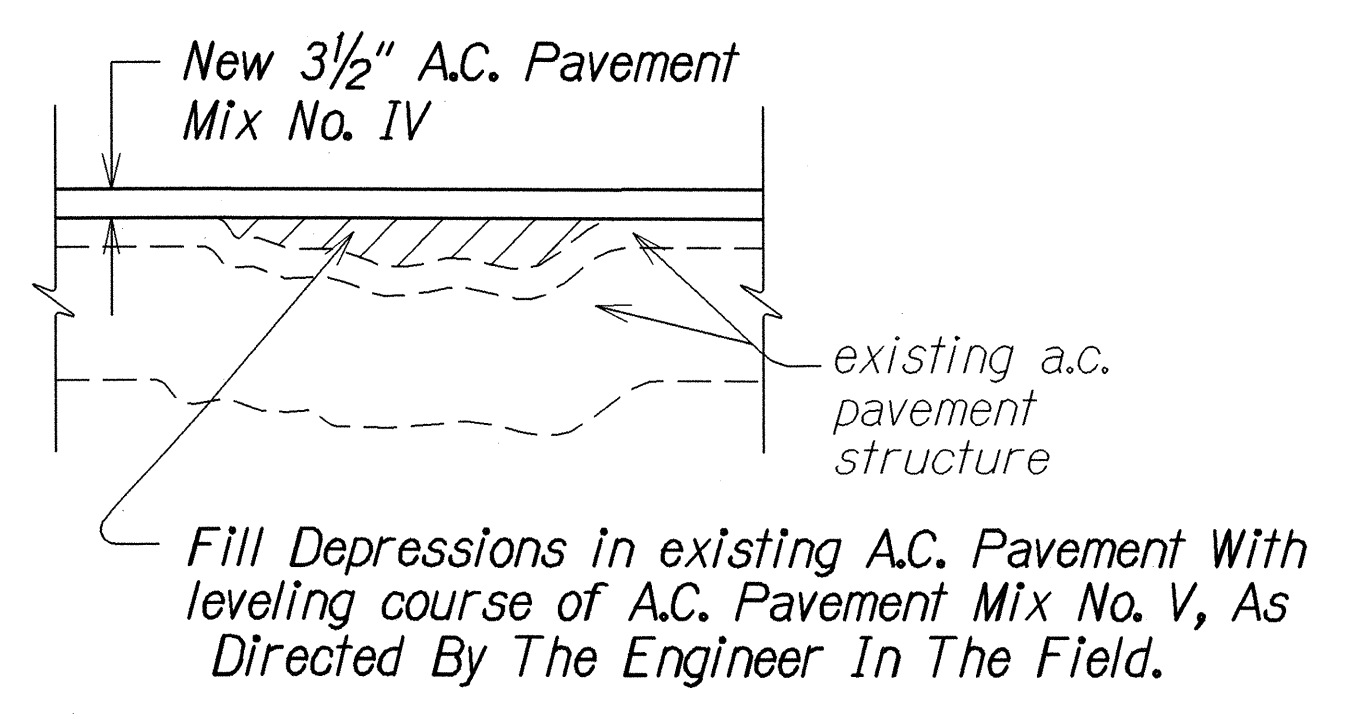

PAVEMENT DETAIL "A"
Not To Scale

LEGEND FOR AS-BUILT POSTINGS	
	Squiggly line for as-built deletion
	Double line for as-built deletion
Roadway	Text for as-built posting

6/8/95	Revise finish course from 3" Mix IV to 3 1/2" Mix IV.
--------	---

DATE	REVISION
------	----------

STATE OF HAWAII
DEPARTMENT OF TRANSPORTATION
HIGHWAYS DIVISION

TYPICAL SECTION & DETAILS

HAWAII BELT ROAD RESURFACING
PAPAIOU TO PEPEEKEO
F.A. PROJECT NO. STP-019-2(35)

Scale: As Shown Date: April, 1995

SHEET No. 1 OF 1 SHEETS