


INDEX TO DRAWINGS	
SHEET NO.	DESCRIPTION
1	TITLE SHEET
2	STANDARD PLANS SUMMARY
3	GENERAL NOTES
4	TYPICAL SECTIONS
5	PAVEMENT MARKING LEGEND DETAILS AND NOTES
6 - 18	ROADWAY, SIGNING AND PAVEMENT MARKING PLANS
19	PAVEMENT RECONSTRUCTION AND BRIDGE JOINT DETAILS
20	GUARDRAIL REFLECTOR MARKER DETAIL
21	BRIDGE OVERLAY AND JOINT WORK QUANTITY SCHEDULE
22 - 24	REFLECTOR AND OBJECT MARKER SCHEDULE
25	GUARDRAIL SCHEDULE
26	MISCELLANEOUS SCHEDULES
27 - 28	SIGN SCHEDULE
29	RECONSTRUCTION AREA SCHEDULE
30	BRIDGE CONNECTION - TYPE I DETAILS AND NOTES
① 31	BRIDGE CONNECTION - TYPE II DETAILS AND NOTES
② 32 - 34	"MELT" DETAILS
35	CONSTRUCTION SIGN PLAN AND SCHEDULE
36	NPDES



SHEET NOS. ① C.O.313-1 THROUGH C.O.313-3
AND ② 345-1 ARE SUPPLEMENTARY SHEETS
TO THIS PROJECT. TOTAL SHEET COUNT
AFTER "AS-BUILT" POSTING 40 SHTS.

HAWAII DISTRICT DESIGNED BY
J. FUJIMOTO
P.S. & E. BY
587-2249
PHONE
NOVEMBER, 1994
DATE

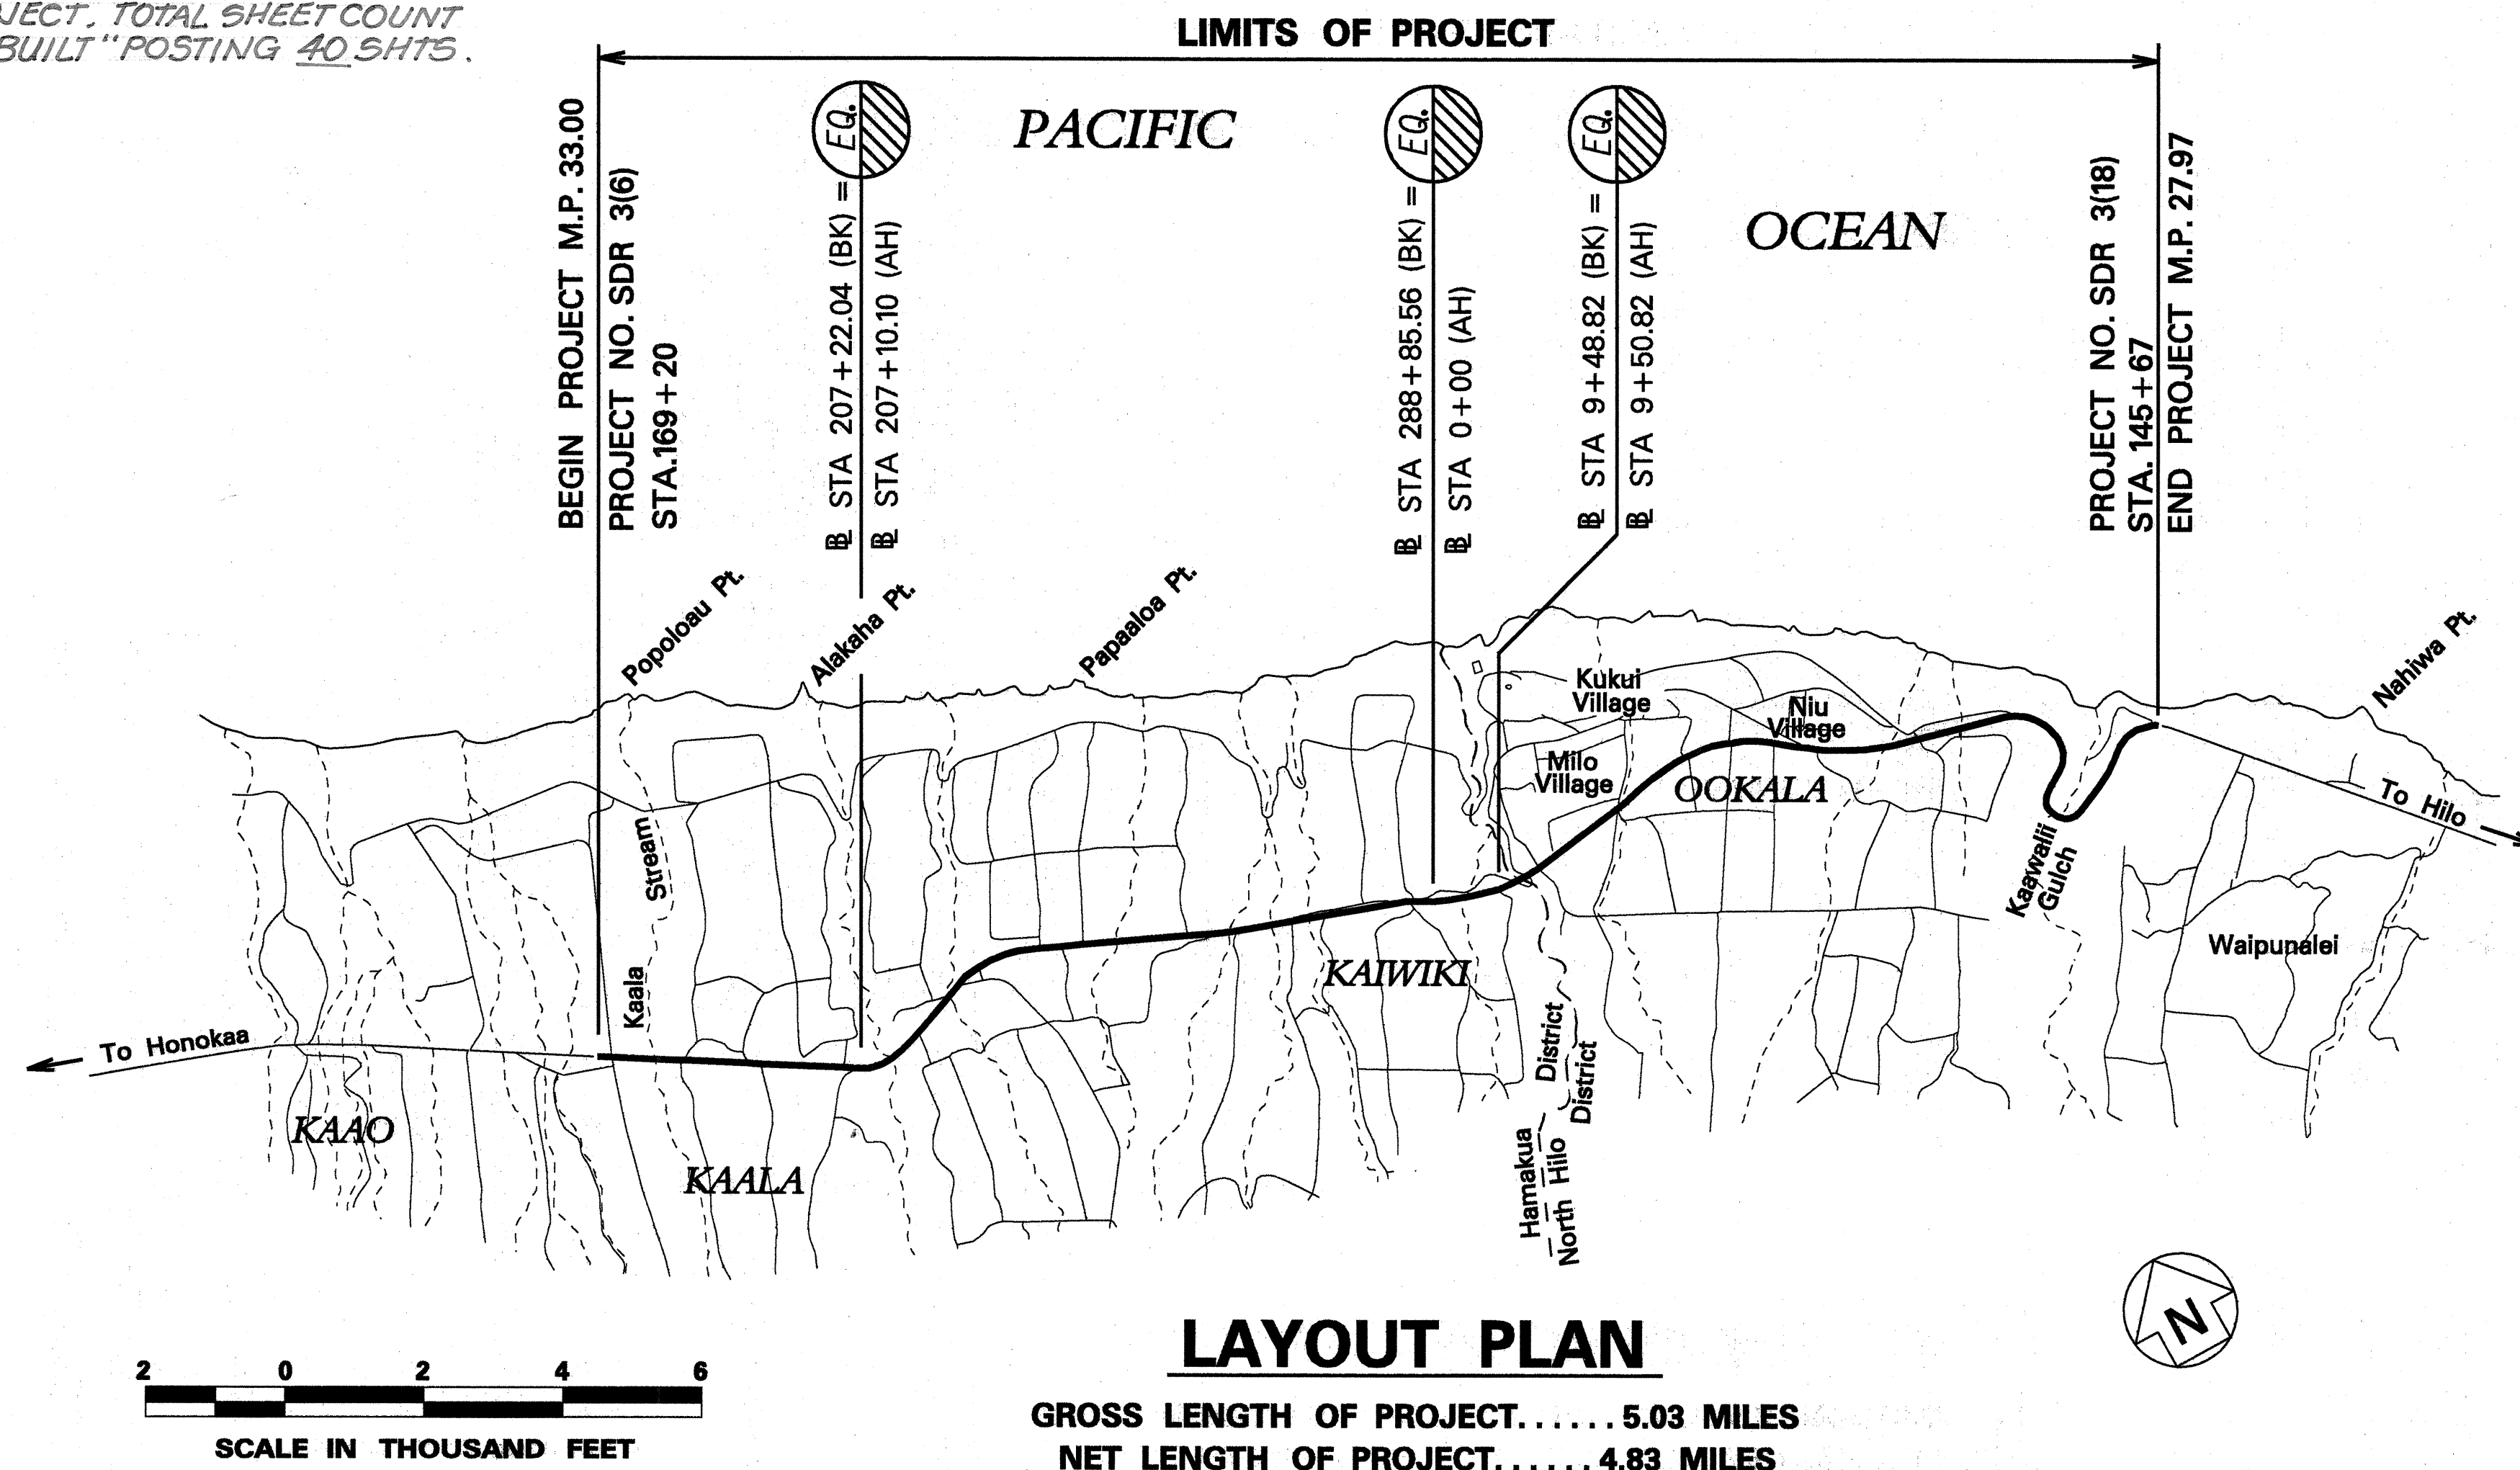

STATE OF HAWAII
DEPARTMENT OF TRANSPORTATION
HIGHWAYS DIVISION
HONOLULU, HAWAII
"AS-BUILT"
PLANS FOR
HAWAII BELT ROAD RESURFACING
KAALA BRIDGE TO KAAWALII GULCH
FEDERAL AID PROJECT NO. STP-019-2(37)
DISTRICTS OF NORTH HILO AND HAMAKUA
ISLAND OF HAWAII

FED. ROAD DIST. NO.	STATE	FED. AID PROJ. NO.	FISCAL YEAR	SHEET NO.	TOTAL SHEETS
HAWAII	HAW.	STP-019-2(37)	1995	1	36

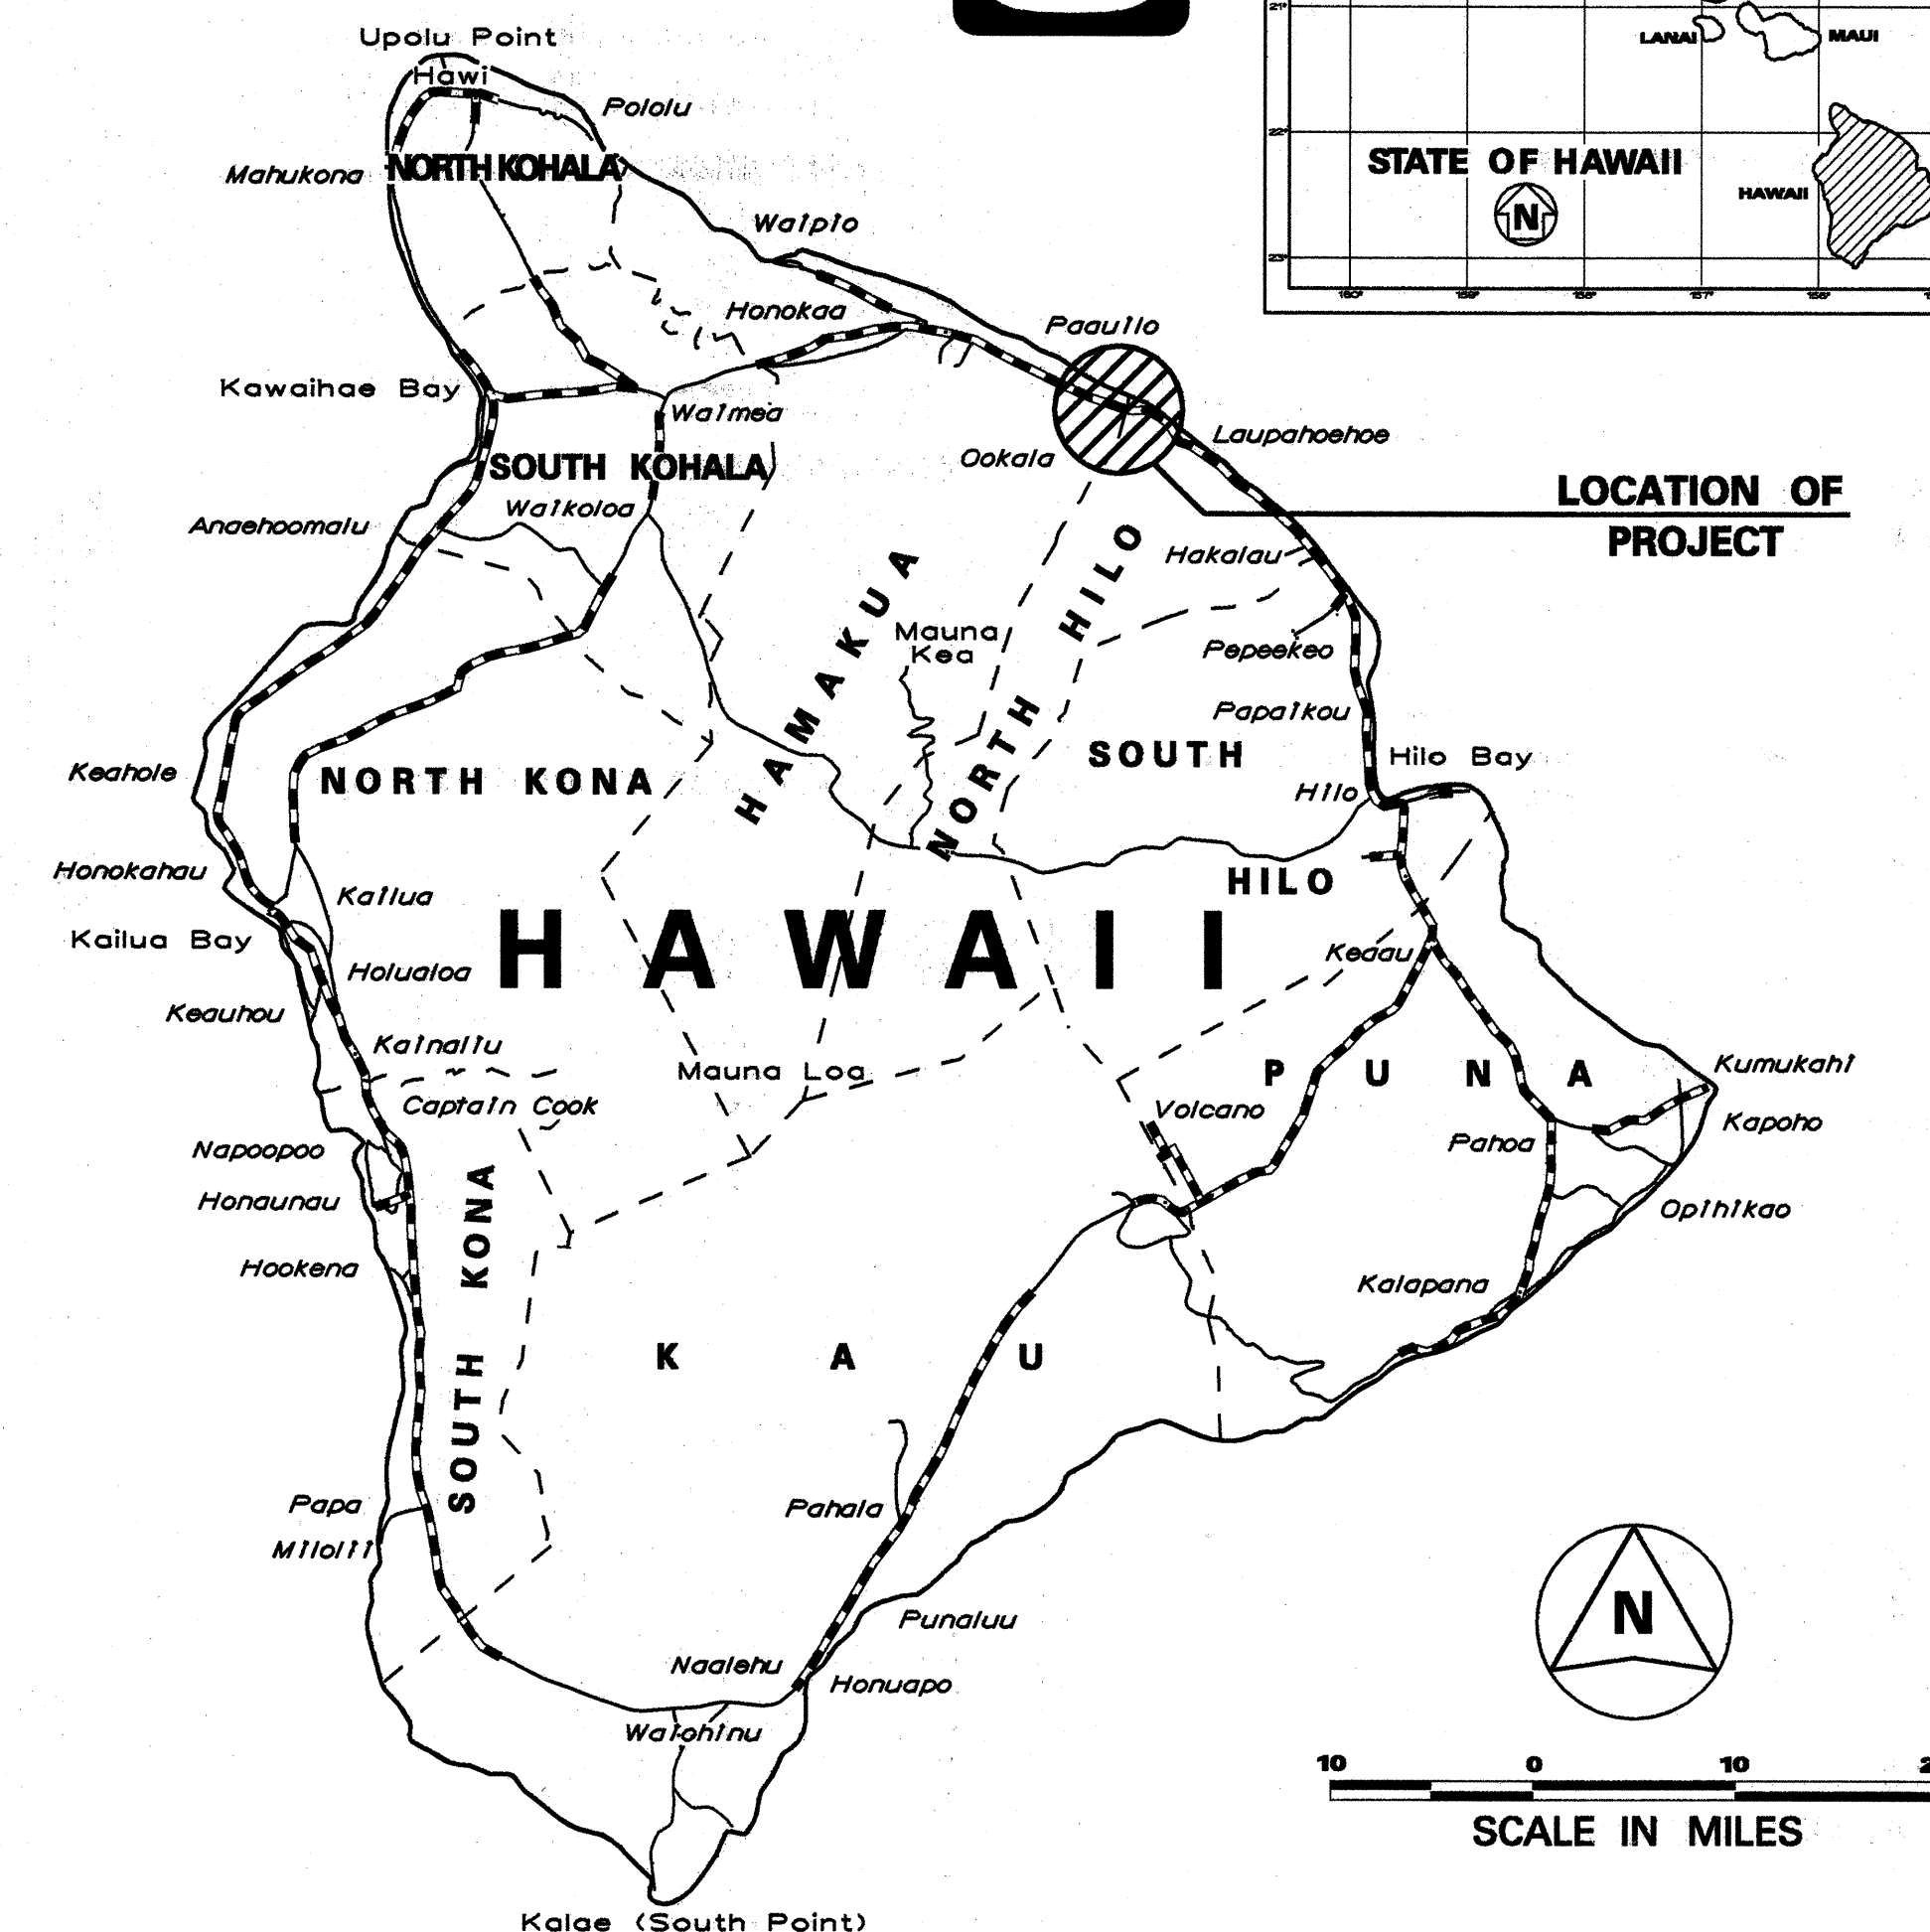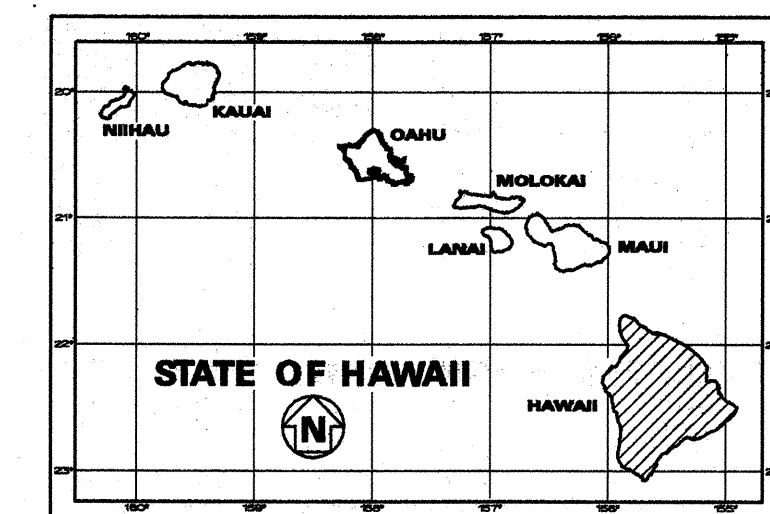

FEDERAL AID PROJECTS PREVIOUSLY CONSTRUCTED
OR UNDER CONSTRUCTION

MILE POST 33.00 TO MILE POST 27.97

DESIGN DESIGNATION

ADT (1994)..... 7,900
ADT (2004)..... 12,600
DHV 1,060
D 55/45
T 10.5 %
V 65 M.P.H.

CHANGES MADE DURING CONSTRUCTION HAVE BEEN
INCORPORATED ON THESE PLANS EXCEPT CHANGES
IN THE ORIGINAL THEORETICAL QUANTITIES. FOR
ACTUAL QUANTITIES, REFER TO PROJECT LEDGER
AND/OR COMPUTATION BOOK.

for *Steve J. Cho* 3-2-06
RESIDENT ENGINEER DATE

"AS-BUILT"

DEPARTMENT OF TRANSPORTATION STATE OF HAWAII	
APPROVED: <i>Erin Hagan</i>	5/10/95
DIR. OF TRANSPORTATION	DATE