

INDEX TO DRAWINGS	
SHEET NO.	DESCRIPTION
1	TITLE SHEET
2	STANDARD PLANS SUMMARY
3	GENERAL NOTES
4	NANUE BRIDGE PLAN & ELEVATION
5	WAILUKU BRIDGE PLAN & ELEVATION
6	CONSTRUCTION SIGN PLAN

STATE OF HAWAII

DEPARTMENT OF TRANSPORTATION

HIGHWAYS DIVISION

HONOLULU, HAWAII

"AS-BUILT"

PLANS FOR

HAWAII BELT ROAD

CLEAN AND PAINT STEEL MEMBERS




NANUE AND WAILUKU BRIDGES

FEDERAL AID PROJECT NO. BR-019-2(40)


DISTRICTS OF NORTH AND SOUTH HILO

ISLAND OF HAWAII


FED. ROAD DIST. NO.	STATE	FED. AID PROJ. NO.	FISCAL YEAR	SHEET NO.	TOTAL SHEETS
HAWAII	HAW.	BR-019-2(40)	1996	1	6

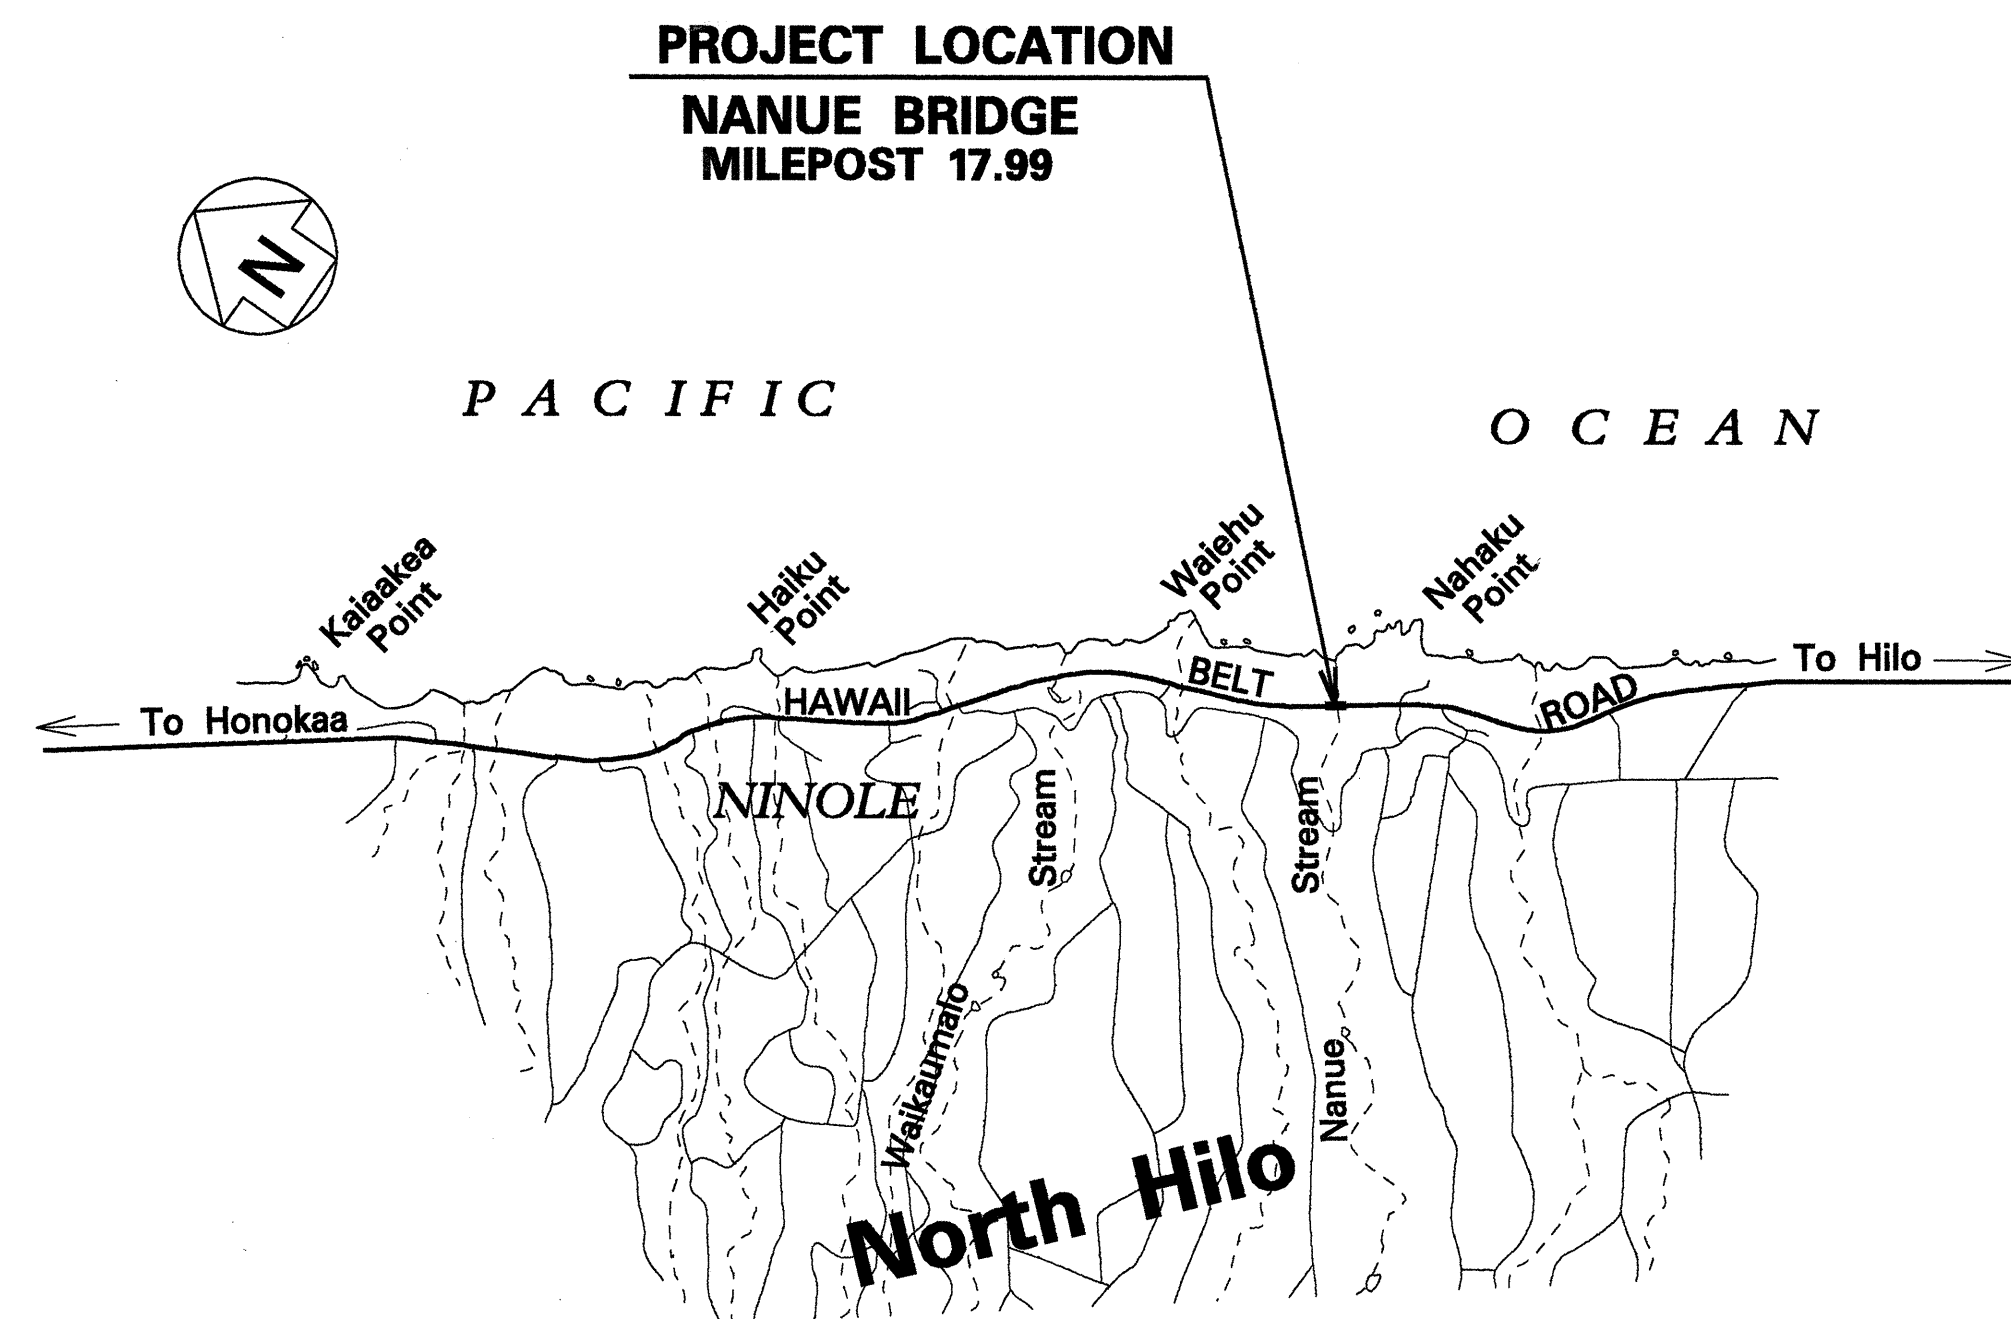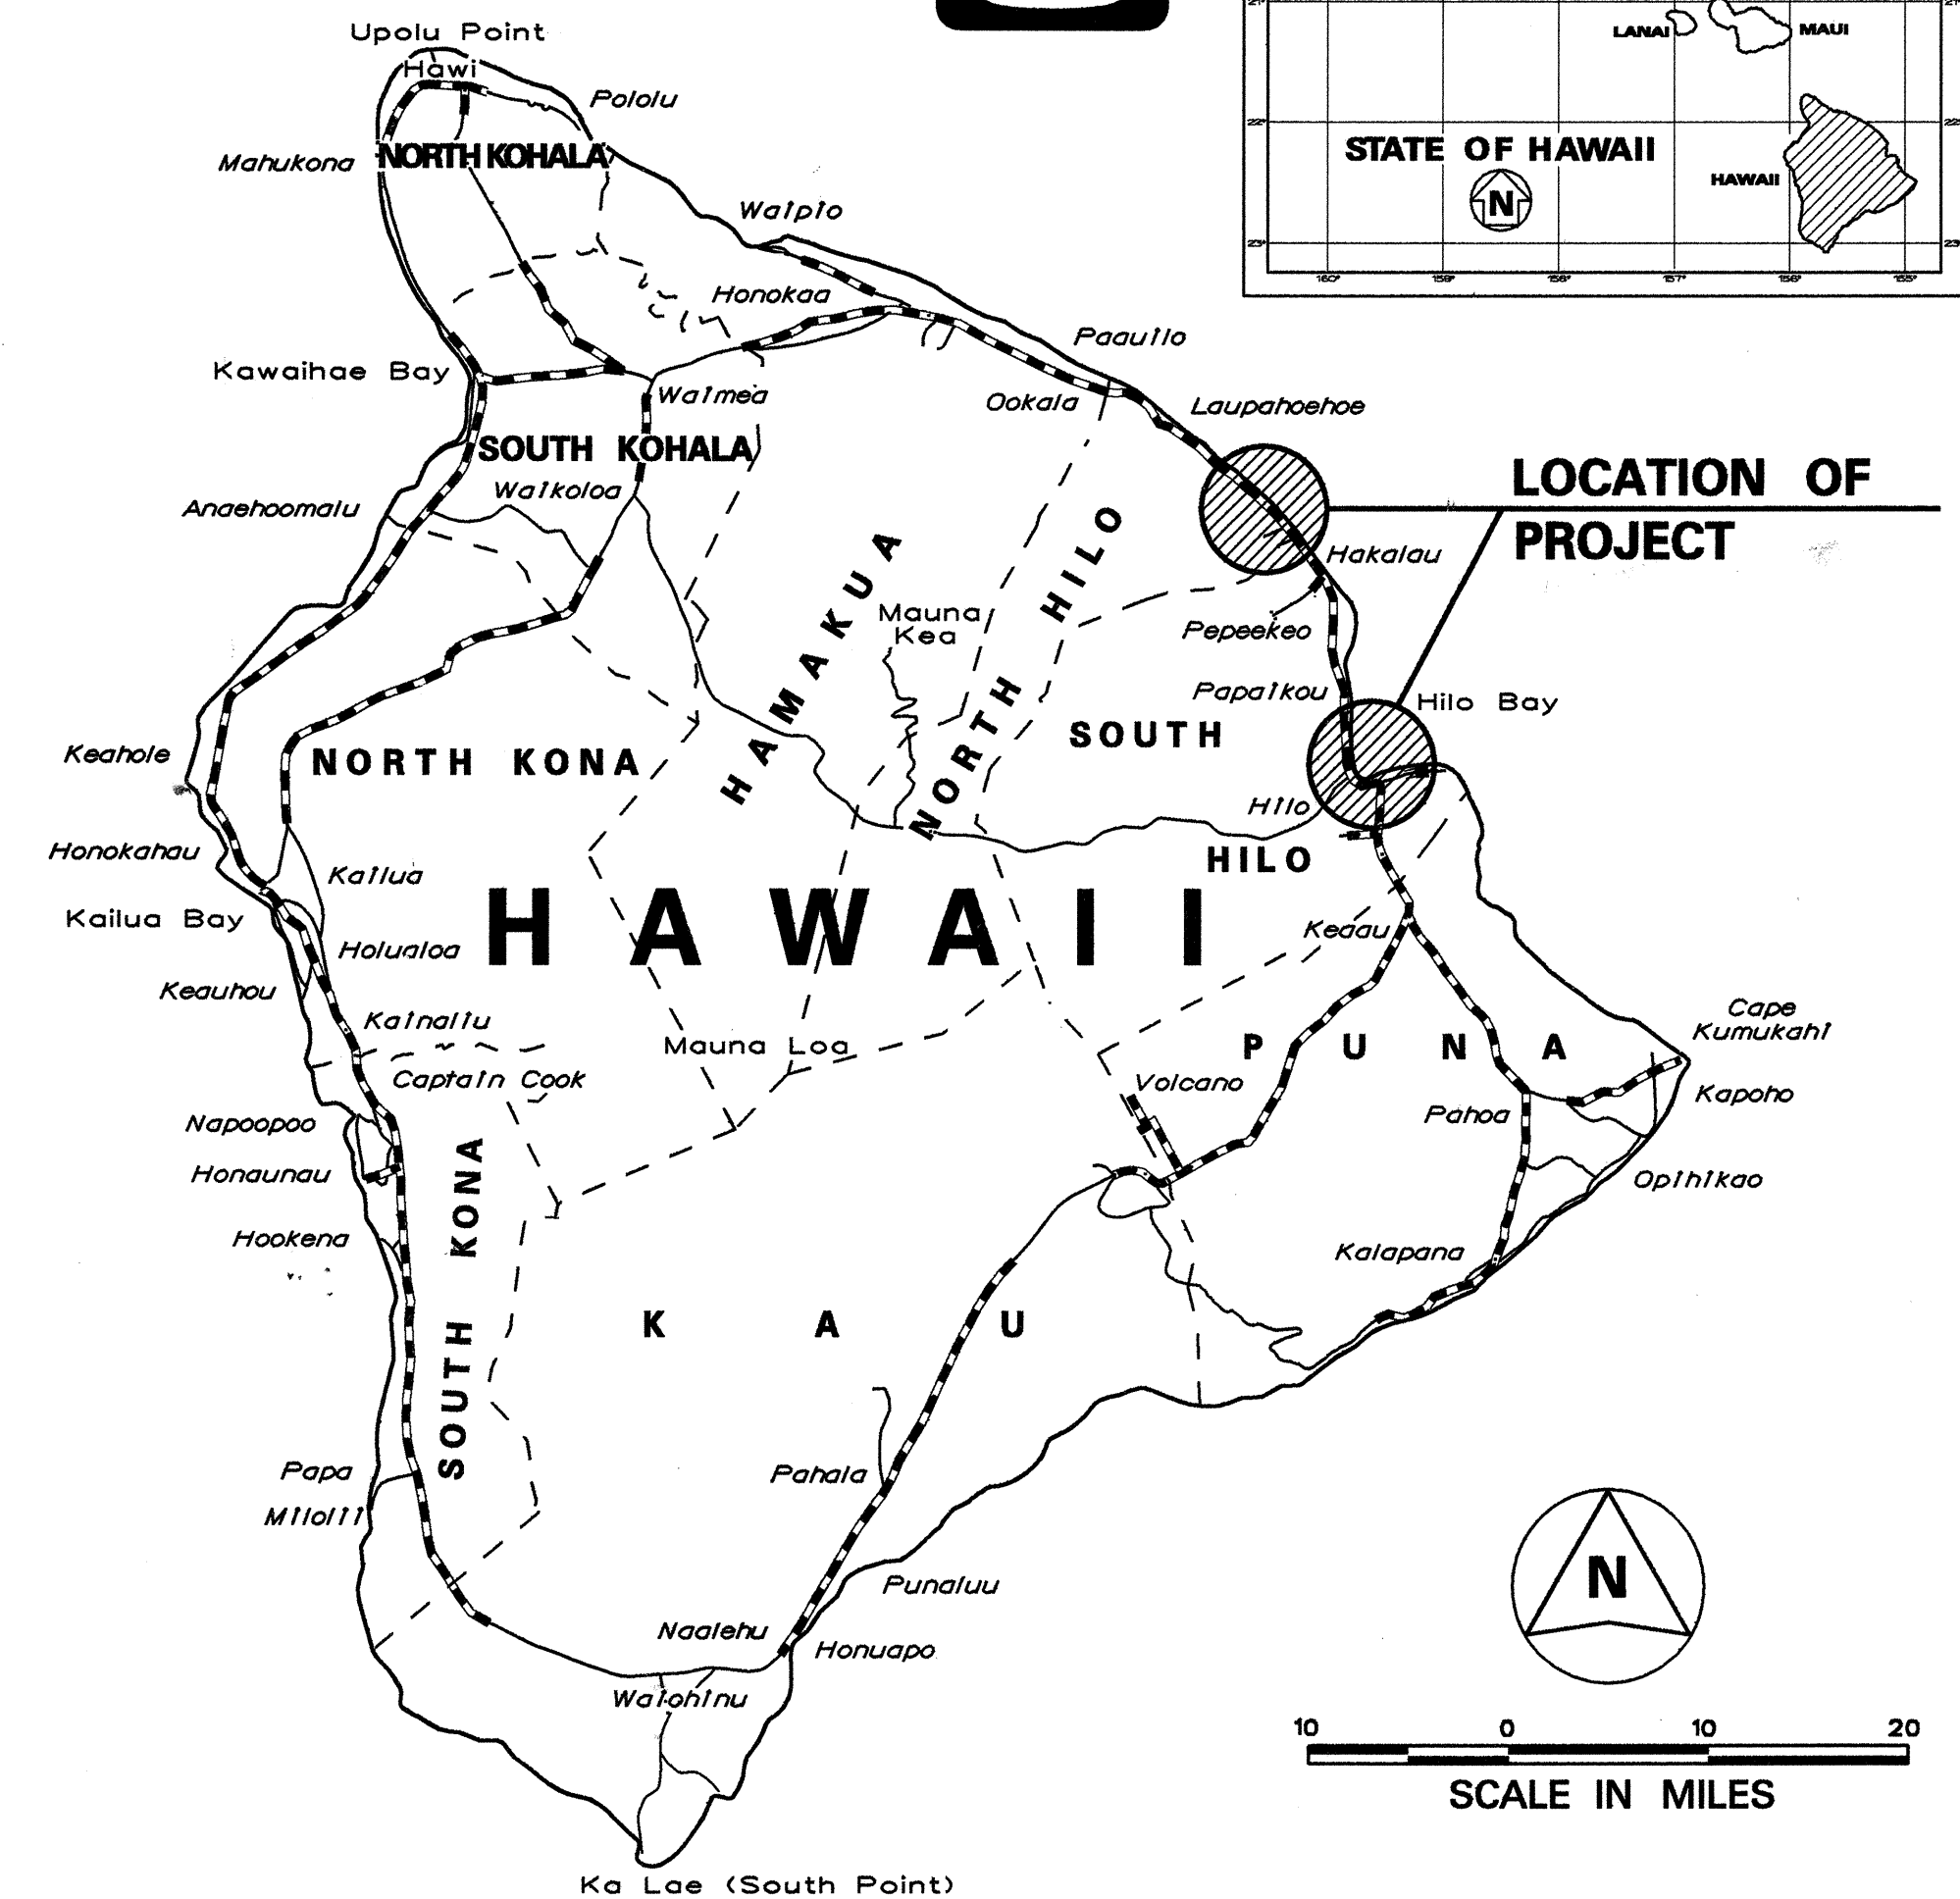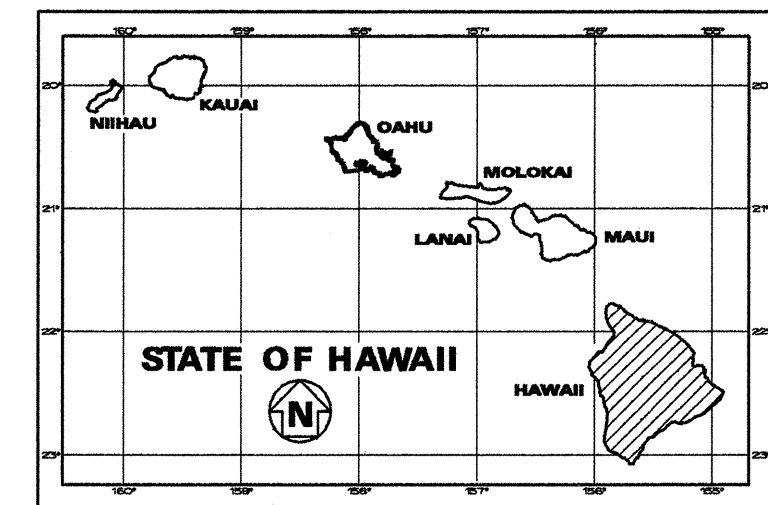

LAYOUT PLAN

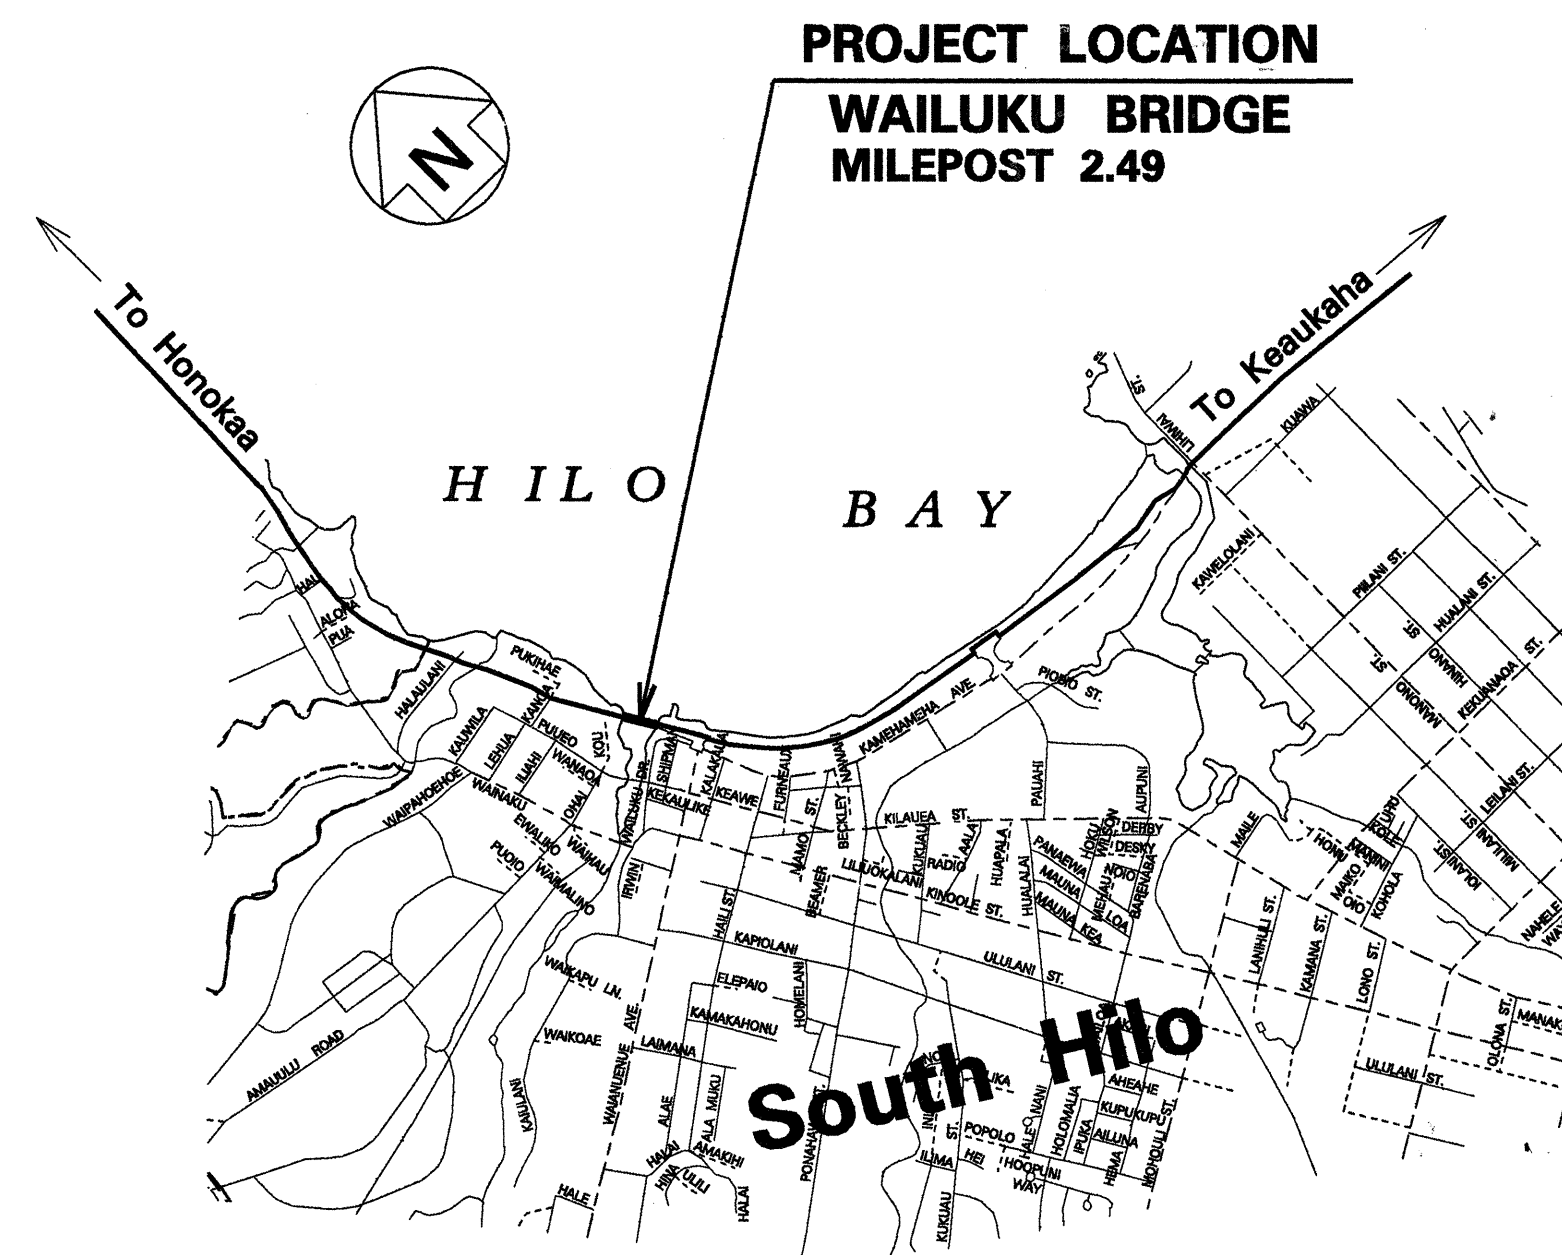

LAYOUT PLAN

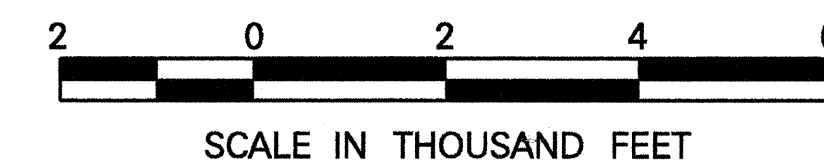

DEPARTMENT OF TRANSPORTATION STATE OF HAWAII	
APPROVED:	DATE
<i>Kayn Bayarh</i>	5/17/96
DIR. OF TRANSPORTATION	DATE

HAWAII DISTRICT DESIGNED BY JULIUS B. FRONDA P.S. & E.B.Y. MAY 1996 DATE 5/17/96 PHONE 587-2242