


FED. ROAD DIST. NO.	STATE	FED. AID PROJ. NO.	FISCAL YEAR	SHEET NO.	TOTAL SHEETS
HAWAII	HAW.	STP-019-1(23)	1996	8	8


NOTES

- Layout of pavement markings and striping shall be done by the Contractor and accepted by the Engineer prior to any installation work.
- Existing pavement markings not incorporated in the final traffic pattern shall be removed as directed by the Engineer. Costs shall be incidental to the various pavement marking items.
- Final locations of all signs shall be accepted by the Engineer prior to any installation work.
- Existing signs not shown on these plans shall remain as posted unless otherwise directed by the Engineer. Removal and disposal of existing signs and/or posts as designated on these plans shall be incidental to the various signing items.
- All pavement striping shall be as noted on the Legend or plans.
- All preformed pavement marking tapes over existing pavement shall be applied with an approved primer as recommended by the tape manufacturer and as accepted by the Engineer. The primer shall be allowed to dry to the tacky stage prior to tape application.

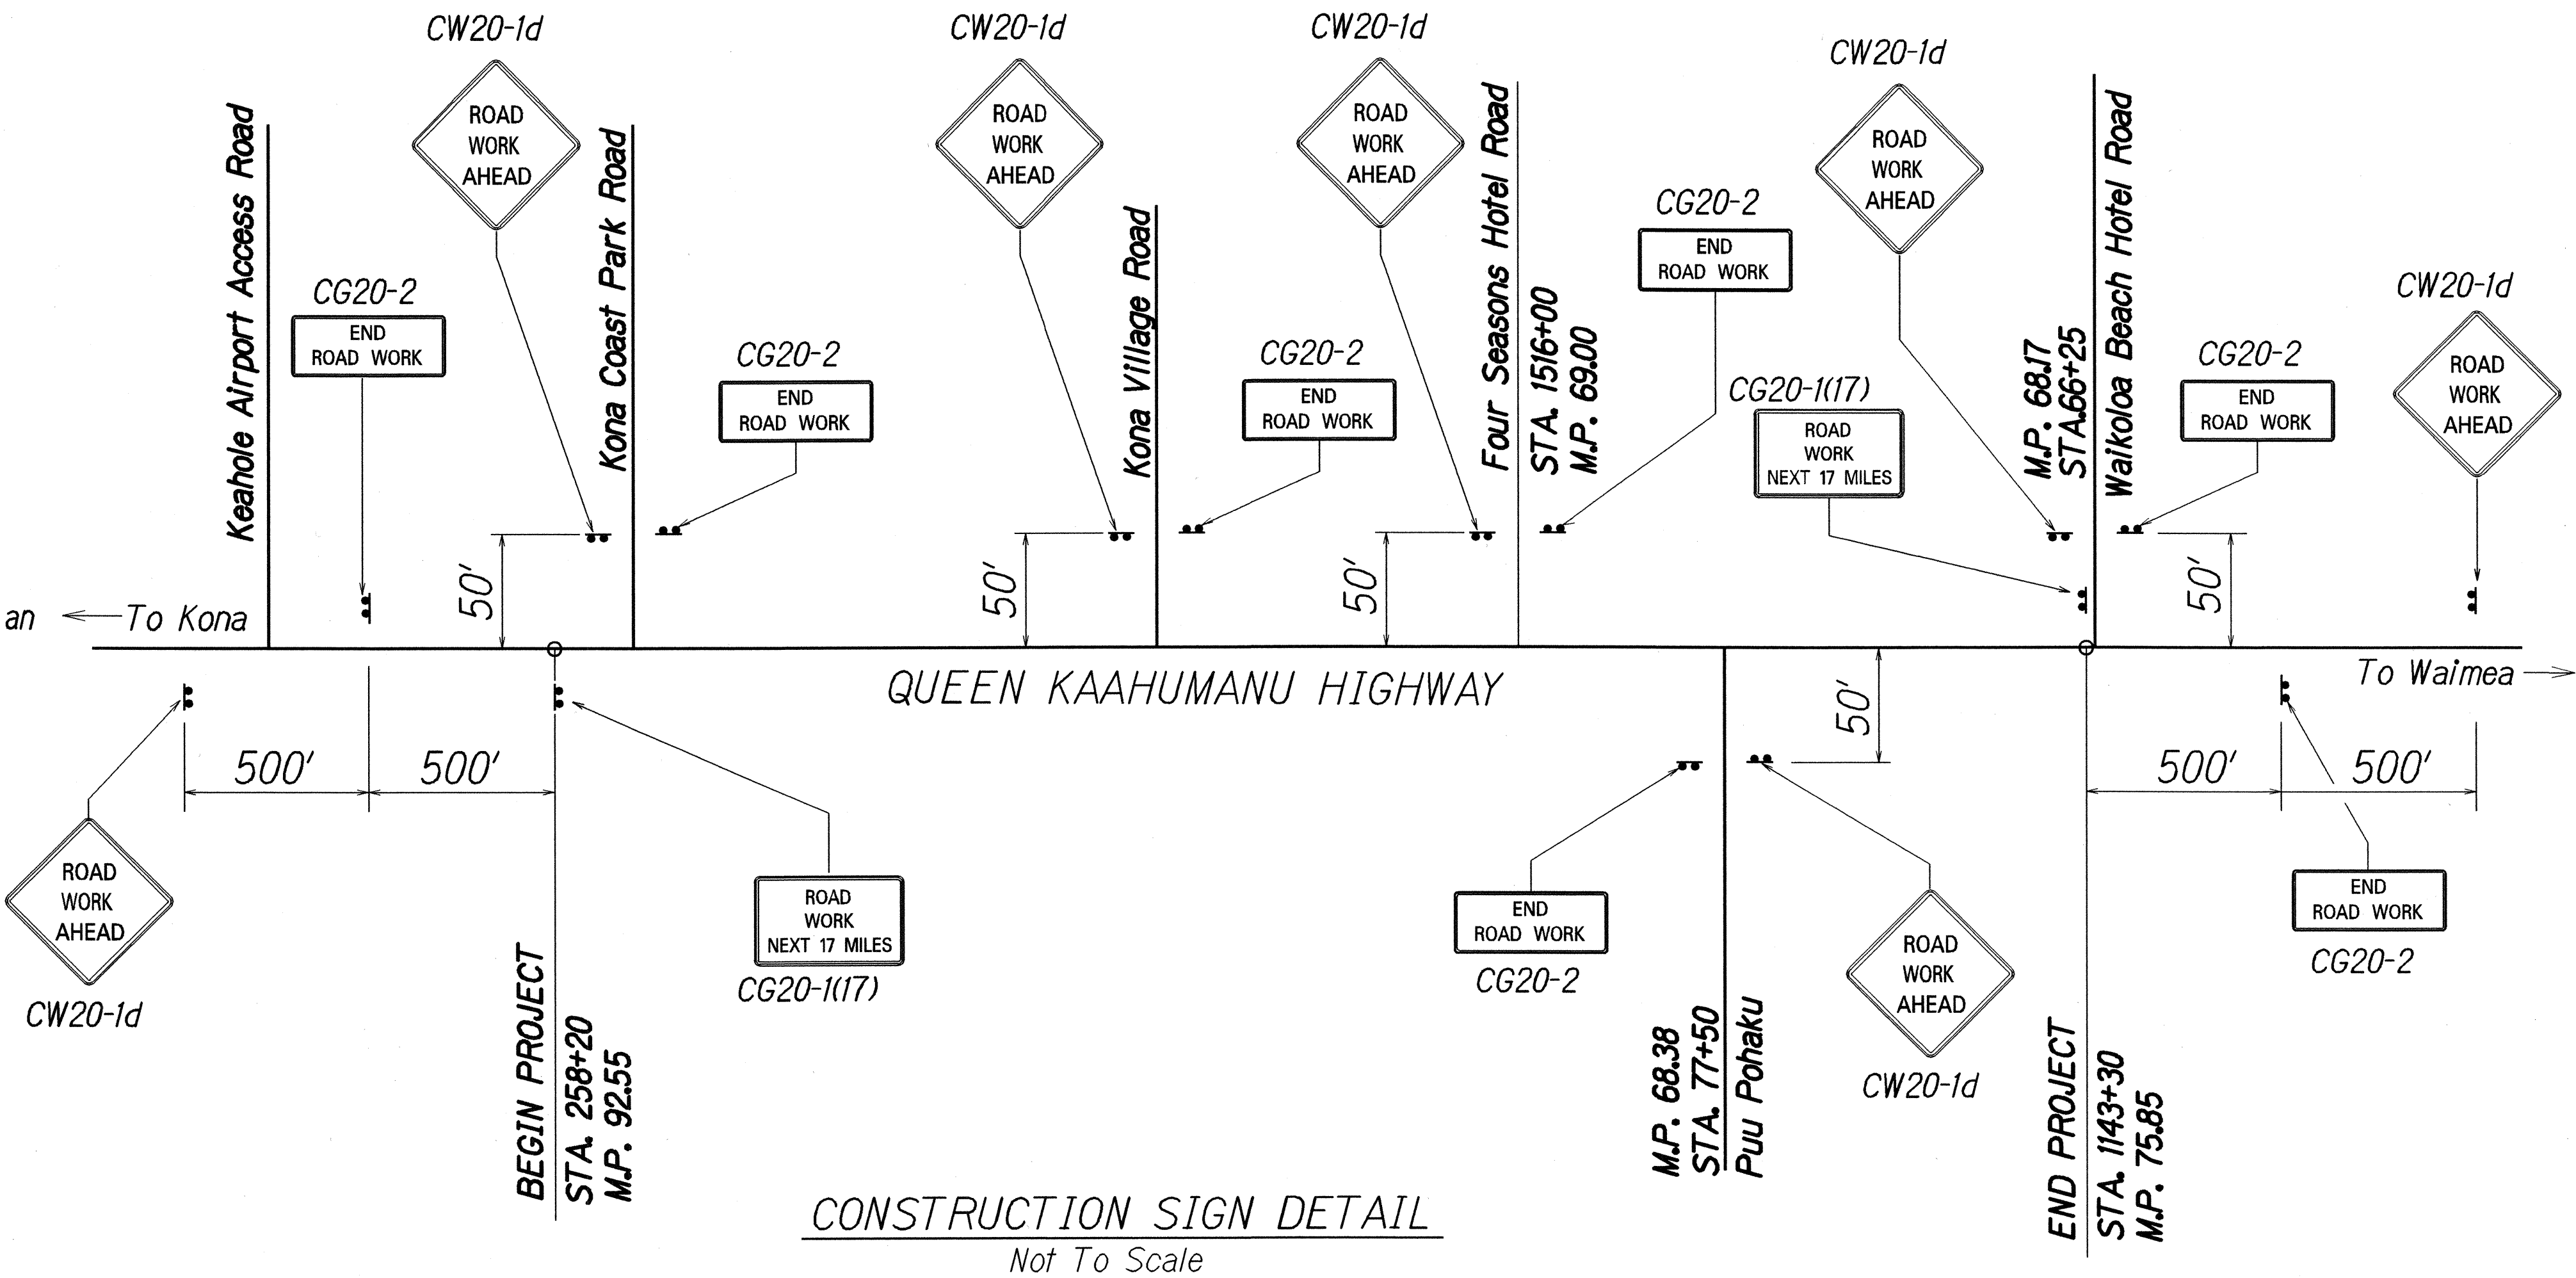

CONSTRUCTION SIGN DETAIL  
Not To Scale

PAVEMENT MARKER AND STRIPING SUMMARY	
DESCRIPTION	QUANTITY
4 INCH PAVEMENT STRIPING ITEM NO. 629J013	27,632 <del>27,000</del> L.F.
TYPE "C" PAVEMENT MARKERS ITEM NO. 629.2030	736 <del>700</del> EACH
4 INCH PAVEMENT STRIPING ITEM NO. 629J013	145,030 <del>138,800</del> L.F.
TYPE "C" PAVEMENT MARKERS ITEM NO. 629.2030	3592 <del>3500</del> EACH

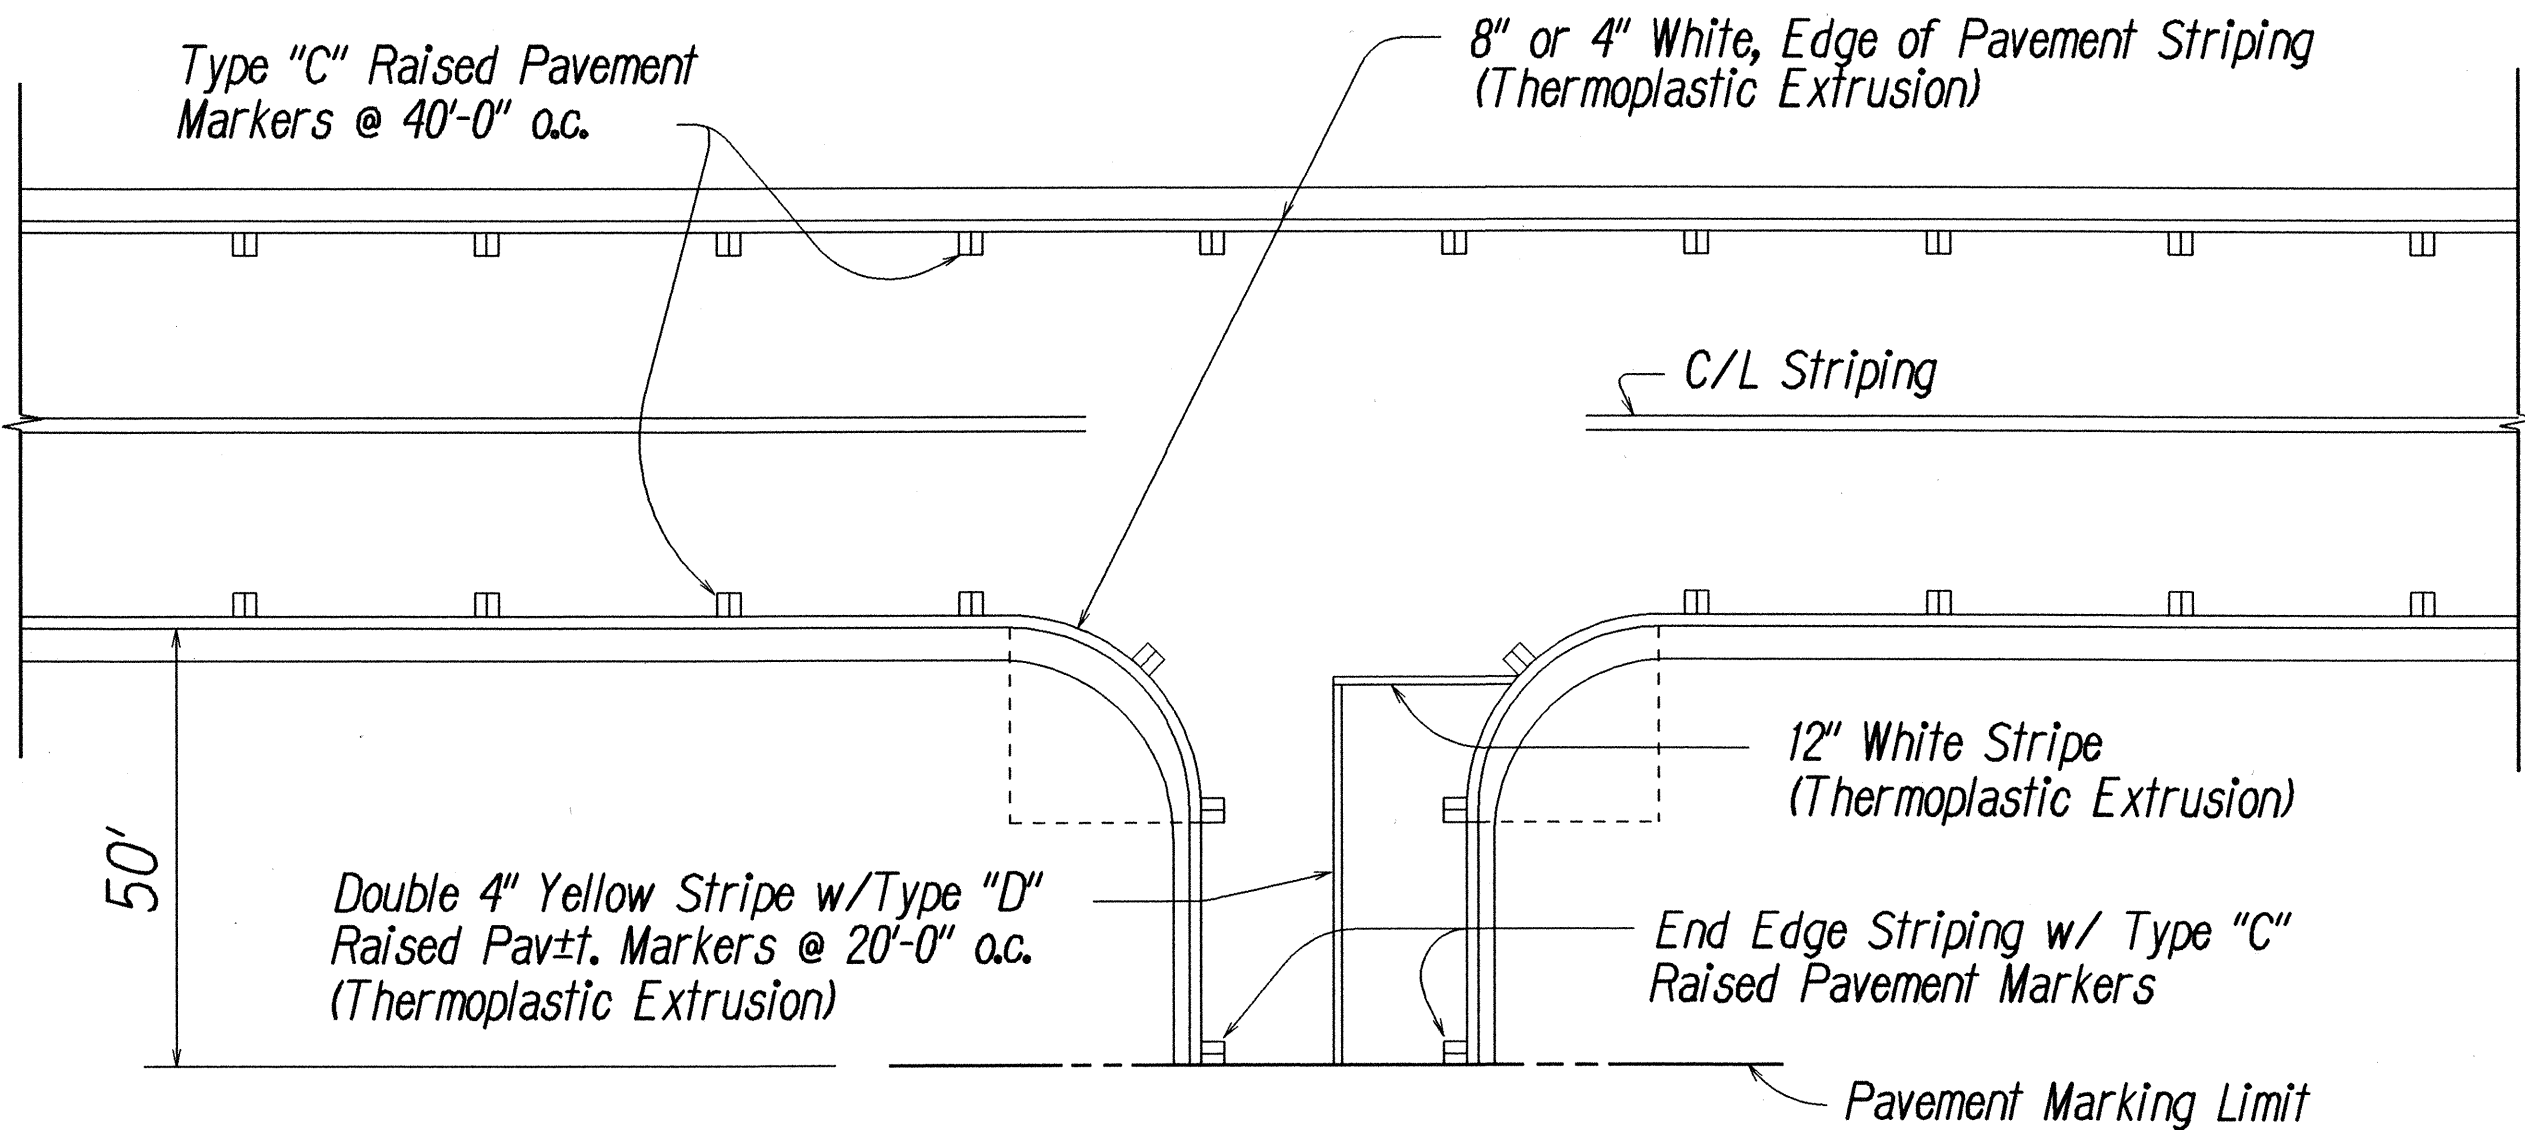

TYPICAL EDGE OF PAVEMENT MARKING  
Not to Scale

LEGEND FOR AS-BUILT POSTINGS	
	Squiggly line for as-built deletion
	Double line for as-built deletion
Roadway	Text for as-built posting

STATE OF HAWAII  
DEPARTMENT OF TRANSPORTATION  
HIGHWAYS DIVISION

**CONSTRUCTION SIGN & PAVEMENT MARKING DETAIL**  
**QUEEN KAAHUMANU SHOULDER IMPROVEMENTS**  
**Keahole to Waikoloa**  
**Federal Aid Project No. STP-019-1(23)**  
Scale: As Shown      Date: May, 1996