




FED. ROAD DIST. NO.	STATE	PROJ. NO.	FISCAL YEAR	SHEET NO.	TOTAL SHEETS
HAWAII	HAW.	19A-01-97M	1997	4	29

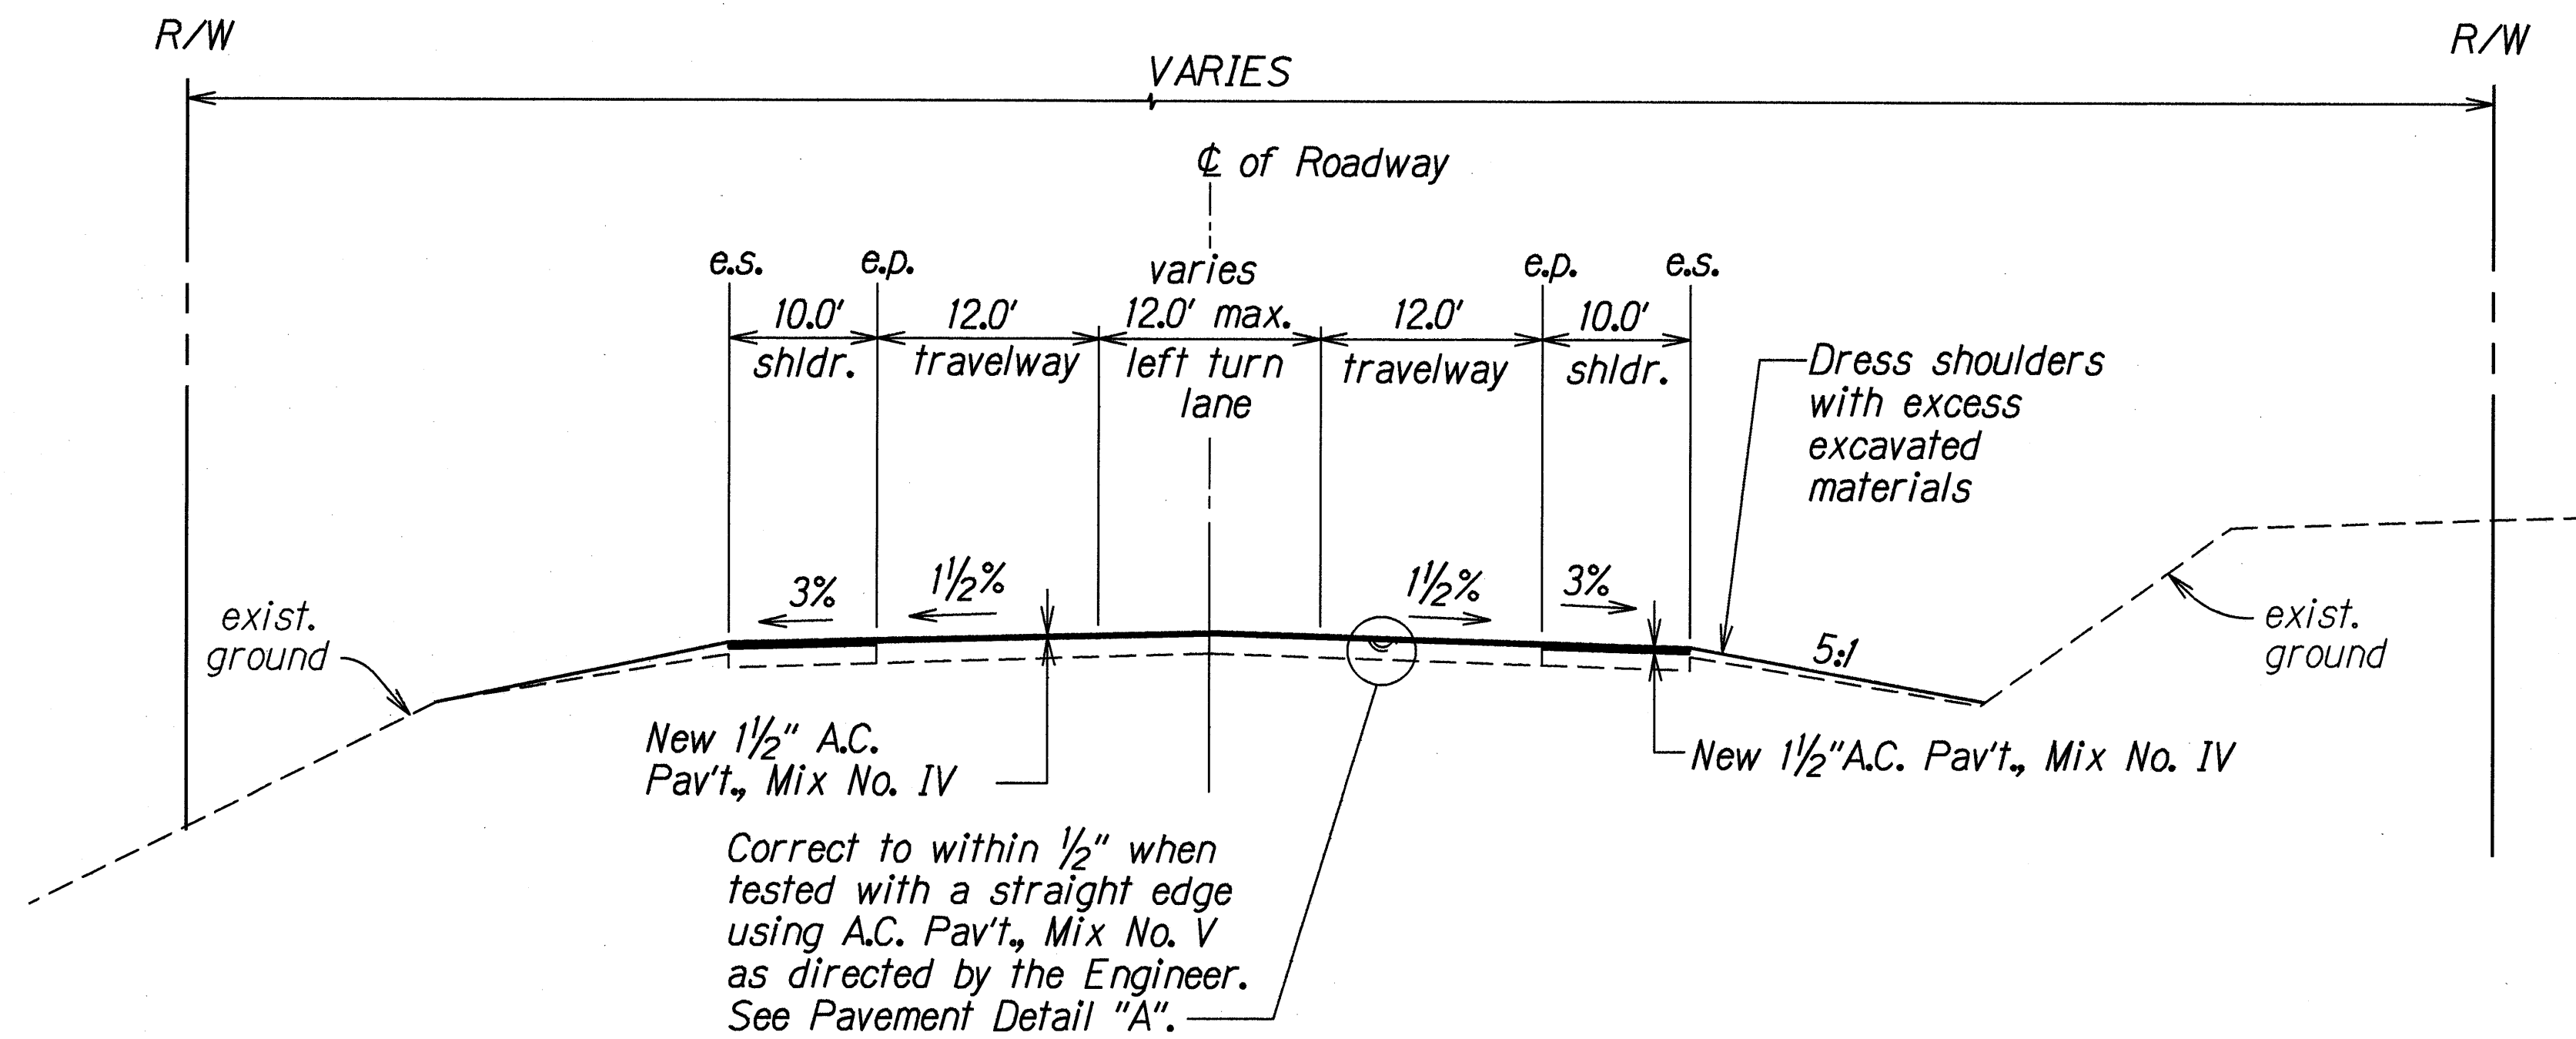


TYPICAL SECTION
Not To Scale

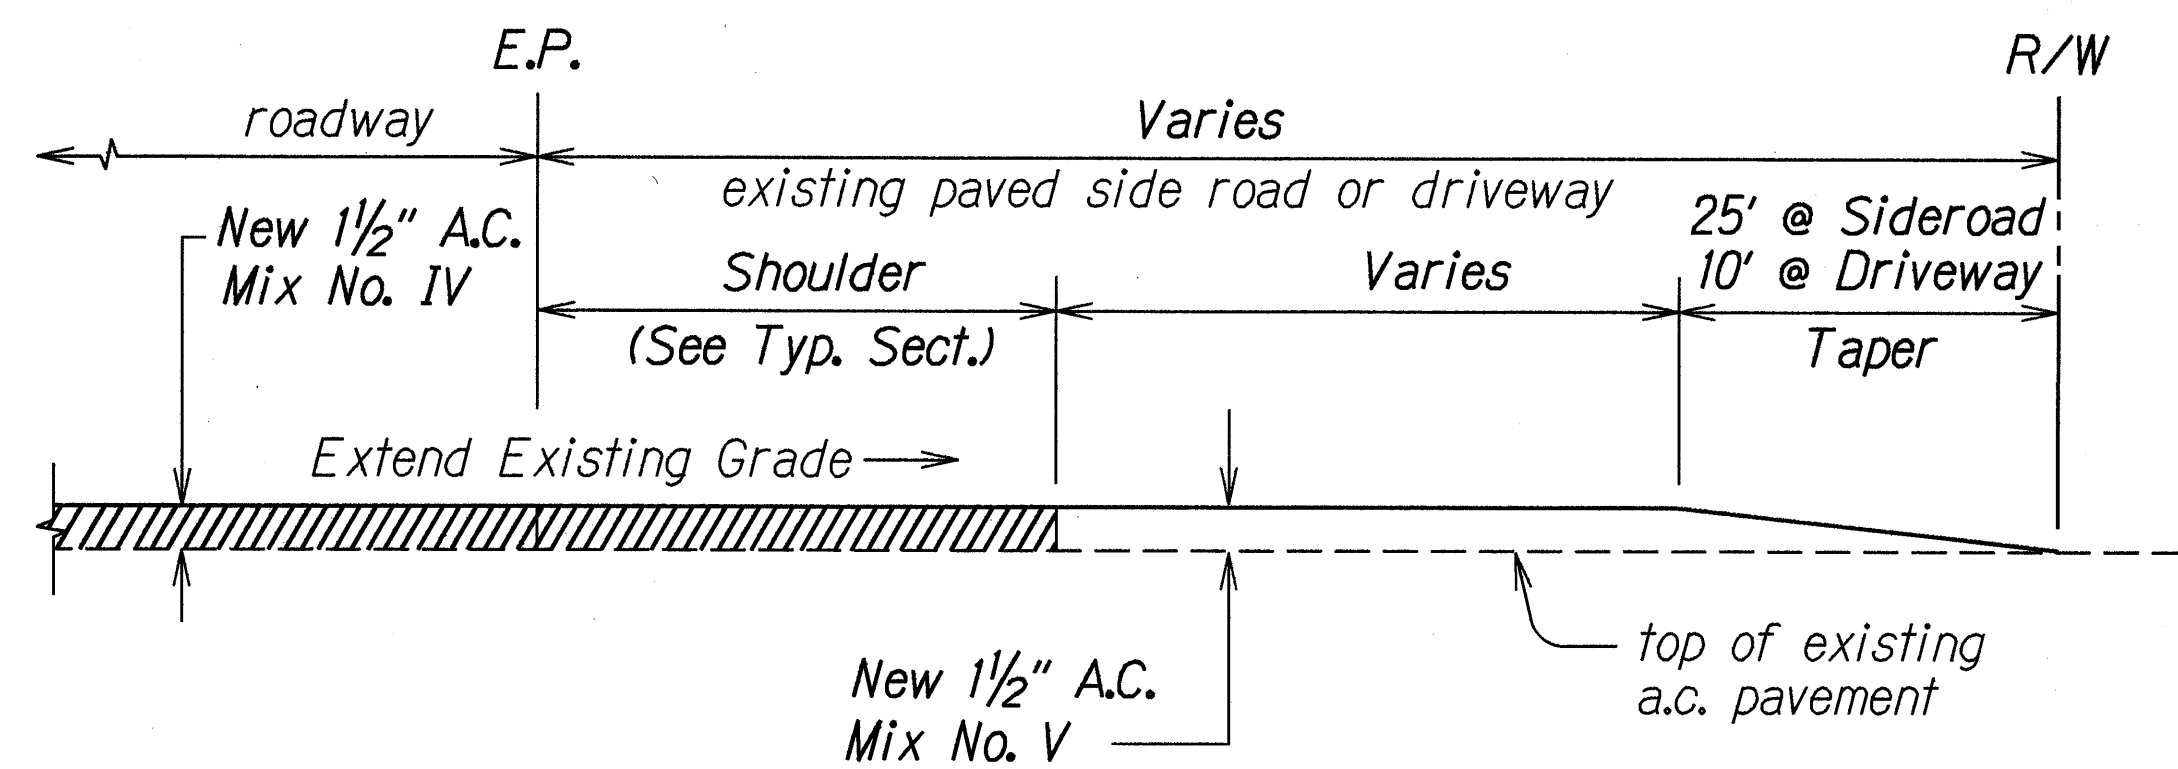

**A. C. RESURFACING AT PAVED SIDEROAD
OR PAVED DRIVEWAY DETAIL**
Not To Scale

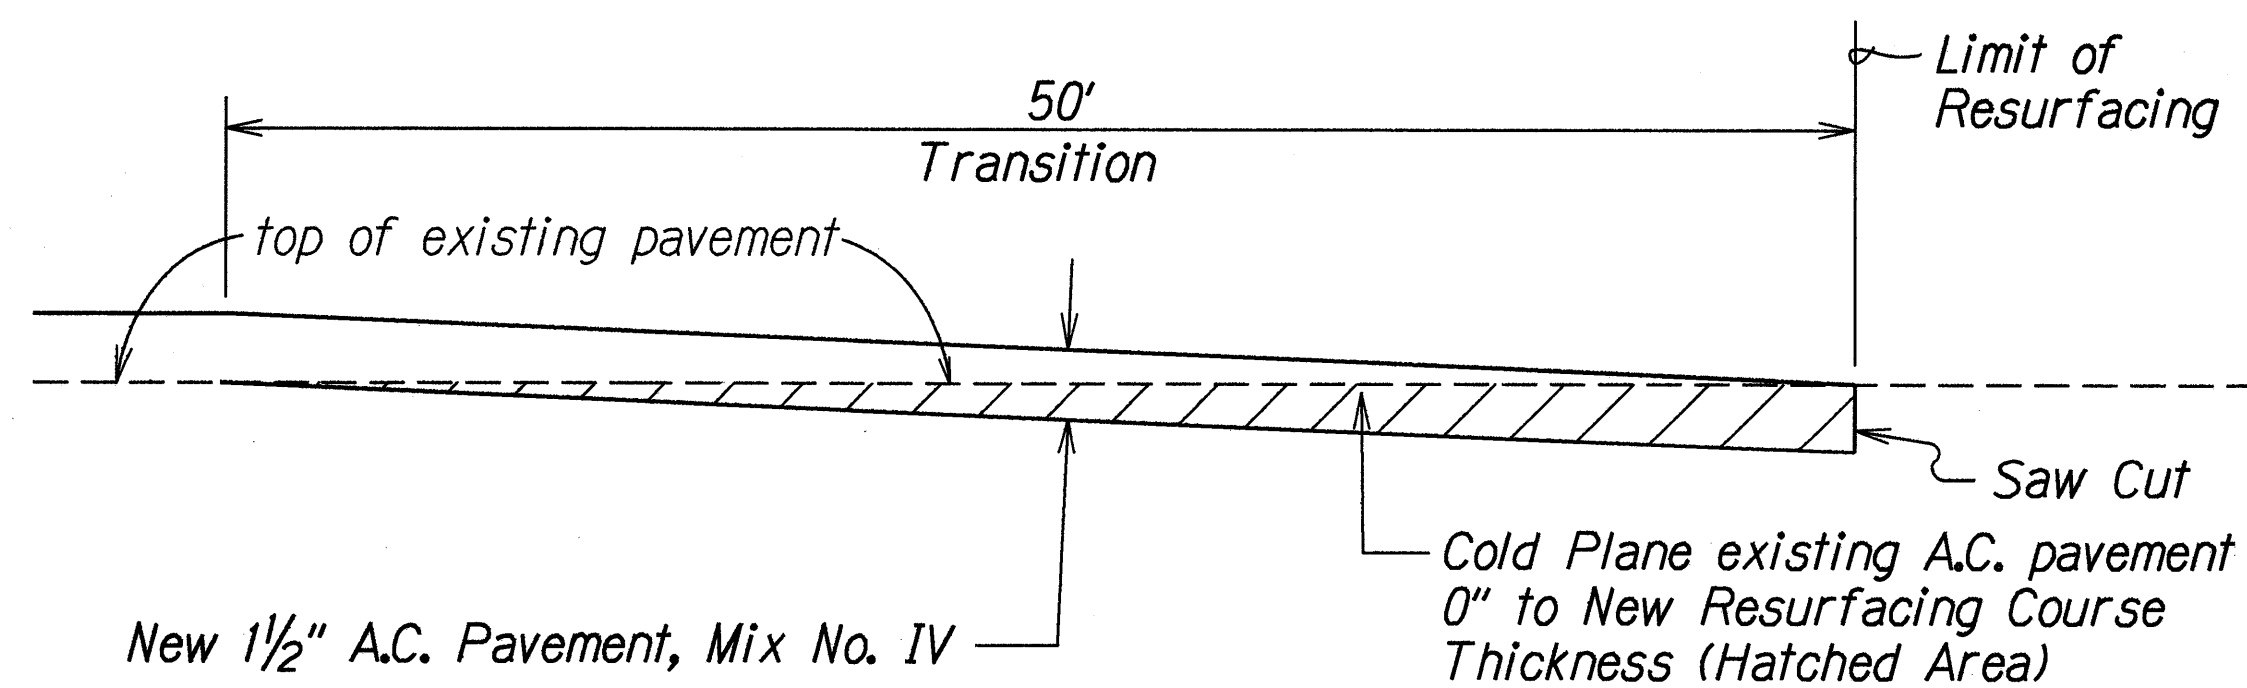

**COLD PLANED TRANSITION
AT BEGINNING AND END OF PROJECT**
Not To Scale

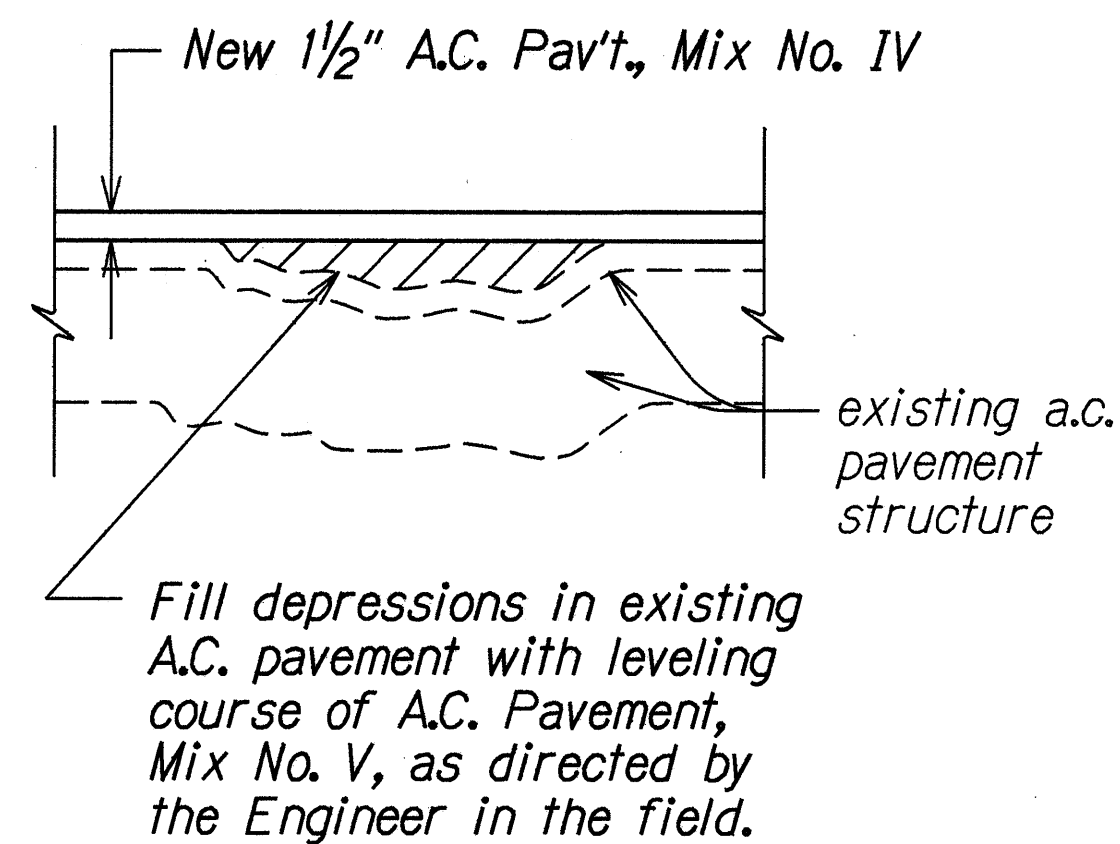

PAVEMENT DETAIL "A"
Not To Scale

ORIGINAL PLAN	DATE	6/12/97
SURVEY PLOTTED BY		
DRAWN BY		
DESIGNED BY		
CHECKED BY		
NOTED BY		
INCHES		
FEET		
SCALE		

6-12-97	Deleted Pavement Detail "B" per Addendum No. 1.
DATE	REVISION

STATE OF HAWAII DEPARTMENT OF TRANSPORTATION HIGHWAYS DIVISION
TYPICAL SECTION
QUEEN KA'AHUMANU HIGHWAY RESURFACING PALANI ROAD TO HONOKOHAU HARBOR PROJECT NO. 19A-01-97M
Scale: As Shown Date: May, 1997
SHEET No. 1 OF 1 SHEETS