INDEX TO DRAWINGS	
SHEET NO.	DESCRIPTION
1	TITLE SHEET
2	STANDARD PLANS SUMMARY
3	TYPICAL SECTION AND NOTES
4	ROADWAY PLAN

STATE OF HAWAII

DEPARTMENT OF TRANSPORTATION

HIGHWAYS DIVISION HONOLULU, HAWAII


"AS-BUILT"

PLANS FOR

HAWAII BELT ROAD EMERGENCY SLOPE STABILIZATION

VICINITY OF KAAWALII GULCH PROJECT NO. 19H-01-97M

DISTRICT OF NORTH HILO ISLAND OF HAWAI'I

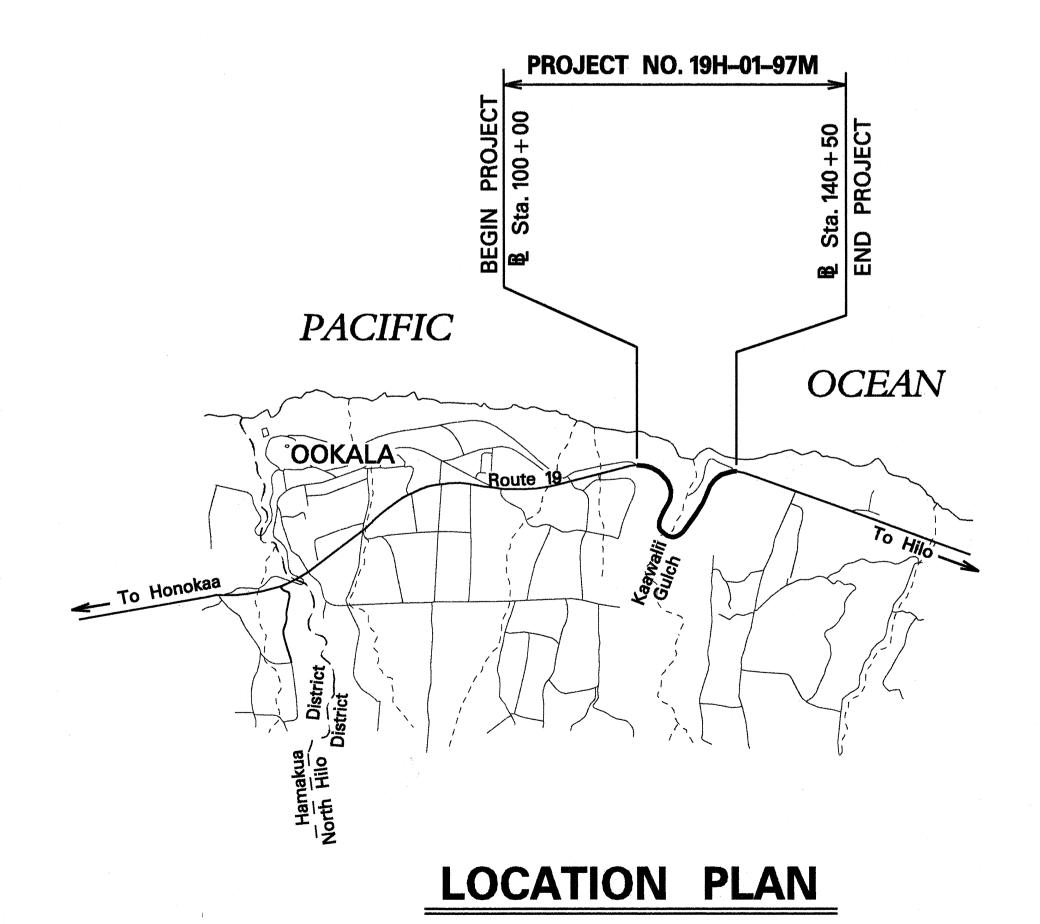

LENGTH OF PROJECT..... 0.77 MILES

STATE OF HAWAI'I Wai'ōhinu Ka Lae (South Point) ---- FEDERAL AID PROJECTS PREVIOUSLY CONSTRUCTED OR UNDER CONSTRUCTION

MILE POST 28.83 TO MILE POST 28.06

CHANGES MADE DURING CONSTRUCTION HAVE BEEN INCORPORATED ON THESE PLANS EXCEPT CHANGES IN THE ORIGINAL THEORETICAL QUANTITIES.

PROJECT ENGINEER 23 SEPTEMBER 1998

DATE

(11)

DEPARTMENT OF TRANSPORTATION STATE OF HAWAII

APPROVED:

Liza Granbill 5/20/08

DIR. OF TRANSPORTATION DATE

2 0 2 4

SCALE IN THOUSAND FEET

FISCAL YEAR