


FED. ROAD DIST. NO.	STATE	PROJ. NO.	FISCAL YEAR	SHEET NO.	TOTAL SHEETS
HAWAII	HAW.	19K-01-97M	1997	4	10

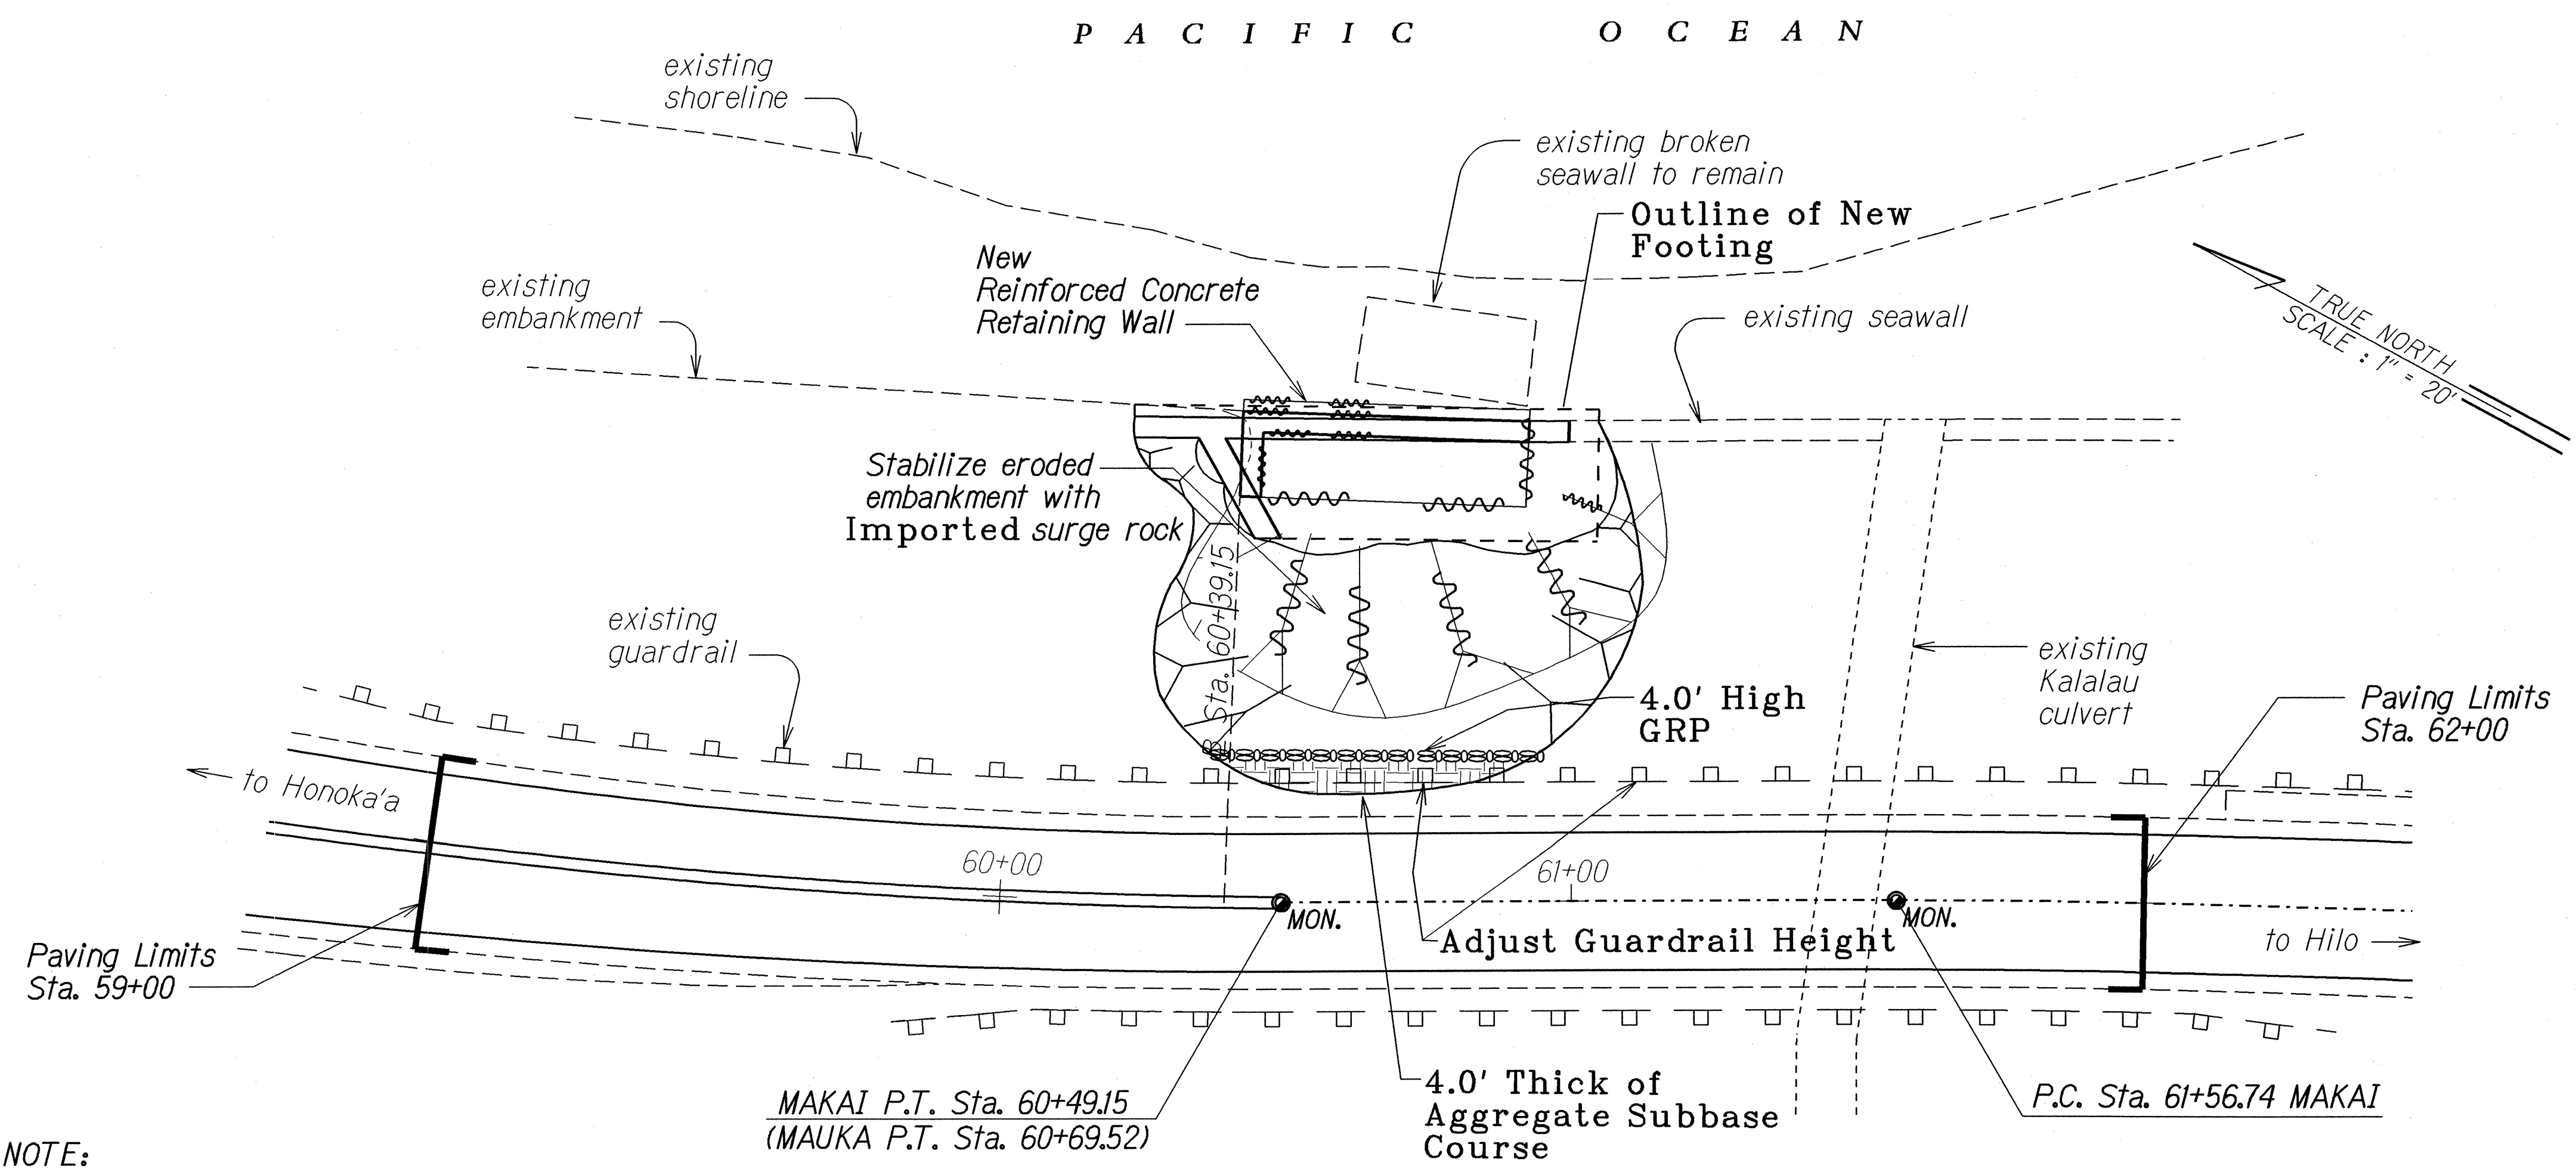

NOTE:  
1. Stations are referenced to Makai Baseline.

SITE PLAN  
Scale: 1" = 20'

LEGEND FOR AS-BUILT POSTINGS	
	Squiggly line for as-built deletion
	Double line for as-built deletion
Roadway	Text for as-built posting

STATE OF HAWAII  
DEPARTMENT OF TRANSPORTATION  
HIGHWAYS DIVISION

**PLANS AND ELEVATIONS**  
HAWAII BELT ROAD,  
Emergency Repair To Seawall & Embankment,  
Vicinity Of Kalalau Stream  
Project No. 19K-01-97M  
Scale: As Noted      Date: May, 1997

SHEET No. 1 OF 1 SHEETS

ORIGINAL PLAN	SURVEY PLOTTED BY	DATE
	TRACED BY	5/12/97
NOTE BOOK	DESIGNED BY	5/28/97
	QUANTITIES BY	
	CHECKED BY	

"AS-BUILT"