

INDEX TO DRAWINGS	
SHEET NO.	DESCRIPTION
1	TITLE SHEET
2	STANDARD PLANS SUMMARY
3	GENERAL NOTES
4	PLANS AND ELEVATIONS
5	LAYOUT PLAN AND ELEVATION GENERAL AND STRUCTURAL NOTES
6	TYPICAL MAIN WALL AND SIDE WALL SECTIONS
7	FOOTING REINFORCING ARRANGEMENT
8	MAIN WALL REINFORCING ARRANGEMENT
⑩ 9	TYPICAL CROSS SECTIONS
10	CONSTRUCTION SIGN PLAN AND SCHEDULE

Sheet No. ⑩ 9S-1 is a supplementary sheet to this project. Total sheet count after "As-Built" Posting 11 sheets.

STATE OF HAWAI'I

DEPARTMENT OF TRANSPORTATION

HIGHWAYS DIVISION

HONOLULU, HAWAI'I

"AS-BUILT"

PLANS FOR

HAWAII BELT ROAD,

EMERGENCY REPAIR TO


SEAWALL AND EMBANKMENT,

VICINITY OF KALALAU STREAM

PROJECT NO. 19K-01-97M

DISTRICT OF SOUTH HILO

ISLAND OF HAWAI'I



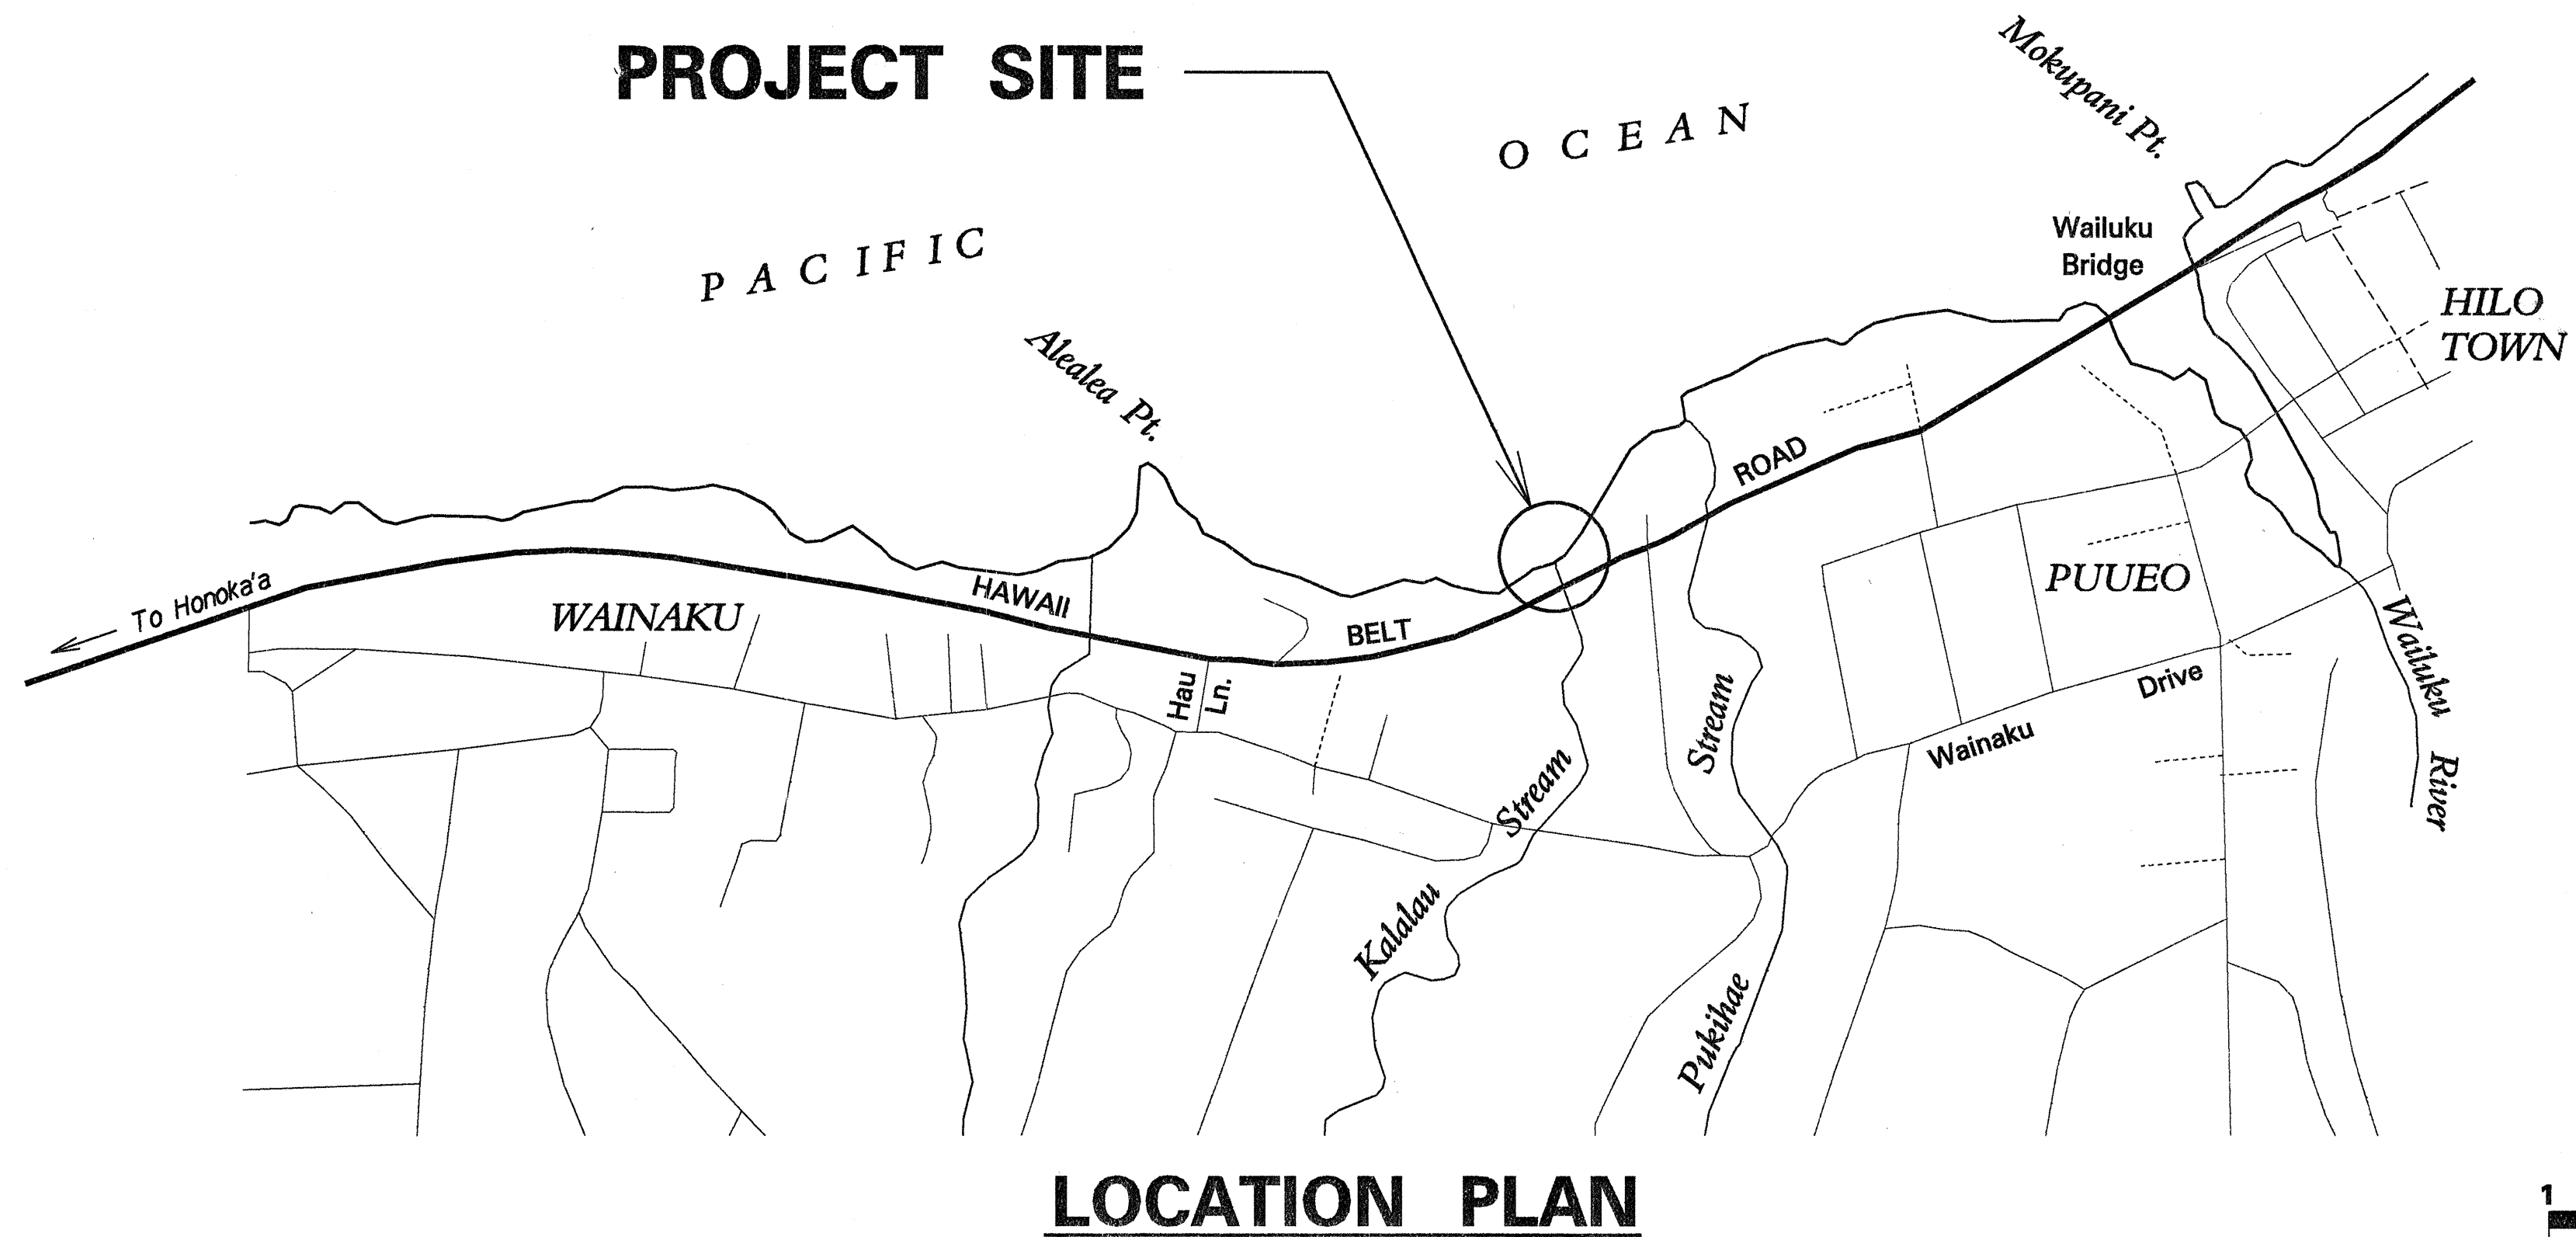


LOCATION PLAN

GROSS LENGTH OF PROJECT 0.06 MILES

NET LENGTH OF PROJECT 0.06 MILES

FED. ROAD DIST. NO.	STATE	PROJ. NO.	FISCAL YEAR	SHEET NO.	TOTAL SHEETS
HAWAI'I	HAW.	19K-01-97M	1997	1	10

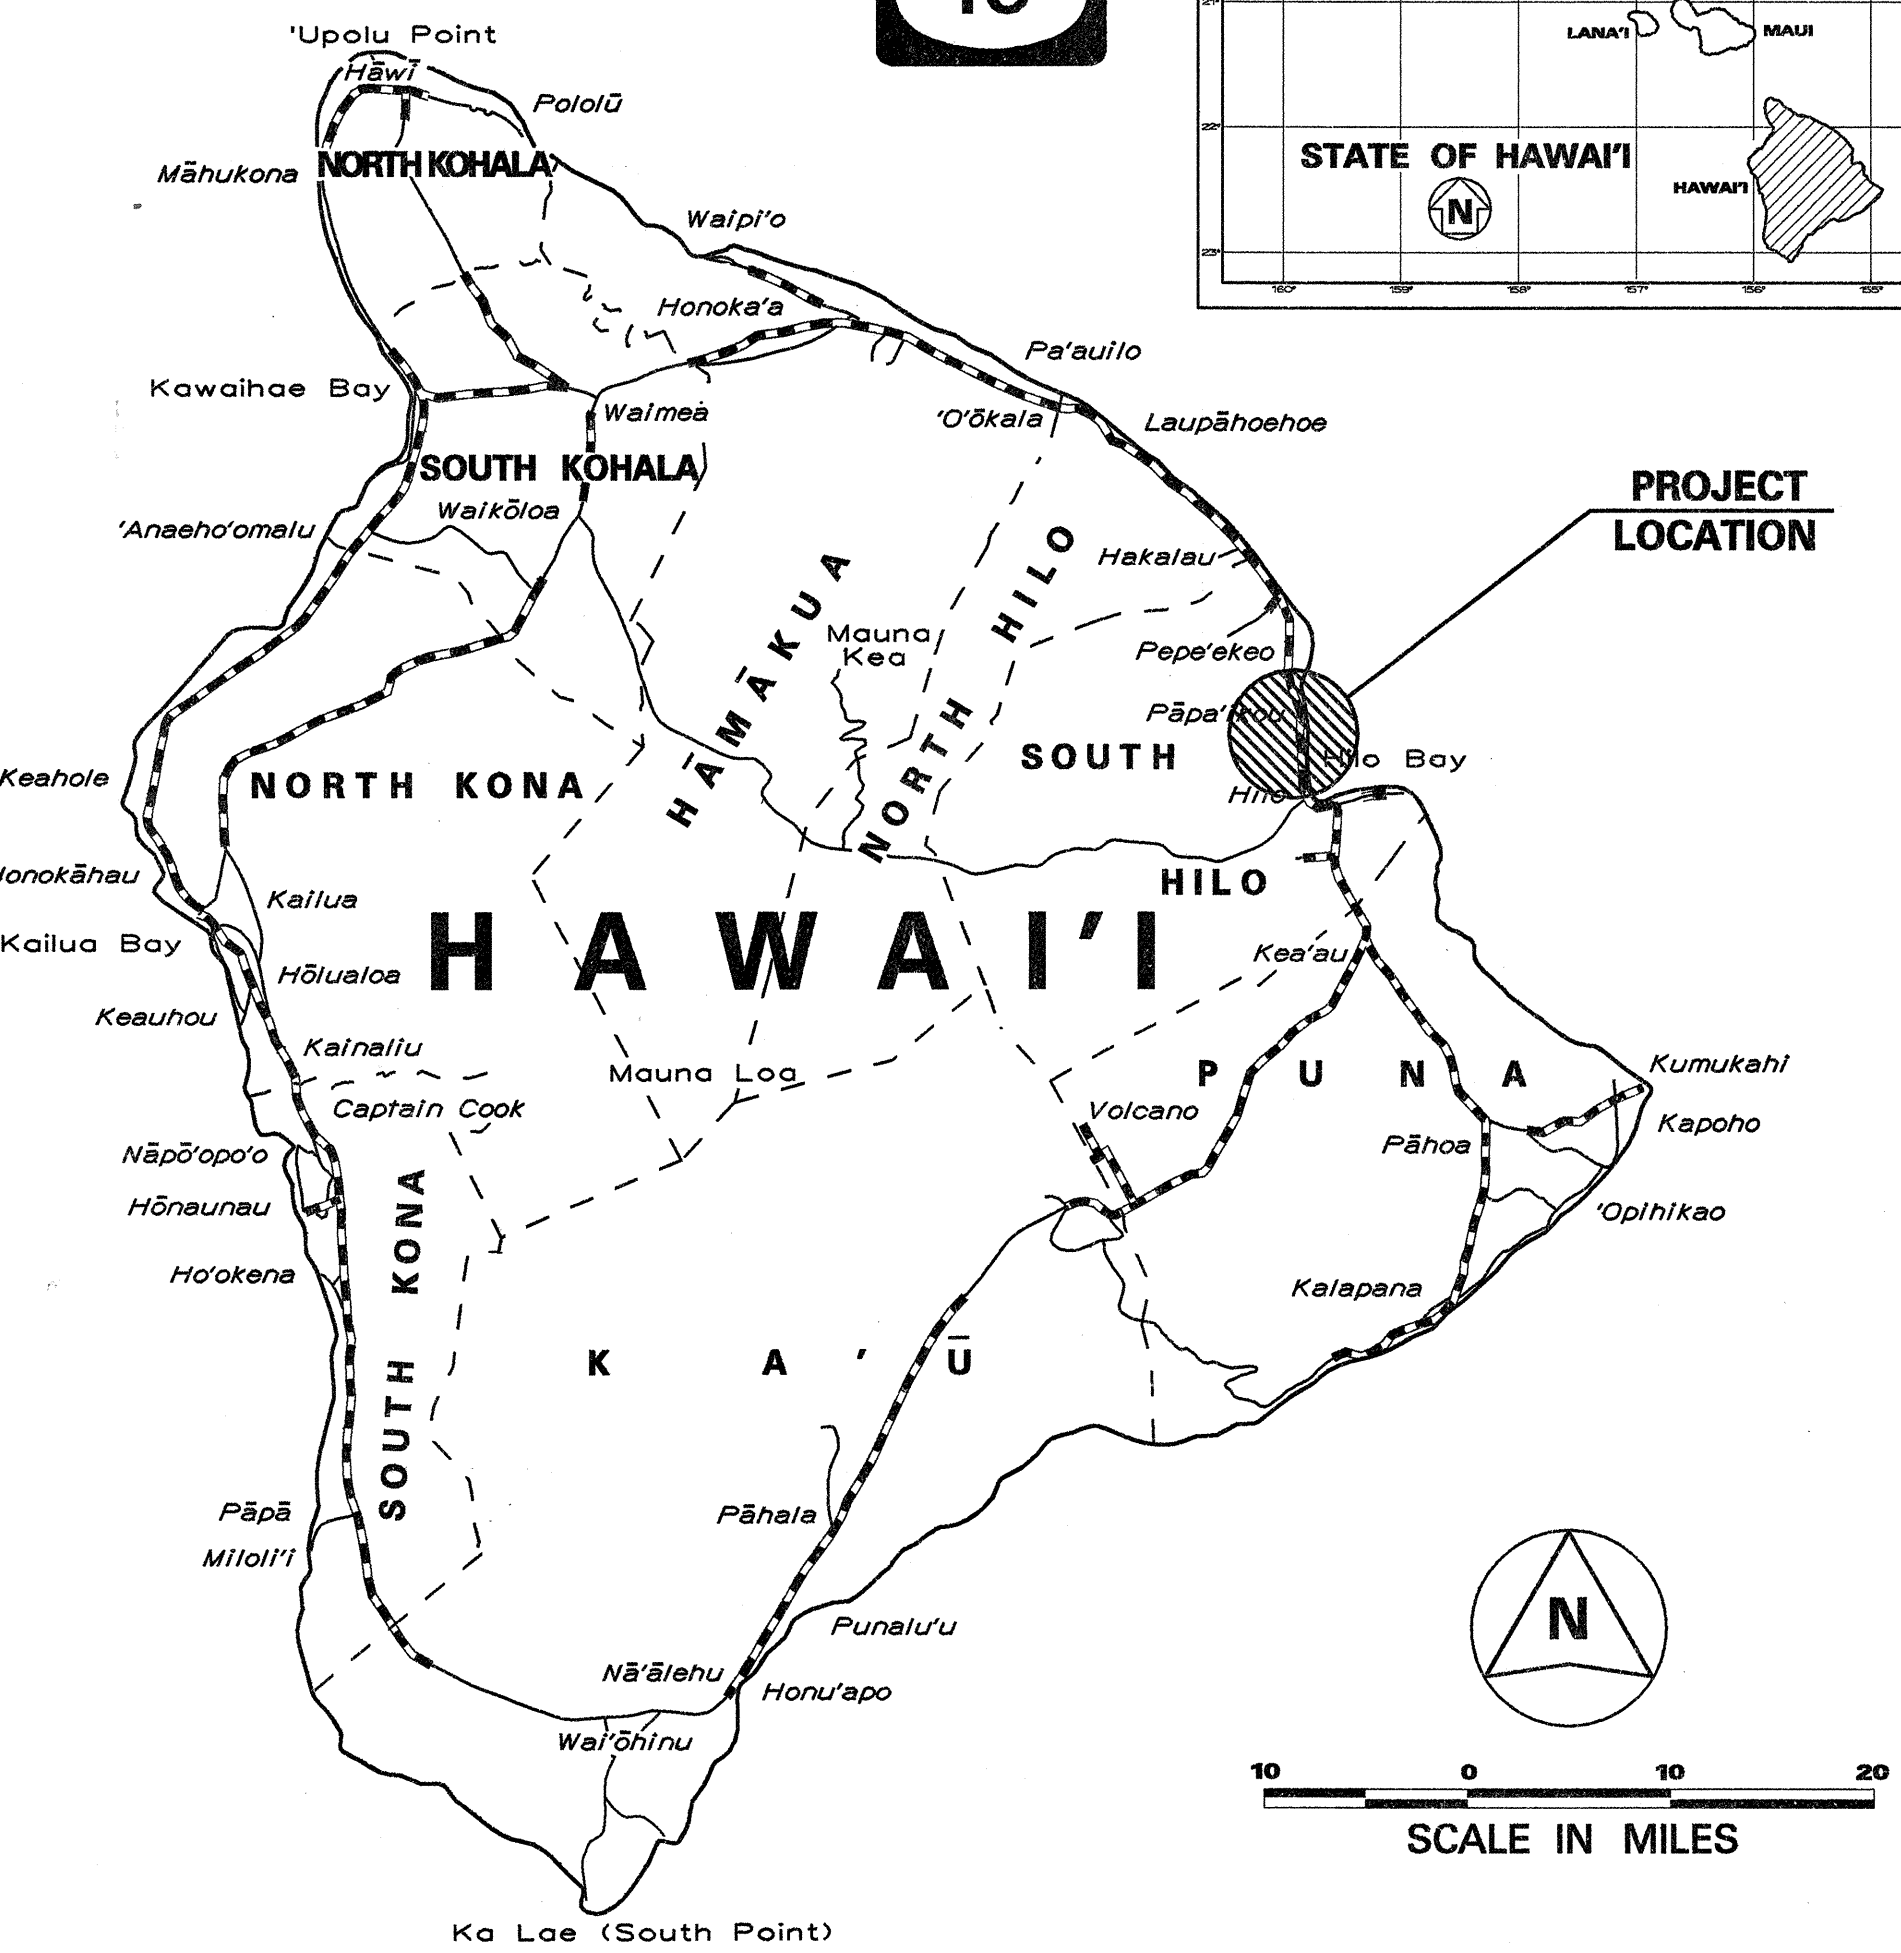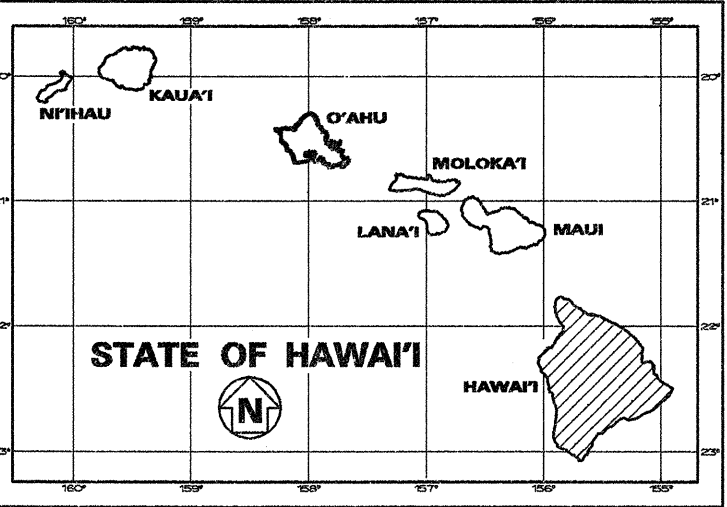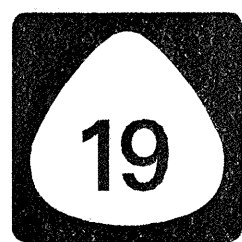

FEDERAL AID PROJECTS PREVIOUSLY CONSTRUCTED OR UNDER CONSTRUCTION

MILE POST 3.20 TO MILE POST 3.26

CHANGES MADE DURING CONSTRUCTION HAVE BEEN INCORPORATED ON THESE PLANS EXCEPT CHANGES IN THE ORIGINAL THEORETICAL QUANTITIES. FOR ACTUAL QUANTITIES, REFER TO PROJECT LEDGER AND/OR CONSTRUCTION BOOK.

RESIDENT ENGINEER DATE

DEPARTMENT OF TRANSPORTATION

STATE OF HAWAII

APPROVED: *Raymond B. Fronda* 5/28/97

DIR. OF TRANSPORTATION DATE

HAWAII DISTRICT DESIGNED BY JULIUS B. FRONDA P. S. & E. BY MAY, 1997 DATE 587-2246 PHONE