
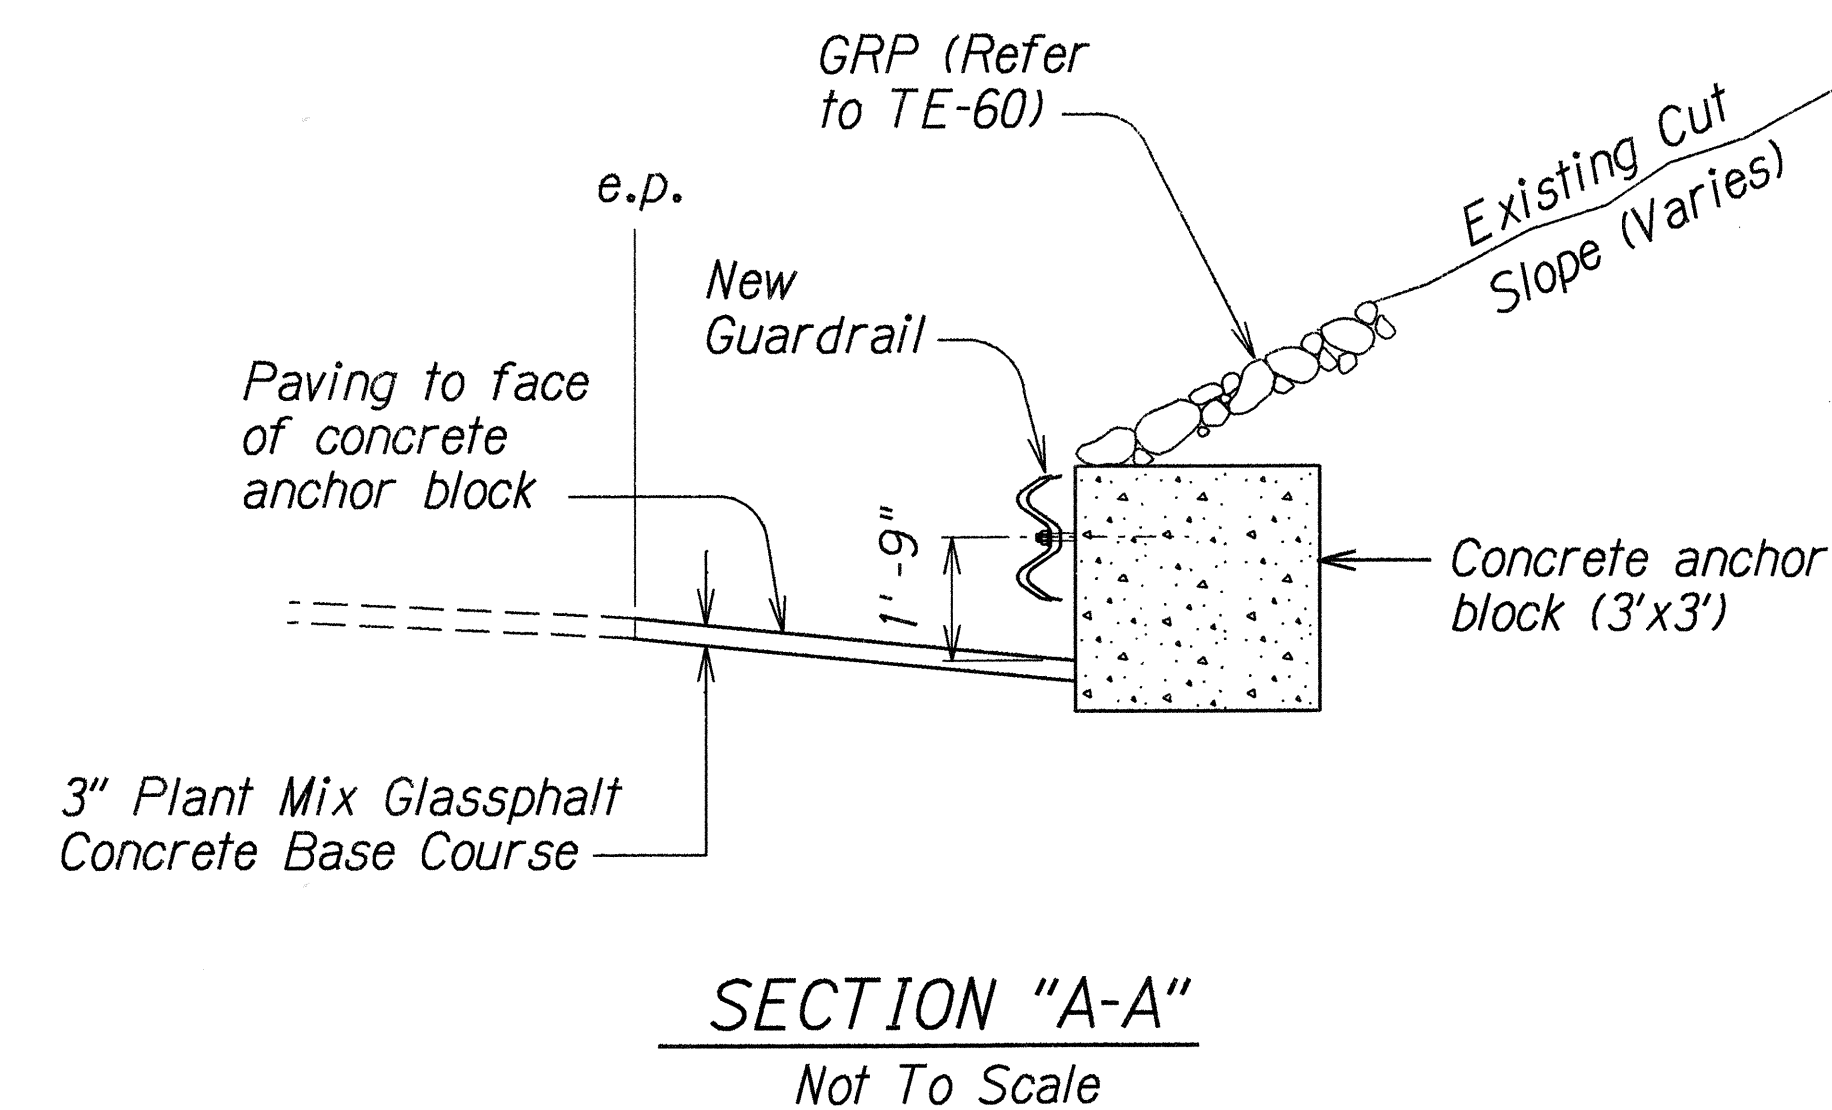
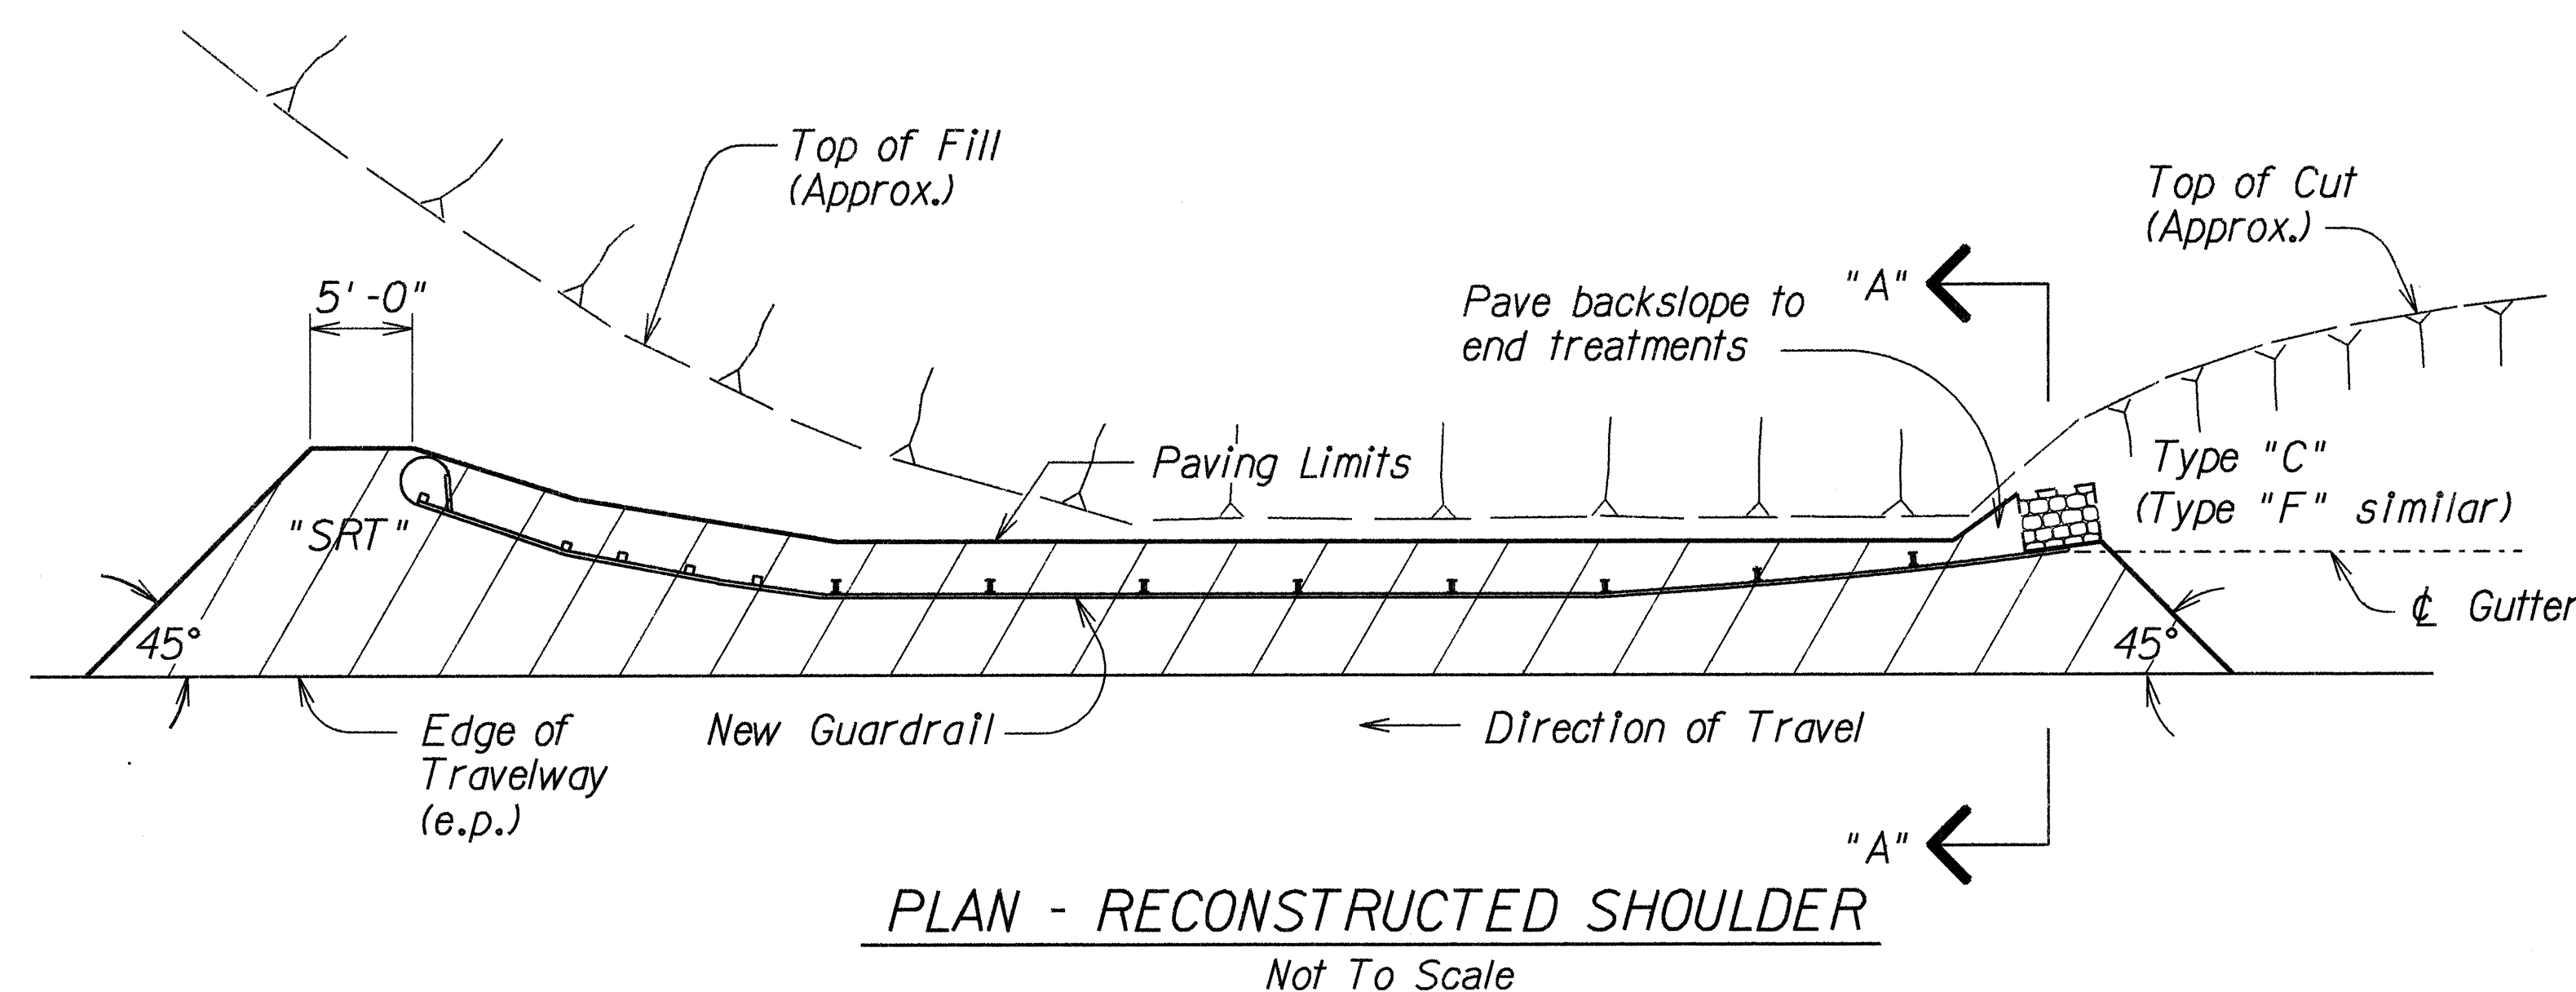
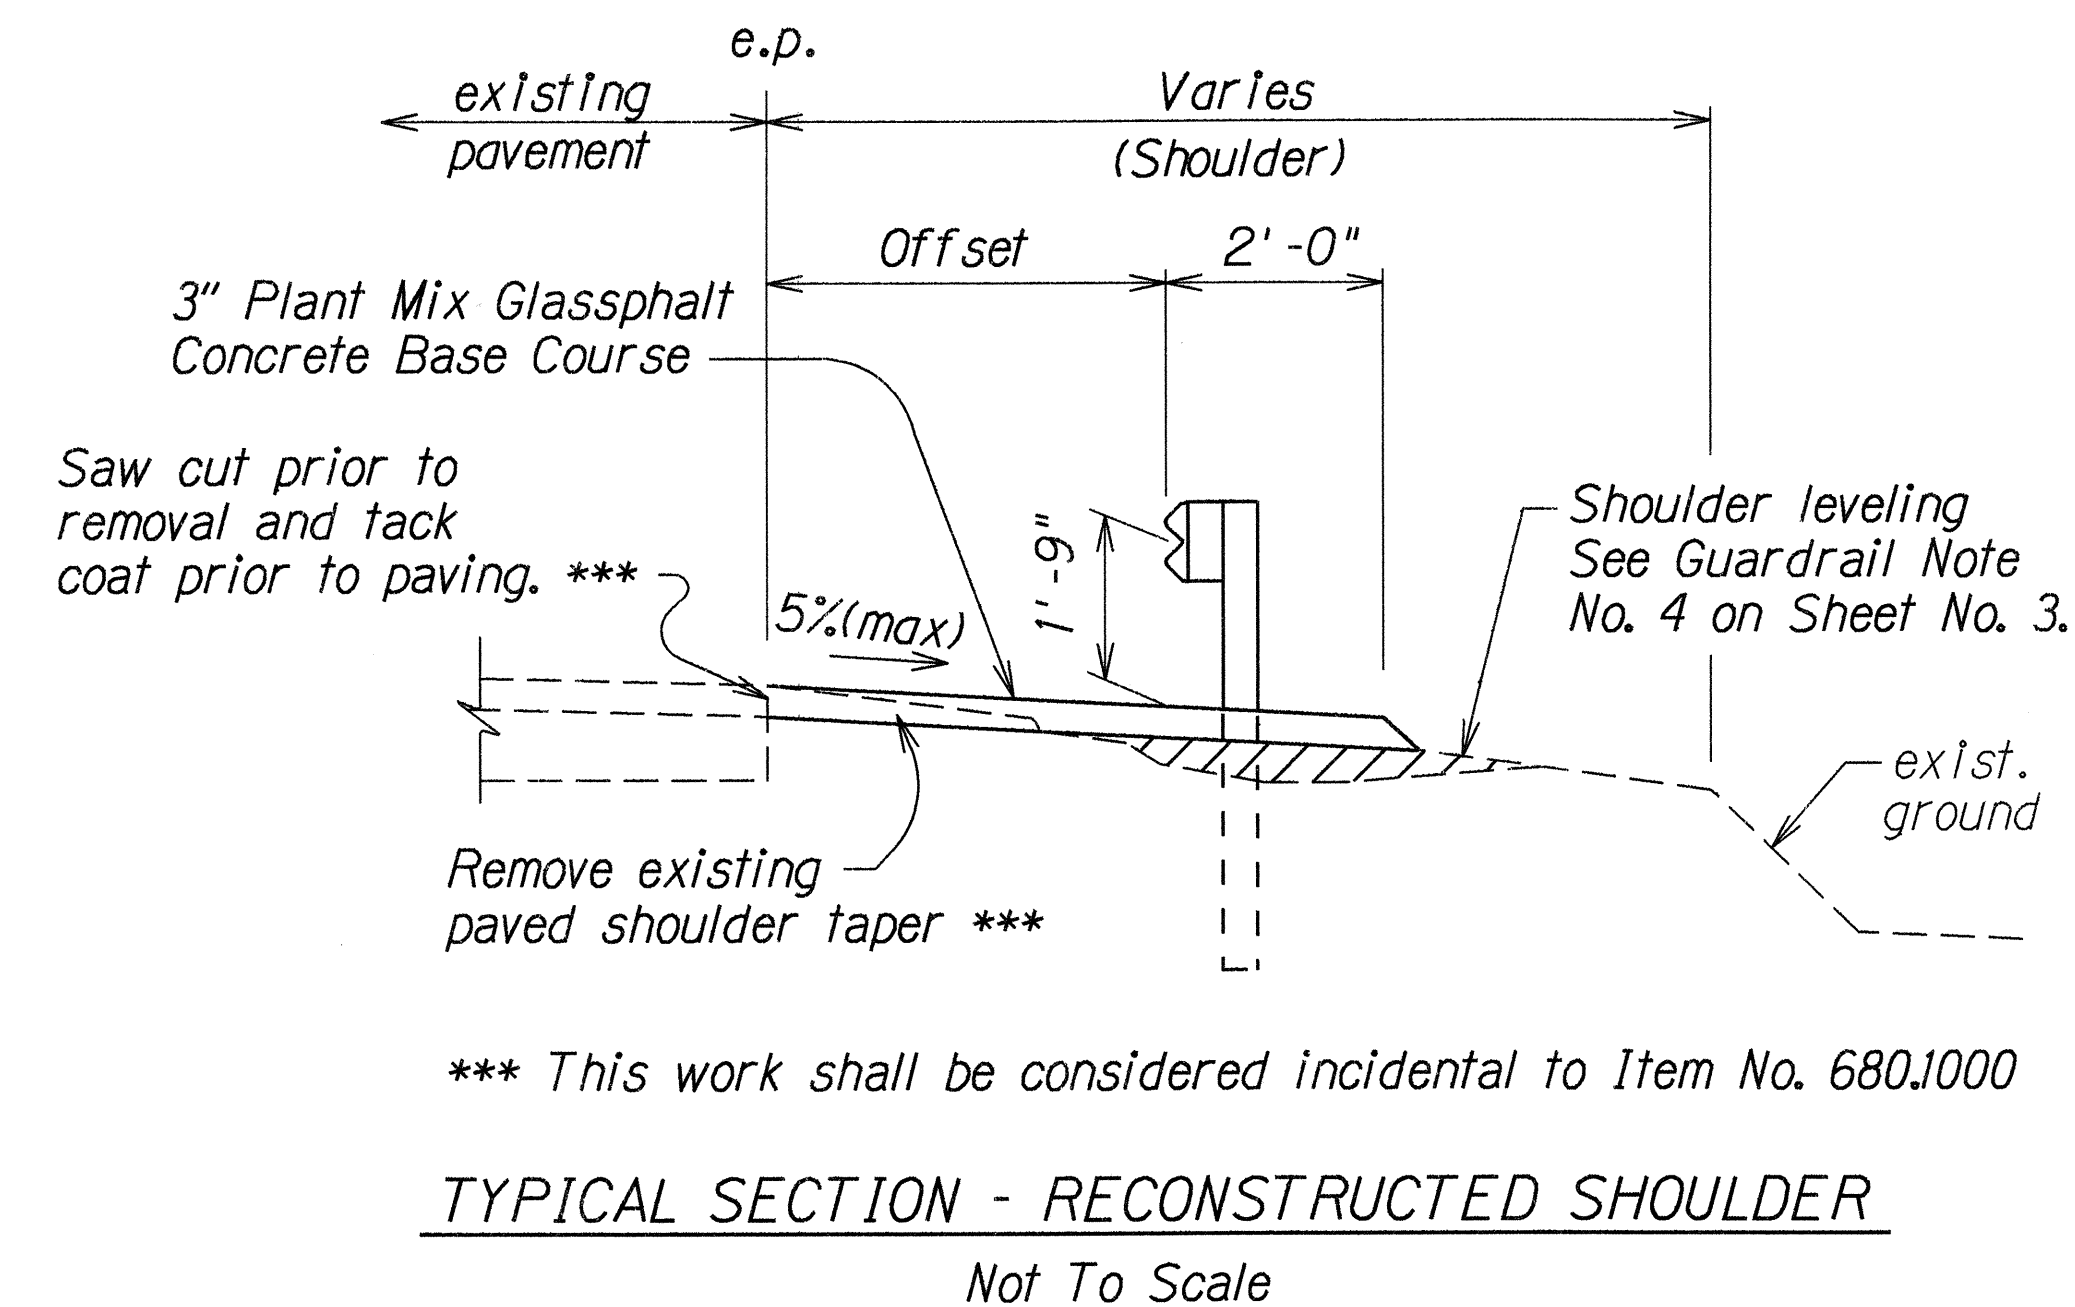


FED. ROAD DIST.	STATE	FED. AID PROJ. NO.	FISCAL YEAR	SHEET NO.	TOTAL SHEETS
HAWAII	HAW.	STP-019-1(25)	1997	4	13

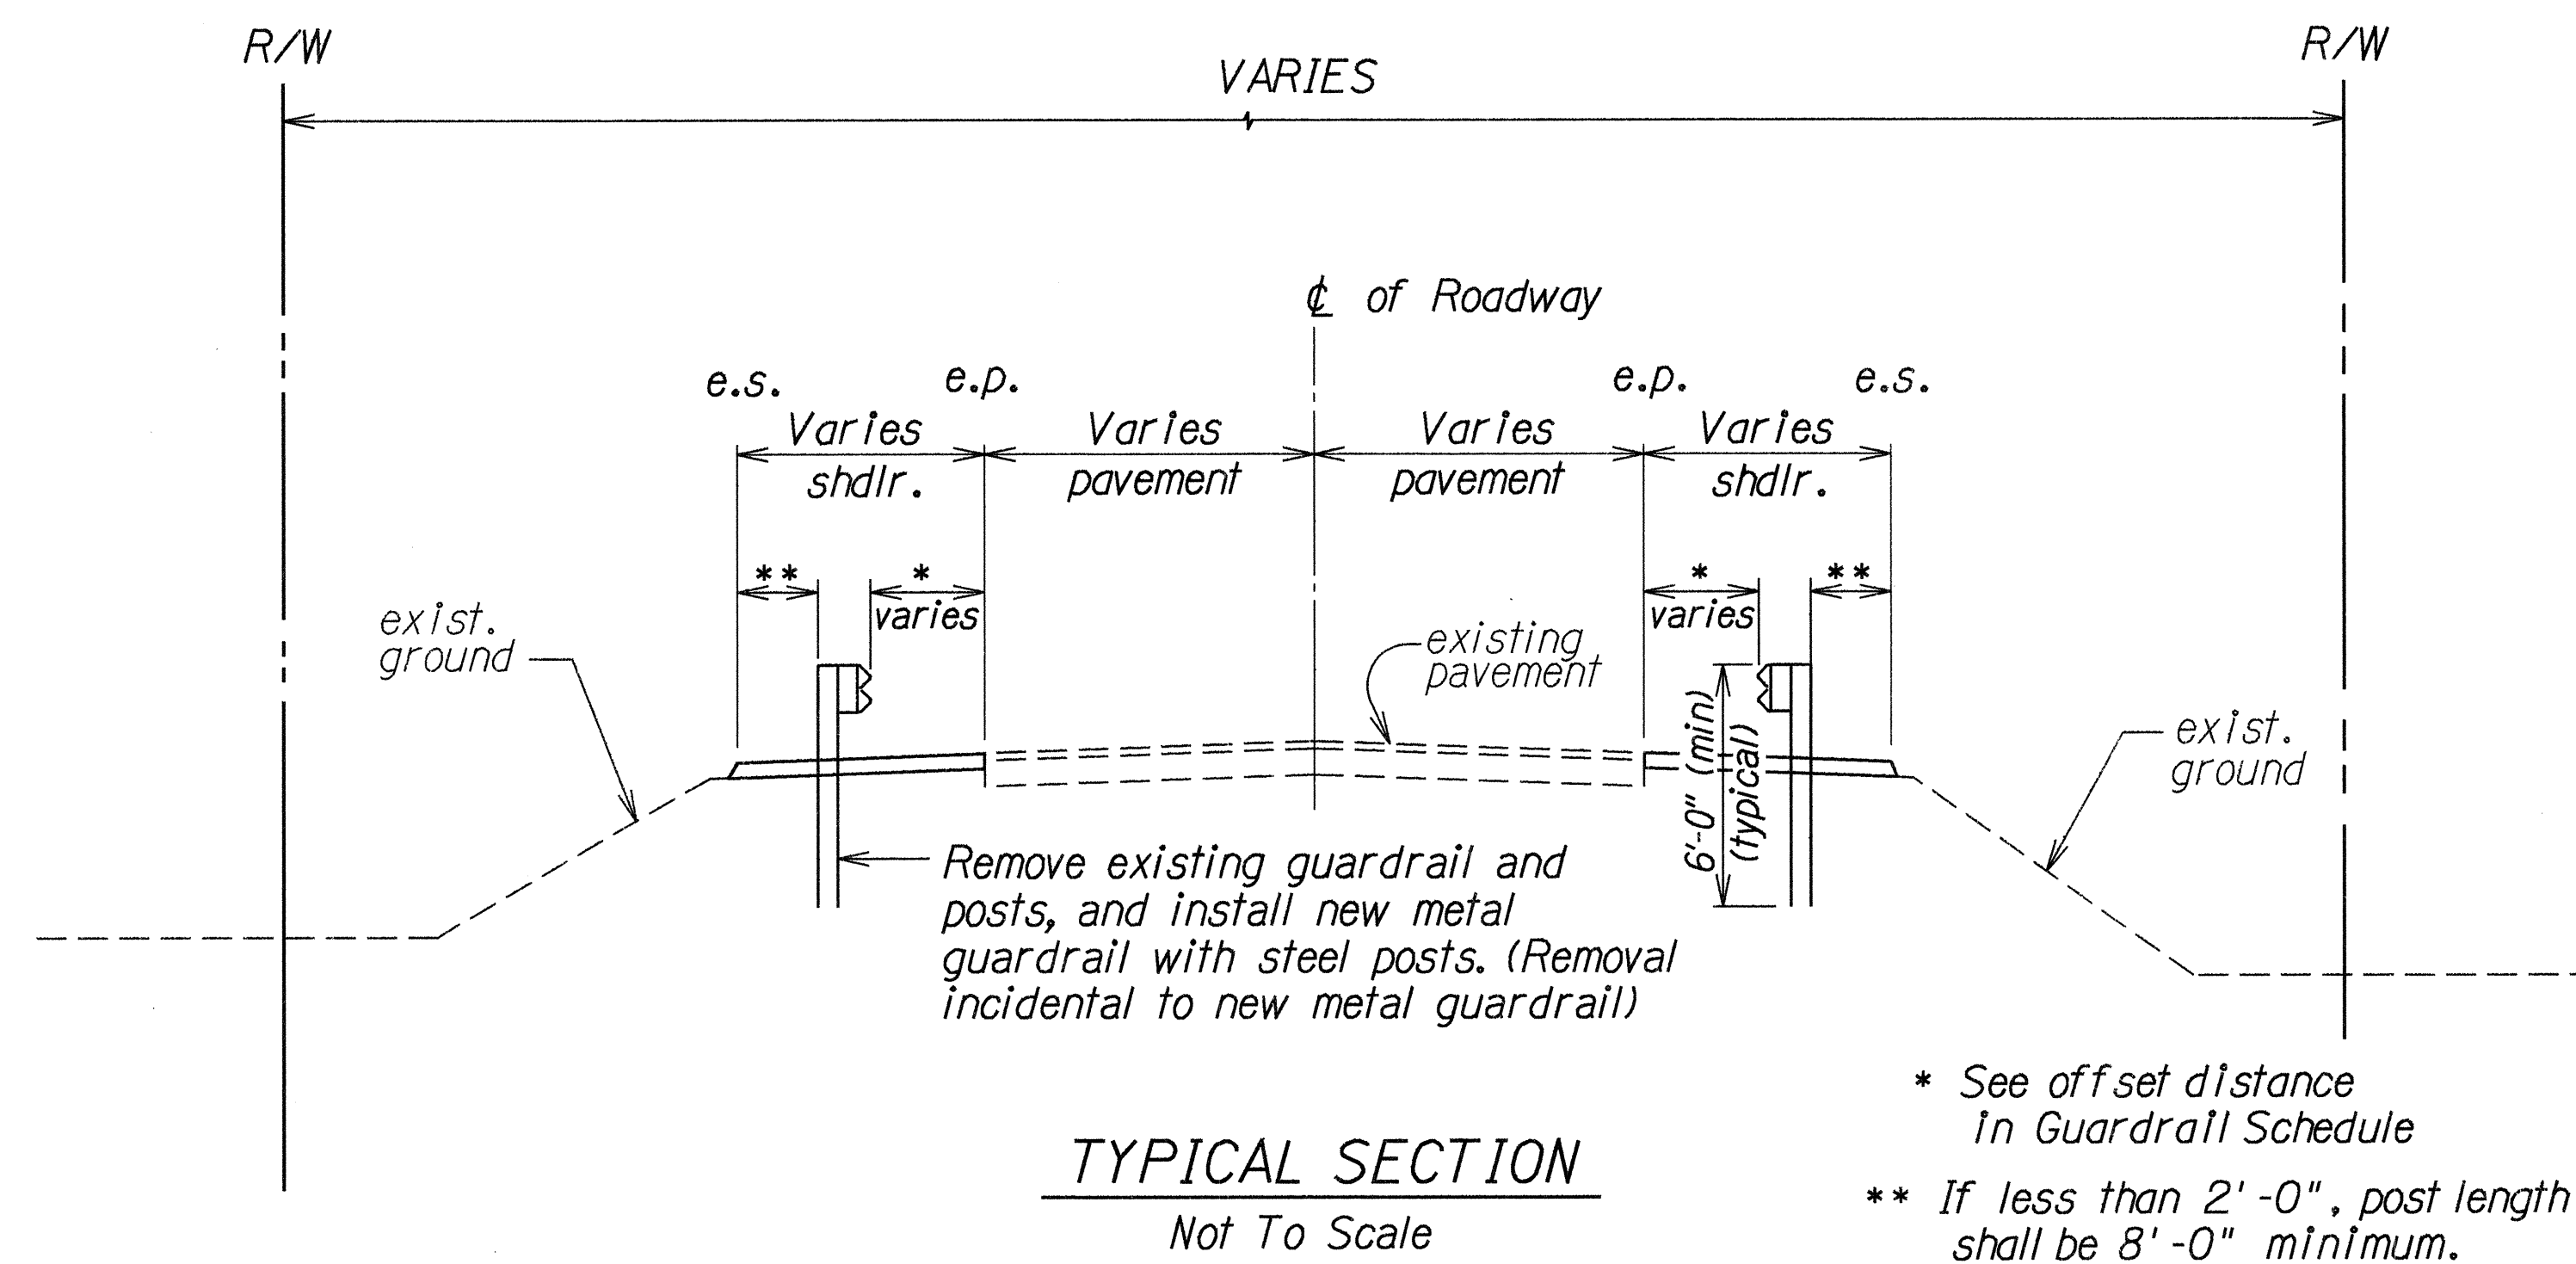

SURVEY PLOTTED BY	DATE
DRAWN BY	
DESIGNED BY	
QUANTITIES BY	
CHECKED BY	

STATE OF HAWAII
DEPARTMENT OF TRANSPORTATION
HIGHWAYS DIVISION

TYPICAL SECTION

GUARDRAIL AND SHOULDER IMPROVEMENTS,
HAWAII BELT ROAD, HONOKAA TO WAIMEA
F.A. PROJECT NO. STP-019-1(25)

Scale: As Shown
Date: Sept., 1996

SHEET No. 1 OF 1 SHEETS