


FED. ROAD DIST. NO.	STATE	PROJ. NO.	FISCAL YEAR	SHEET NO.	TOTAL SHEETS
HAWAII	HAW.	19CD-01-97M	1997	18	39

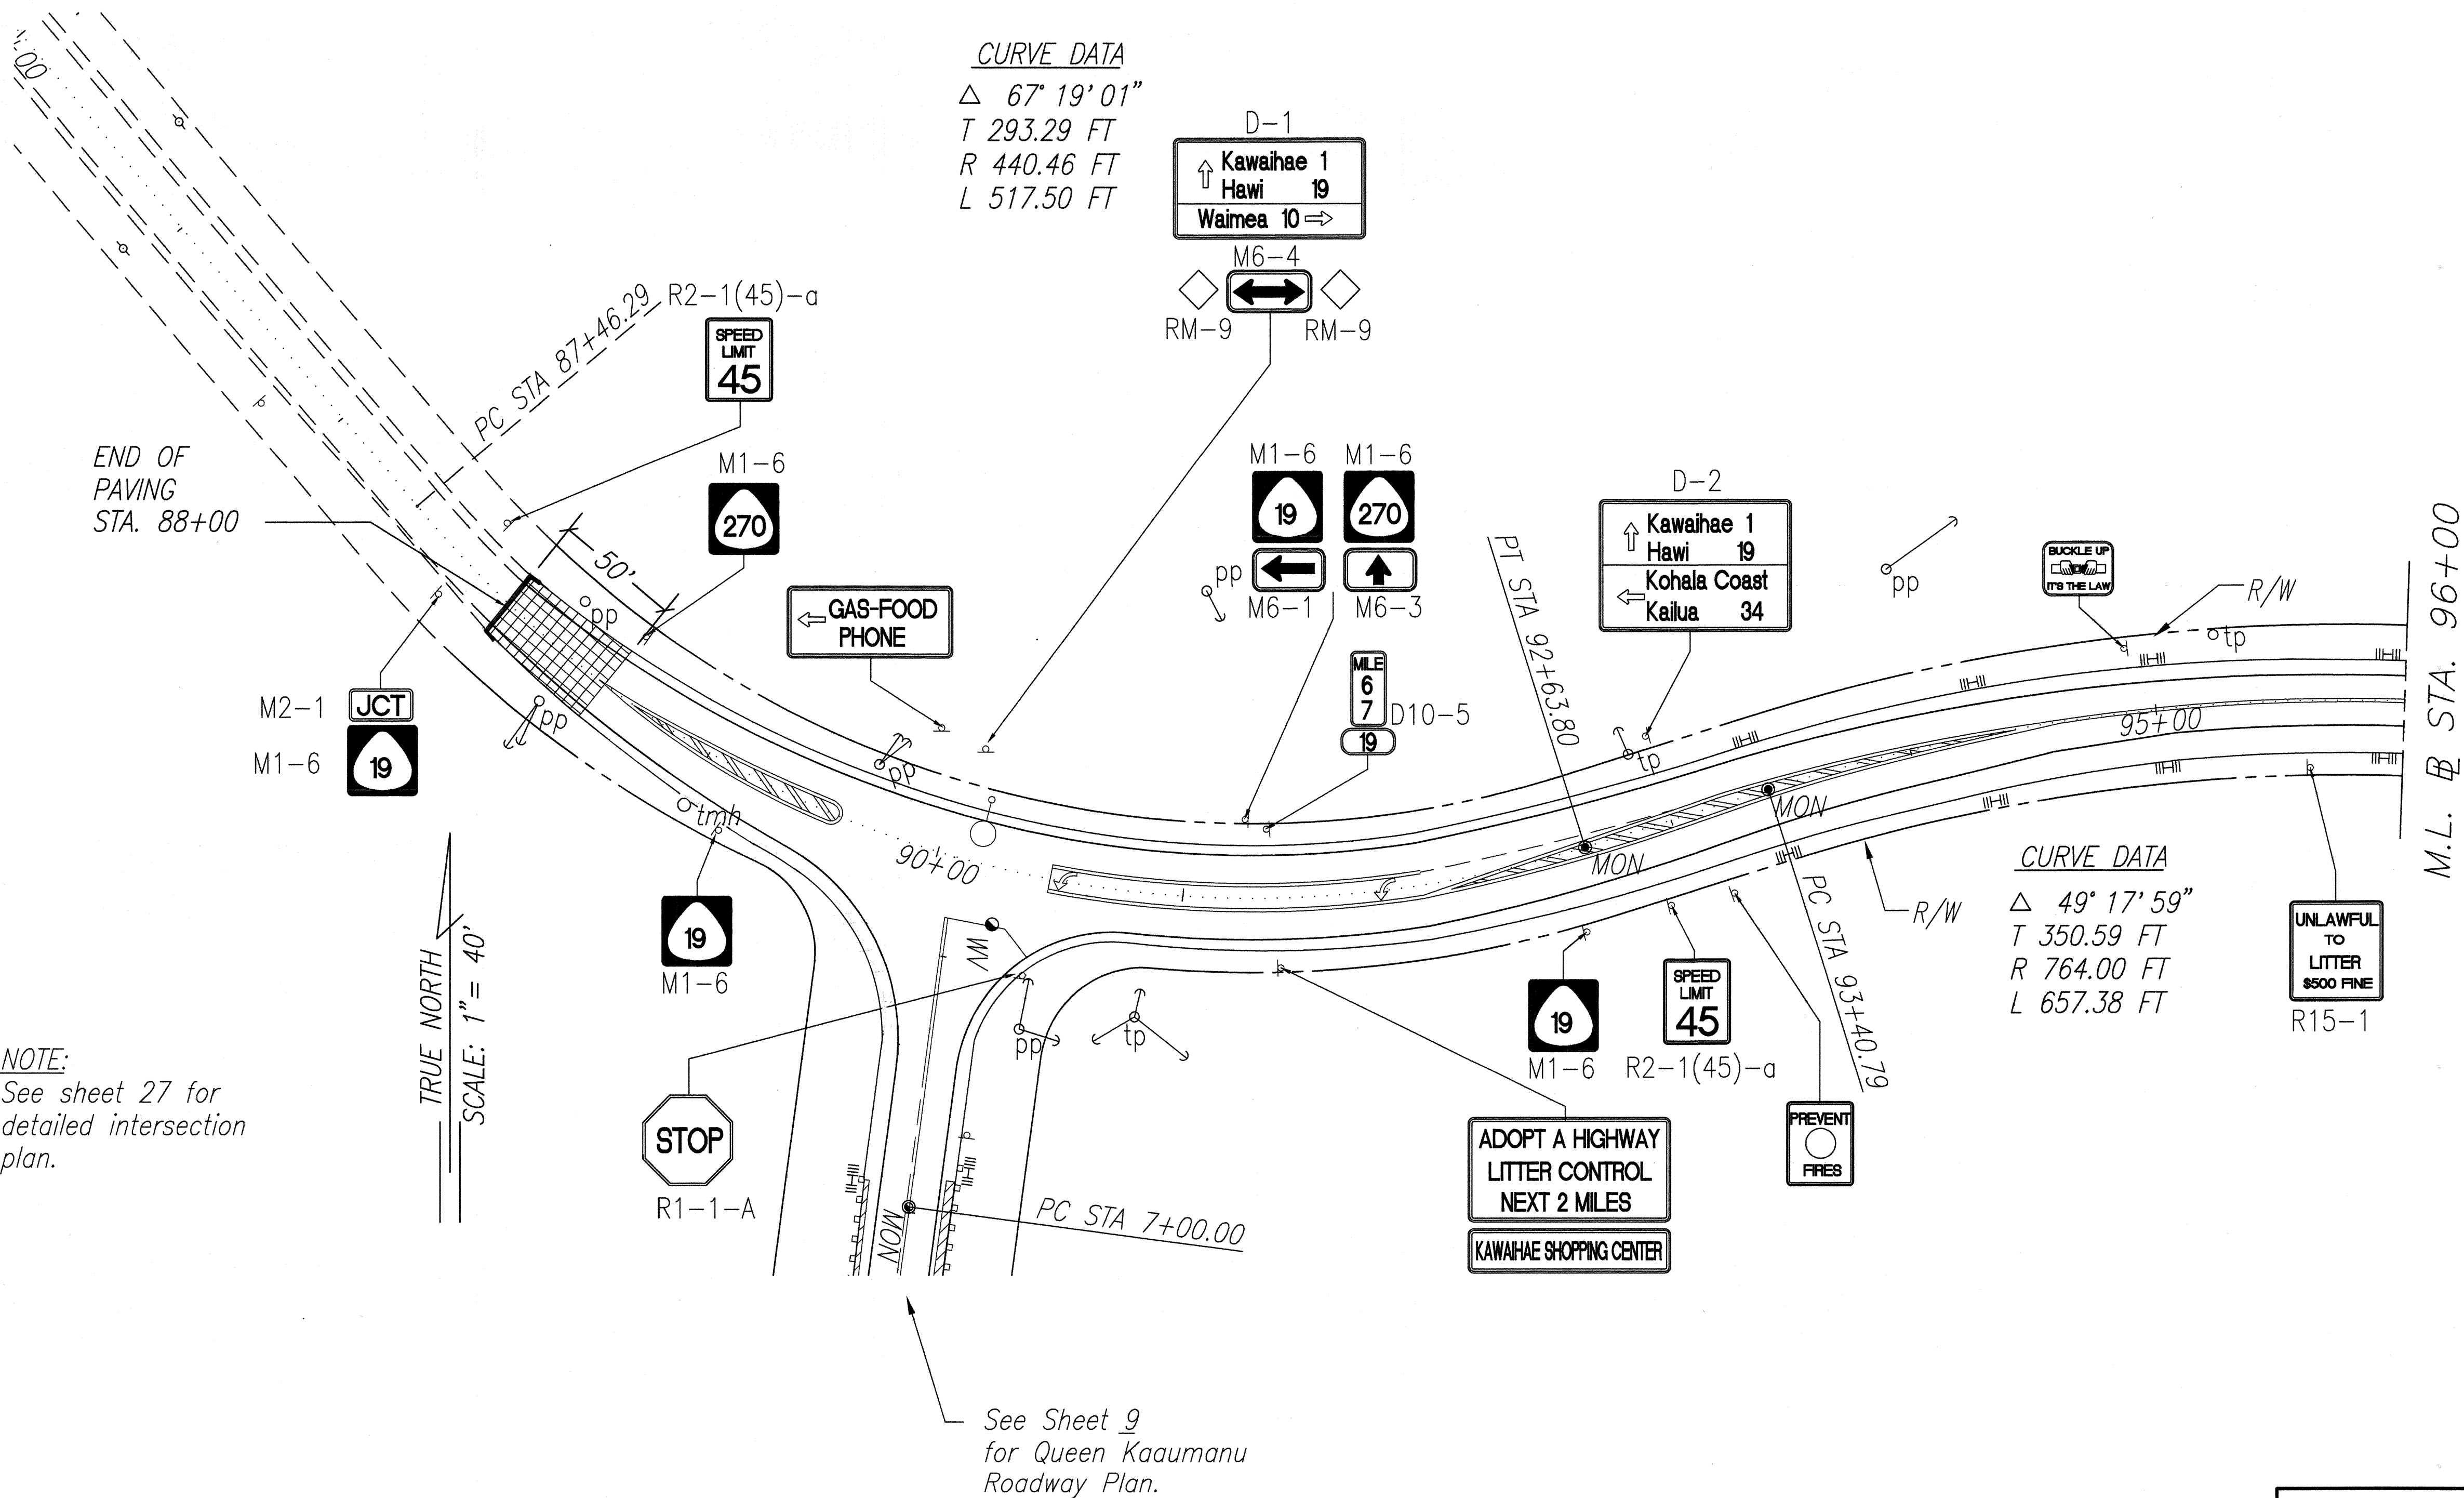

NOTE:
See sheet 27 for
detailed intersection
plan.

ORIGINAL PLAN	SURVEY PLOTTED BY	DATE
	DRAWN BY	
	DESIGNED BY	
	CHECKED BY	
No.		

Wesley R. Segawa, P.E.

This work was prepared by me or under my supervision.

STATE OF HAWAII
DEPARTMENT OF TRANSPORTATION
HIGHWAYS DIVISION


KAWAIHAE ROAD
STA. 88+00 TO 96+00

QUEEN KAAHUMANU AND KAWAIHAE
RESURFACING, ROUTE 19, MP 63.3 TO 69.5


PROJECT NO.19CD-01-97M

SCALE: AS NOTED Date: April, 1997

FED. ROAD DIST. NO.	STATE	PROJ. NO.	FISCAL YEAR	SHEET NO.	TOTAL SHEETS
HAWAII	HAW.	19CD-01-97M	1997	19	39

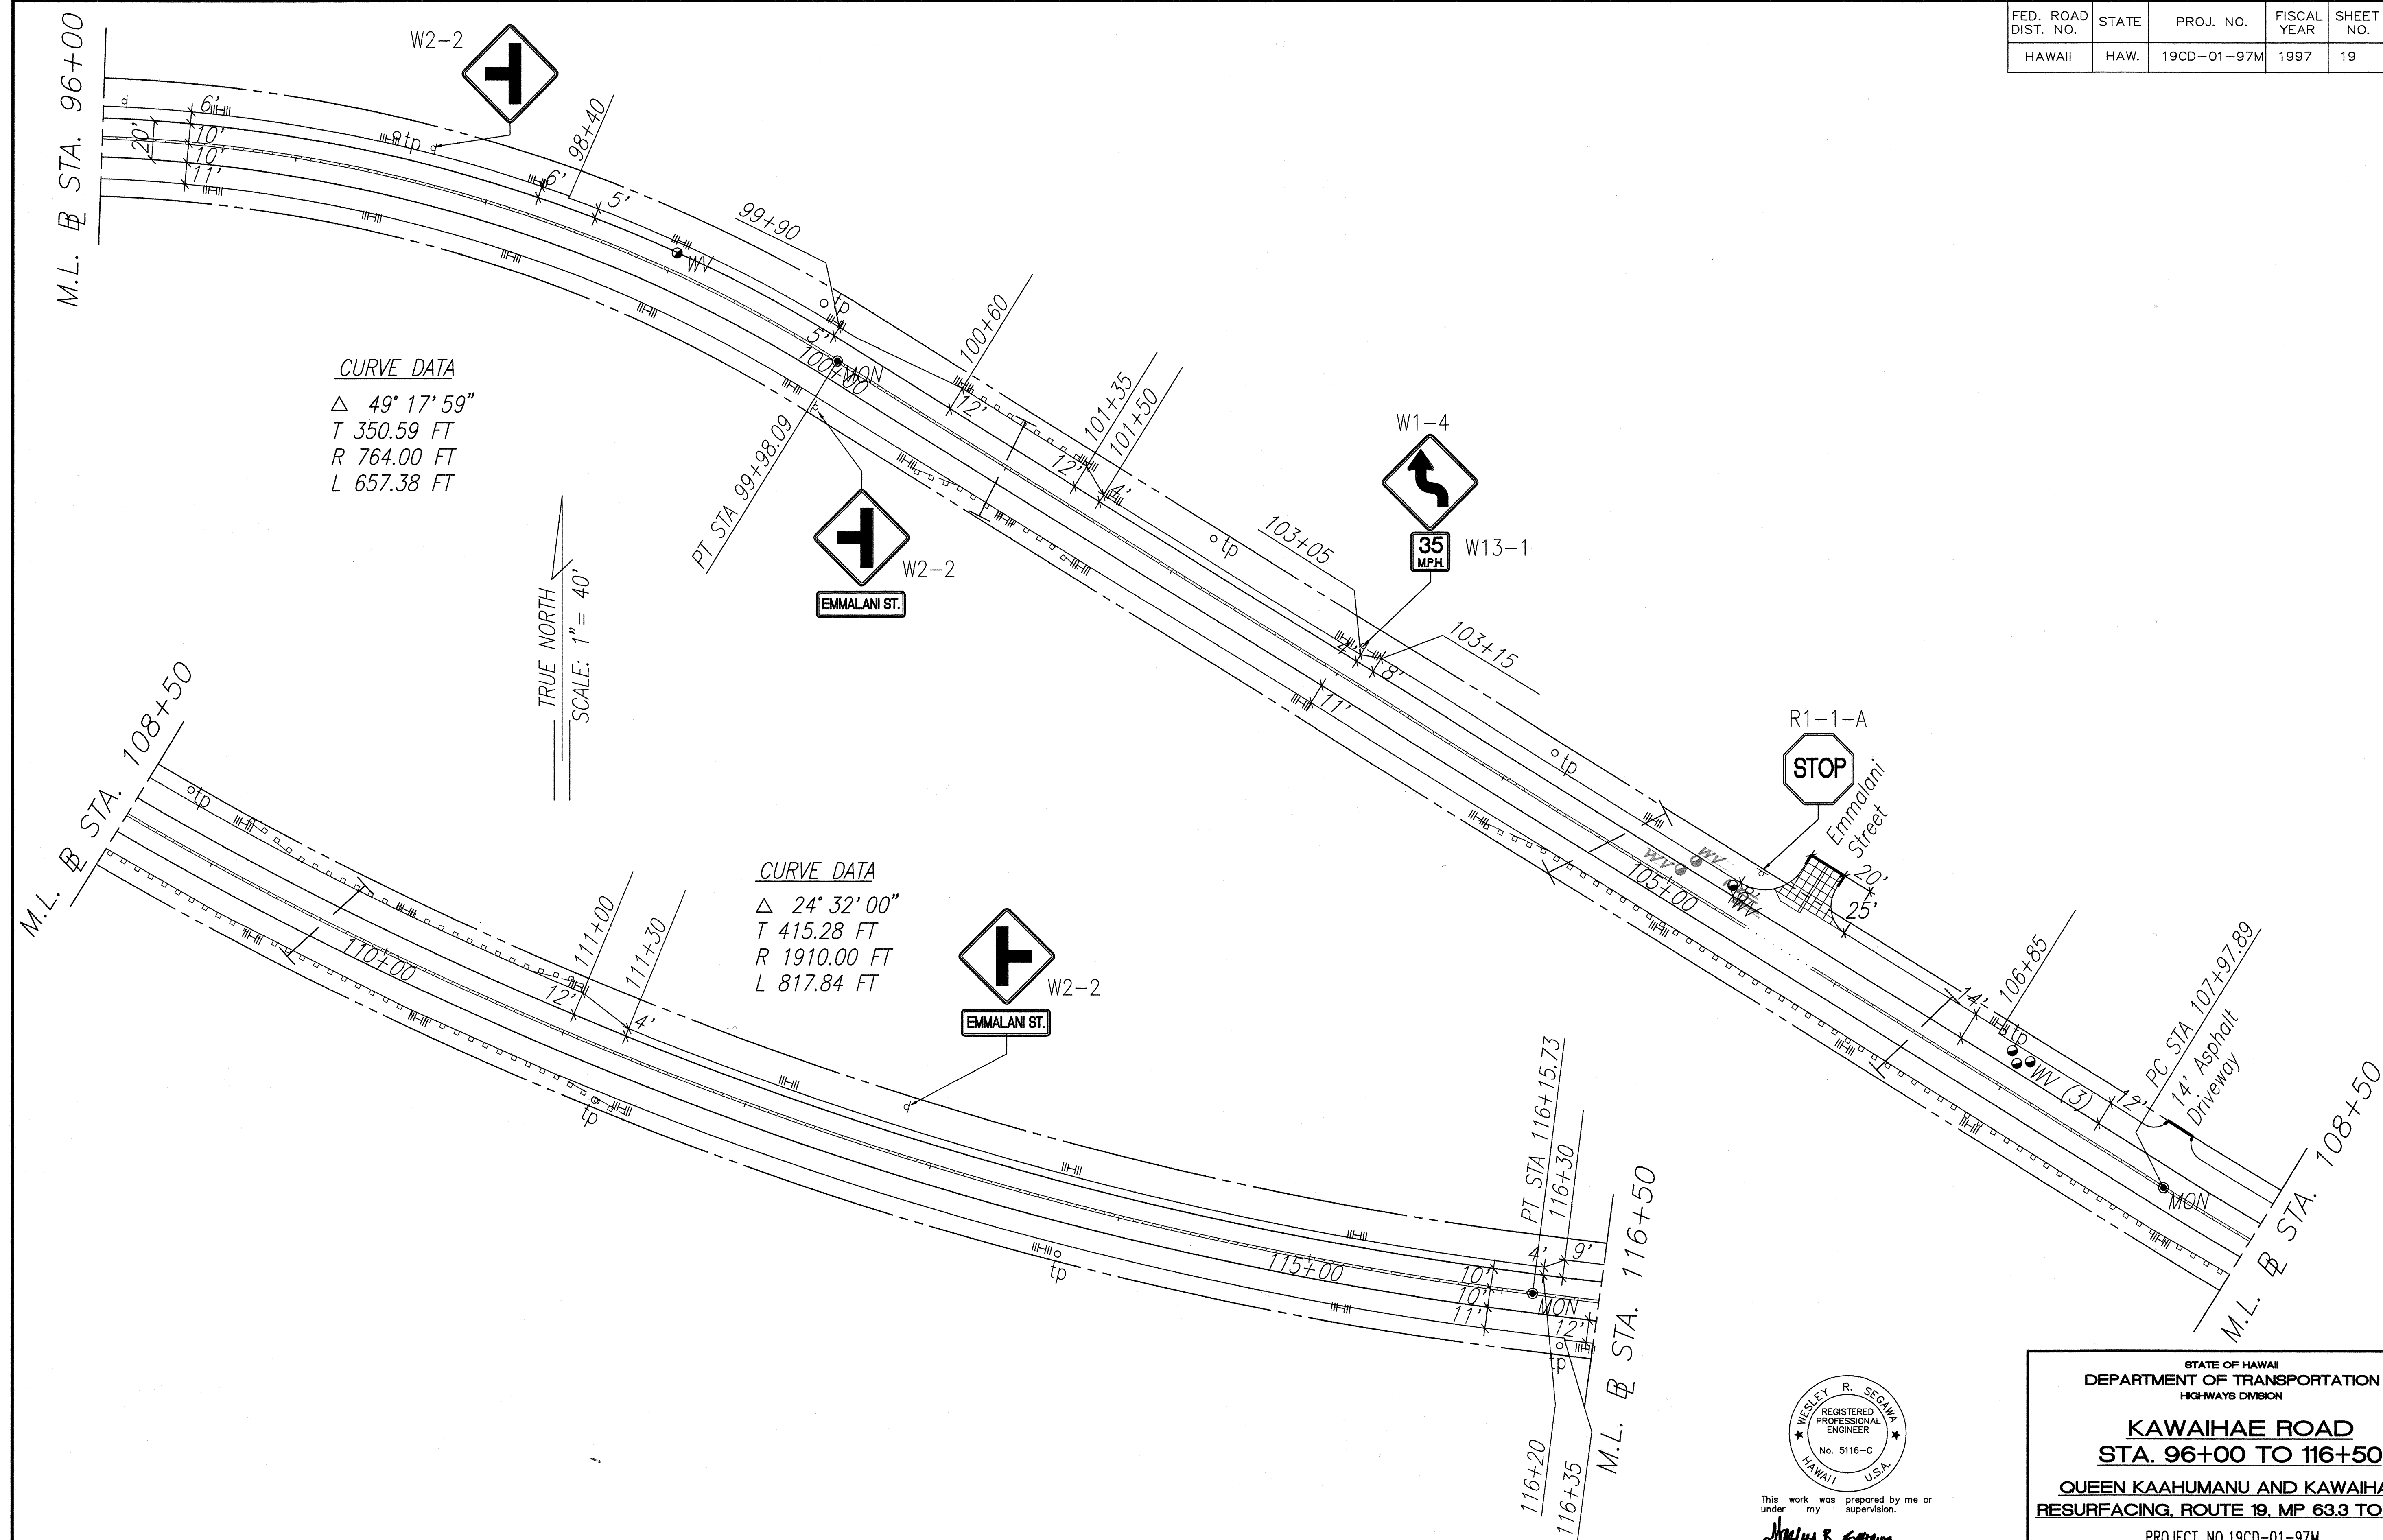

ORIGINAL PLAN	SURVEY PLOTTED BY	DATE
	DRAWN BY	"
	DESIGNED BY	"
	QUANTITIES BY	"
NOTE BOOK	CHECKED BY	"
	No.	

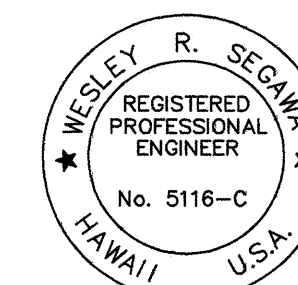

This work was prepared by me or under my supervision.
Wesley R. Segawa, P.E.

STATE OF HAWAII
DEPARTMENT OF TRANSPORTATION
HIGHWAYS DIVISION

KAWAIHÆ ROAD
STA. 96+00 TO 116+50

QUEEN KAAHUMANU AND KAWAIHÆ
RESURFACING, ROUTE 19, MP 63.3 TO 69.5


PROJECT NO.19CD-01-97M

SCALE: AS NOTED Date: April, 1997


SHEET No. 2 OF 9 SHEETS 9704-X

"AS-BUILT"

FED. ROAD DIST. NO.	STATE	PROJ. NO.	FISCAL YEAR	SHEET NO.	TOTAL SHEETS
HAWAII	HAW.	19CD-01-97M	1997	20	39

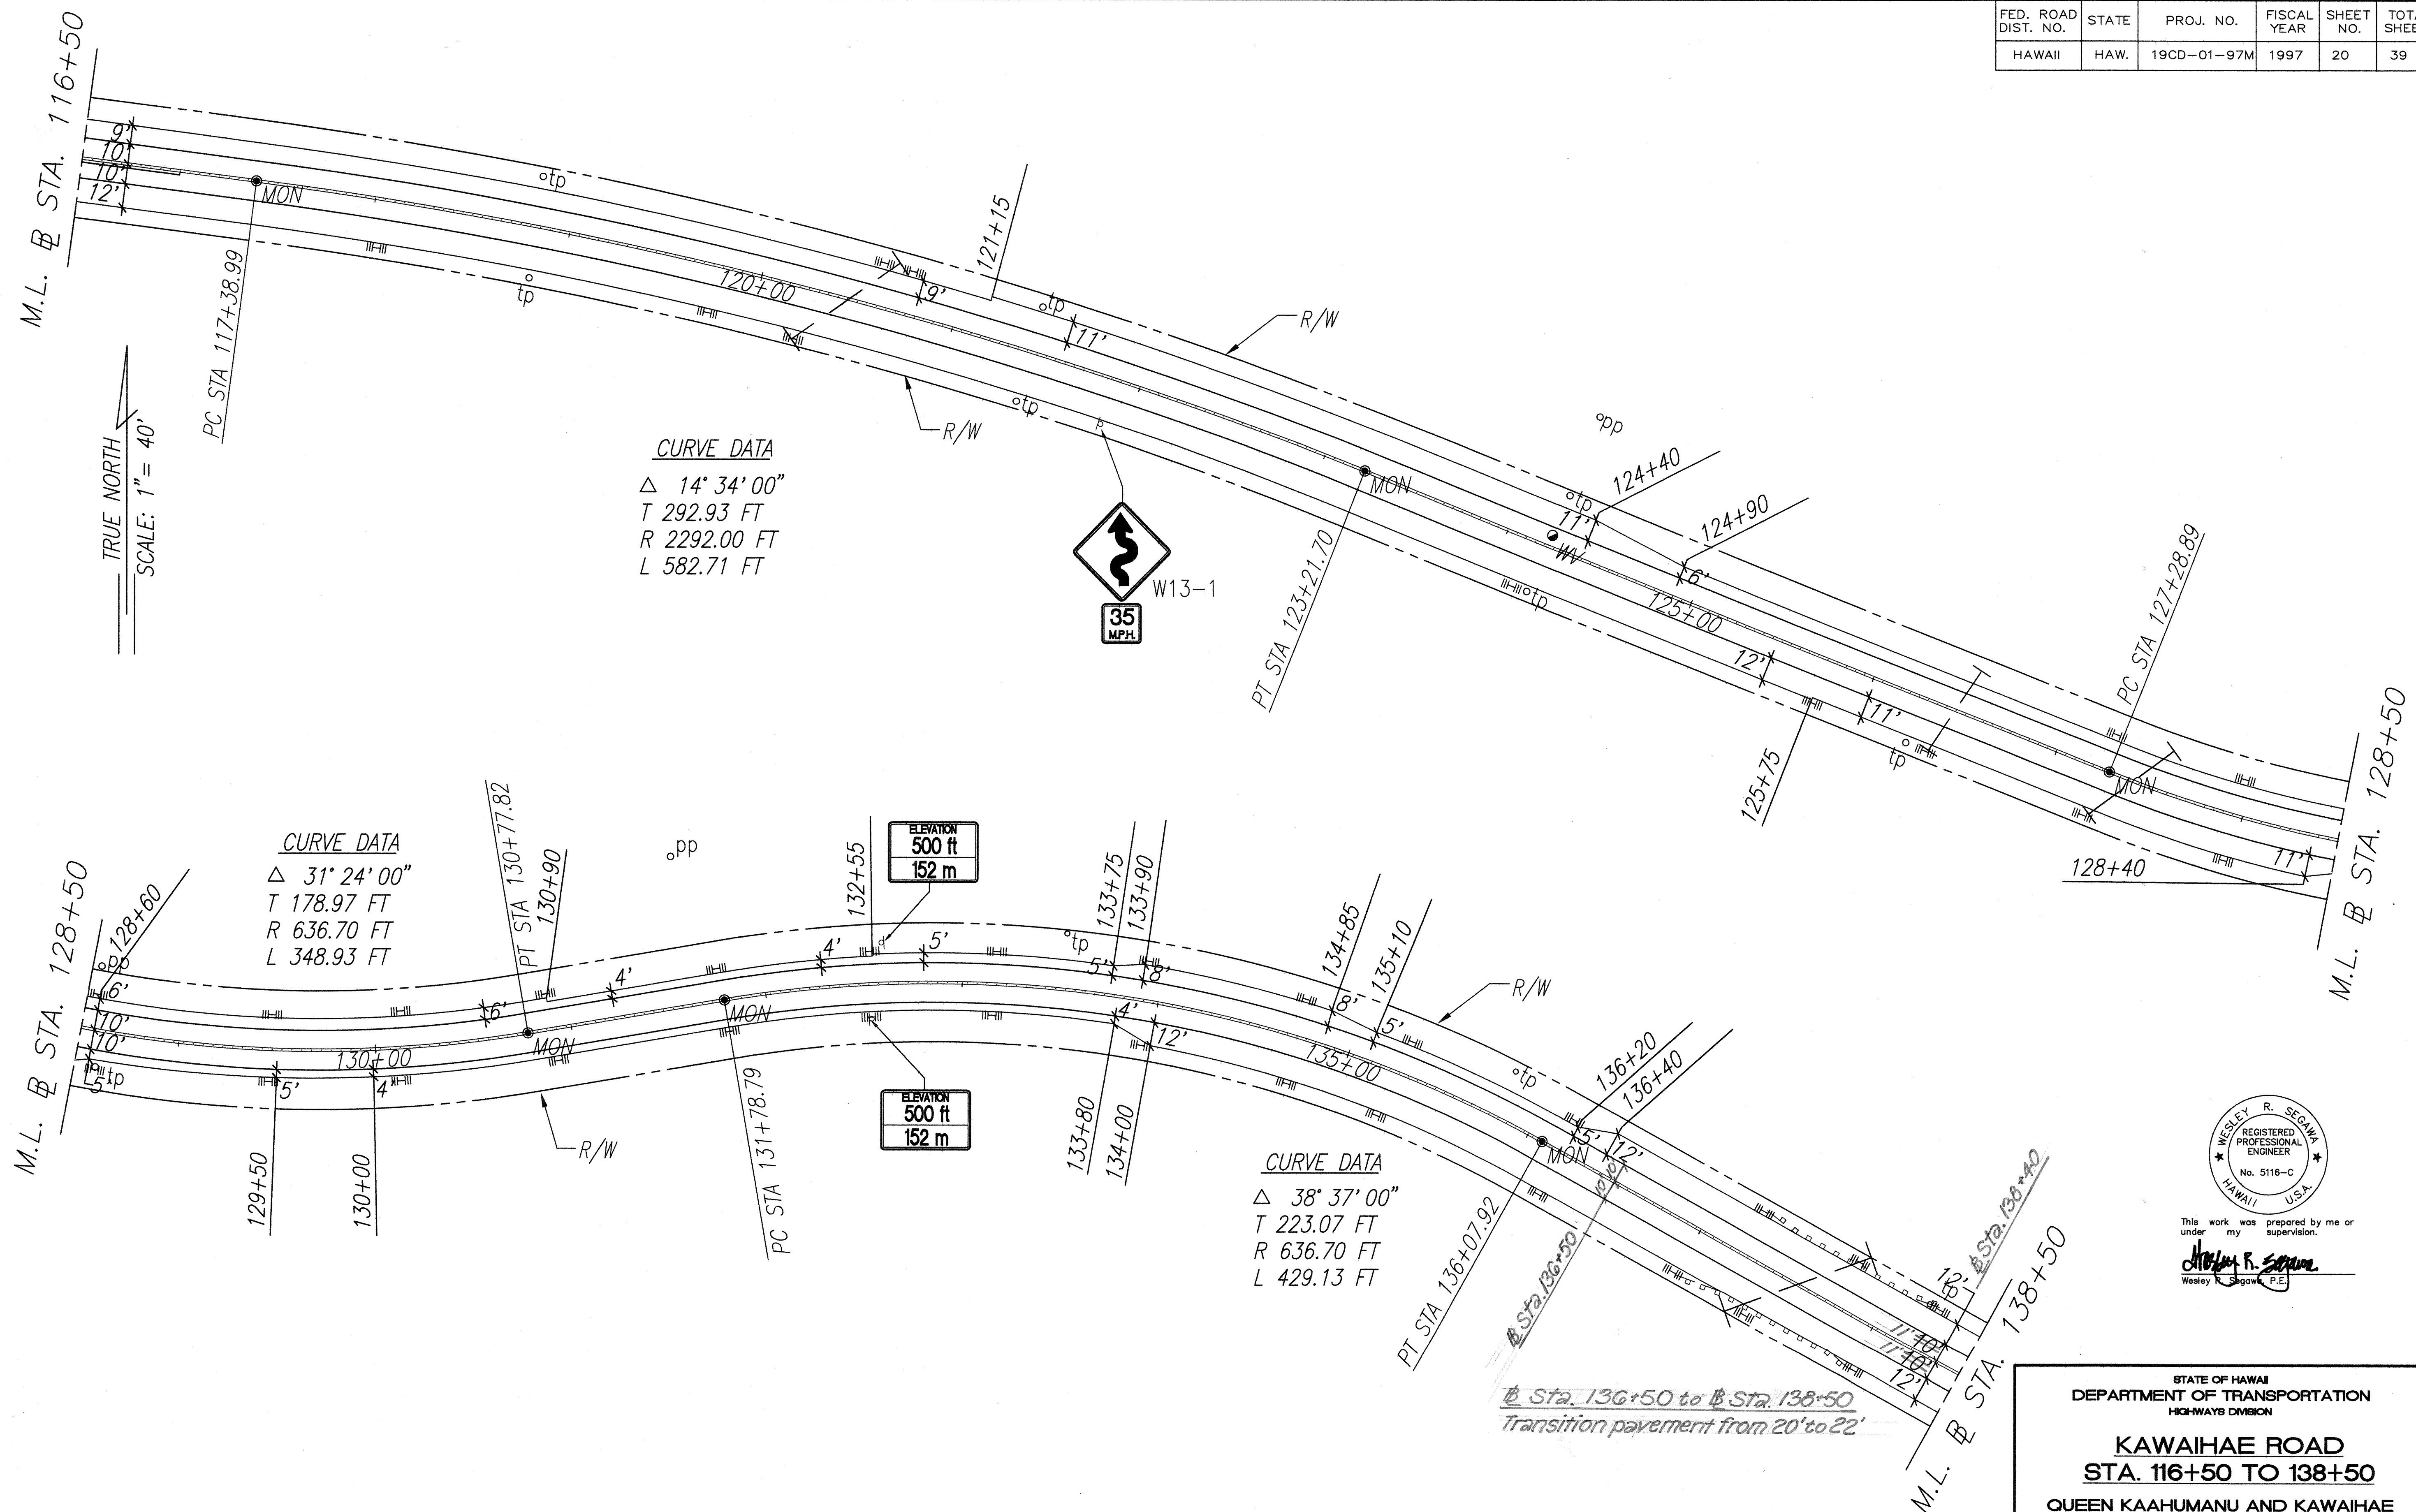

ORIGINAL PLAN	SURVEY PLOTTED BY	DATE
NOTE BOOK	DRAWN BY	
	DESIGNED BY	
	QUANTITIES BY	
	CHECKED BY	

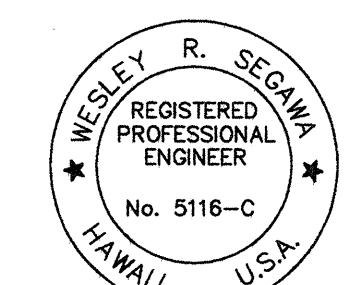

This work was prepared by me or under my supervision.
Wesley R. Segawa, P.E.

STATE OF HAWAII
DEPARTMENT OF TRANSPORTATION
HIGHWAYS DIVISION

KAWAIHAE ROAD
STA. 116+50 TO 138+50

QUEEN KAAHUMANU AND KAWAIHAE
RESURFACING, ROUTE 19, MP 63.3 TO 69.5


PROJECT NO. 19CD-01-97M

SCALE: AS NOTED Date: April, 1997

SHEET No. 3 OF 9 SHEETS 9704-20


"AS-BUILT"

FED. ROAD DIST. NO.	STATE	PROJ. NO.	FISCAL YEAR	SHEET NO.	TOTAL SHEETS
HAWAII	HAW.	19CD-01-97M	1997	21	39

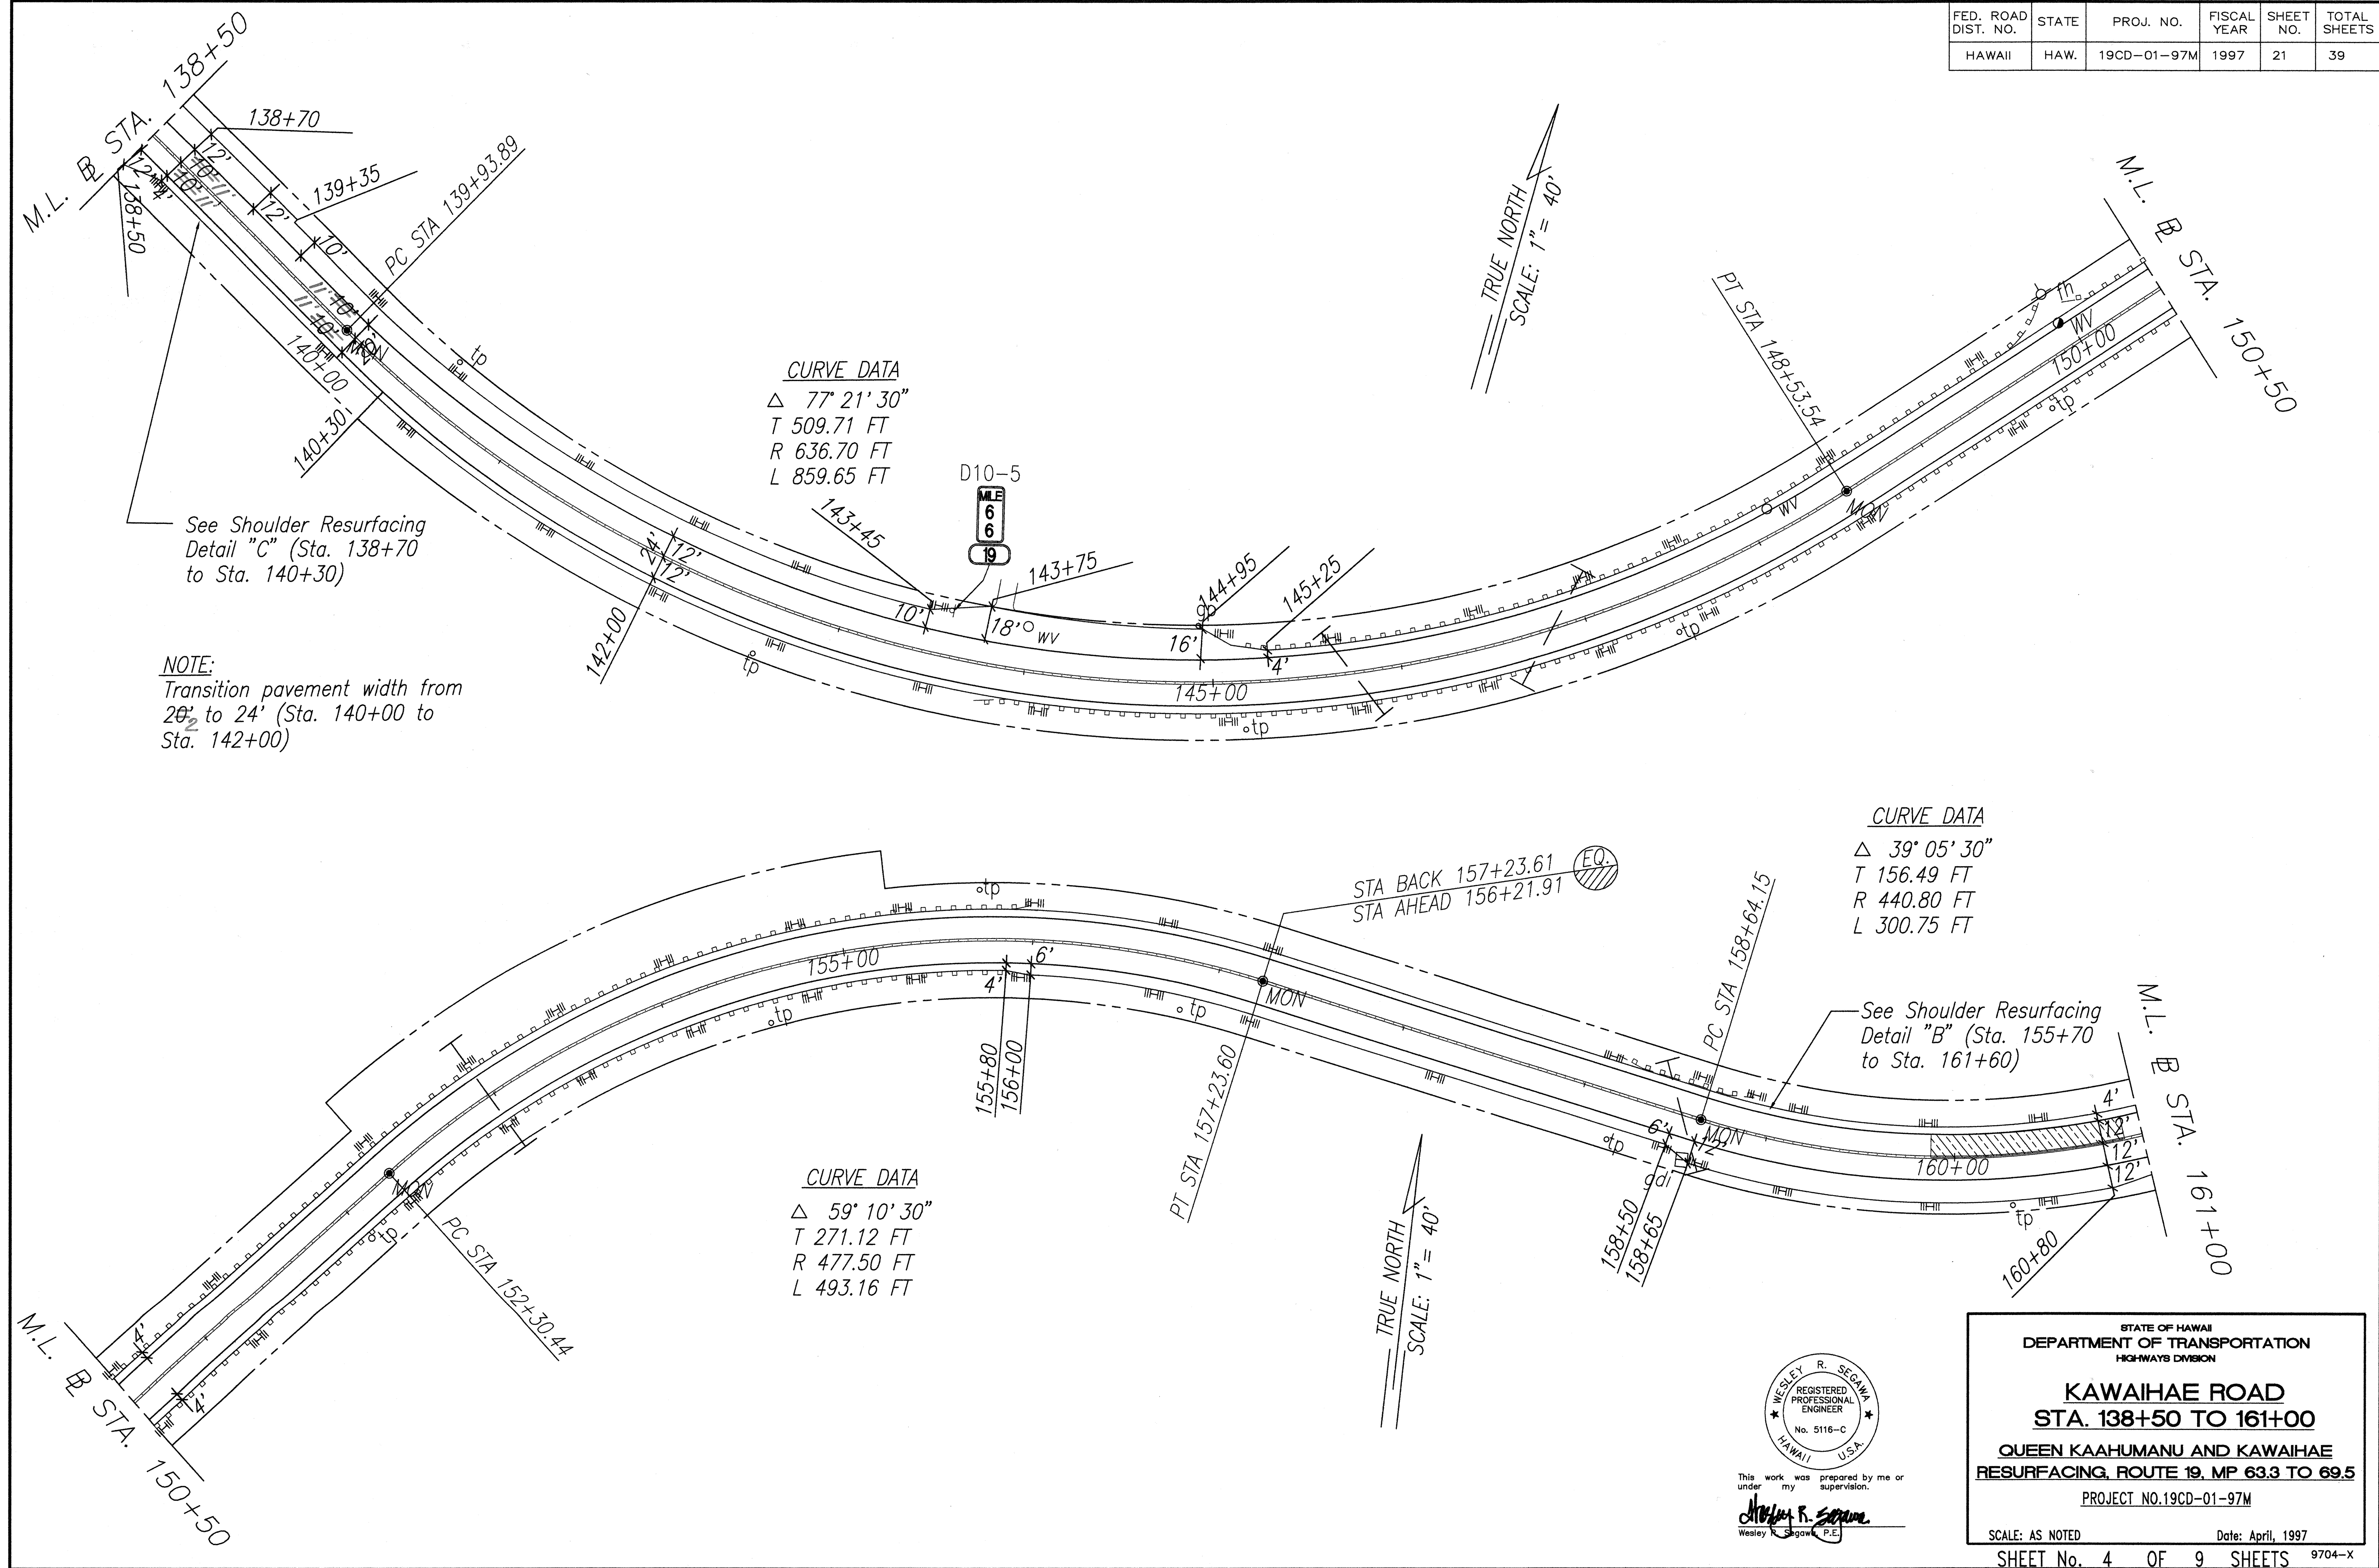


SURVEY PLOTTED BY	DATE
DRAWN BY	
DESIGNED BY	
QUANTITIES BY	
CHECKED BY	
ORIGINAL PLAN	
NOTE BOOK	
No.	

FED. ROAD DIST. NO.	STATE	PROJ. NO.	FISCAL YEAR	SHEET NO.	TOTAL SHEETS
HAWAII	HAW.	19CD-01-97M	1997	22	39

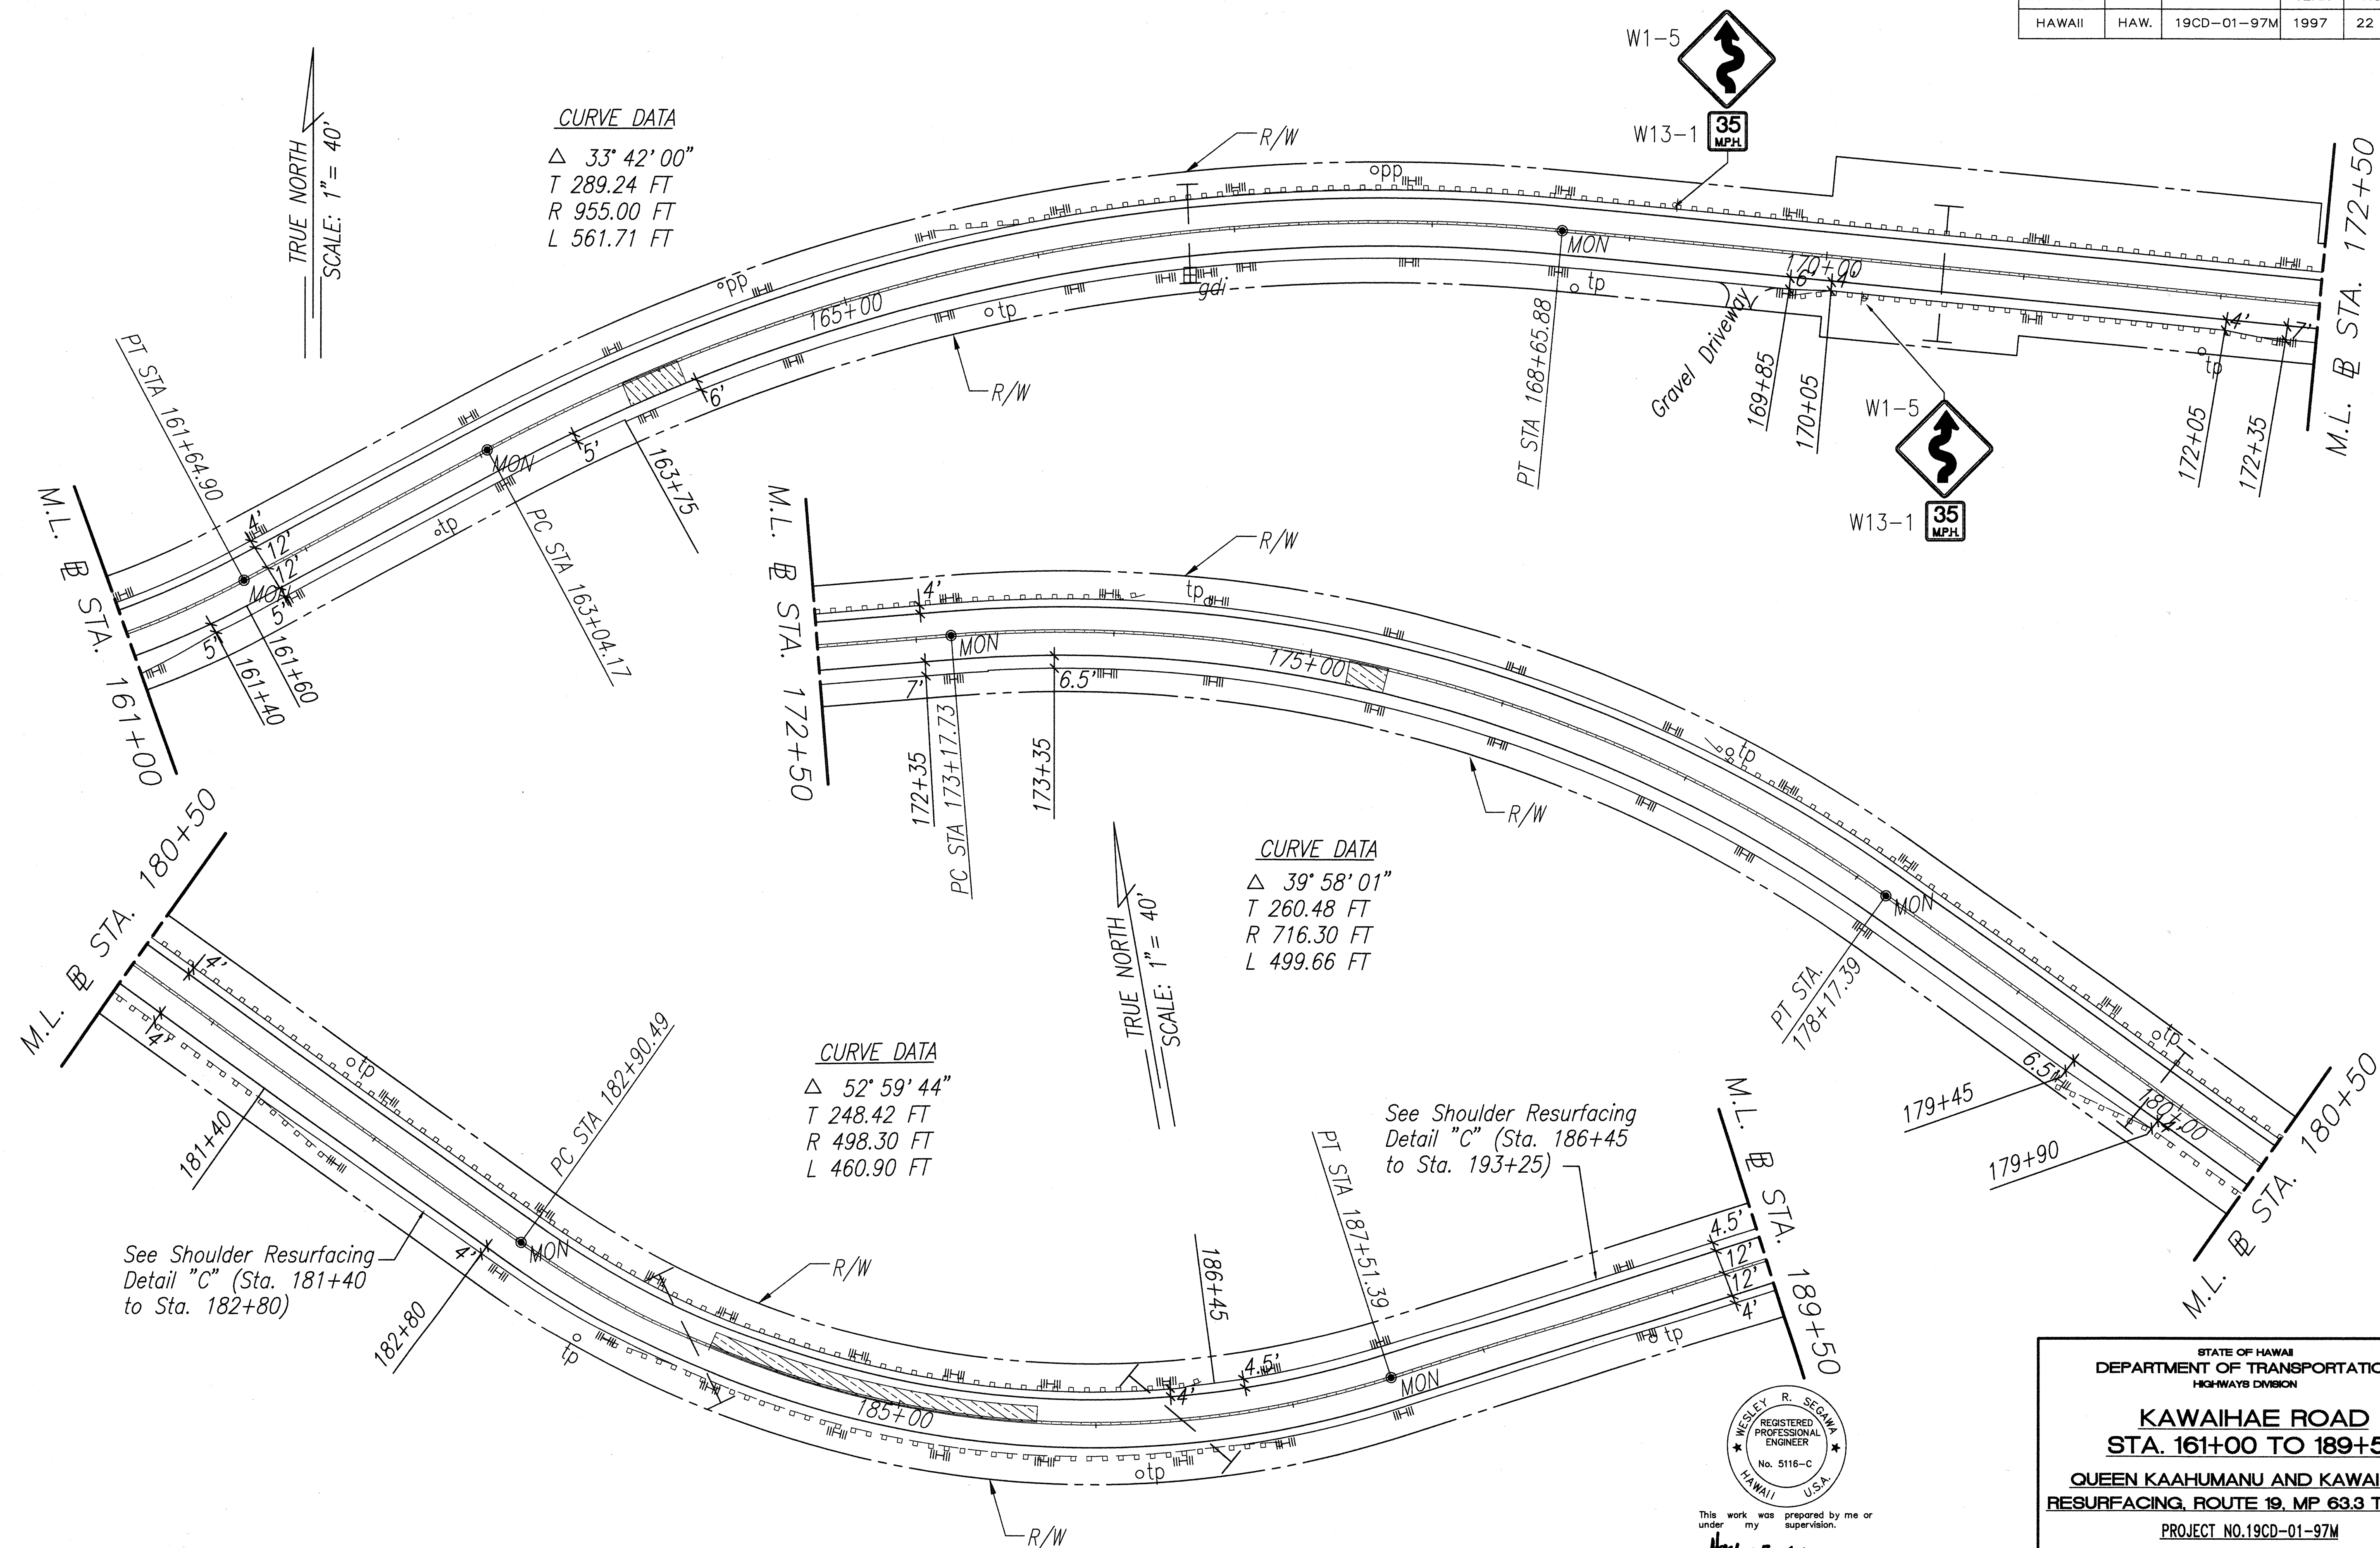

SURVEY PLOTTED BY	DATE
DRAWN BY	
DESIGNED BY	
CHECKED BY	
NOTE BOOK	
QUANTITIES BY	
CHECKED BY	
No.	

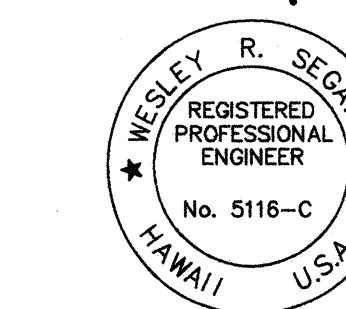

This work was prepared by me or under my supervision.
Wesley R. Segawa, P.E.

STATE OF HAWAII
DEPARTMENT OF TRANSPORTATION
HIGHWAYS DIVISION

KAWAIHÆ ROAD
STA. 161+00 TO 189+50


QUEEN KAAHUMANU AND KAWAIHÆ
RESURFACING, ROUTE 19, MP 63.3 TO 69.5

PROJECT NO.19CD-01-97M


SCALE: AS NOTED Date: April, 1997

SHEET No. 5 OF 9 SHEETS

FED. ROAD DIST. NO.	STATE	PROJ. NO.	FISCAL YEAR	SHEET NO.	TOTAL SHEETS
HAWAII	HAW.	19CD-01-97M	1997	23	39

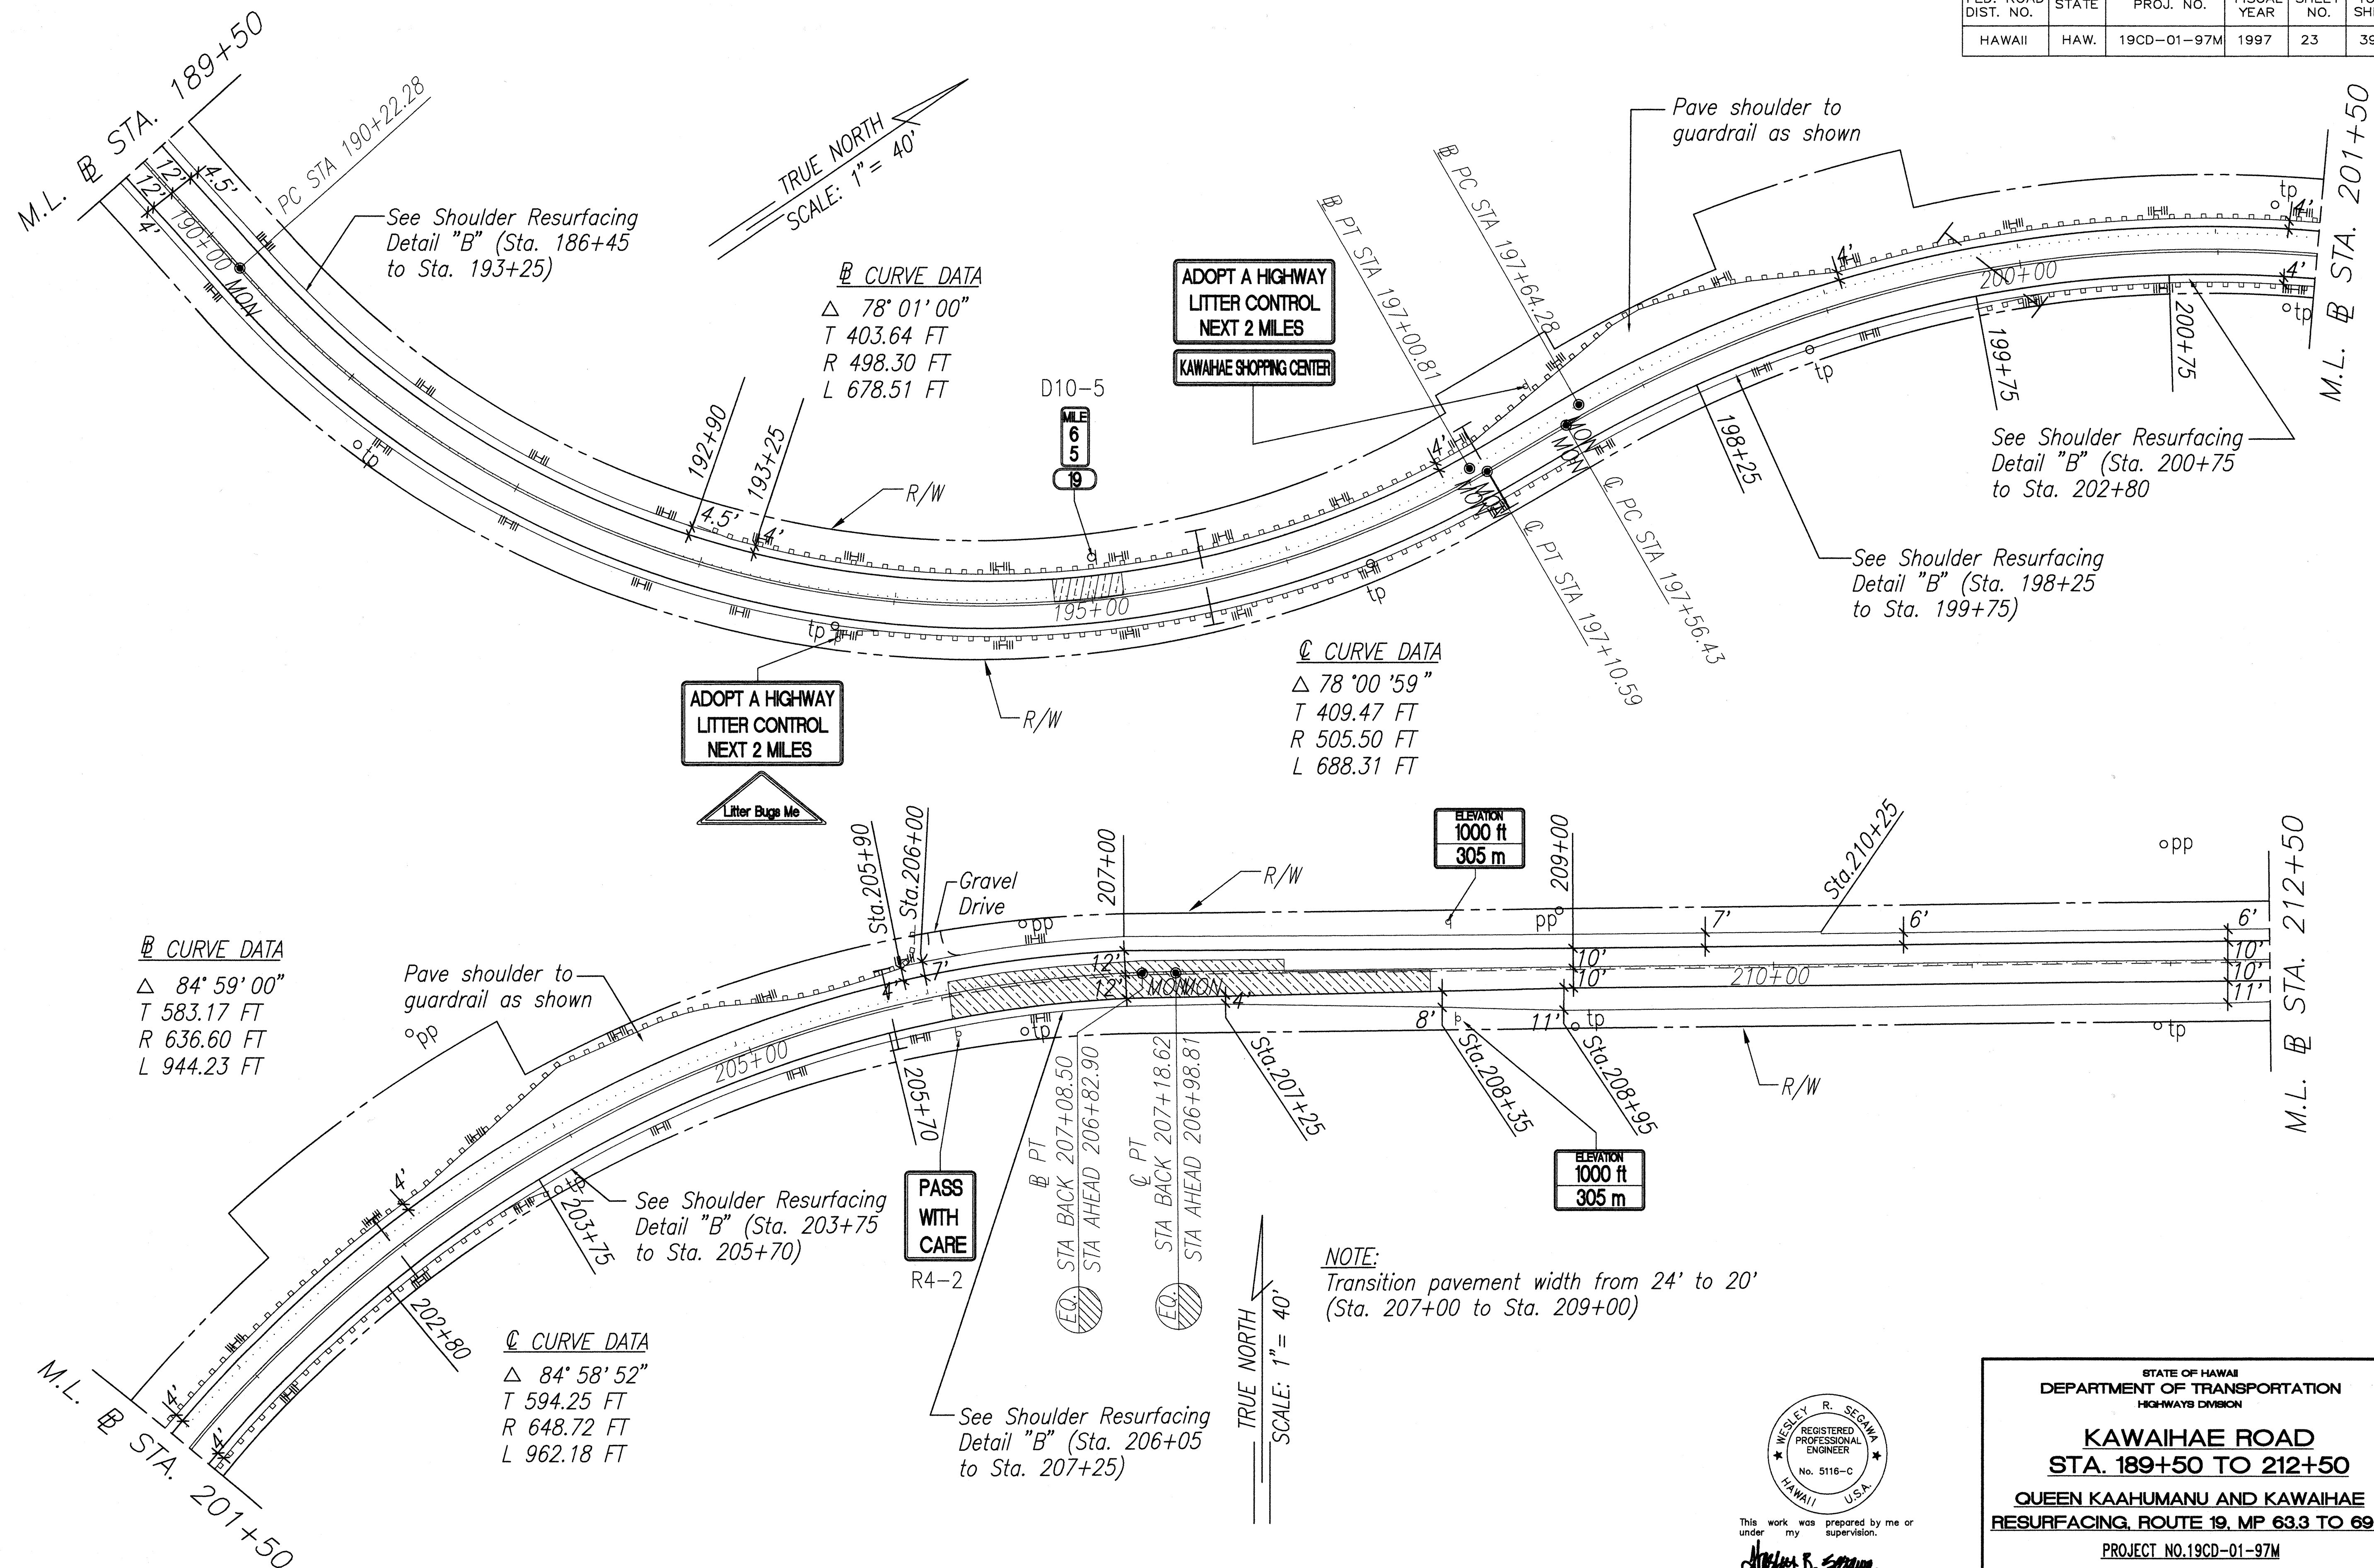

SURVEY PLOTTED BY	DATE
DESIGNED BY	
TRACED BY	
DESIGNED BY	
QUANTITIES BY	
CHECKED BY	
ORIGINAL PLAN	
NOTE BOOK	
No.	

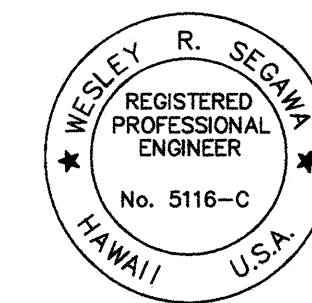


This work was prepared by me or under my supervision.
Wesley R. Segawa, P.E.

STATE OF HAWAII
DEPARTMENT OF TRANSPORTATION
HIGHWAYS DIVISION


KAWAIHAE ROAD
STA. 189+50 TO 212+50
QUEEN KAAHUMANU AND KAWAIHAE
RESURFACING, ROUTE 19, MP 63.3 TO 69.5
PROJECT NO. 19CD-01-97M

SCALE: AS NOTED Date: April, 1997

FED. ROAD DIST. NO.	STATE	PROJ. NO.	FISCAL YEAR	SHEET NO.	TOTAL SHEETS
HAWAII	HAW.	19CD-01-97M	1997	24	39

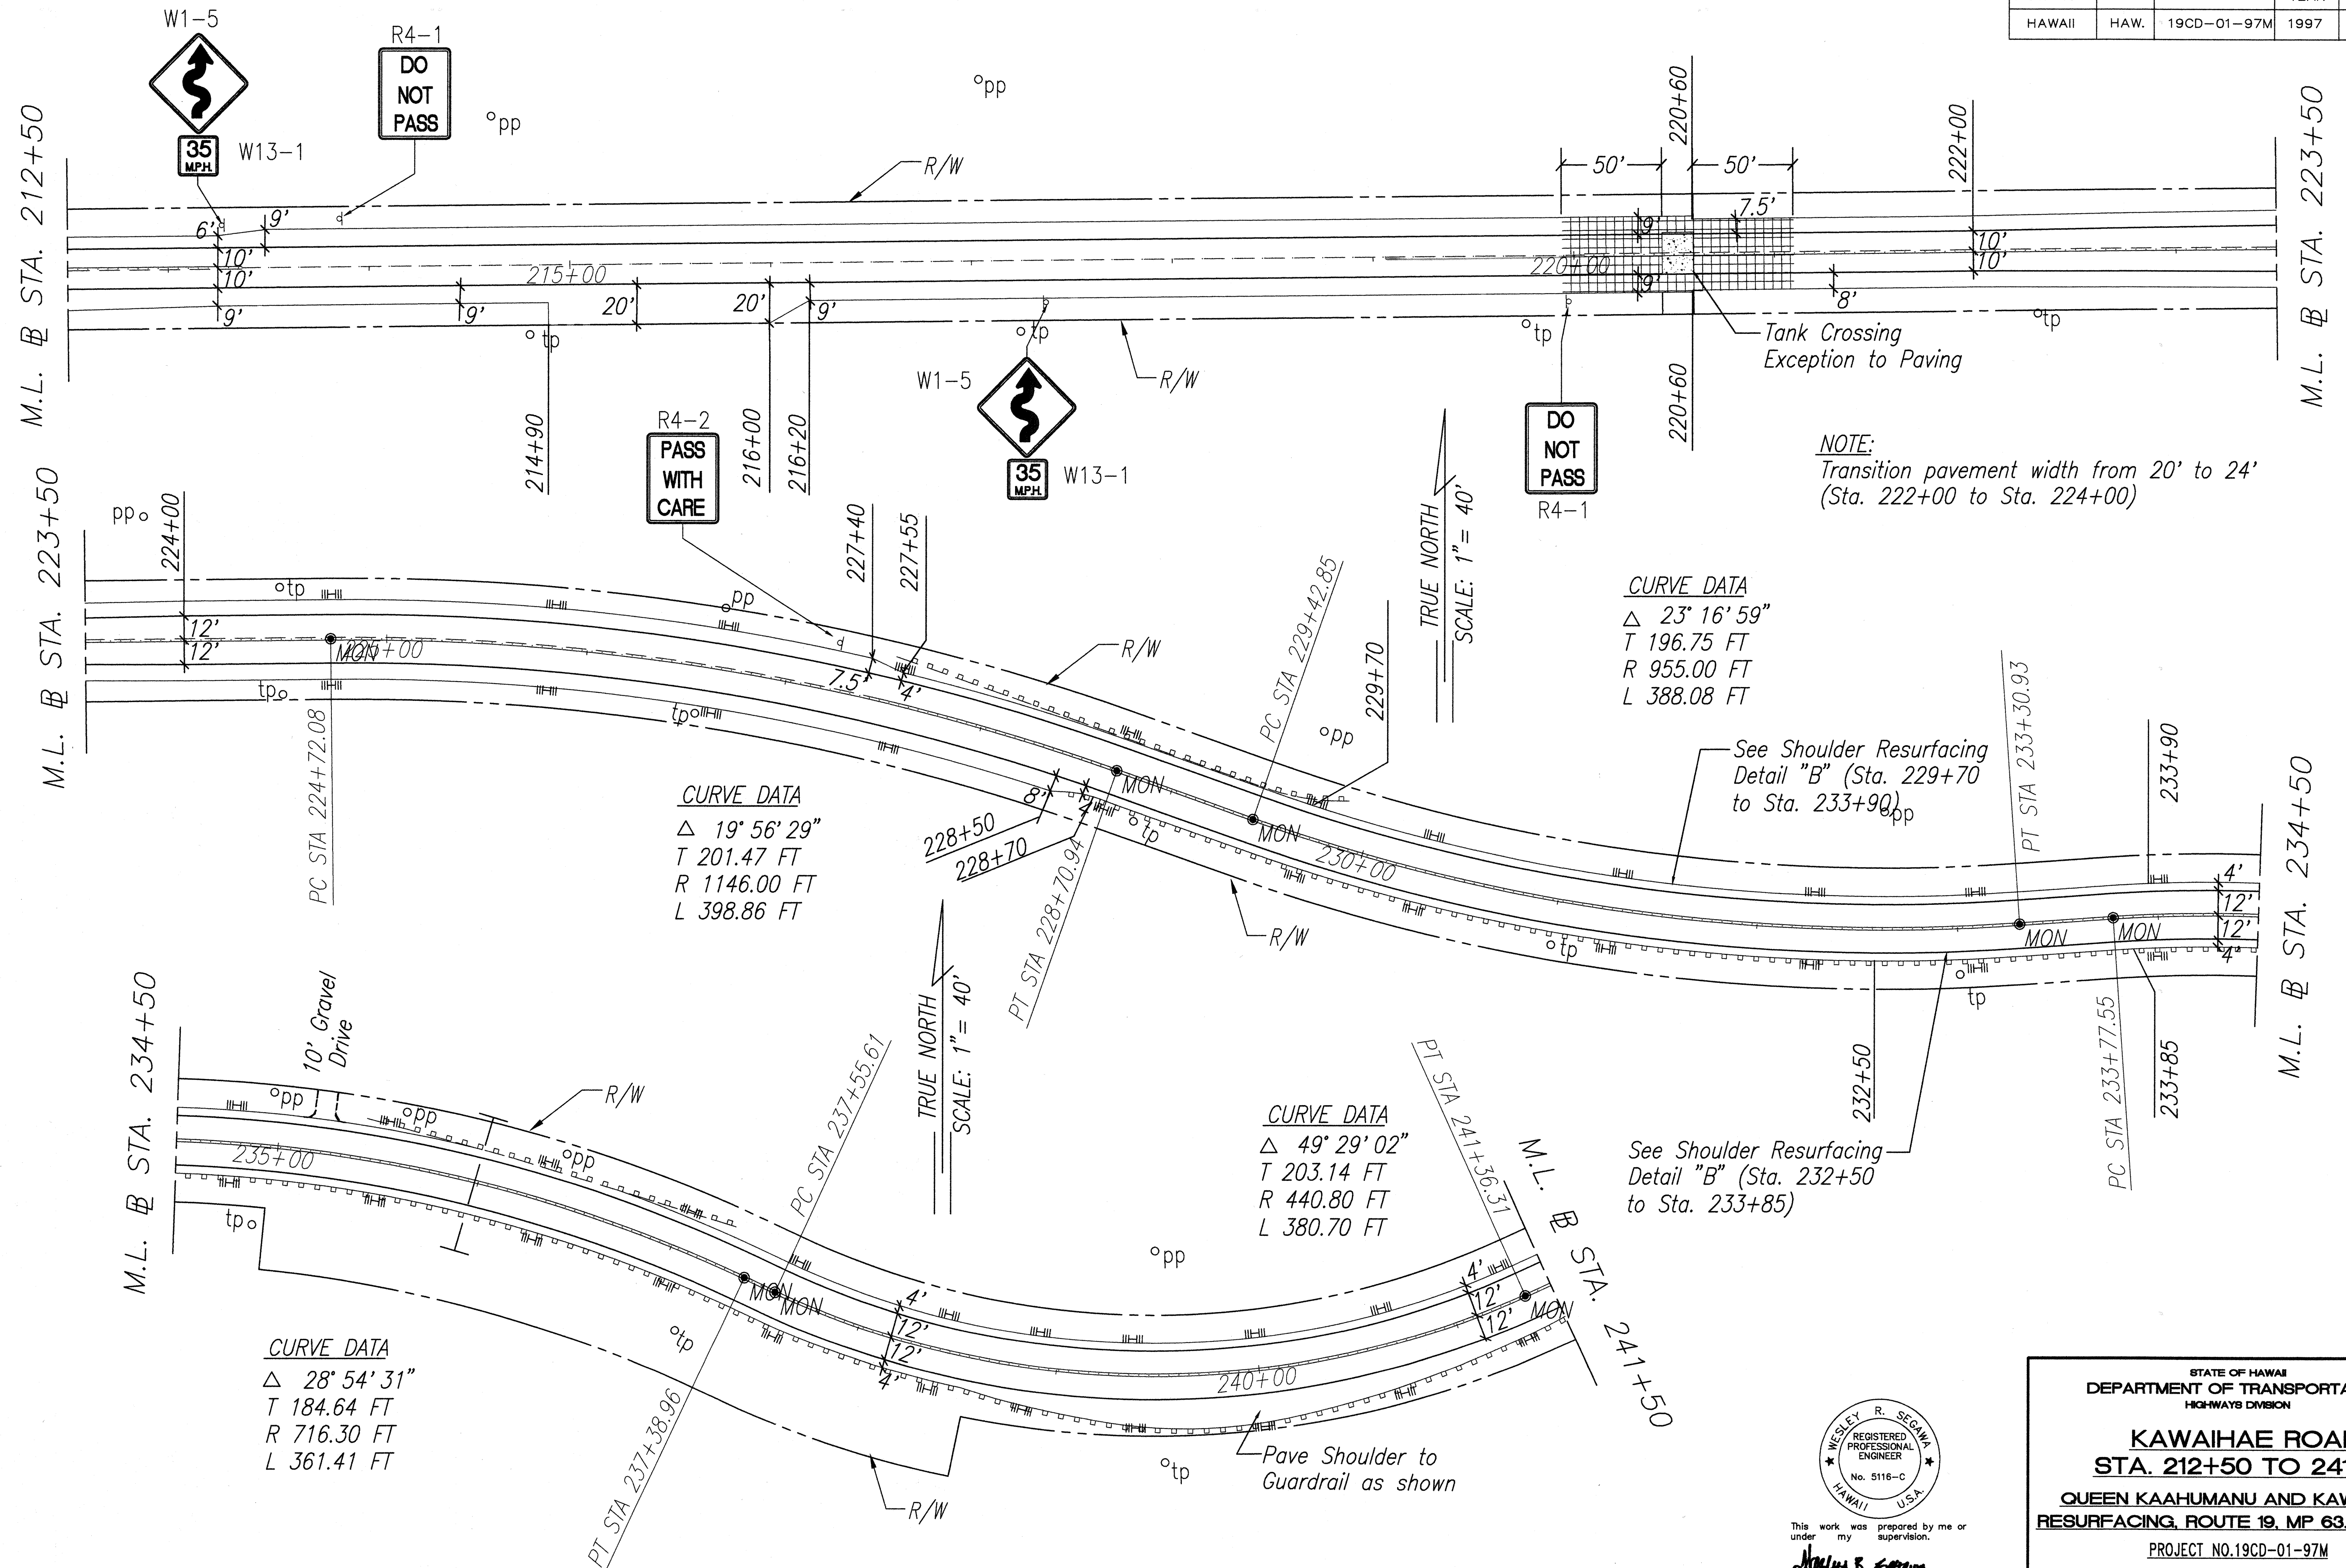

DATE	_____
SURVEY PLOTTED BY	_____
DRAWN BY	_____
DESIGNED BY	_____
CHECKED BY	_____
ORIGINAL PLAN	_____
NOTE BOOK	_____
No.	_____

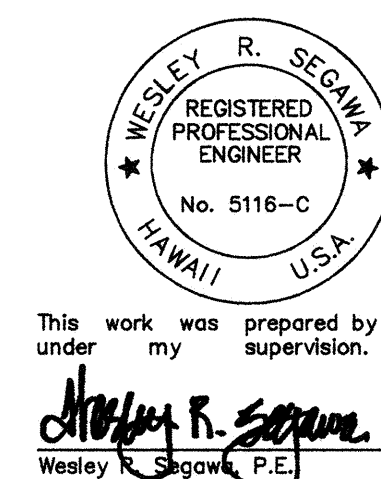

STATE OF HAWAII
DEPARTMENT OF TRANSPORTATION
HIGHWAYS DIVISION

**KAWAIHAE ROAD
STA. 212+50 TO 241+50**

**QUEEN KAAHUMANU AND KAWAIHAE
RESURFACING, ROUTE 19, MP 63.3 TO 69.5**

PROJECT NO. 19CD-01-97M

SCALE: AS NOTED Date: April, 1997

"AS-BUILT"

