

INDEX TO DRAWINGS	
SHEET NO.	DESCRIPTION
1	TITLE SHEET
2	STANDARD PLANS SUMMARY
3	GENERAL NOTES AND LEGENDS
4	PAVEMENT MARKING LEGEND AND NOTES
5-7	TYPICAL SECTIONS AND DETAILS
8	SHOULDER RUMBLE STRIP DETAIL AND NOTES
9-17	ROADWAY PLANS-QUEEN KAAHUMANU HIGHWAY AND HAPUNA BEACH ACCESS ROAD
18-26	ROADWAY PLANS-KAWAIHAE ROAD
27	INTERSECTION PLAN AND DETAIL
28	PAVEMENT RECONSTRUCTION AREA SCHEDULE
29	SHOULDER RECONSTRUCTION AREA SCHEDULE
30	SIGN NOTES
31-32	SIGN SCHEDULE
33-36	REFLECTOR AND OBJECT MARKER SCHEDULE
37-38	MISCELLANEOUS SCHEDULES
39	CONSTRUCTION SIGN PLAN AND SCHEDULE

STATE OF HAWAII

DEPARTMENT OF TRANSPORTATION

HIGHWAYS DIVISION

HONOLULU, HAWAII

PLANS FOR

"AS-BUILT"

QUEEN KAAHUMANU HIGHWAY AND

KAWAIHAE ROAD RESURFACING




ROUTE 19, MP 63.30 TO 69.50

PROJECT NO. 19CD-01-97M

DISTRICT OF SOUTH KOHALA



ISLAND OF HAWAII

FED. ROAD DIST. NO.	STATE	FED. AID PROJ. NO.	FISCAL YEAR	SHEET NO.	TOTAL SHEETS
HAWAII	HAW.	19CD-01-97M	1997	1	39

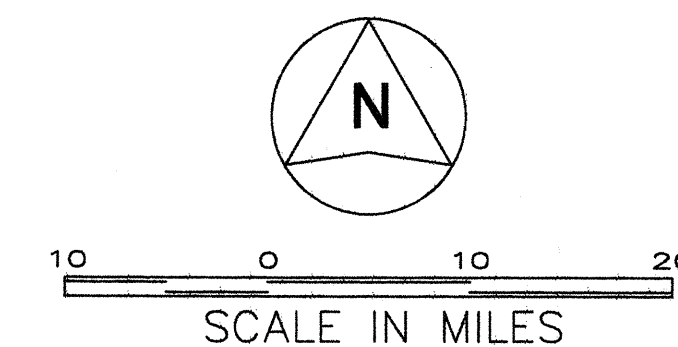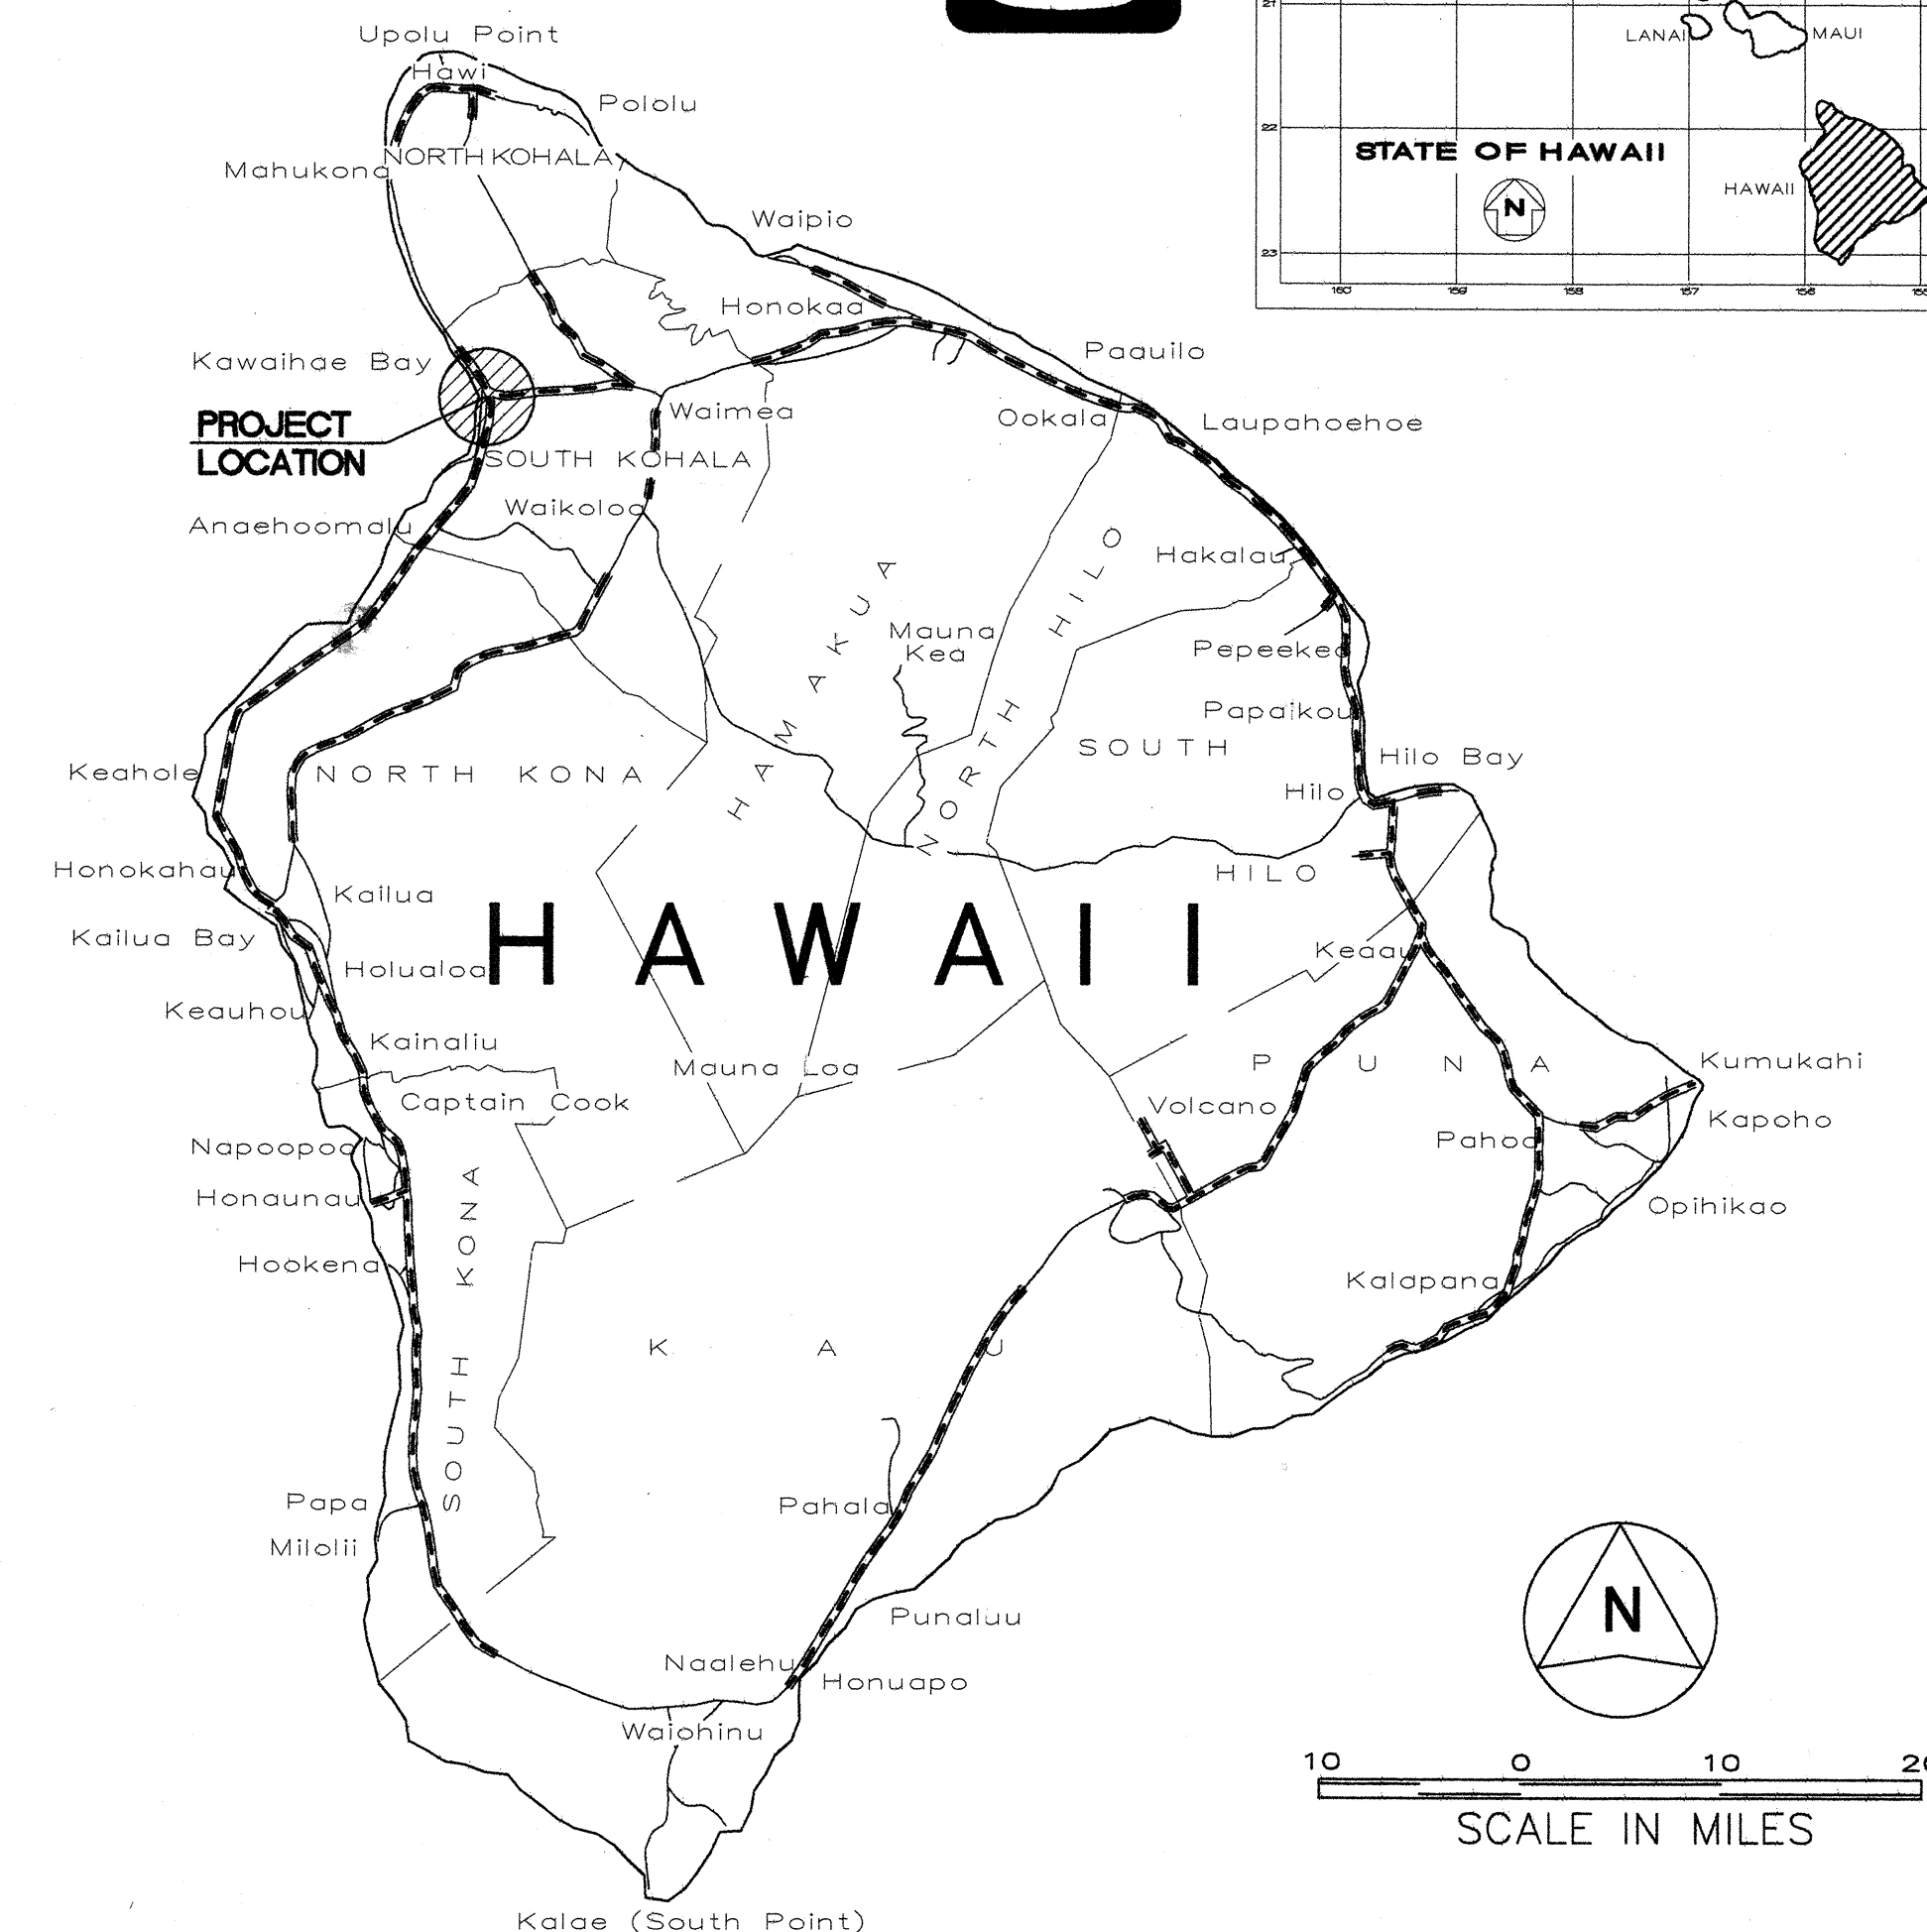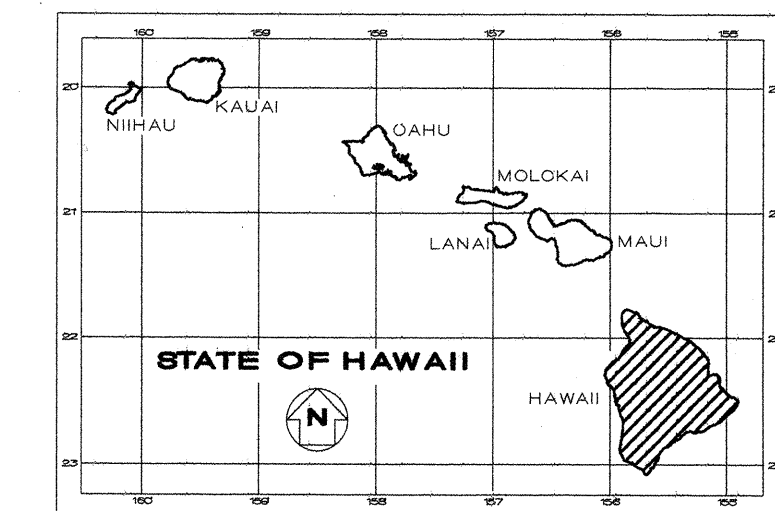

— FEDERAL AID PROJECTS PREVIOUSLY CONSTRUCTED OR UNDER CONSTRUCTION

MILE POST 63.30 TO MILE POST 69.50

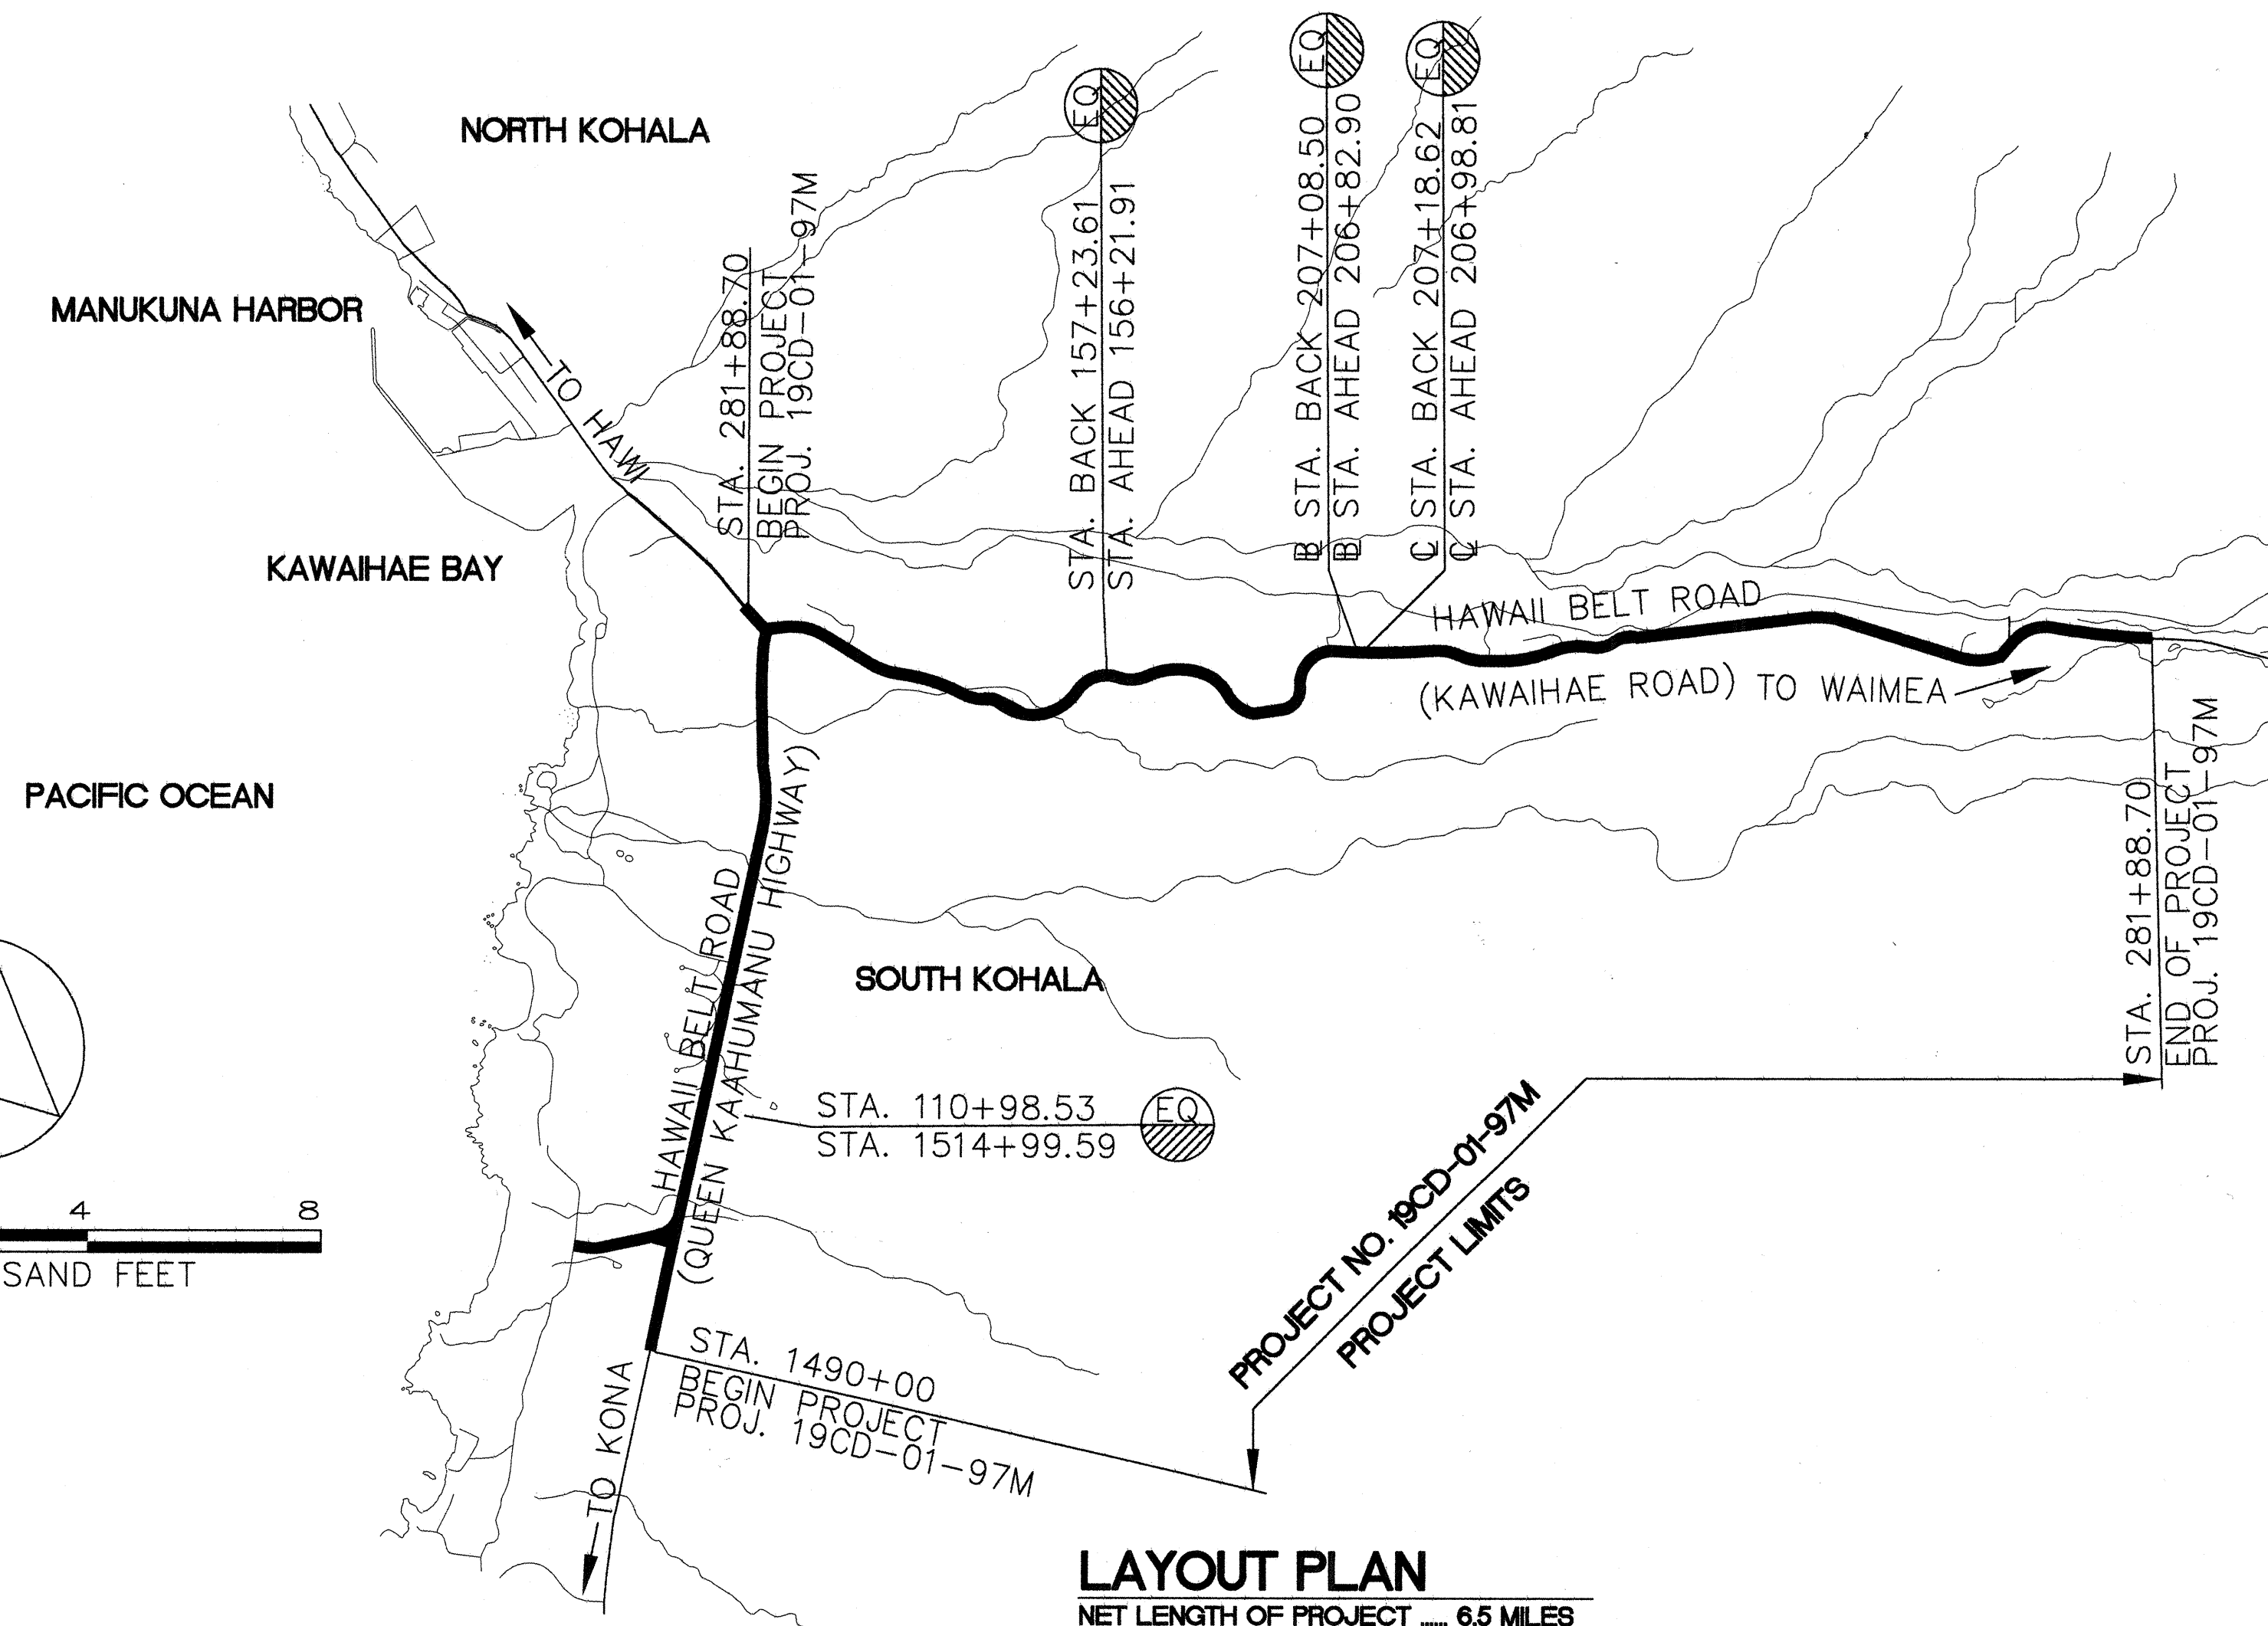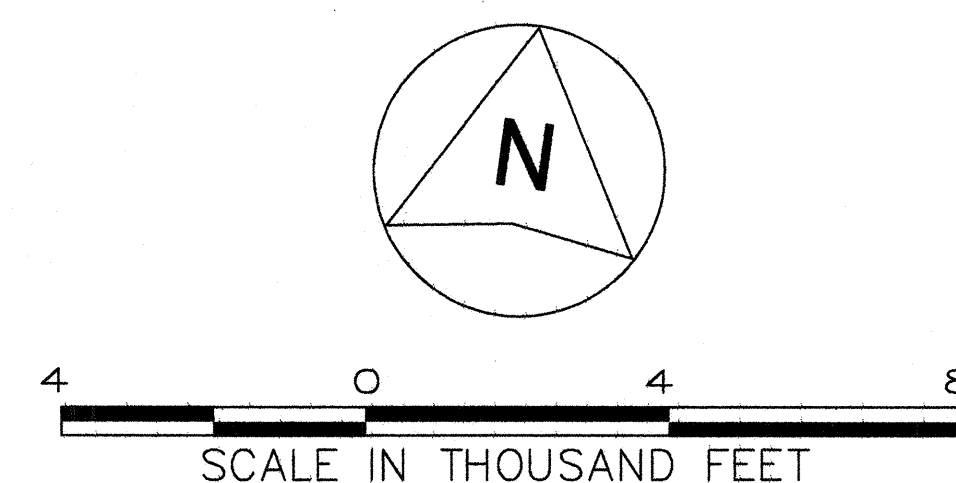

LAYOUT PLAN
NET LENGTH OF PROJECT 6.5 MILES

CHANGES MADE DURING CONSTRUCTION HAVE BEEN INCORPORATED ON THESE PLANS EXCEPT CHANGES IN THE ORIGINAL THEORETICAL QUANTITIES. FOR ACTUAL QUANTITIES, REFER TO PROJECT LEDGER AND/OR COMPUTATION BOOK.

[Signature] 4-13-06
RESIDENT ENGINEER DATE

DEPARTMENT OF TRANSPORTATION
STATE OF HAWAII
APPROVED: *[Signature]* 5/28/97
DIR. OF TRANSPORTATION DATE

DESIGNED BY J. FRONDA 587-2246 APRIL 1997
P. S. & E. BY PHONE DATE
WESLEY R. SEGAWA & ASSOC./HWY-H