

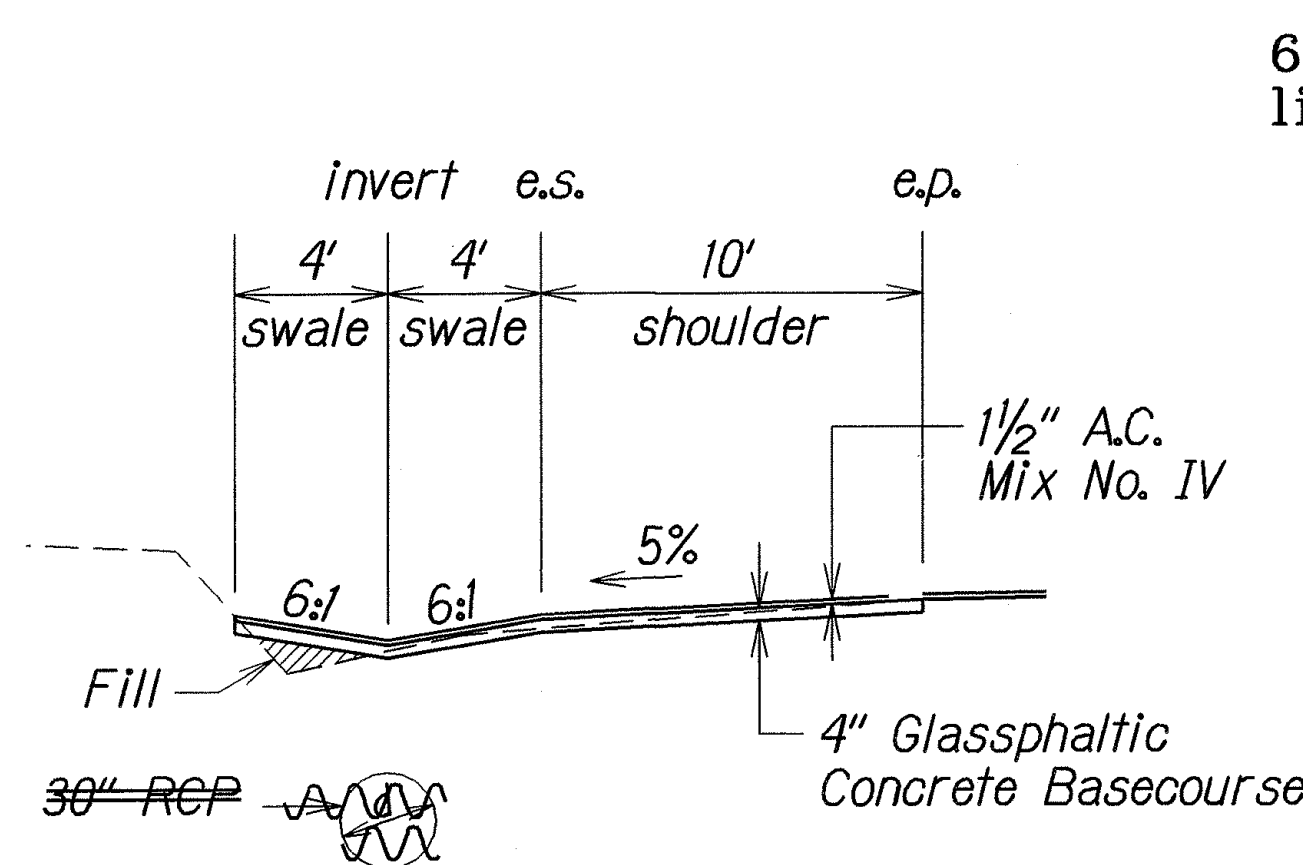
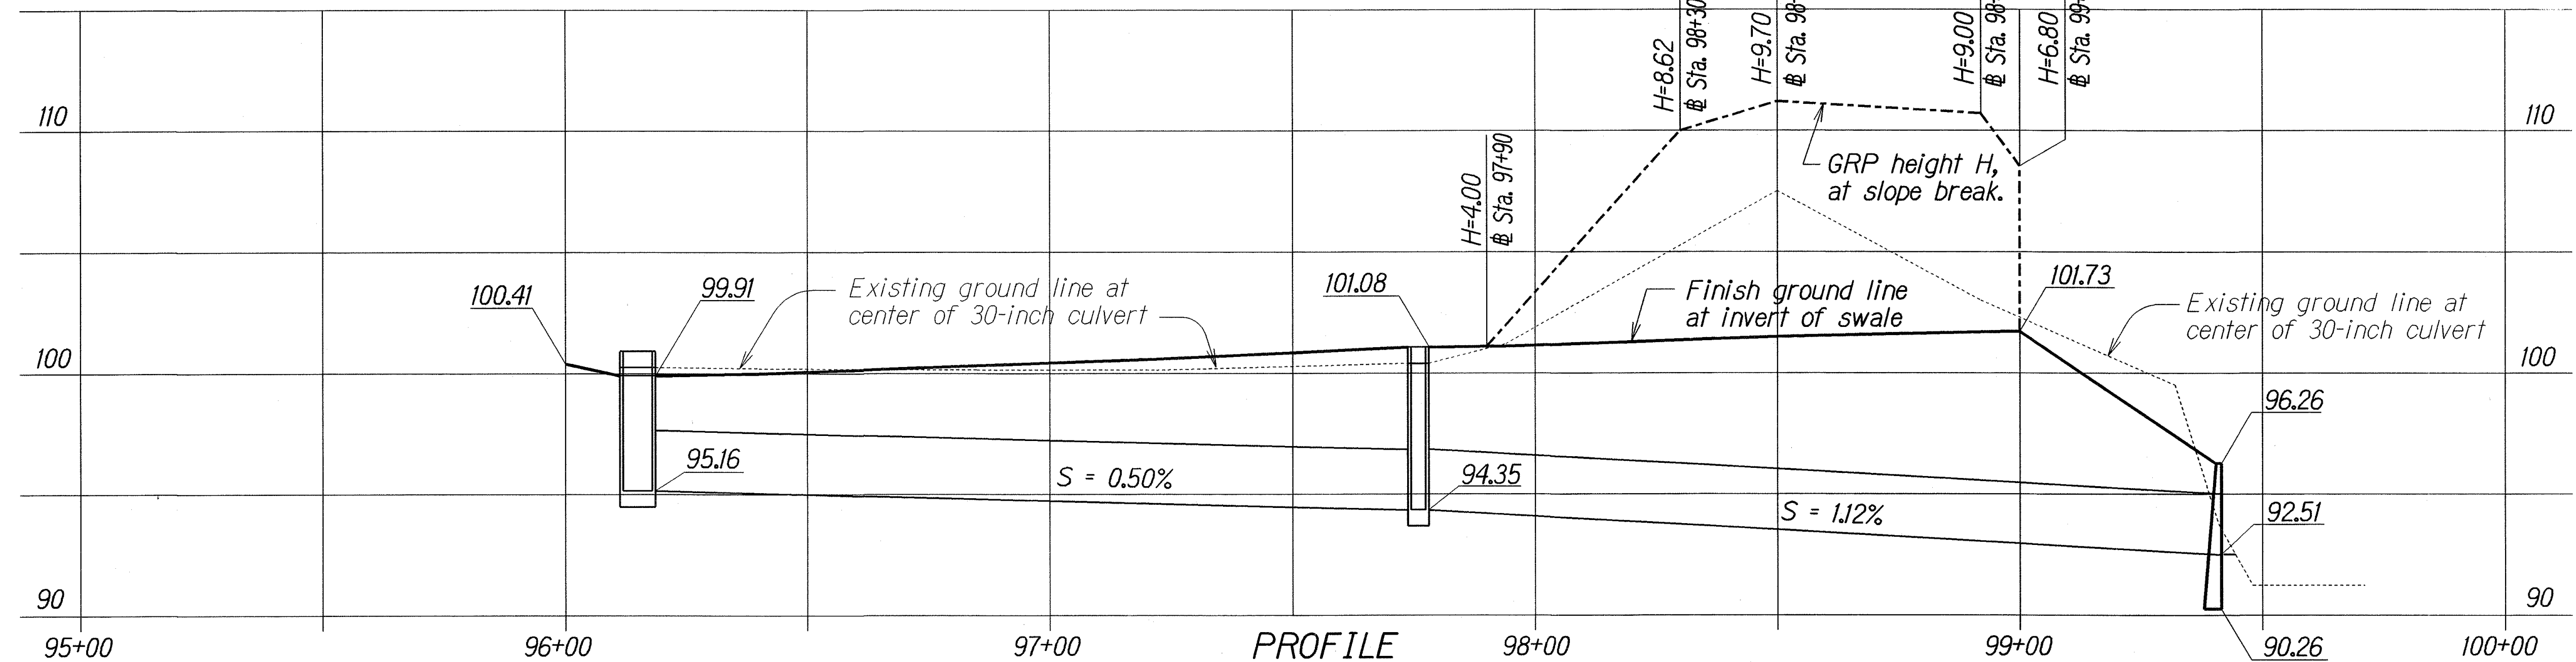



FED. ROAD DIST. NO.	STATE	PROJ. NO.	FISCAL YEAR	SHEET NO.	TOTAL SHEETS
HAWAII	HAW.	19J-01-97M	1997	14	35

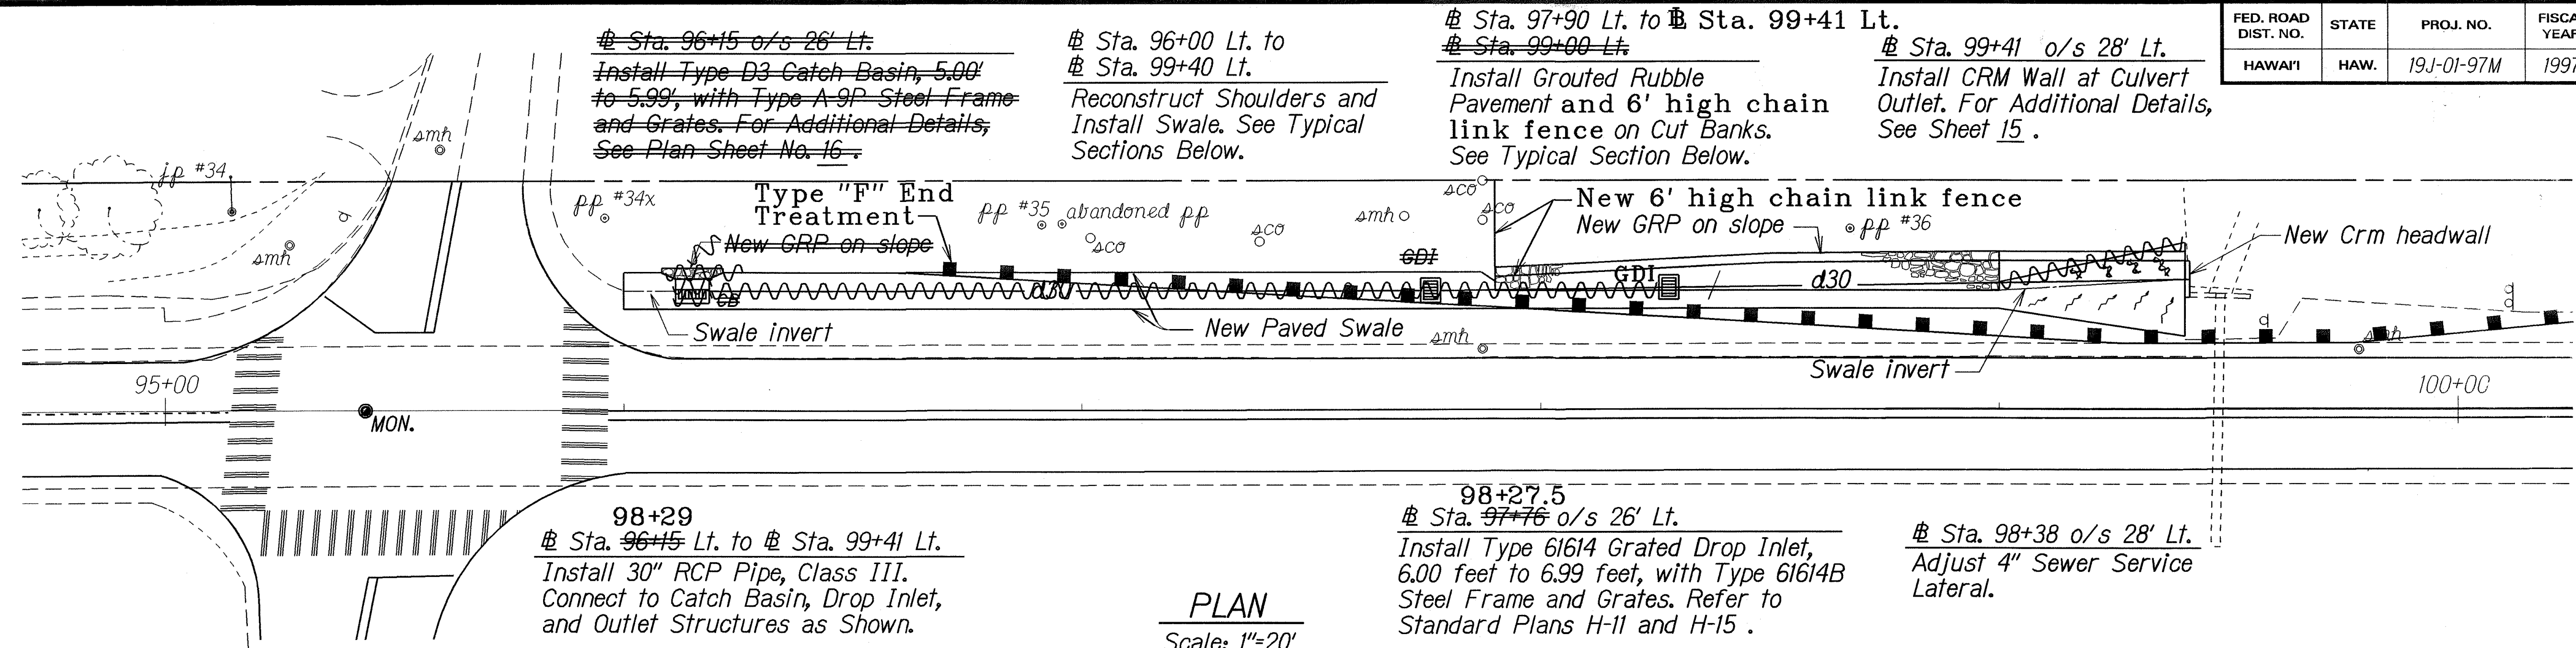

TYPICAL SHOULDER SECTION
(Sta. 96+00 Lt. to Sta. 97+90 Lt.)
Not To Scale

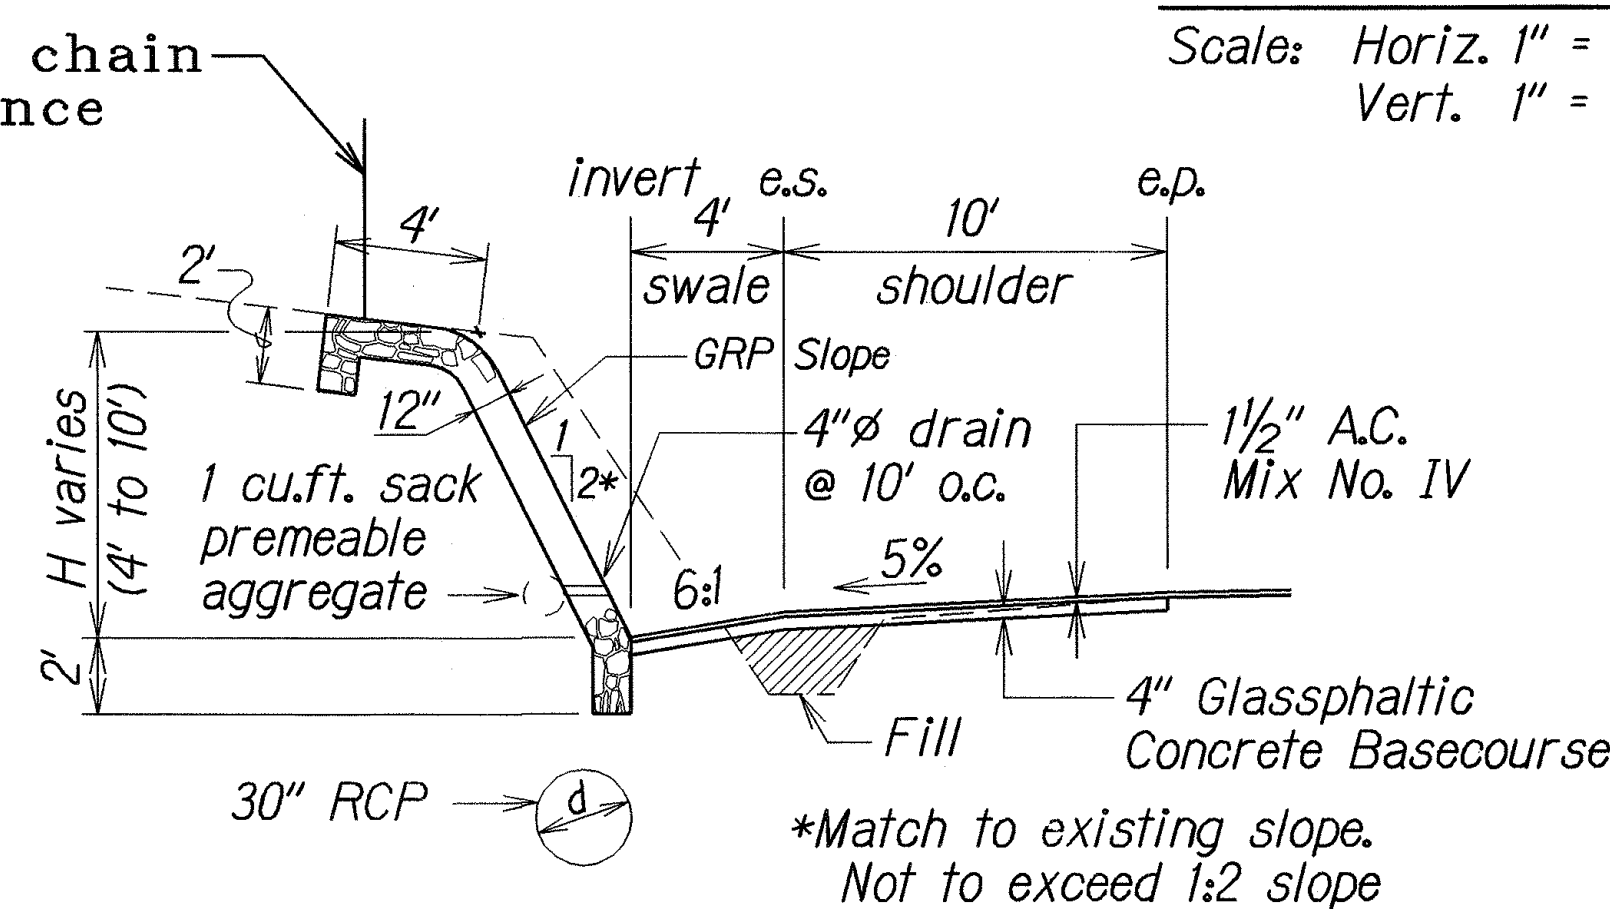

TYPICAL SHOULDER SECTION
(Sta. 97+90 to Sta. 99+41 Lt.)
Not To Scale

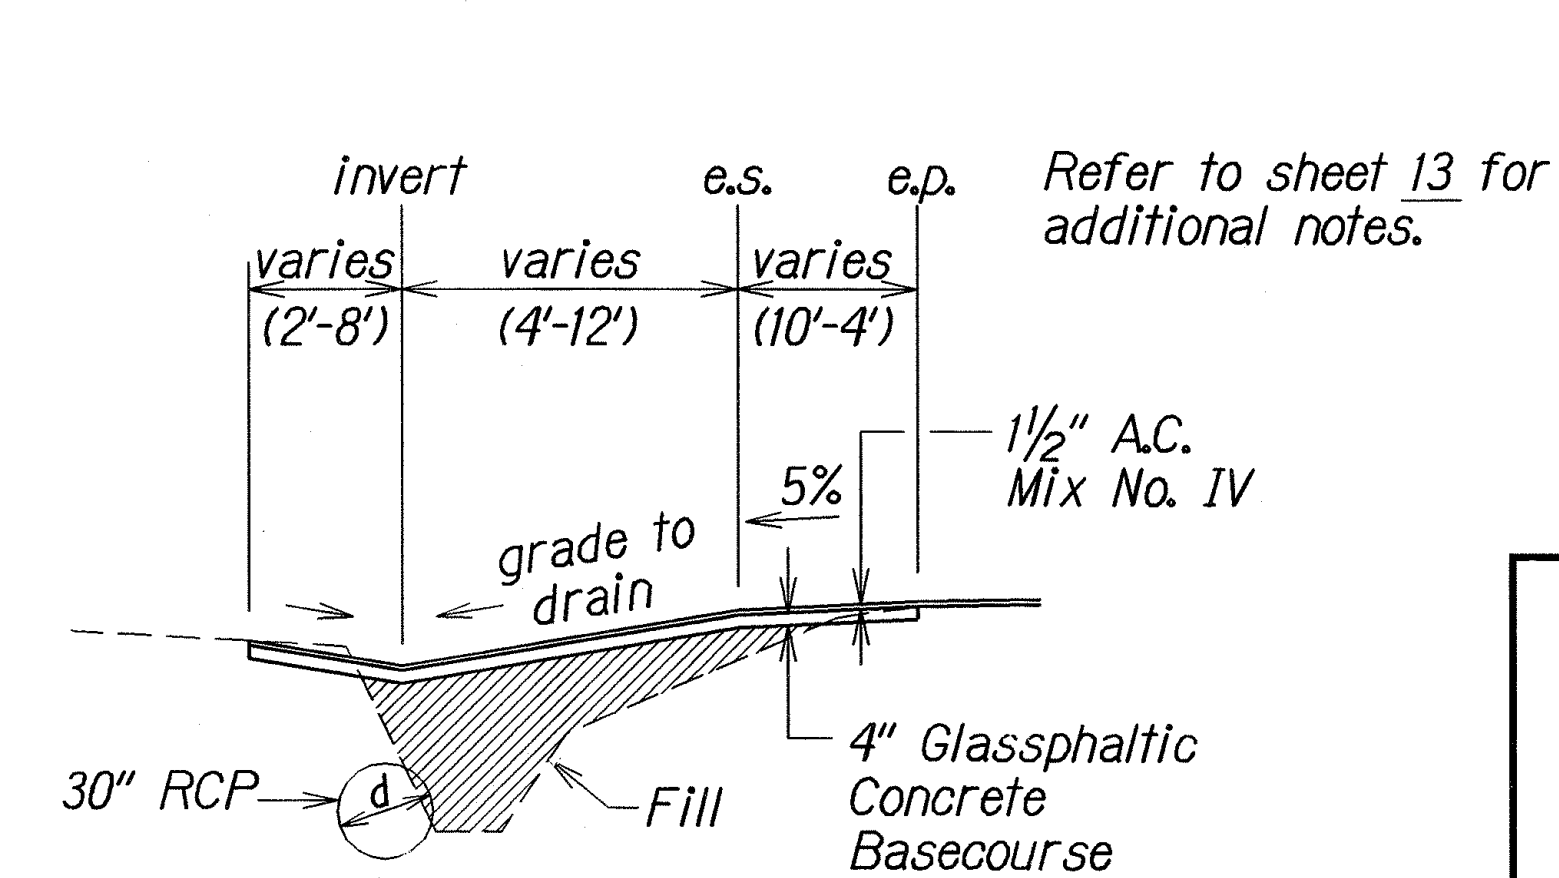

TYPICAL SHOULDER SECTION
(Sta. 99+00 Lt. to Sta. 99+40 Lt.)
Not To Scale

LEGEND FOR AS-BUILT POSTINGS	
	Squiggly line for as-built deletion
	Double line for as-built deletion
	Text for as-built posting

STATE OF HAWAII
DEPARTMENT OF TRANSPORTATION
HIGHWAYS DIVISION

DRAINAGE FACILITY B
STA 96+00 TO 99+41
HAWAII BELT ROAD RESURFACING
PAUKA'A TO PAPA'IKOU
PROJECT NO. 19J-01-97M

Scale: As Shown Date: Jan., 1997

SHEET No. 1 OF 1 SHEETS

"AS-BUILT"