




FED. ROAD DIST.	STATE	PROJ. NO.	FISCAL YEAR	SHEET NO.	TOTAL SHEETS
HAWAII	HAW.	19J-01-97M	1997	23	35

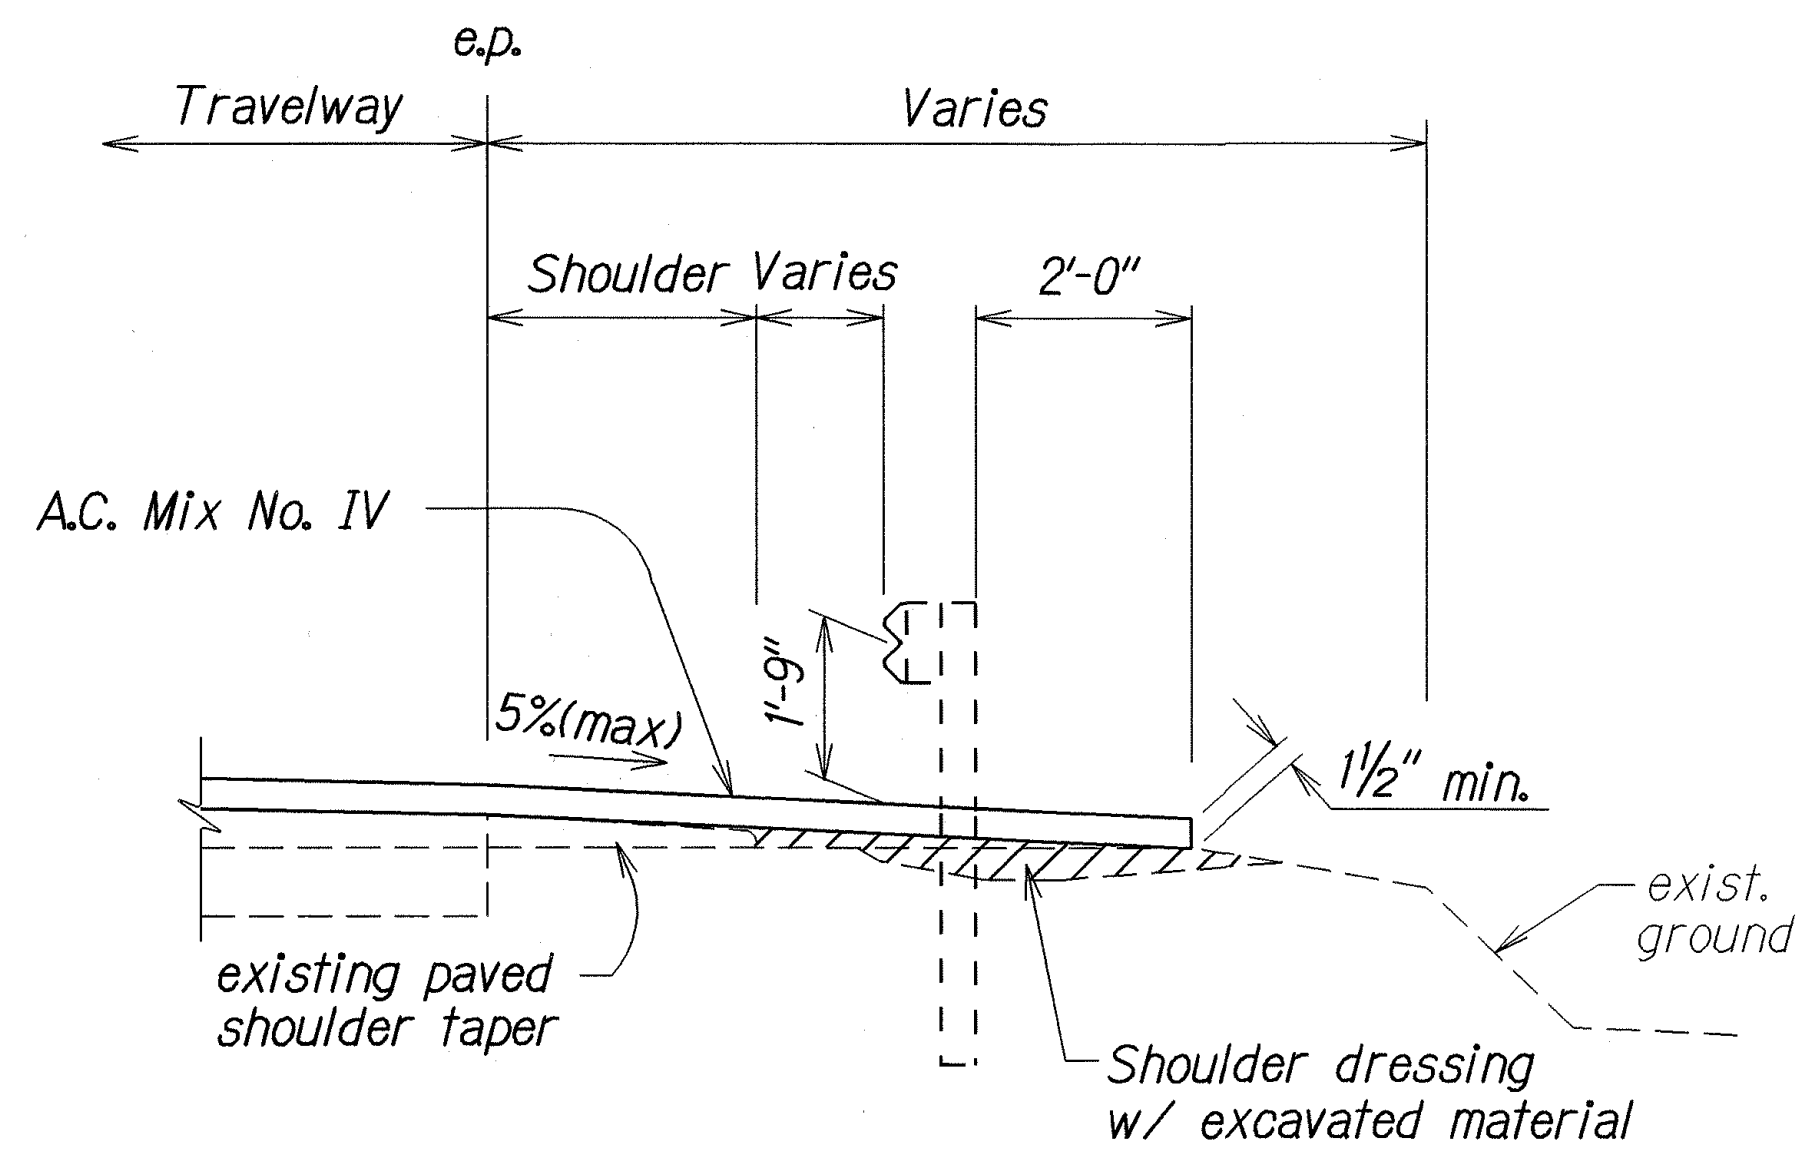


TYPICAL SECTION - GUARDRAIL PAVING DETAIL
Not To Scale

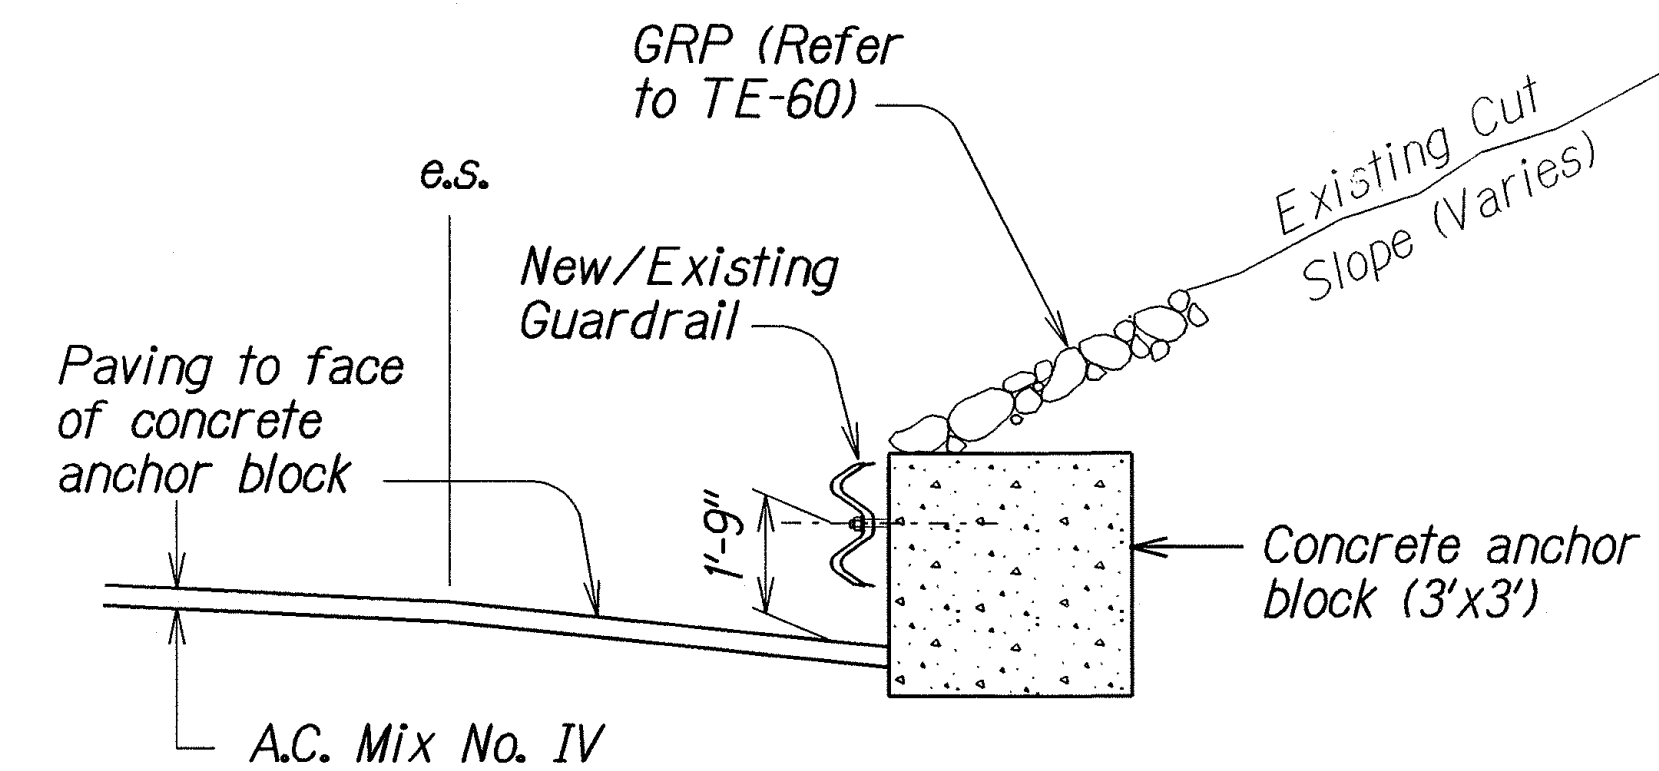

SECTION "A-A"
Not To Scale

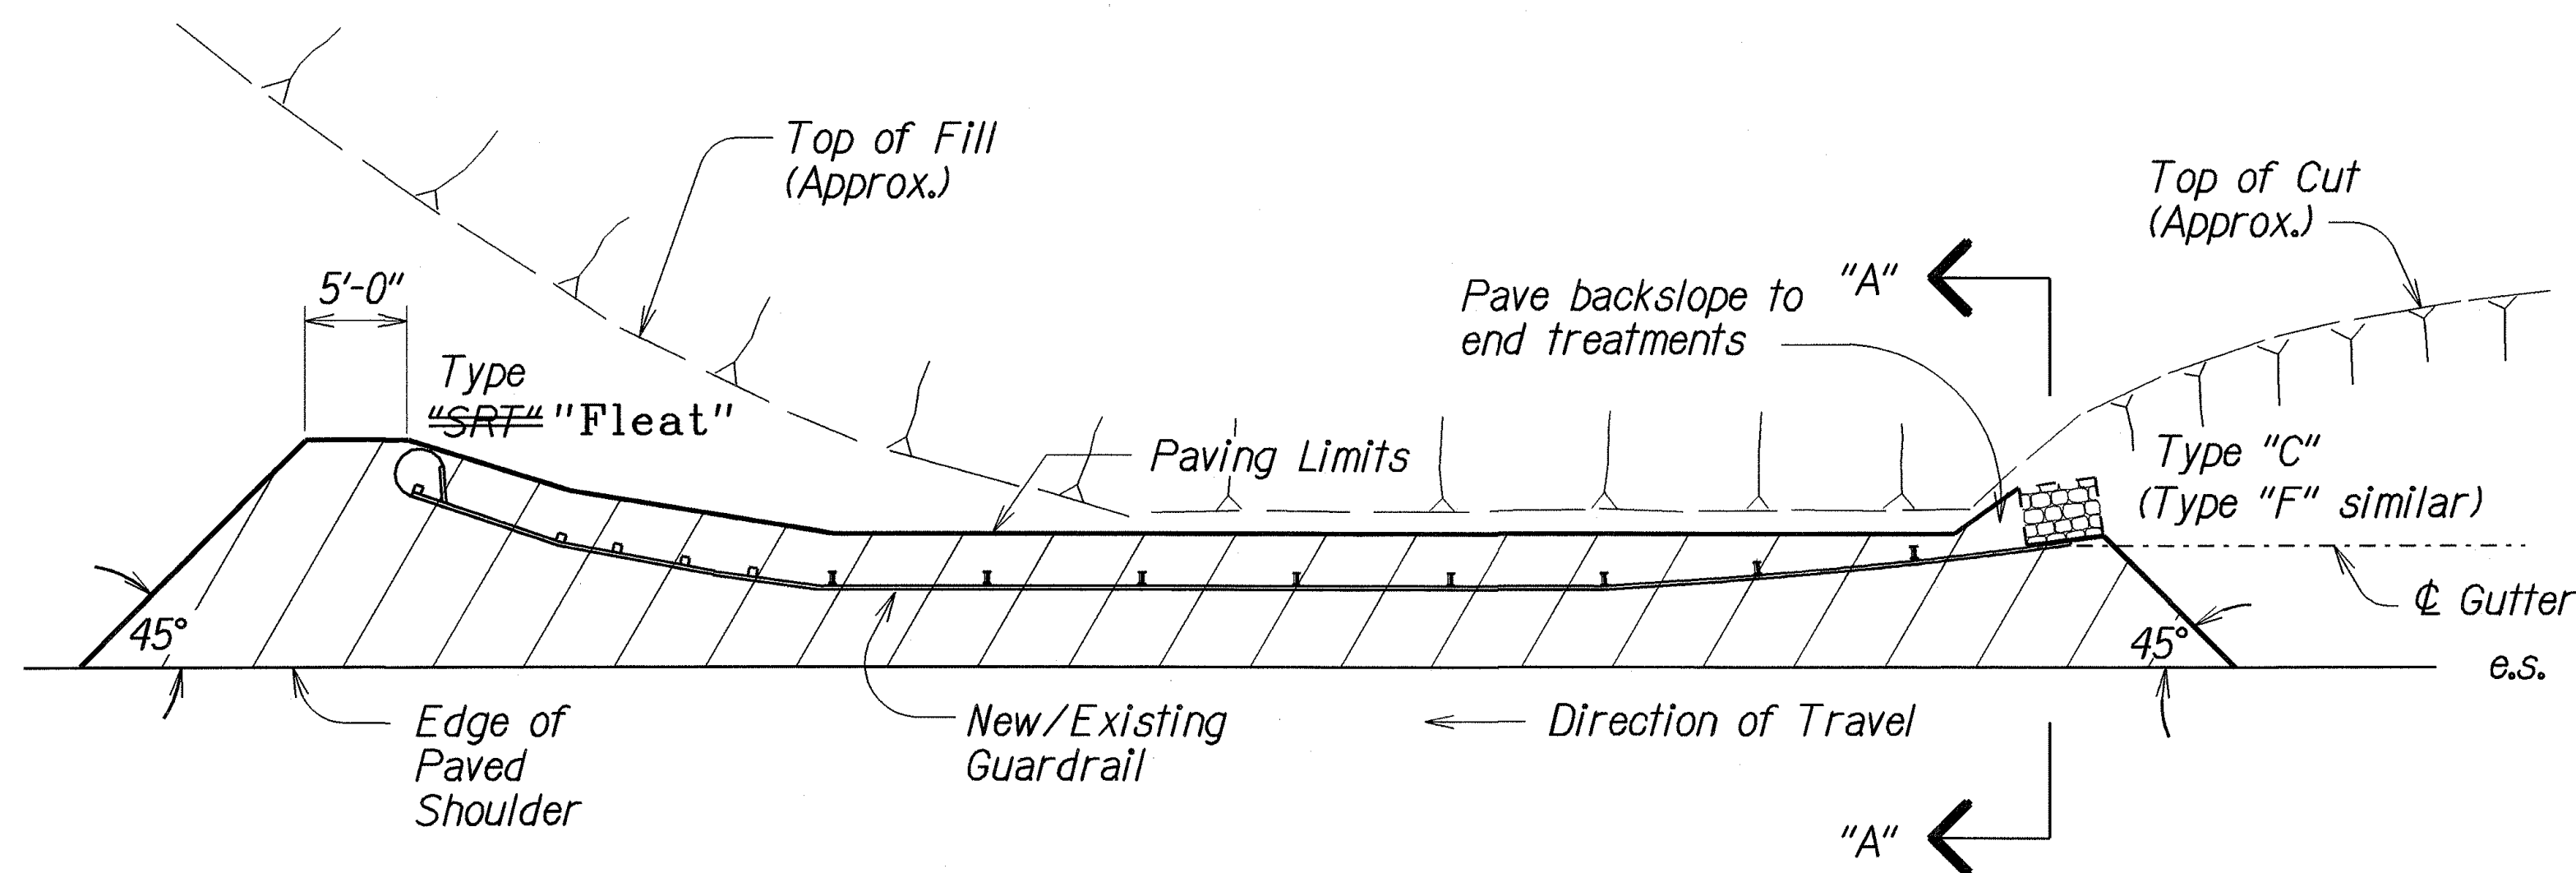



TYPICAL PLAN
Not To Scale

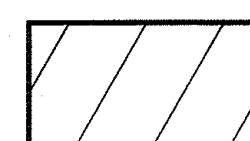 - Area to be paved

Estimated Area to be Paved = 36,878 S.F.

NOTES:

Refer to General Notes 12 and 16 on Sheet 3 regarding preparation and dressing of shoulder areas. A.C. Mix No. IV shall be paid for under Item No. 401.0400.
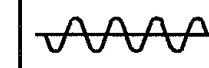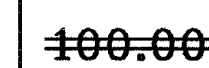
<u>LEGEND FOR AS-BUILT POSTINGS</u>	
	Squiggly line for as-built deletion
	Double line for as-built deletion
Roadway	Text for as-built posting

STATE OF HAWAII DEPARTMENT OF TRANSPORTATION HIGHWAYS DIVISION	
<u>GUARDRAIL PAVING DETAILS</u>	
<u>HAWAII BELT ROAD RESURFACING</u> <u>PAUKAA TO PĀPĀIKOU</u> <u>PROJECT NO. 19J-01-97M</u>	
Scale: As Shown	Date: Jan., 1997
SHEET No. 1 OF 1 SHEETS	

"AS-BUILT"