



FED. ROAD DIST.	STATE	PROJ. NO.	FISCAL YEAR	SHEET NO.	TOTAL SHEETS
HAWAII	HAW.	19J-01-97M	1997	24	35

NOTES:

- Reflector markers located behind guardrail shall be installed with steelposts. At all other locations reflector markers with flexible delineator posts shall be installed.
- Exact location of Reflector Markers shall be determined in the field by the Engineer.

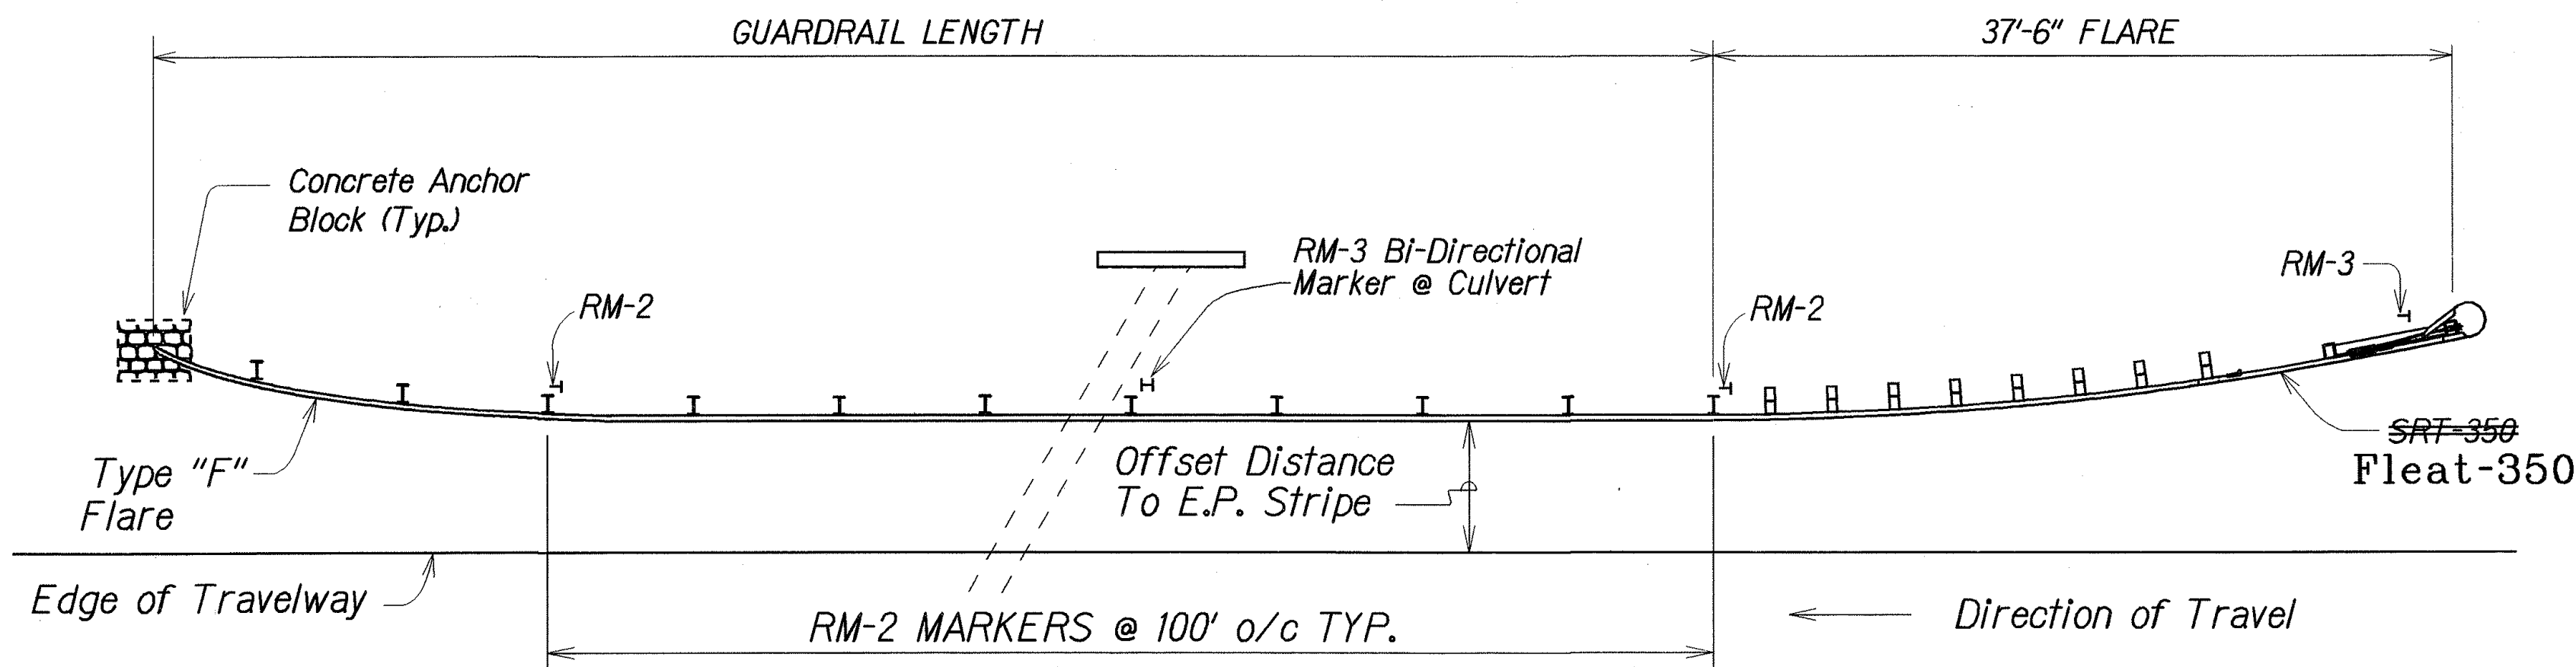

FLEAT
TYPICAL @ "SRT-350" & "F" END TREATMENT

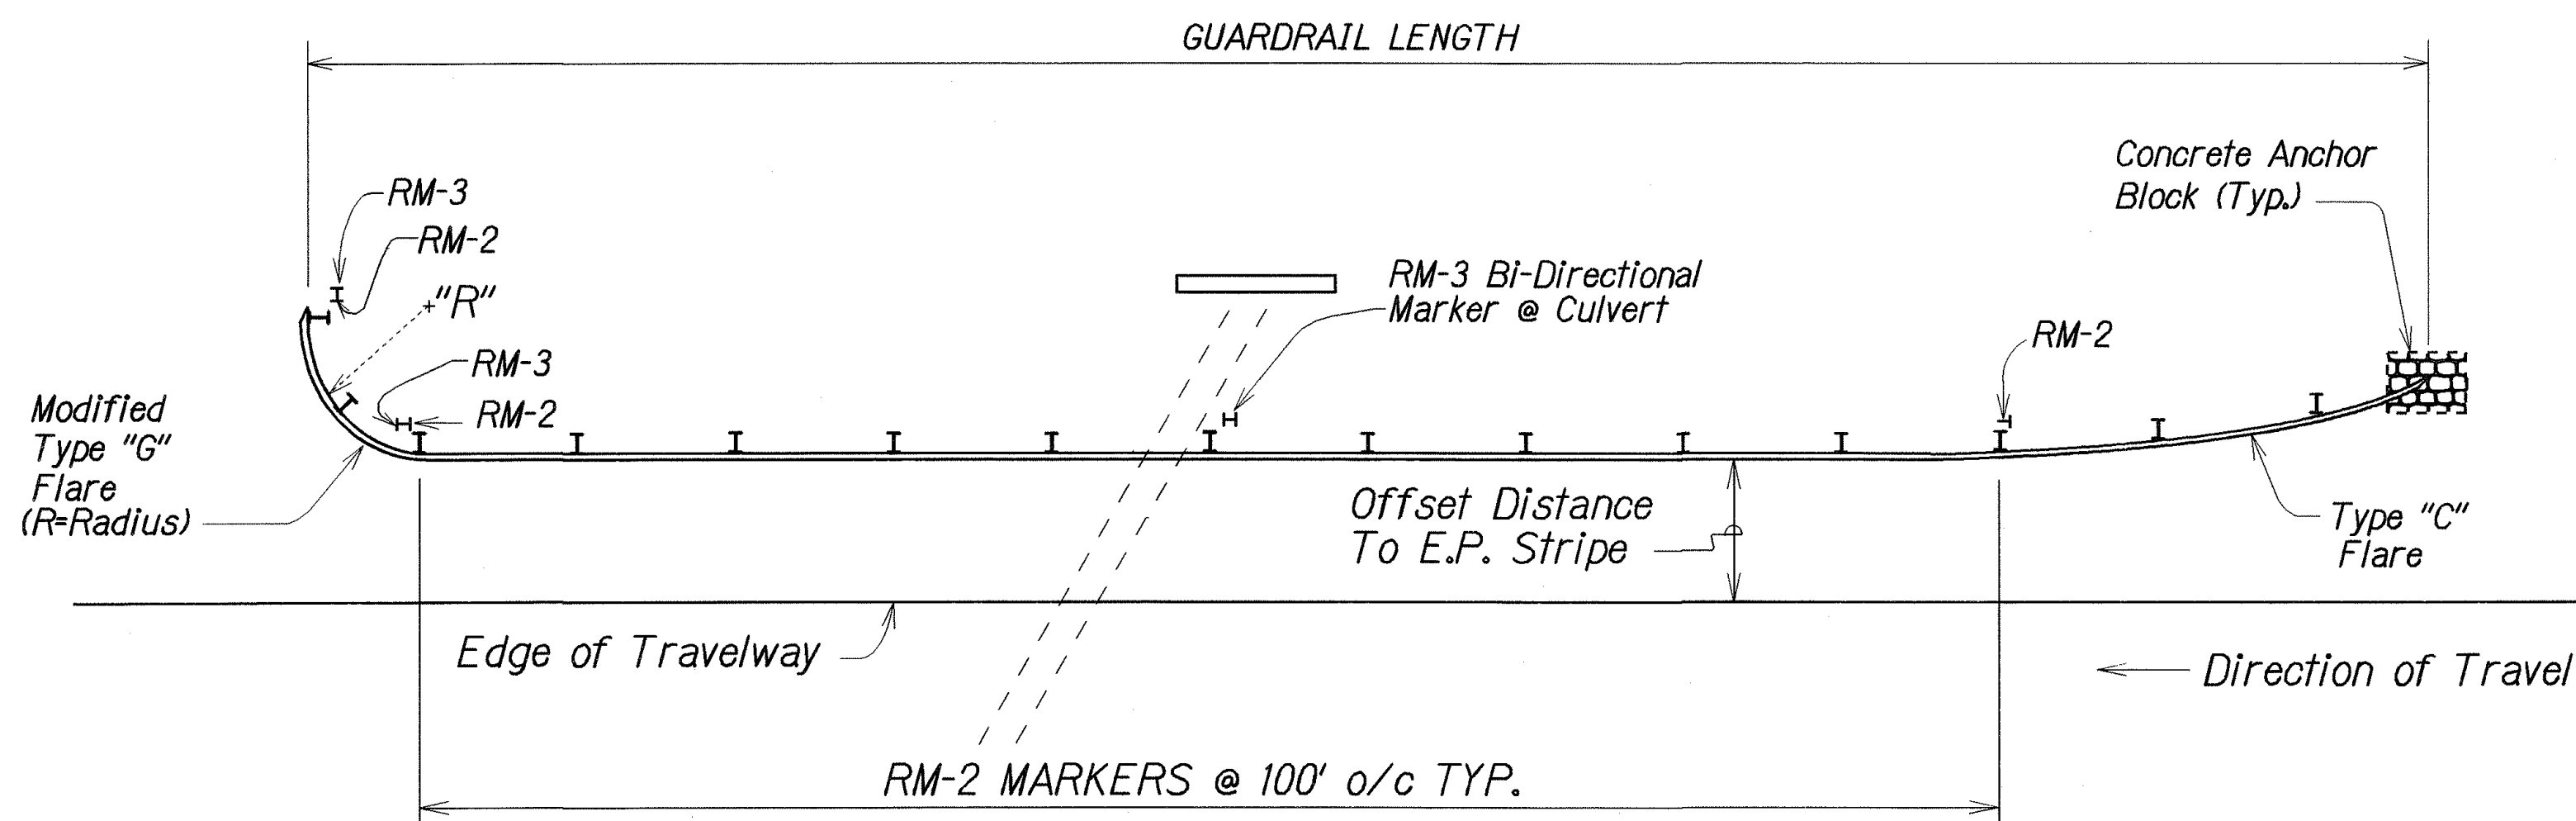

TYPICAL @ MODIFIED "G" & "C" END TREATMENT

TYPICAL GUARDRAIL REFLECTOR MARKER INSTALLATION

Not To Scale

LEGEND FOR AS-BUILT POSTINGS	
	Squiggly line for as-built deletion
	Double line for as-built deletion
Roadway	Text for as-built posting

STATE OF HAWAII
DEPARTMENT OF TRANSPORTATION
HIGHWAYS DIVISION

**GUARDRAIL REFLECTOR
MARKER DETAIL**

HAWAII BELT ROAD RESURFACING
PAUKA'A TO PAPA'IKOU
PROJECT NO. 19J-01-97M

Scale: As Shown
Date: Jan., 1997

SHEET NO. 1 OF 1 SHEETS

ORIGINAL PLAN	SURVEY PLOTTED BY	DATE
NOTE BOOK	DRAWN BY	
integrated	TRACED BY	
N. dgn	QUANTITIES BY	
	CHECKED BY	