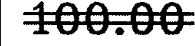


FED. ROAD DIST. NO.	STATE	PROJ. NO.	FISCAL YEAR	SHEET NO.	TOTAL SHEETS
HAWAII	HAW.	19J-01-97M	1997	32	35

CENTERLINE AND REFERENCE SURVEY MONUMENT SCHEDULE							
PROJECT	STATION	MONUMENT TYPE	Adjust Centerline and Reference Mon. (ITEM NO. 613.0110)	Reconstruct Centerline and Reference Mon. (ITEM NO. 613.0120)	Furnish & install Centerline and Reference Mon. (ITEM NO. 613.0130)	CENTERLINE OFFSET (FT.)	EXISTING DEPTH (FT.)
SDR 3(4)	18+51.74	P.C.		1		0.00	0.27
	31+79.24 (Bk) 31+90.30 (Ah)	P.T.		1		0.00	0.23
	62+26.08	R.O.W.				0.20 Lt.	0.12
	63+72.15	S.C.	1			0.40 Lt.	0.12
	71+23.87	C.S.	1			0.00	0.12
	72+44.56	R.O.W.	1			0.10 Lt.	0.11
	94+00	P.I.	1			1.40 Lt.	0.11
	95+43.75	P.T.	1			0.00	0.12
	105+21.86	R.O.W.	1			0.30 Rt.	0.12
	107+28.96	S.C.	1			0.15 Rt.	0.12
	118+00	P.O.C.	1			0.10 Lt.	0.11
FA-F-14B(1)	0+07.54	C.S.	1			0.25 Lt.	0.12
	2+07.54	R.O.W.	1			0.00	0.12
TOTAL			11	2	0		

ROUTE MARKER SCHEDULE							
PROJECT	STATION	LEFT	RIGHT	ROUTE MARKER SIGN NO. (ROUTE NO.)	REMOVE	INSTALL ASSEMBLY	
						TYPE A	TYPE B
SDR 3(4)	50+13	●	●	M1-6 (19)	1	1	
	50+52	●	●	M1-6 (19)	1	1	
FA-F14B(1)	3+21	●		M1-6 (19)	1	1	
	4+48	●		M1-6 (19)/M6-4	1	1	
Scenic Route	1+15		●	M1-6 (19)/M6-4	1	1	
TOTALS					5	5	—

MILEPOST MARKER SCHEDULE						
PROJECT	STATION	LEFT	RIGHT	MILE POST D10-4 (12"X24") MILE POST NO. (RTE. NO.)	REMOVE	INSTALL WITH POST (Bi-Directional)
SDR-3(4)	60+73		●	6 (19)	1	1
	113+38		●	7 (19)	1	1
TOTALS					2	2

LEGEND FOR AS-BUILT POSTINGS	
	Squiggly line for as-built deletion
	Double line for as-built deletion
Roadway	Text for as-built posting

STATE OF HAWAII DEPARTMENT OF TRANSPORTATION HIGHWAYS DIVISION	
MISCELLANEOUS SCHEDULES	
HAWAII BELT ROAD RESURFACING PAUKA'A TO PĀPA'IKOU PROJECT NO. 19J-01-97M	
Scale: None	Date: Jan., 1997
SHEET No. 1 OF 1 SHEETS	

ORIGINAL PLAN	SURVEY PLOTTED BY	DATE
NOTE BOOK	DRAWN BY	1/97
DESIGNED BY	DESIGNED BY	
QUANTITIES BY	QUANTITIES BY	
CHECKED BY	CHECKED BY	
N.	N.	