


INDEX TO DRAWINGS	
SHEET NO.	DESCRIPTION
1	TITLE SHEET
2	STANDARD PLANS SUMMARY
3	GENERAL NOTES
4	TYPICAL SECTION
5	PĀPA'IKOU PEDESTRIAN OVERPASS
6	PAVEMENT RECONSTRUCTION DETAILS AND SCHEDULE
7	LEGEND
8 - 12	ROADWAY PLANS
13	DRAINAGE FACILITY A
14	DRAINAGE FACILITY B
15	CRM CULVERT DETAILS AND NOTES
16	DRAINAGE DETAILS, TYPE D3 C.B.
17	DRAINAGE DETAILS, TYPE A22 D.G.I.
18	UTILITY SCHEDULE
19 - 21	GUARDRAIL SCHEDULE
22	SRT-350 SLOTTED RAIL TERMINAL
23	GUARDRAIL PAVING DETAILS
24	GUARDRAIL REFLECTOR MARKER DETAIL
25 - 26	REFLECTOR AND OBJECT MARKER SCHEDULE
27	PAVEMENT MARKING LEGEND & NOTES
28	STRIPING AND PAVEMENT MARKING SCHEDULE
29 - 31	SIGN SCHEDULE, DETAILS AND NOTES
32	MISCELLANEOUS SCHEDULES
33	CONSTRUCTION SIGN PLAN AND SCHEDULE
34 - 35	TREE TRIMMING SECTION AND NOTES

SHEET NO. 19 C.O. 225-1 IS A SUPPLEMENTARY SHEET TO THIS PROJECT. TOTAL SHEET COUNT AFTER 'AS-BUILT' POSTING IS 35 SHEETS.



HAWAII DISTRICT DESIGNED BY J. FUJIMOTO
P.S. & E. BY 587-2249
DATE JAN. 1997

STATE OF HAWAII
DEPARTMENT OF TRANSPORTATION
HIGHWAYS DIVISION
HONOLULU, HAWAII
"AS-BUILT"
PLANS FOR
HAWAII BELT ROAD RESURFACING
PAUKA'A TO PĀPA'IKOU
PROJECT NO. 19J-01-97M

DISTRICT OF SOUTH HILO
ISLAND OF HAWAII

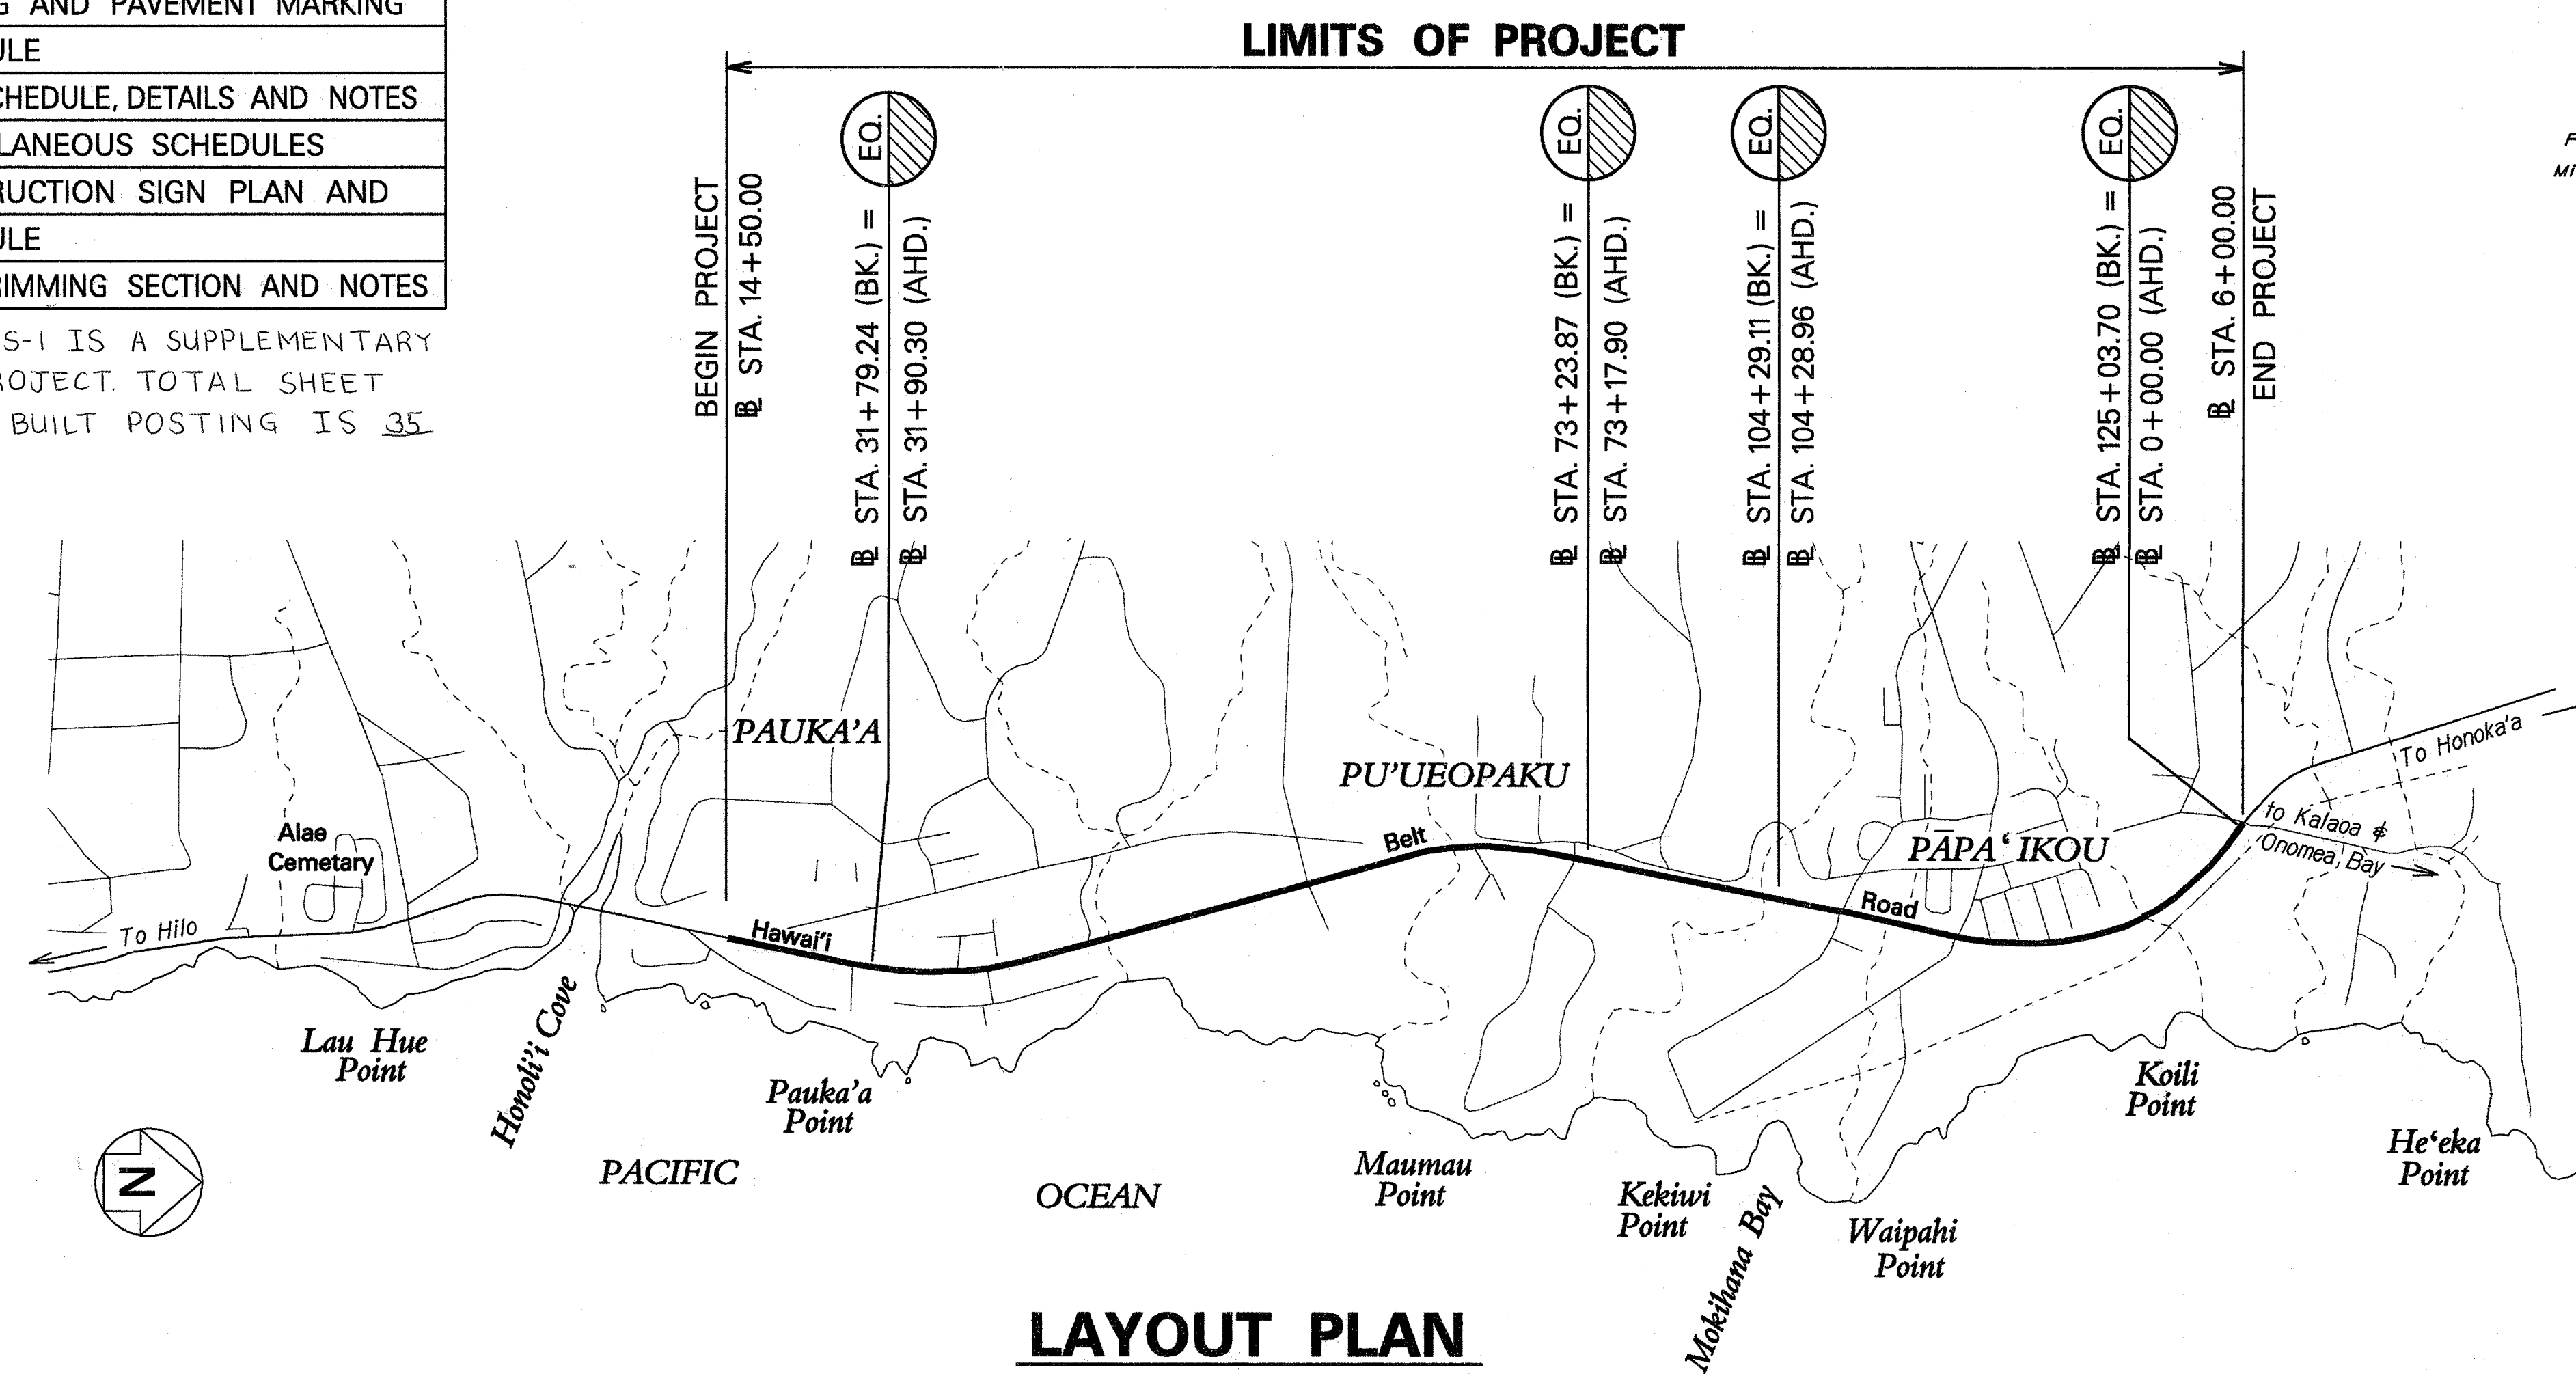

FED. ROAD DIST. NO.	STATE	PROJ. NO.	FISCAL YEAR	SHEET NO.	TOTAL SHEETS
HAWAII	HAW.	19J-01-97M	1997	1	35

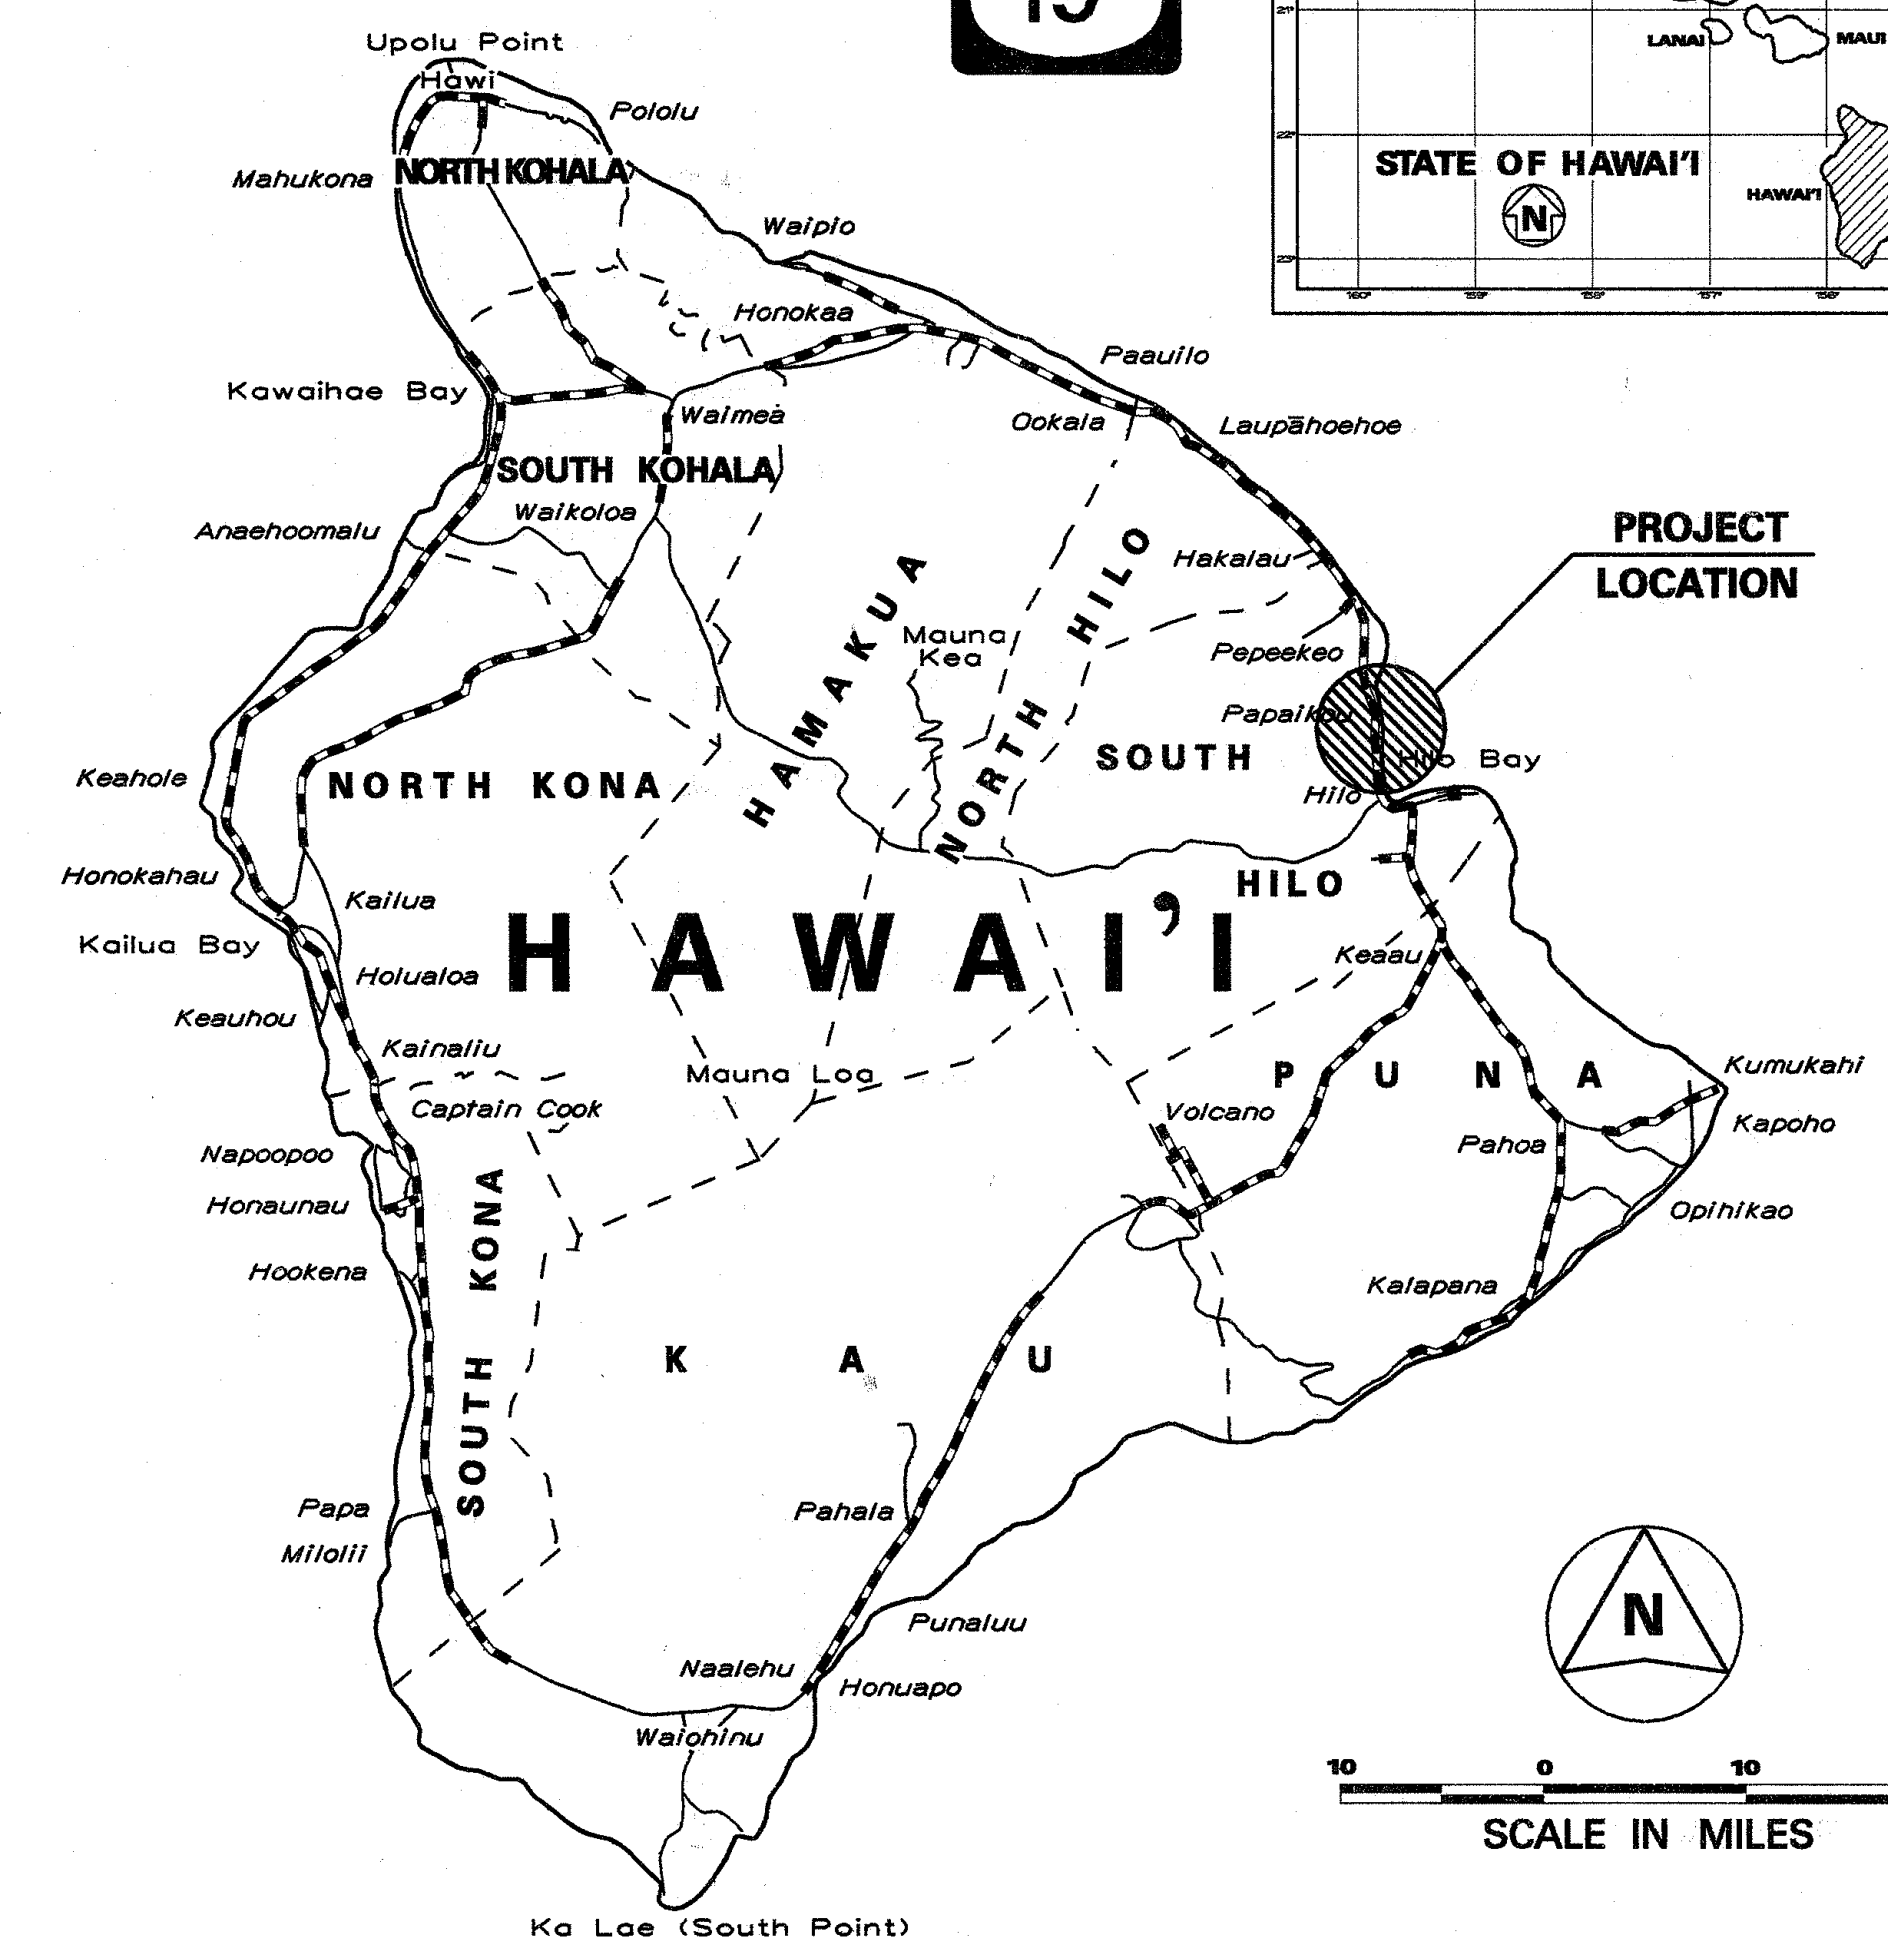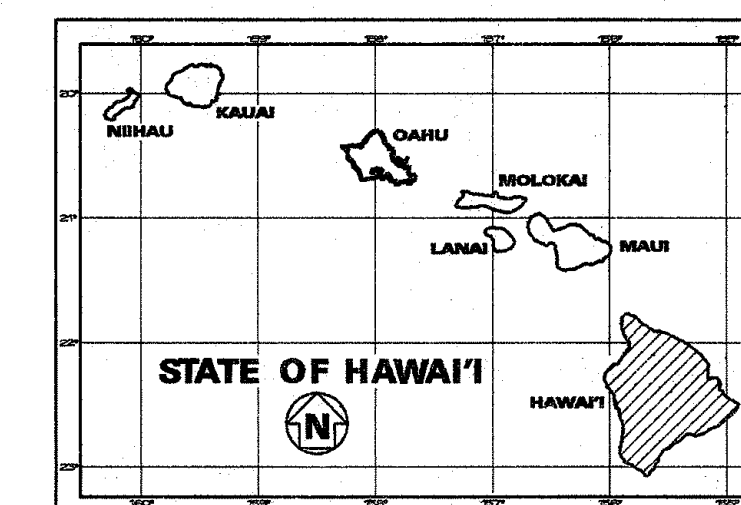

FEDERAL AID PROJECTS PREVIOUSLY CONSTRUCTED OR UNDER CONSTRUCTION

MILE POST 5.12 TO MILE POST 7.33

CHANGES MADE DURING CONSTRUCTION HAVE BEEN INCORPORATED ON THESE PLANS EXCEPT CHANGES IN THE ORIGINAL THEORETICAL QUANTITIES. FOR ACTUAL QUANTITIES, REFER TO PROJECT LEDGER AND/OR COMPUTATION BOOK.

12-12-08

DEPARTMENT OF TRANSPORTATION
STATE OF HAWAII
APPROVED: *[Signature]* 5/29/97
DIR. OF TRANSPORTATION DATE

SCALE IN THOUSAND FEET