


DATE
SURVEY PLOTTED
DRAWN BY
DESIGNED BY
NOTED BY
CHECKED BY
ORIGINAL
PLAN
BOOK
No.

FROM	TO	MAIN CONTROL		SIGNAL CONTROL		DETECTORS		TELEPHONE		INTERCONNECT		OPTICOM		SPARE	STREET LIGHTING		REMARKS
		CONDUIT	CONDUCTORS	CONDUIT	CONDUCTORS	CONDUIT	CONDUCTORS	CONDUIT	CONDUCTORS	CONDUIT	CONDUCTORS	CONDUIT	CONDUCTORS	CONDUIT	CONDUIT	CONDUCTORS	
		2"	26C #14	2"	1 - #14 COLOR CODED	2"	2 - #16 VEHICLE	2"		2"		1 1/2"	3C #20	1 1/2"	2"	SEE ELECT. PLANS	
CONT.	PB1	2	2			2	7			1		1	3				
PB1	PB1A	1	1							1							
PB1	PB2	2	2			2	7					1	2		1		
PB1A	C			1	8							1	1				
PB1A	PB12									1							
PB2	PB3	1	1			1	2								1		
PB2	PB8	1	1			1	4					1	2				
PB3	D			1	4												
PB3	PB4					1	2								1		
PB3	PB7	1	1												1		
PB4	PB5					1	1										
PB5	PB6					1	1										
PB7	F			1	4							1	1				
PB7	PB7A	1	1									1	1				
PB7	PB8	1	1									1	1				
PB7A	E			1	12							1	1				
PB8	A			1	4							1	1				
PB8	PB8A	1	1			1	3										
PB8A	B			1	4												
PB8A	PB9					1	3										
PB9	PB10					1	1										
PB10	PB11					1	1										
PB12	PB13									1							
PB13	PB14									1							
PB14	PB15									1							
PB15	PB16									1							
PB16	PB17									1							
PB17	PB18									1							
PB18	PB19									1							
PB19	PB20									1							
PB20	PB21									1							
PB21	PB22									1							
PB22	PB23									1							
PB23	PB24									1							
PB24	PB25									1							
PB25	PB26									1							
PB26	Exist. PB1									1							
Exist. PB2	Exist. PB3									1							
Exist. PB3	Exist. PB4									1							
Exist. PB4	Exist. PB5									1							
Exist. PB5	Exist. Cont.									1							

CONDUIT – CABLE TABLE

FED.ROAD DIST.NO	STATE	FED.AID PROJ.NO	FISCAL YEAR	SHEET NO.	TOTAL SHEETS
HAWAII	HAW.	STP-019-1(22)	1998	7	17

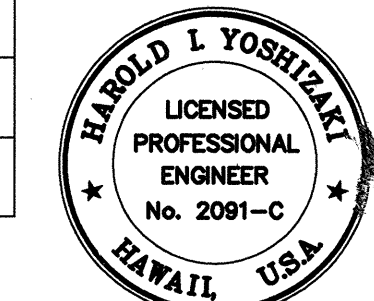

THIS WORK WAS PREPARED BY ME
OR UNDER MY SUPERVISION.
Harold L. Yoshizaki
SHIMABUKURO, ENDO & YOSHIKAWA, INC.
1126 12th Avenue
Honolulu, Hawaii 96816

10-8-97 Removed Interconnect Conductors (12 pr #19) and added Street Lighting

DATE REVISION

STATE OF HAWAII
DEPARTMENT OF TRANSPORTATION
HIGHWAYS DIVISION

CONDUIT – CABLE TABLE

QUEEN KAAHUMANU HIGHWAY
TRAFFIC SIGNALS AT KAIMINANI DRIVE
FED. AID PROJECT NO. STP-019-1(22)

SCALE: DATE:

SHEET NO. 4 OF 4 SHEETS