



FED. ROAD DIST. NO.	STATE	FED. AID PROJ. NO.	FISCAL YEAR	SHEET NO.	TOTAL SHEETS
HAWAII	HAW.	STP-019-1(22)	1998	8	17

TRUE NORTH
Scale: 1" = 20'

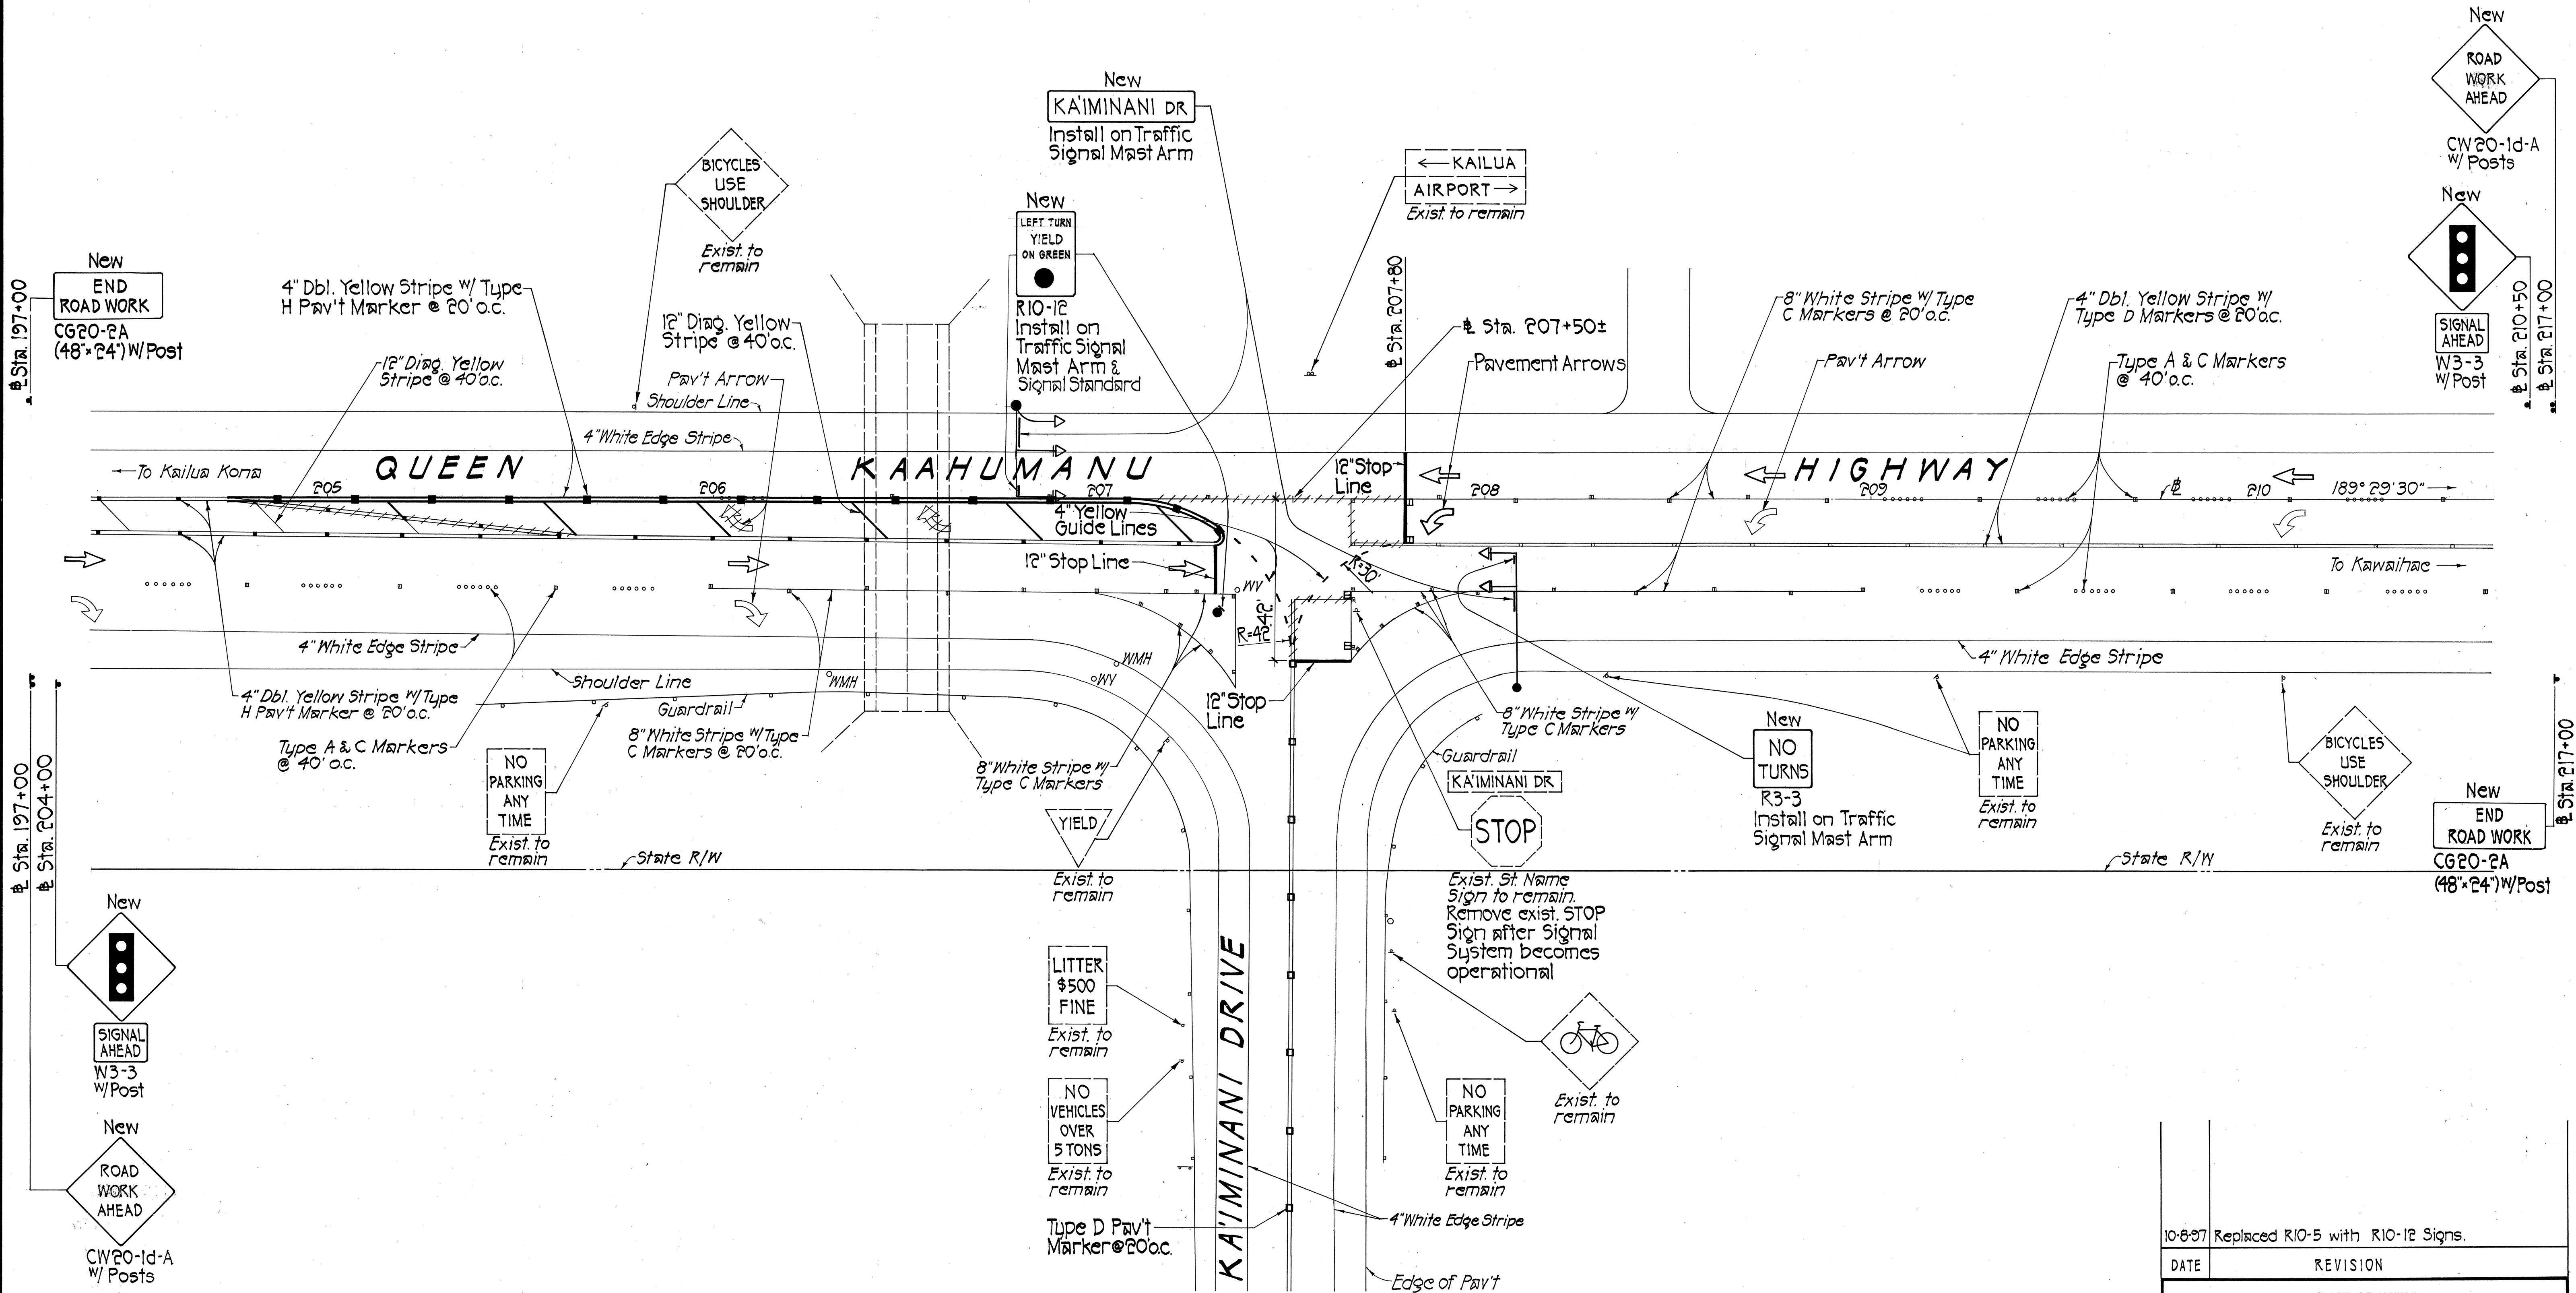

SIGNS, STRIPES & MARKERS PLAN Scale: 1" = 20'

DATE	_____
SURVEY PLOTTED BY	_____
DRAWN BY	_____
CHECKED BY	_____
NO.	_____

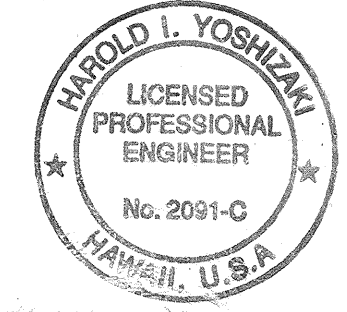

THIS WORK WAS PREPARED BY ME OR UNDER MY SUPERVISION.
Harold I. Yoshizaki
SHIMABUKURO, ENDO & YOSHIKAWA, INC.
1126 12th Avenue
Honolulu, Hawaii 96816

10-8-97	Replaced R10-5 with R10-12 Signs.
DATE	REVISION
STATE OF HAWAII DEPARTMENT OF TRANSPORTATION HIGHWAYS DIVISION SIGNS, STRIPES & MARKERS PLAN QUEEN KAAHUMANU HIGHWAY TRAFFIC SIGNALS @ KAIMINANI DRIVE FEDERAL AID PROJECT NO. STP-019-1(22) SCALE: AS SHOWN DATE: May 1997 SHEET NO. 1 OF 1 SHEETS	