
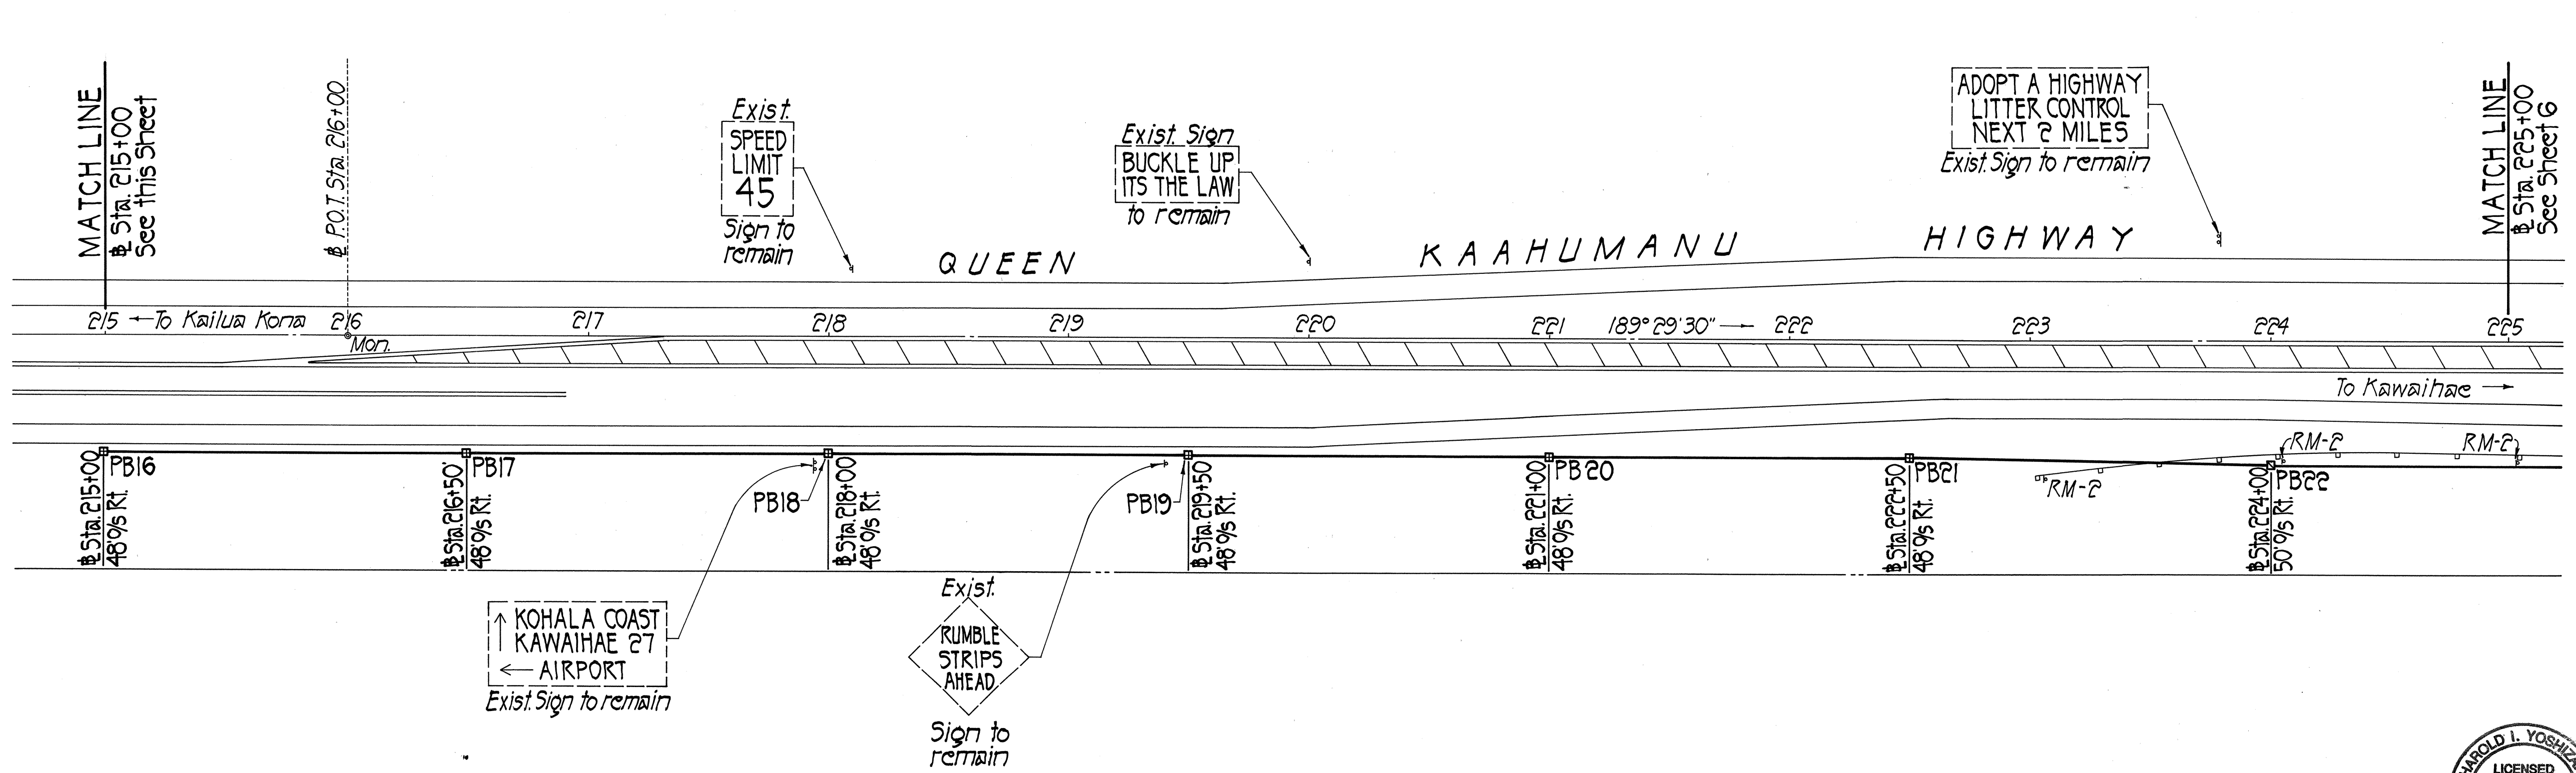



FED. ROAD DIST. NO.	STATE	FED. AID PROJ. NO.	FISCAL YEAR	SHEET NO.	TOTAL SHEETS
HAWAII	HAW.	STP-019-1(22)	1998	5	17

TRUE NORTH
Scale: 1" = 40'

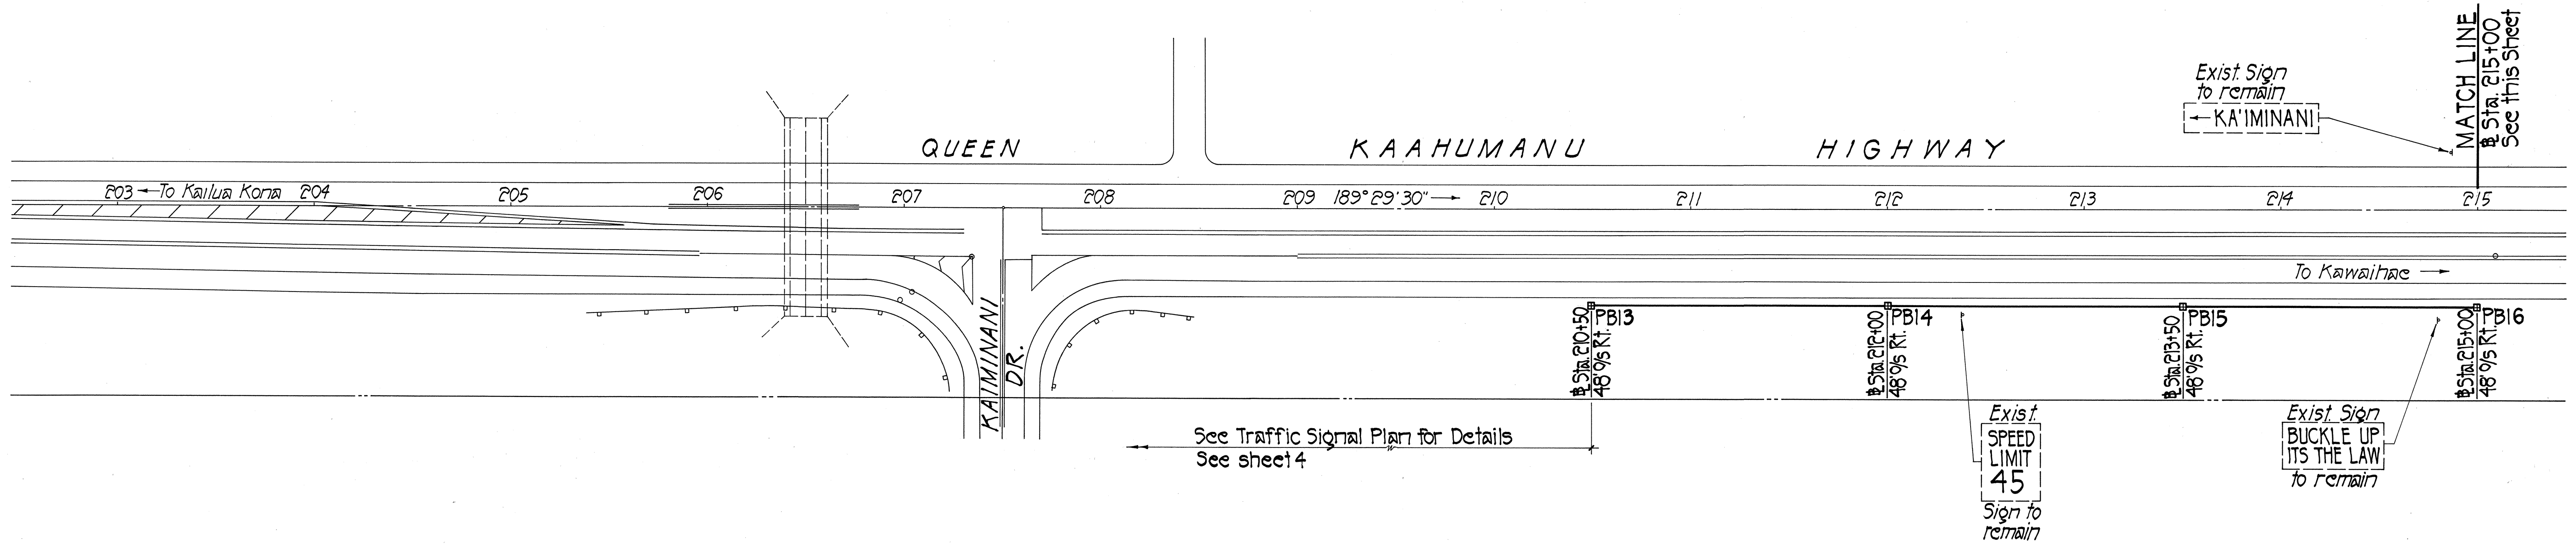

TRUE NORTH
Scale: 1" = 40'

UNDERGROUND INTERCONNECT CONDUIT AND PULLBOX PLAN Scale: 1" = 40'

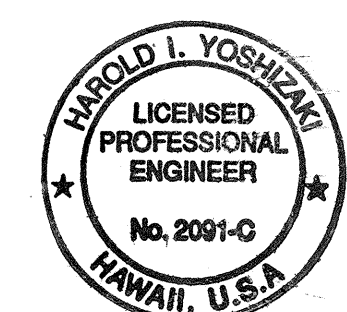

THIS WORK WAS PREPARED BY ME OR UNDER MY SUPERVISION.
Harold L. Yoshizaki
SHIMABUKURO, ENDO & YOSHIKAWA, INC.
1126 12th Avenue
Honolulu, Hawaii 96816

STATE OF HAWAII
DEPARTMENT OF TRANSPORTATION
HIGHWAYS DIVISION

**UNDERGROUND INTERCONNECT
CONDUIT AND PULLBOX PLAN**

QUEEN KAAHUMANU HIGHWAY
TRAFFIC SIGNALS @ KAIMINANI DRIVE
FEDERAL AID PROJECT NO. STP-019-1(22)

SCALE: AS SHOWN DATE: May 1997


SHEET No. 5 OF 4 SHEETS

5

ORIGINAL PLAN	DATE
SURVEY PLOTTED BY	
DRAWN BY	
DESIGNED BY	
QUANTITIES BY	
CHECKED BY	
NO.	

FED. ROAD DIST. NO.	STATE	FED. AID PROJ. NO.	FISCAL YEAR	SHEET NO.	TOTAL SHEETS
HAWAII	HAW.	STP-019-1(22)	1998	6	17

TRUE NORTH
Scale: 1" = 40'

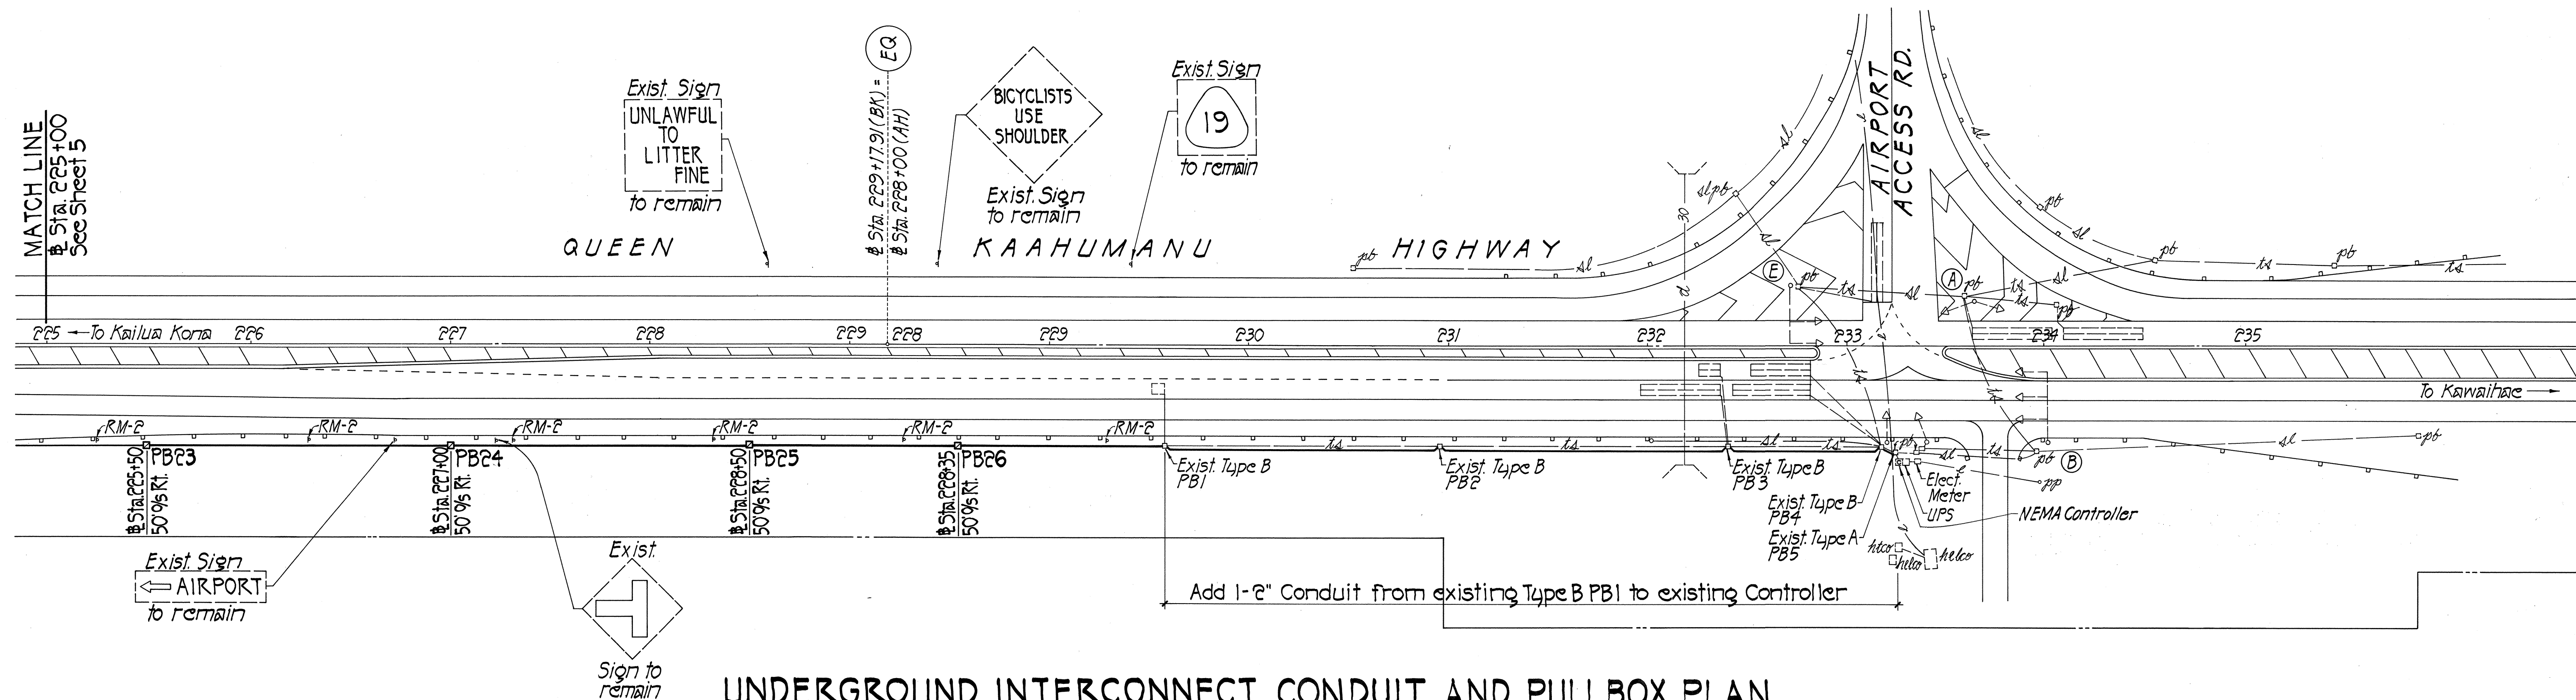


UNDERGROUND INTERCONNECT CONDUIT AND PULLBOX PLAN
Scale: 1" = 40'

ORIGINAL PLAN	DATE
SURVEY PLOTTED BY	
DRAWN BY	
DESIGNED BY	
QUANTITIES BY	
CHECKED BY	
NO.	

10-8-97 Interconnect to NEMA Controller not required.

DATE REVISION

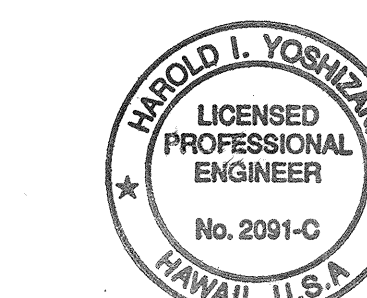

THIS WORK WAS PREPARED BY ME OR UNDER MY SUPERVISION.
Harold I. Yoshizaki
SHIMABUKURO, ENDO & YOSHIZAKI, INC.
1126 12th Avenue
Honolulu, Hawaii 96816

STATE OF HAWAII
DEPARTMENT OF TRANSPORTATION
HIGHWAYS DIVISION
**UNDERGROUND INTERCONNECT
CONDUIT AND PULLBOX PLAN**
QUEEN KAAHUMANU HIGHWAY
TRAFFIC SIGNALS @ KAIMINANI DRIVE
FEDERAL AID PROJECT NO. STP-019-1(22)
SCALE: AS SHOWN DATE: May 1997
SHEET No. 3 OF 4 SHEETS