
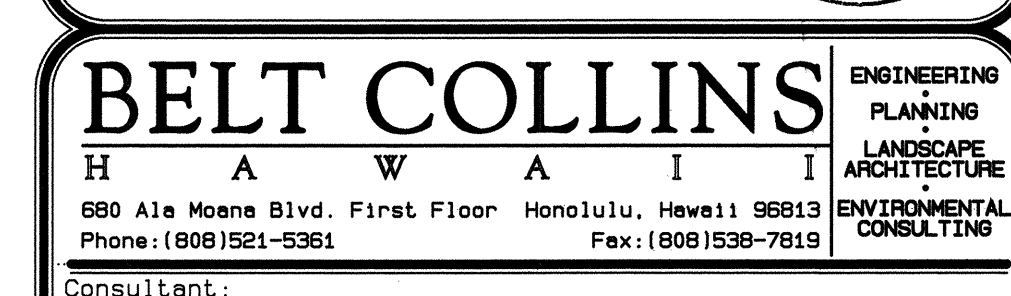


ALL SPOT GRADES SHOWN ARE @ 20'
INTERVALS, UNLESS OTHERWISE NOTED

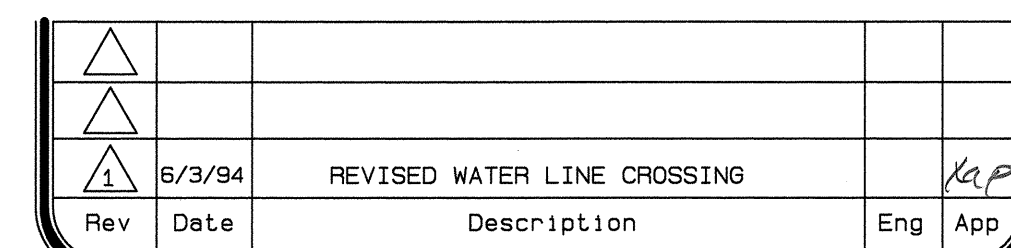

MAKALAPUA
SIGNALIZED INTERSECTION AT QUEEN
KAAHUMANU HIGHWAY AND MAKALAPUA BLVD

Designed By: RI, KT Drawn By: OL
Project No. 333 5000 Date: JAN 1994

Approved By: _____