

SCALES : HORIZ. 1" = 20'  
VERT. 1" = 4'

Rev	Date	Description	Eng	App

THIS WORK WAS PREPARED BY ME OR UNDER MY SUPERVISION AND CONSTRUCTION OF THIS PROJECT WILL BE UNDER MY OBSERVATION.

CHERYL M. PALESCH  
REGISTERED PROFESSIONAL ENGINEER  
No. 5952-C  
HAWAII, U.S.A.

PROJECT NO. 190A-02-92

**BELT COLLINS & ASSOCIATES**  
Engineering • Planning • Landscape Architecture  
680 Ala Moana Boulevard Suite 200 Honolulu, Hawaii 96813  
Phone: (808) 521-5361 Telex: BELTH 7430474 Fax: (808) 538-7819











Client:  
**HOUSING FINANCE AND DEVELOPMENT CORPORATION**  
STATE OF HAWAII

**VILLAGES OF LA'I OPUA**  
BACKBONE INFRASTRUCTURE PHASE-2A

**KEALAKEHE PARKWAY**  
CROSS SECTIONS  
STA 44 + 63.10 TO STA 49 + 00

Designed by: A.K. Date: NOV., 1993  
Drawn by: RCD Proj. no.: (BCA) 841.0104

Approved: \_\_\_\_\_  
Date \_\_\_\_\_

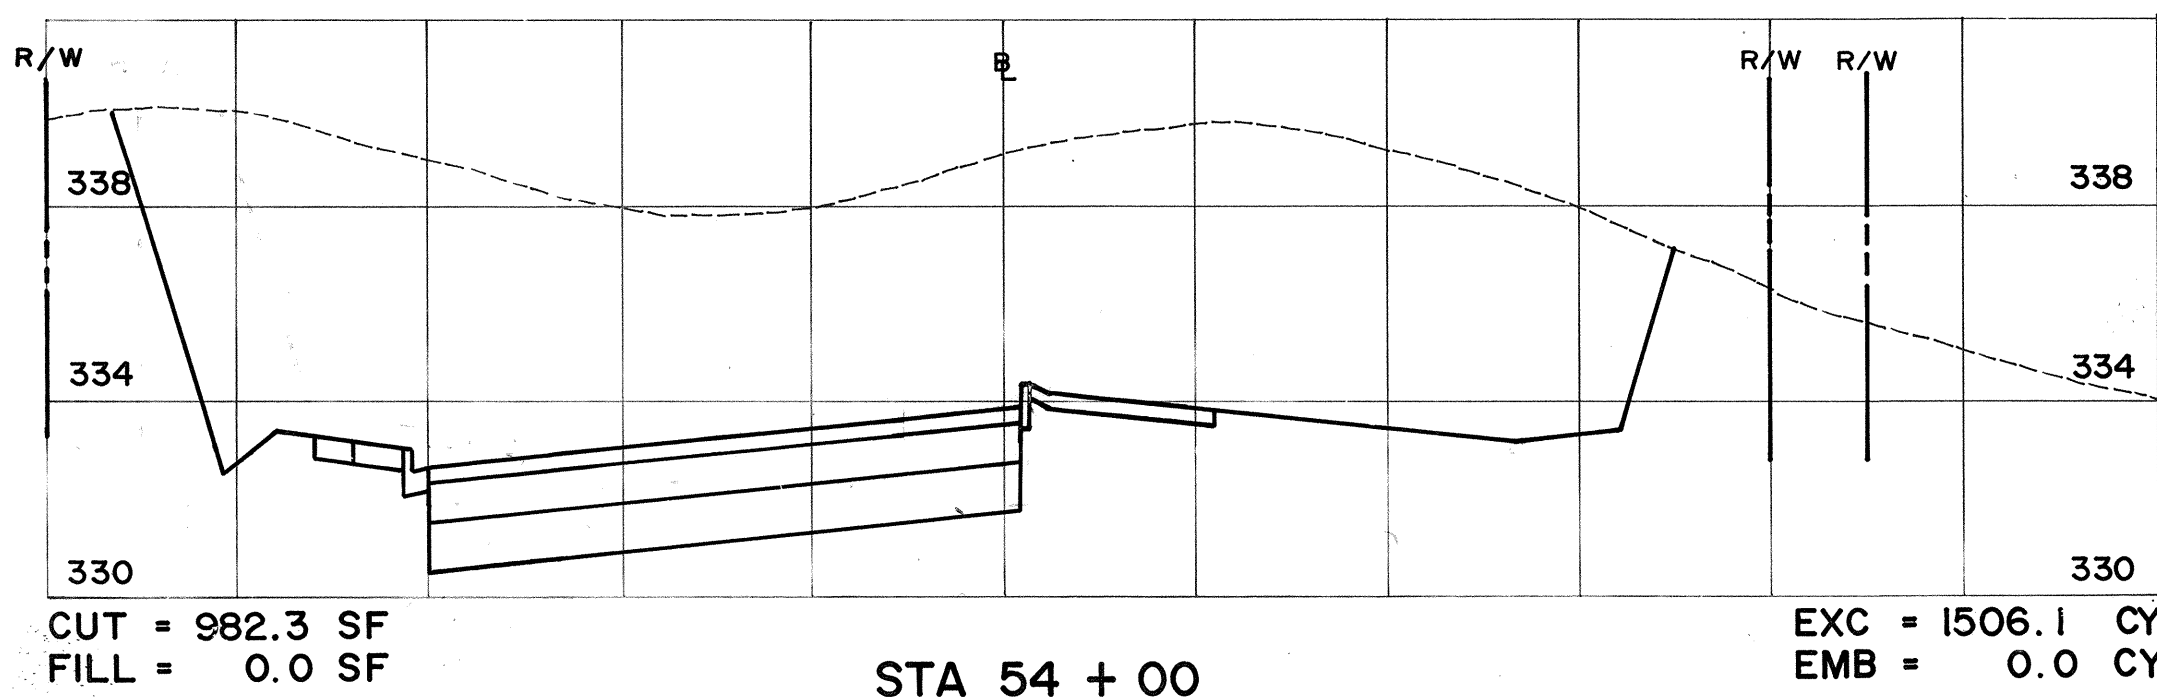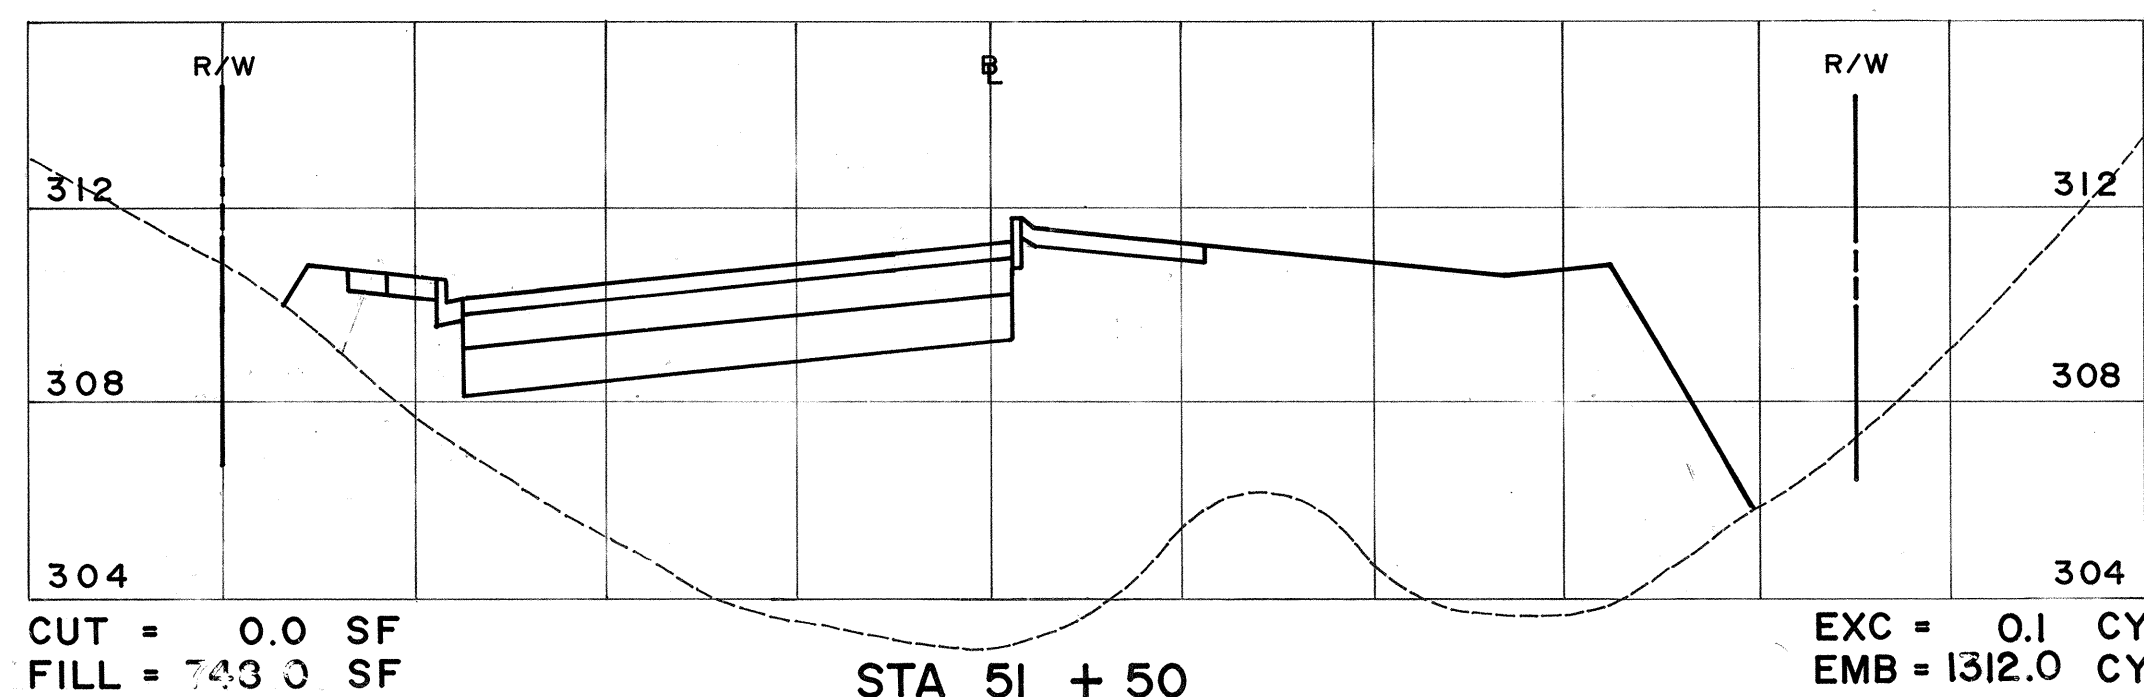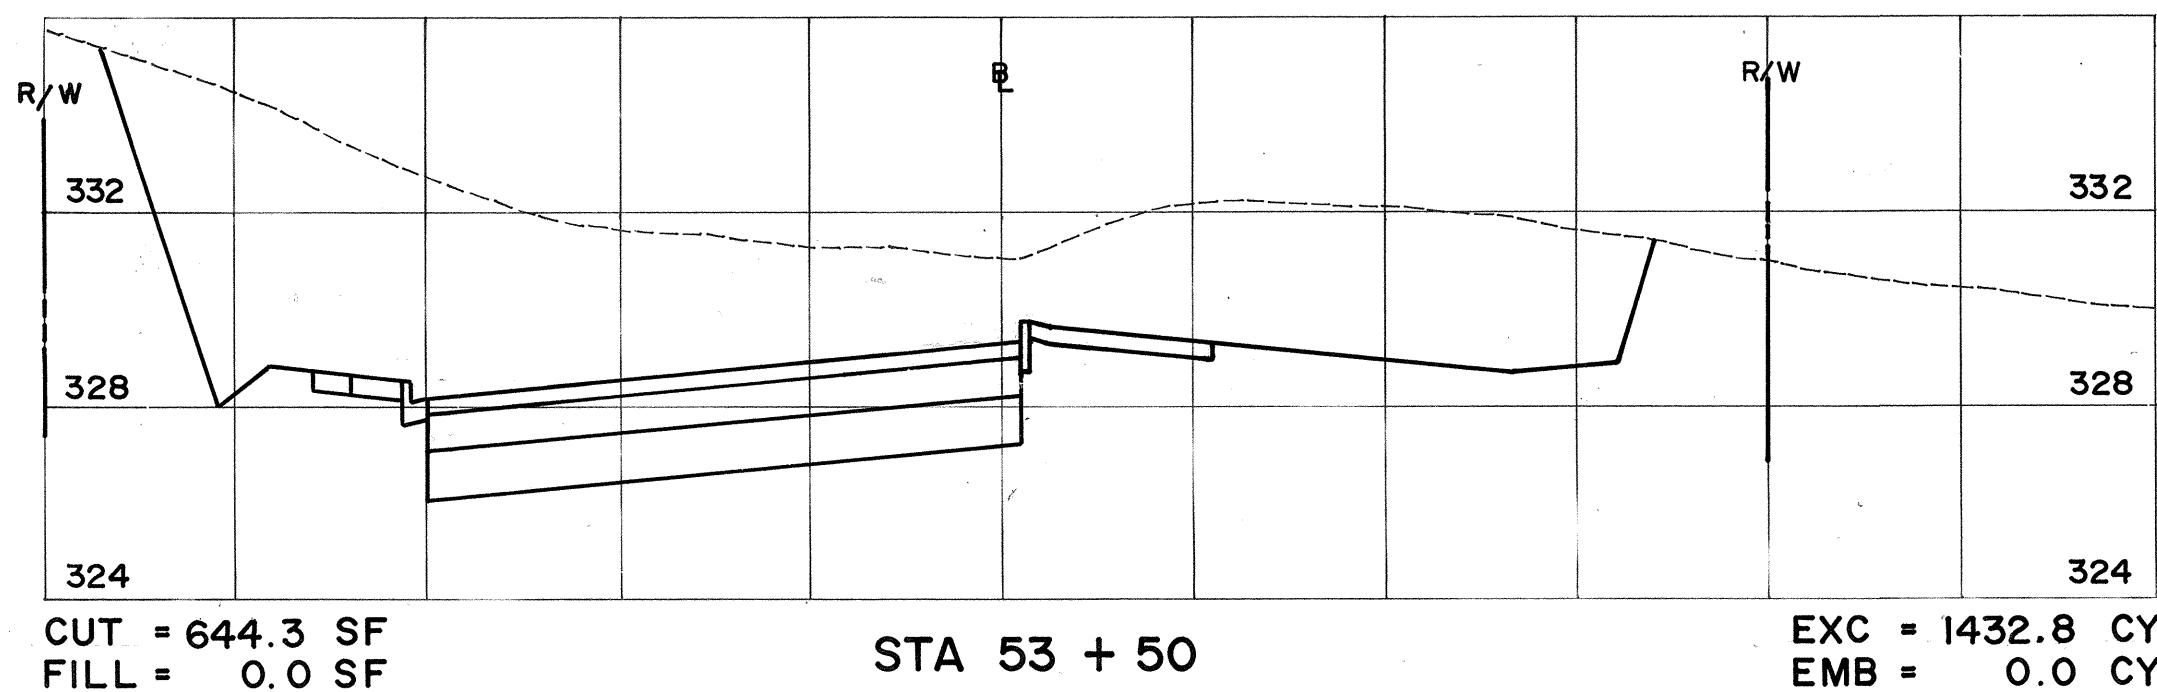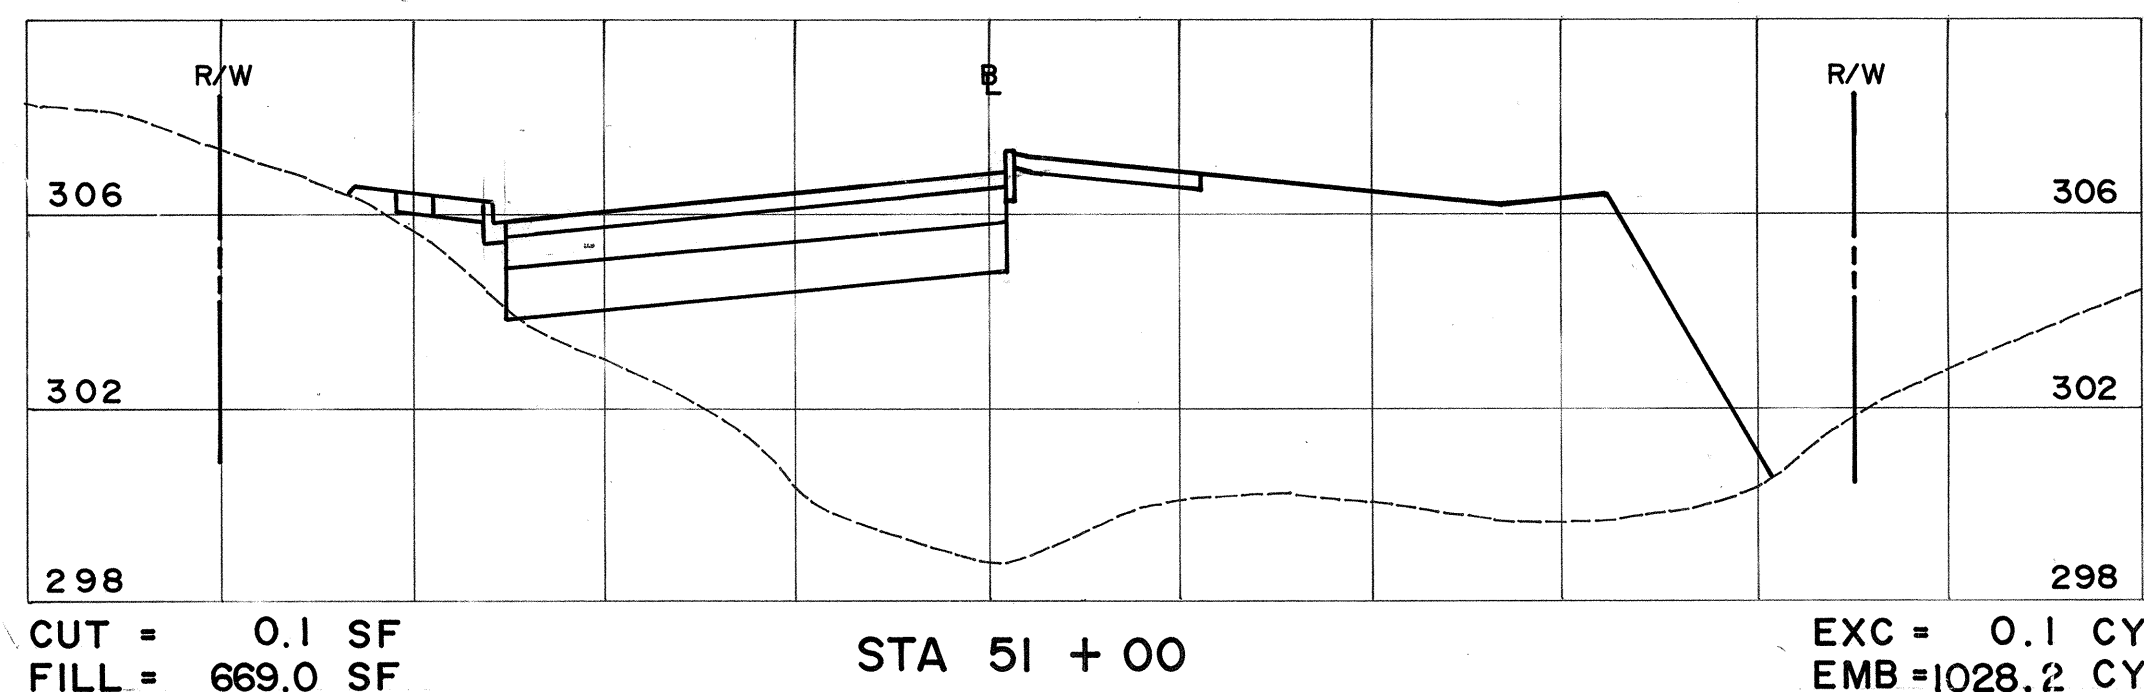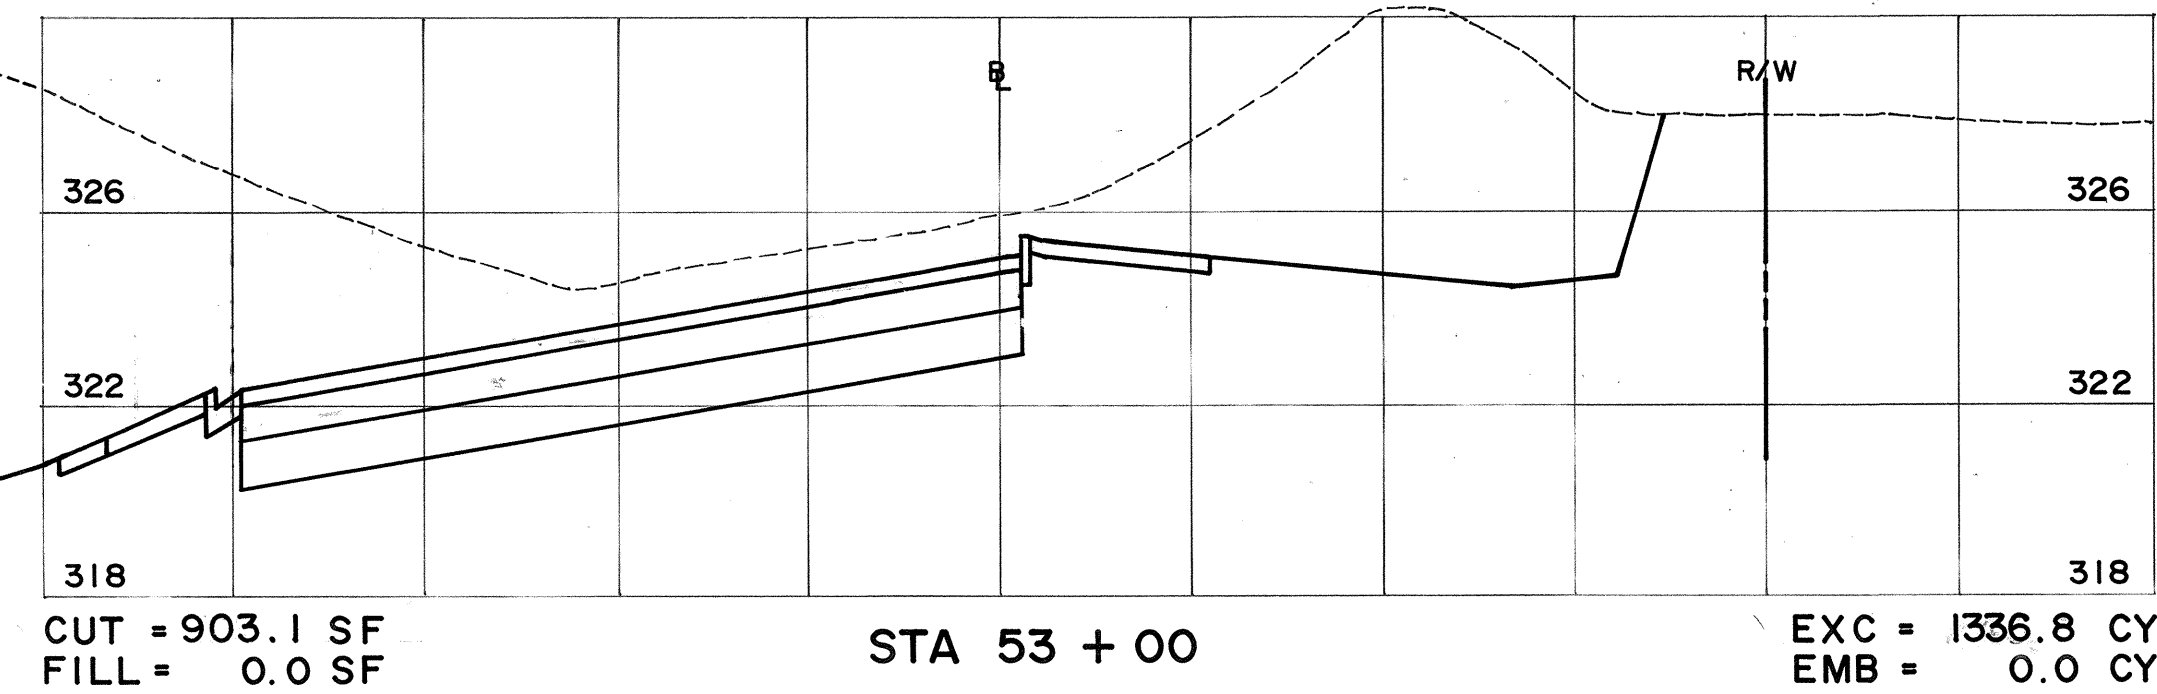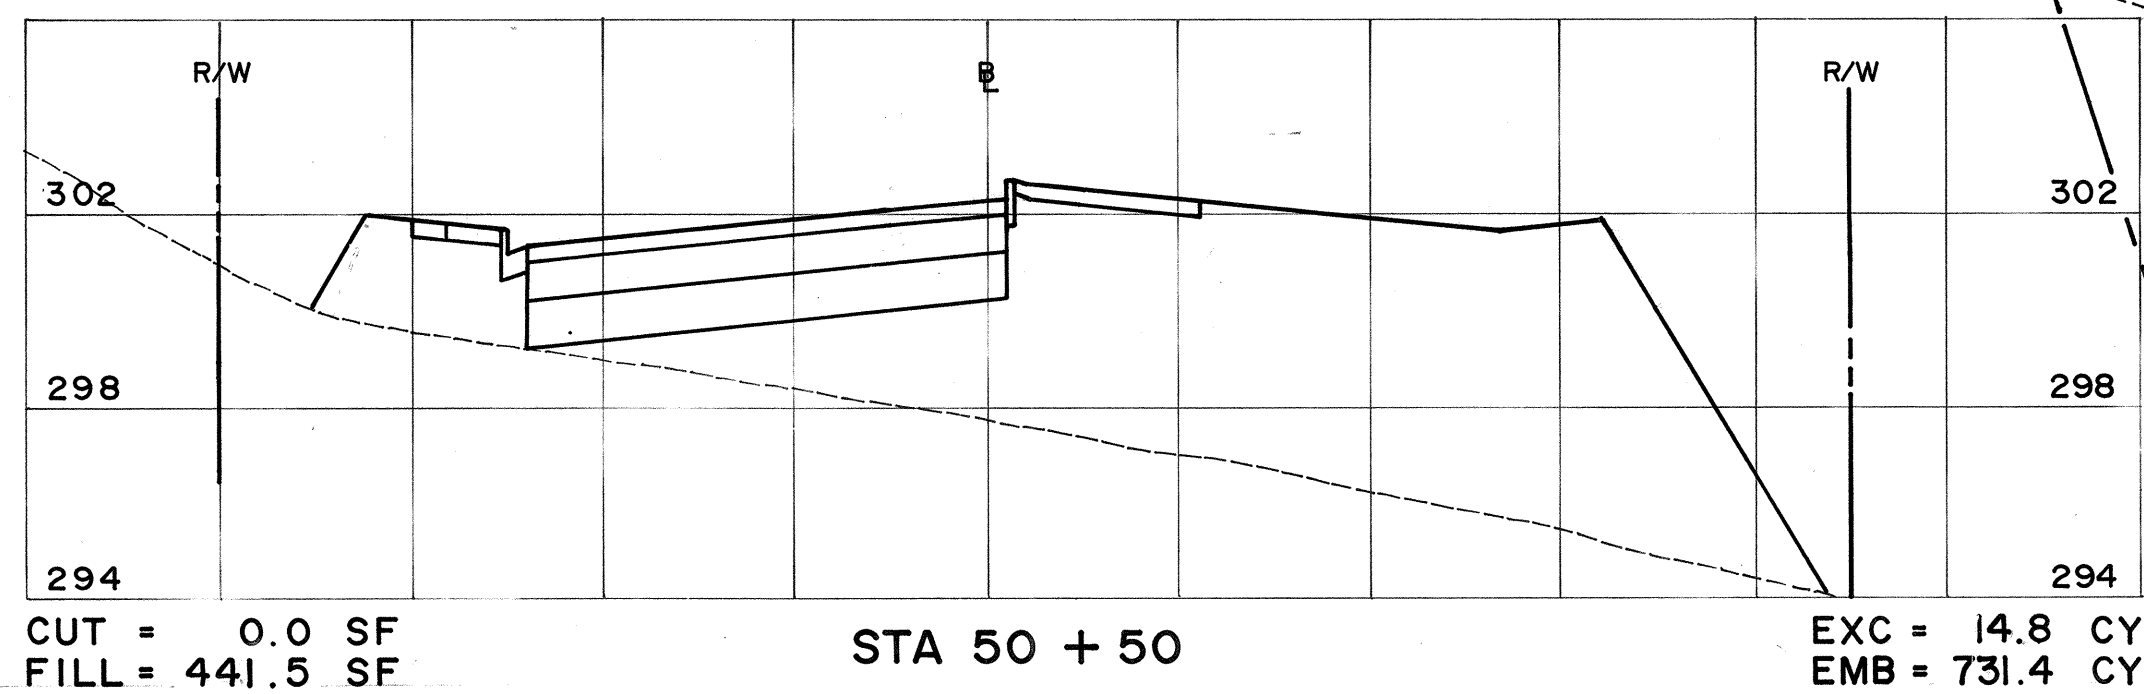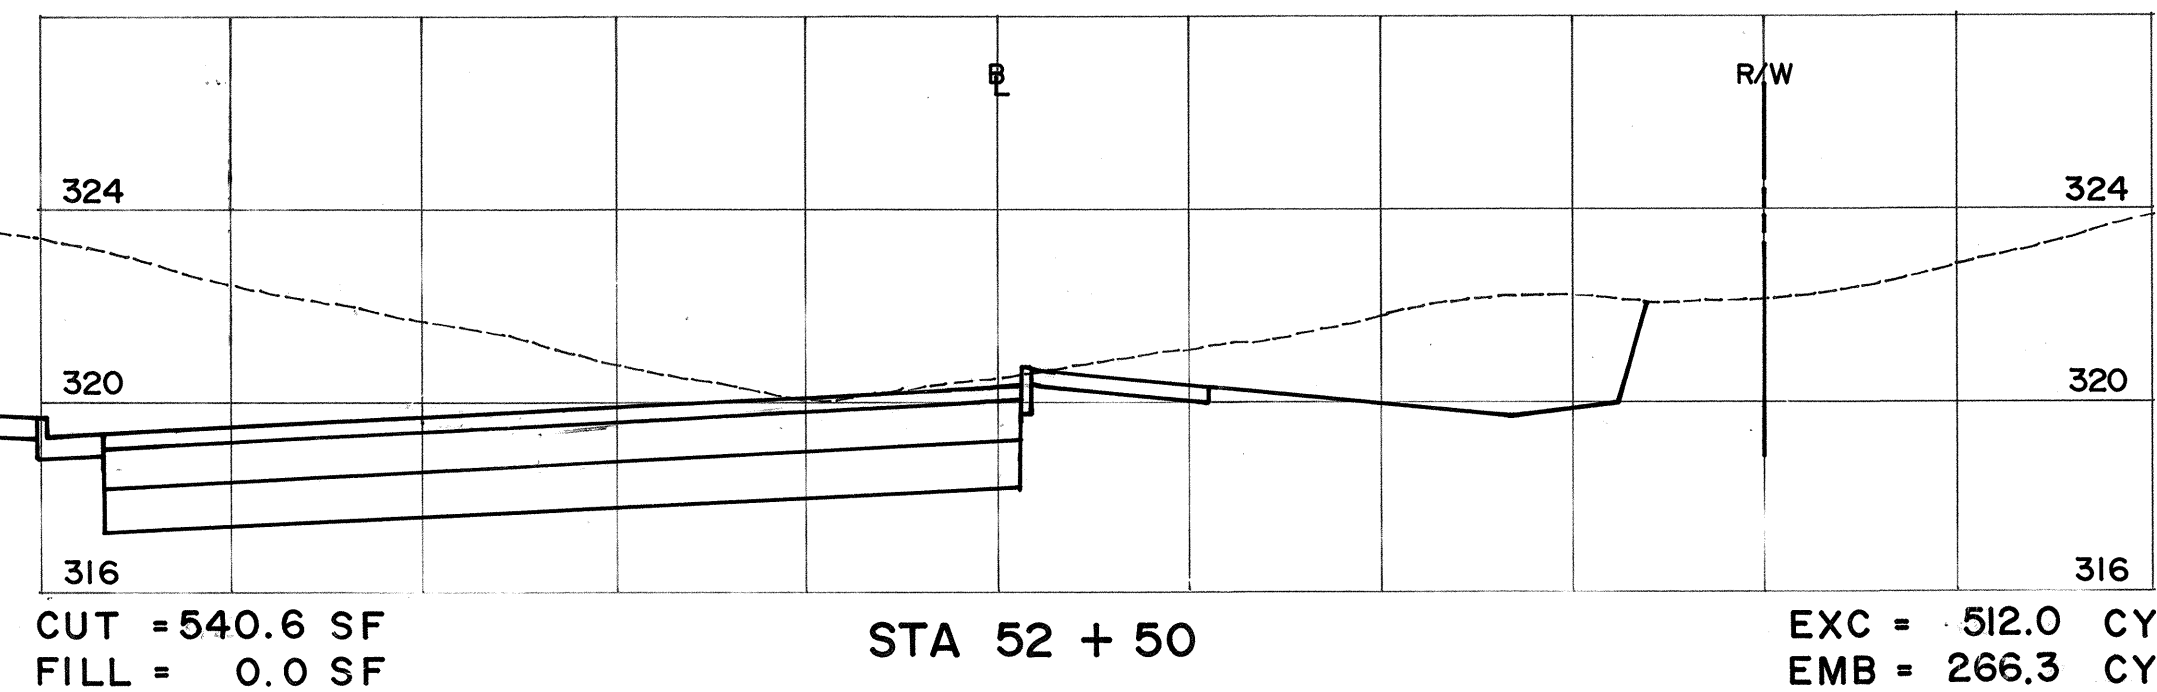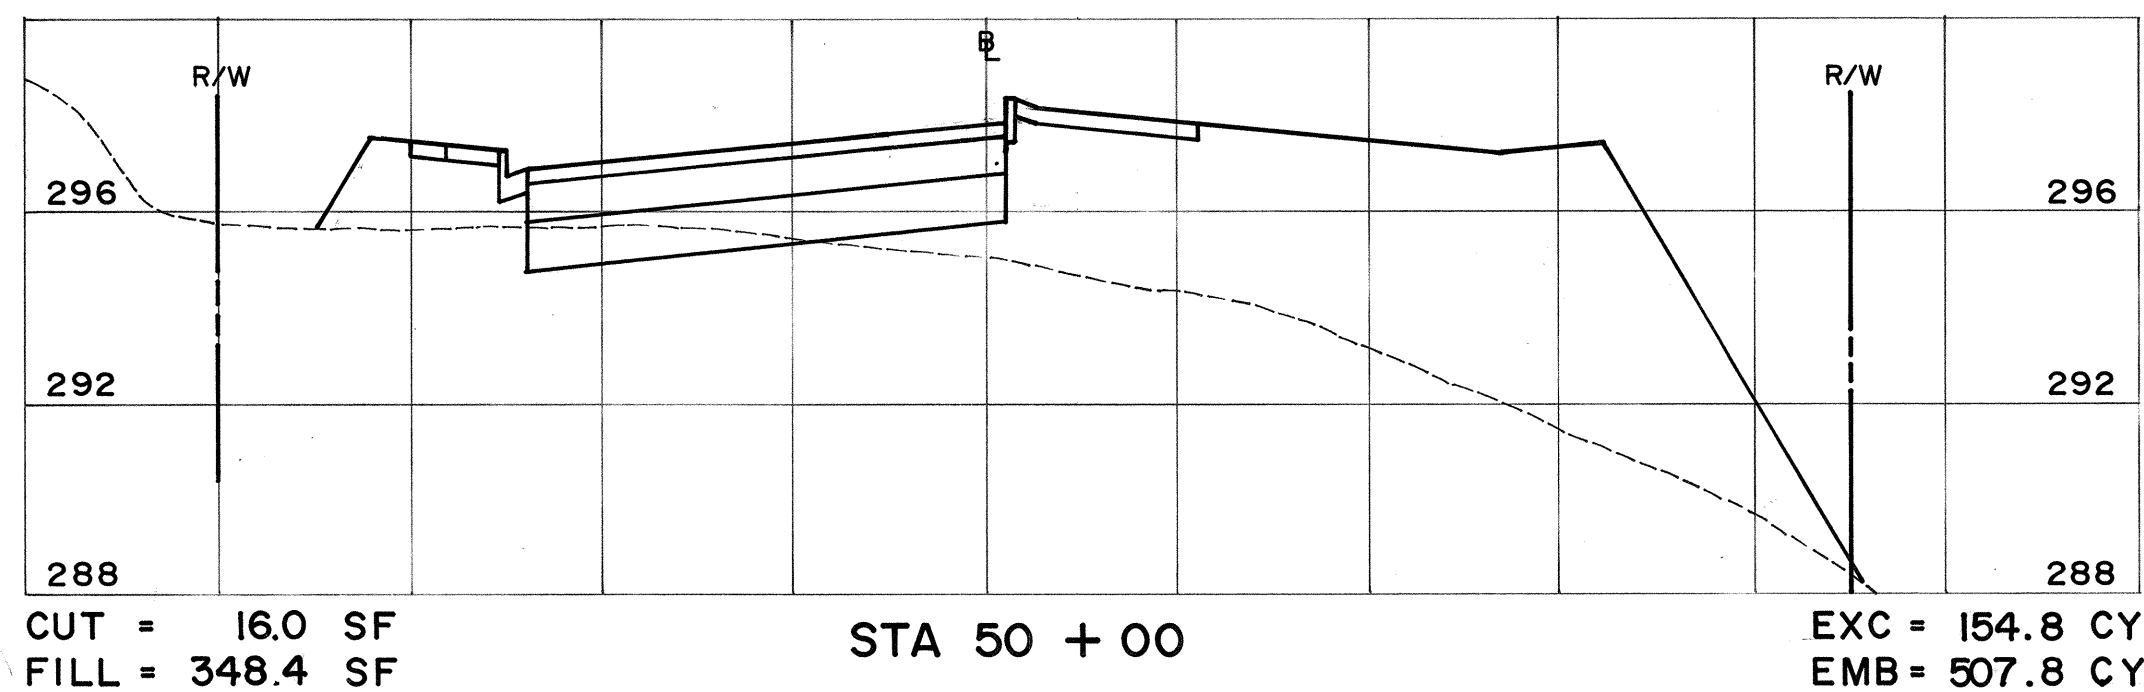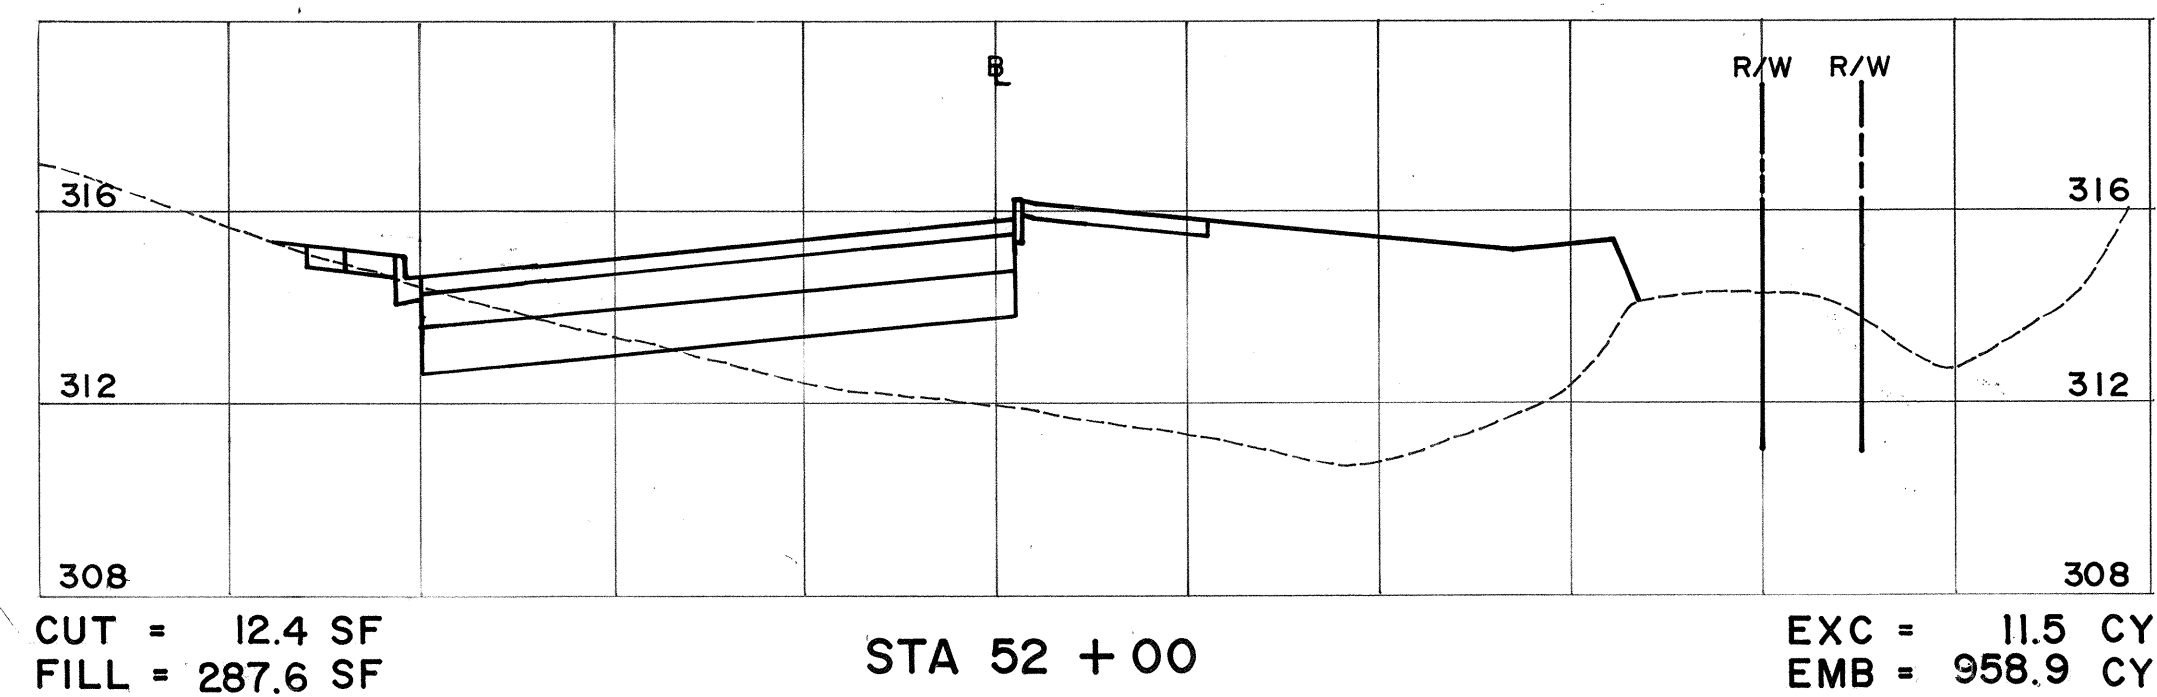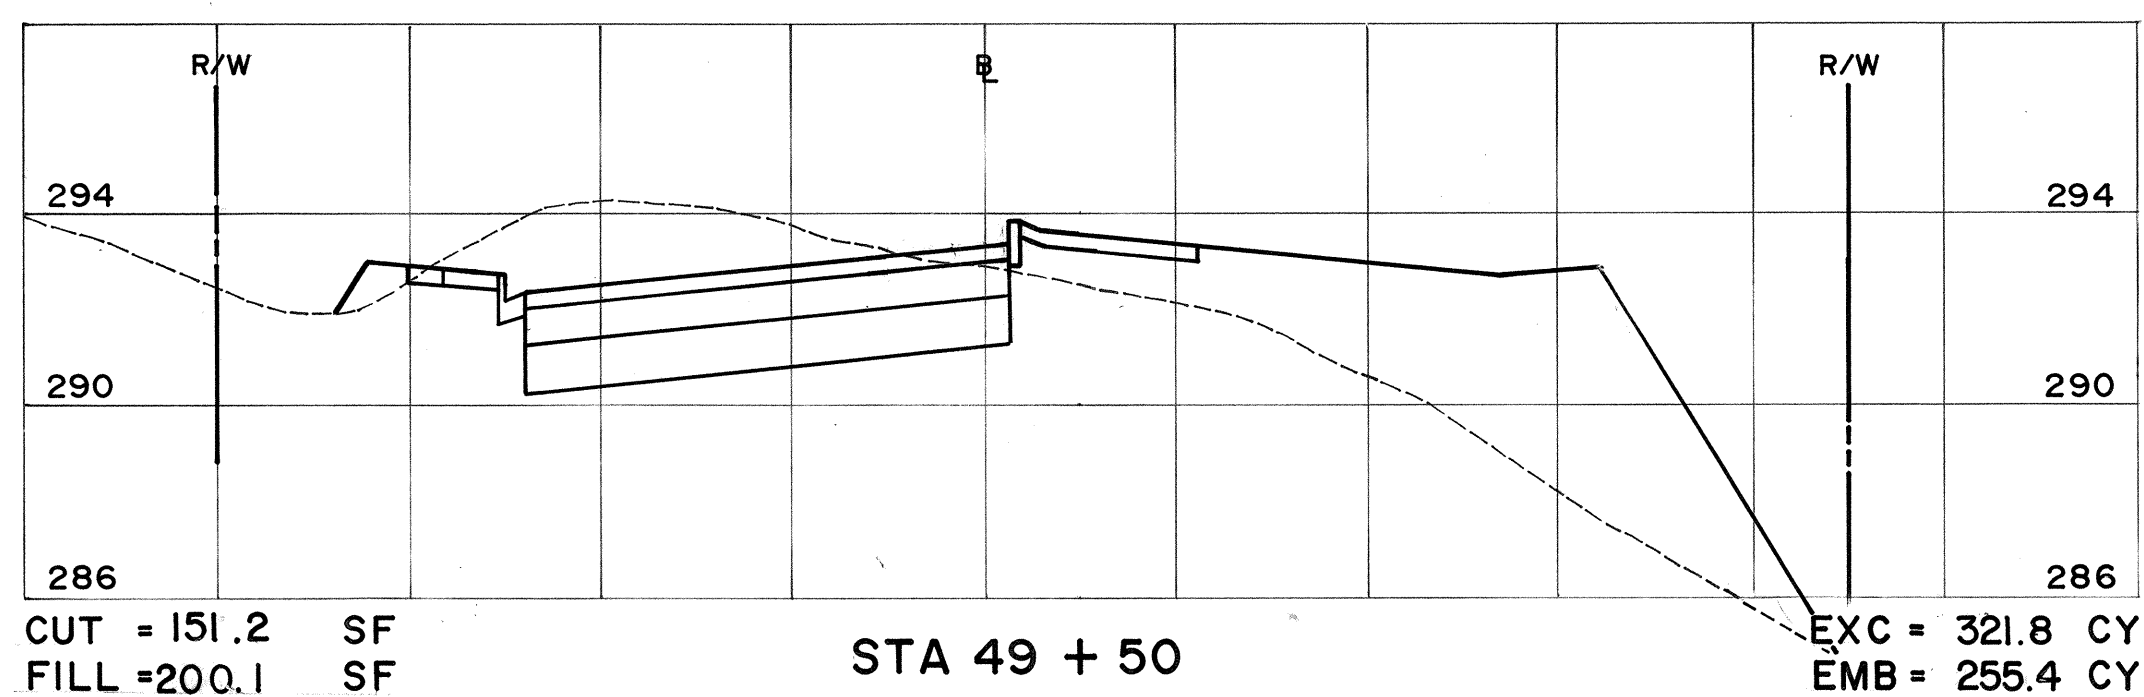

SCALES : HORIZ : 1" = 20'  
VERT : 1" = 4'

Rev	Date	Description	Eng	App

THIS WORK WAS PREPARED BY ME OR UNDER MY SUPERVISION AND CONSTRUCTION OF THIS PROJECT WILL BE UNDER MY OBSERVATION.

CHERYL M. PALES  
REGISTERED PROFESSIONAL ENGINEER  
No. 5952-C  
HAWAII, U.S.A.

PROJECT NO. 190A-02-92

**BELT COLLINS & ASSOCIATES**  
Engineering • Planning • Landscape Architecture  
680 Ala Moana Boulevard Suite 200 Honolulu, Hawaii 96813  
Phone: (808) 521-5361 Telex: BELTH 7430474 Fax: (808) 538-7819

Client:  
**HOUSING FINANCE AND DEVELOPMENT CORPORATION**  
STATE OF HAWAII

**VILLAGES OF LA'I'OPUA**  
BACKBONE INFRASTRUCTURE PHASE-2A

**KEALAKEHE PARKWAY**  
CROSS SECTIONS  
STA 49+50 TO STA 54+00

Designed by: A.K. Date: NOV. 1993  
Drawn by: V.B.M. Proj. no.: (BCA) 841.0104  
Approved: \_\_\_\_\_  
Date: \_\_\_\_\_











841.0104-C-25

Trim: 22"x36"

RECORD DRAWINGS

SHEET C-36 of 111 Sheets



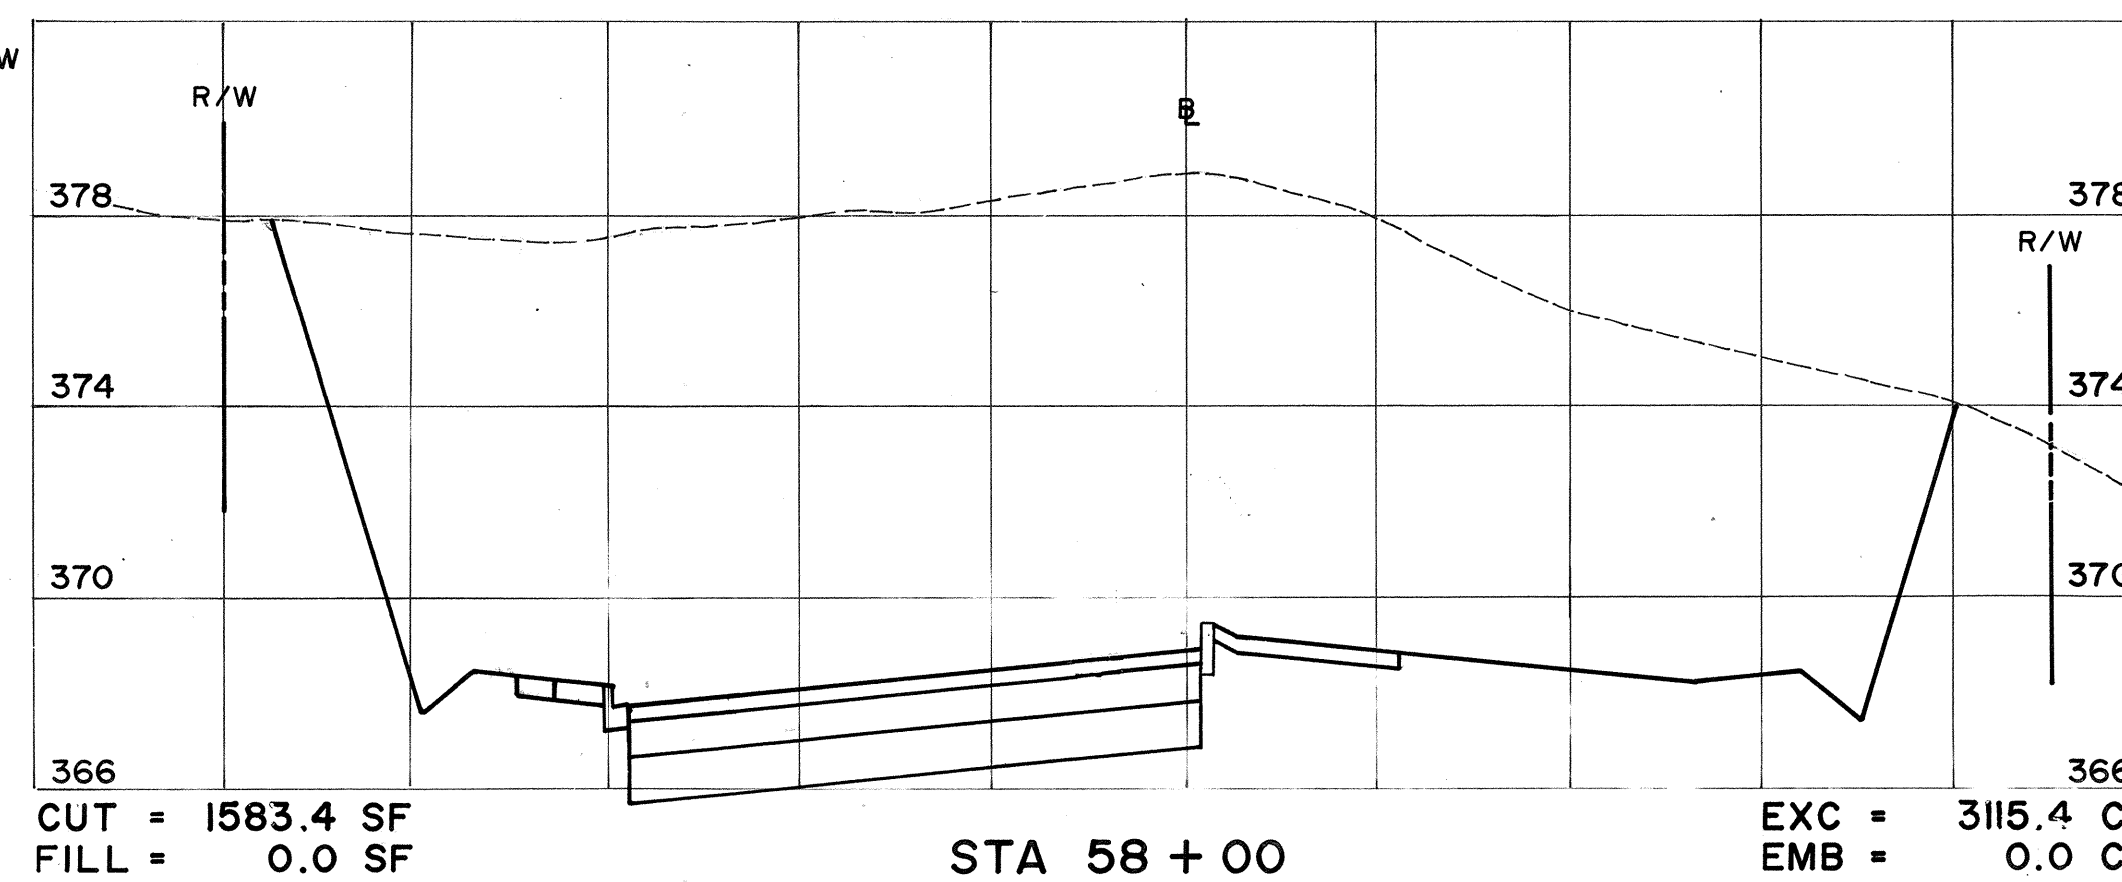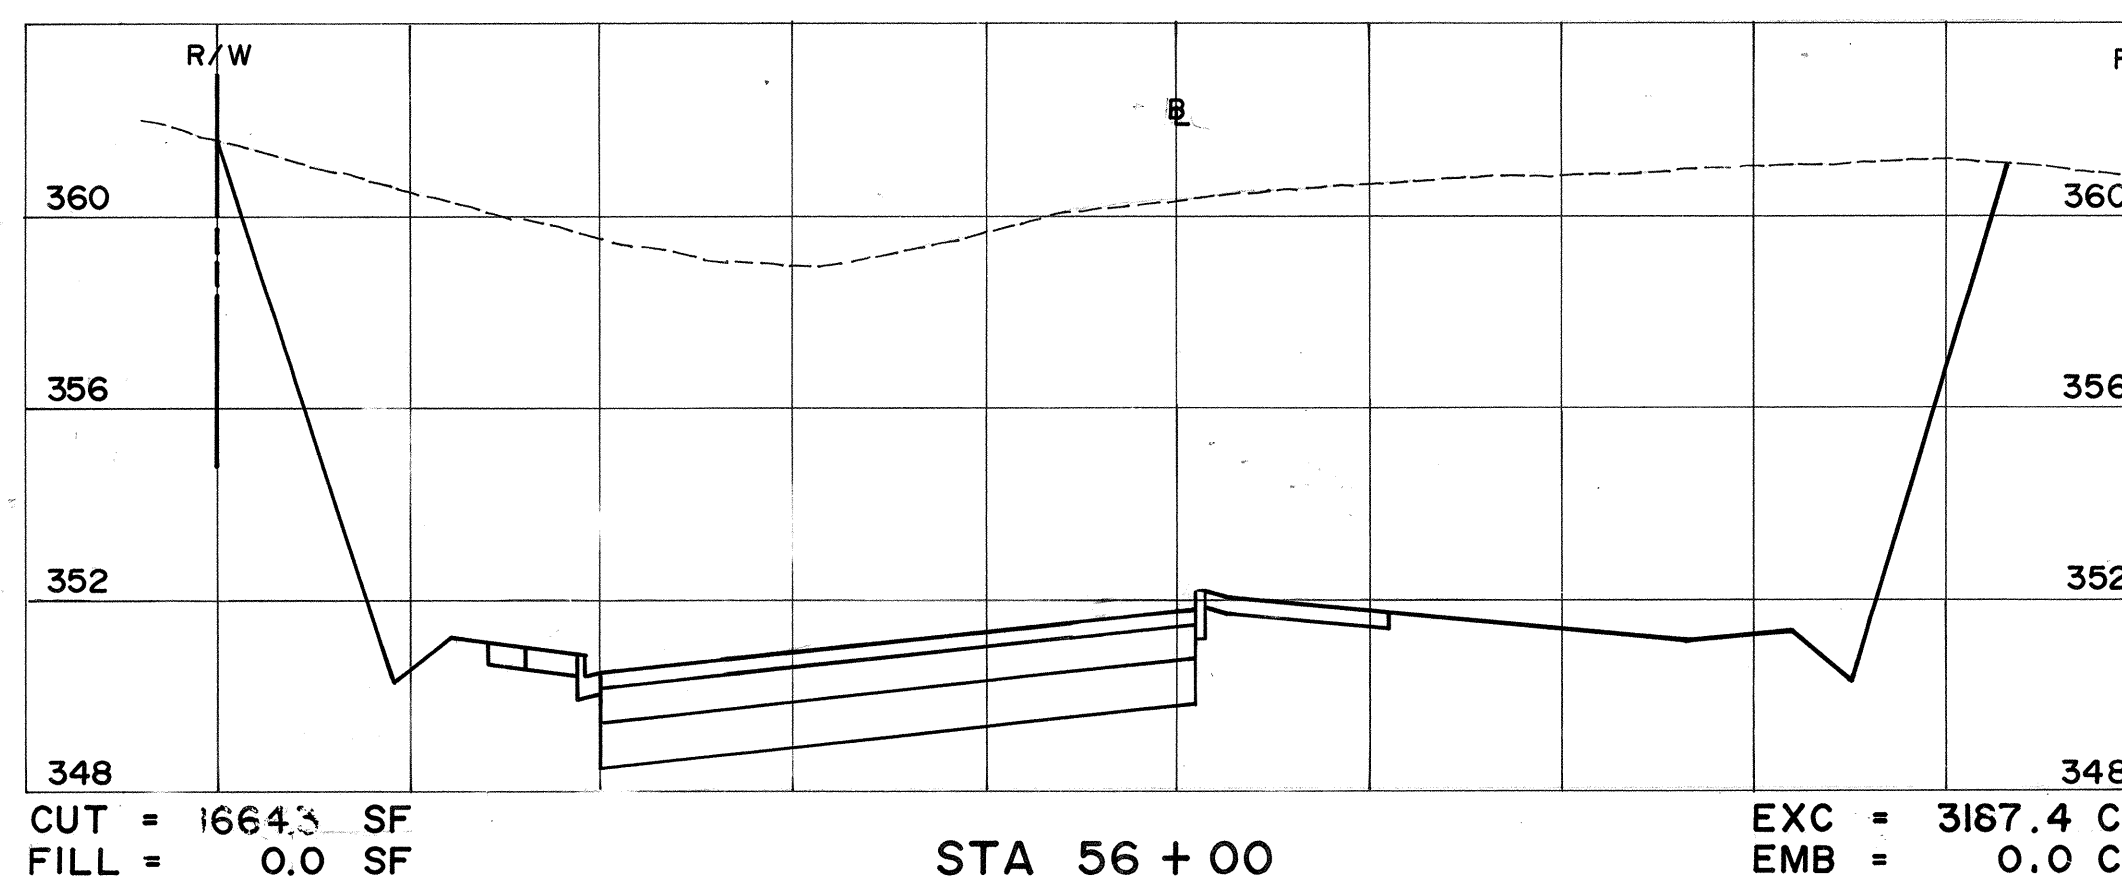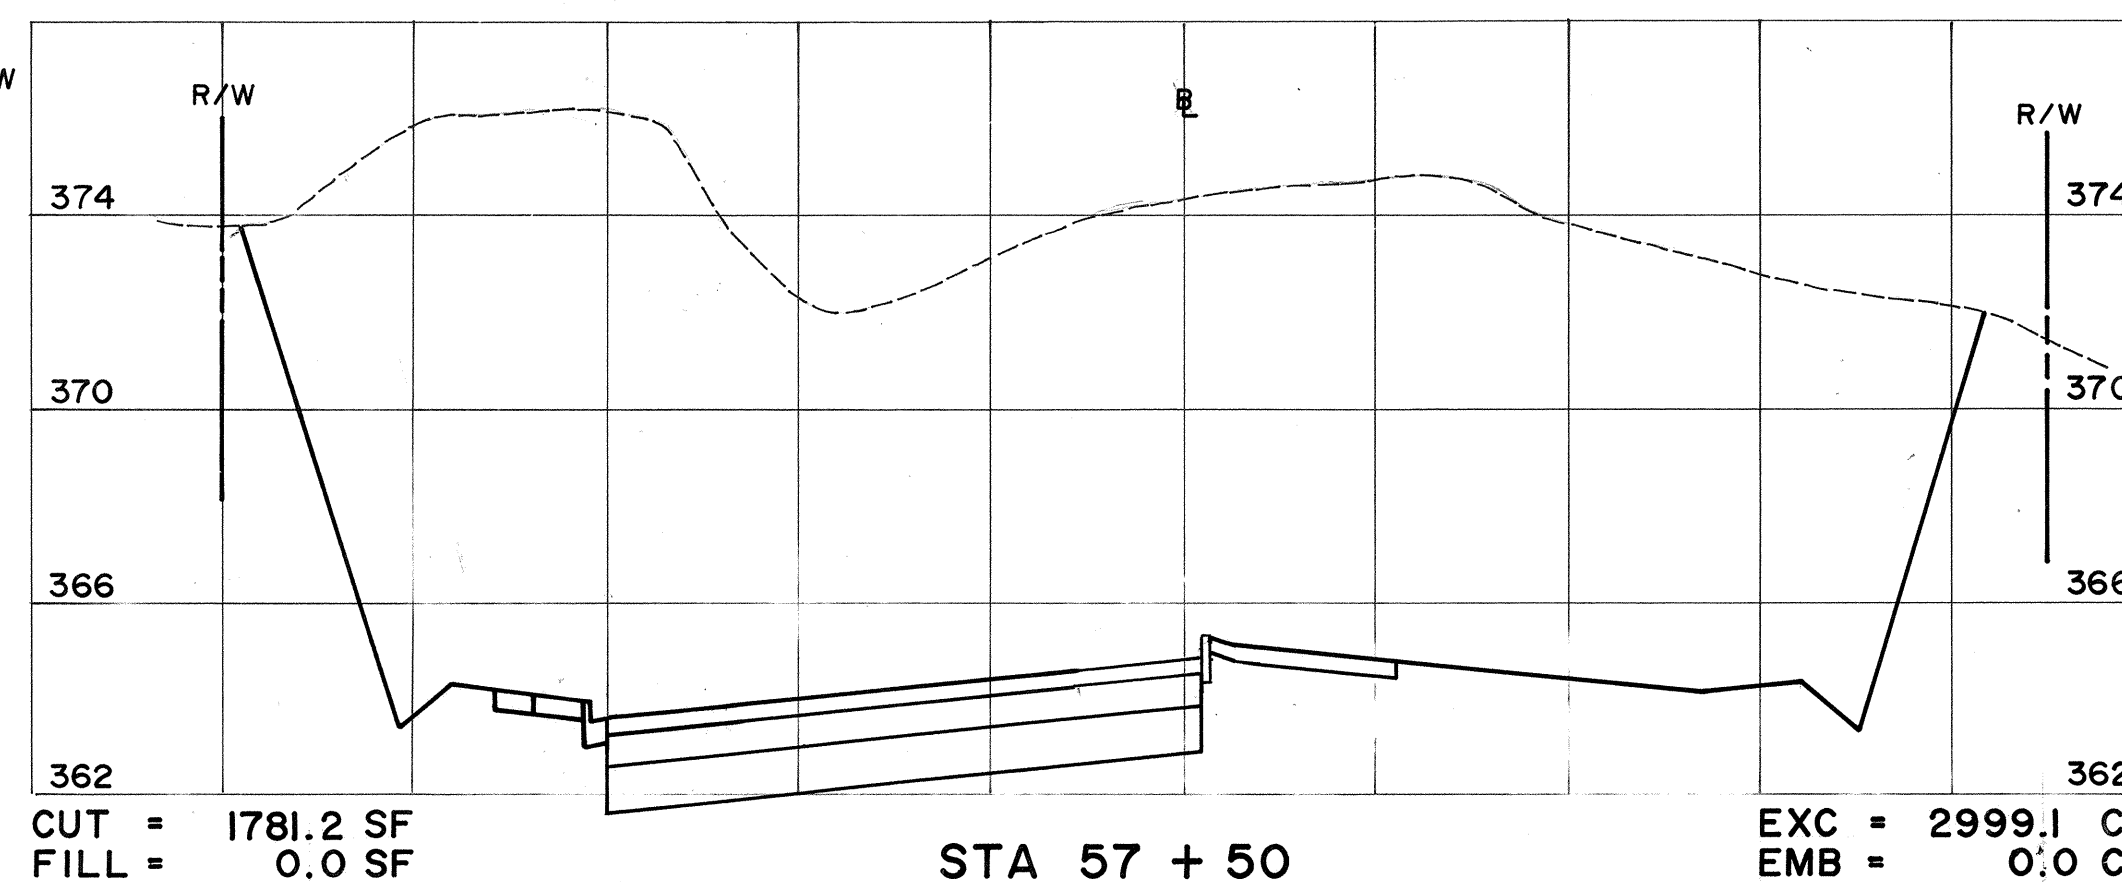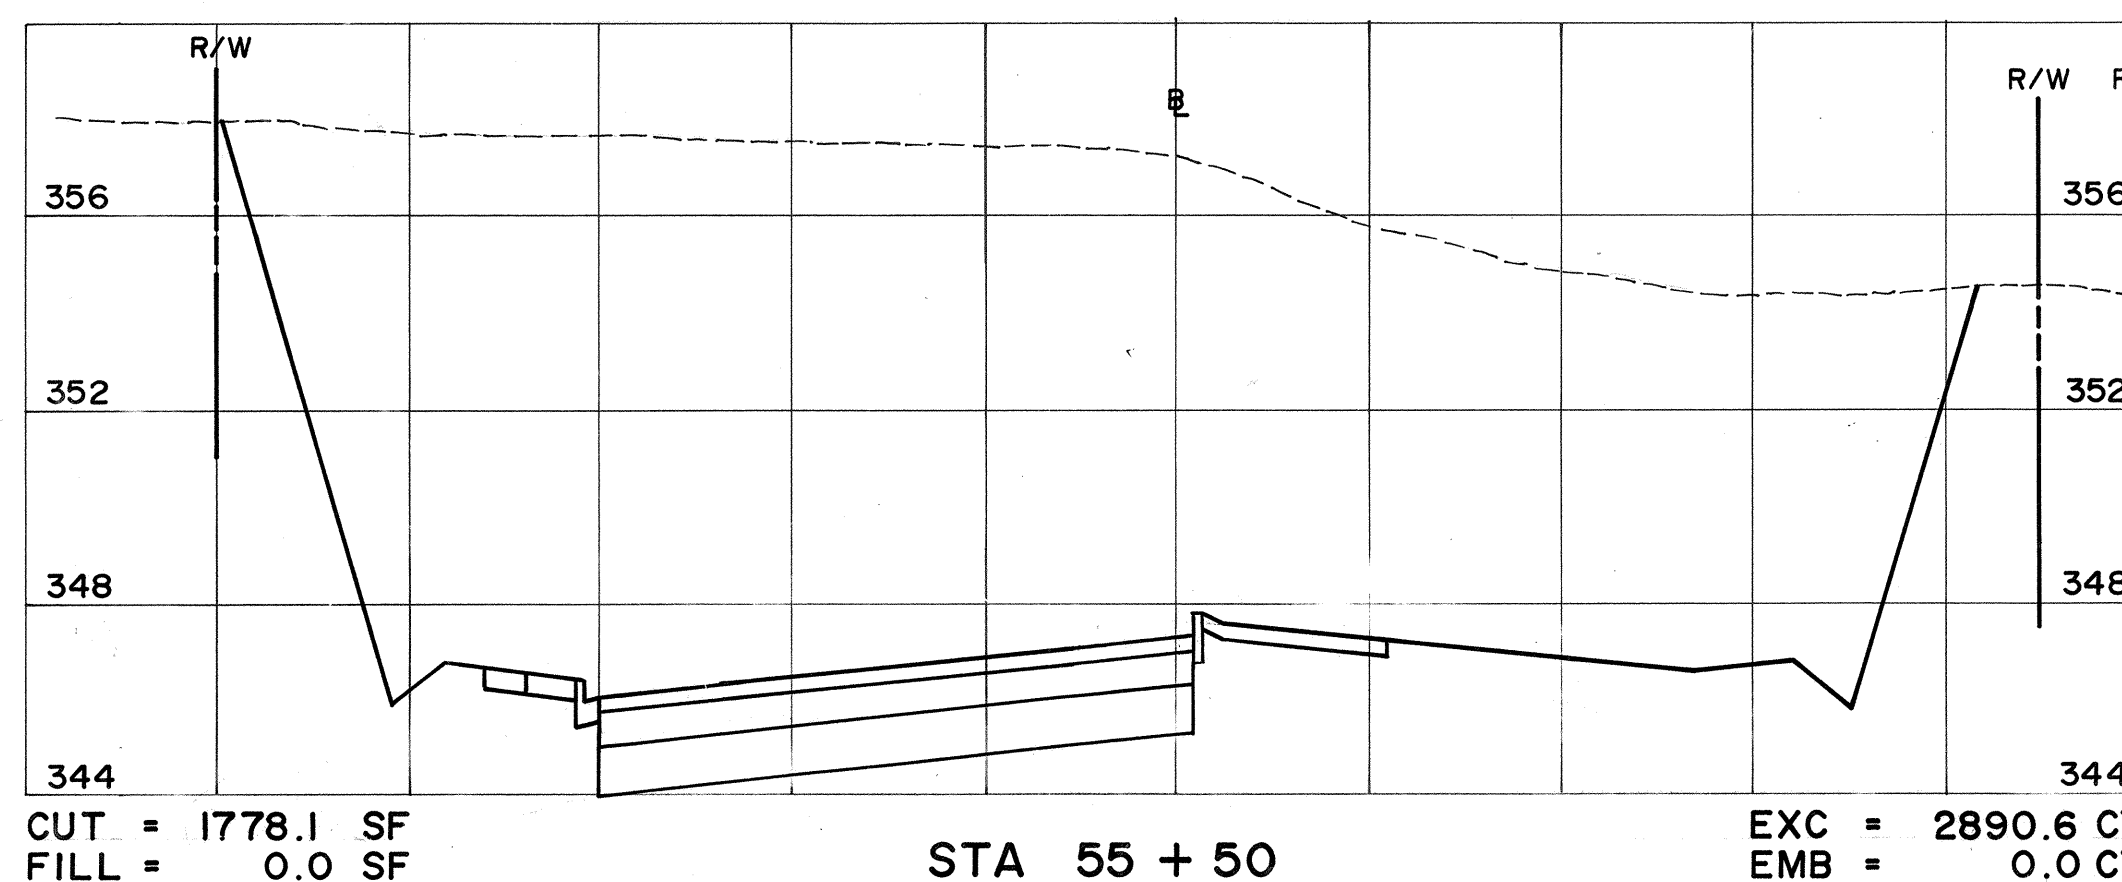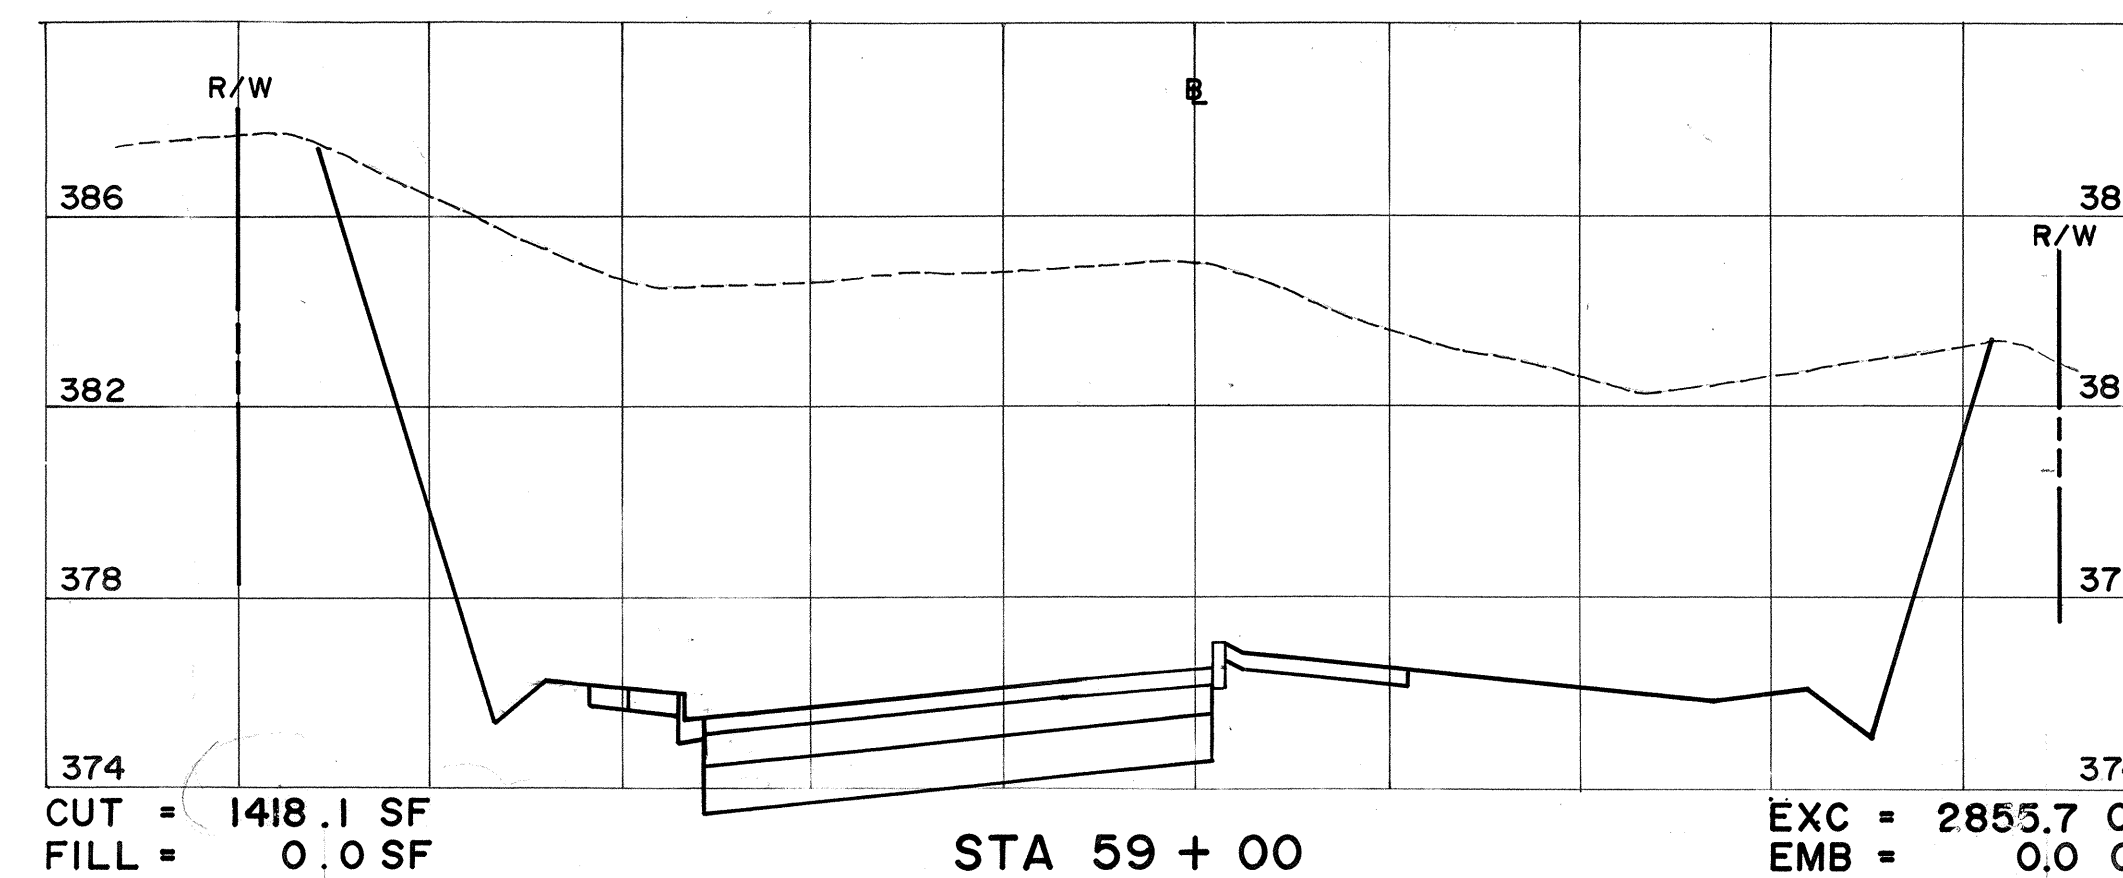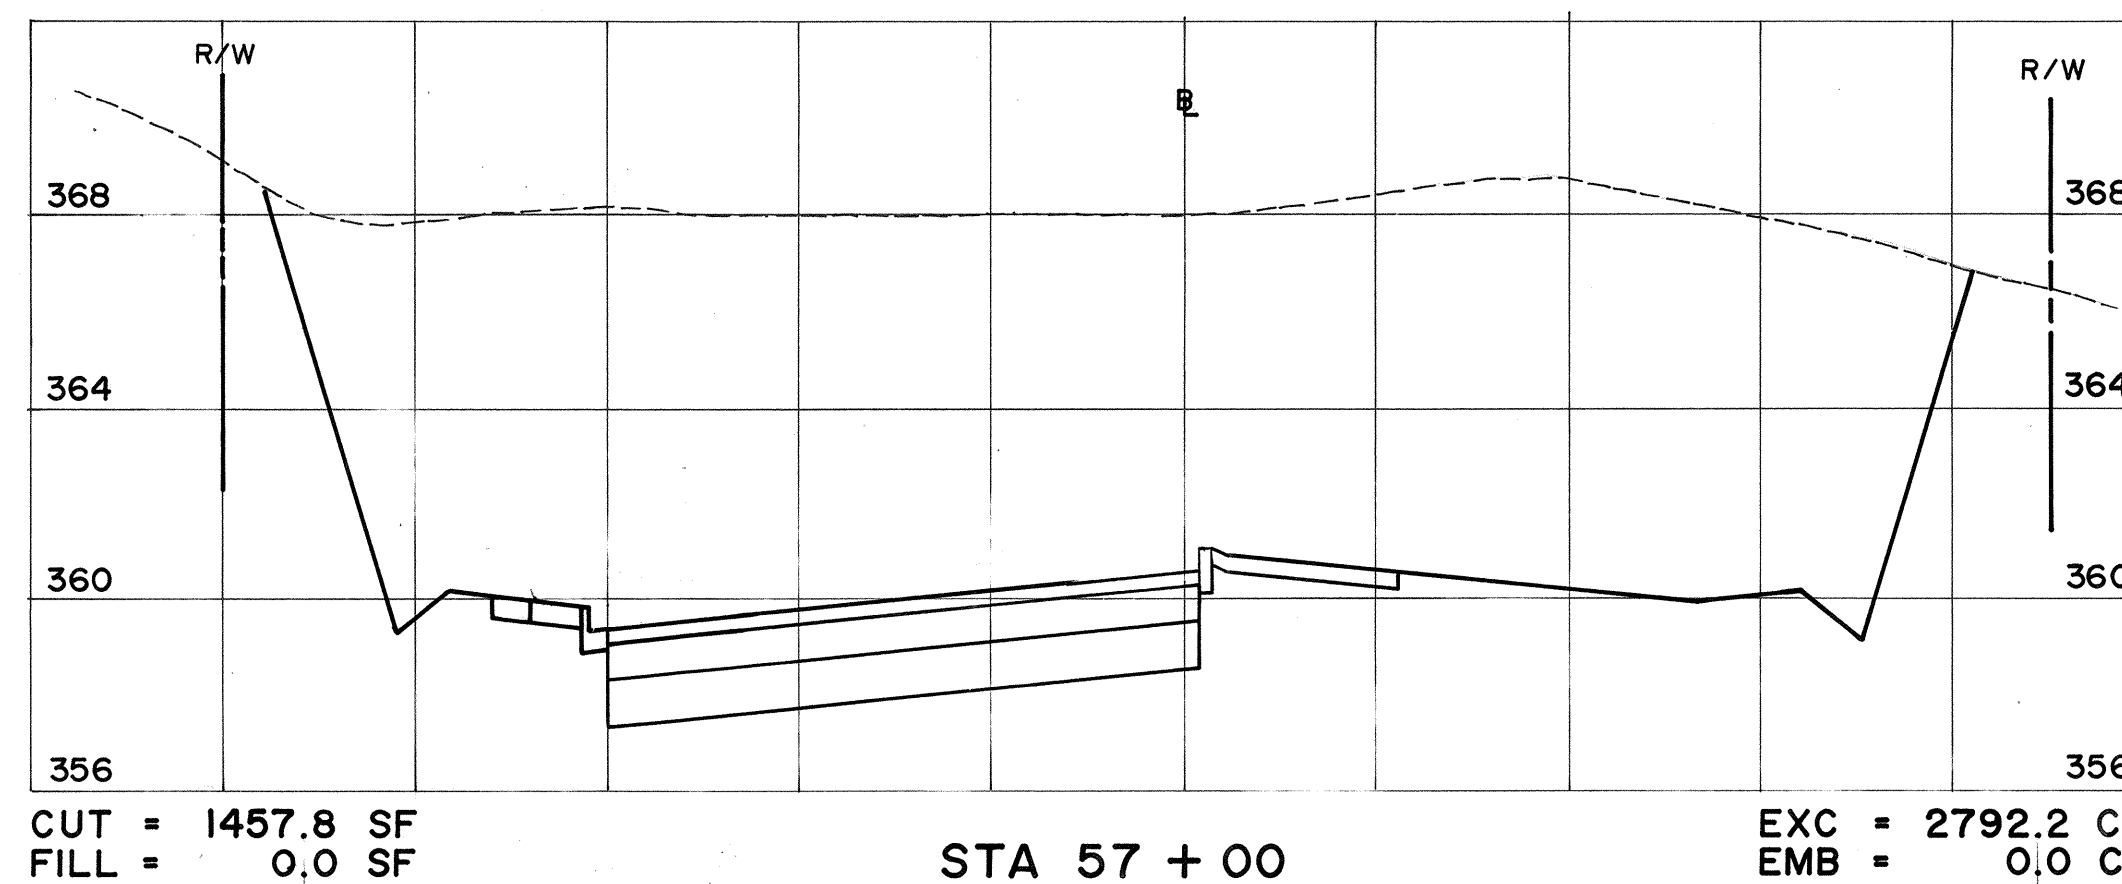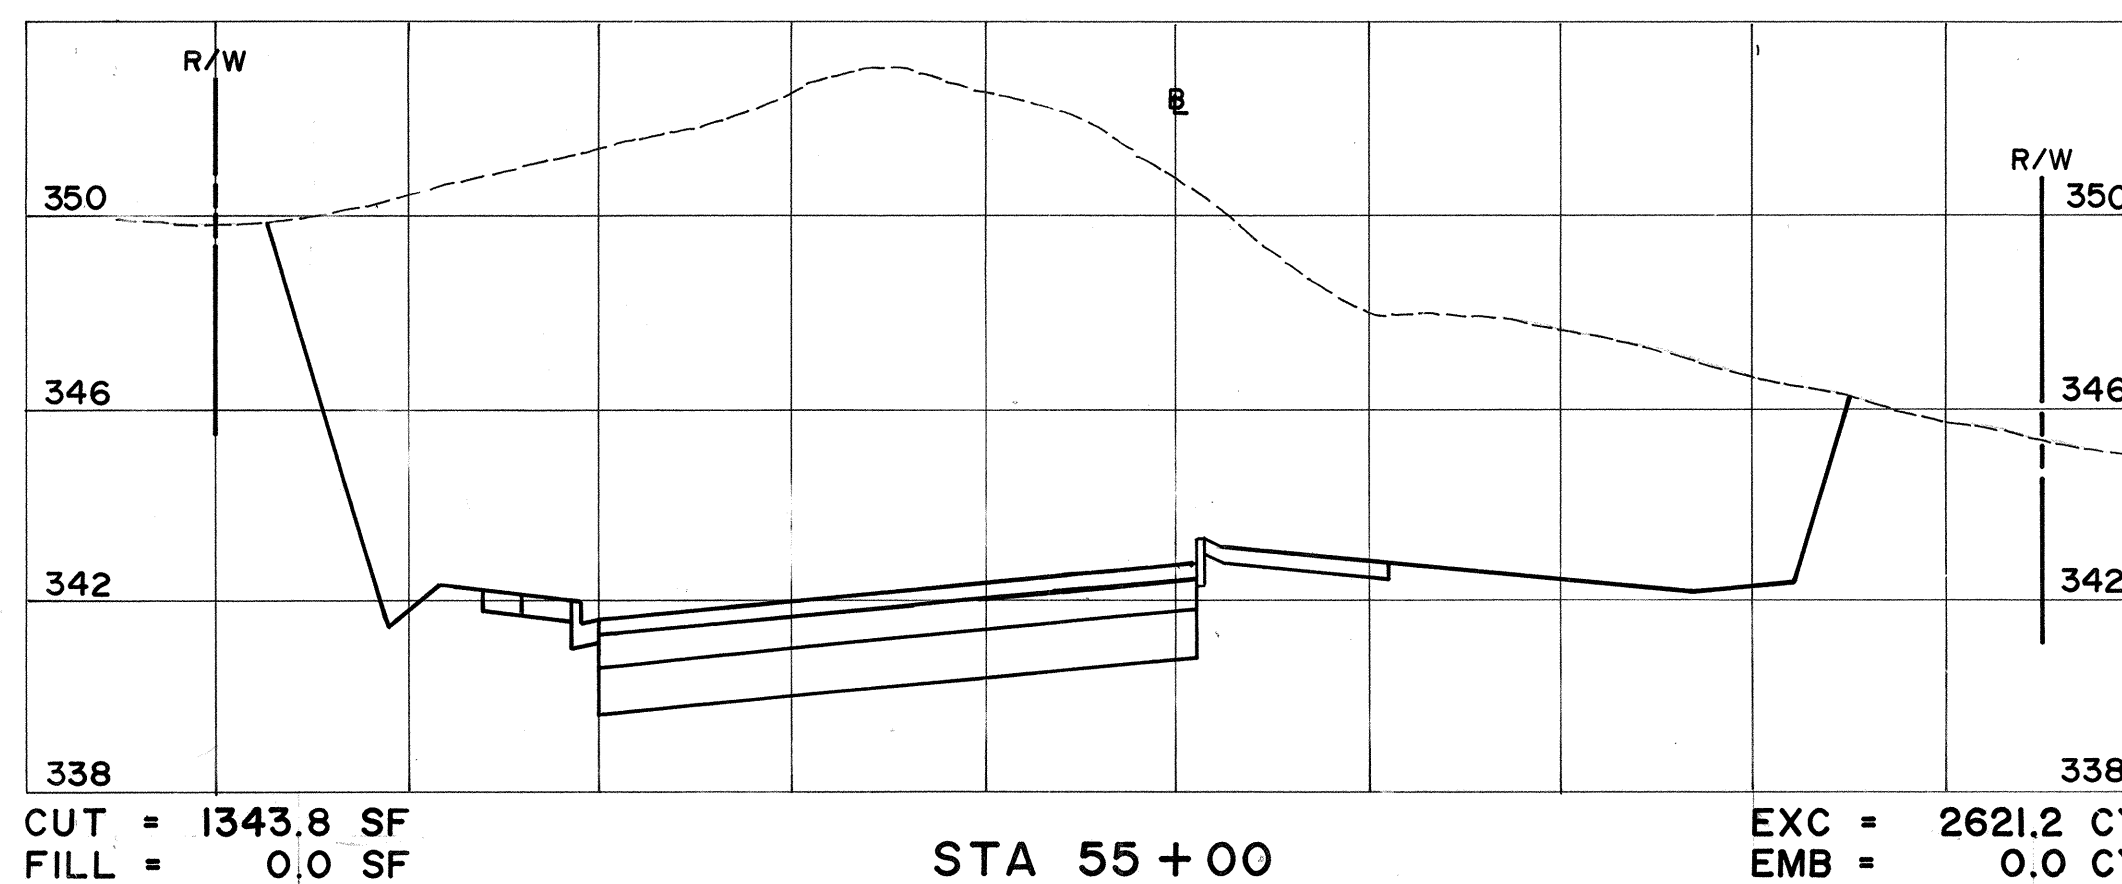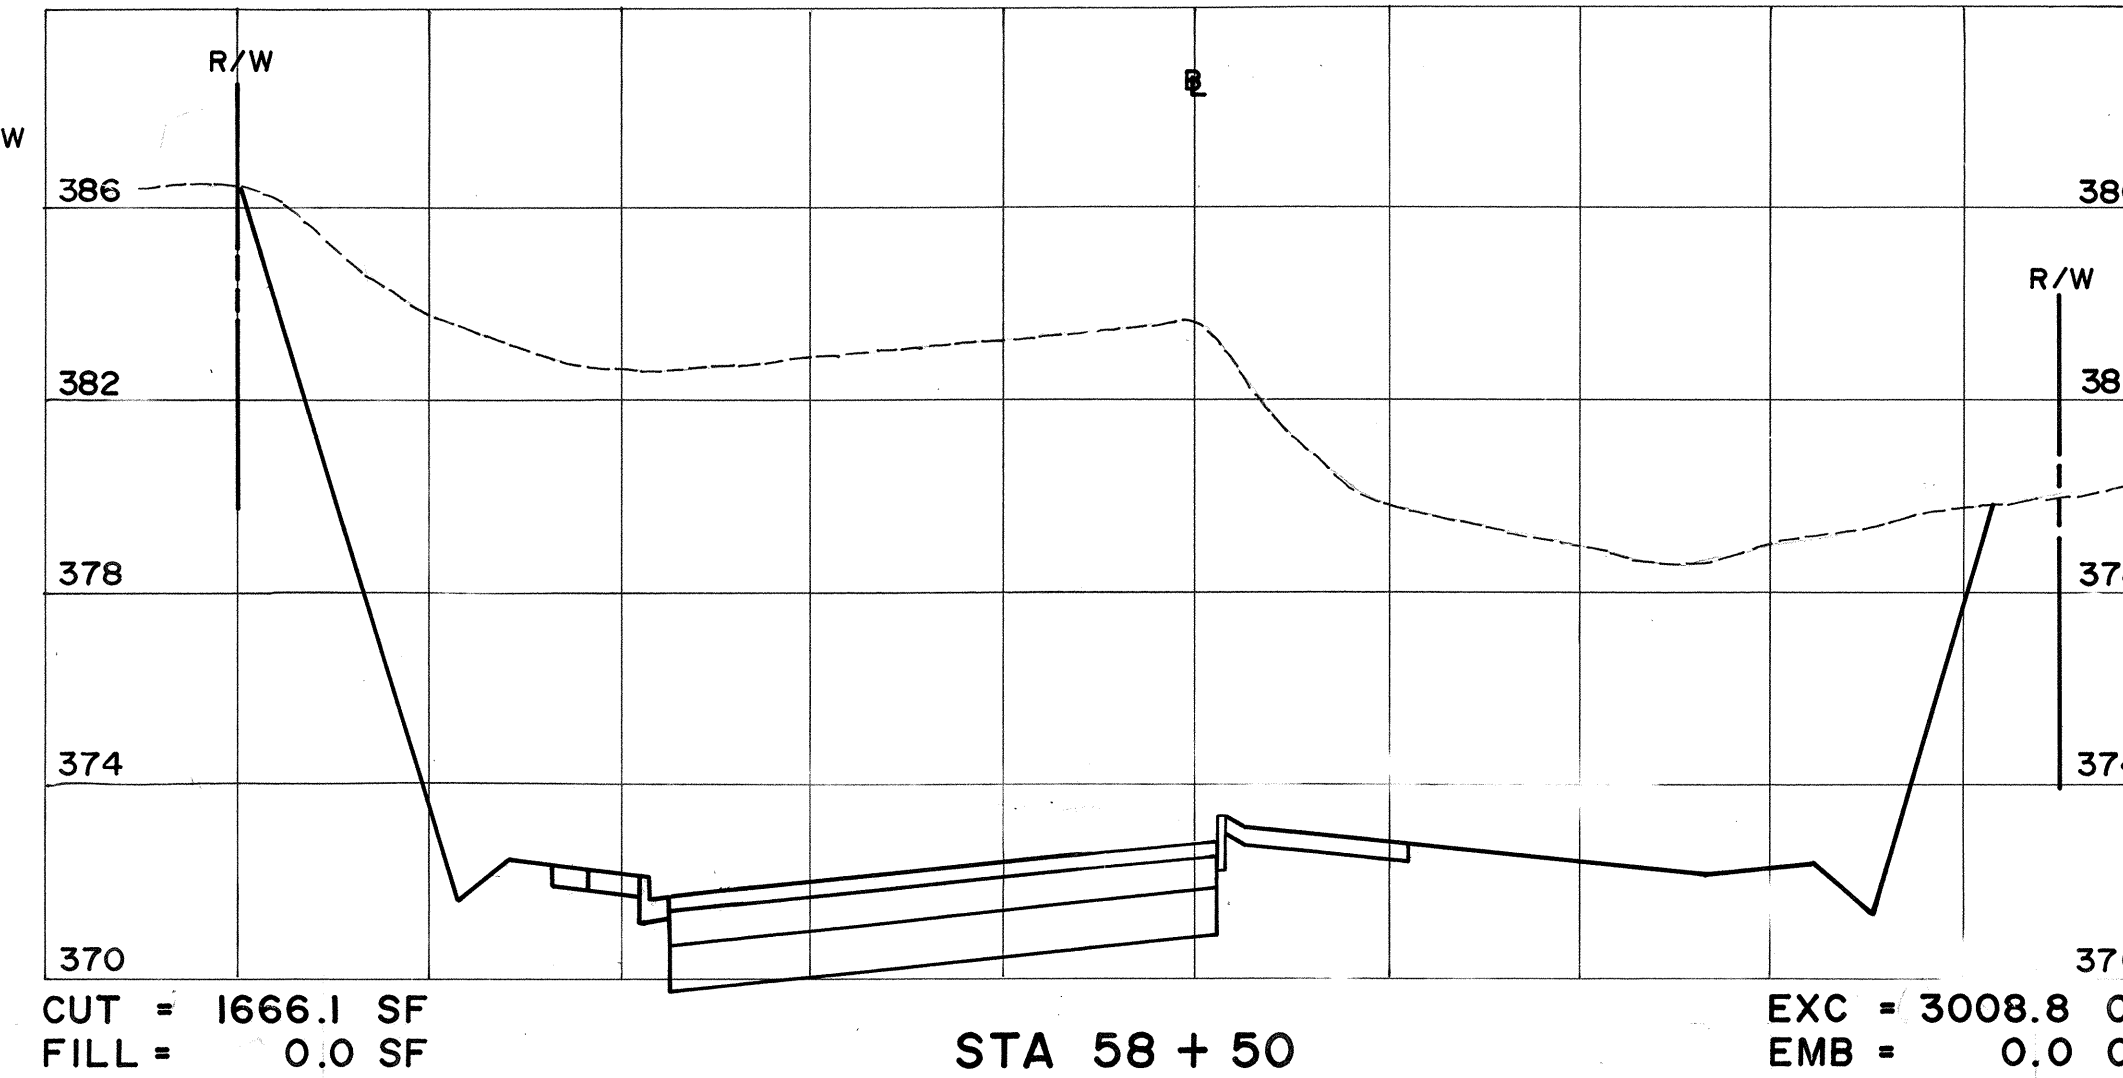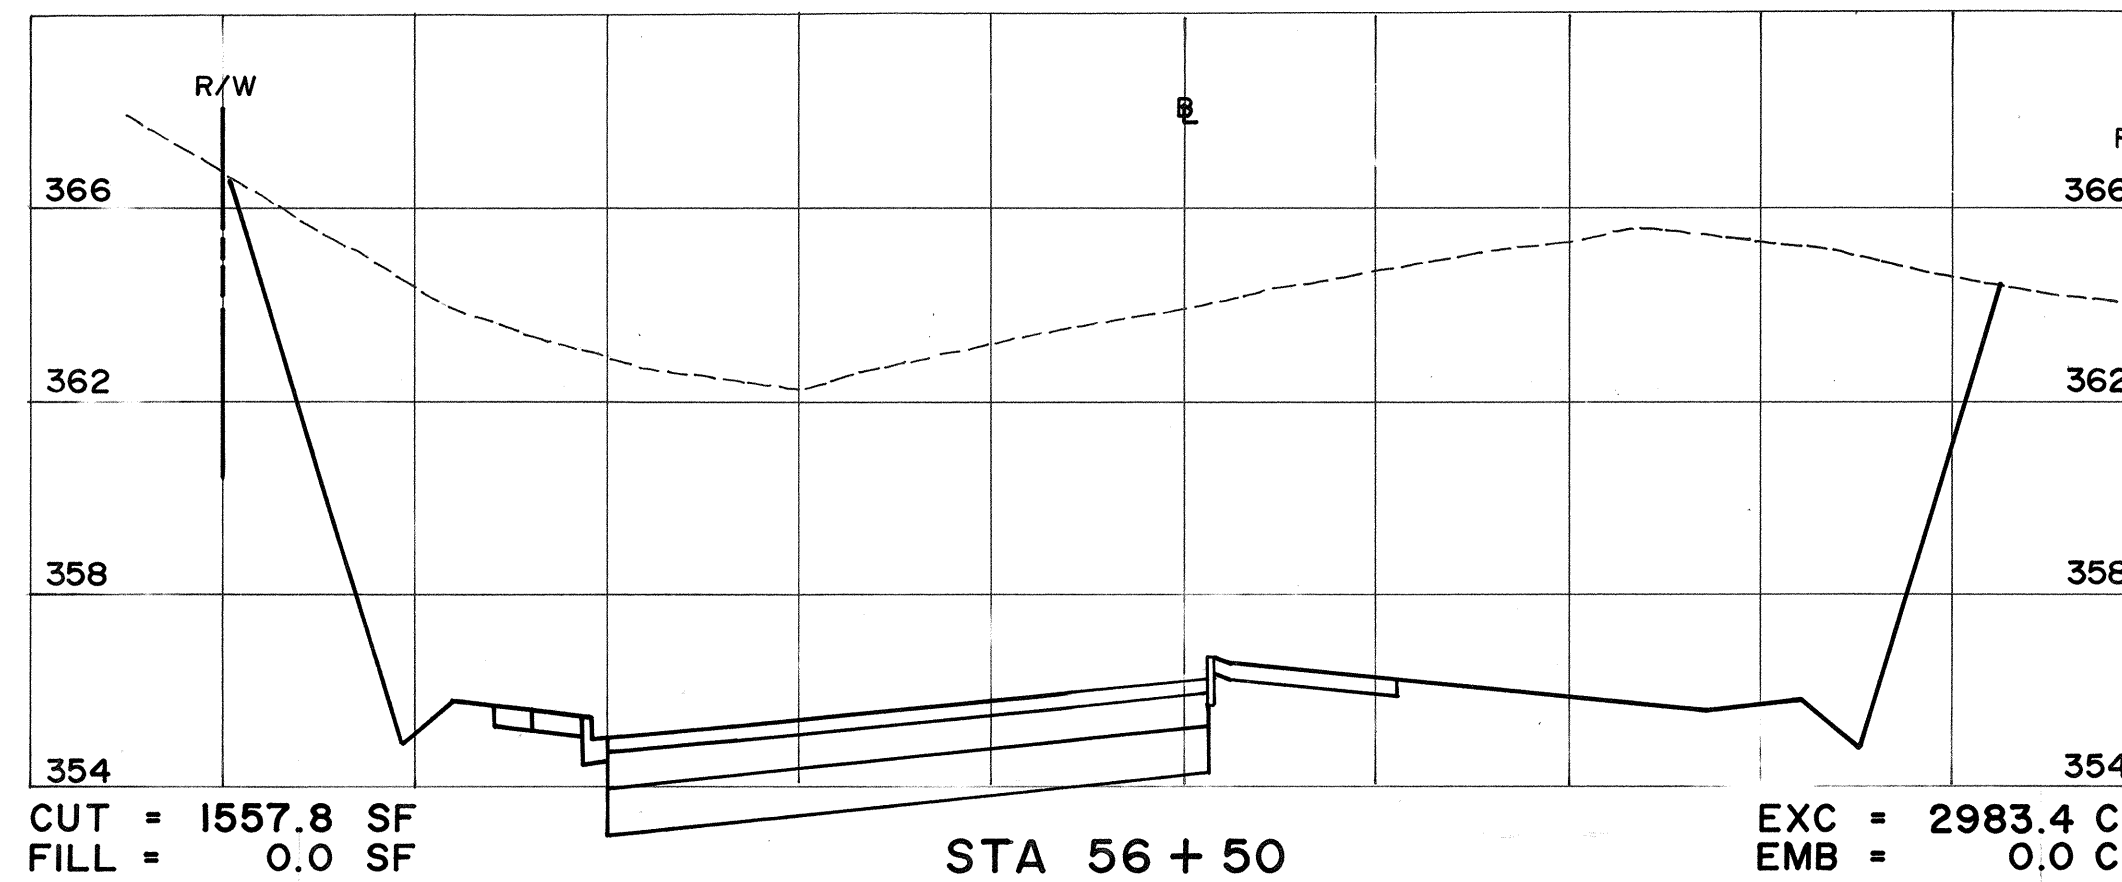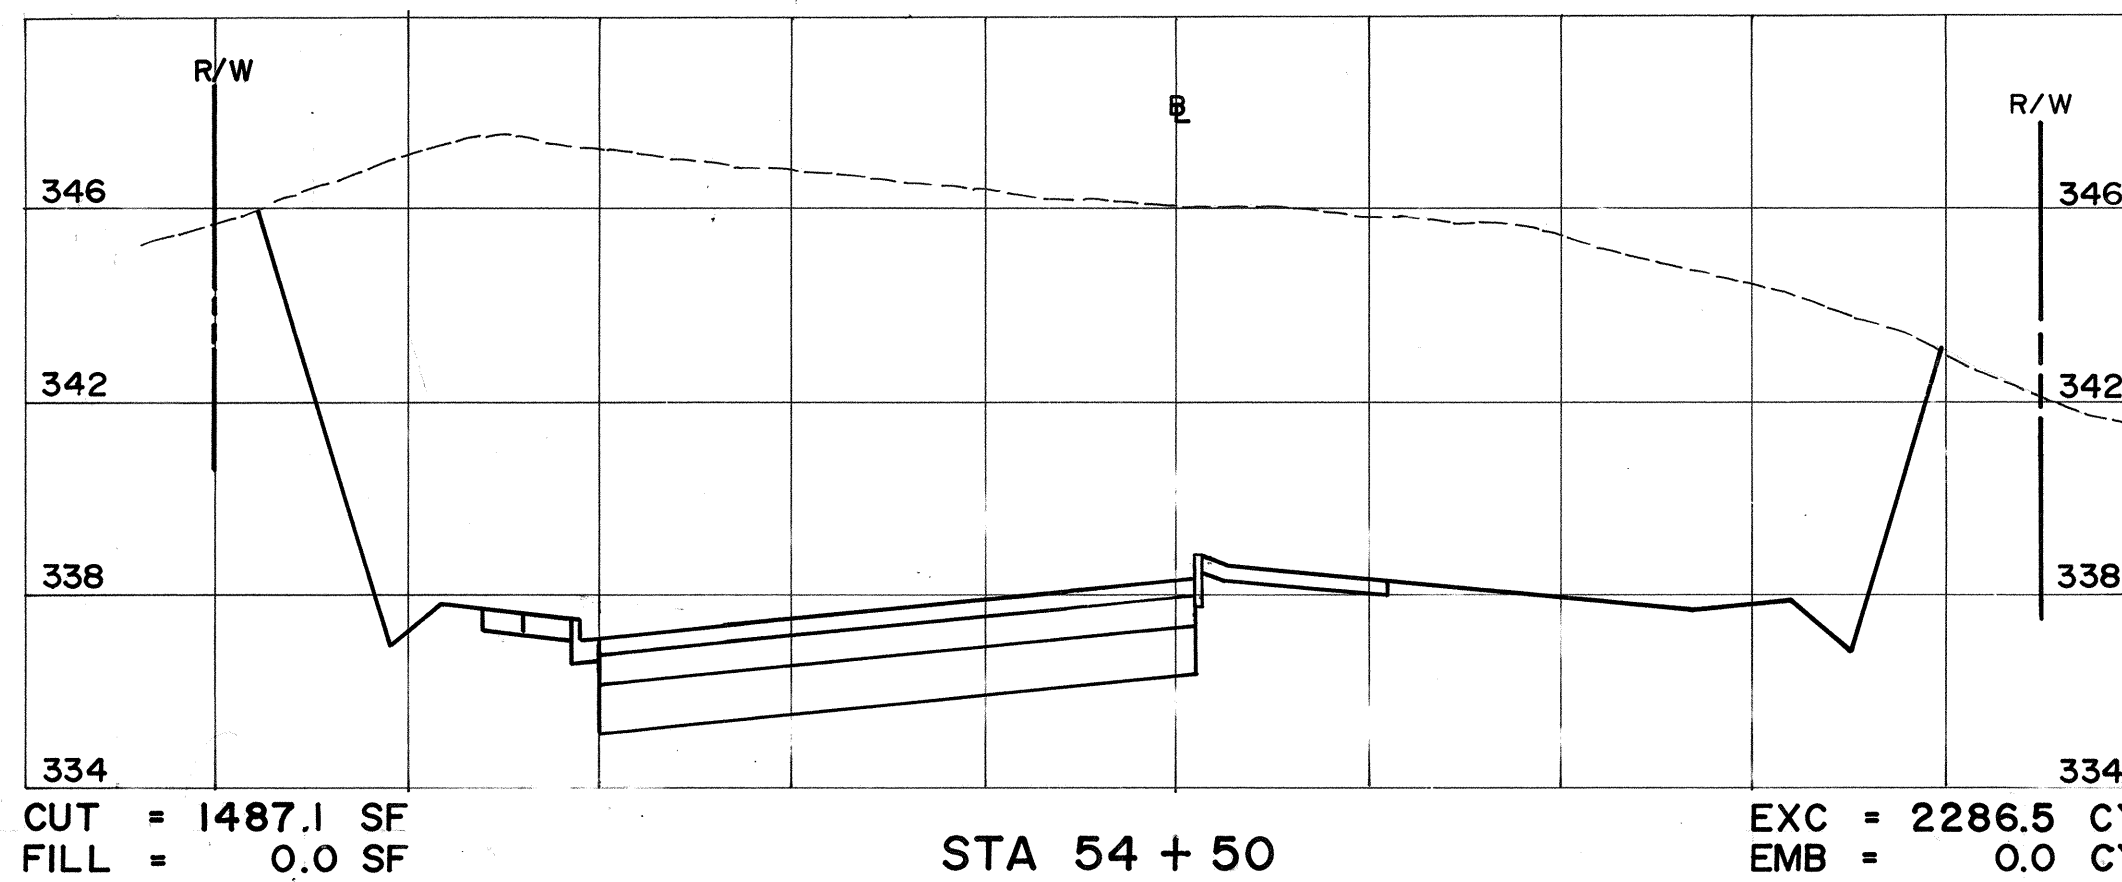

SCALES : HORIZ : 1" = 20'  
VERT : 1" = 4'

Rev	Date	Description	Eng	App

THIS WORK WAS PREPARED BY ME OR UNDER MY SUPERVISION AND CONSTRUCTION OF THIS PROJECT WILL BE UNDER MY OBSERVATION.

CHEYL M. PALESH  
REGISTERED PROFESSIONAL ENGINEER  
No. 5952-C  
HAWAII, U.S.A.

PROJECT NO.190A-02-92

**BELT COLLINS & ASSOCIATES**  
Engineering • Planning • Landscape Architecture  
680 Ala Moana Boulevard, Suite 200, Honolulu, Hawaii 96813  
Phone: (808) 521-5361 Telex: BELTH 7430474 Fax: (808) 538-7819

Consultant:

Client:  
**HOUSING FINANCE AND DEVELOPMENT CORPORATION**  
STATE OF HAWAII

**VILLAGES OF LA'I OPUA**  
BACKBONE INFRASTRUCTURE PHASE-2A

**KEALAKEHE PARKWAY**  
CROSS SECTIONS  
STA 54 + 50 TO STA 59 + 00

Designed by: A.K. Date: NOV., 1993  
Drawn by: M.F.O.D.C. Proj. no.: (BCA) 841.0104









Approved: \_\_\_\_\_  
Date \_\_\_\_\_

841.540C-25

Trim: 22"x36"

RECORD DRAWINGS

SHEET C-37 of 111 Sheets

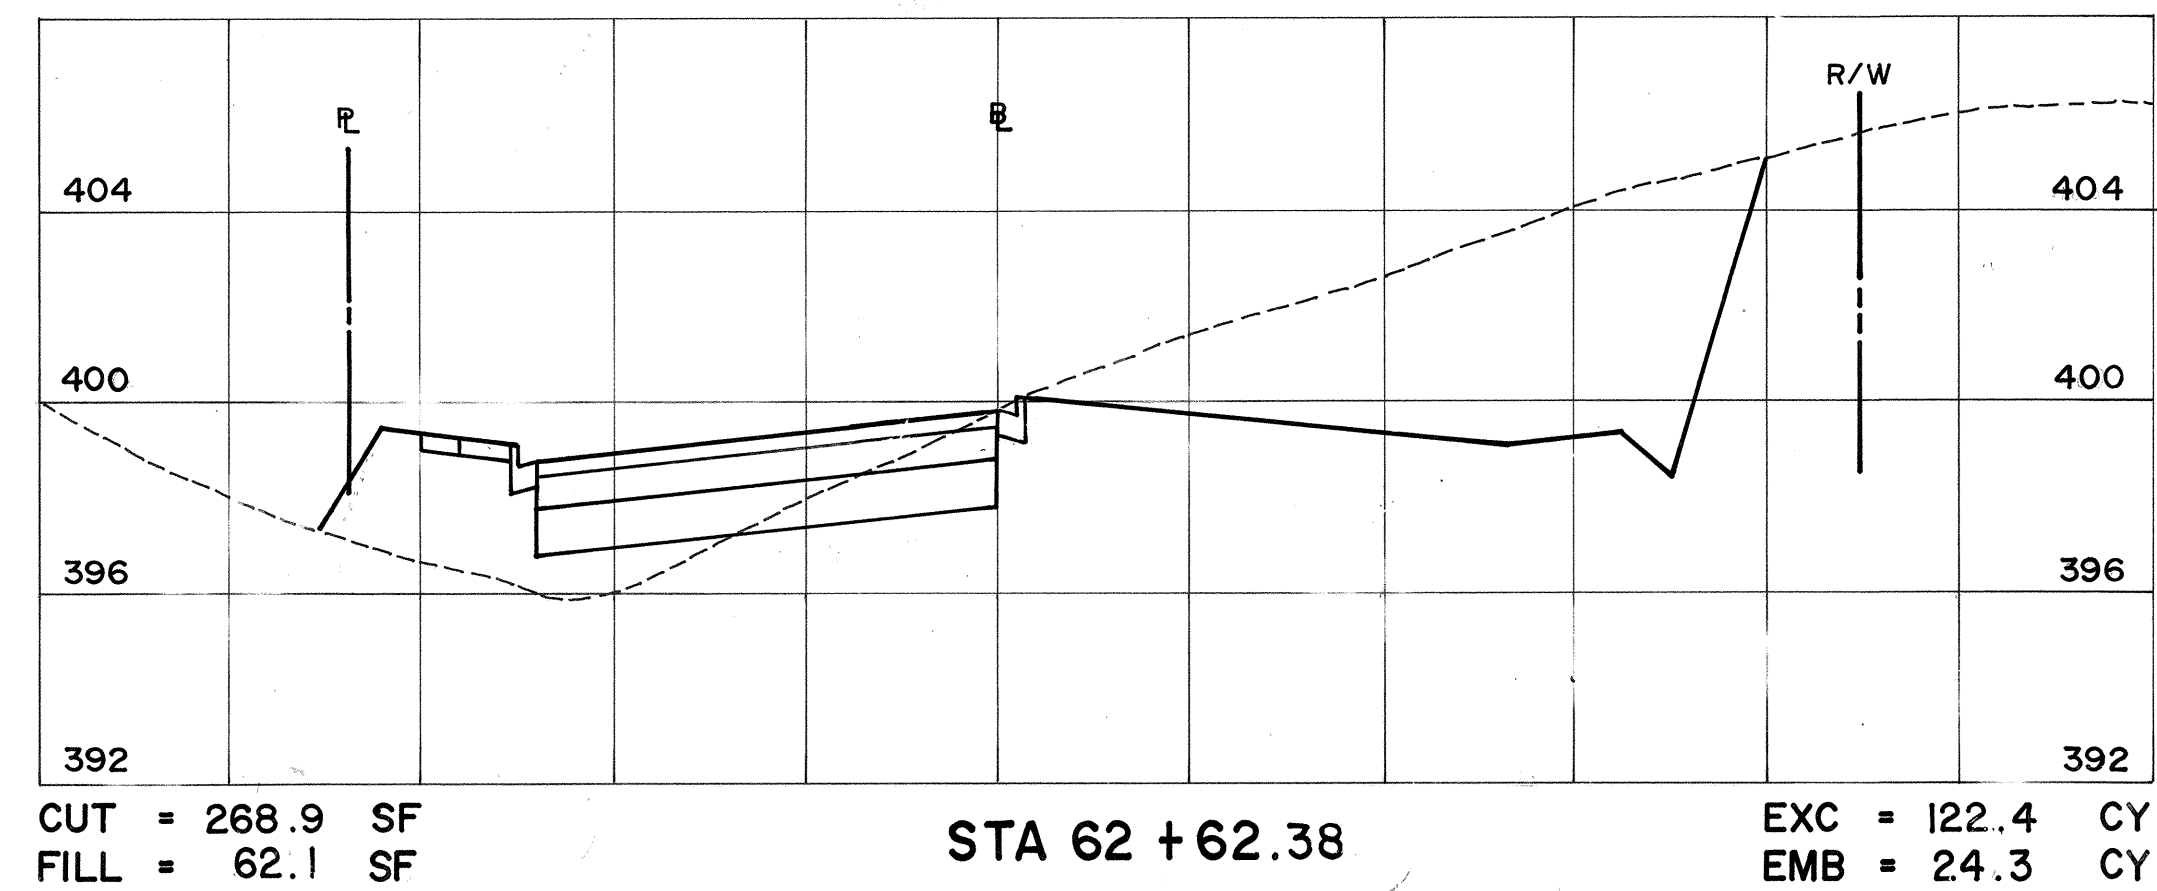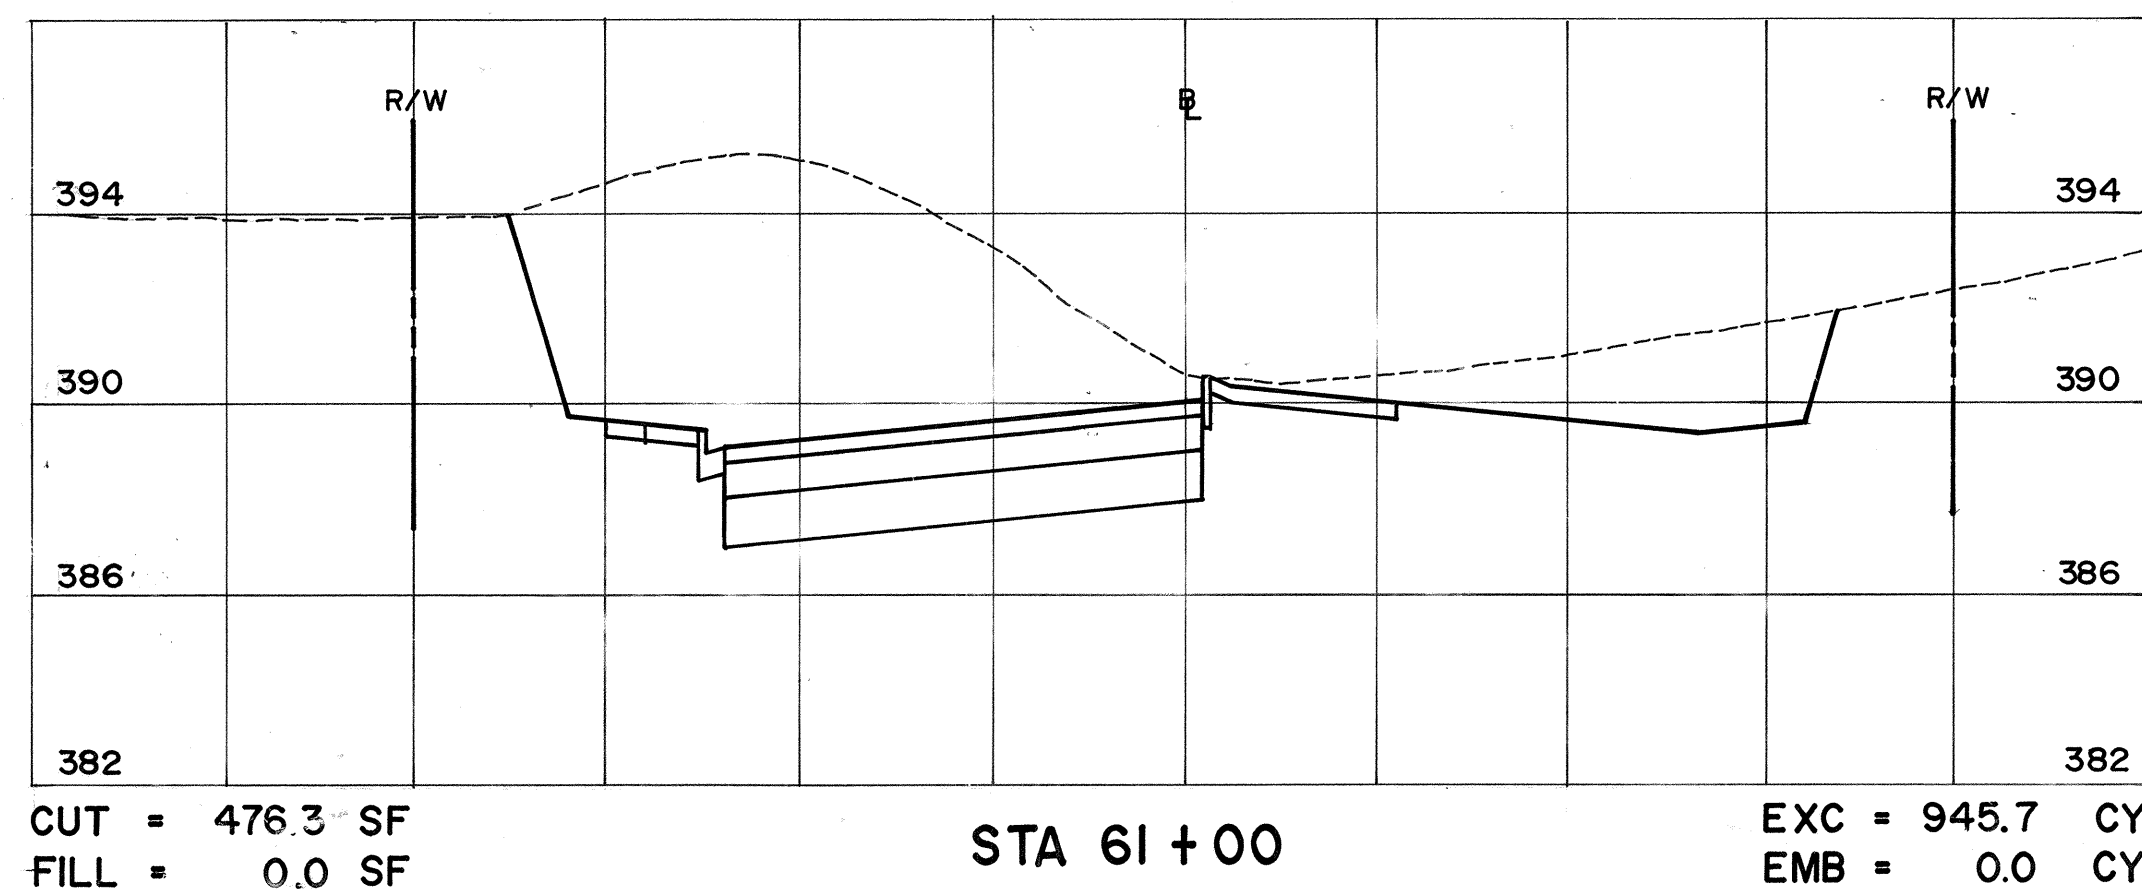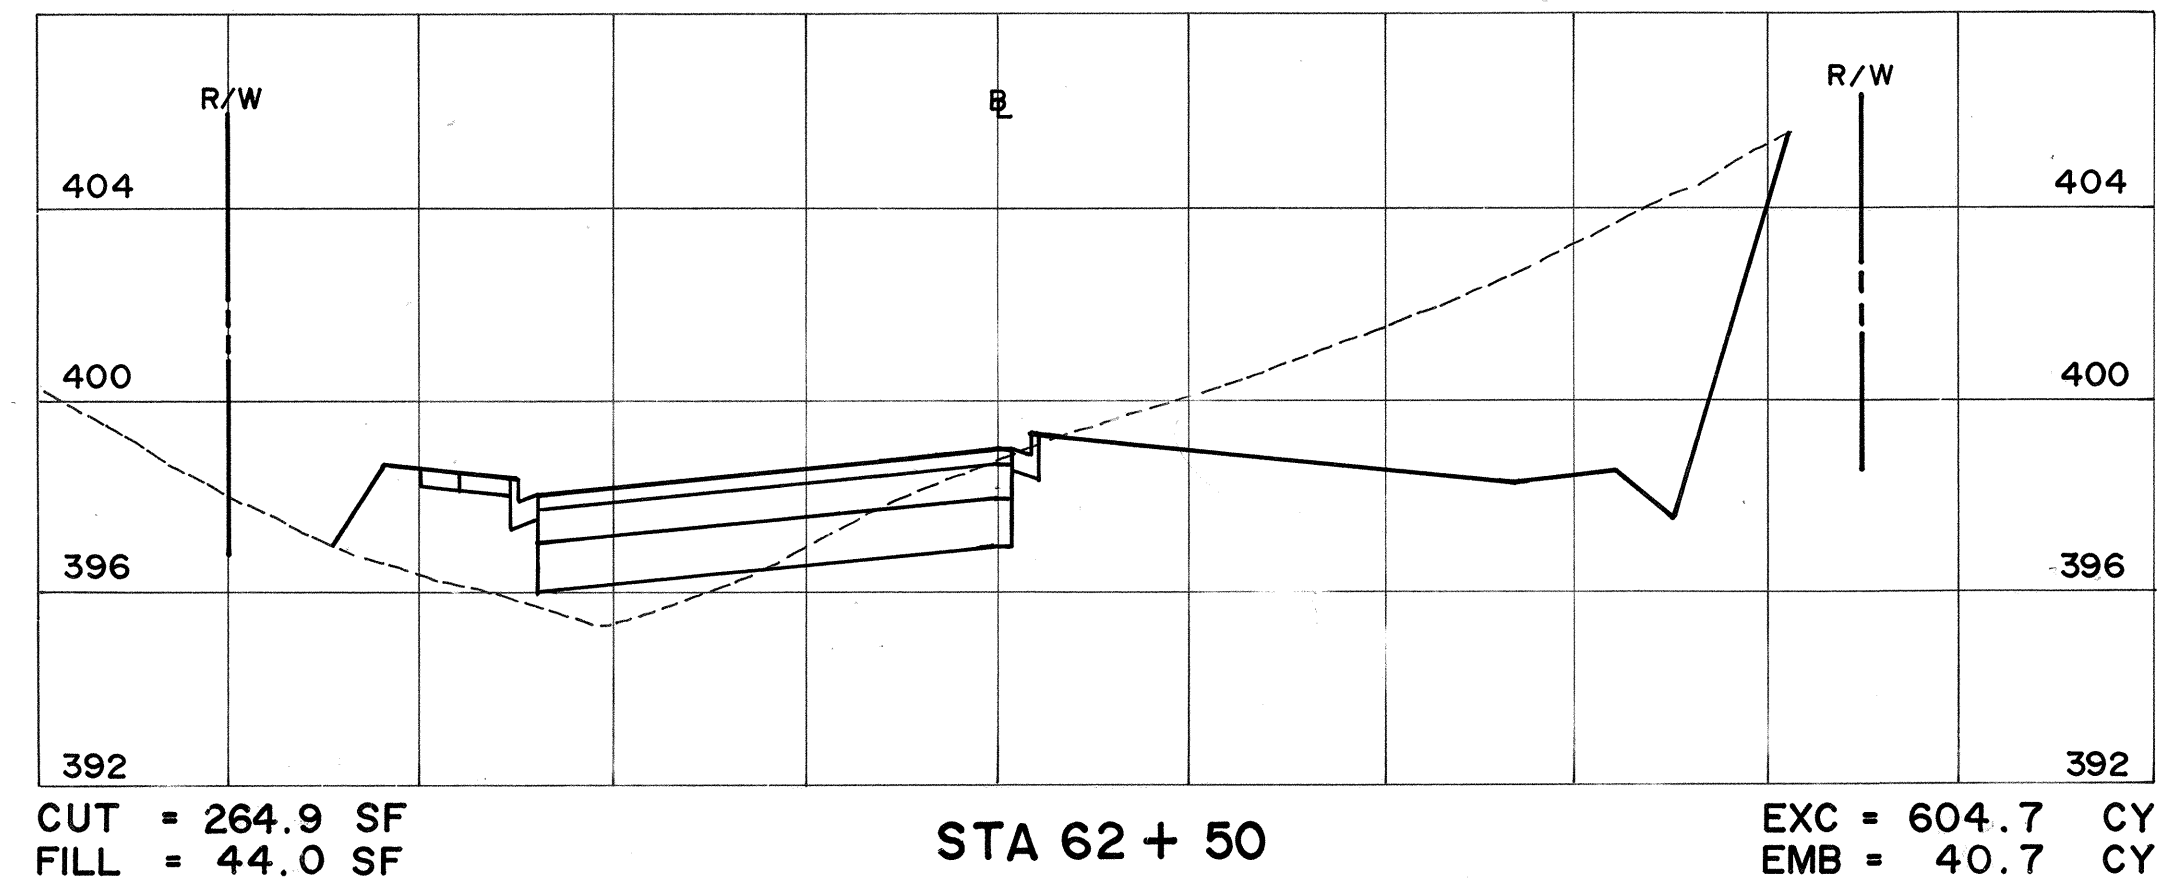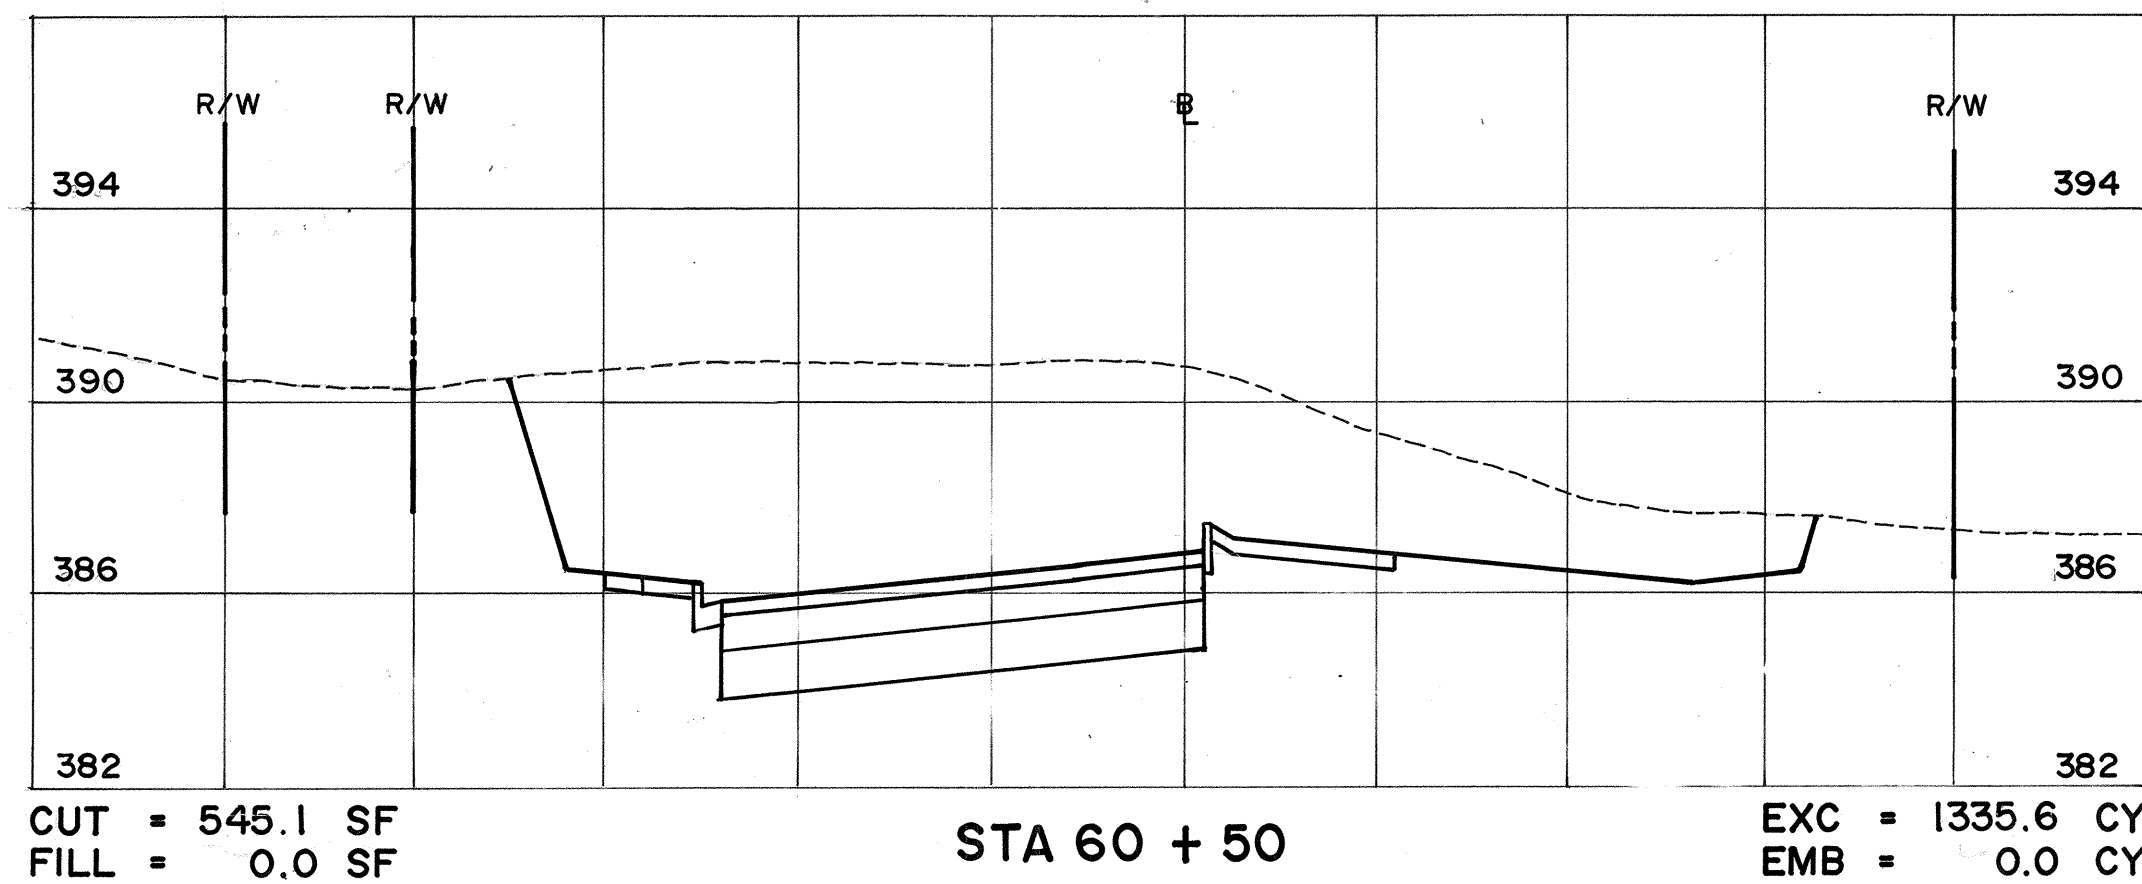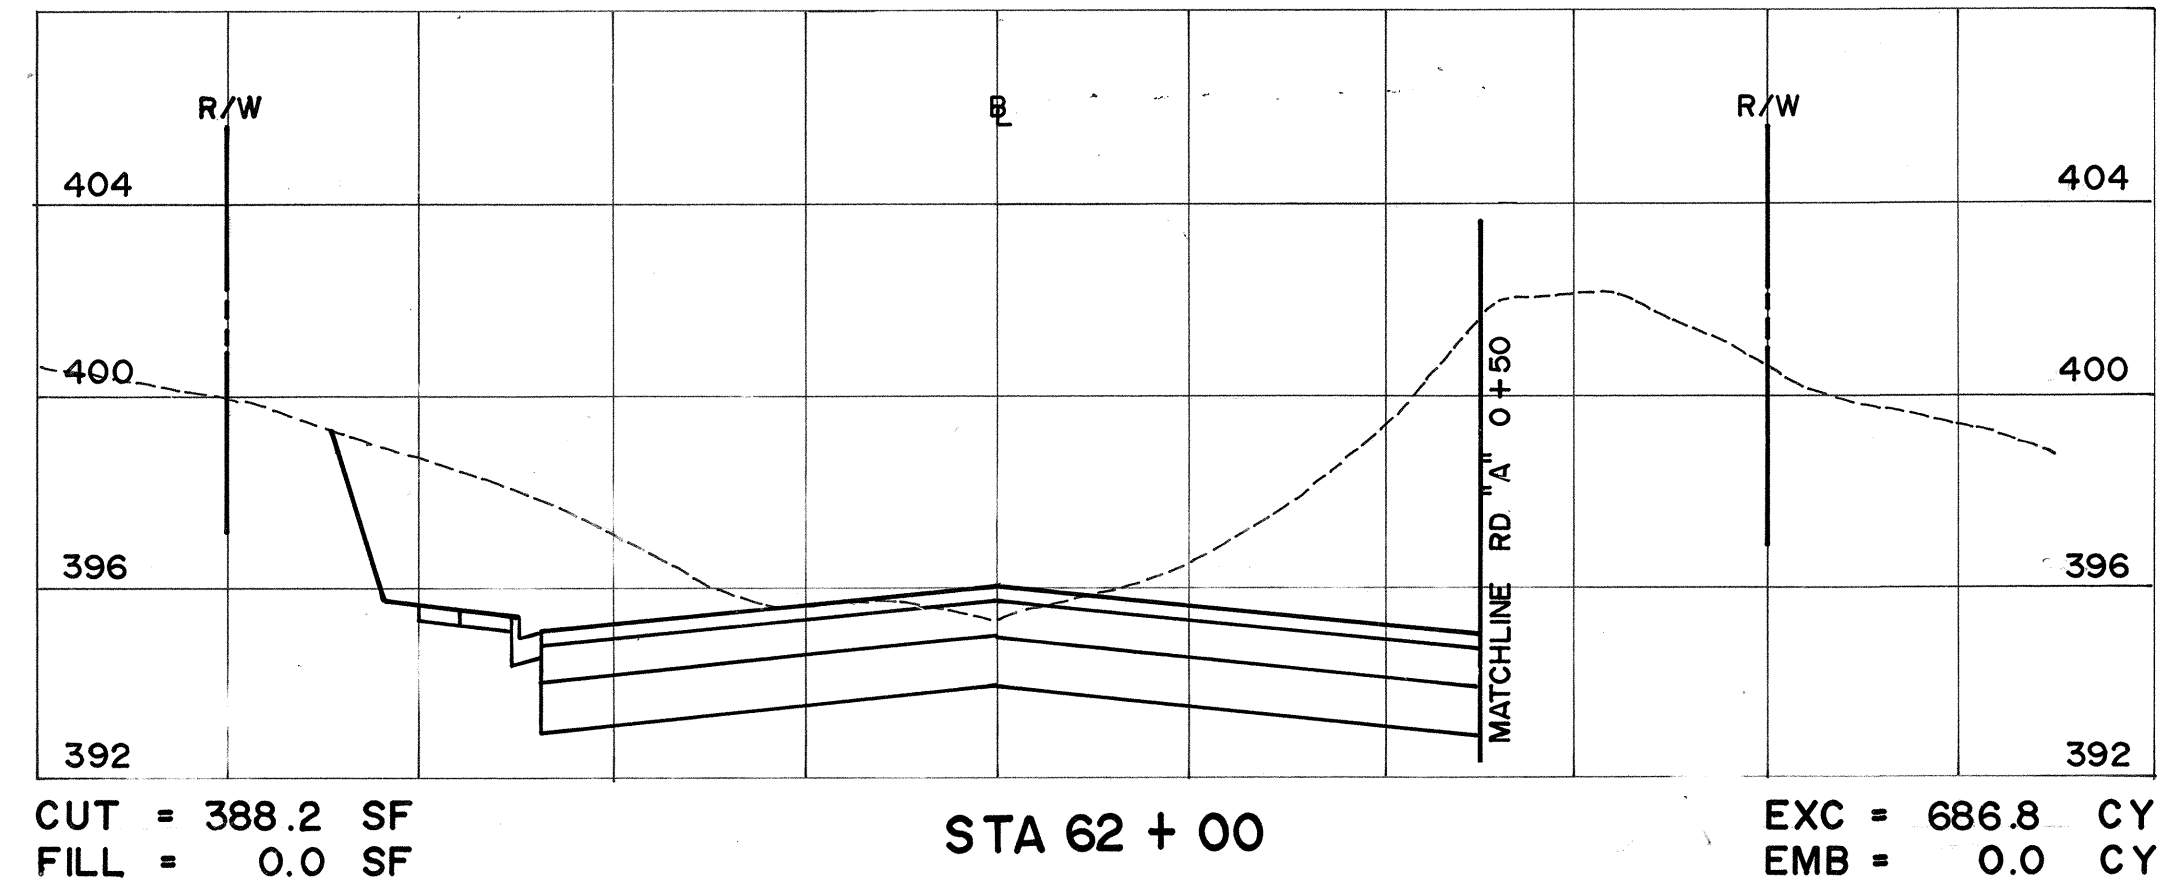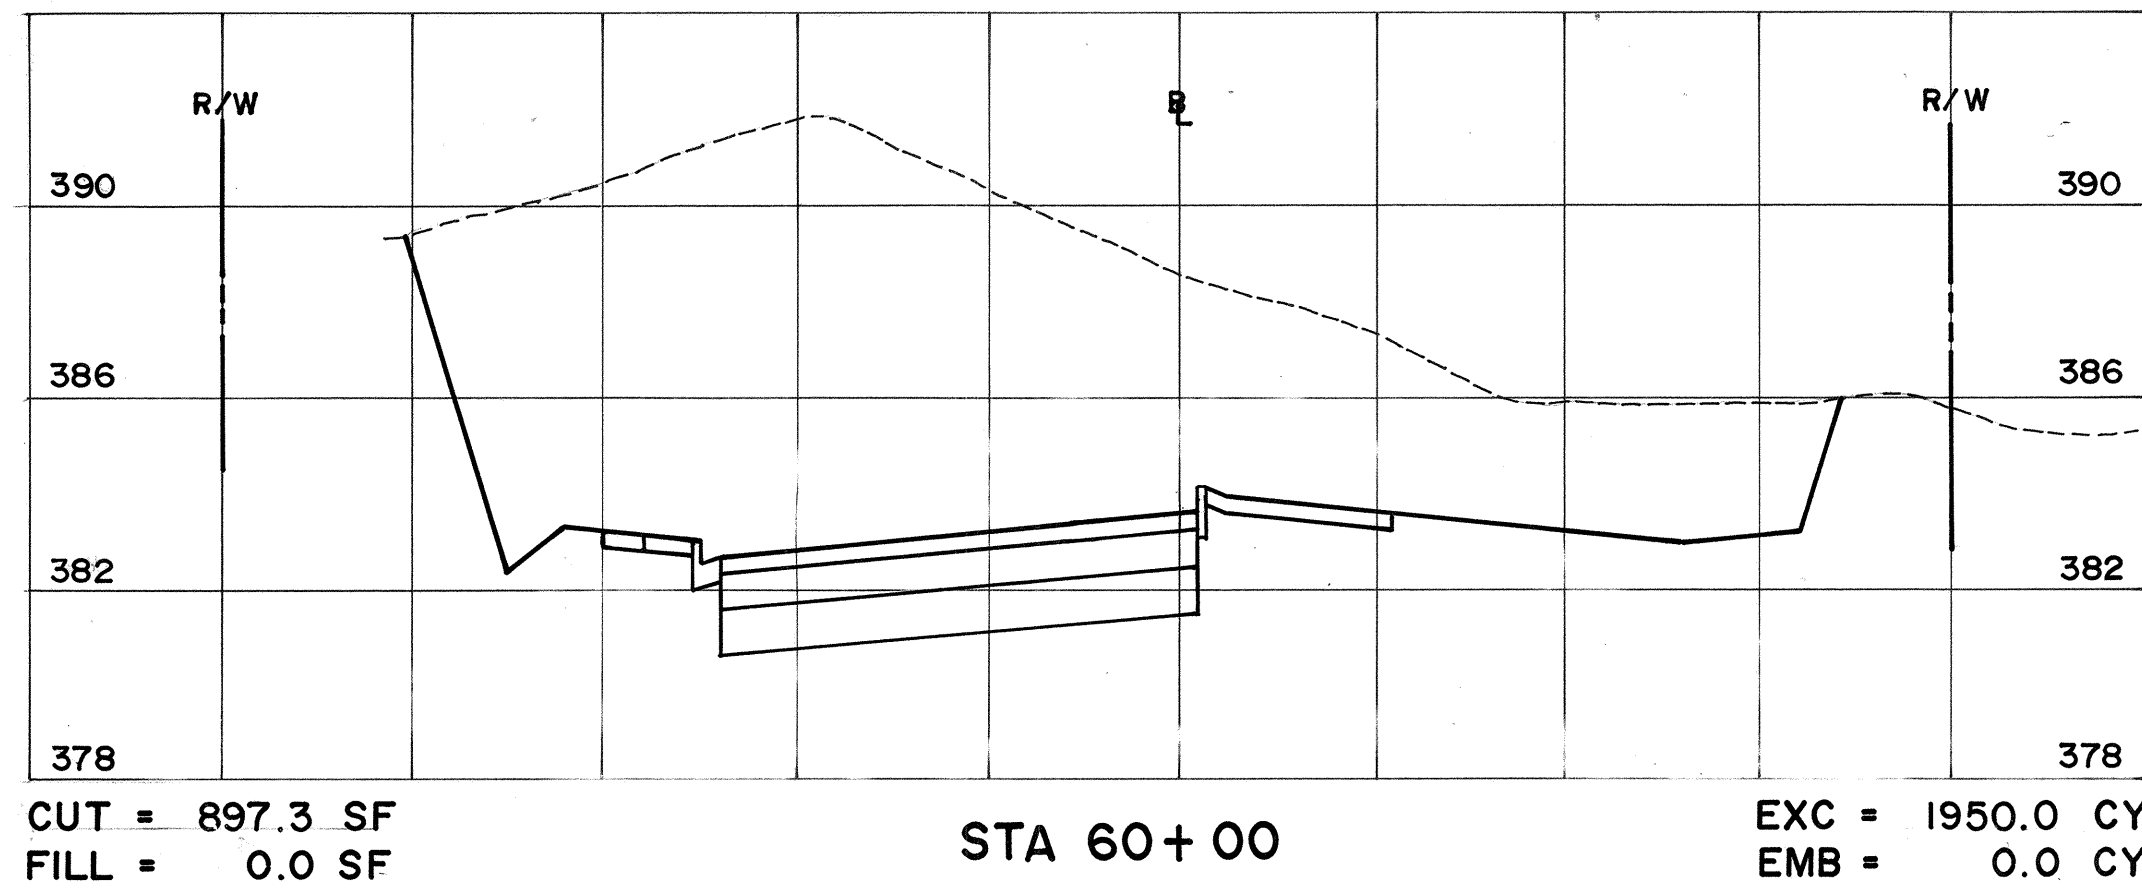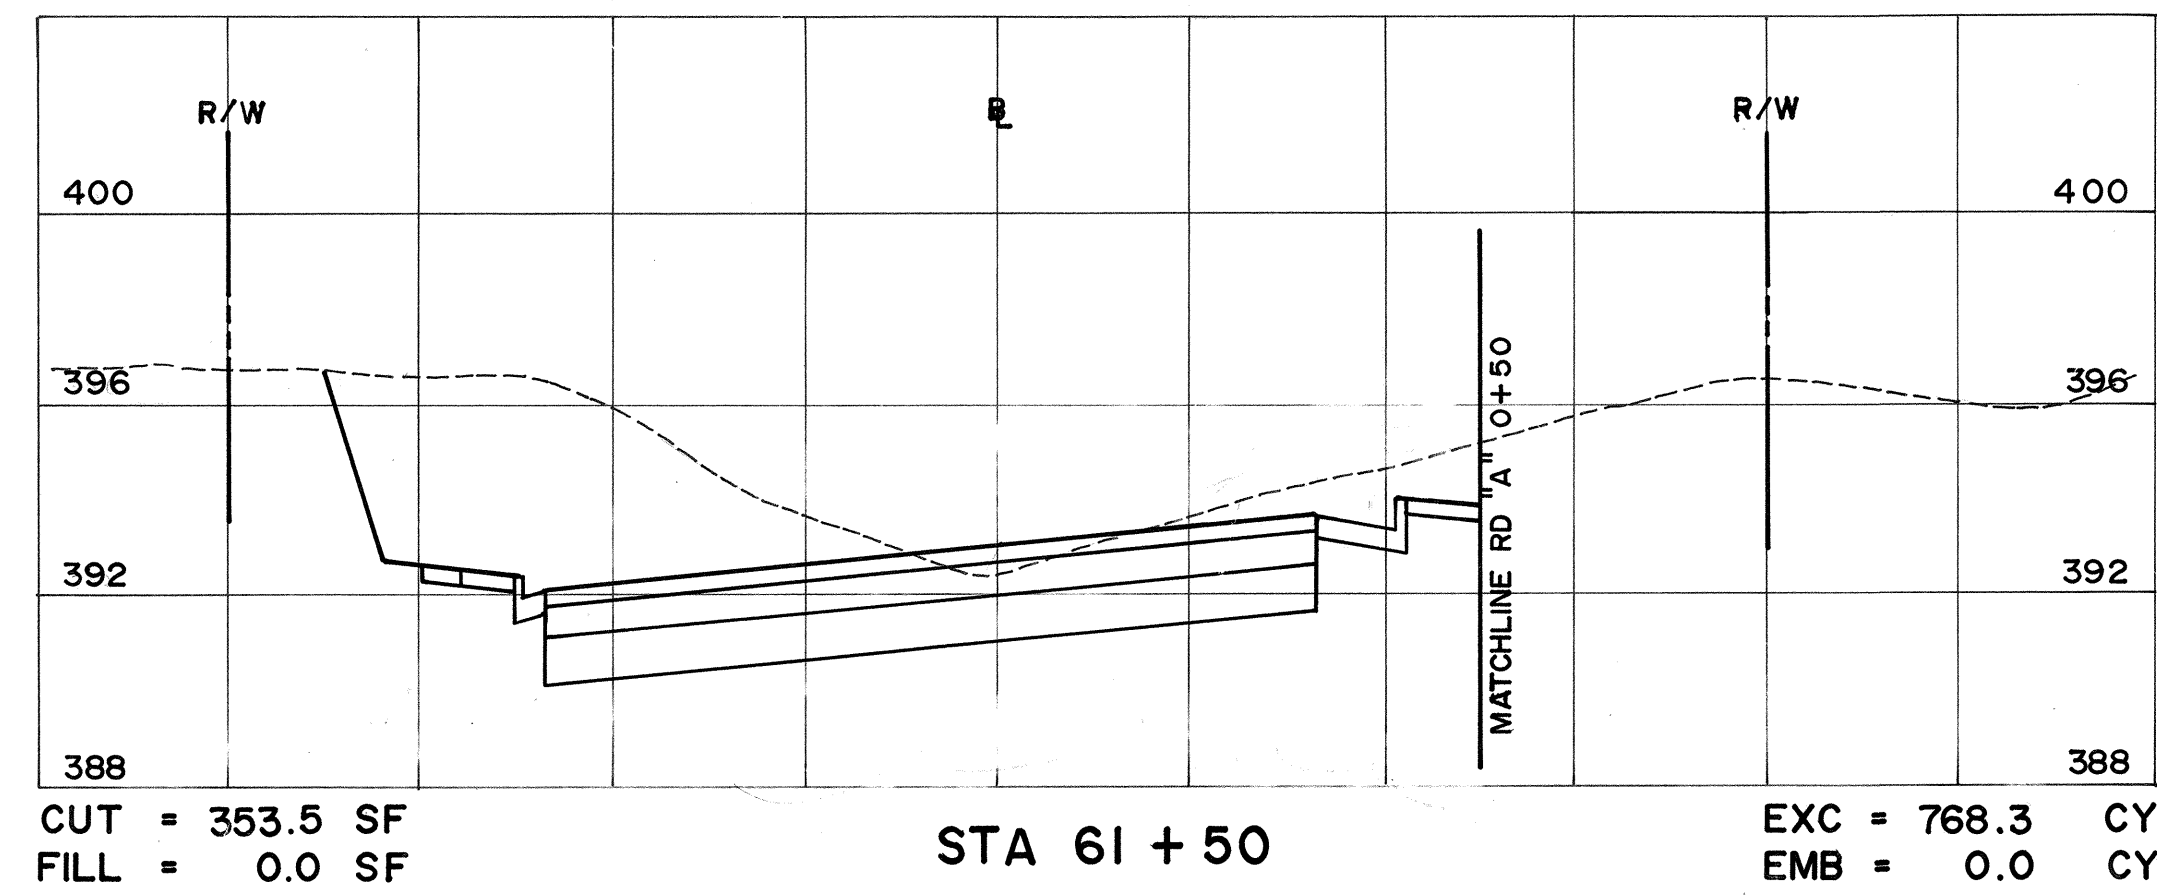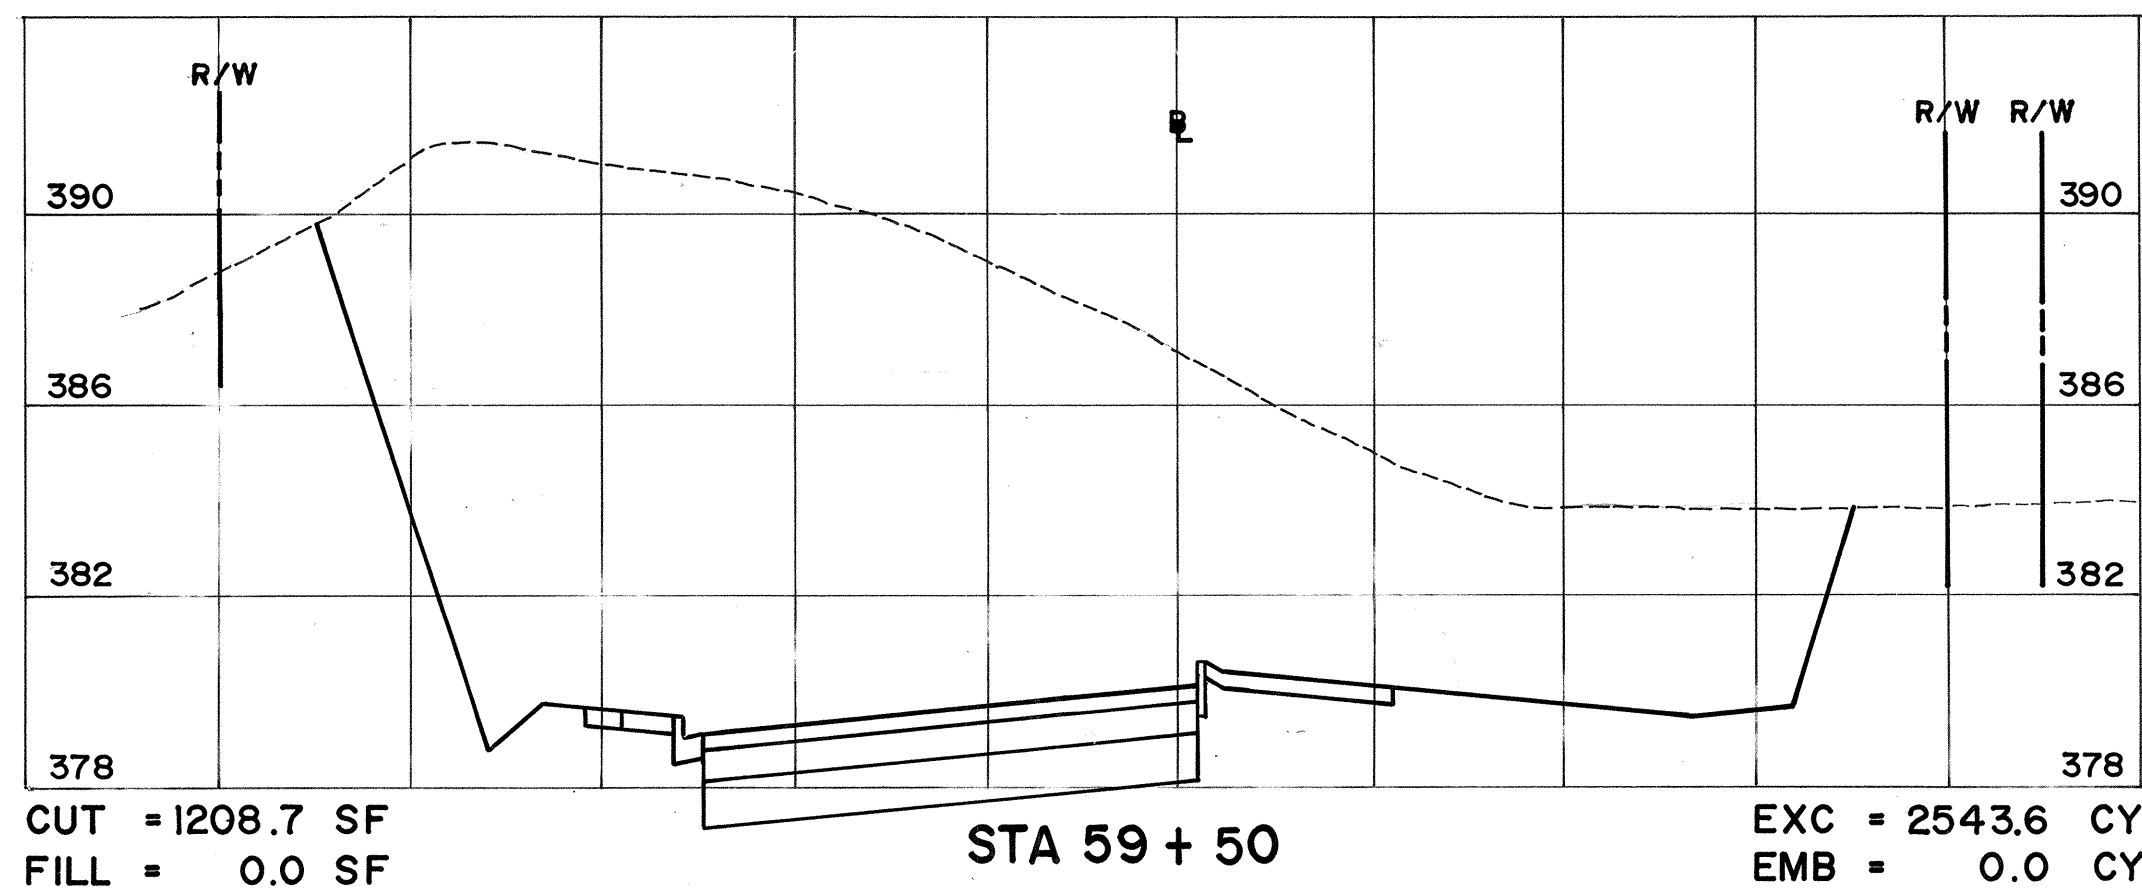

SCALES : HORIZ : 1" = 20'  
VERT : 1" = 4'

Rev	Date	Description	Eng	App

THIS WORK WAS PREPARED BY ME  
OR UNDER MY SUPERVISION  
AND CONSTRUCTION OF THIS  
PROJECT WILL BE UNDER MY  
OBSERVATION.

CHERYL M. PALESH  
REGISTERED  
PROFESSIONAL  
ENGINEER  
No. 5952-C  
HAWAII, U.S.A.

PROJECT NO. 190A-02-92

**BELT COLLINS & ASSOCIATES**  
Engineering • Planning • Landscape Architecture  
680 Ala Moana Boulevard Suite 200 Honolulu, Hawaii 96813  
Phone: (808) 521-5361 Telex: BELTH 7430474 Fax: (808) 538-7819

Client:  
**HOUSING FINANCE AND  
DEVELOPMENT CORPORATION**  
STATE OF HAWAII

**VILLAGES OF LA'I OPUA  
BACKBONE INFRASTRUCTURE PHASE-2A**

**KEALAKEHE PARKWAY  
CROSS SECTIONS  
STA 59+50 TO STA 62+62.38**

Designed by: A.K. Date: NOV. 1993  
Drawn by: RKN Proj. no.: (BCA) 841.0104  
Approved: \_\_\_\_\_  
Date: \_\_\_\_\_

841.0104-C-38

Trim: 22"x36"

RECORD DRAWINGS

SHEET C-38 of 111 Sheets