

5275.3

Fed. Road Dist. No.	State	Fed. Aid Proj. No.	Project No.	Sheet No.	Total Sheets
HAWAII	HAW	SDR 2(1)	1947	4	12

B.M.: Drill hole in rock
Elevation, 7.38

PORION OF EXISTING ROADWAY
WASHED OUT BY SEISMIC WAVE
OF APRIL 1, 1946 & HEAVY SEAS OF
JANUARY 1947 & PREVIOUS YEARS

Sta. 90+40 L. Excavate Connecting
Channel to Elev. -2.0 as directed.
EST. QUANT.: 150 C.Y. Uncl. Exc.

Sta. 91+00 L. Fill Pond
to Elev. 5.0 as directed.
EST. QUANT.: 500 C.Y. Emb.

NOTE: All connections to existing private
driveways to be as staked. Total
estimated quantities, 70 Sq. Yd.
Pav't, 120 C.Y. Emb.

B.M.: Spike in conc. at SW
corner of Ld. Ct. Appl'n
1111. Elevation 7.83.

L.D. CT. APPL'N 1146

STA. 101+65 26 : END OF PROJ. NO. SDR 2(1)



STA. 16+70 11 COUNTY OF HAWAII, JOB NO. 386

F.A. Marker as per Std Details

NOTE: Construct connection between Sta. 101+65 26 & Sta. 103+00
Extreme care shall be exercised in this operation to assure
a smooth, pleasant appearing, easy riding approach.

PROJ. EQUATION

Scale: 1"=100'

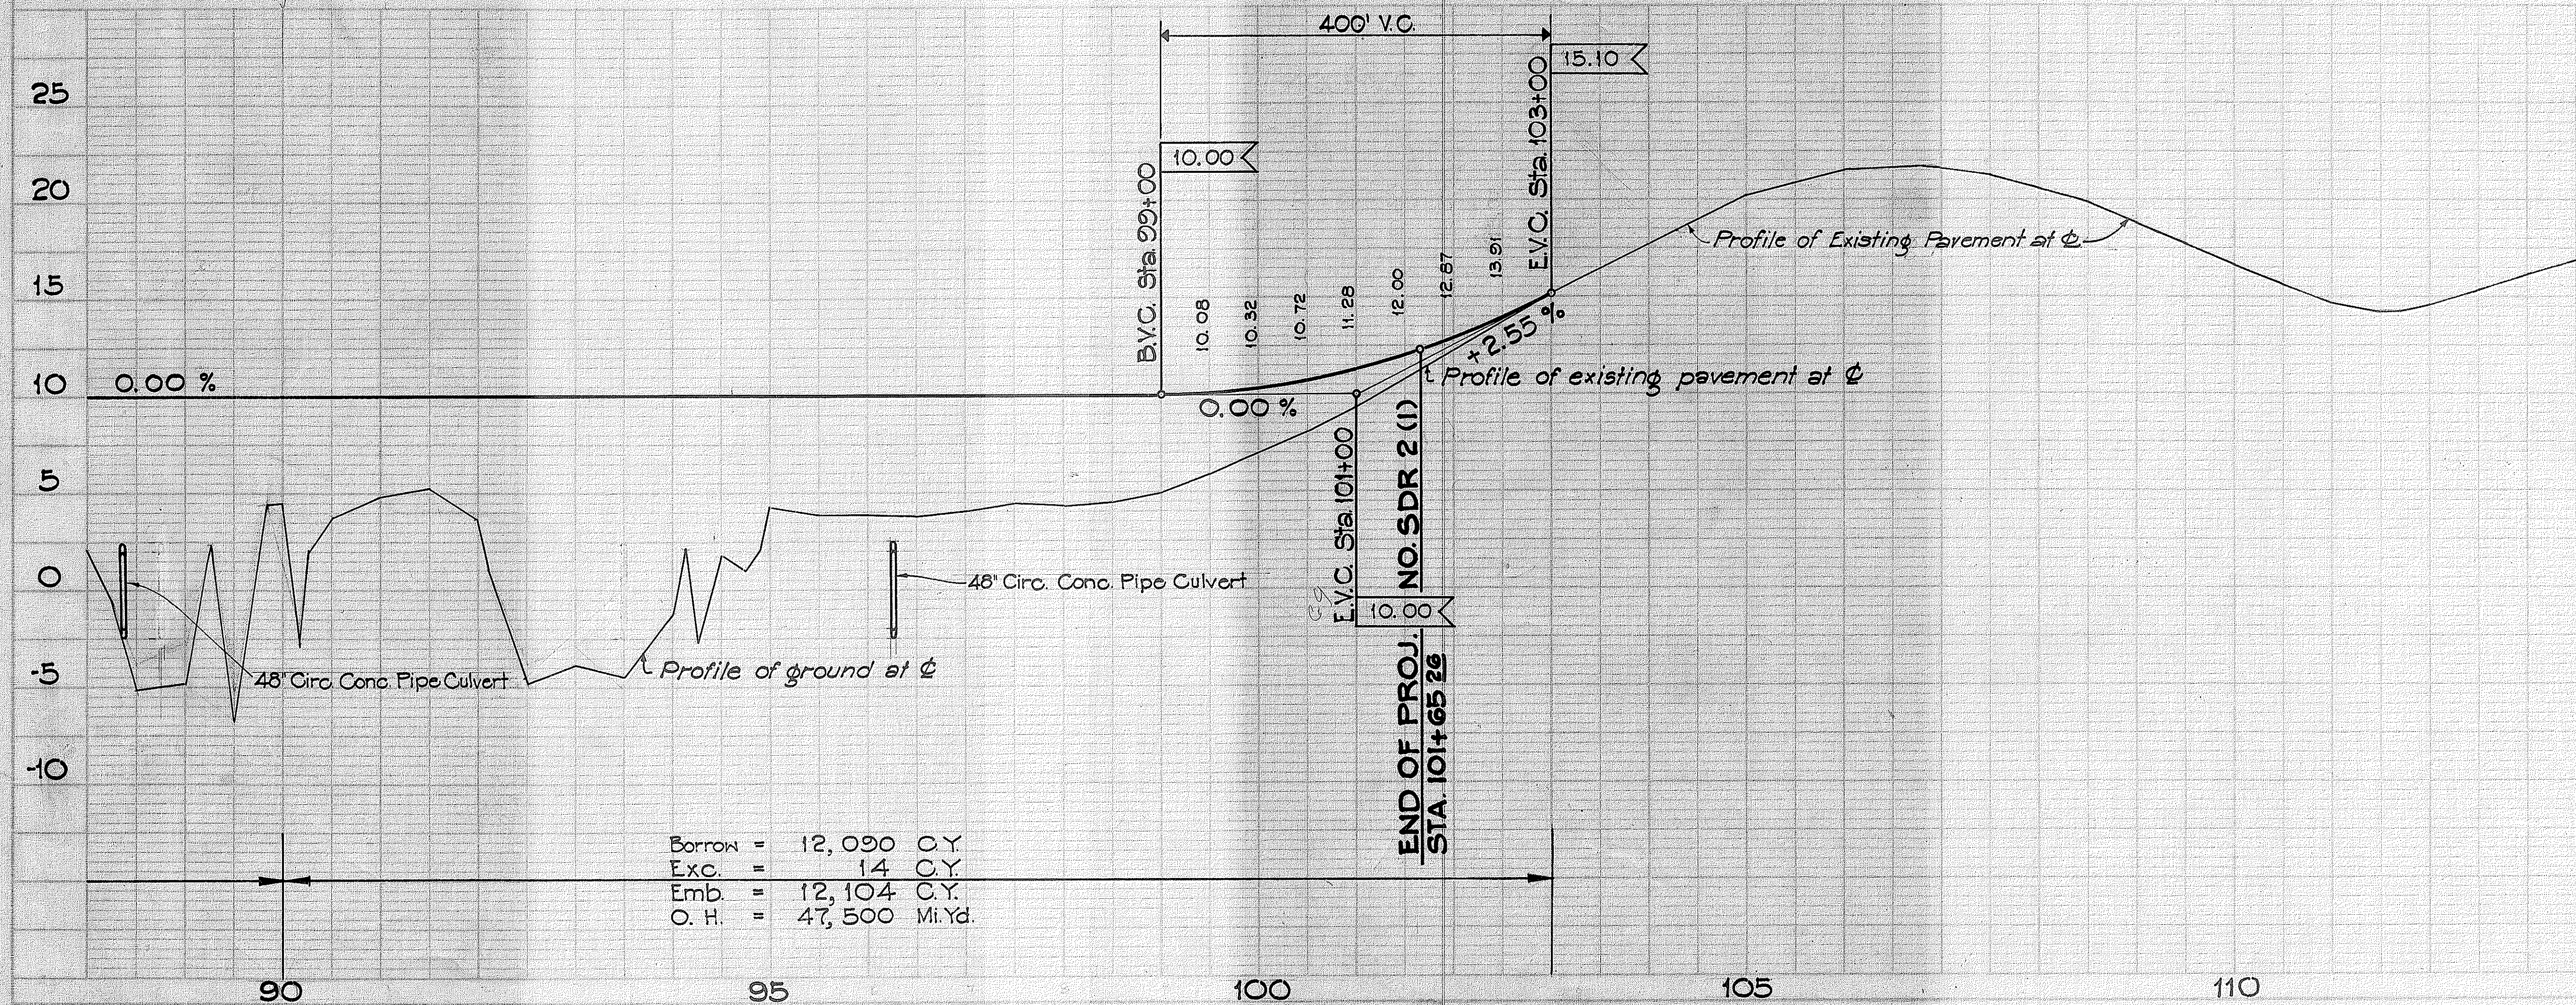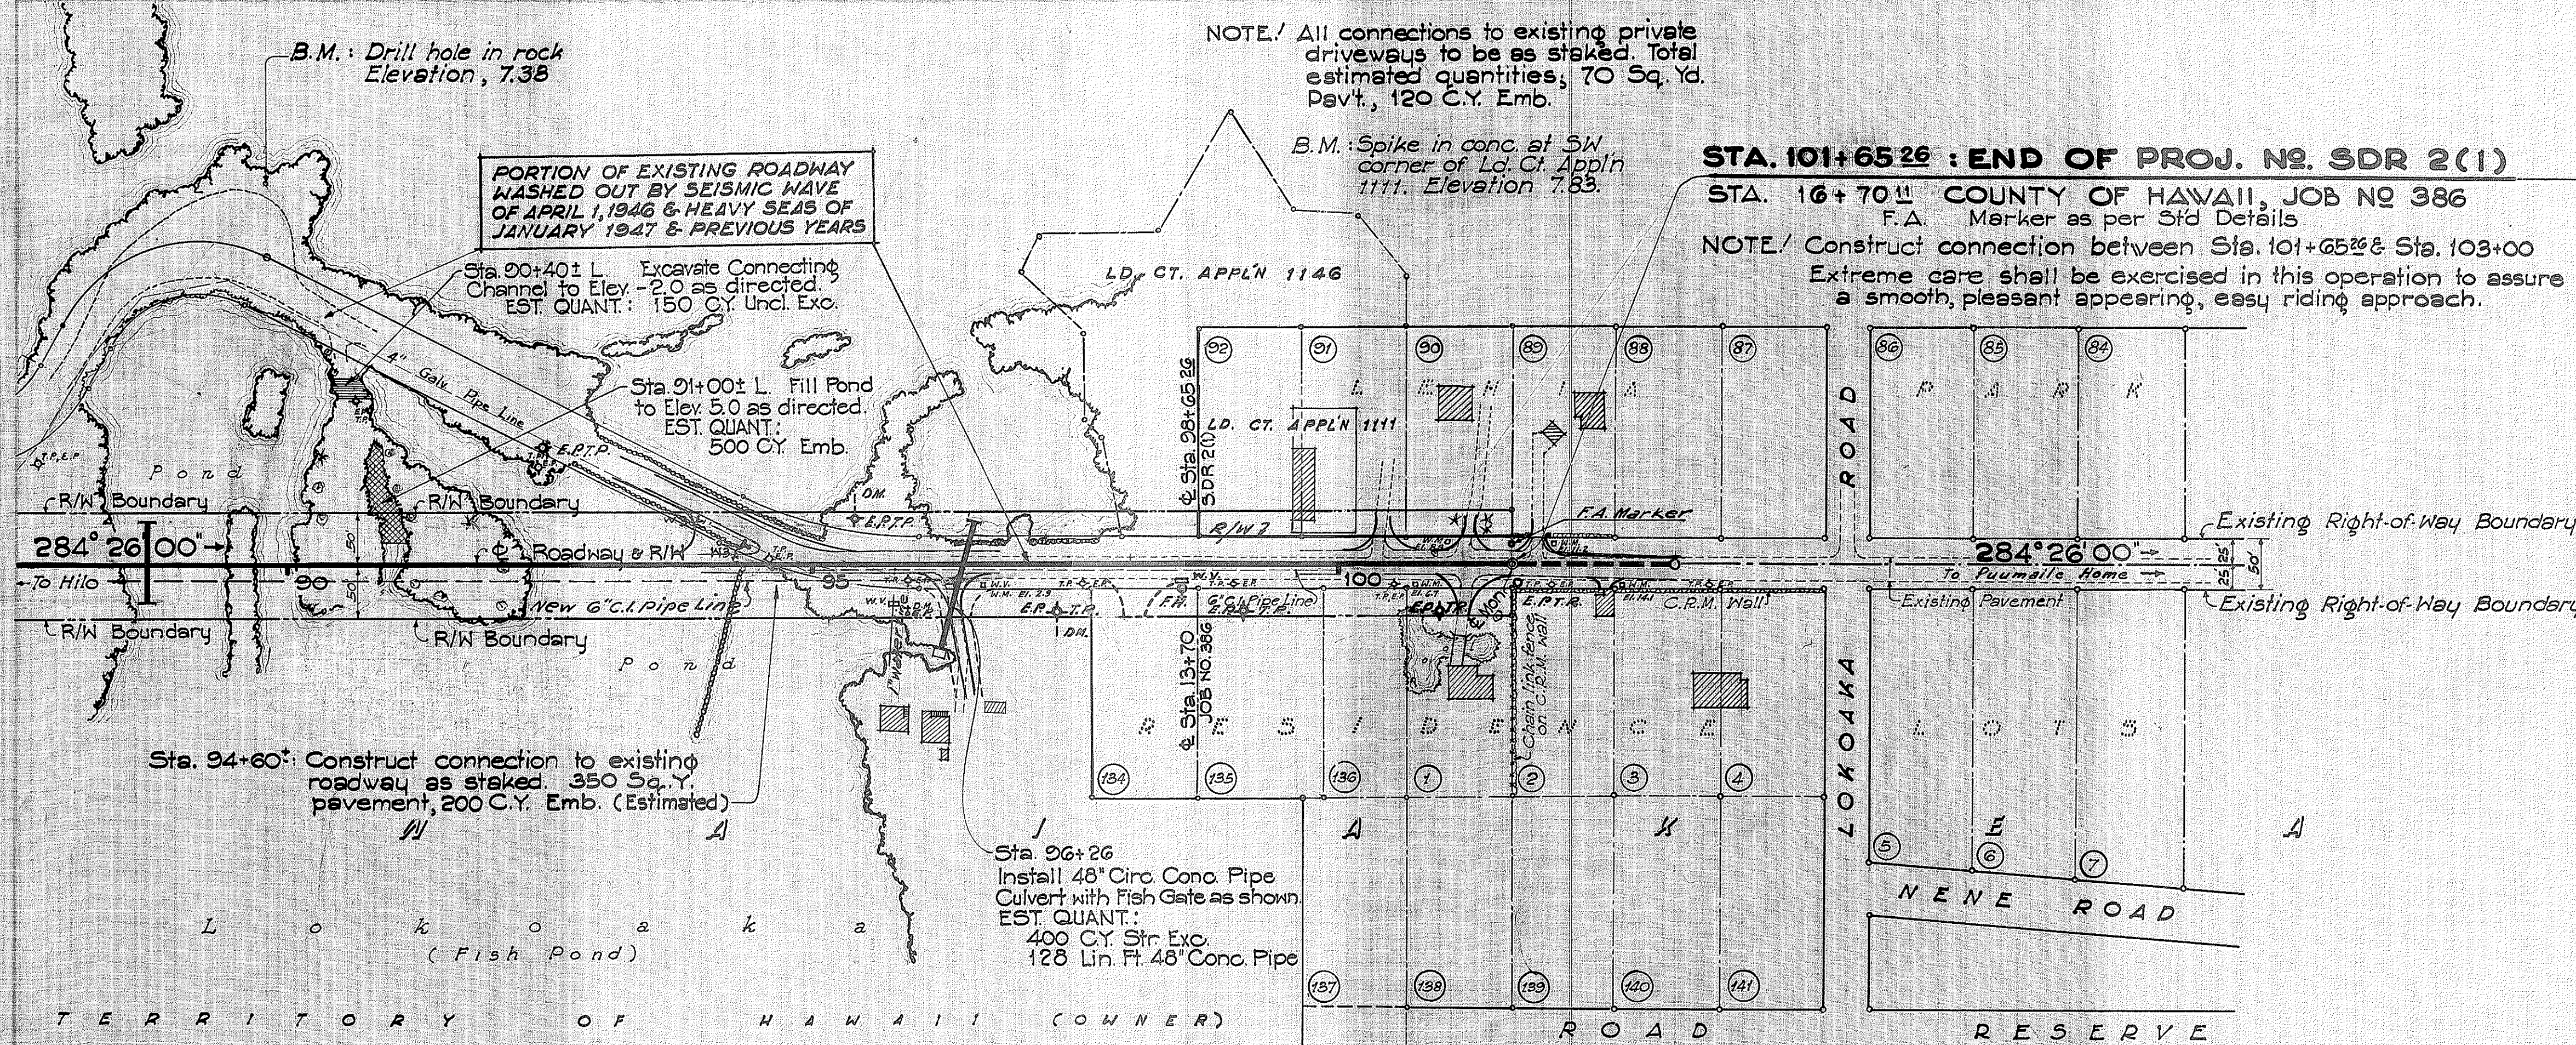

Borrow = 12,090 C.Y.
Exc. = 14 C.Y.
Emb. = 12,104 C.Y.
O. H. = 47,500 Mi. Yd.

END OF PROJ.
STA. 101+65 26

PLATE 1 - PLAN PROFILE, C.T. R.L. & C. STUBBINS

5275.4