

N:\DOT\HWY\RT19G\19g-54.dwg Tue Jun 15 10:33:36 1999 P. Asanji

ORIGINAL PLAN	SURVEY PLOTTED BY _____	DATE _____
	DRAWN BY _____	" " " "
	DESIGNED BY _____	" " " "
	QUANTITIES BY _____	" " " "
NOTE BOOK No. _____		

CENTERLINE AND REFERENCE SURVEY MONUMENT SCHEDULE				
STATION	MONUMENT TYPE	ADJUST AND/OR RECONSTRUCT EXIST. ITEM NO. 613.0110	CENTERLINE OFFSET * (FT.)	EXIST. DEPTH (FT.)
128+42.4	P.C. Mon.	X	0.00	
131+19.66	P.I. Mon.	X	6.6 Rt.	
133+97.40	P.T. Mon.	X		
160+08.68	P.C. Mon.	X		
172+02.85	P.T. Mon.	X		
235+96.33	P.C. Mon.	X		
EQ. 249+62.16 =249+65.43	P.T. Mon.	X		
269+24.32	P.C. Mon.	X		
278+64.32	P.T. Mon.	X		
333+92.57	Mon.	X	1.8 Lt.	
340+08.16	C.S. Mon.	X	1.59 Lt.	
341+76	Mon.	X	0.43 Lt.	
344+93.25	Mon.	X	1.37 Lt.	
346+60.28	S.C. Mon.	X	1.67 Lt.	
349+37.16	C.S. Mon.	X	1.71 Lt.	
351+03.85	Mon.	X	1.28 Lt.	
EQ. 357+24.57 =0+00	Mon.	X	1.53 Lt.	
5+58.72	P.C. Mon.	X	1.75 Lt.	
9+14.55	P.T. Mon.	X	2.01 Lt.	

* Right and Left Stations Are Determined When Facing in the Up Station Direction


UTILITY SCHEDULE				
STATION	OFFSET FROM CENTERLINE		TYPE	REMARKS
	LEFT	RIGHT		
3+00		16.0	WV	
3+03		18.0	WV	
3+06		16.0	WV	

LEGEND:

SMH - Sewer Manhole
WM - Water Meter
WV - Water Valve

MILEPOST AND ROUTE MARKER SCHEDULE					
STATION	LEFT	RIGHT	ROUTE MARKER SIGN NO. (ROUTE NO.)	REMOVE	INSTALL TYPE A ASSEMBLY
124+34		●	M1-6 (19)	X	X
124+44	●		M1-6 (19)	X	X
197+82	●		M1-6 (19)	X	X
197+82		●	M1-6 (19)	X	X
289+34	●		M1-6 (19)	X	X
289+34		●	M1-6 (19)	X	X
0+30	●		M1-6 (19)	X	X
0+35		●	M1-6 (19)	X	X
TOTALS				8	8
STATION	LEFT	RIGHT	MILE POST D10-4 (MILE) W/D10-7 (ROUTE NO.)	REMOVE	INSTALL WITH POST (BI-DIRECTIONAL)
157+22	●		D10-2(40)w/D10-7(19)	X	X
210+00	●		D10-2(39)w/D10-7(19)	X	X
262+88	●		D10-2(38)w/D10-7(19)	X	X
314+36	●		D10-2(37)w/D10-7(19)	X	X
10+96	●		D10-2(36)w/D10-7(19)	X	X
TOTALS				5	5

* Contractor Shall Submit Shop Drawings of Mile Post Sign to the Engineer for Approval Prior to Fabrication.

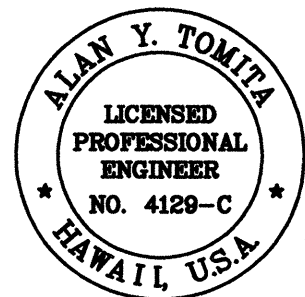

THIS WORK WAS PREPARED BY ME OR UNDER MY SUPERVISION.

Alan Y. Tomita

FED. ROAD DIST. NO.	STATE	PROJ. NO.	FISCAL YEAR	SHEET NO.	TOTAL SHEETS
HAWAII	HAW.	19G-01-99M	1999	54	55

6/3/99	Revised Description for Item No. 613.0110, Deleted Column for Reconstruct Exist. Item No. 613.0120.
Date	Revision

STATE OF HAWAII DEPARTMENT OF TRANSPORTATION HIGHWAYS DIVISION	
MISCELLANEOUS SCHEDULES	
HAWAII BELT ROAD RESURFACING Vicinity of Kahawailili Bridge to East Paauilo Bridge Project No. 19G-01-99M	
Scale: As Shown	Date: June, 1999
SHEET No. 1 OF 1 SHEETS	