

SIGN SCHEDULES


FED. ROAD DIST. NO.	STATE	PROJ. NO.	FISCAL YEAR	SHEET NO.	TOTAL SHEETS
HAWAII	HAW.	19G-01-99M	1999	50	55

STATION	LEFT	RIGHT	TYPE	SIGN TO REMAIN	REMOVE	INSTALL (10 SQ. FT. OF LESS)		INSTALL (GREATER THAN 10 SQ. FT.)		DESTINATION SIGN PANEL (S.F.)
						W/POST	WO/POST	W/POST	WO/POST	
101+80		●	R1-1	X						
102+40		●	W8-6	X						
103+80		●	W2-1	X						
108+70	●		R1-1		X	X				
108+80		●	R1-1		X	X				
110+00	●	●	ELEVATION SIGN	X						
111+00			R4-2		X	X				
113+30	●		W2-1		X	X				
145+00		●	W2-1			X				
141+66		●	W2-1		X					
149+14	●		R1-1		X	X				
149+30		●	R1-1		X	X				
153+90	●		W2-1			X				
155+80		●	W2-1		X	X				
156+30	●		W2-1		X					
157+24	●	●	ADOPT A HIGHWAY SIGN		X (2)			X (2)		
157+24	●		"BAHAI'S OF HAMAKUA" SIGN		X		X			
157+24		●	"HONOKAA METHODIST" SIGN		X		X			
168+00		●	R1-1		X	X				
168+20	●		R1-1		X	X				
173+50	●		W2-1			X				
183+36		●	DESTINATION SIGN		X					28
183+36		●	HERITAGE PARK SIGN	X		Remove & Reinstall				
188+00		●	R1-1		X	X				
188+90		●	W2-1 W2-2L		X	X				
189+80	●	●	HERITAGE PARK SIGN	X						
188+90										
191+80	●		DESTINATION SIGN		X					28
192+66	●		R1-1		X	X				
193+56		●	R1-1		X	✕				
195+76		●	W15-3		X	X				
198+70	●		W2-1 W2-2R			X				
200+42	●		W2-1 W2-2R		X	✕				
207+14	●		W15-3		X	X				
216+00		●	W2-1			X				
220+16	●		R1-1		X	X				
220+76		●	R1-1		X	X				

EQ. 249+62.16
=249+65.43

STATION	LEFT	RIGHT	TYPE	SIGN TO REMAIN	REMOVE	INSTALL (10 SQ. FT. OF LESS)		INSTALL (GREATER THAN 10 SQ. FT.)		DESTINATION SIGN PANEL (S.F.)
						W/POST	WO/POST	W/POST	WO/POST	
227+26	●		W2-1			X				
225+00		●	W2-2L			X				
259+60		●	² WE -2L			X				
262+92	●		ADOPT A HIGHWAY SIGN		X			X		
262+92	●		"HONOKAA METHODIST" SIGN		X		X			
264+04	●		R1-1		X	X				
264+50		●	ADOPT A HIGHWAY SIGN		X			X		
264+50		●	"HAMAKUA LIONS CLUB" SIGN		X		X			
268+80	●		^R W2-2 E			X				
300+30	●		"PREVENT WILD FIRES" SIGN	X						
304+86		●	W2-1		X					
306+90		●	W2-1			X				
310+84	●		R1-1		X	X				
312+24		●	R1-1		X	X				
312+80		●	"PAAUILO SOLID WASTE TSFR STN" SIGN	X						
318+00	●		W2-1		X	X				
322+00		●	W2-2L			X				
323+80		●	R2-5b		X			X		
326+10	●		R1-1		X	X				
328+02		●	W2-1		X					
330+00		●	W2-1			X				
331+00	●		^R W2-2 E			X				
332+20	●		R4-2		X	X				
333+04	●	●	R2-1(55) R2-1(45)		X (2)			X (2)		
334+24	●		R1-1		X	X				
334+60		●	R1-1		X	X				
337+60	●		W2-1			X				
339+46	●		W2-1		X					
342+80		●	DESTINATION SIGN		X					32

ORIGINAL PLAN	SURVEY PLOTTED BY	DATE
NO. _____	DRAWN BY	_____
	TRACED BY	_____
	QUANTITIES BY	_____
	CHECKED BY	_____

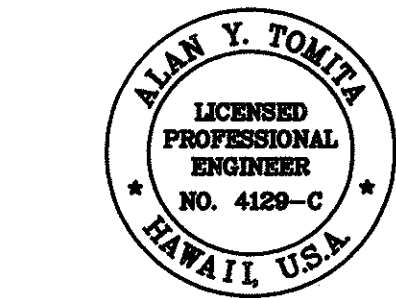

THIS WORK WAS PREPARED BY ME OR UNDER MY SUPERVISION.

Alan Y. Tomita


STATE OF HAWAII DEPARTMENT OF TRANSPORTATION HIGHWAYS DIVISION	
SIGN SCHEDULE	
HAWAII BELT ROAD RESURFACING Vicinity of Kahawailili Bridge to East Paauilo Bridge Project No. 19G-01-99M	
Scale: None	Date: May, 1999
SHEET No. 1 OF 2 SHEETS	

"AS-BUILT"

[illegible]

EQ. $\frac{357+24.57}{=0+00}$

ORIGINAL PLAN	SURVEY PLOTTED BY _____ DATE _____
	DRAWN BY _____
	TRACED BY _____
	DESIGNED BY _____
NOTE BOOK	QUANTITIES BY _____
	CHECKED BY _____
No. _____	

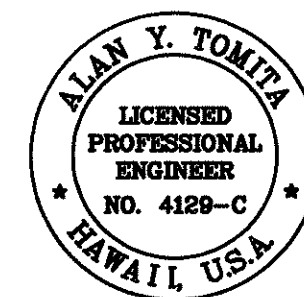

THIS WORK WAS PREPARED BY ME
OR UNDER MY SUPERVISION.

Alan y Emma

STATE OF HAWAII
DEPARTMENT OF TRANSPORTATION
HIGHWAYS DIVISION

SIGN SCHEDULE

HAWAII BELT ROAD RESURFACING
Vicinity of Kahawailiili Bridge to East Paauilo Bridge
Project No. 19G-01-99M

Scale: None Date: May, 1999

SHEET No. 2 OF 2 SHEETS

"AS-BUILT"