

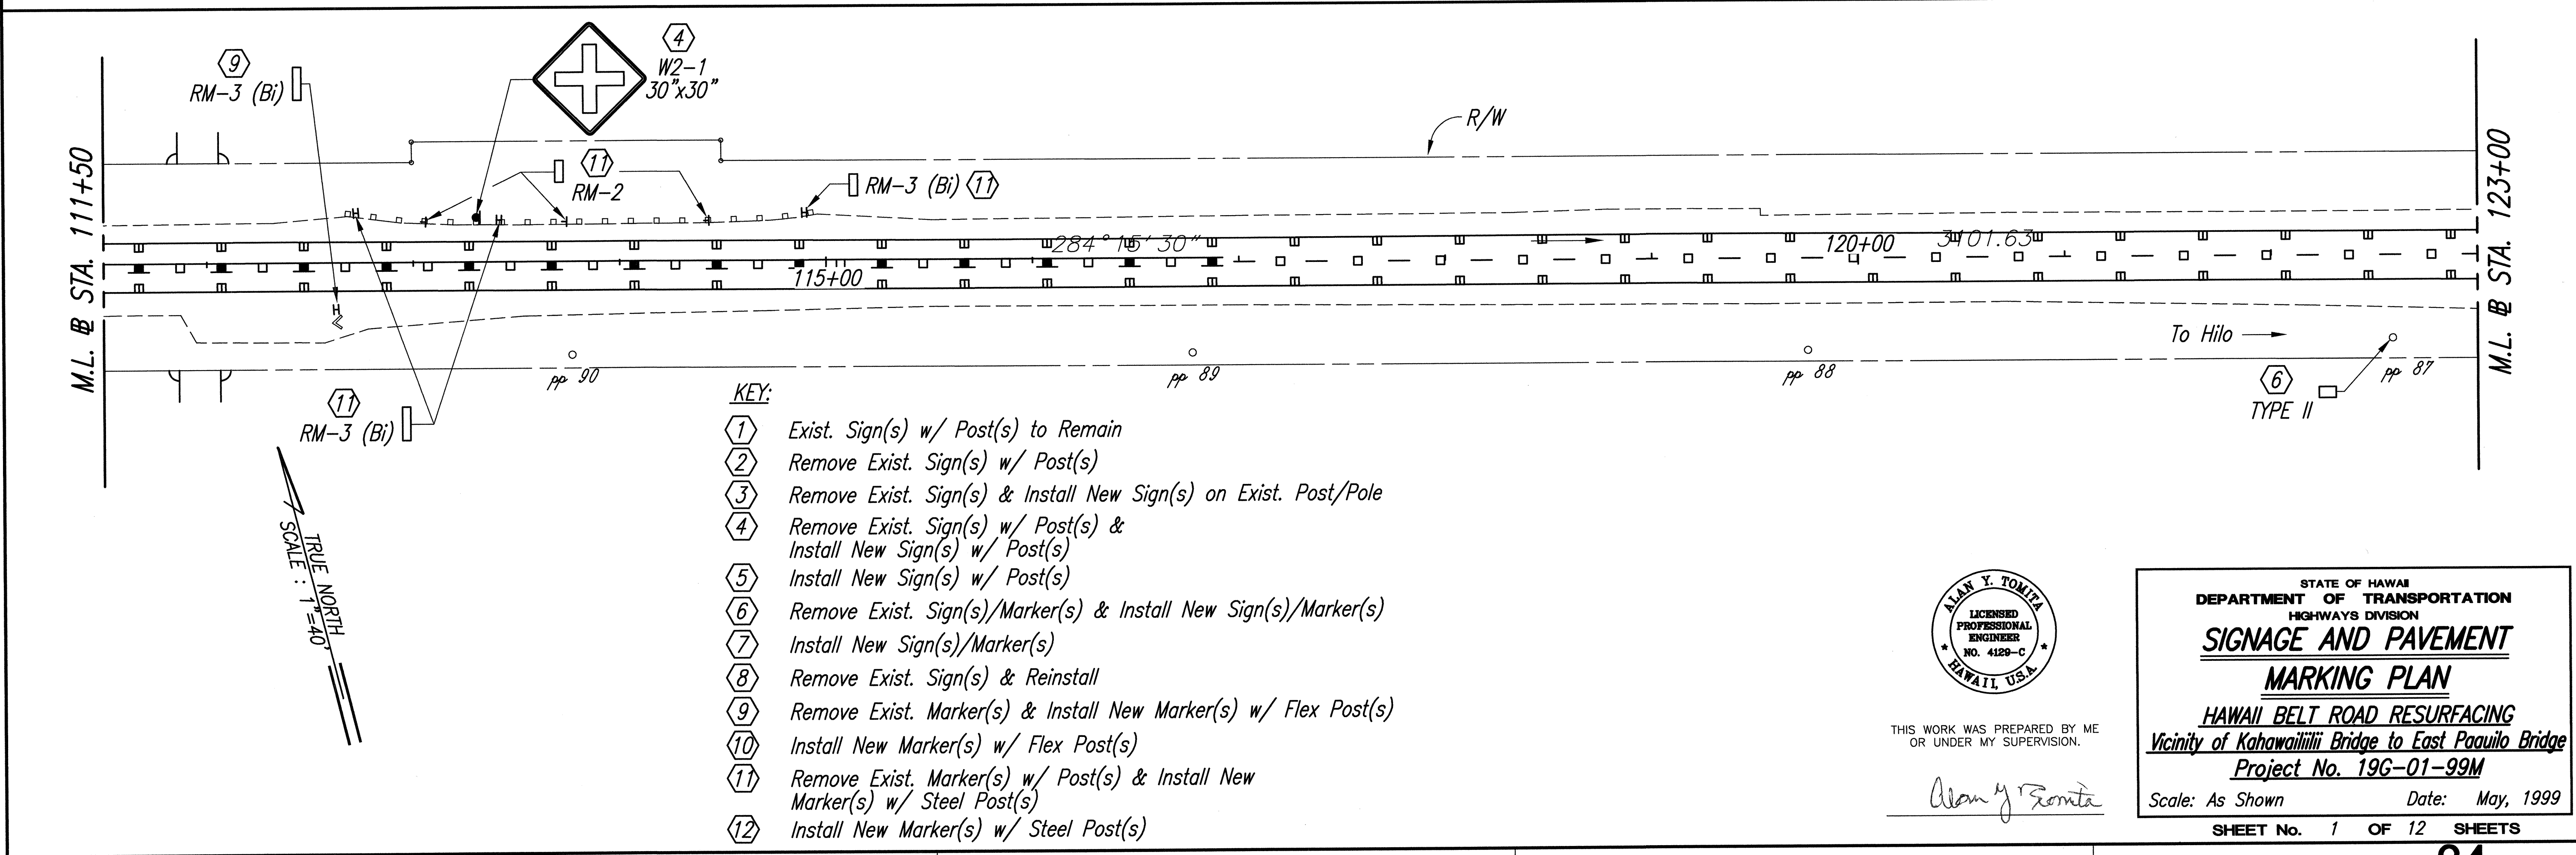


FED. ROAD DIST. NO.	STATE	PROJ. NO.	FISCAL YEAR	SHEET NO.	TOTAL SHEETS
HAWAII	HAW.	19G-01-99M	1999	34	55

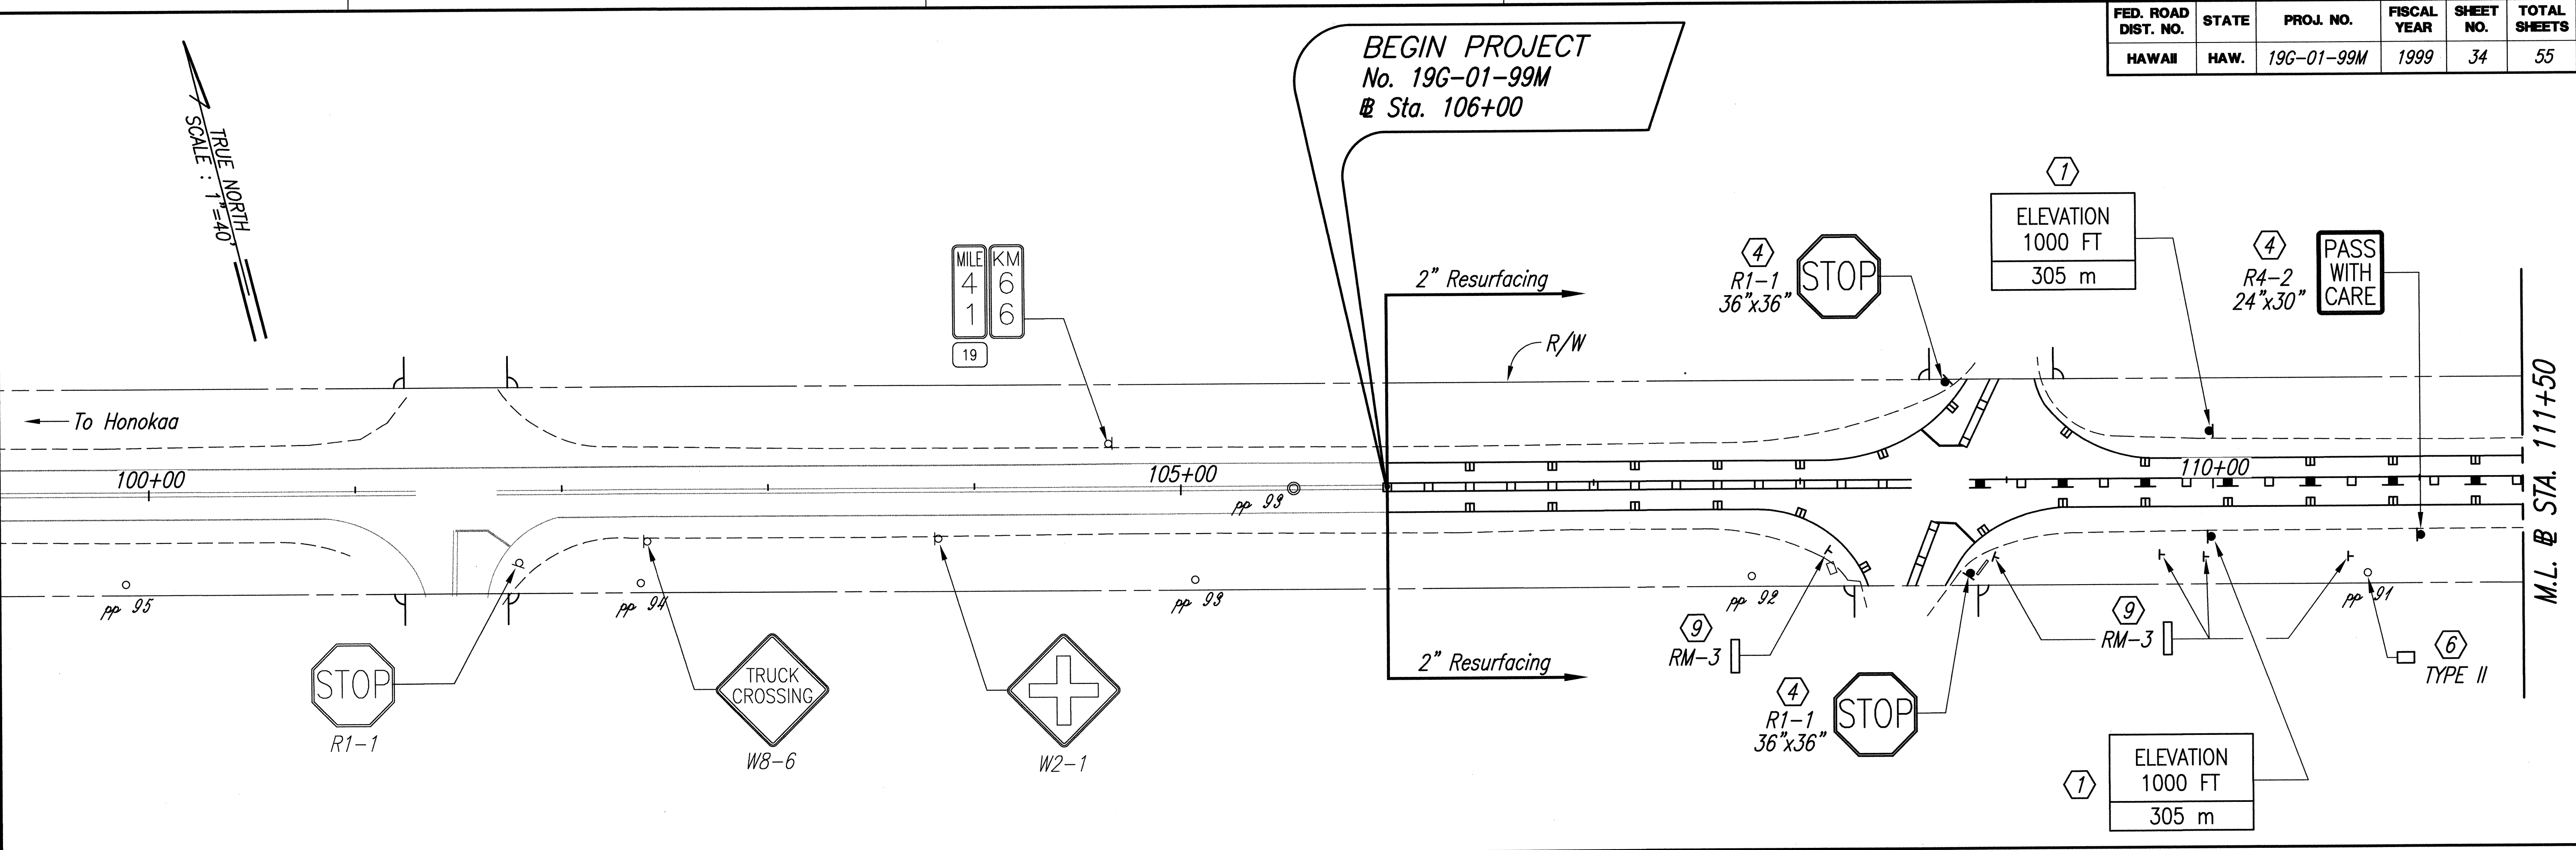

ORIGINAL PLAN	SURVEY PLOTTED BY	DATE
NOTE BOOK	DRAWN BY	
	DESIGNED BY	
	CHECKED BY	
	APPROVED BY	

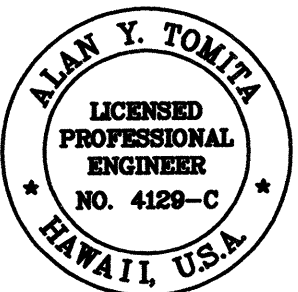



THIS WORK WAS PREPARED BY ME
OR UNDER MY SUPERVISION.

Alan Y. Tomita

STATE OF HAWAII
DEPARTMENT OF TRANSPORTATION
HIGHWAYS DIVISION
SIGNAGE AND PAVEMENT
MARKING PLAN
HAWAII BELT ROAD RESURFACING
Vicinity of Kahawaiilili Bridge to East Paauilo Bridge
Project No. 19G-01-99M
Scale: As Shown Date: May, 1999
SHEET No. 1 OF 12 SHEETS

34

FED. ROAD DIST. NO.	STATE	PROJ. NO.	FISCAL YEAR	SHEET NO.	TOTAL SHEETS
HAWAII	HAW.	19G-01-99M	1999	35	55

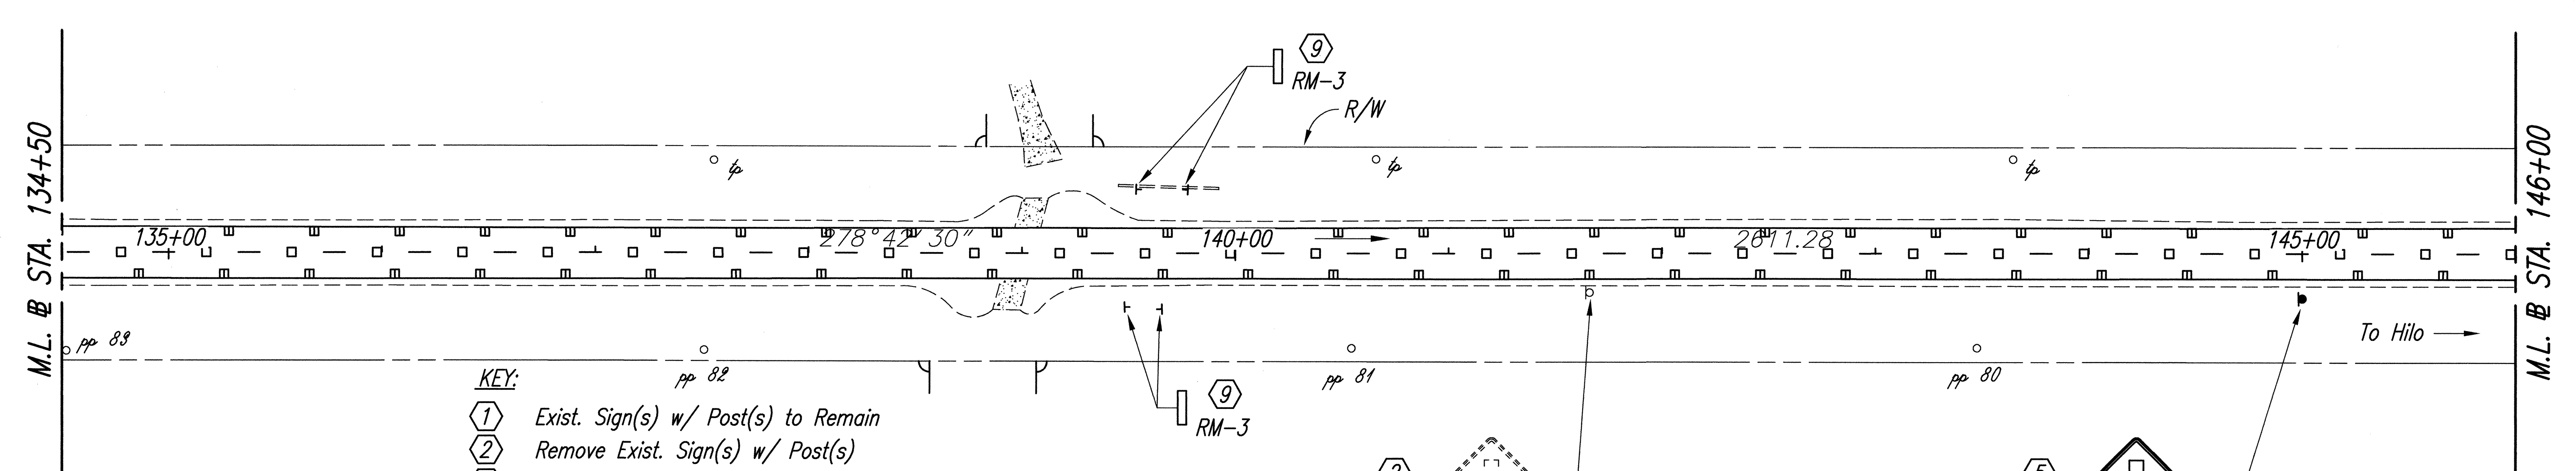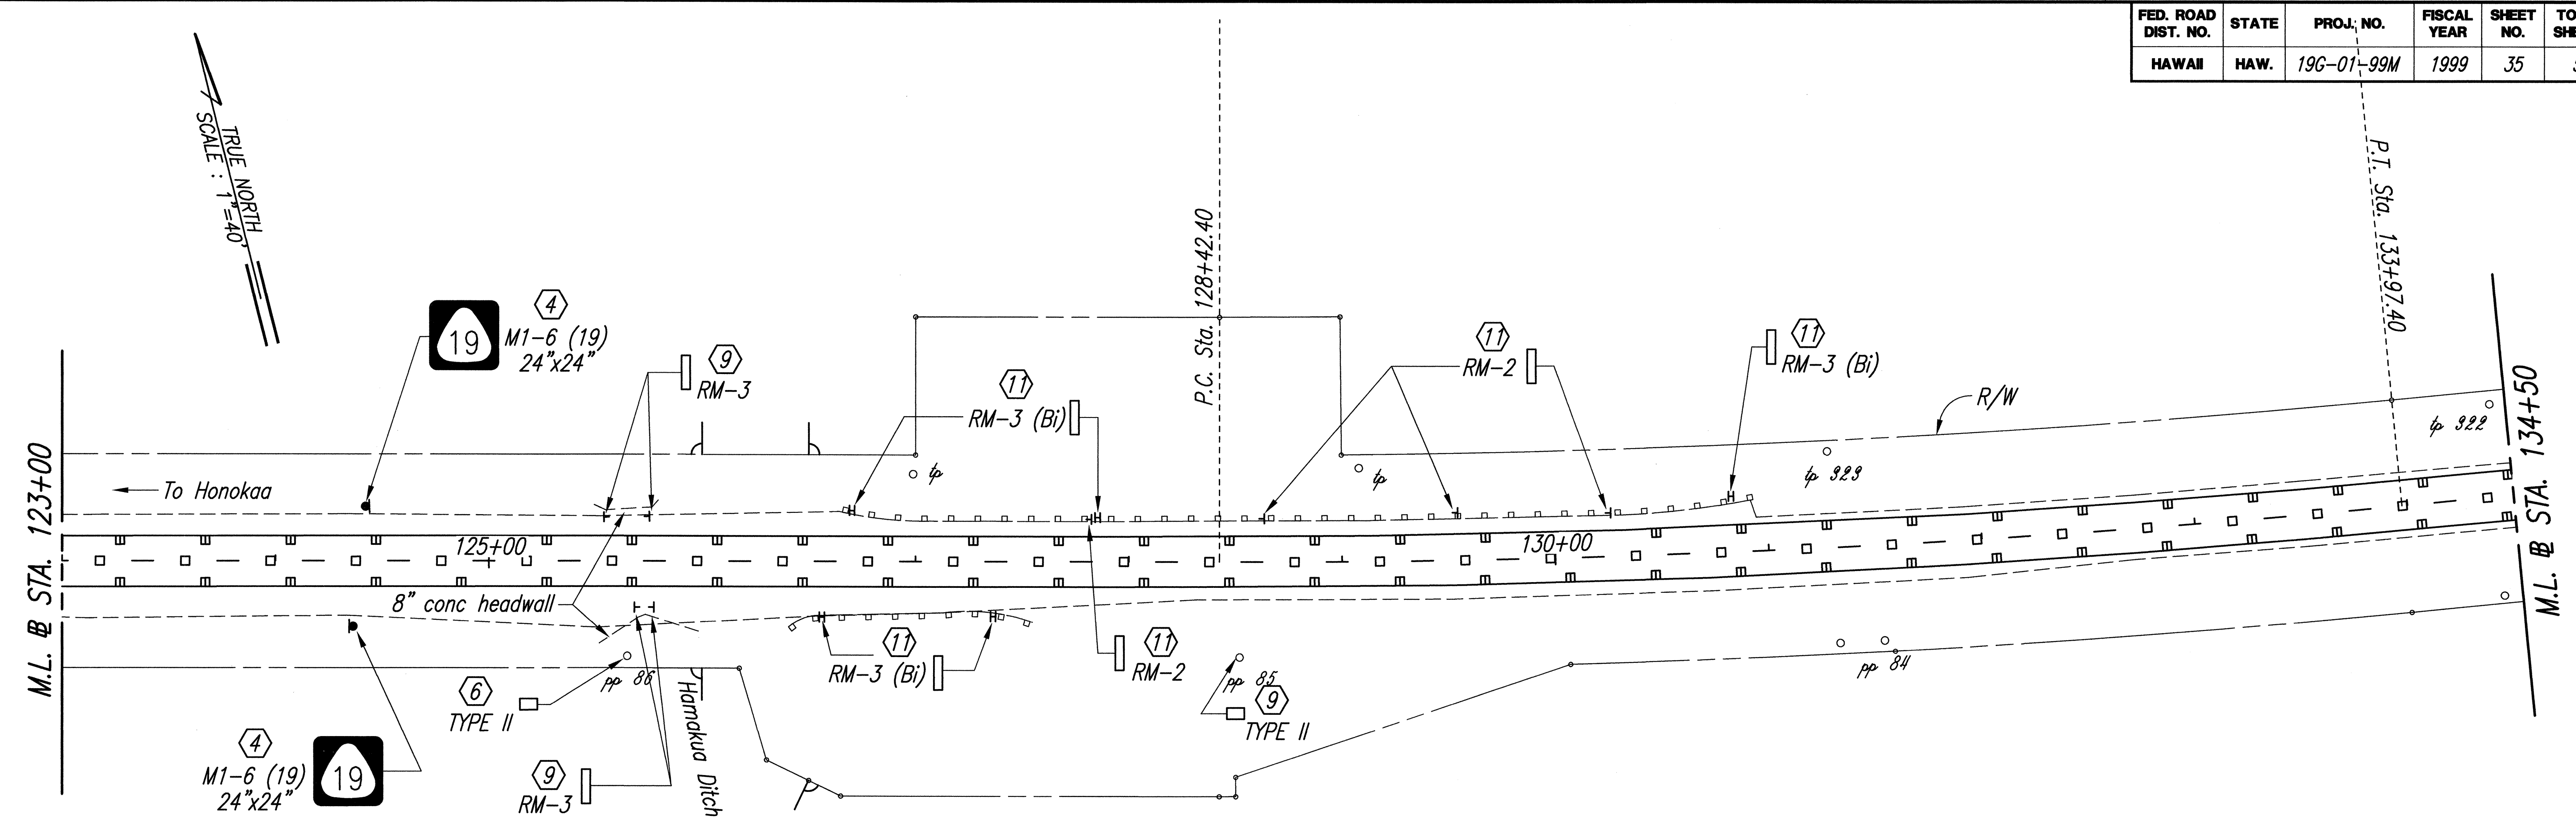

- KEY:**
- 1 Exist. Sign(s) w/ Post(s) to Remain
 - 2 Remove Exist. Sign(s) w/ Post(s)
 - 3 Remove Exist. Sign(s) & Install New Sign(s) on Exist. Post/Pole
 - 4 Remove Exist. Sign(s) w/ Post(s) & Install New Sign(s) w/ Post(s)
 - 5 Install New Sign(s) w/ Post(s)
 - 6 Remove Exist. Sign(s)/Marker(s) & Install New Sign(s)/Marker(s)
 - 7 Install New Sign(s)/Marker(s)
 - 8 Remove Exist. Sign(s) & Reinstall
 - 9 Remove Exist. Marker(s) & Install New Marker(s) w/ Flex Post(s)
 - 10 Install New Marker(s) w/ Flex Post(s)
 - 11 Remove Exist. Marker(s) w/ Post(s) & Install New Marker(s) w/ Steel Post(s)
 - 12 Install New Marker(s) w/ Steel Post(s)

ORIGINAL PLAN	SURVEY PLOTTED BY	DATE
DRAWN BY		
DESIGNED BY		
CHECKED BY		
NO.		

THIS WORK WAS PREPARED BY ME OR UNDER MY SUPERVISION.

Alan Y. Tomita

STATE OF HAWAII
DEPARTMENT OF TRANSPORTATION
HIGHWAYS DIVISION

SIGNAGE AND PAVEMENT



MARKING PLAN

HAWAII BELT ROAD RESURFACING
Vicinity of Kahawaiiliili Bridge to East Paauilo Bridge
Project No. 19G-01-99M

Scale: As Shown Date: May, 1999



SHEET No. 2 OF 12 SHEETS

FED. ROAD DIST. NO.	STATE	PROJ. NO.	FISCAL YEAR	SHEET NO.	TOTAL SHEETS
HAWAII	HAW.	19G-01-99M	1999	36	55

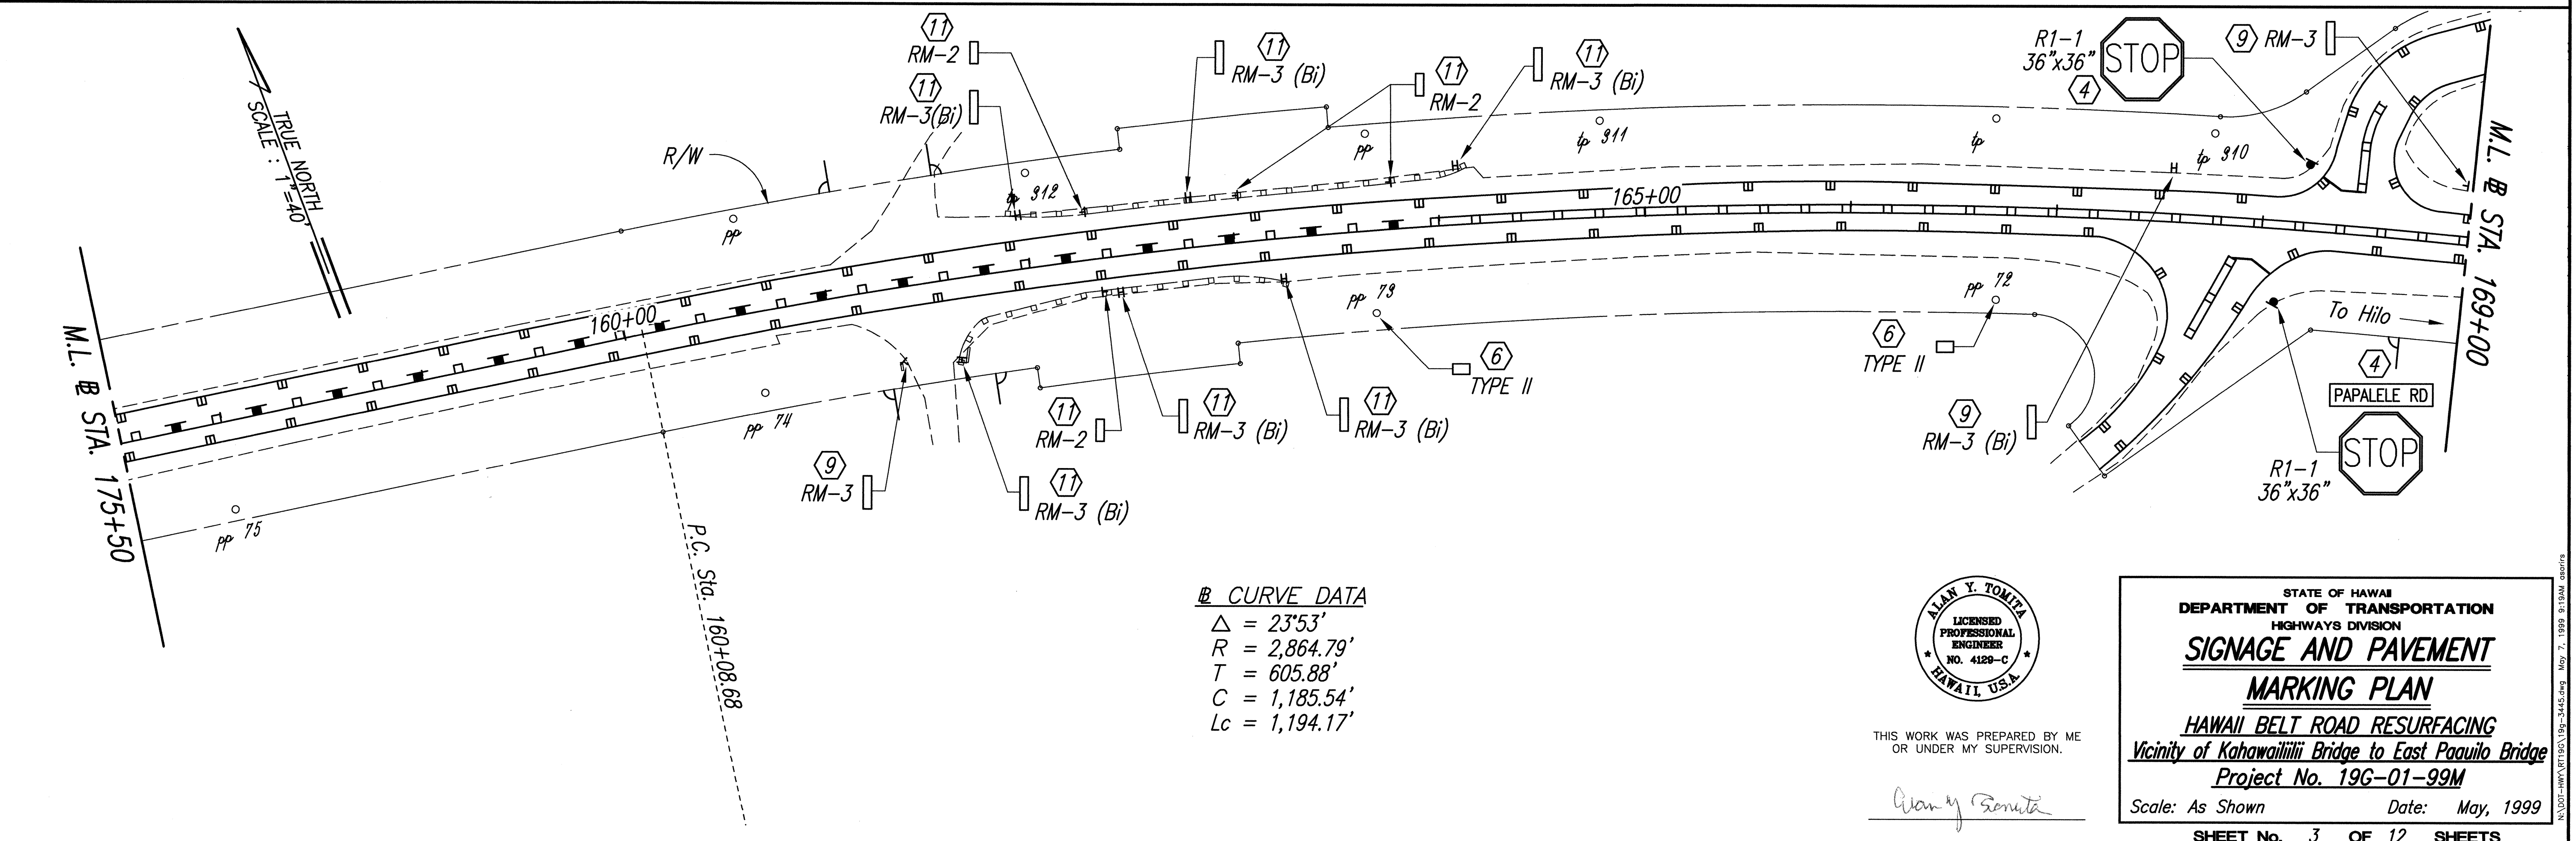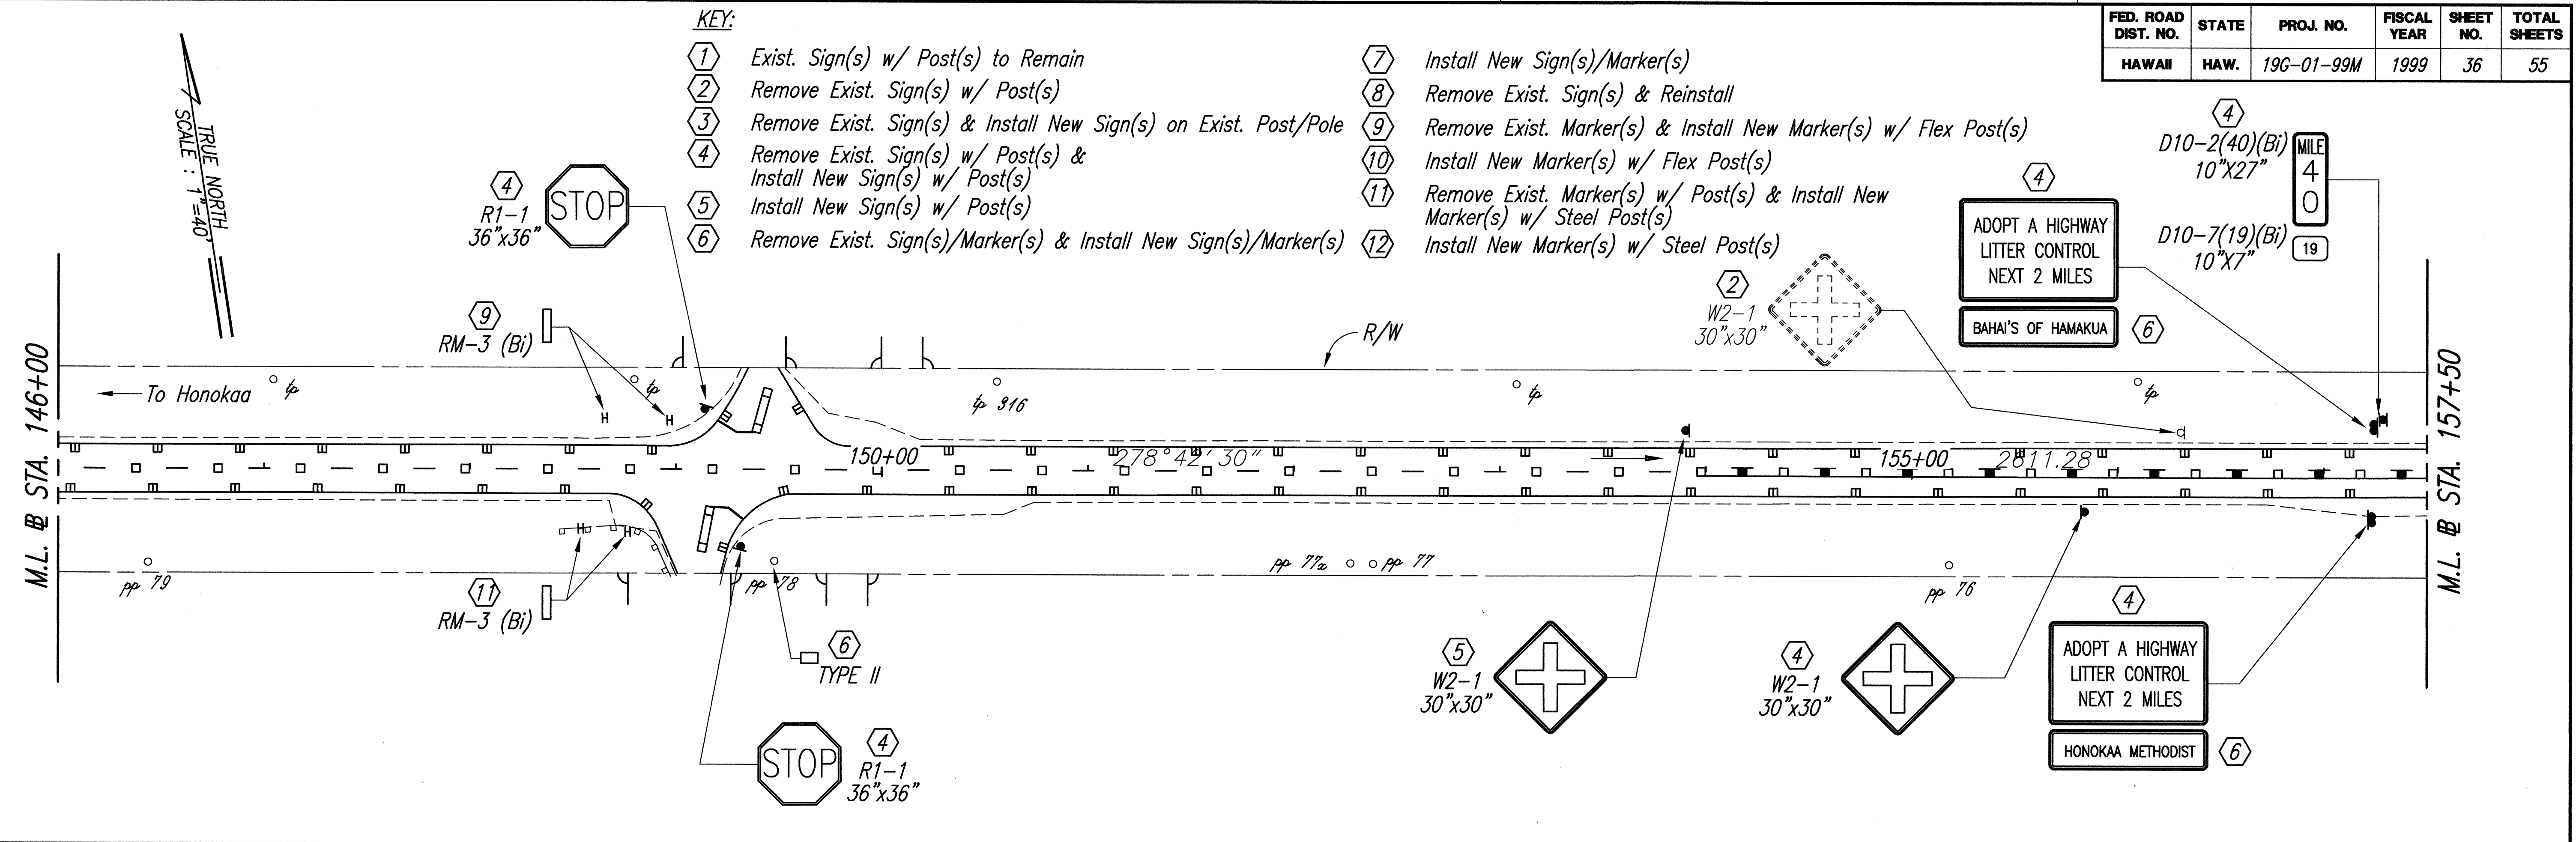


ORIGINAL PLAN	DATE
DRAWN BY	
TRACED BY	
QUANTITIES BY	
CHECKED BY	
No.	

FED. ROAD DIST. NO.	STATE	PROJ. NO.	FISCAL YEAR	SHEET NO.	TOTAL SHEETS
HAWAII	HAW.	19G-01-99M	1999	39	55

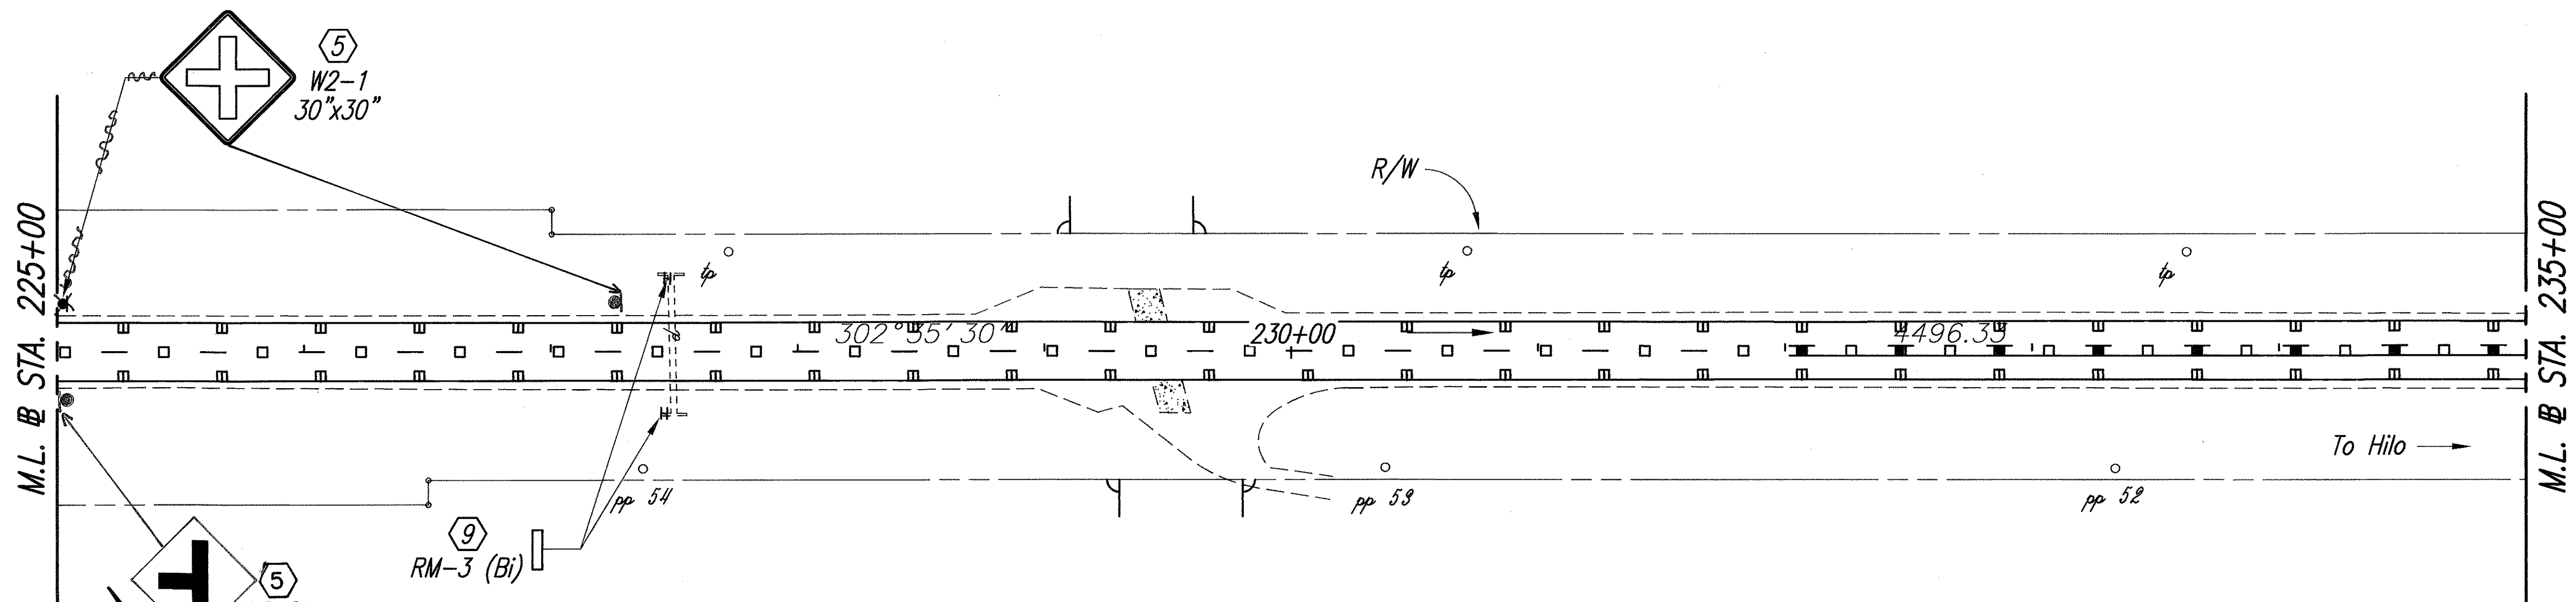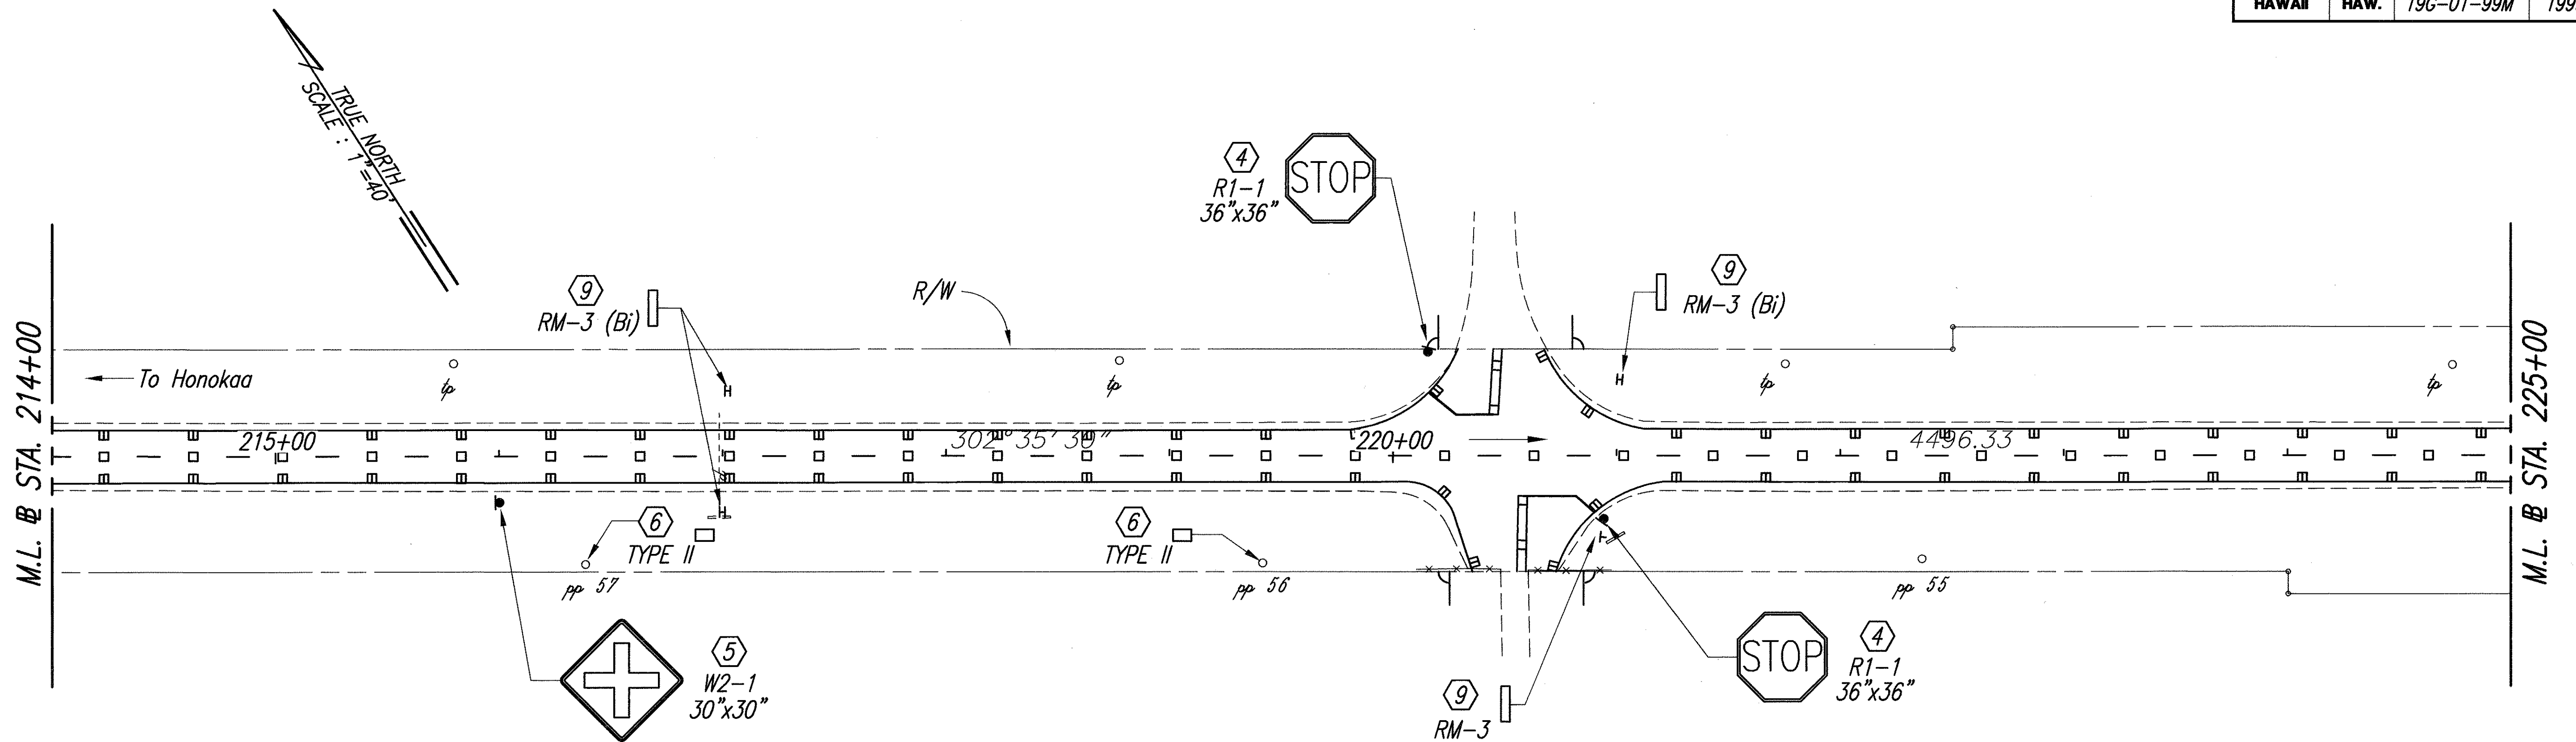

KEY:

- | | | | |
|---|---|----|---|
| 1 | Exist. Sign(s) w/ Post(s) to Remain | 7 | Install New Sign(s)/Marker(s) |
| 2 | Remove Exist. Sign(s) w/ Post(s) | 8 | Remove Exist. Sign(s) & Reinstall |
| 3 | Remove Exist. Sign(s) & Install New Sign(s) on Exist. Post/Pole | 9 | Remove Exist. Marker(s) & Install New Marker(s) w/ Flex Post(s) |
| 4 | Remove Exist. Sign(s) w/ Post(s) & Install New Sign(s) w/ Post(s) | 10 | Install New Marker(s) w/ Flex Post(s) |
| 5 | Install New Sign(s) w/ Post(s) | 11 | Remove Exist. Marker(s) w/ Post(s) & Install New Marker(s) w/ Steel Post(s) |
| 6 | Remove Exist. Sign(s)/Marker(s) & Install New Sign(s)/Marker(s) | 12 | Install New Marker(s) w/ Steel Post(s) |

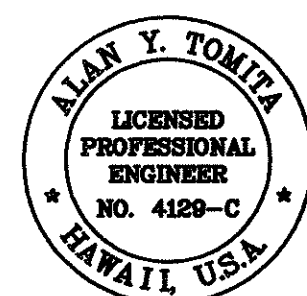

THIS WORK WAS PREPARED BY ME
OR UNDER MY SUPERVISION.

Alan Y. Tomita

STATE OF HAWAII
DEPARTMENT OF TRANSPORTATION
HIGHWAYS DIVISION
SIGNAGE AND PAVEMENT
MARKING PLAN
HAWAII BELT ROAD RESURFACING
Vicinity of Kahawailiili Bridge to East Paauilo Bridge
Project No. 19G-01-99M

Scale: As Shown Date: May, 1999

SHEET No. 6 OF 12 SHEETS

"AS-BUILT"

39

ORIGINAL PLAN	SURVEY PLOTTED BY	DATE
NOTE BOOK	DRAWN BY	
DESIGNED BY	CHECKED BY	
QUANTITIES BY		
NO.		

FED. ROAD DIST. NO.	STATE	PROJ. NO.	FISCAL YEAR	SHEET NO.	TOTAL SHEETS
HAWAII	HAW.	19G-01-99M	1999	40	55

KEY:

- 1

Exist. Sign(s) w/ Post(s) to Remain

2

Remove Exist. Sign(s) w/ Post(s)

3

Remove Exist. Sign(s) & Install New Sign(s) on Exist. Post/Pole

4

Remove Exist. Sign(s) w/ Post(s) & Install New Sign(s) w/ Post(s)

5

Install New Sign(s) w/ Post(s)

6

Remove Exist. Sign(s)/Marker(s) & Install New Sign(s)/Marker(s)
- 7

Install New Sign(s)/Marker(s)

8

Remove Exist. Sign(s) & Reinstall

9

Remove Exist. Marker(s) & Install New Marker(s) w/ Flex Post(s)

10

Install New Marker(s) w/ Flex Post(s)



11

Remove Exist. Marker(s) w/ Post(s) & Install New Marker(s) w/ Steel Post(s)


12

Install New Marker(s) w/ Steel Post(s)

Sta. 246+30±
Begin 8" White Edge Stripe w/
Type C Raised Pavement Markers
@ 40'-0" O.C.

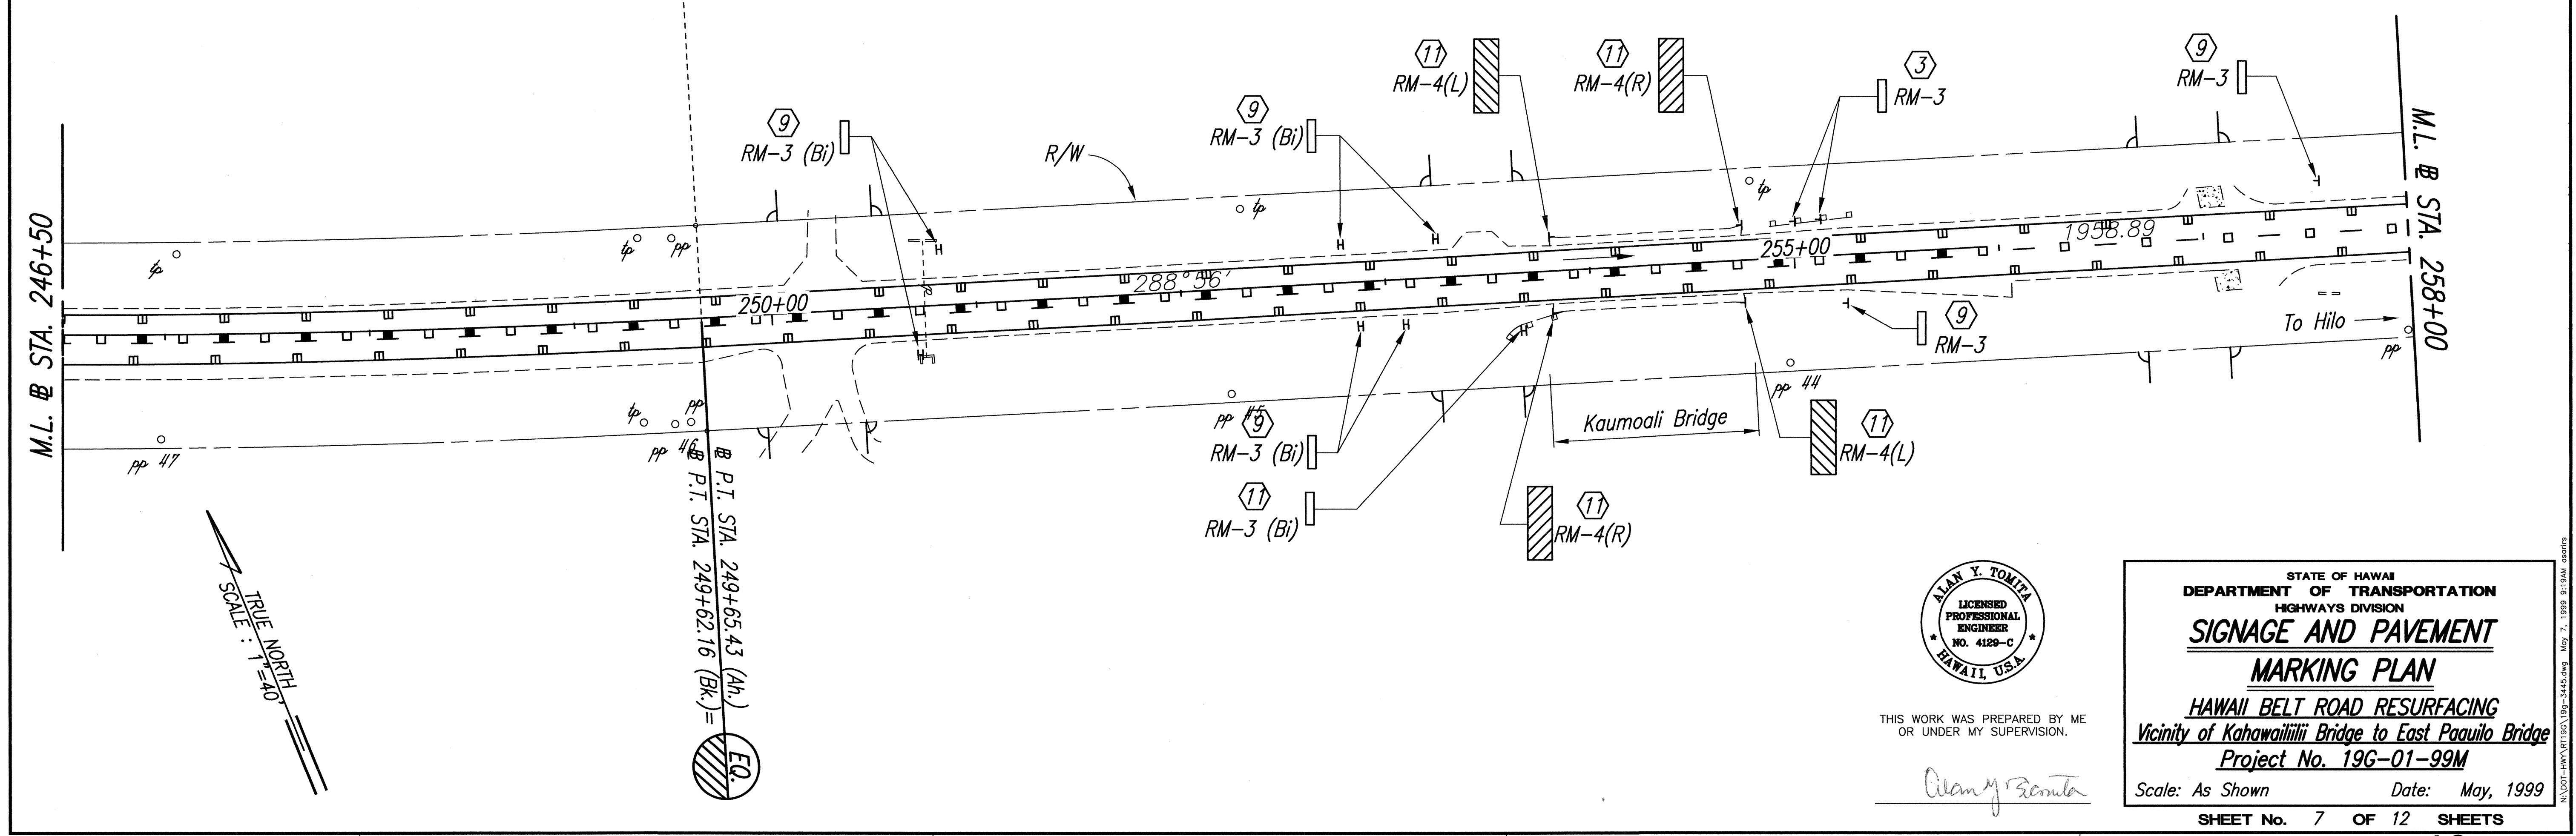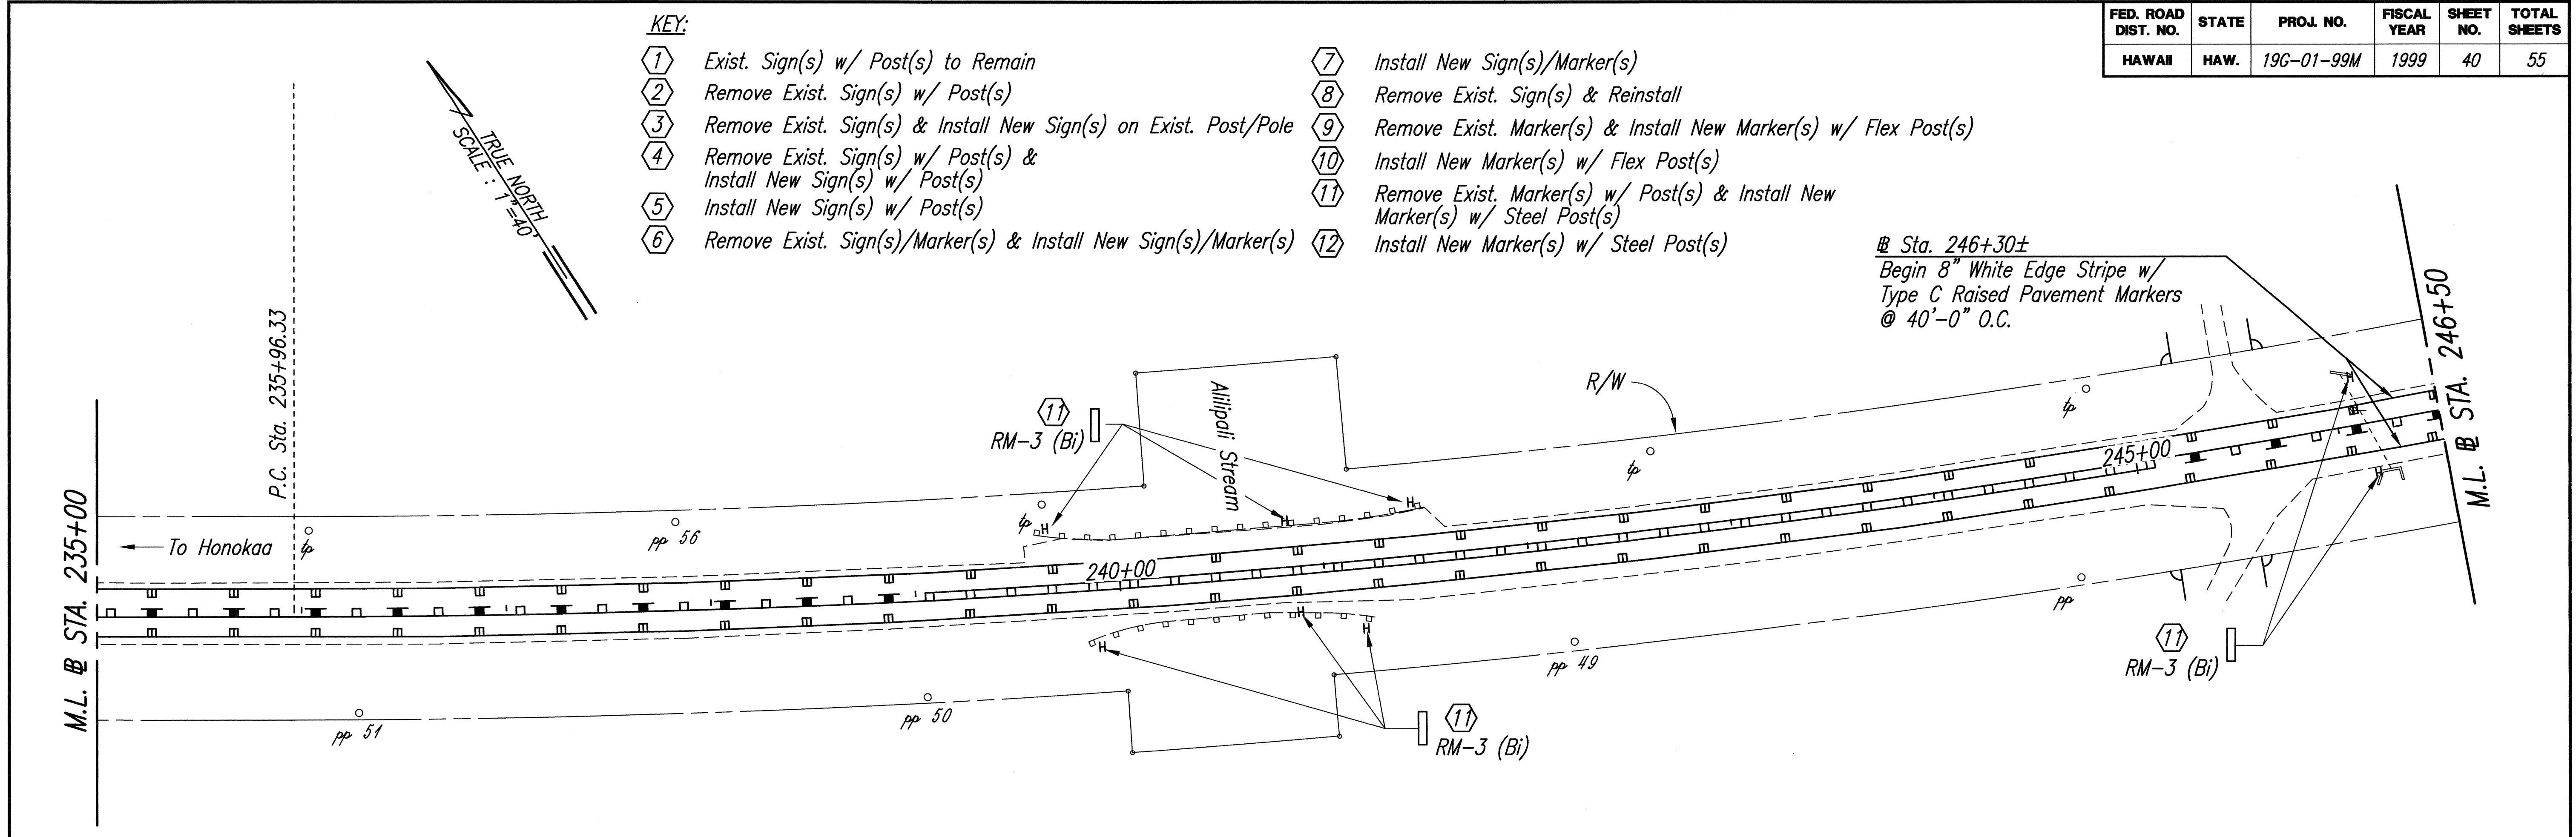

DATE	_____
SURVEY PLOTTED BY	_____
DRAWN BY	_____
DESIGNED BY	_____
CHECKED BY	_____
ORIGINAL PLAN	_____
NOTE BOOK	_____
No.	_____

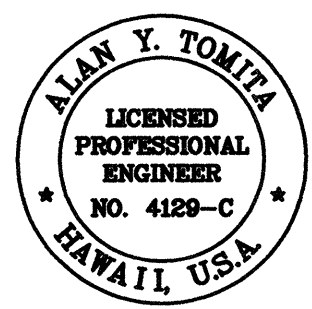

THIS WORK WAS PREPARED BY ME
OR UNDER MY SUPERVISION.

Alan Y. Tomita

STATE OF HAWAII

DEPARTMENT OF TRANSPORTATION

HIGHWAYS DIVISION

SIGNAGE AND PAVEMENT

MARKING PLAN

HAWAII BELT ROAD RESURFACING

Vicinity of Kahawailili Bridge to East Paauilo Bridge

Project No. 19G-01-99M



Scale: As Shown

Date: May, 1999


SHEET No. 7 OF 12 SHEETS

40

FED. ROAD DIST. NO.	STATE	PROJ. NO.	FISCAL YEAR	SHEET NO.	TOTAL SHEETS
HAWAII	HAW.	19G-01-99M	1999	41	55

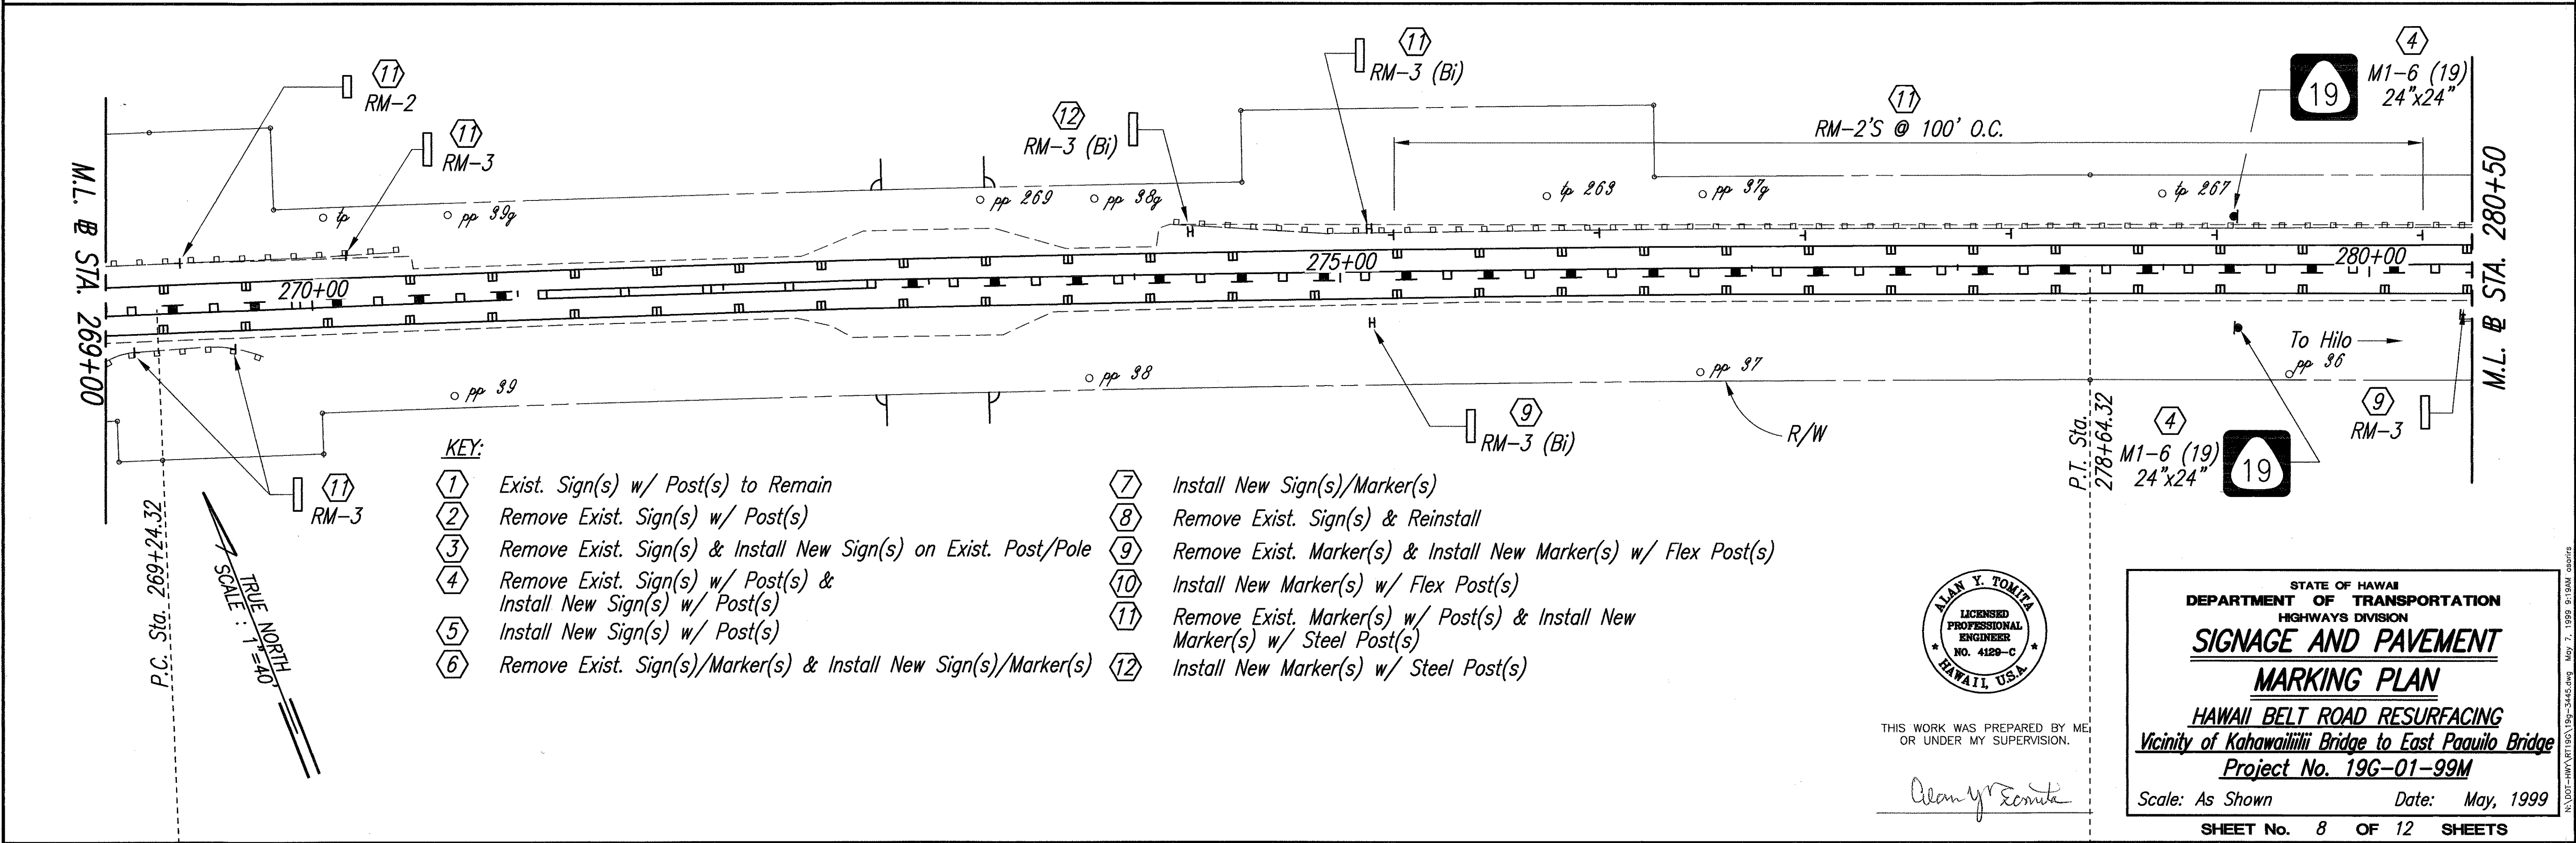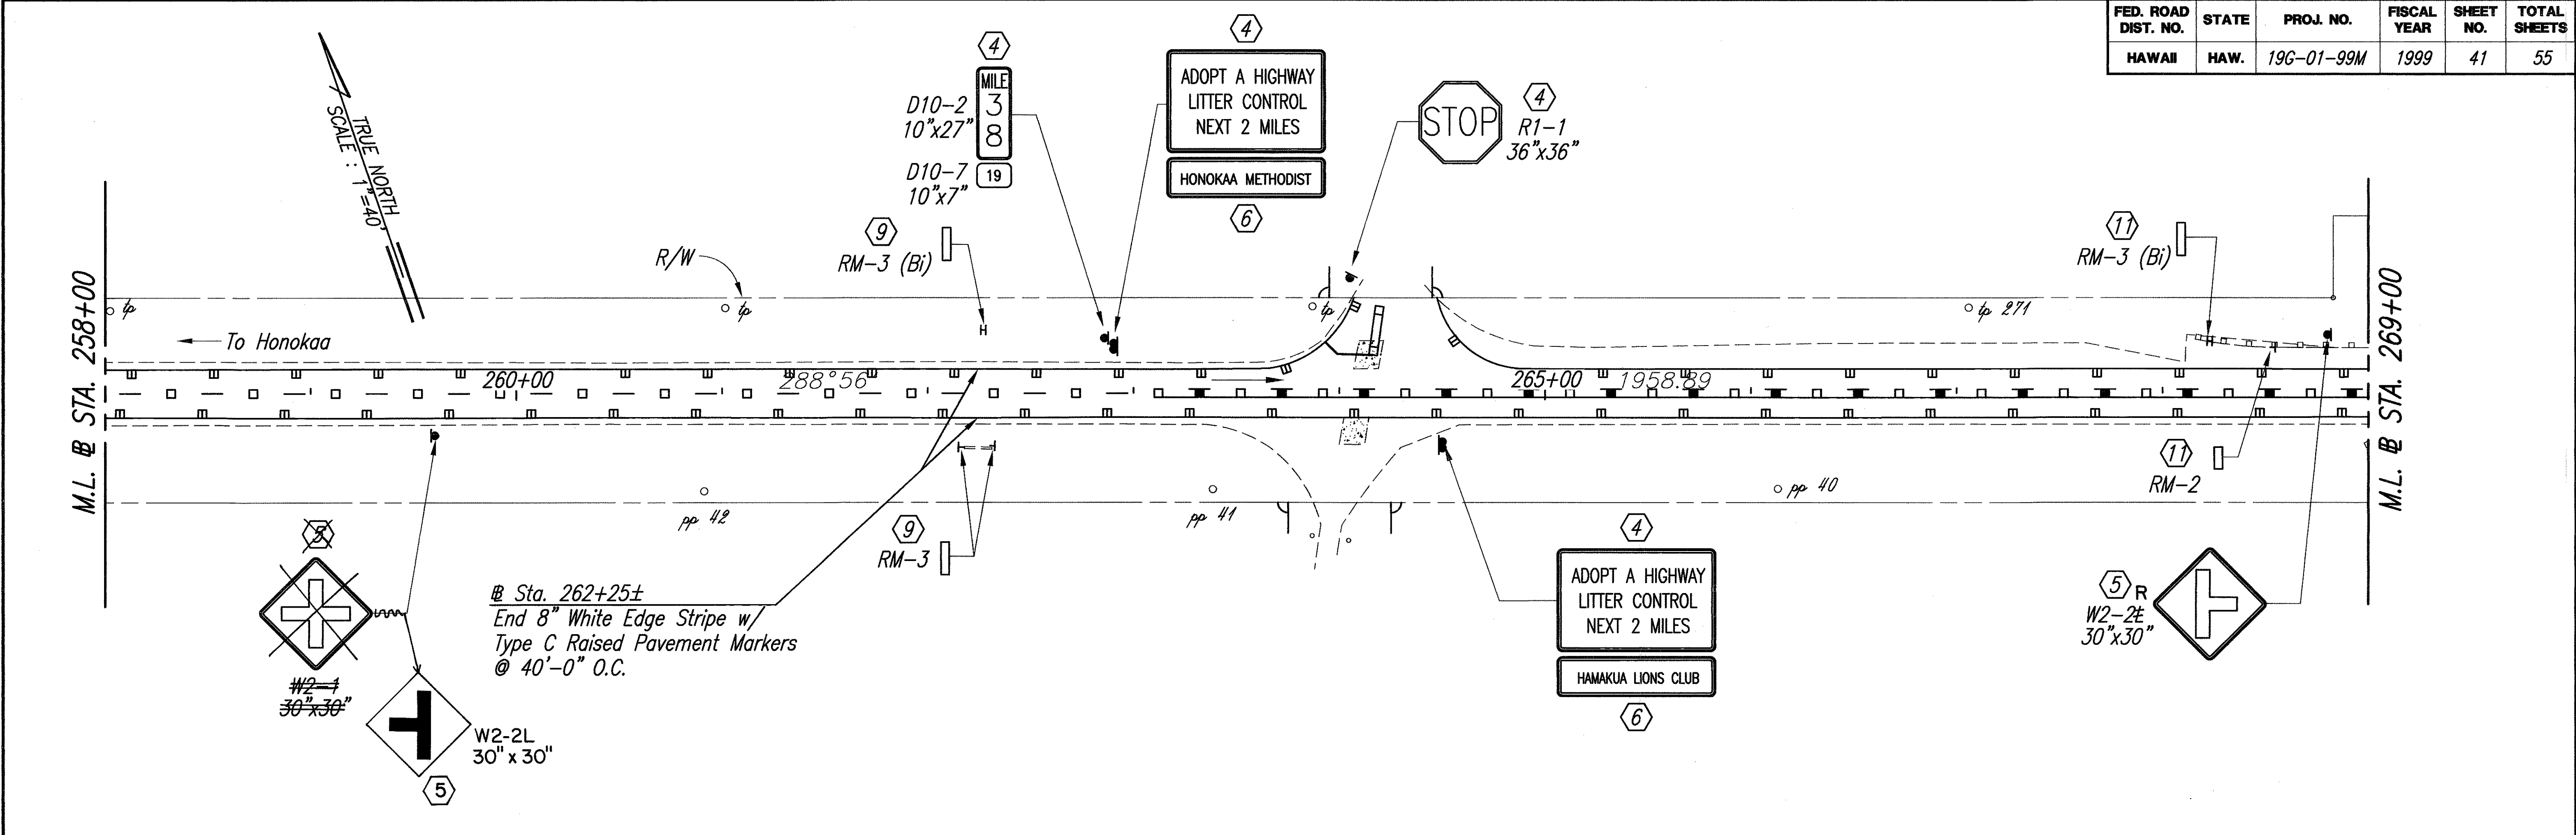

ORIGINAL PLAN	SURVEY PLOTTED BY	DATE
NOTE BOOK	DESIGNED BY	
	QUANTITIES BY	
	CHECKED BY	

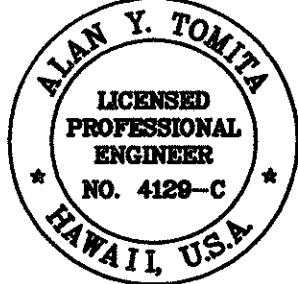

THIS WORK WAS PREPARED BY ME, OR UNDER MY SUPERVISION.

Alan Y. Tomita

STATE OF HAWAII

DEPARTMENT OF TRANSPORTATION

HIGHWAYS DIVISION

SIGNAGE AND PAVEMENT

MARKING PLAN

HAWAII BELT ROAD RESURFACING

Vicinity of Kahawaiilili Bridge to East Paauilo Bridge

Project No. 19G-01-99M

Scale: As Shown



Date: May, 1999

SHEET No. 8 OF 12 SHEETS

41


"AS-BUILT"

FED. ROAD DIST. NO.	STATE	PROJ. NO.	FISCAL YEAR	SHEET NO.	TOTAL SHEETS
HAWAII	HAW.	19G-01-99M	1999	42	55

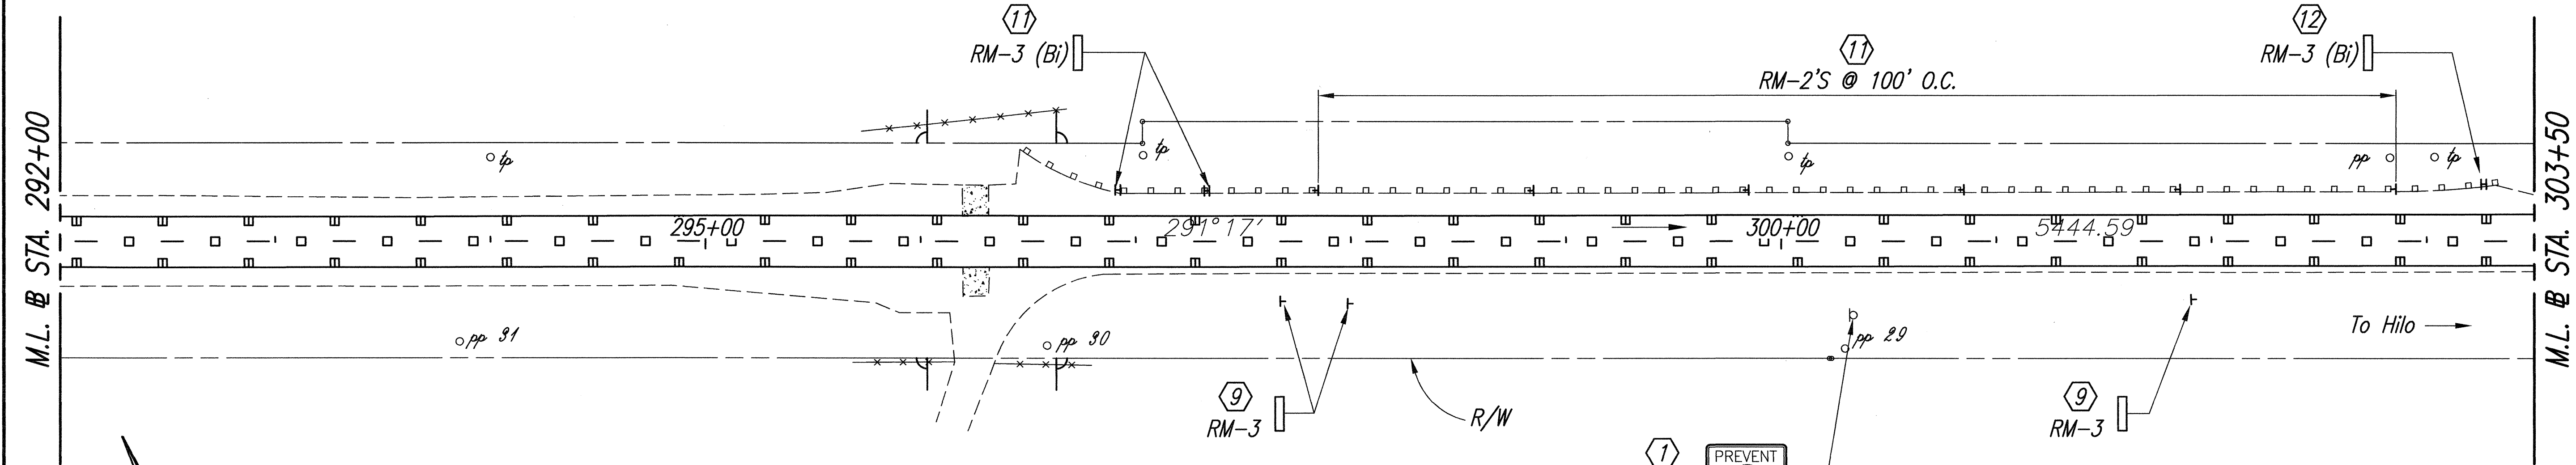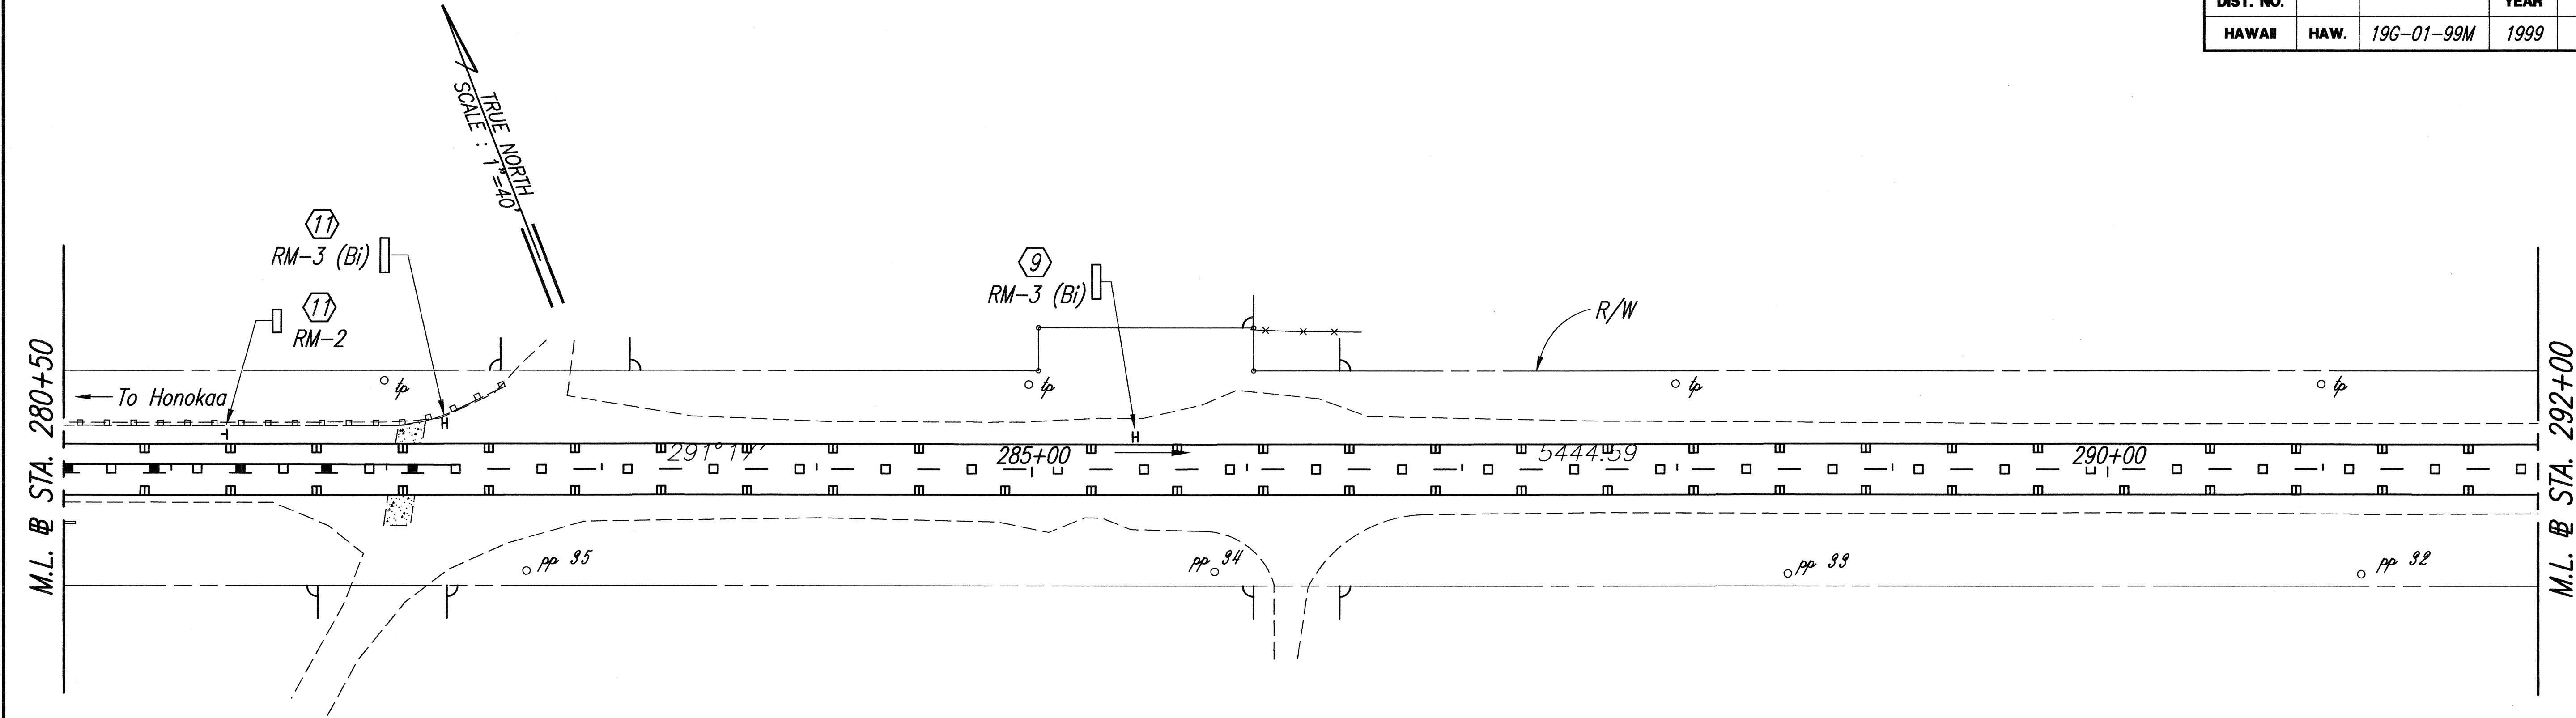

- KEY:**
- | | |
|---|--|
| (1) Exist. Sign(s) w/ Post(s) to Remain | (7) Install New Sign(s)/Marker(s) |
| (2) Remove Exist. Sign(s) w/ Post(s) | (8) Remove Exist. Sign(s) & Reinstall |
| (3) Remove Exist. Sign(s) & Install New Sign(s) on Exist. Post/Pole | (9) Remove Exist. Marker(s) & Install New Marker(s) w/ Flex Post(s) |
| (4) Remove Exist. Sign(s) w/ Post(s) & Install New Sign(s) w/ Post(s) | (10) Install New Marker(s) w/ Flex Post(s) |
| (5) Install New Sign(s) w/ Post(s) | (11) Remove Exist. Marker(s) w/ Post(s) & Install New Marker(s) w/ Steel Post(s) |
| (6) Remove Exist. Sign(s)/Markers & Install New Sign(s)/Marker(s) | (12) Install New Marker(s) w/ Steel Post(s) |

ORIGINAL PLAN	SURVEY PLOTTED BY	DATE
DRAWN BY	DESIGNED BY	CHECKED BY
NOTE BOOK	DESIGNED BY	CHECKED BY
No.		


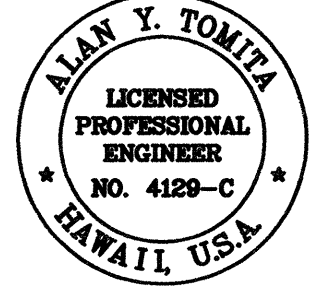


THIS WORK WAS PREPARED BY ME
OR UNDER MY SUPERVISION.


Alan Y. Tomita

STATE OF HAWAII
DEPARTMENT OF TRANSPORTATION
HIGHWAYS DIVISION
SIGNAGE AND PAVEMENT
MARKING PLAN
HAWAII BELT ROAD RESURFACING
Vicinity of Kahawailili Bridge to East Paauilo Bridge
Project No. 19G-01-99M
Scale: As Shown Date: May, 1999
SHEET NO. 9 OF 12 SHEETS

FED. ROAD DIST. NO.	STATE	PROJ. NO.	FISCAL YEAR	SHEET NO.	TOTAL SHEETS
HAWAII	HAW.	19G-01-99M	1999	43	55

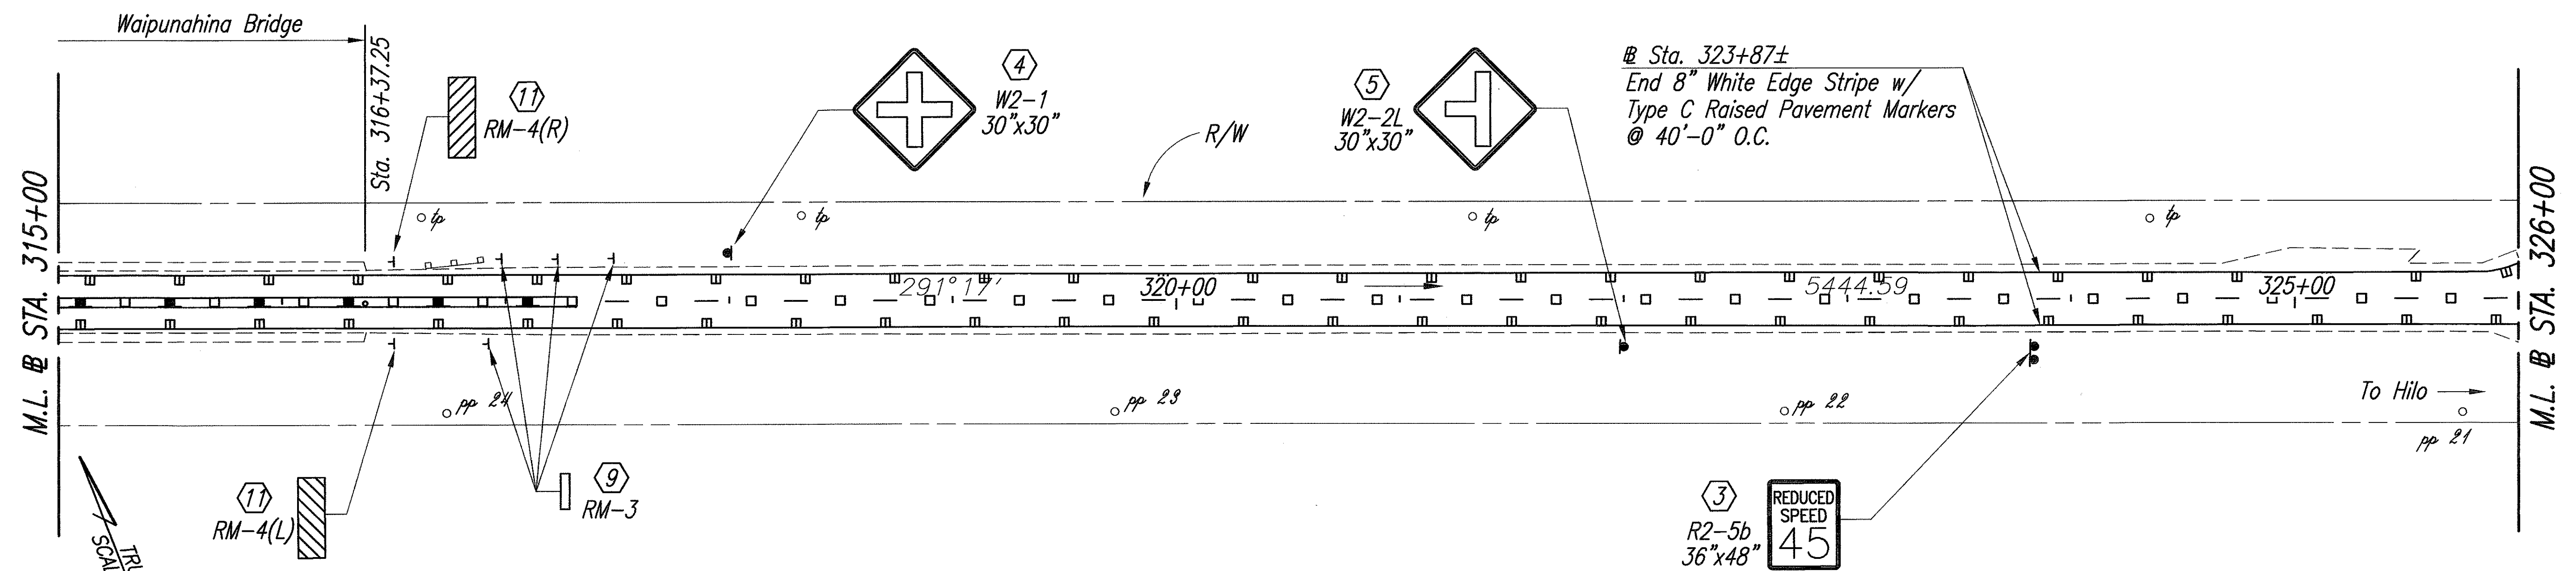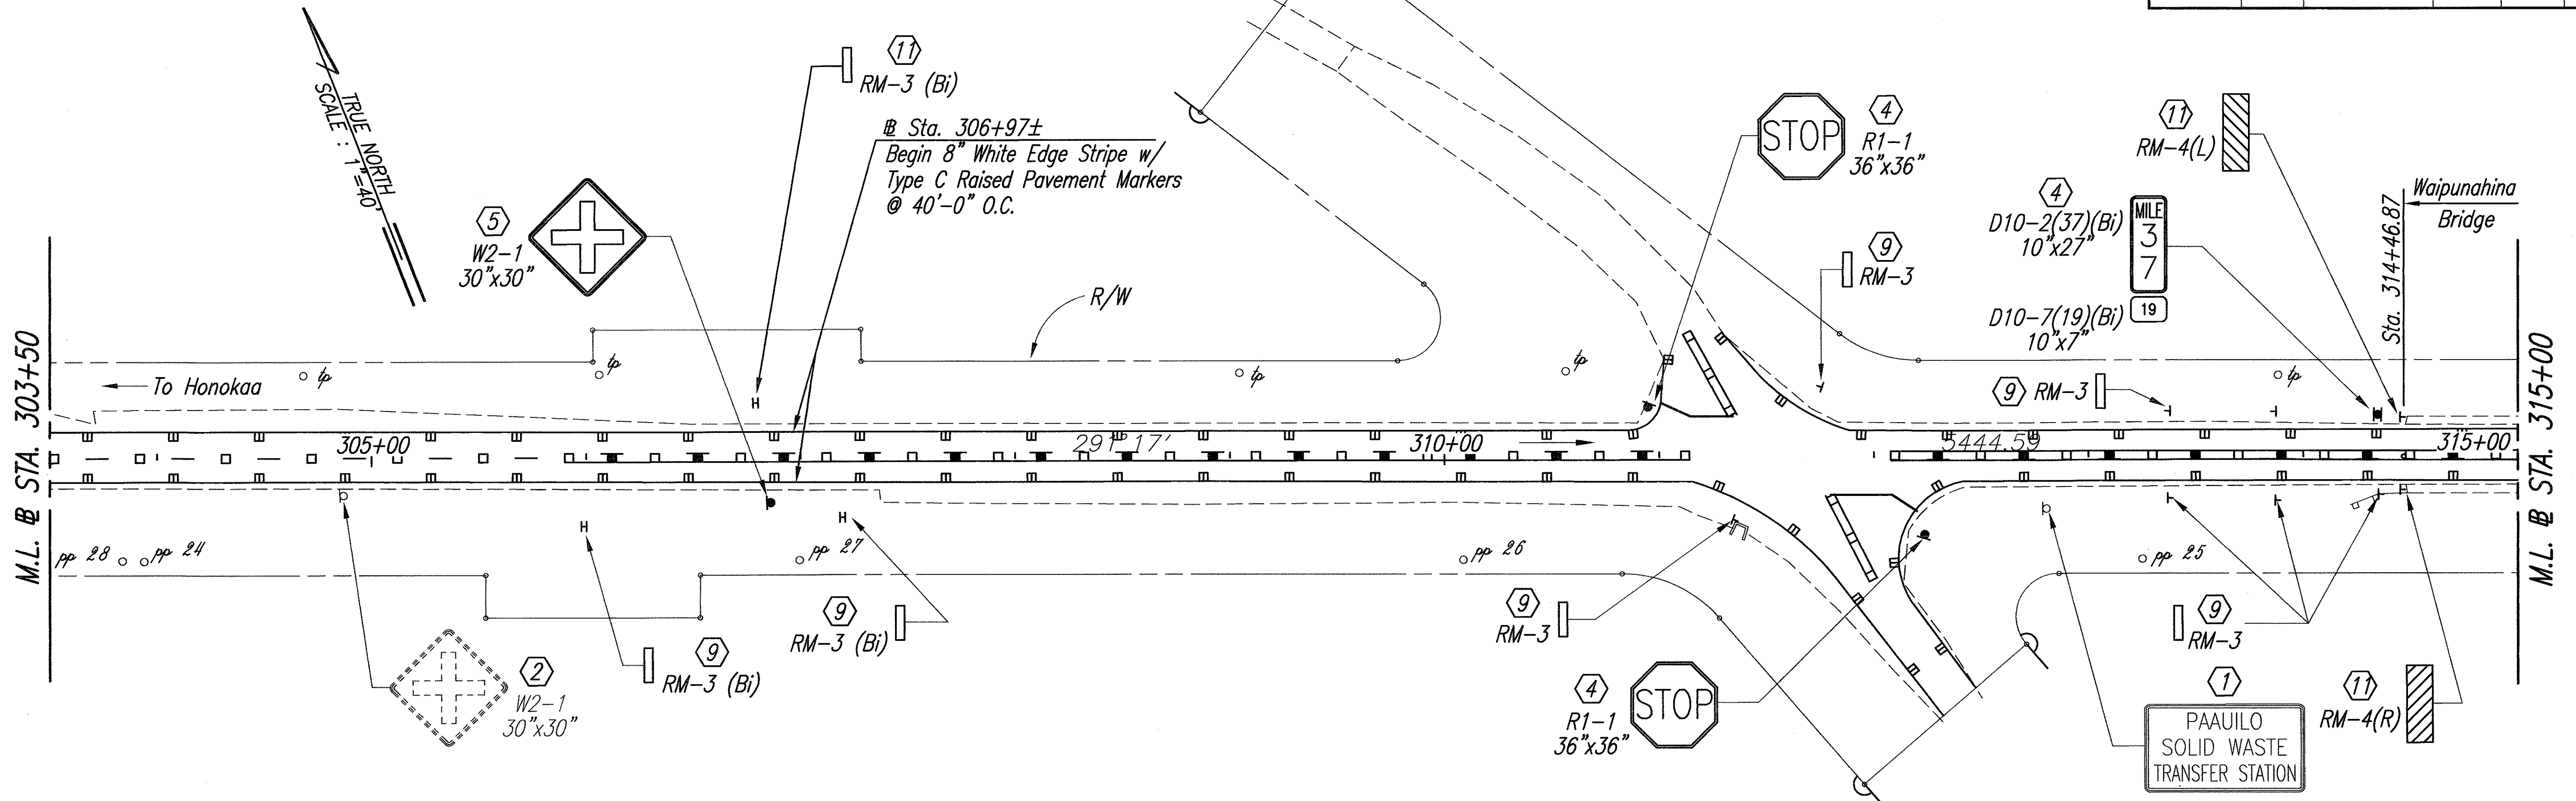

- KEY:
- 1 Exist. Sign(s) w/ Post(s) to Remain
 - 2 Remove Exist. Sign(s) w/ Post(s)
 - 3 Remove Exist. Sign(s) & Install New Sign(s) on Exist. Post/Pole
 - 4 Remove Exist. Sign(s) w/ Post(s) & Install New Sign(s) w/ Post(s)
 - 5 Install New Sign(s) w/ Post(s)
 - 6 Remove Exist. Sign(s)/Marker(s) & Install New Sign(s)/Marker(s)
 - 7 Install New Sign(s)/Marker(s)
 - 8 Remove Exist. Sign(s) & Reinstall
 - 9 Remove Exist. Marker(s) & Install New Marker(s) w/ Flex Post(s)
 - 10 Install New Marker(s) w/ Flex Post(s)
 - 11 Remove Exist. Marker(s) w/ Post(s) & Install New Marker(s) w/ Steel Post(s)
 - 12 Install New Marker(s) w/ Steel Post(s)

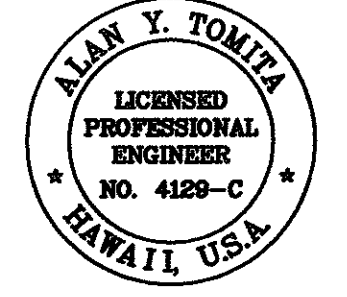

THIS WORK WAS PREPARED BY ME OR UNDER MY SUPERVISION.

Alan Y. Tomita

STATE OF HAWAII
DEPARTMENT OF TRANSPORTATION
HIGHWAYS DIVISION
SIGNAGE AND PAVEMENT
MARKING PLAN
HAWAII BELT ROAD RESURFACING
Vicinity of Kahawailiili Bridge to East Paauilo Bridge
Project No. 19G-01-99M
Scale: As Shown Date: May, 1999
SHEET No. 10 OF 12 SHEETS



"AS-BUILT"

ORIGINAL PLAN	SURVEY PLOTTED BY	DATE
NOTE BOOK	DESIGNED BY	
	QUANTITIES BY	
	CHECKED BY	
No.		


FED. ROAD DIST. NO.	STATE	PROJ. NO.	FISCAL YEAR	SHEET NO.	TOTAL SHEETS
HAWAII	HAW.	19G-01-99M	1999	44	55

KEY:

- | | | | |
|---|---|---|---|
| ① | Exist. Sign(s) w/ Post(s) to Remain | ⑦ | Install New Sign(s)/Marker(s) |
| ② | Remove Exist. Sign(s) w/ Post(s) | ⑧ | Remove Exist. Sign(s) & Reinstall |
| ③ | Remove Exist. Sign(s) & Install New Sign(s) on Exist. Post/Pole | ⑨ | Remove Exist. Marker(s) & Install New Marker(s) w/ Flex Post(s) |
| ④ | Remove Exist. Sign(s) w/ Post(s) & Install New Sign(s) w/ Post(s) | ⑩ | Install New Marker(s) w/ Flex Post(s) |
| ⑤ | Install New Sign(s) w/ Post(s) | ⑪ | Remove Exist. Marker(s) w/ Post(s) & Install New Marker(s) w/ Steel Post(s) |
| ⑥ | Remove Exist. Sign(s)/Marker(s) & Install New Sign(s)/Marker(s) | ⑫ | Install New Marker(s) w/ Steel Post(s) |

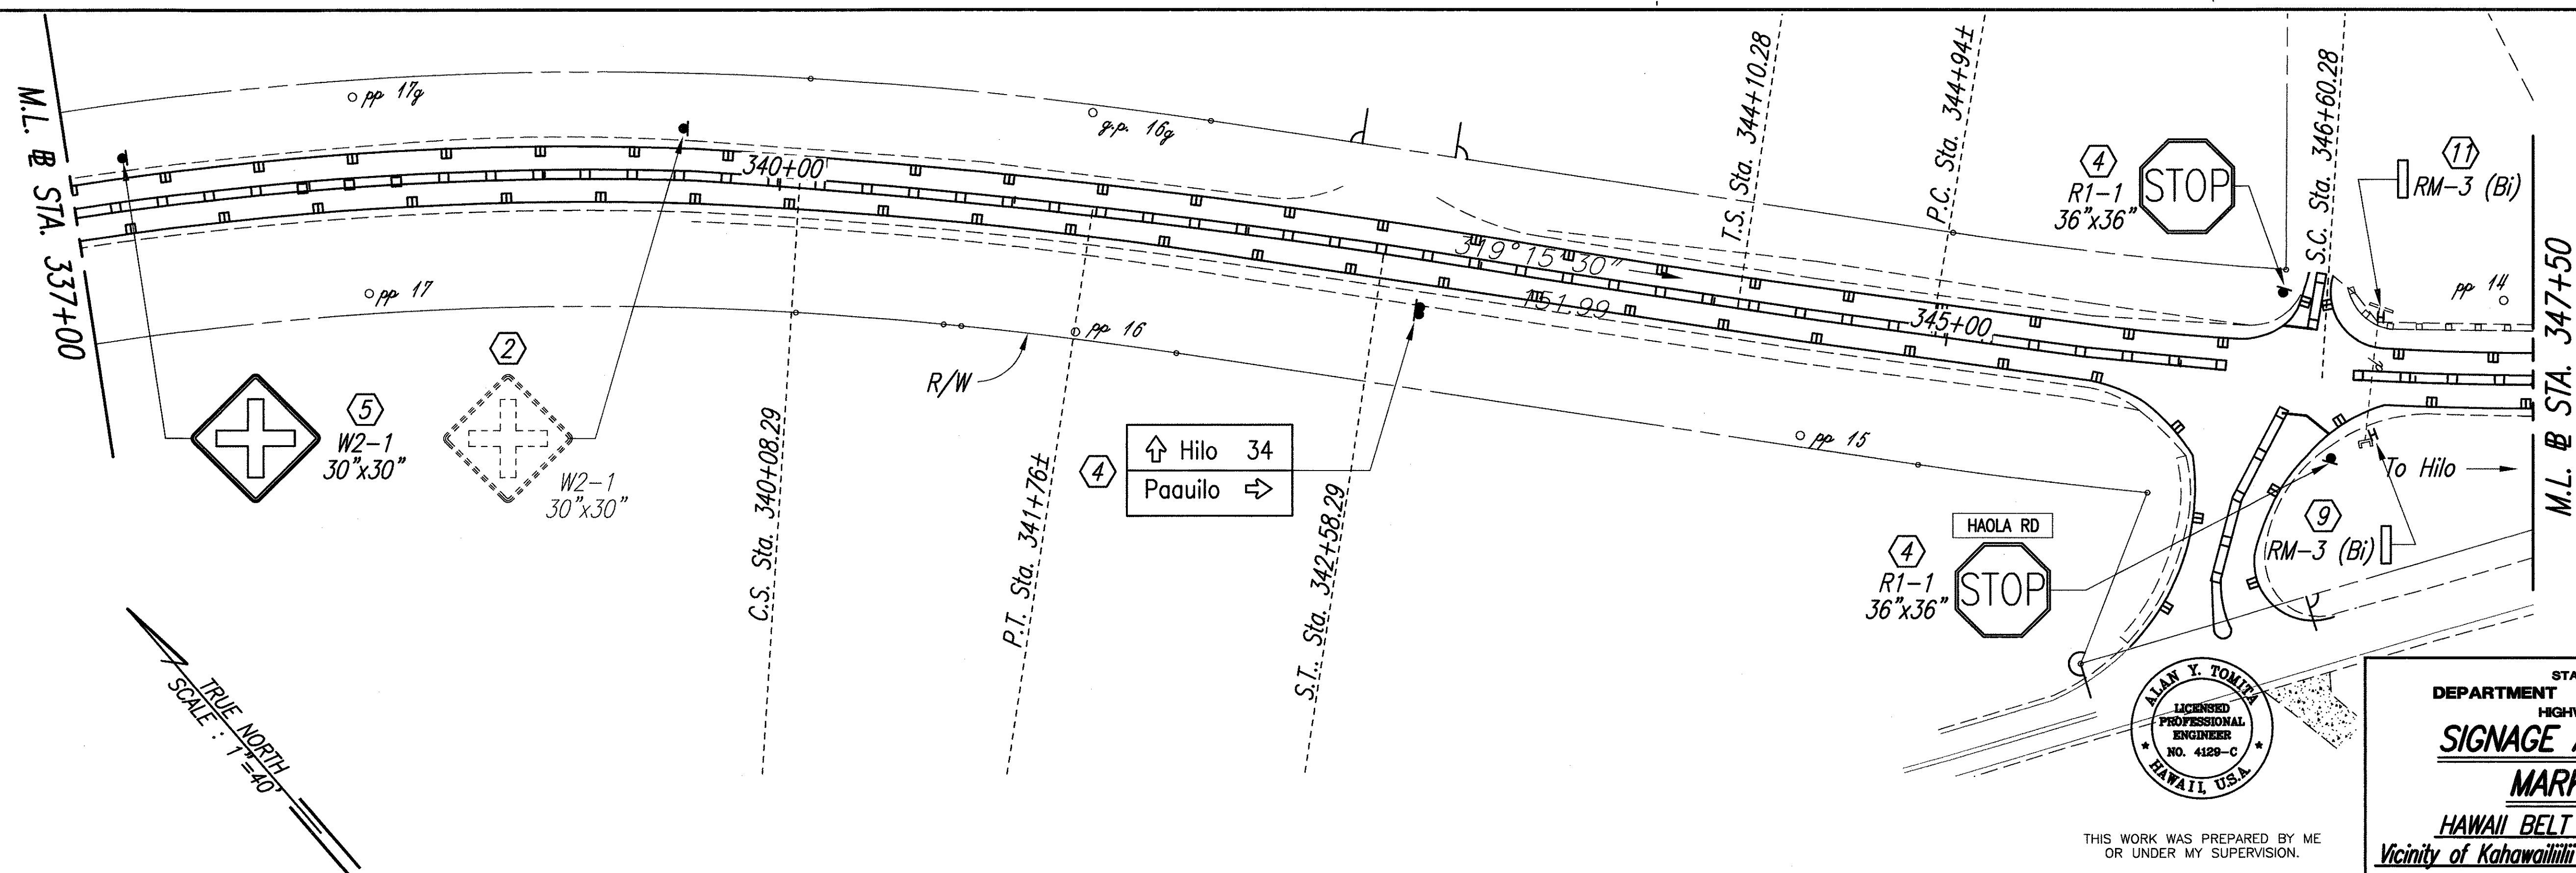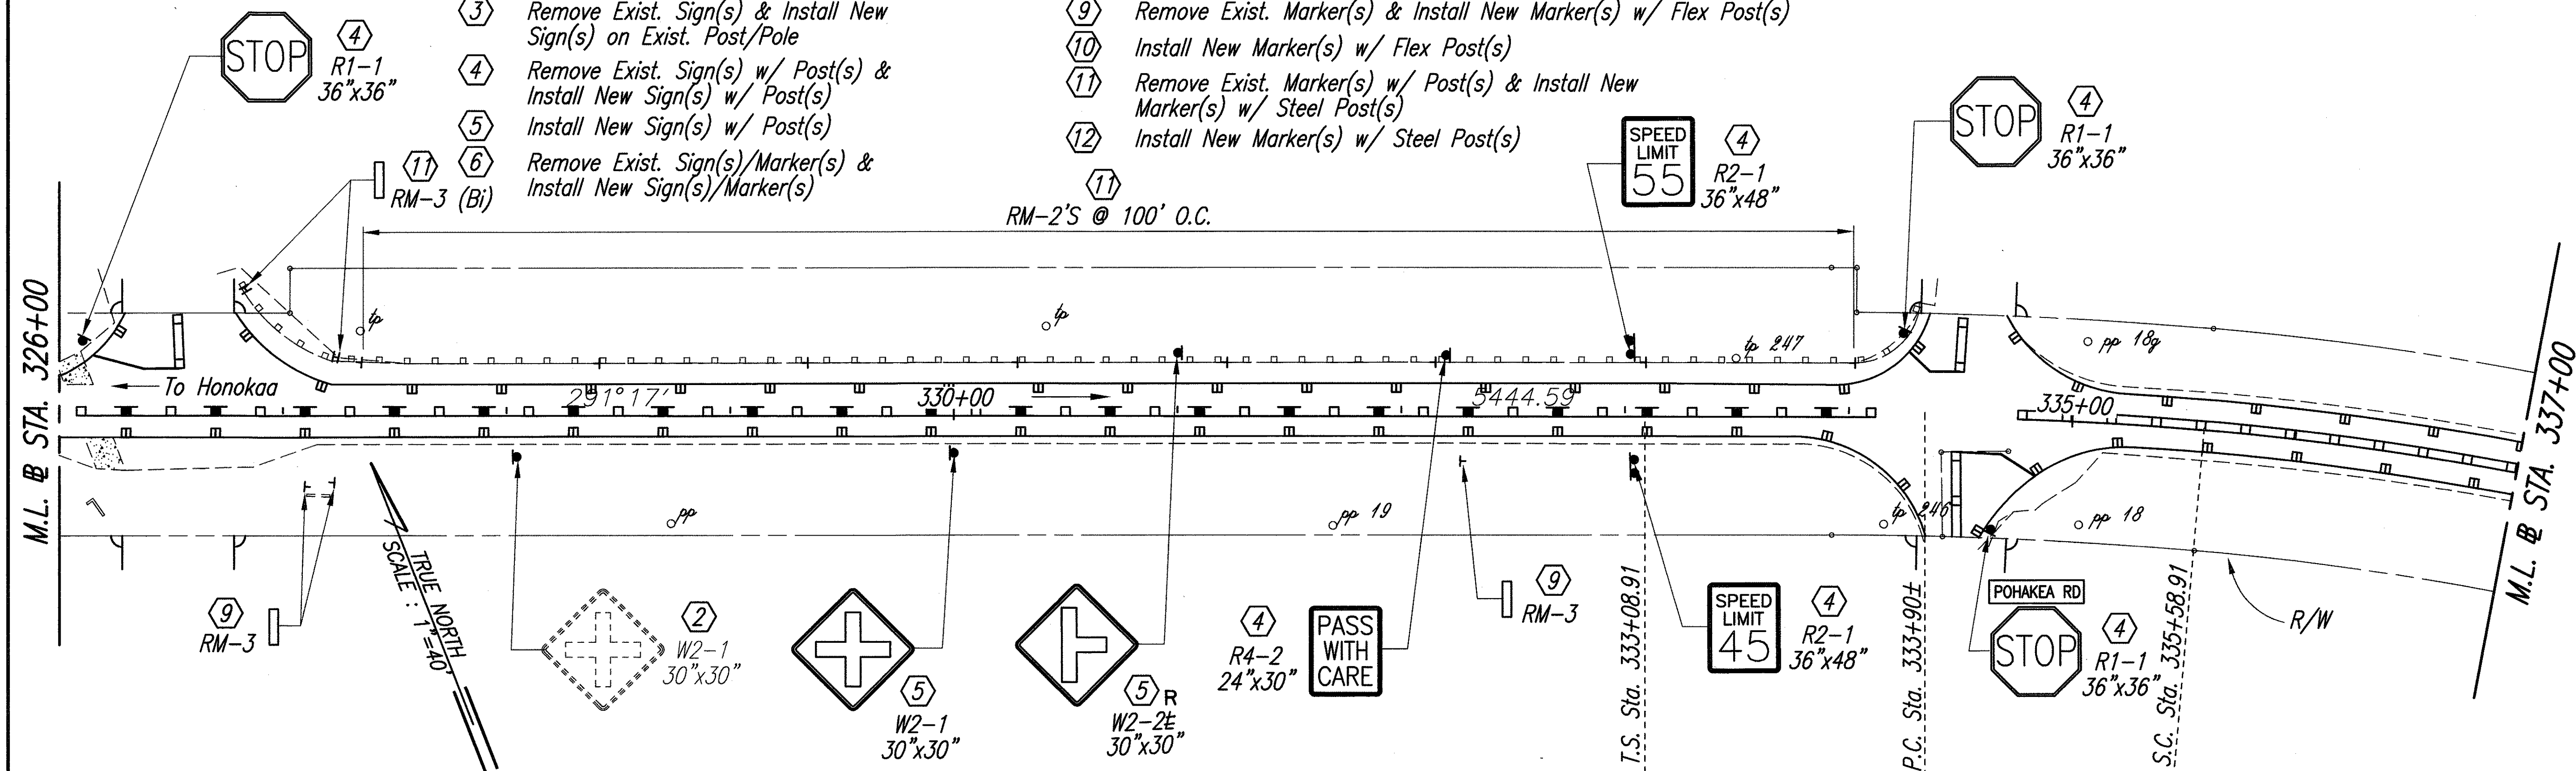

ORIGINAL PLAN	DATE
DESIGNED BY	
TRACED BY	
NOTE BOOK	
QUANTITIES BY	
CHECKED BY	
No.	

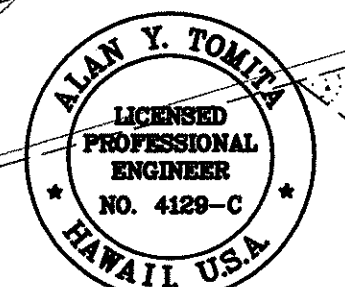

THIS WORK WAS PREPARED BY ME OR UNDER MY SUPERVISION.



Alan Y. Tomita

STATE OF HAWAII
DEPARTMENT OF TRANSPORTATION
HIGHWAYS DIVISION
SIGNAGE AND PAVEMENT
MARKING PLAN
HAWAII BELT ROAD RESURFACING
Vicinity of Kahawaiilili Bridge to East Paauilo Bridge
Project No. 19G-01-99M
Scale: As Shown Date: May, 1999
SHEET No. 11 OF 12 SHEETS


"AS-BUILT"

FED. ROAD DIST. NO.	STATE	PROJ. NO.	FISCAL YEAR	SHEET NO.	TOTAL SHEETS
HAWAII	HAW.	19G-01-99M	1999	45	55

NOTE:
For Key Notes, See Sheet 31.

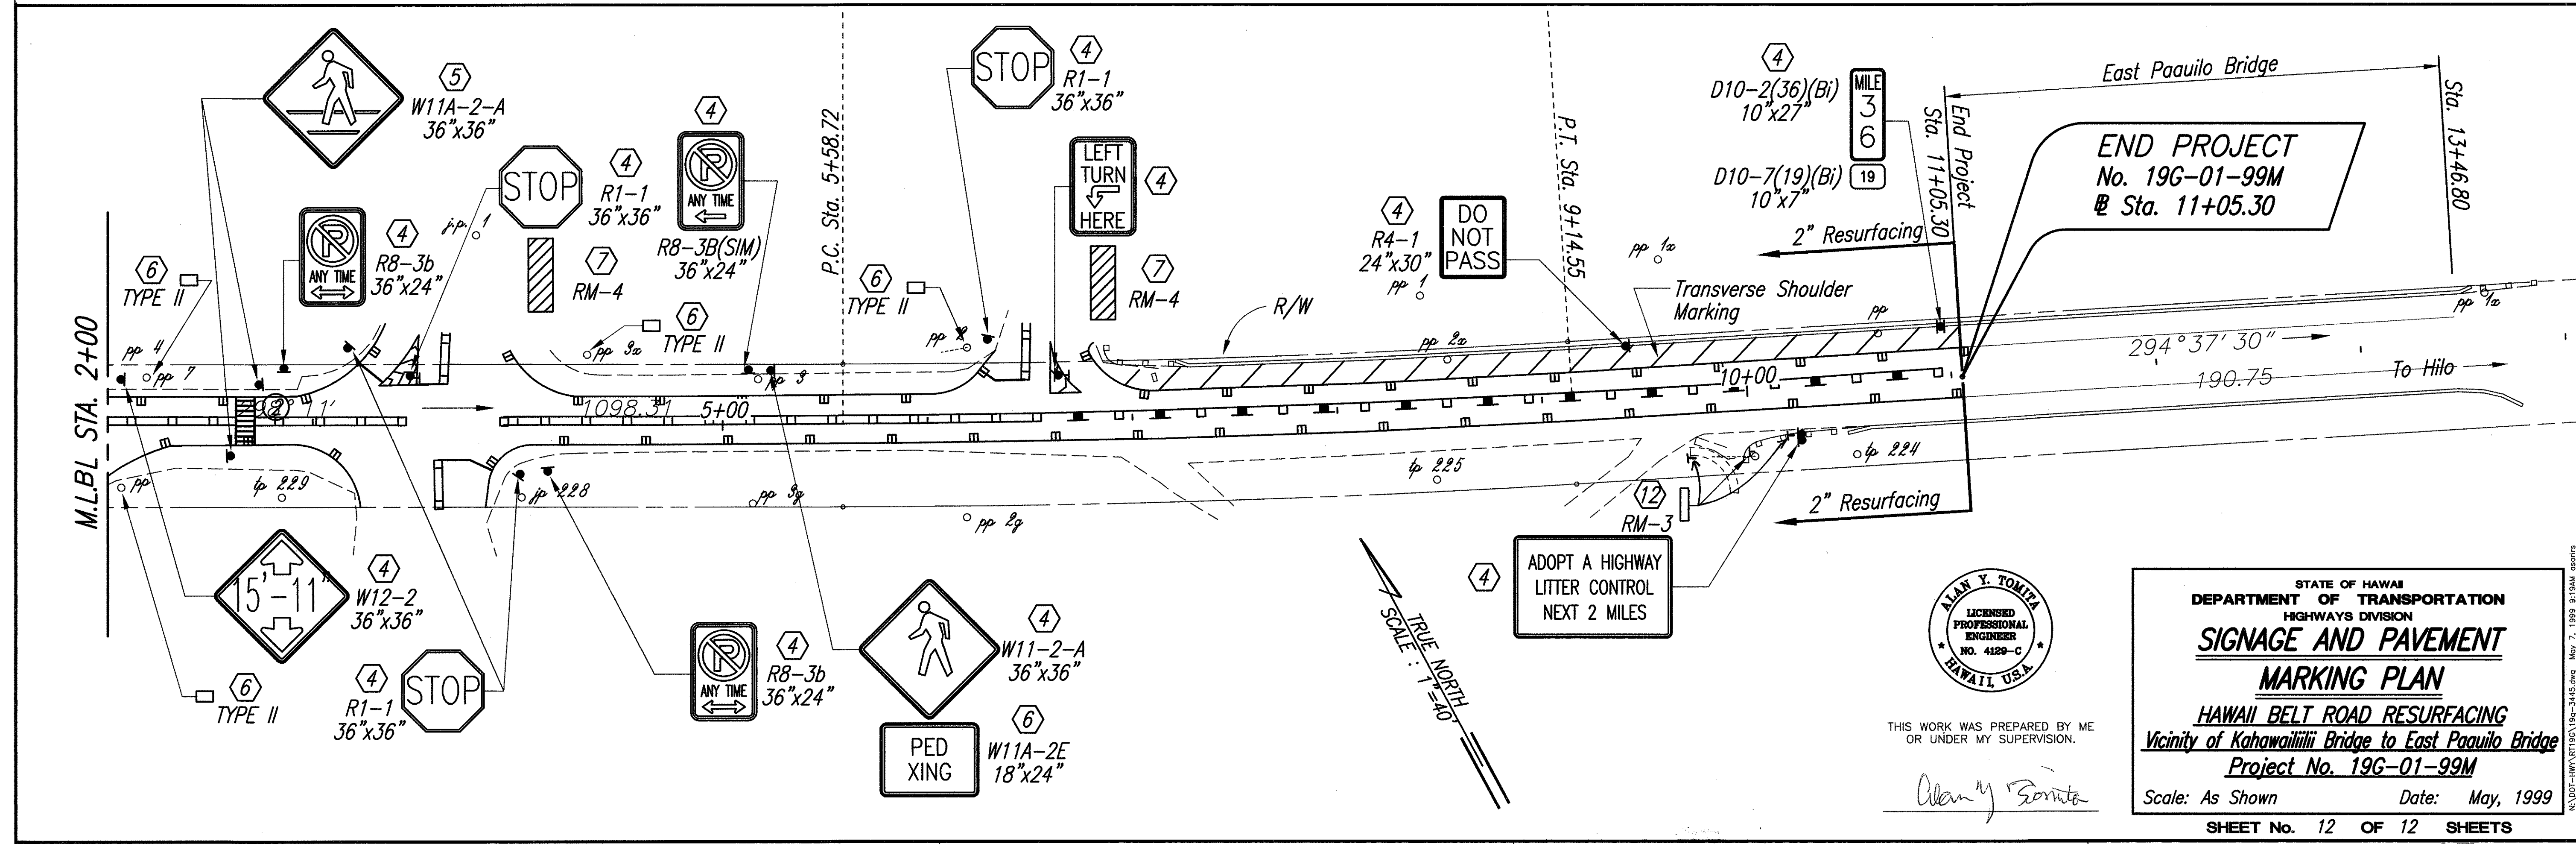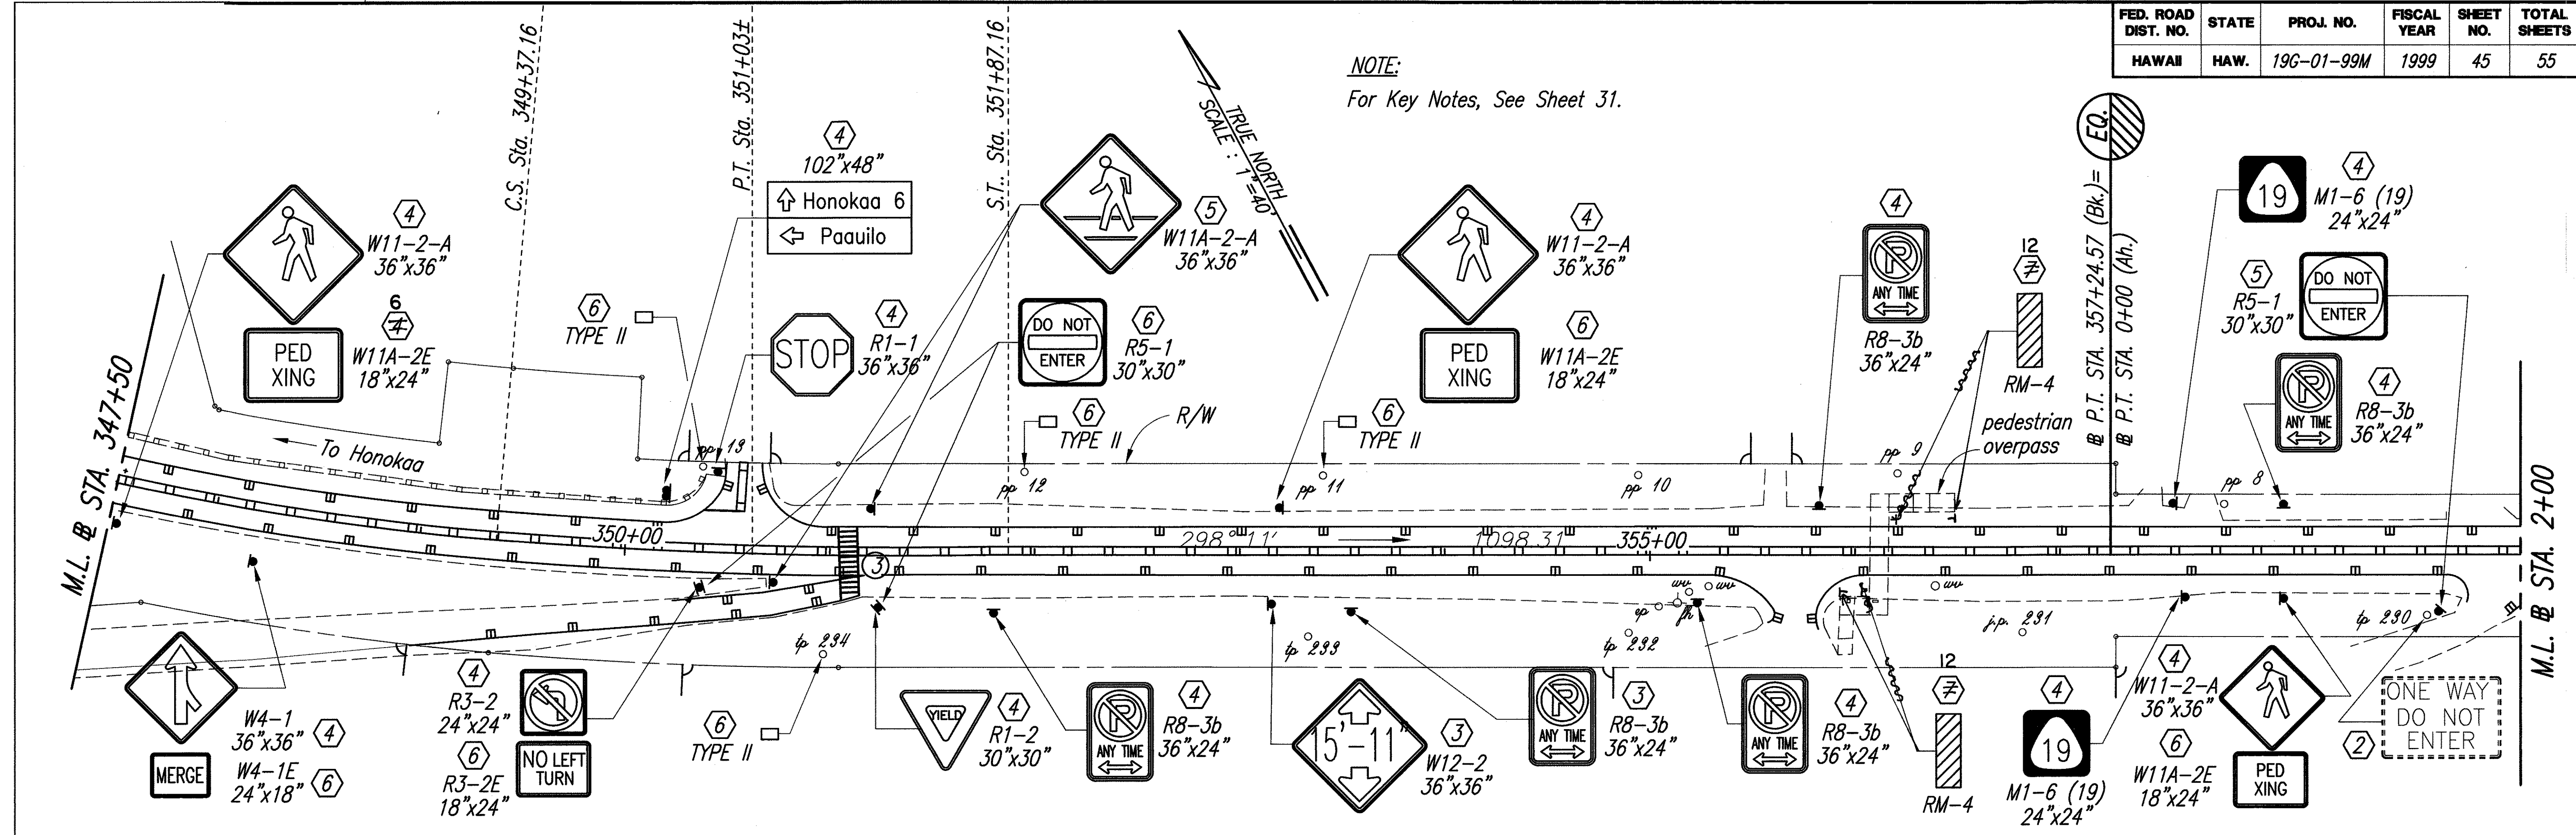

SURVEY PLOTTED BY	DATE
DRAWN BY	
TRACED BY	
QUANTITIES BY	
CHECKED BY	
NO.	

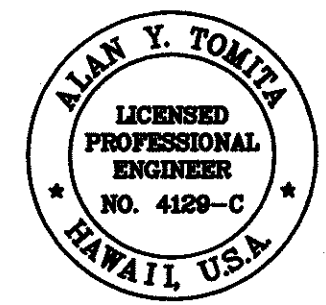

THIS WORK WAS PREPARED BY ME OR UNDER MY SUPERVISION.

Alan Y. Tomita

STATE OF HAWAII
DEPARTMENT OF TRANSPORTATION
HIGHWAYS DIVISION
SIGNAGE AND PAVEMENT MARKING PLAN
HAWAII BELT ROAD RESURFACING
Vicinity of Kahawailili Bridge to East Paauilo Bridge
Project No. 19G-01-99M
Scale: As Shown Date: May, 1999
SHEET No. 12 OF 12 SHEETS

AS-BUILT