

ORIGINAL PLAN

SURVEY PLOTTED BY

DATE

NOTE BOOK

TRACED BY

DESIGNED BY

QUANTITIES BY

CHECKED BY


No.

EQ. 249+62.16
=249+65.43

STRIPING AND PAVEMENT MARKING SCHEDULE

FED. ROAD DIST. NO.	STATE	PROJ. NO.	FISCAL YEAR	SHEET NO.	TOTAL SHEETS
HAWAII	HAW.	19G-01-99M	1999	46	55

STATION	TRAFFIC REGIME		THERMOPLASTIC OR TAPE TYPE () (LINEAR FEET)																PAVEMENT MARKERS (Each)				
			629.1020		629.1011			629.1012		629.1013				629.1017					629.2010	629.2030	629.2040	629.2050	629.2060
	4"	4"	4"	12"	4"	4"	8"	8"	12"	4" WHITE	4" WHITE	12"	SOLID WHITE ARROW			SOLID WHITE WORDS (III)							
	LEFT	RIGHT	DOUBLE YELLOW (I)	DBL. YELLOW GUIDELINES (I)	YELLOW C.L. (I)	YELLOW DIAGONAL (II)	WHITE STRIPE (I)	WHITE E.P. (II)	WHITE STRIPE (I)	WHITE STRIPE (II)	WHITE DIAGONAL (II)	EDGE LINE EXTENSION (III)	GUIDE LINES (III)	STOP BAR (III)	RT. (III)		ST. (III)	LT. (III)					
105+99	NP	NP	254				508													13	13		
108+53																							
OPEN																							
108+87	NP	P			800		1,600													40	20	20	80
116+97	P	P					7,420													186	93		372
154+07	P	NP			993		1,986													50	25	25	100
164+00	NP	NP	622				1,244													31	31		
170+22	NP	NP	1735						3,470	3,664										118	118		
187+57																							
OPEN																							
188+00	NP	P	700				1,400													37	19	18	72
195+00	P	P					7,404													186	93		372
232+02	P	NP			716		1,432													36	18	18	72
239+18	NP	NP	582				1,164													29	29		
245+00	NP	P			130		260													6	3	3	12
246+30	NP	P			960				1,920	1,920										48	24	24	96
255+90	P	P							1,268	1,268										30	15		60
262+24	P	P					152													4	2		8
263+00	P	NP			800		1,600													40	20	20	80
271+00	NP	NP	170				340													8	4		16
272+70	NP	P			960		1,920													48	24	24	96
282+30	P	P					4,710													118	59		236
305+85	P	NP			530		1,060													26	13	13	52
311+15																							

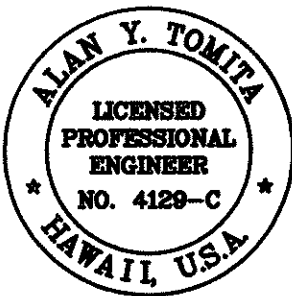

THIS WORK WAS PREPARED BY ME OR UNDER MY SUPERVISION.

Alan Y. Tomita

STATE OF HAWAII
DEPARTMENT OF TRANSPORTATION
HIGHWAYS DIVISION
STRIPING AND PAVEMENT MARKING SCHEDULE
HAWAII BELT ROAD RESURFACING
Vicinity of Kahawailiili Bridge to East Paauilo Bridge
Project No. 19G-01-99M
Scale: None Date: May, 1999
SHEET No. 1 OF 2 SHEETS

"AS-BUILT"

