

STATE OF HAWAII

DEPARTMENT OF TRANSPORTATION

HIGHWAYS DIVISION

HONOLULU, HAWAII

"AS-BUILT" PLANS FOR

ROUTE 19G

HAWAII BELT ROAD

RESURFACING


VICINITY OF KAHAWAILILII BRIDGE TO EAST PAAUILO BRIDGE

M.P. 40.97 TO M.P. 36.00

PROJECT NO. 19G-01-99M


DISTRICT OF HAMAKUA

ISLAND OF HAWAII

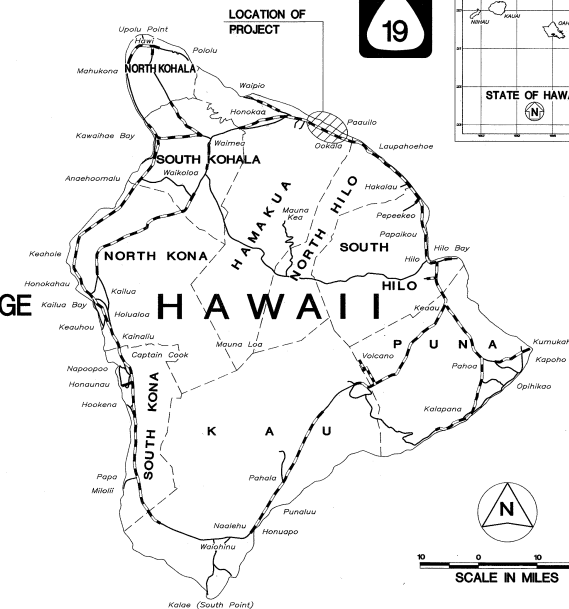


MILE POST 40.97 **TO MILE POST** 36.00

M&E Pacific, Inc. Todd Nishoka 692-7572 May 1999
DESIGNED BY P. S. & E. BY PHONE DATE

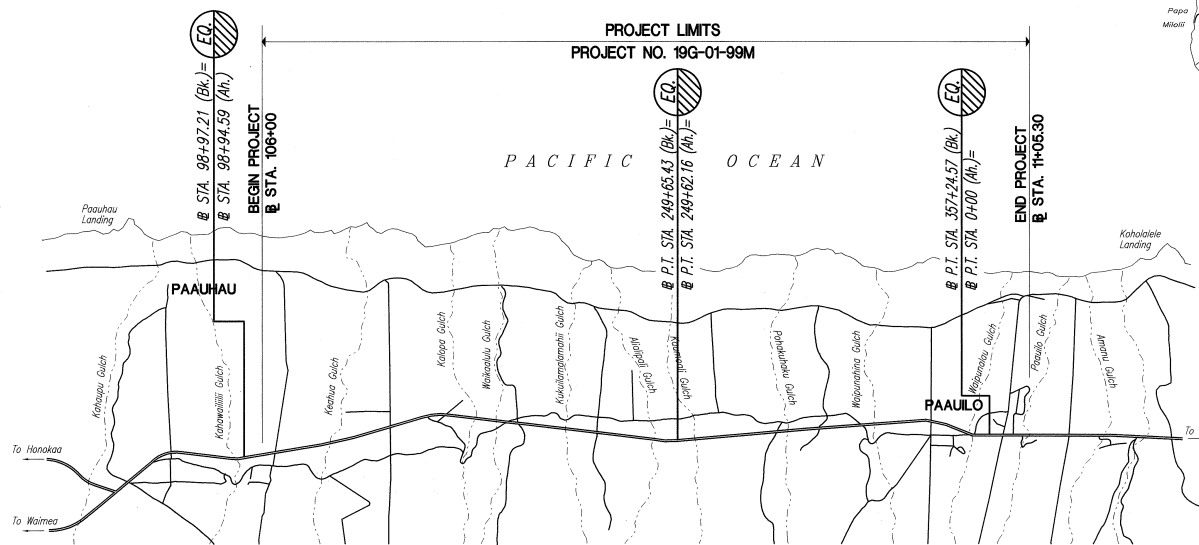

LAYOUT PLAN
LENGTH OF PROJECT 4.97 MILES

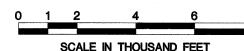

DEPARTMENT OF TRANSPORTATION
STATE OF HAWAII
APPROVED:
Glenn M. Quinn
DIRECTOR OF TRANSPORTATION
5-7-99
DATE