
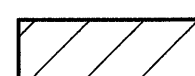
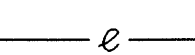

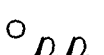

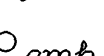

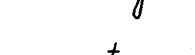

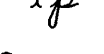

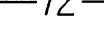
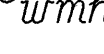
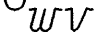
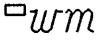
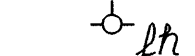
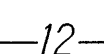

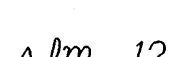



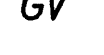
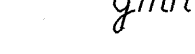
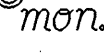
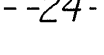


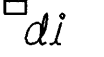
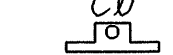

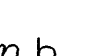

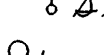
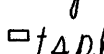


GENERAL NOTES

1. The scope of work for this project includes roadway excavation; demolishing specified areas of concrete sidewalk and curb ramps; construction of new concrete sidewalk and new curb ramps; installing shoulders by widening the travelway; installing pavement striping & markers and traffic signs.
2. The Contractor is reminded of the requirements of Subsection 108.01 - Subletting of Contract, which requires him to perform work amounting to not less than 50 percent of the total contract cost less deductible items. Non-compliance with this Subsection may be grounds for rejection of bid.
3. The Contractor's attention is directed to the following Sections of the Special Provisions: Subsection 107.13 - Public Convenience and Safety; Subsection 107.21 - Contractor's Responsibility For Utility Property And Services; and Section 645 -Traffic Control.
4. At the end of each day's work, the Contractor shall remove all equipment and other obstructions to permit free and safe passage of public traffic.
5. The existence and location of underground utilities, manholes, monuments and structures as shown on the plans are from the latest available data but the accuracy is not guaranteed. The encountering of other obstacles during the course of work is possible. The Contractor shall be held liable for any damages incurred to the existing facilities and/or improvements as a result of his operations.
6. The exact locations and limits or areas to be excavated and reconstructed shall be determined in the field by the Engineer.
7. The Contractor shall notify the Engineer in writing, two (2) weeks prior to starting paving operations.
8. The Contractor shall remove and dispose of all existing raised pavement markers, thermoplastic line markings, traffic tapes and epoxy adhesives prior to the restriping. This work shall be considered incidental to Asphalt Concrete Pavement, Mix No. IV and will not be paid for separately.
9. Existing drainage system will be functional at all times during construction. The Contractor is to furnish materials, equipment, labor, tools and incidentals necessary to maintain flow. This work shall be considered incidental to various contract items.
10. The contractor shall provide for access to and from all existing side streets at all times.
11. All saw cutting work shall be considered incidental to Asphalt Concrete Pavement, Mix No. IV and will not be paid for separately.

LEGEND

-  Reconstruction Areas
-  Shoulder Improvement Areas
-  Existing Electrical Line
-  Existing Joint Pole
-  Existing Power Pole
-  Existing Guy Anchor
-  Existing Electric Manhole
-  Existing Electric Pull Box
-  Existing Telephone Line
-  Existing Telephone Pole
-  Existing Telephone Manhole
-  Existing 12" Water Line
-  Existing Water Manhole
-  Existing Water Valve Box
-  Existing Water Meter
-  Existing Fire Hydrant
-  Existing 12" Sewer Line
-  Existing Sewer Manhole
-  Existing Sewer Force Main
-  Existing 6" Gas Line
-  Existing Gas Valve Box
-  Adjusted Gas Valve Box
-  Existing Gas Manhole
-  Existing Monument
-  Existing 24" Drain Line
-  Existing Storm Drain Manhole
-  Existing Grated Drop Inlet
-  Existing Drop Inlet
-  Existing Catch Basin
-  Existing Utility Box
-  Existing Traffic Sign
-  Existing Highway Lighting Standard
-  Existing Traffic Signal Pole
-  Existing Traffic Signal Pullbox
-  Adjusted Traffic Signal Pullbox
-  Existing Electric Manhole

FED. ROAD DIST. NO.	STATE	FED. AID PROJ. NO.	FISCAL YEAR	SHEET NO.	TOTAL SHEETS
HAWAII	HAW.	NH-019-2(54)	2001	3	30

SURVEY PLOTTED BY	DATE
DESIGNED BY	
TRACED BY	
NOTED BY	
QUANTITIES BY	
CHECKED BY	

ORIGINAL PLAN	004701
NOTE BOOK	004701
DATE	11/20/01

STATE OF HAWAII
DEPARTMENT OF TRANSPORTATION
HIGHWAYS DIVISION

GENERAL NOTES AND LEGEND

KAMEHAMEHA AVENUE
BIKEWAY IMPROVEMENTS
Hilo Bayfront Highway to Kalanianaʻole Avenue
Federal Aid Project No. NH-019-2(54)

Date: April, 2001

SHEET No. 1 OF 1 SHEETS