


FED. ROAD DIST. NO.	STATE	FED. AID PROJ. NO.	FISCAL YEAR	SHEET NO.	TOTAL SHEETS
HAWAII	HAW.	NH-019-2(54)	2001	ADD. 10	30

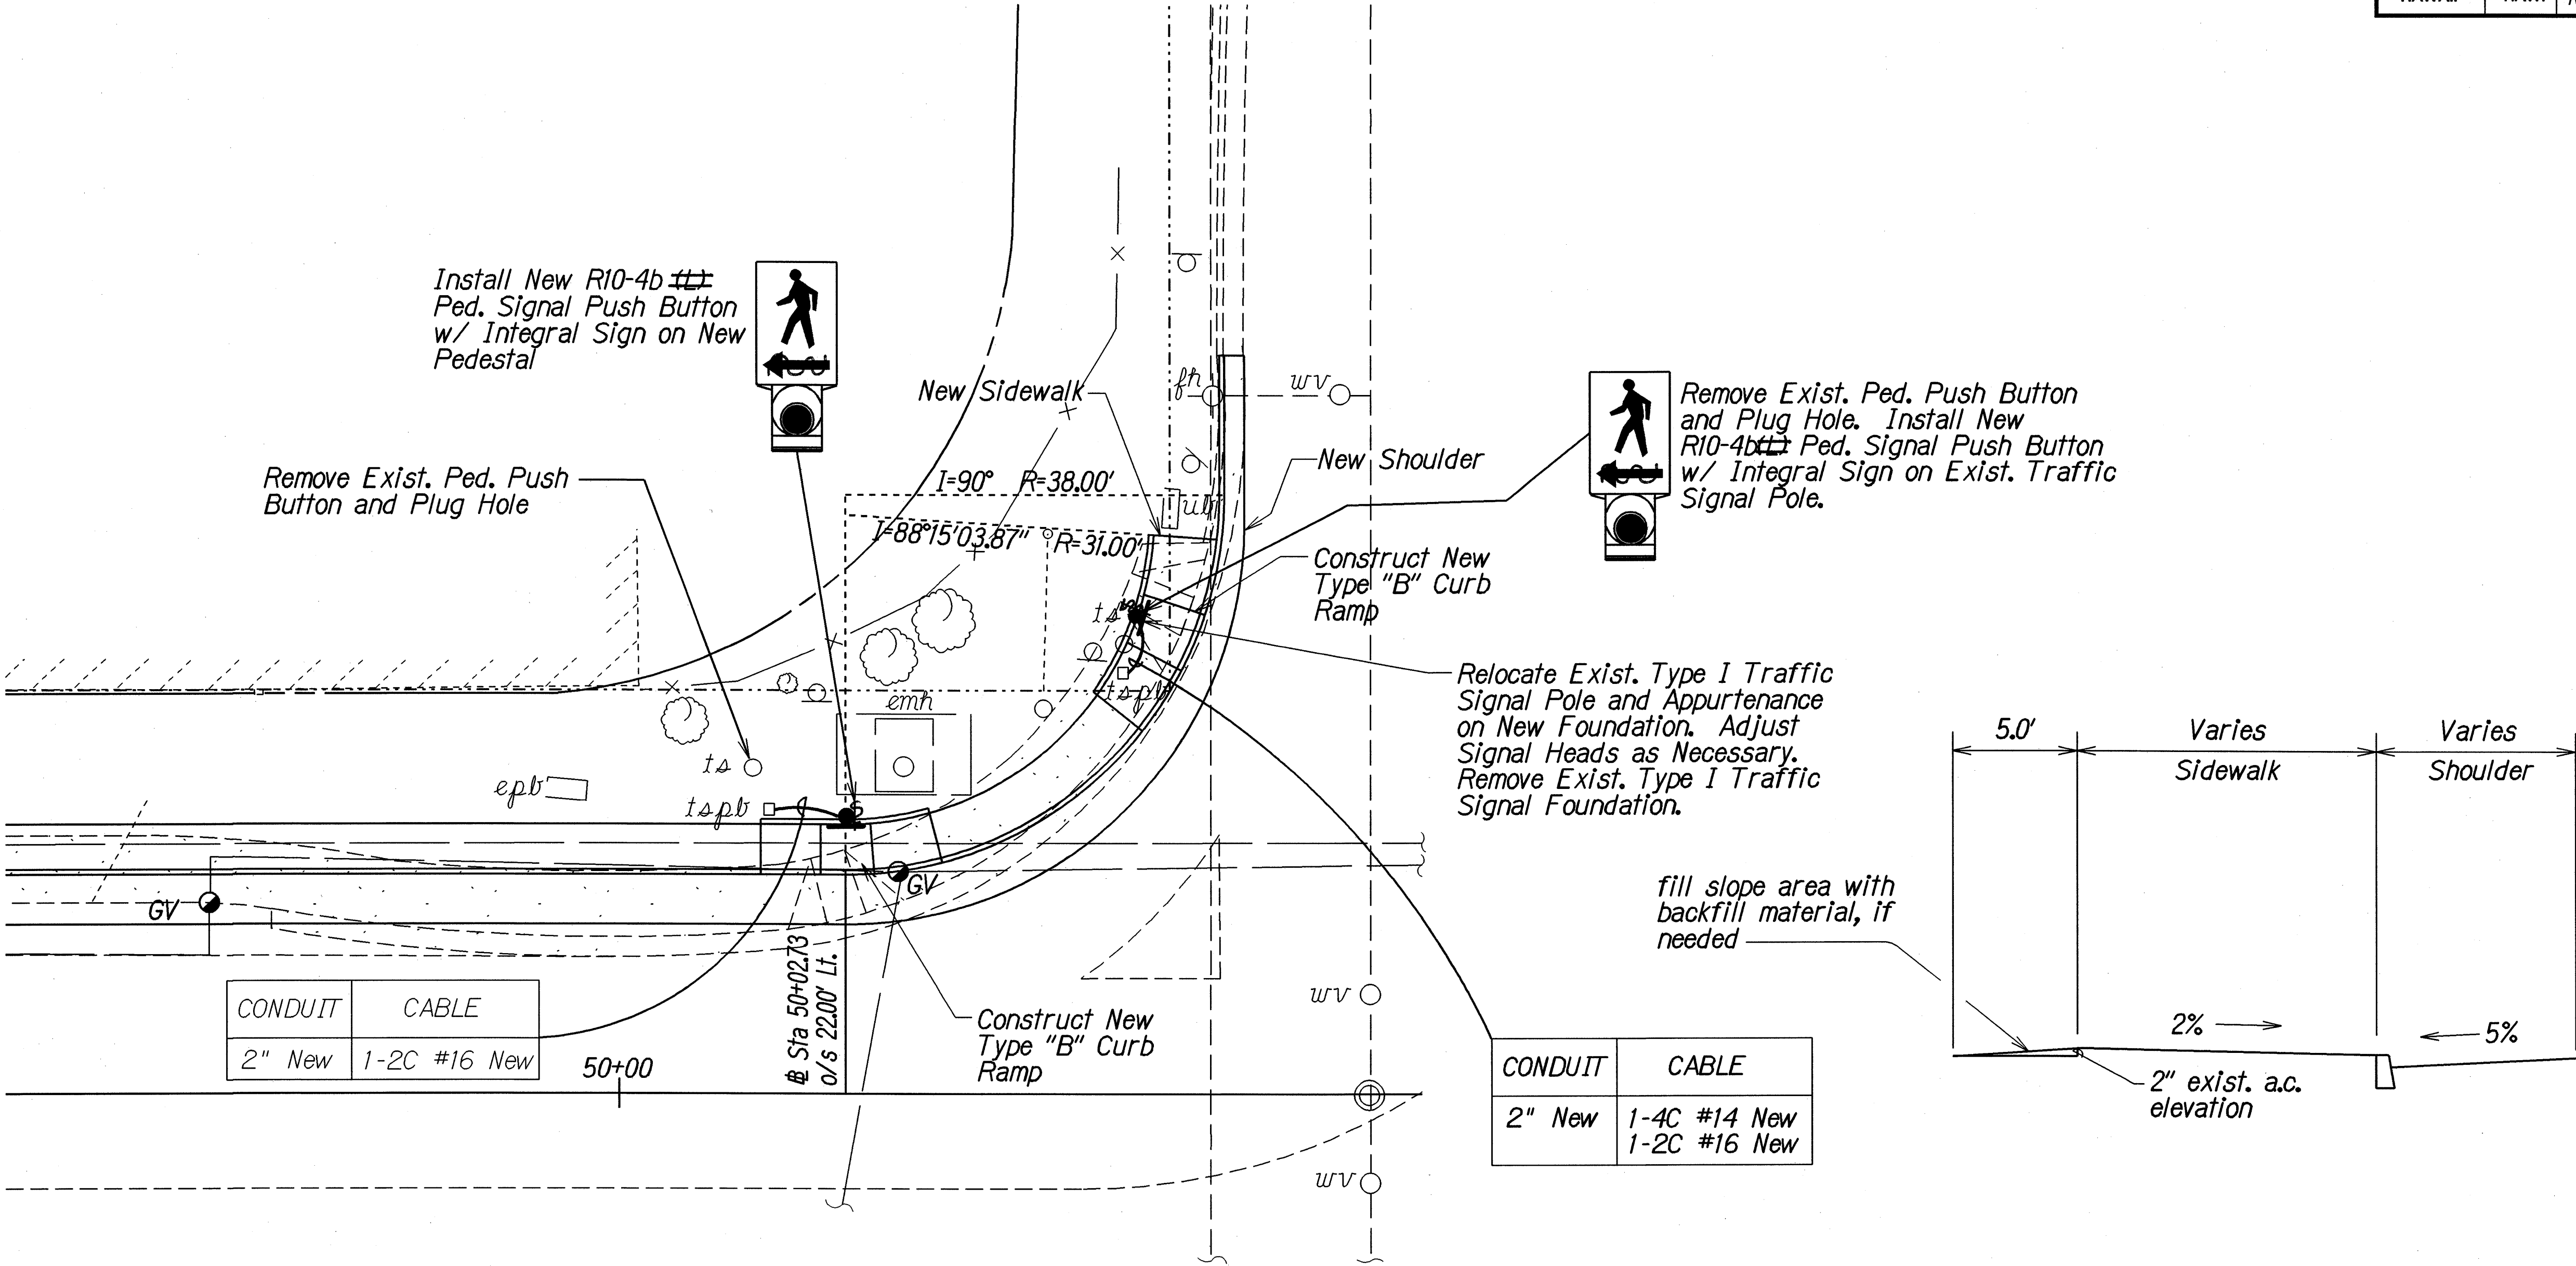

KAMEHAMEHA AVE./BANYAN DRIVE
INTERSECTION DETAIL
Scale: 1"=10.0'

TYPICAL SECTION
FOR NEW SIDEWALK AT BANYAN DR. INTERSECTION
Not To Scale


DATE	12/20/01
SURVEY PLOTTED BY	MO. L.
DRAWN BY	MO. L.
DESIGNED BY	MO. L.
CHECKED BY	MO. L.
APPROVED BY	MO. L.
NOTED BY	MO. L.
ORIGINAL PLAN	NO. 1000000000

12/17/01	Revise Pedestrian Push Buttons
DATE	REVISION
STATE OF HAWAII DEPARTMENT OF TRANSPORTATION HIGHWAYS DIVISION	
TYPICAL SECTION AND MISCELLANEOUS DETAIL	
KAMEHAMEHA AVENUE BIKEWAY IMPROVEMENTS	
Hilo Bayfront Highway to Kalanianaʻole Avenue	
Federal Aid Project No. NH-019-2(54)	
Scale: As Shown	Date: April, 2001
SHEET No. 2 OF 2 SHEETS	

"AS-BUILT"

ADD 10

FED. ROAD DIST. NO.	STATE	FED. AID PROJ. NO.	FISCAL YEAR	SHEET NO.	TOTAL SHEETS
HAWAII	HAW.	NH-019-2(54)	2001	ADD. 29	30

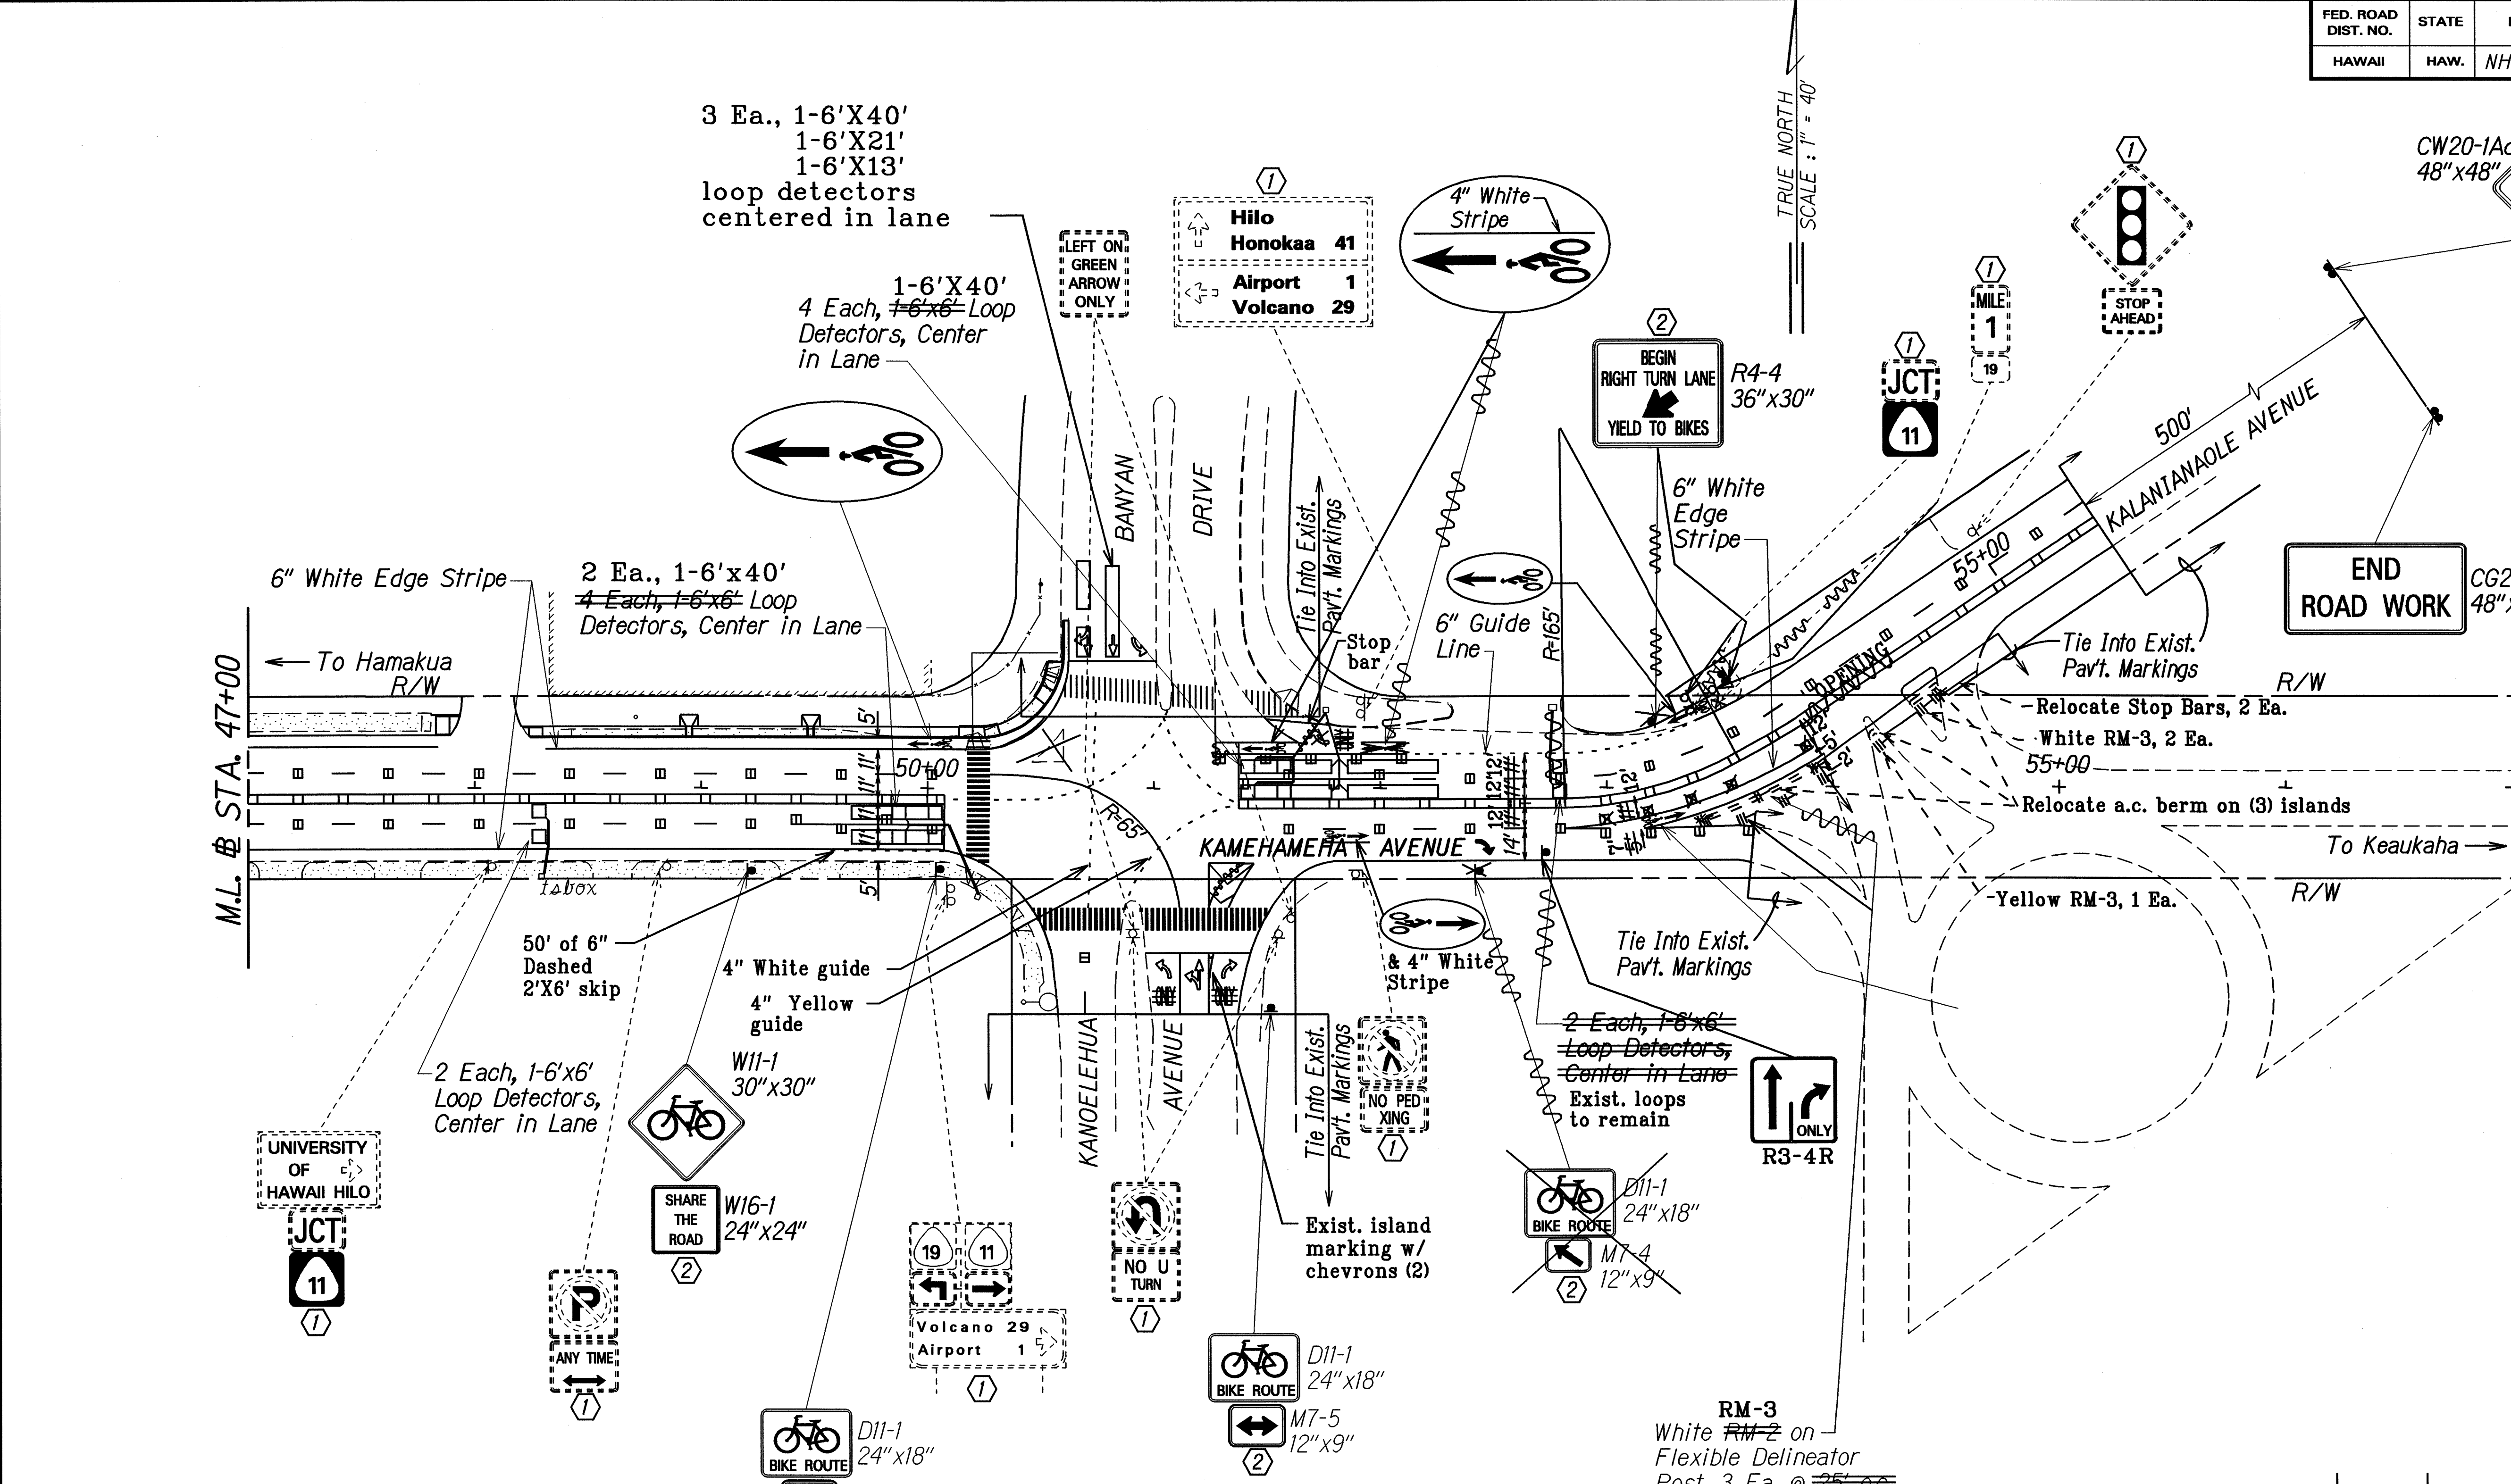

NOTE: Prior to installing new 6'x6' Loop Detectors, all existing loop detector cables shall be removed and roadway will be resealed. Tie new cables into existing system and make all necessary connections. This removal, resealing and tie-in work shall be considered incidental to Item No. 623.7051 Loop Detector Sensing Unit (6'x6') One Loop.

- KEY:
- ① Exist. Sign(s) & Post(s) to Remain
 - ② Install New Sign(s) w/Post(s)

LEGEND FOR AS-BUILT POSTINGS	
	Squiggly line for as-built deletion
	Double line for as-built deletion
Roadway	Text for as-built posting

12/21/01	Added New Loop Detectors to the Plans
DATE	REVISION
STATE OF HAWAII DEPARTMENT OF TRANSPORTATION HIGHWAYS DIVISION	
PAVEMENT MARKING & SIGNING PLAN	
KAMEHAMEHA AVE. BIKEWAY IMPROVEMENTS	
Hilo Bayfront Hwy. to Kalanianaʻole Ave.	
Federal Aid Project No. NH-019-2(54)	
Scale: 1"=40'	Date: July, 2001
SHEET No. T4 OF 5 SHEETS	

SURVEY PLOTTED BY	DATE
DRAWN BY	
DESIGNED BY	
CHECKED BY	
ORIGINAL PLAN	
NOTE BOOK	
FILED	
DATE	
BY	

AS-BUILT

ADD. 29