


FED. ROAD DIST. NO.	STATE	FED. AID PROJ. NO.	FISCAL YEAR	SHEET NO.	TOTAL SHEETS
HAWAII	HAW.	NH-019-2(54)	2000	19	30

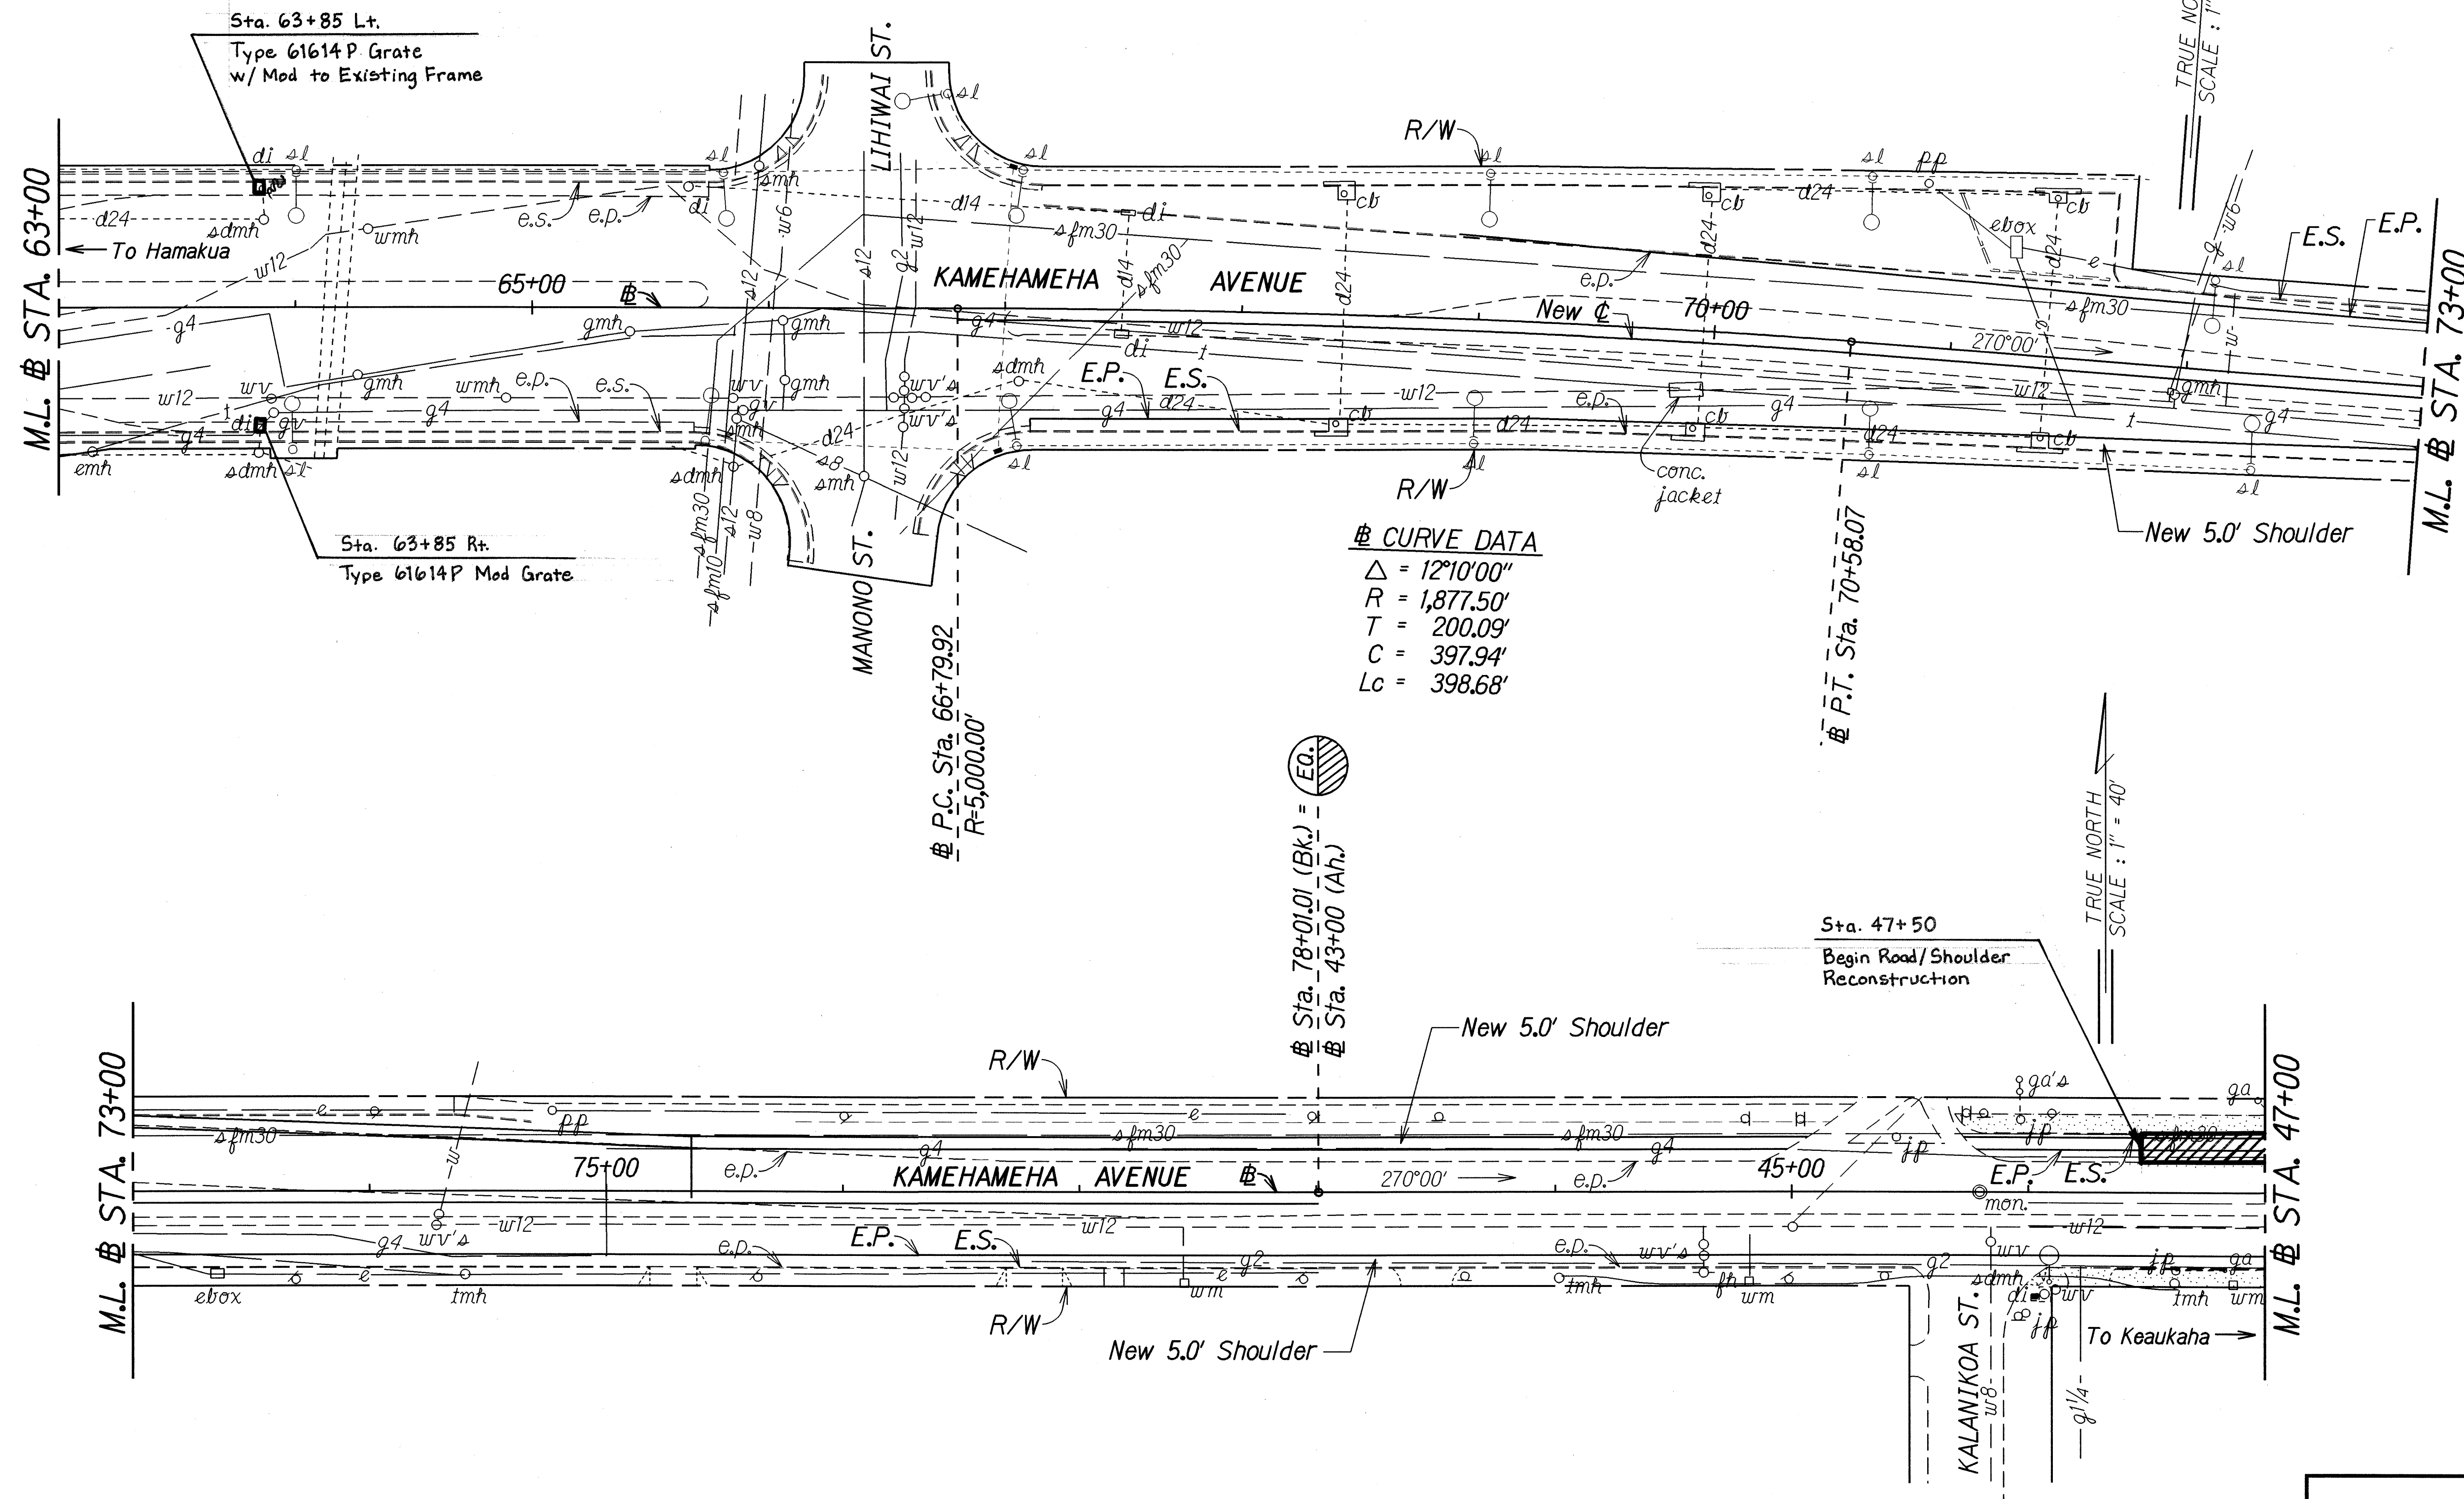

ORIGINAL PLAN	DATE	5/18/00
DESIGNED BY	DESIGNED BY	
NOTED BY	NOTED BY	
CHECKED BY	CHECKED BY	

STATE OF HAWAII
DEPARTMENT OF TRANSPORTATION
HIGHWAYS DIVISION


ROADWAY PLAN
KAMEHAMEHA AVENUE
BIKEWAY IMPROVEMENTS
 Hilo Bayfront Highway to Kalanianaʻahele Avenue
 Federal Aid Project No. NH-019-2(54)

Scale: 1"=40' Date: April, 2001

SHEET No. 2 OF 3 SHEETS

"AS-BUILT"

FED. ROAD DIST. NO.	STATE	FED. AID PROJ. NO.	FISCAL YEAR	SHEET NO.	TOTAL SHEETS
HAWAII	HAW.	NH-019-2(54)	2001	20	30

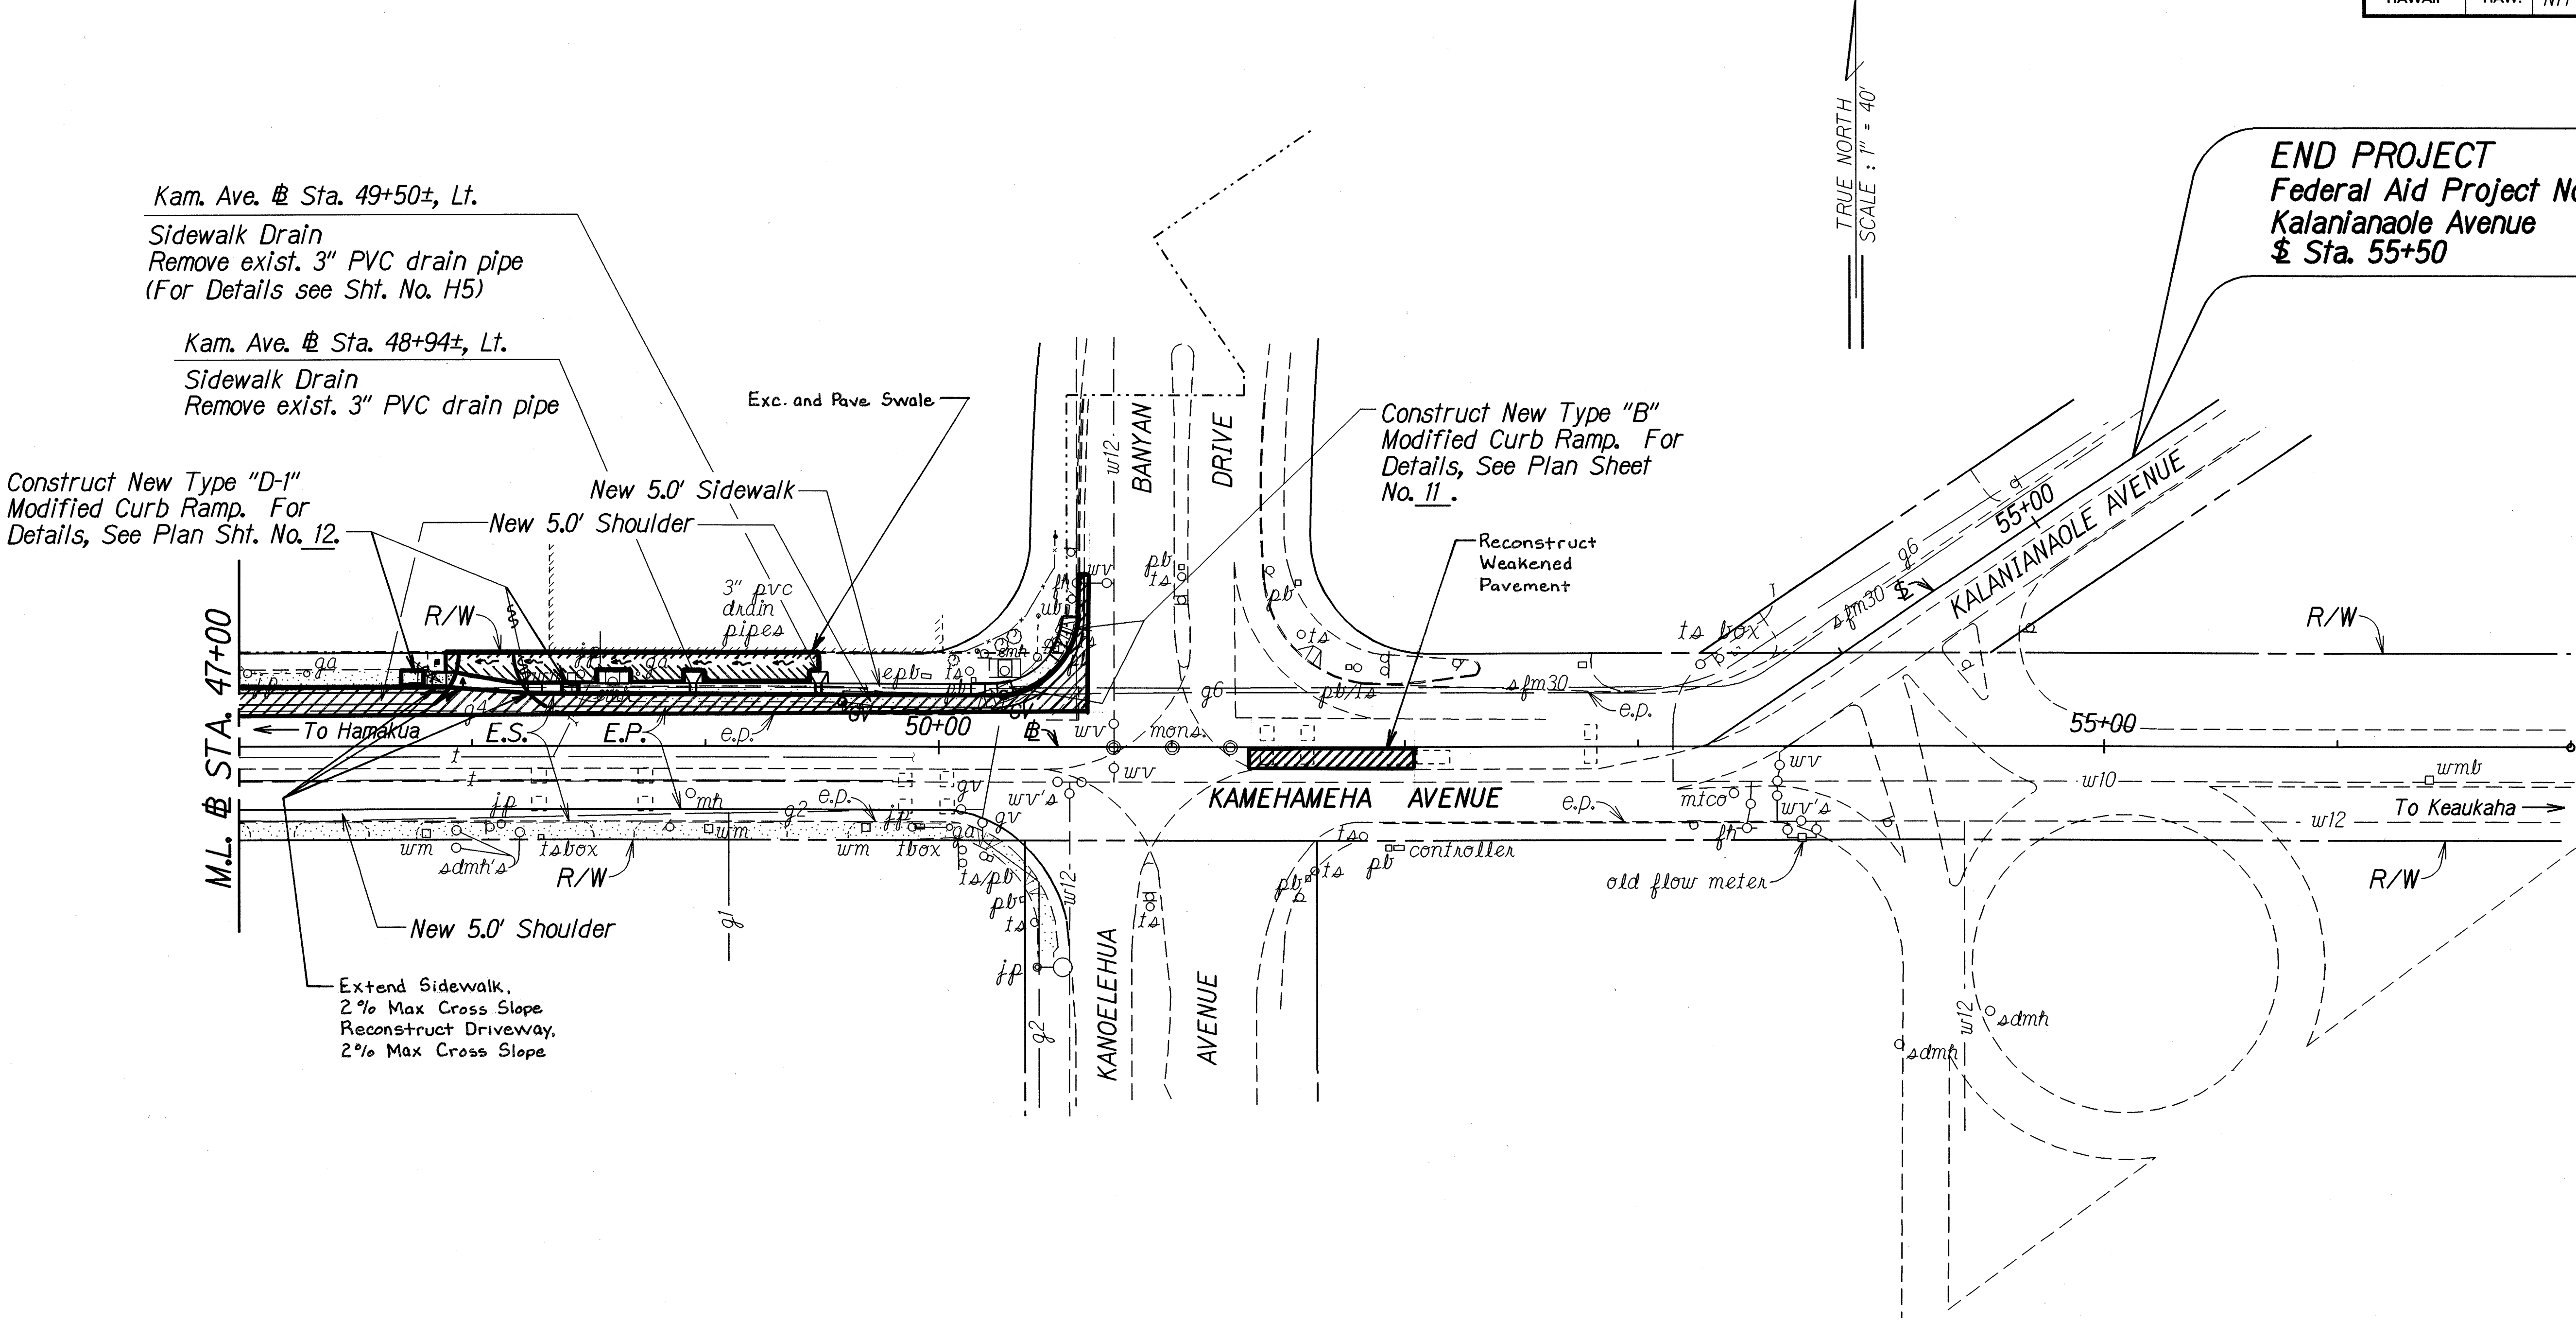

END PROJECT
Federal Aid Project No. NH-019-2(54)
Kalanianaʻole Avenue
Sta. 55+00

Kam. Ave. Sta. 49+50±, Lt.
Sidewalk Drain
Remove exist. 3" PVC drain pipe
(For Details see Sht. No. H5)

Kam. Ave. Sta. 48+94±, Lt.
Sidewalk Drain
Remove exist. 3" PVC drain pipe

Construct New Type "D-1"
Modified Curb Ramp. For
Details, See Plan Sht. No. 12.

Construct New Type "B"
Modified Curb Ramp. For
Details, See Plan Sheet
No. 11.

Reconstruct
Weakened
Pavement

Extend Sidewalk.
2% Max Cross Slope
Reconstruct Driveway.
2% Max Cross Slope

SURVEY PLOTTED BY	DATE
DRAWN BY	12/28/00
DESIGNED BY	
QUANTITIES BY	
CHECKED BY	
ORIGINAL PLAN	
NOTE BOOK	
DESIGNED BY	
QUANTITIES BY	
CHECKED BY	

STATE OF HAWAII
DEPARTMENT OF TRANSPORTATION
HIGHWAYS DIVISION

ROADWAY PLAN

KAMEHAMEHA AVENUE

BIKEWAY IMPROVEMENTS

Hilo Bayfront Highway to Kalanianaʻole Avenue

Federal Aid Project No. NH-019-2(54)

Scale: 1"=40'

Date: April, 2001

SHEET No. 3 OF 3 SHEETS

"AS-BUILT"