



FED. ROAD DIST. NO.	STATE	FED. AID PROJ. NO.	FISCAL YEAR	SHEET NO.	TOTAL SHEETS
HAWAII	HAW.	NH-019-2(54)	2001	6	30

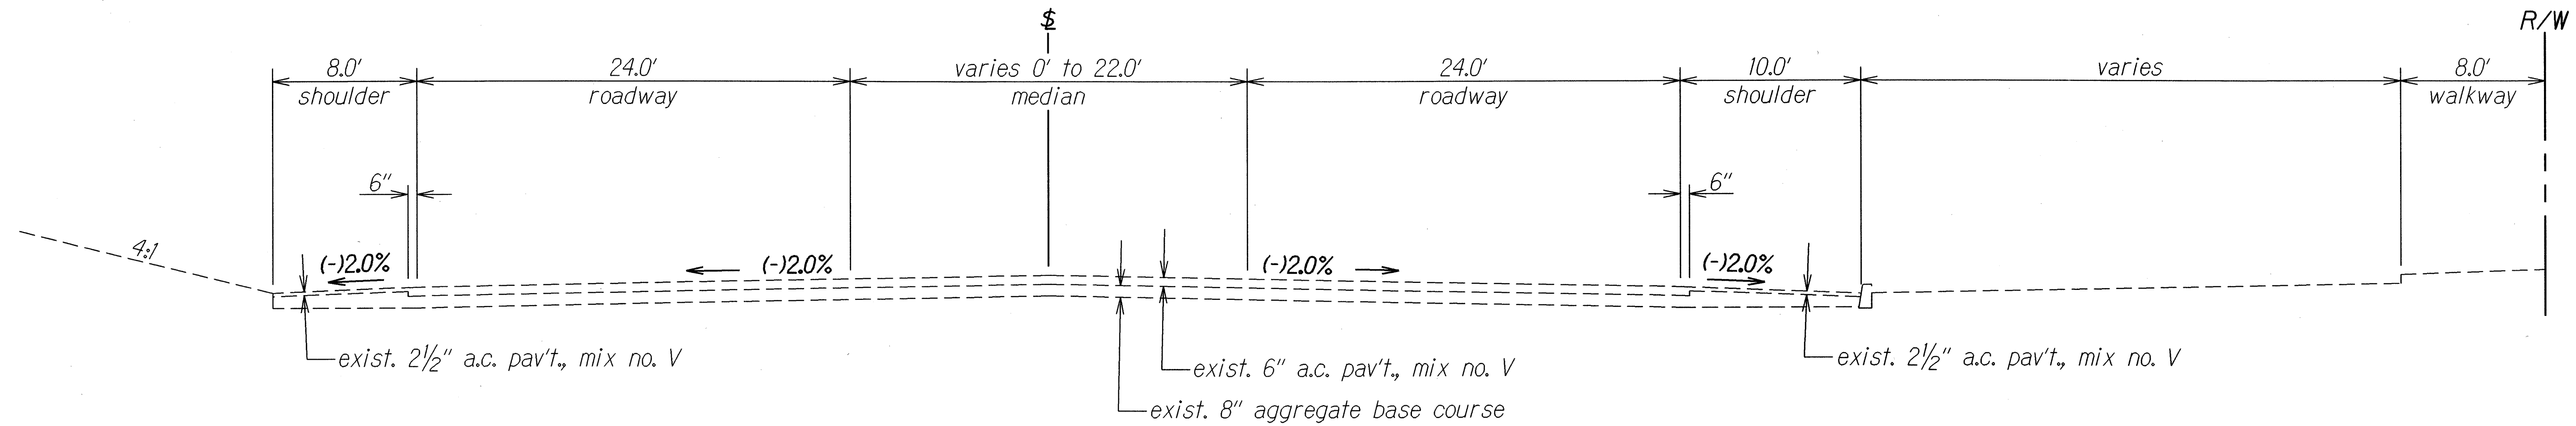

TYPICAL SECTION
KAMEHAMEHA AVENUE
± STA. 20+00 TO ± STA. 29+79.22
 Scale: 1"=5.0'

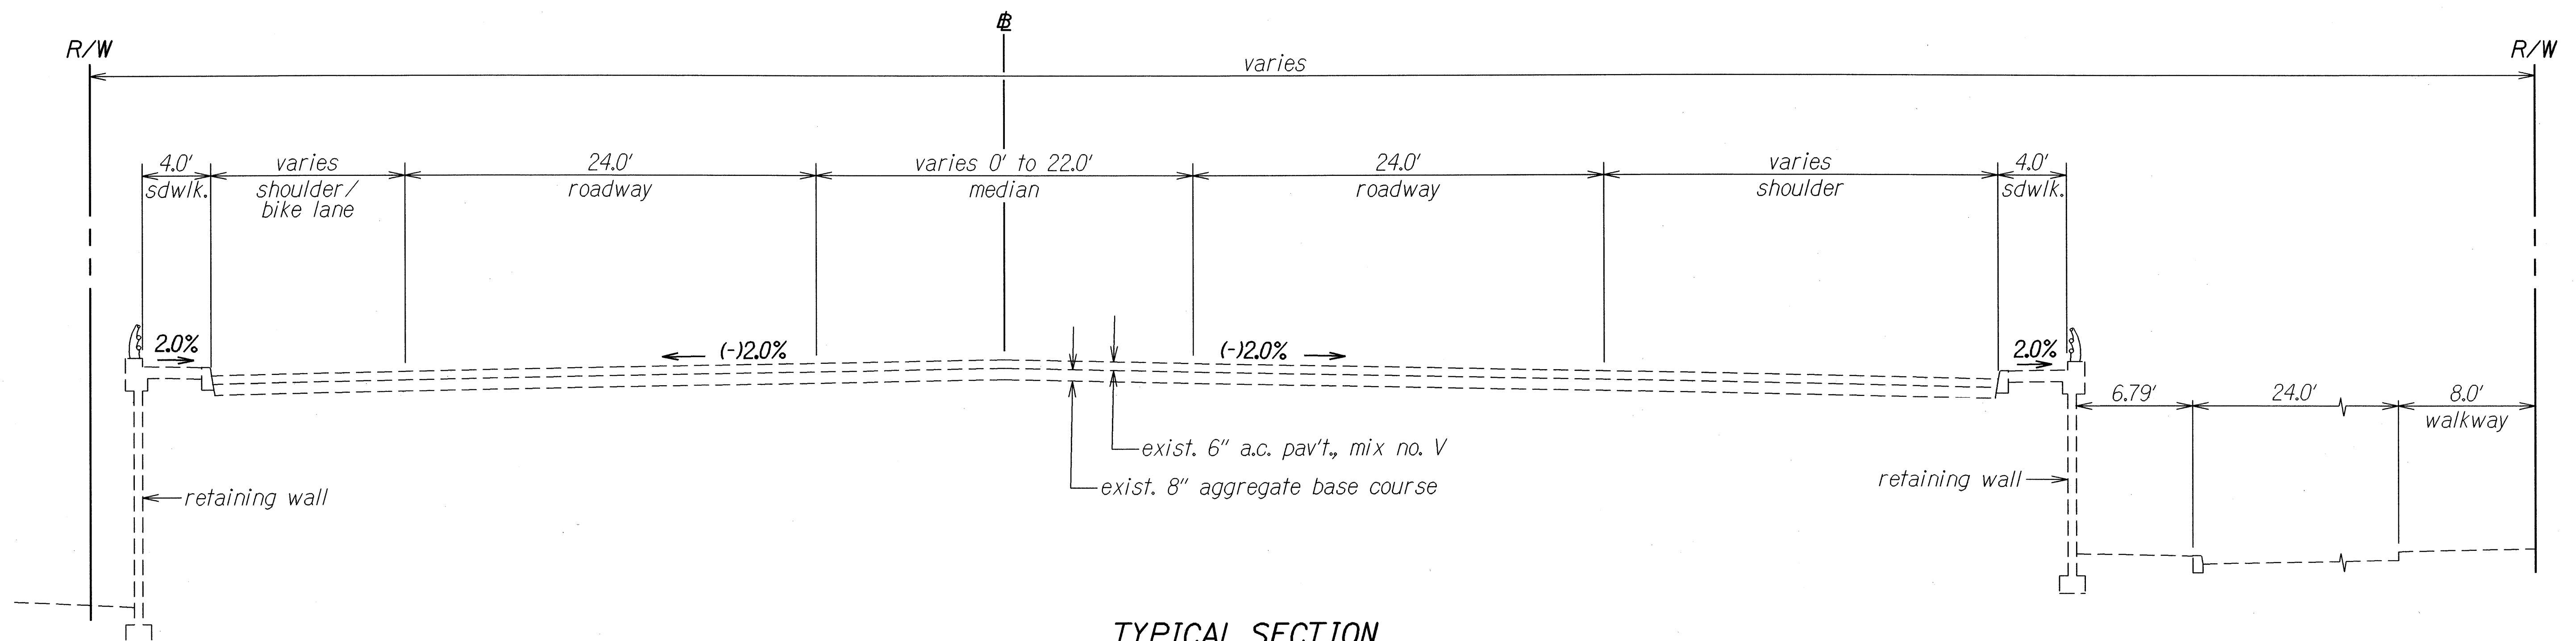

TYPICAL SECTION
BRIDGE APPROACH, WEST END
 Scale: 1"=5.0'

SURVEY PLOTTED BY	DATE
DESIGNED BY	4/19/01
DESIGNED BY	
QUANTITIES BY	
CHECKED BY	
ORIGINAL PLAN	
NOTE BOOK	
DATE	
BY	

STATE OF HAWAII
 DEPARTMENT OF TRANSPORTATION
 HIGHWAYS DIVISION

TYPICAL SECTIONS

KAMEHAMEHA AVE. BIKEWAY IMPROVEMENTS


Hilo Bayfront Highway to Kalanianaʻaʻole Avenue

Federal Aid Project No. NH-019-2(54)


Scale: 1"=5.0' Date: April, 2001

SHEET No. 1 OF 3 SHEETS

FED. ROAD DIST. NO.	STATE	FED. AID PROJ. NO.	FISCAL YEAR	SHEET NO.	TOTAL SHEETS
HAWAII	HAW.	NH-019-2(54)	2001	7	30

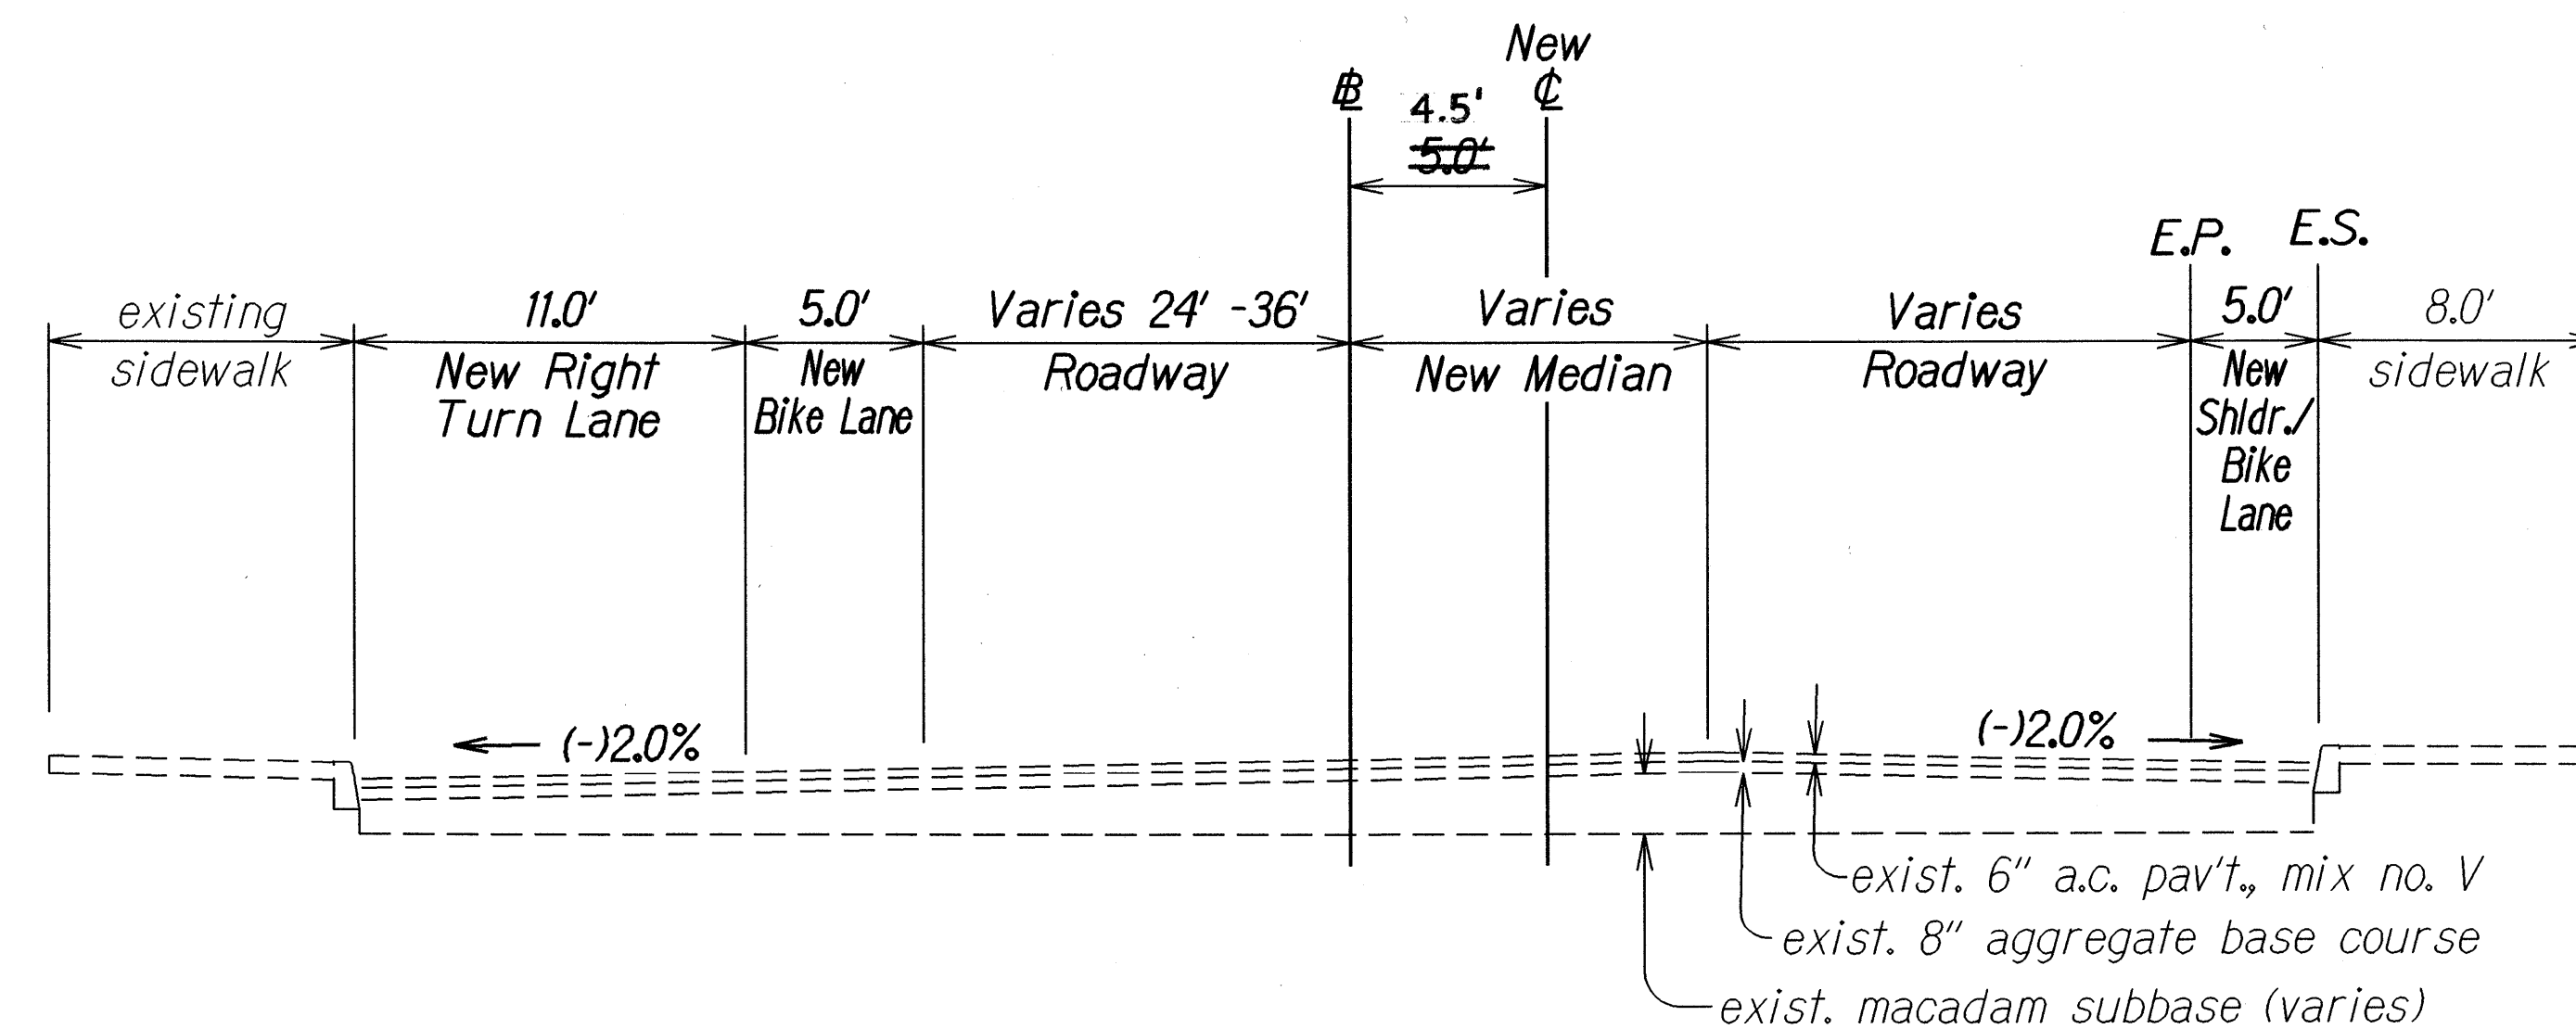

TYPICAL SECTION
KAMEHAMEHA AVENUE
STA. 67+00± TO # STA. 69+08±
Not To Scale

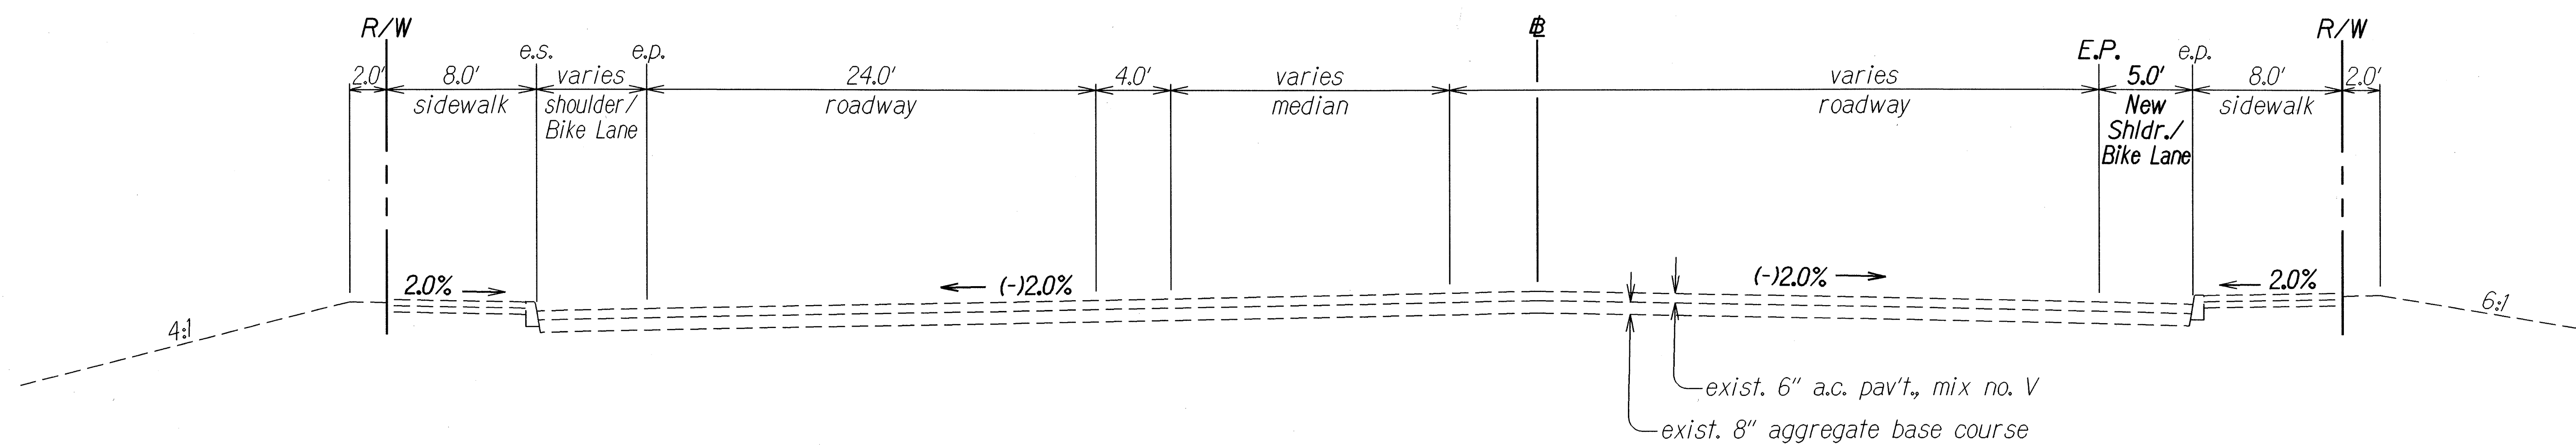

TYPICAL SECTION
KAMEHAMEHA AVENUE
STA. 69+08± TO # STA. 74+65±
Scale: 1"=5.0'

ORIGINAL PLAN	SURVEY PLOTTED BY _____ DATE <u>4/19/00</u>
NOTE BOOK	DRAWN BY <u>L. Howells</u>
<u>add 3 km</u>	TRACED BY _____
<u>1 km dist 2</u>	DESIGNED BY <u>L. Murashige</u>
	QUANTITIES BY _____
	CHECKED BY _____

STATE OF HAWAII
DEPARTMENT OF TRANSPORTATION
HIGHWAYS DIVISION

TYPICAL SECTIONS


KAMEHAMEHA AVE. BIKEWAY
IMPROVEMENTS

Hilo Bayfront Highway to Kalanianaʻaʻole Avenue
Federal Aid Project No. NH-019-2(54)


Scale: 1"=5.0' Date: April, 2001

SHEET No. 2 OF 3 SHEETS

FED. ROAD DIST. NO.	STATE	FED. AID PROJ. NO.	FISCAL YEAR	SHEET NO.	TOTAL SHEETS
HAWAII	HAW.	NH-019-2(54)	2001	8	30

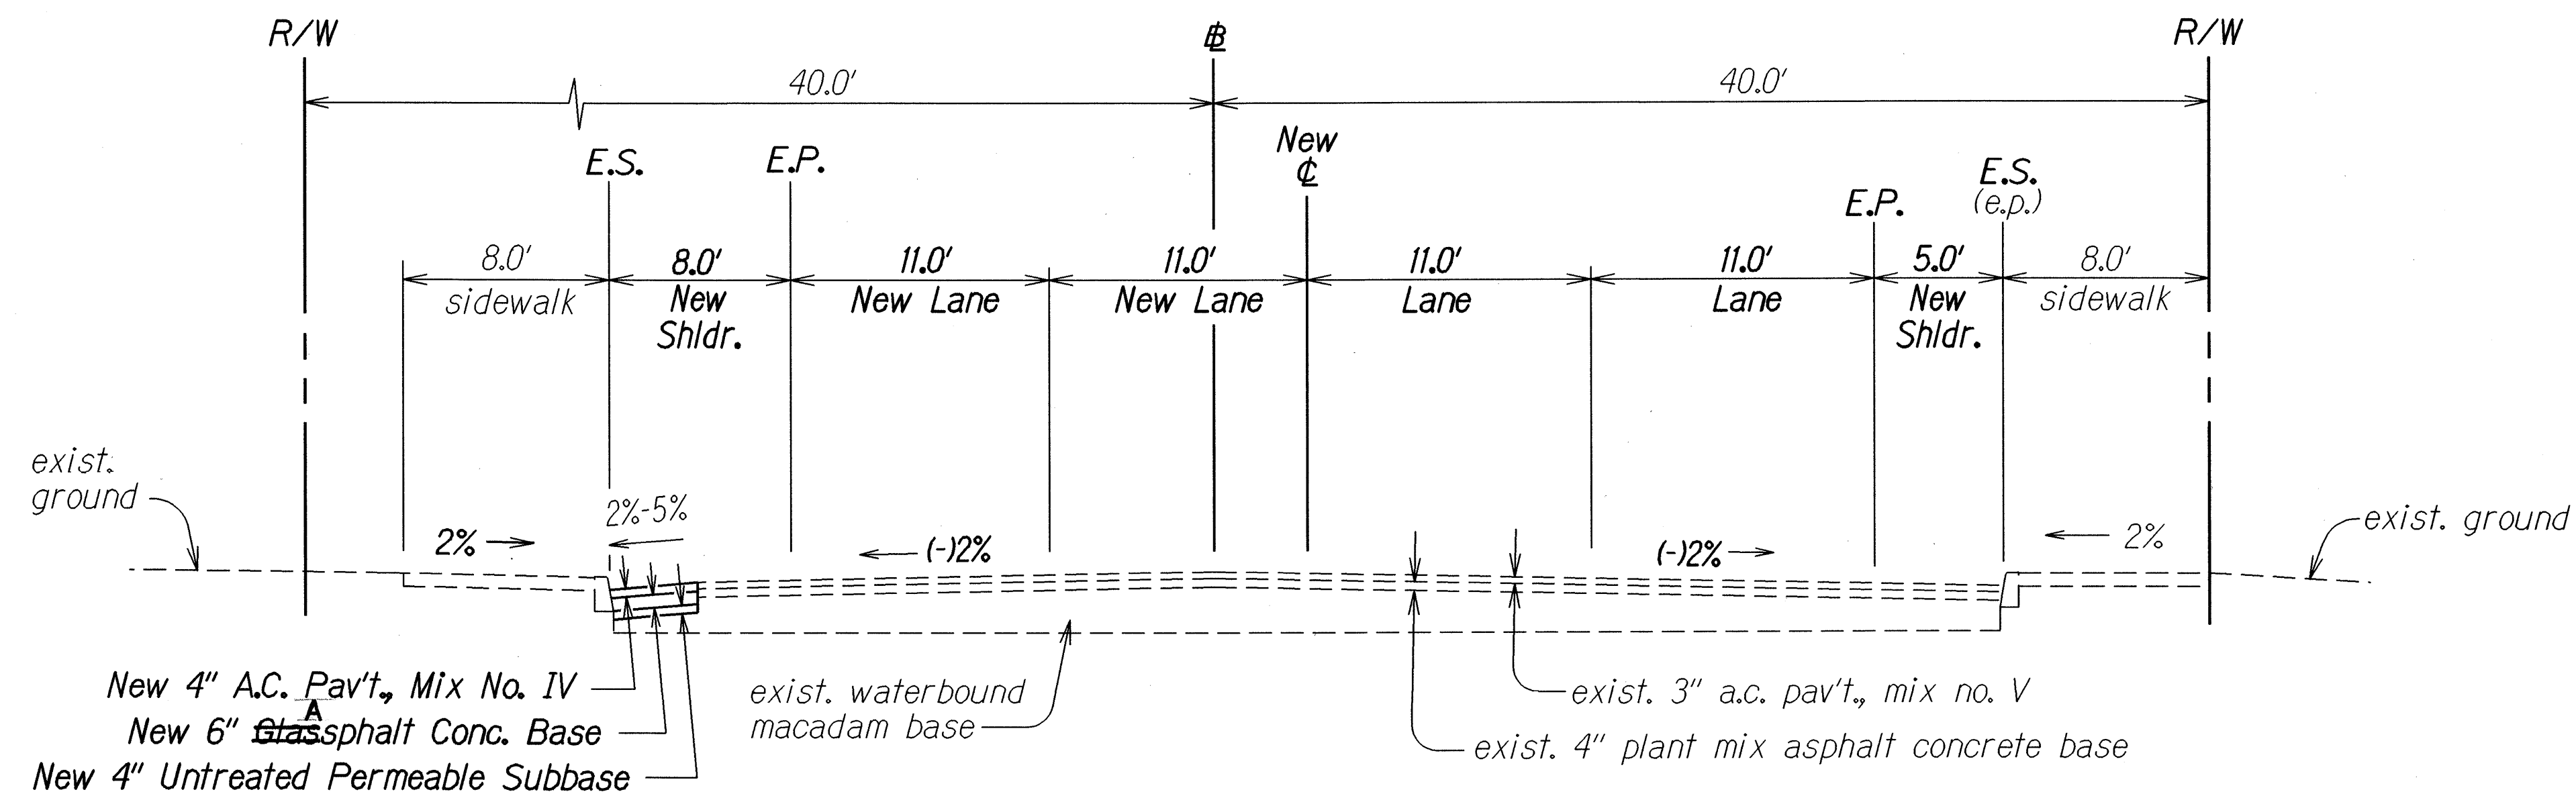

TYPICAL SECTION
KAMEHAMEHA AVE.
ℳ STA. 45+70± to ℳ STA. 47+88±
Not To Scale

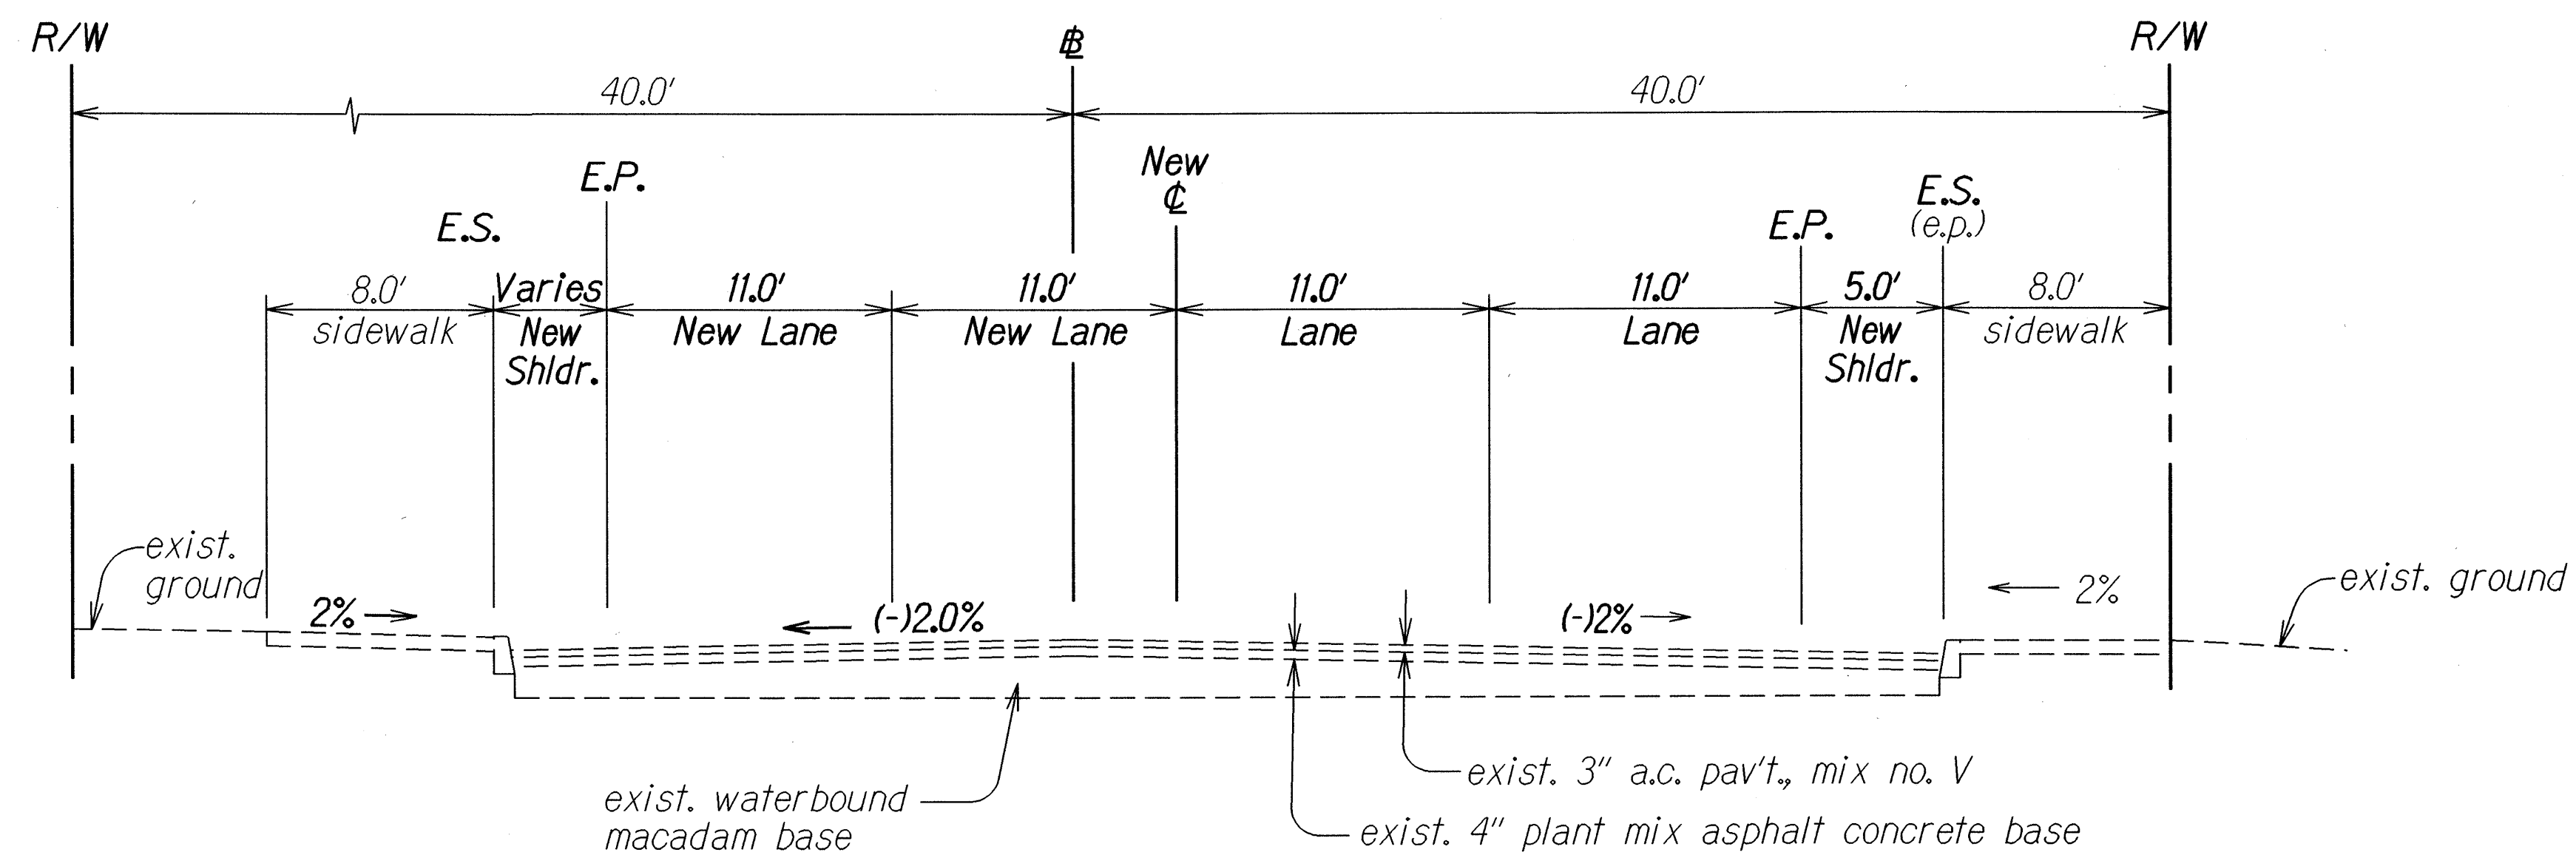

TYPICAL SECTION
KAMEHAMEHA AVE. - @ STA. 74+65± TO @ STA. 45+70±
Not To Scale

ORIGINAL PLAN	SURVEY PLOTTED BY _____ DATE _____
	DRAWN BY <i>L. Howells</i> _____ DATE <i>4/19/00</i> _____
	TRACED BY _____
NOTE BOOK	DESIGNED BY <i>L. Murashige</i> _____
<i>add.kml</i>	QUANTITIES BY _____
<i>lkmad3</i>	CHECKED BY _____

STATE OF HAWAII
DEPARTMENT OF TRANSPORTATION
HIGHWAYS DIVISION

TYPICAL SECTIONS

KAMEHAMEHA AVE. BIKEWAY
IMPROVEMENTS

Hilo Bayfront Highway to Kalaiananale Avenue
Federal Aid Project No. NH-019-2(54)

Scale: 1"=50' Date: April, 2001

SHEET No. 3 OF 3 SHEETS