



FED. ROAD DIST. NO.	STATE	FED. AID PROJ. NO.	FISCAL YEAR	SHEET NO.	TOTAL SHEETS
HAWAII	HAW.	BR-019-2(44)	1998	11	61

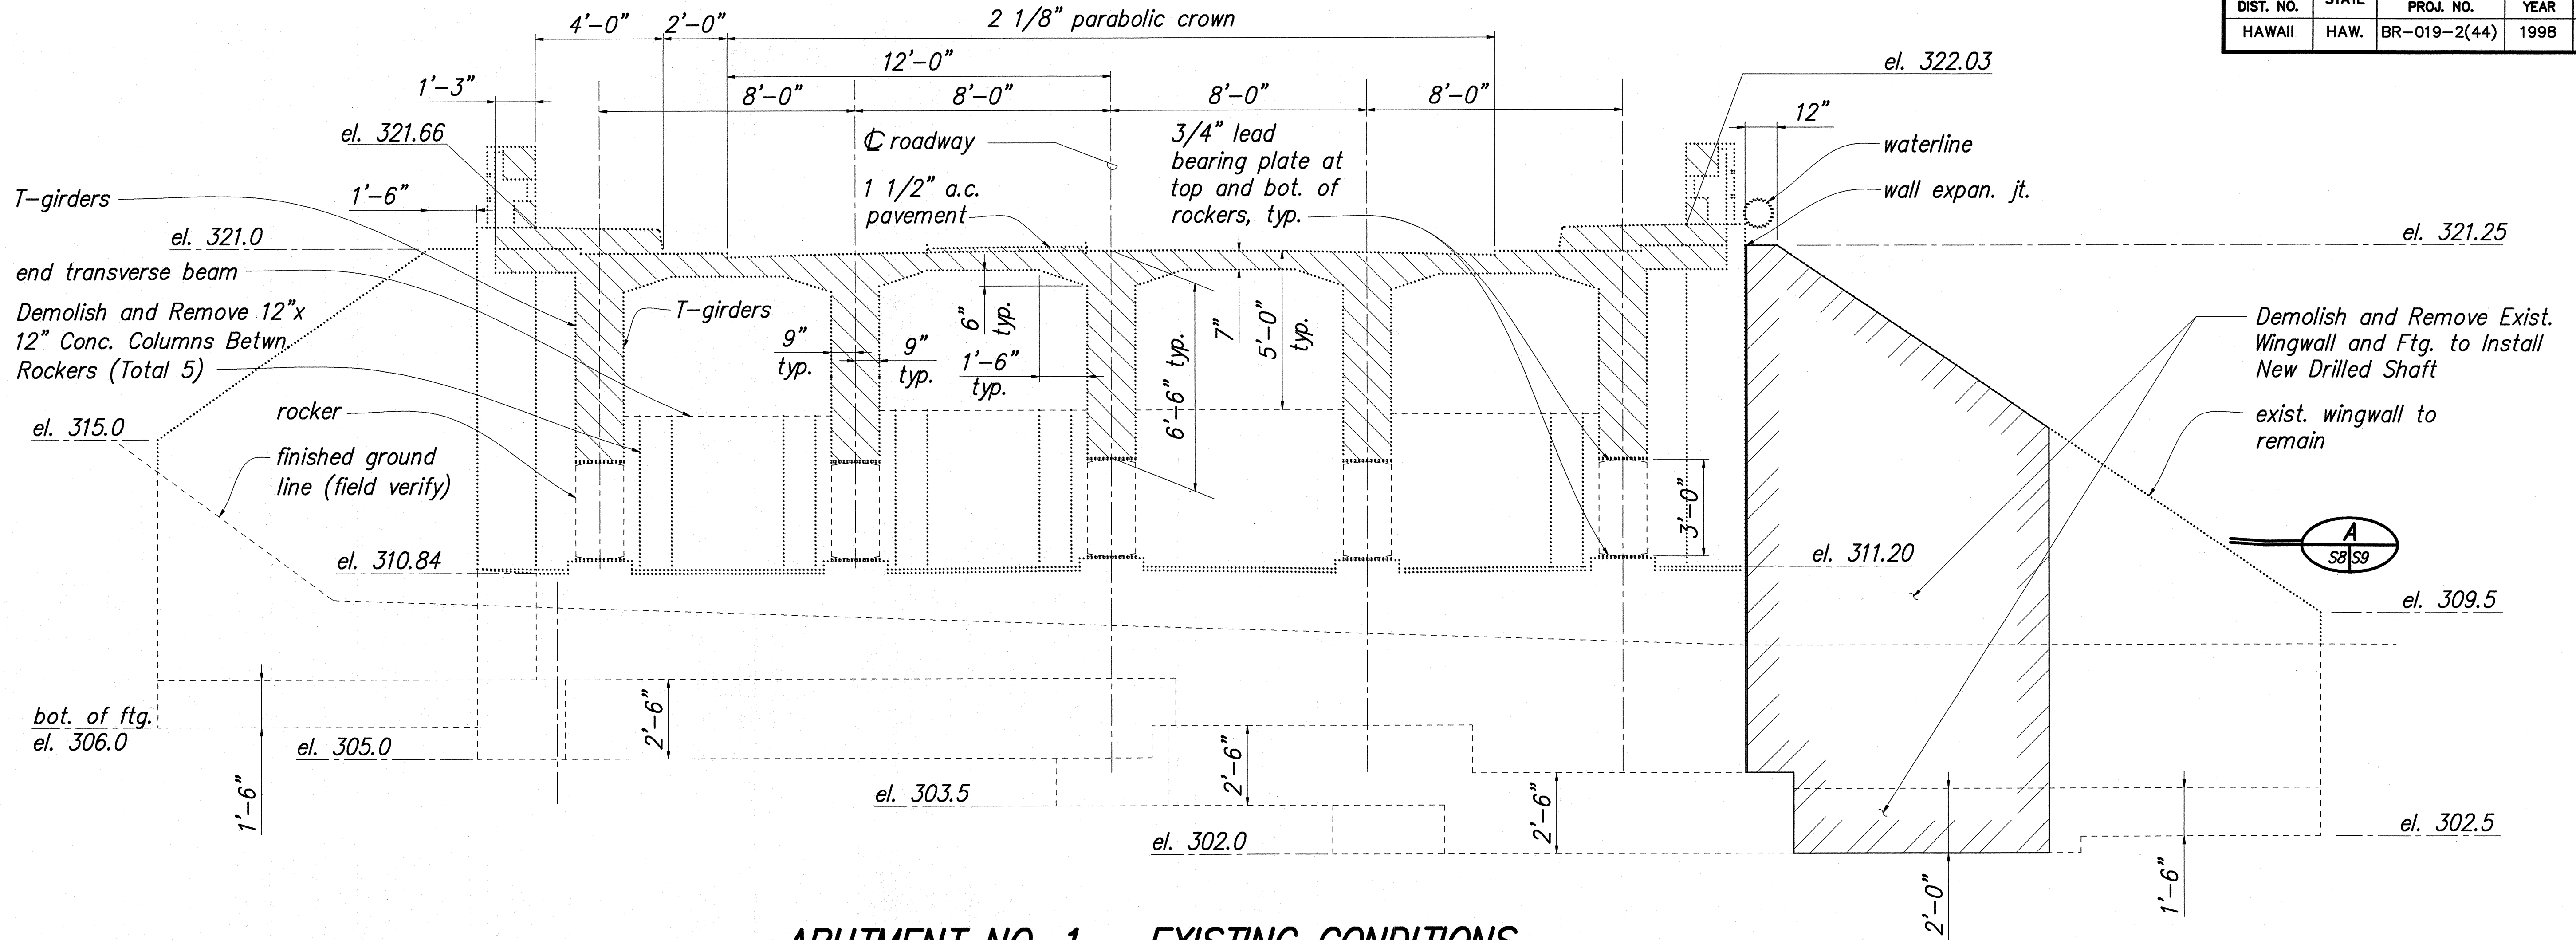

ABUTMENT NO. 1 – EXISTING CONDITIONS
NORMAL TO GIRDERS ELEVATION
 SCALE: 3/8"=1'-0"

ORIGINAL PLAN	SURVEY PLOTTED BY	DATE
NOTE BOOK	DRAWN BY	"
No.	DESIGNED BY	"
	QUANTITIES BY	"
	CHECKED BY	"

MAY 28 1998

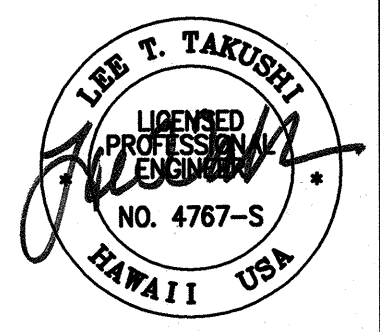


STATE OF HAWAII
 DEPARTMENT OF TRANSPORTATION
 HIGHWAYS DIVISION

MOANALULU BRIDGE
ABUTMENT NO. 1
EXISTING CONDITIONS ELEVATION

 HAWAII BELT ROAD, SEISMIC RETROFIT OF VARIOUS BRIDGES,
 VICINITY OF LAUPAHOEHOE
 FEDERAL AID PROJECT NO. BR-019-2(44)
 SCALE: AS NOTED DATE: APRIL 1998

 SHEET No. S8 OF 58 SHEETS


FED. ROAD DIST. NO.	STATE	FED. AID PROJ. NO.	FISCAL YEAR	SHEET NO.	TOTAL SHEETS
HAWAII	HAW.	BR-019-2(44)	1998	12	61

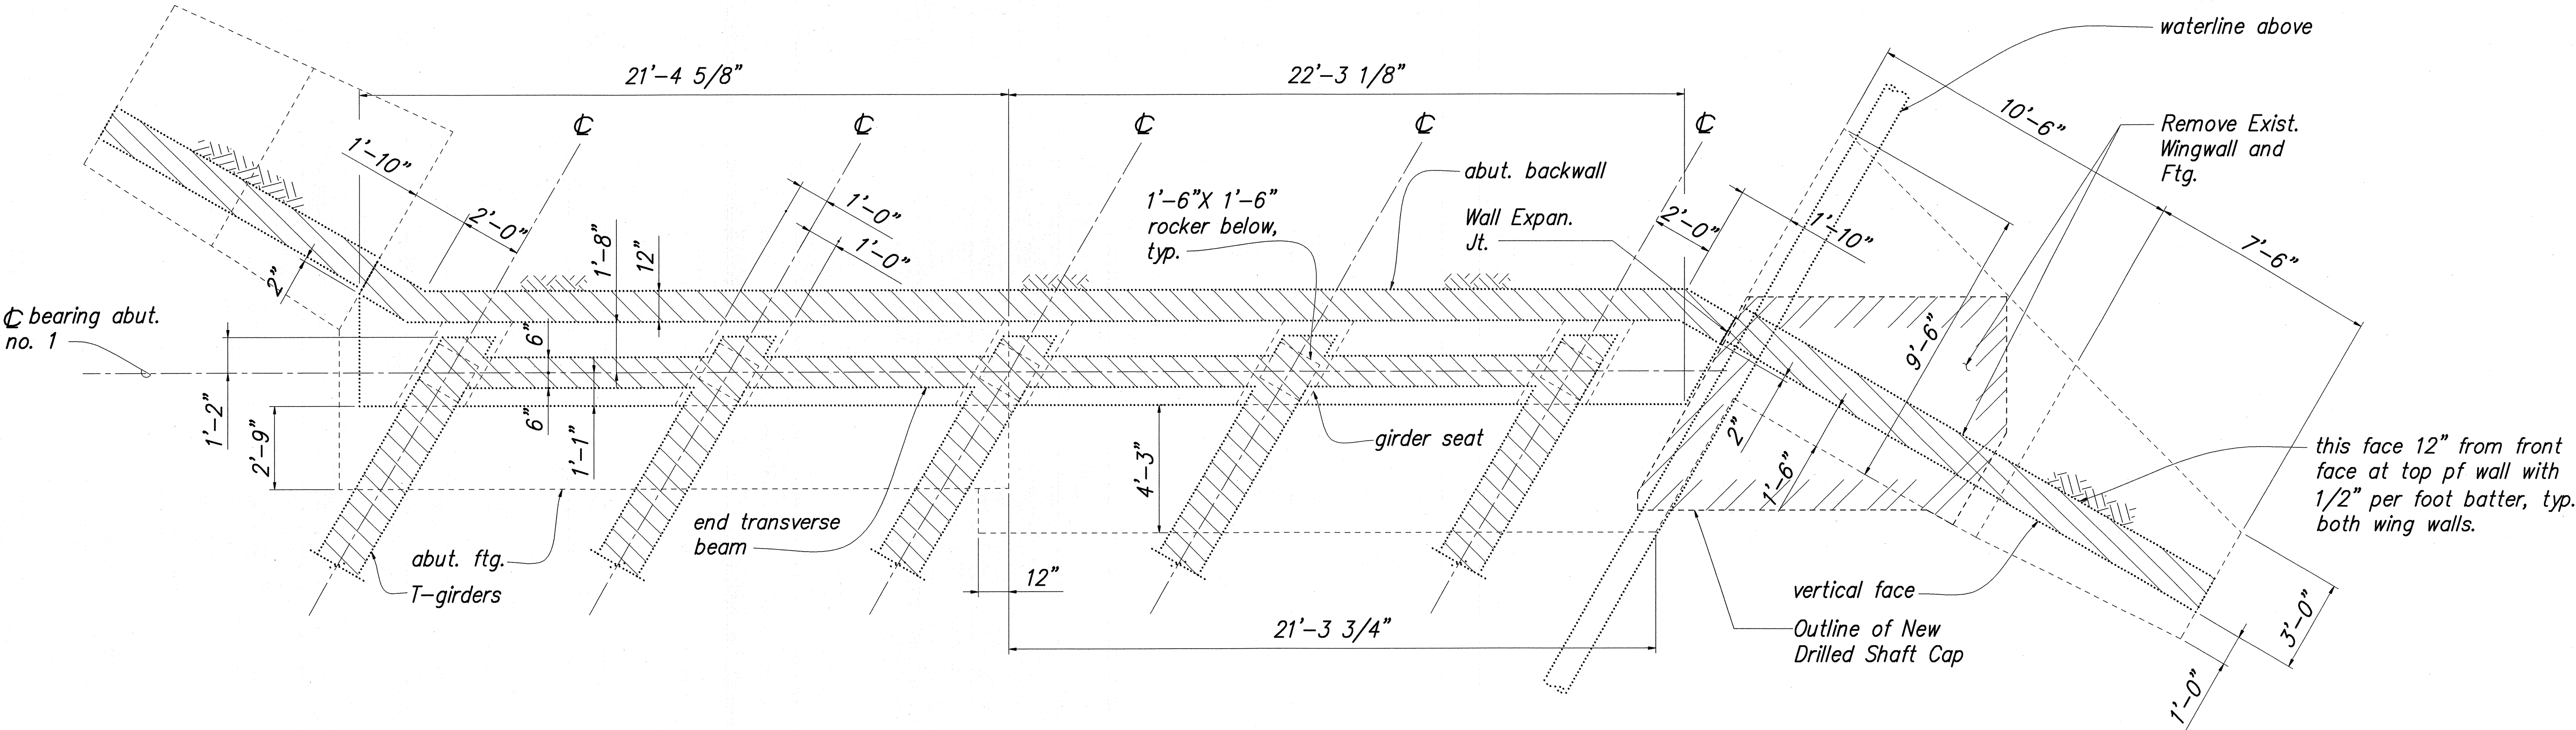

ABUTMENT NO. 1
EXISTING CONDITIONS – SECTION PLAN
SCALE: 3/8"=1'-0"
A
S8 S9

ORIGINAL PLAN	SURVEY PLOTTED BY	DATE
NOTE BOOK	DRAWN BY	"
No.	DESIGNED BY	"
	QUANTITIES BY	"
	CHECKED BY	"

1997\9702000\DWG\DET1\97020039.DWG 05/22/98 09:41 CEC

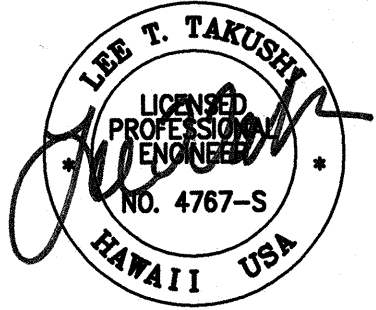


STATE OF HAWAII
DEPARTMENT OF TRANSPORTATION
HIGHWAYS DIVISION

MOANALULU BRIDGE
ABUTMENT NO. 1
EXISTING CONDITIONS SECTION

HAWAII BELT ROAD, SEISMIC RETROFIT OF VARIOUS BRIDGES,
VICINITY OF LAUPAHOEHOE
FEDERAL AID PROJECT NO. BR-019-2(44)
SCALE: AS NOTED DATE: APRIL 1998


FED. ROAD DIST. NO.	STATE	FED. AID PROJ. NO.	FISCAL YEAR	SHEET NO.	TOTAL SHEETS
HAWAII	HAW.	BR-019-2(44)	1998	15	61

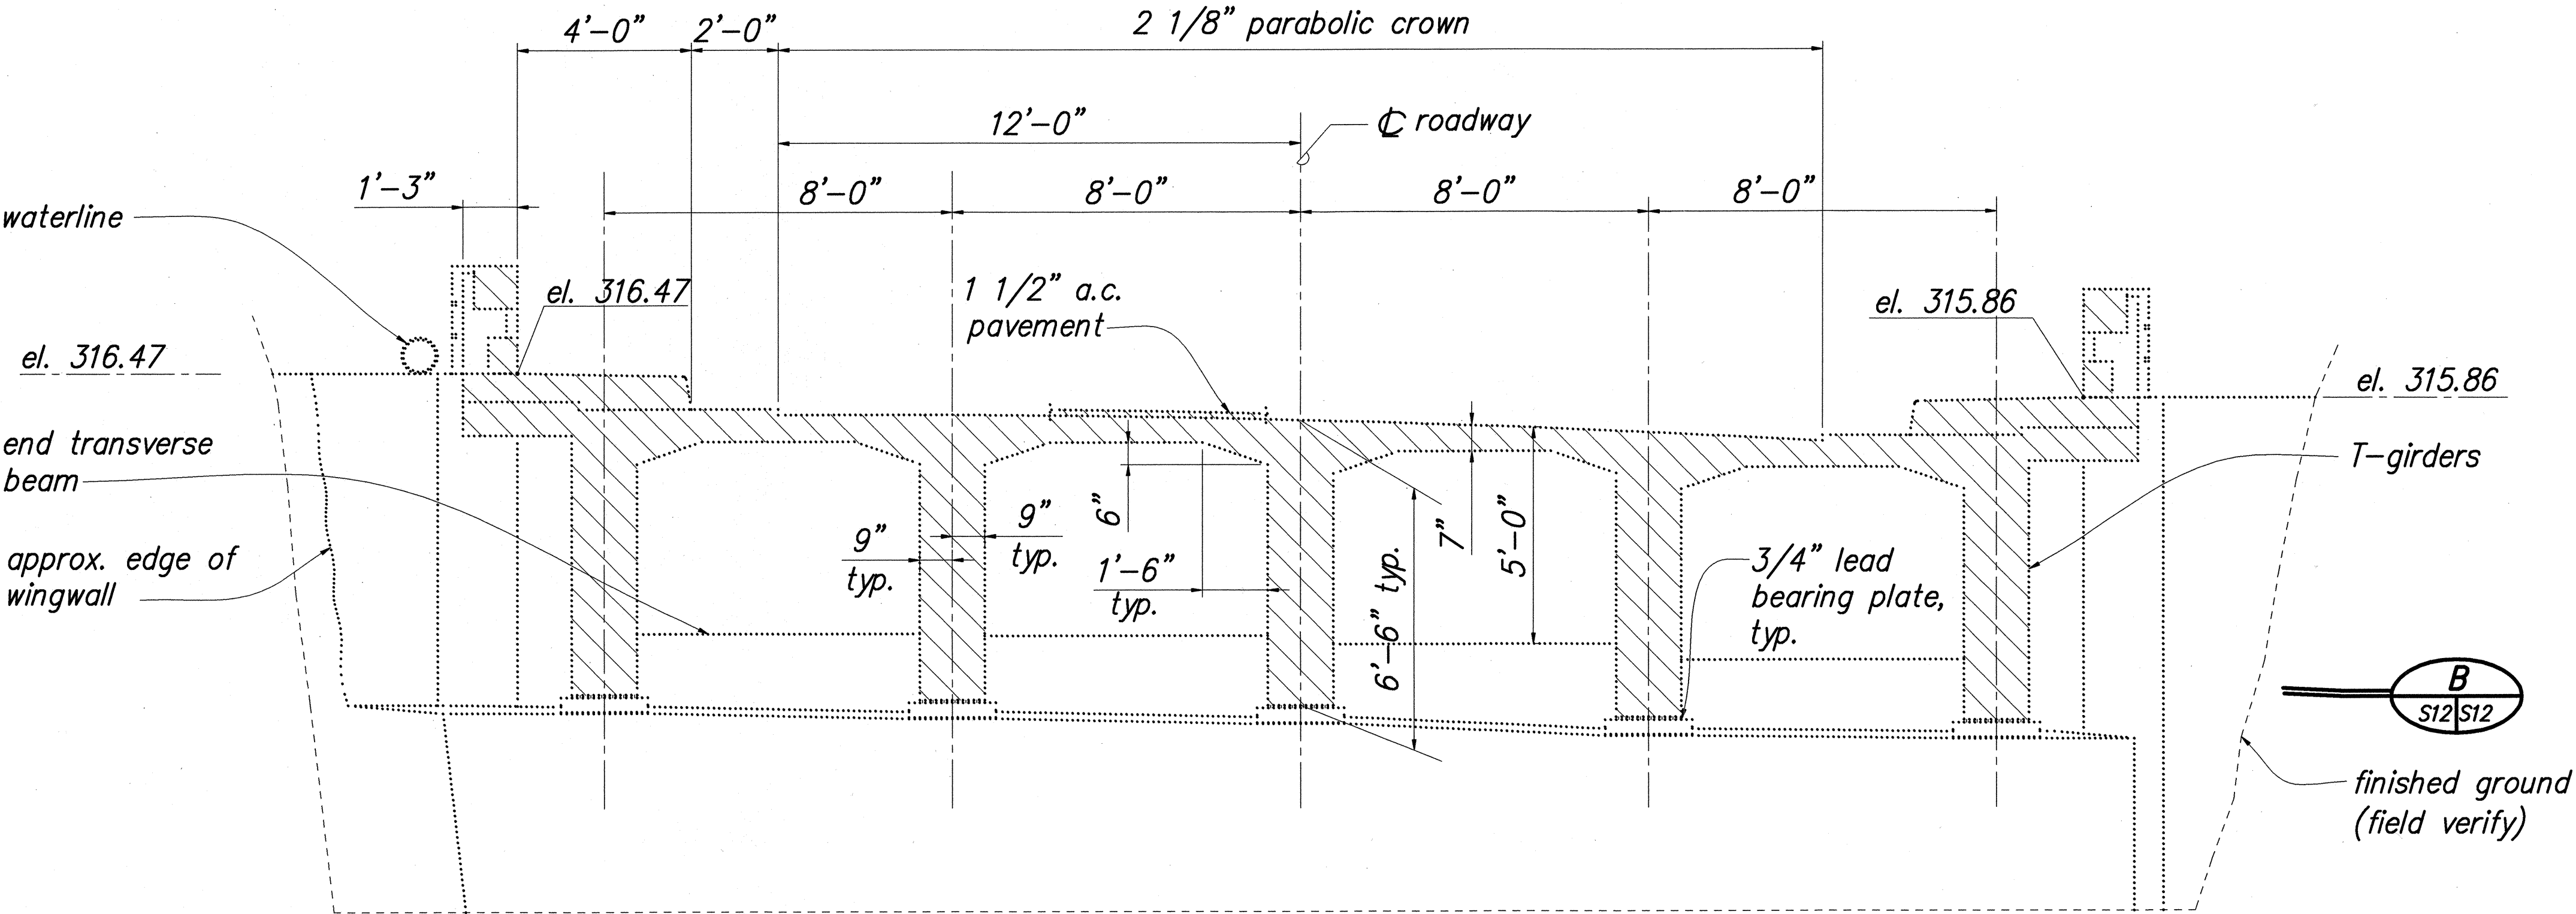

ABUTMENT NO. 2 – EXISTING CONDITIONS
NORMAL TO GIRDER ELEVATION

SCALE: $\frac{3}{8}" = 1'-0"$


A
S12S12

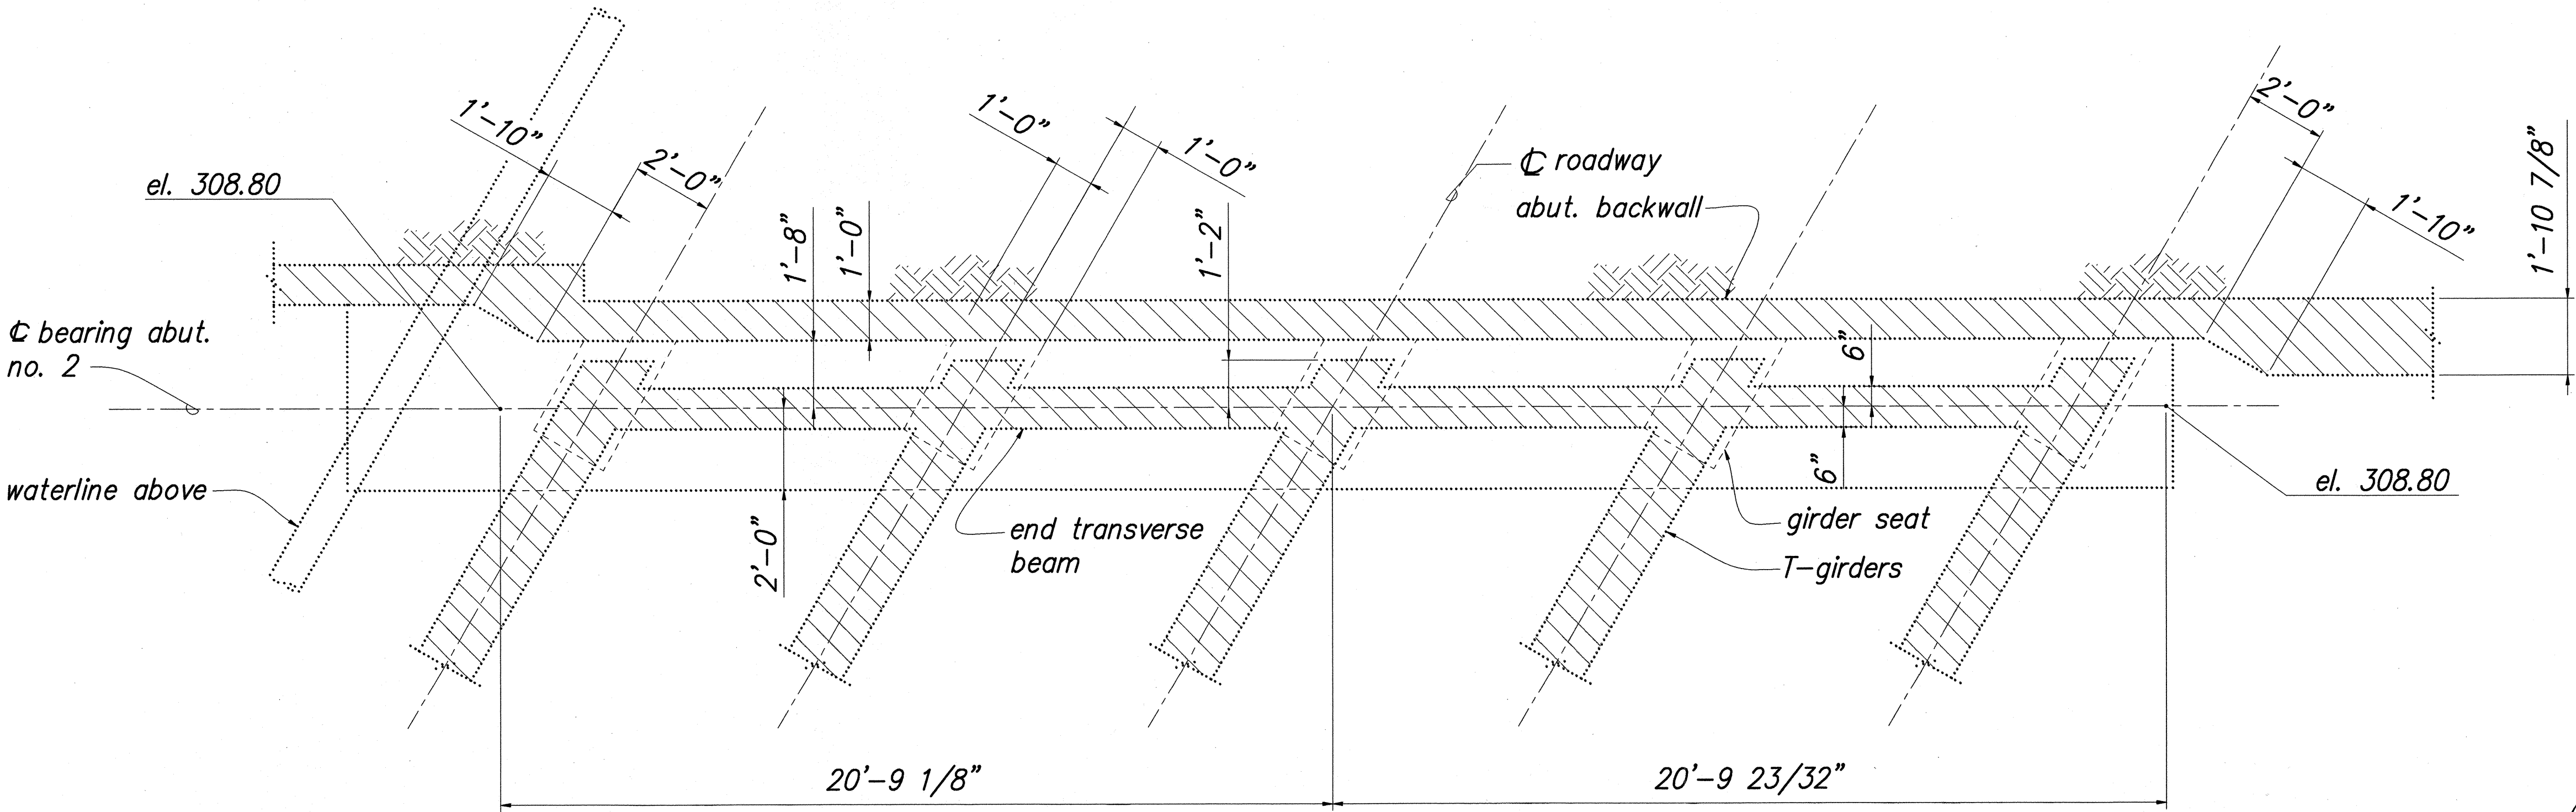

ABUTMENT NO. 2
EXISTING CONDITIONS SECTION PLAN

SCALE: $\frac{3}{8}" = 1'-0"$

B
S12S12

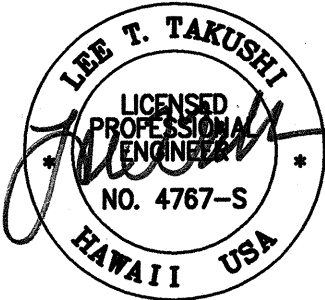

STATE OF HAWAII
DEPARTMENT OF TRANSPORTATION
HIGHWAYS DIVISION


MOANALULU BRIDGE
ABUTMENT NO. 2 - EXISTING CONDITIONS
ELEVATION AND SECTION

HAWAII BELT ROAD, SEISMIC RETROFIT OF VARIOUS BRIDGES,
VICINITY OF LAUPAHOEHOE
FEDERAL AID PROJECT NO. BR-019-2(44)


SCALE: AS NOTED
DATE: APRIL 1998

SHEET No. S12 OF 58 SHEETS

FED. ROAD DIST. NO.	STATE	FED. AID PROJ. NO.	FISCAL YEAR	SHEET NO.	TOTAL SHEETS
HAWAII	HAW.	BR-019-2(44)	1998	16	61

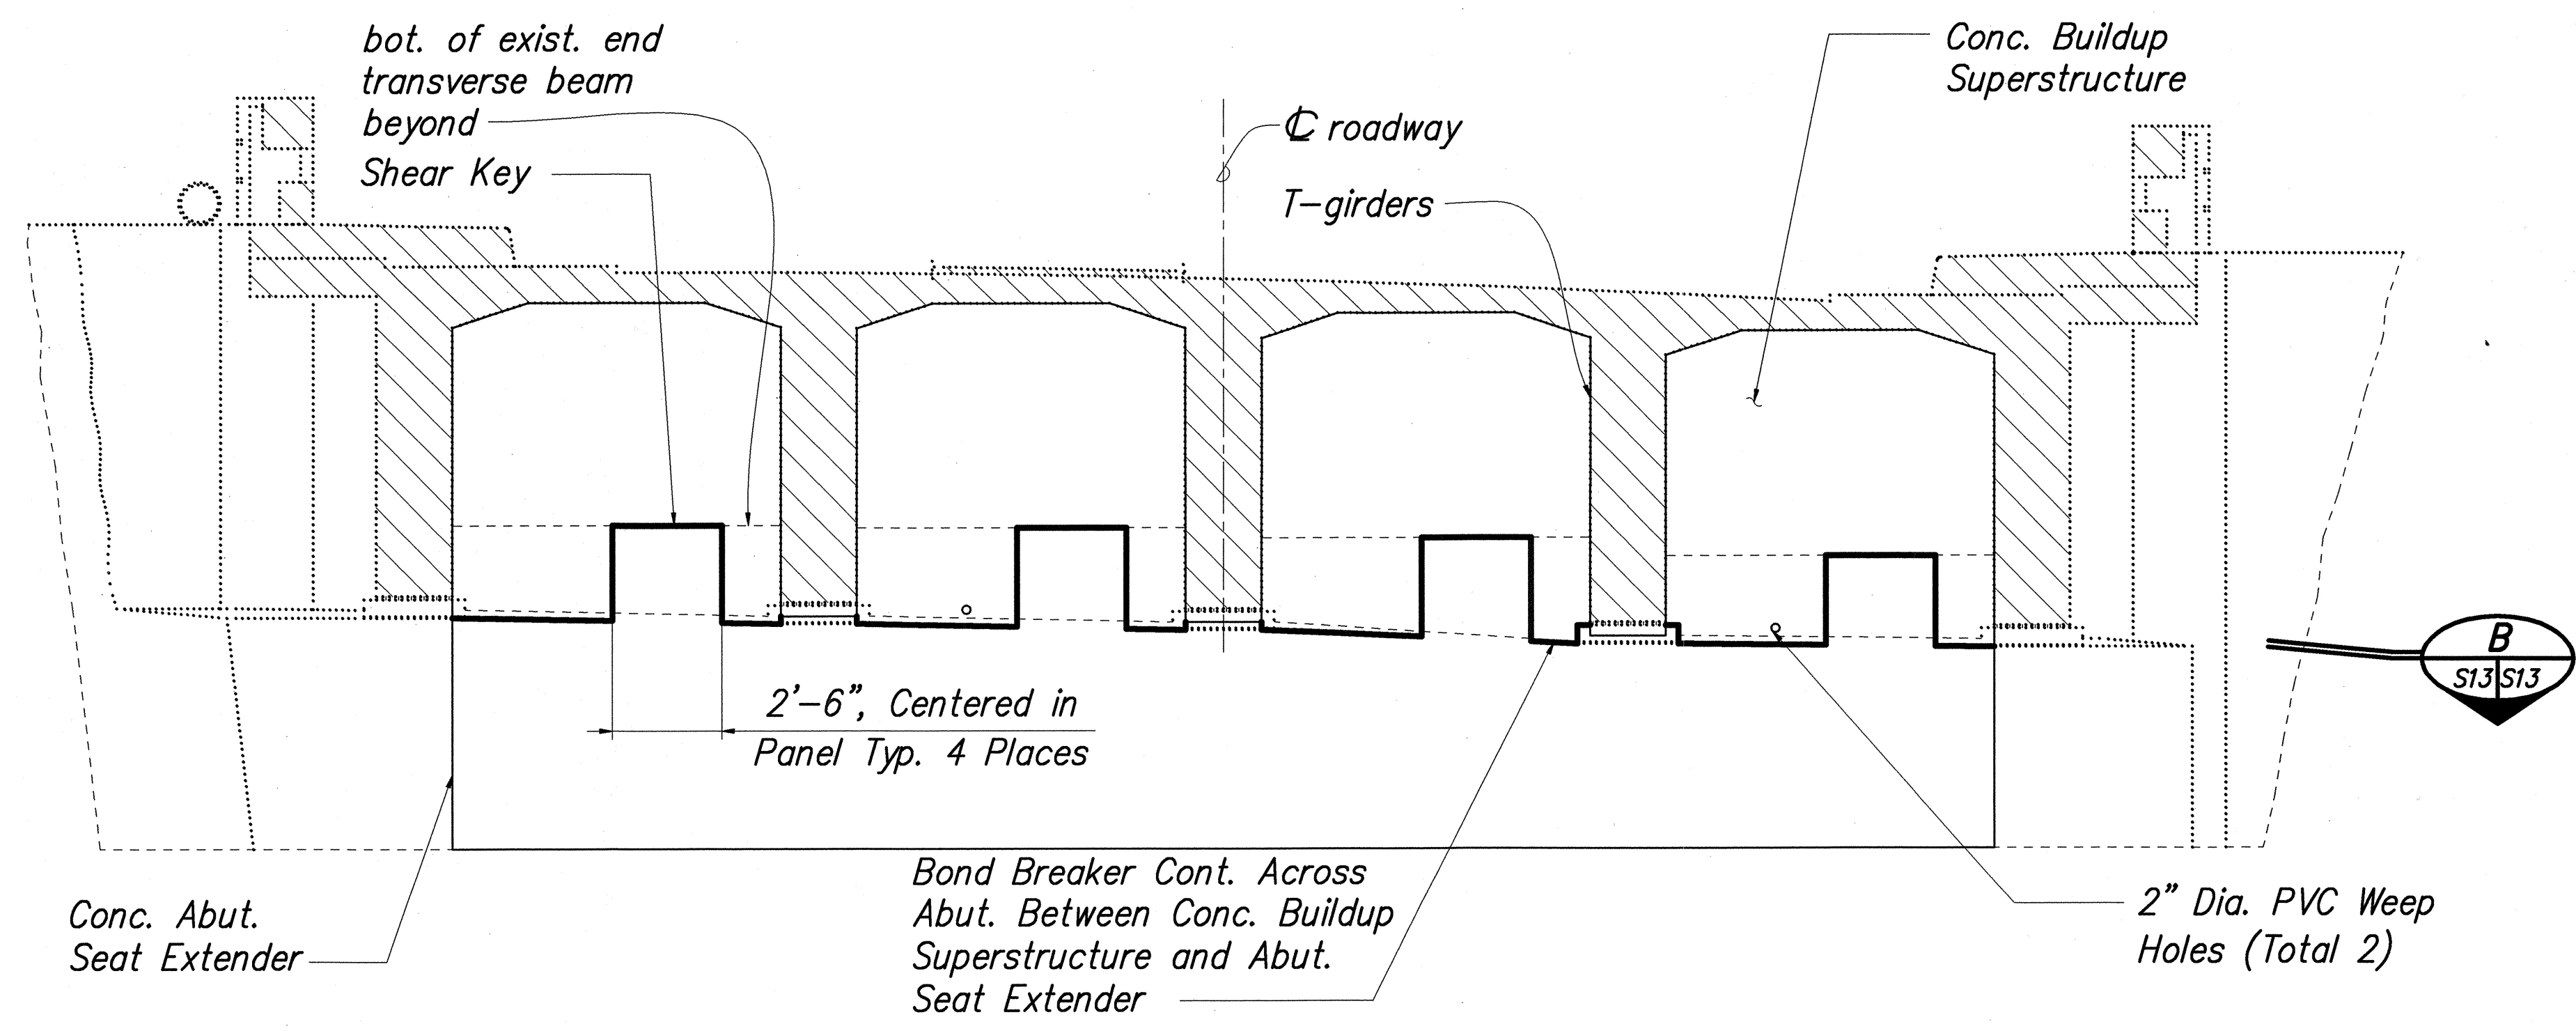


ABUTMENT NO. 2 - NEW CONDITIONS
NORMAL TO GIRDERS ELEVATION
 SCALE: 3/8"=1'-0" A
S13|S13

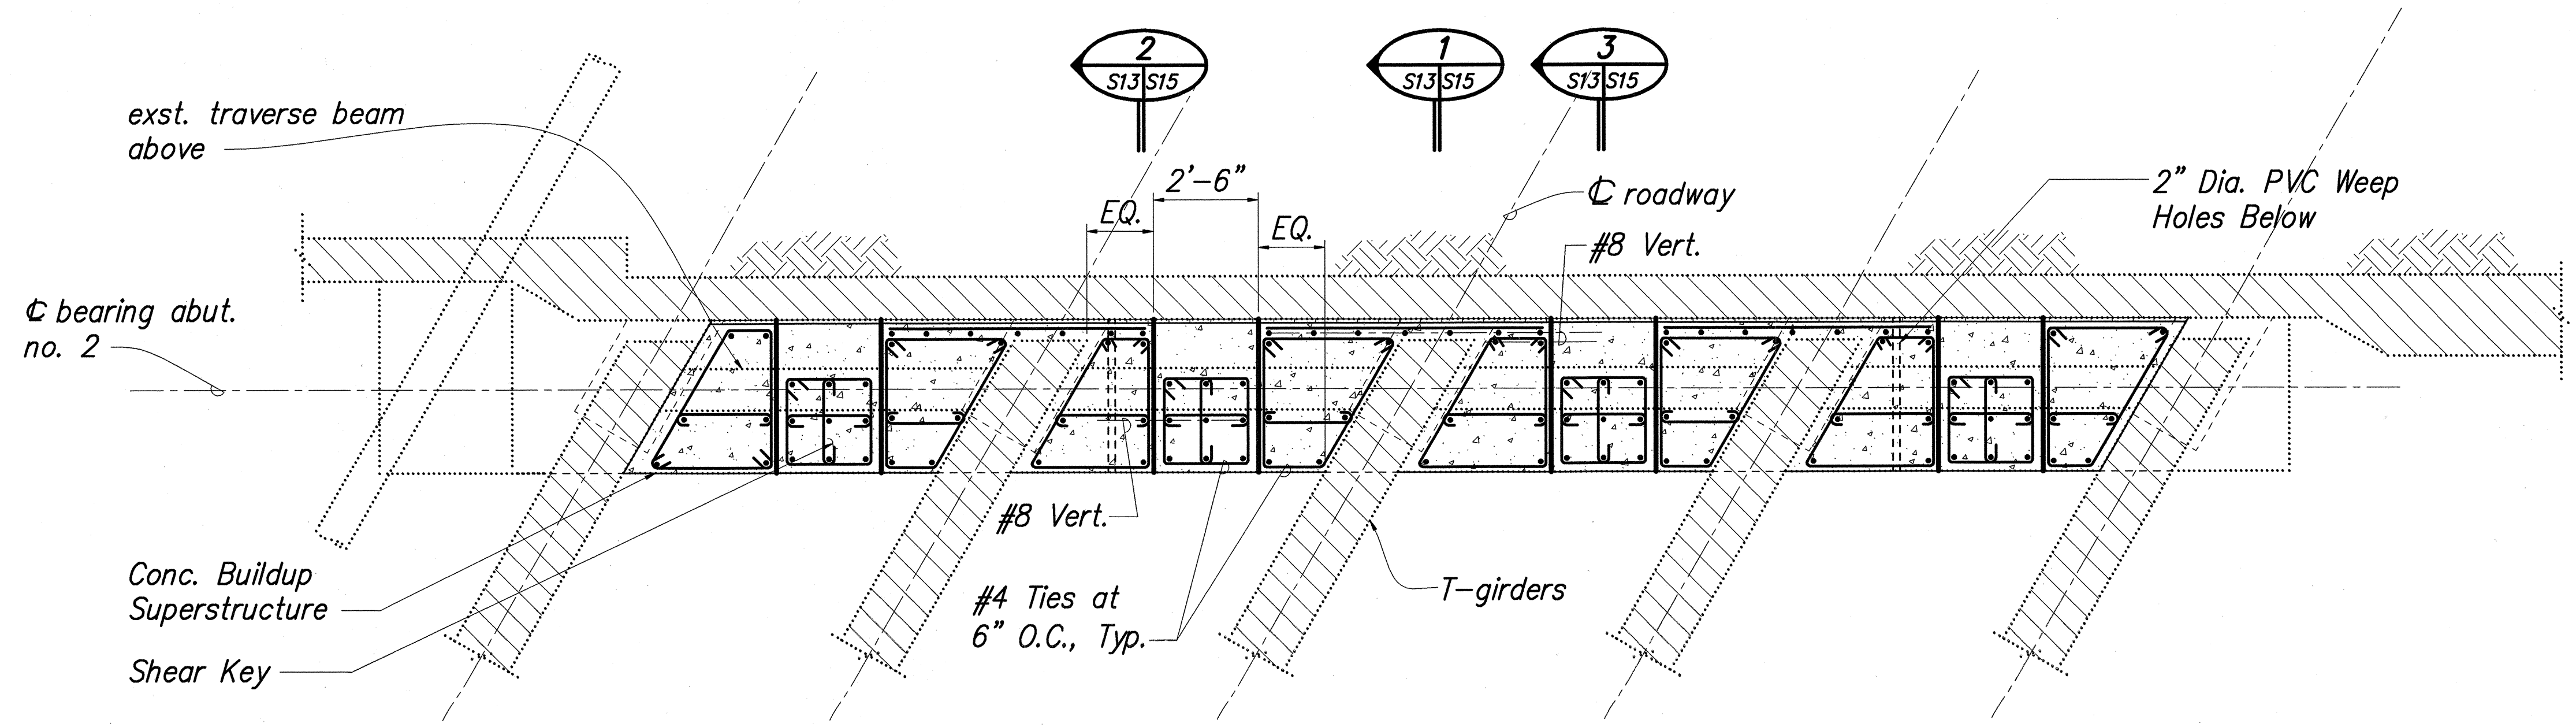

ABUTMENT NO. 2
NEW CONDITIONS SECTION PLAN
 SCALE: 3/8"=1'-0" B
S13|S13

SURVEY PLOTTED BY	DATE
DRAWN BY	" "
DESIGNED BY	" "
QUANTITIES BY	" "
CHECKED BY	" "
ORIGINAL PLAN	No.
NOTE BOOK	No.

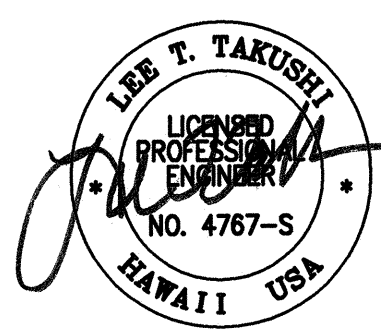

STATE OF HAWAII
 DEPARTMENT OF TRANSPORTATION
 HIGHWAYS DIVISION


MOANALULU BRIDGE
ABUTMENT NO. 2 - NEW CONDITIONS
ELEVATION AND SECTION

 HAWAII BELT ROAD, SEISMIC RETROFIT OF VARIOUS BRIDGES,
 VICINITY OF LAUPAHOEHOE
 FEDERAL AID PROJECT NO. BR-019-2(44)
 SCALE: AS NOTED DATE: APRIL 1998


 SHEET No. S13 OF 58 SHEETS

MAY 26 1998


FED. ROAD DIST. NO.	STATE	FED. AID PROJ. NO.	FISCAL YEAR	SHEET NO.	TOTAL SHEETS
HAWAII	HAW.	BR-019-2(44)	1998	19	61

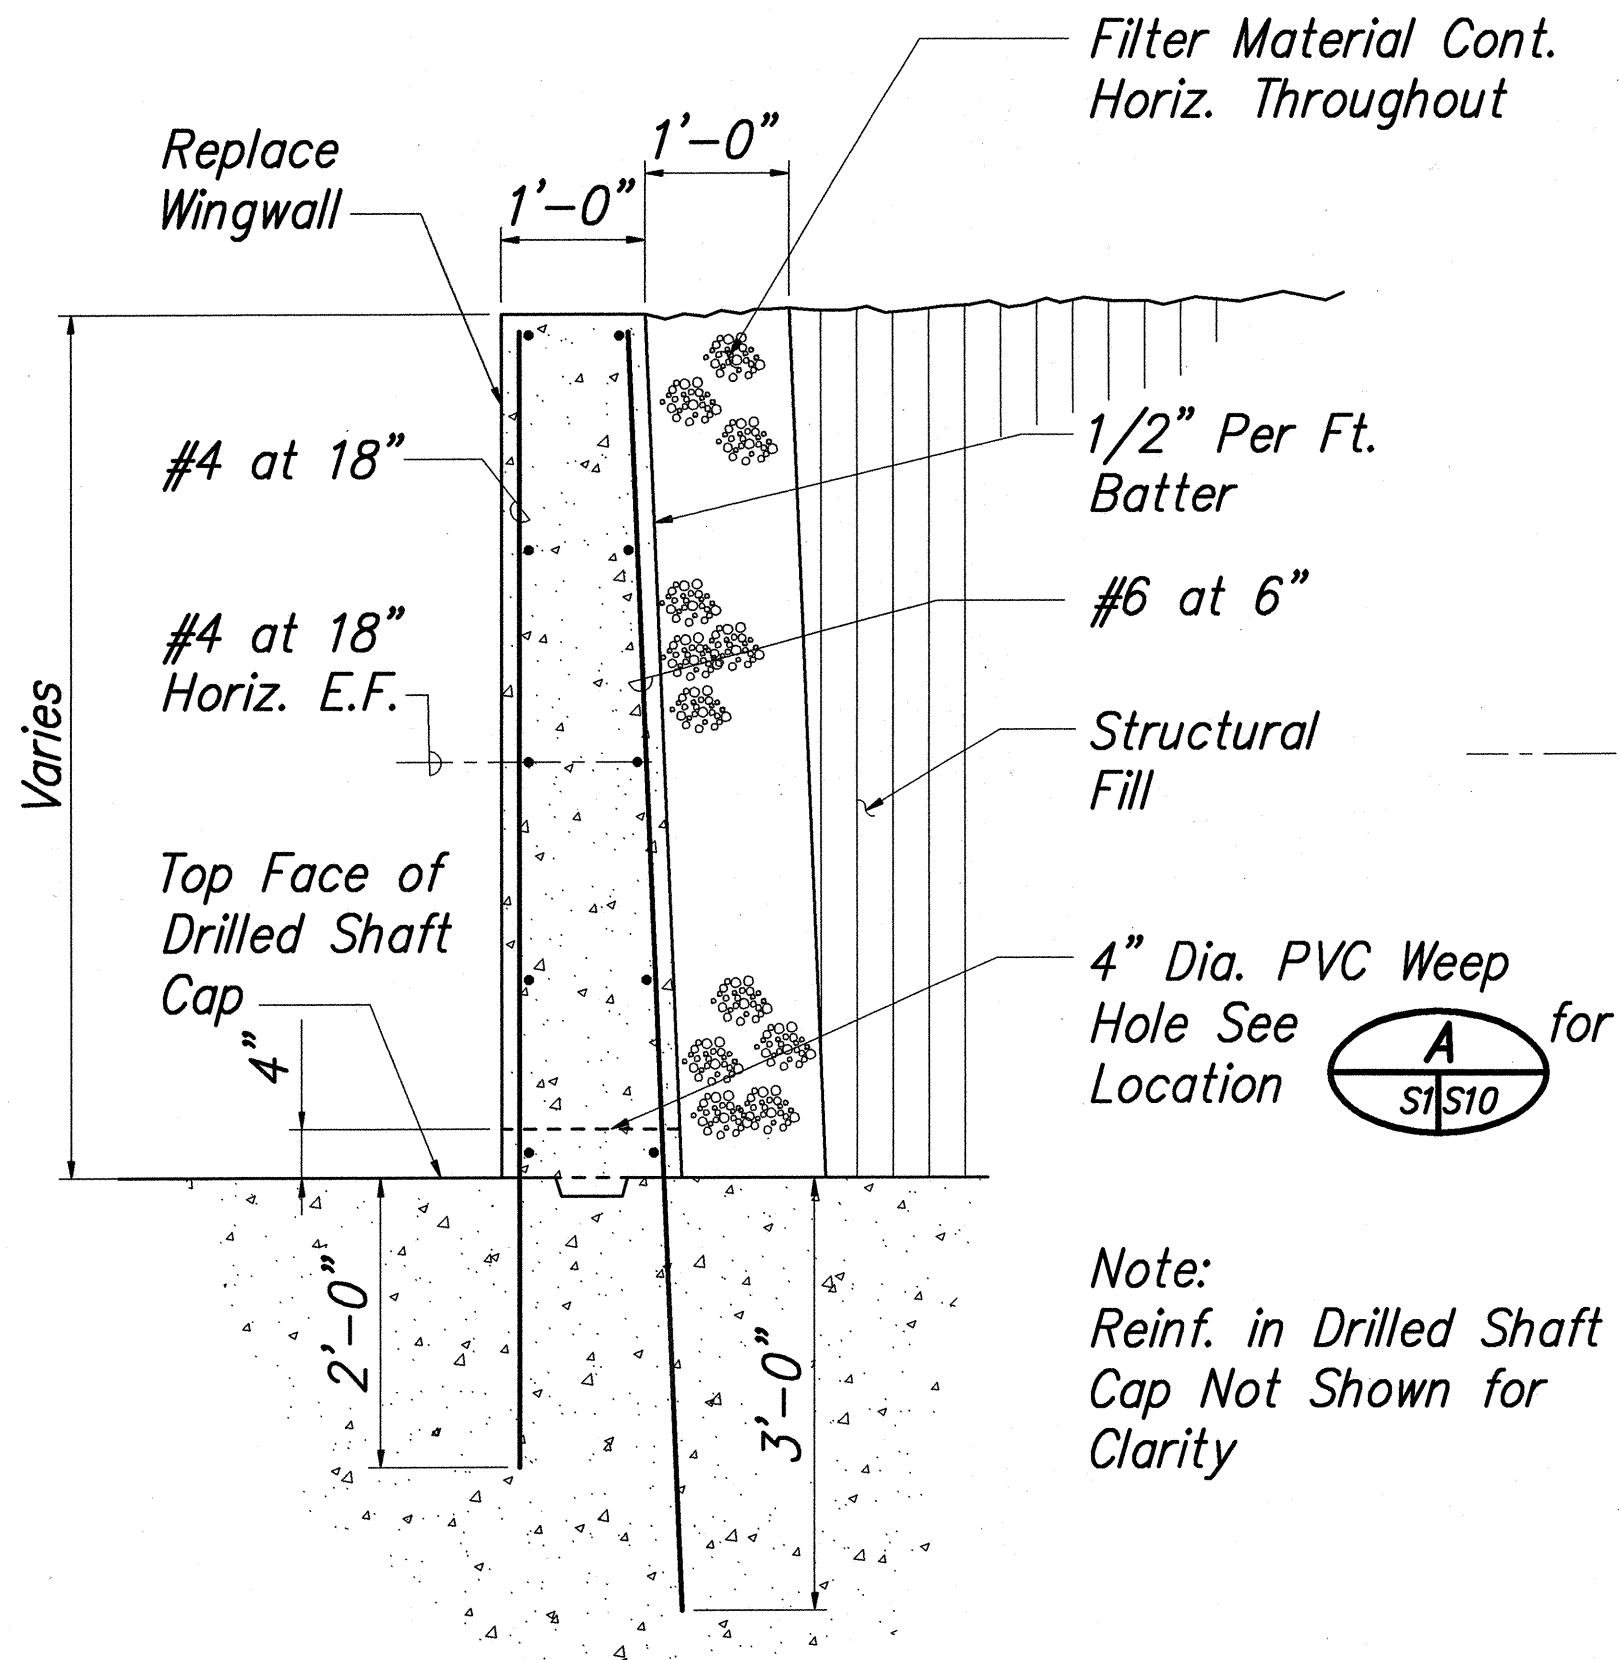

DETAIL 1
SCALE: 3/4"=1'-0"
S10, S11/

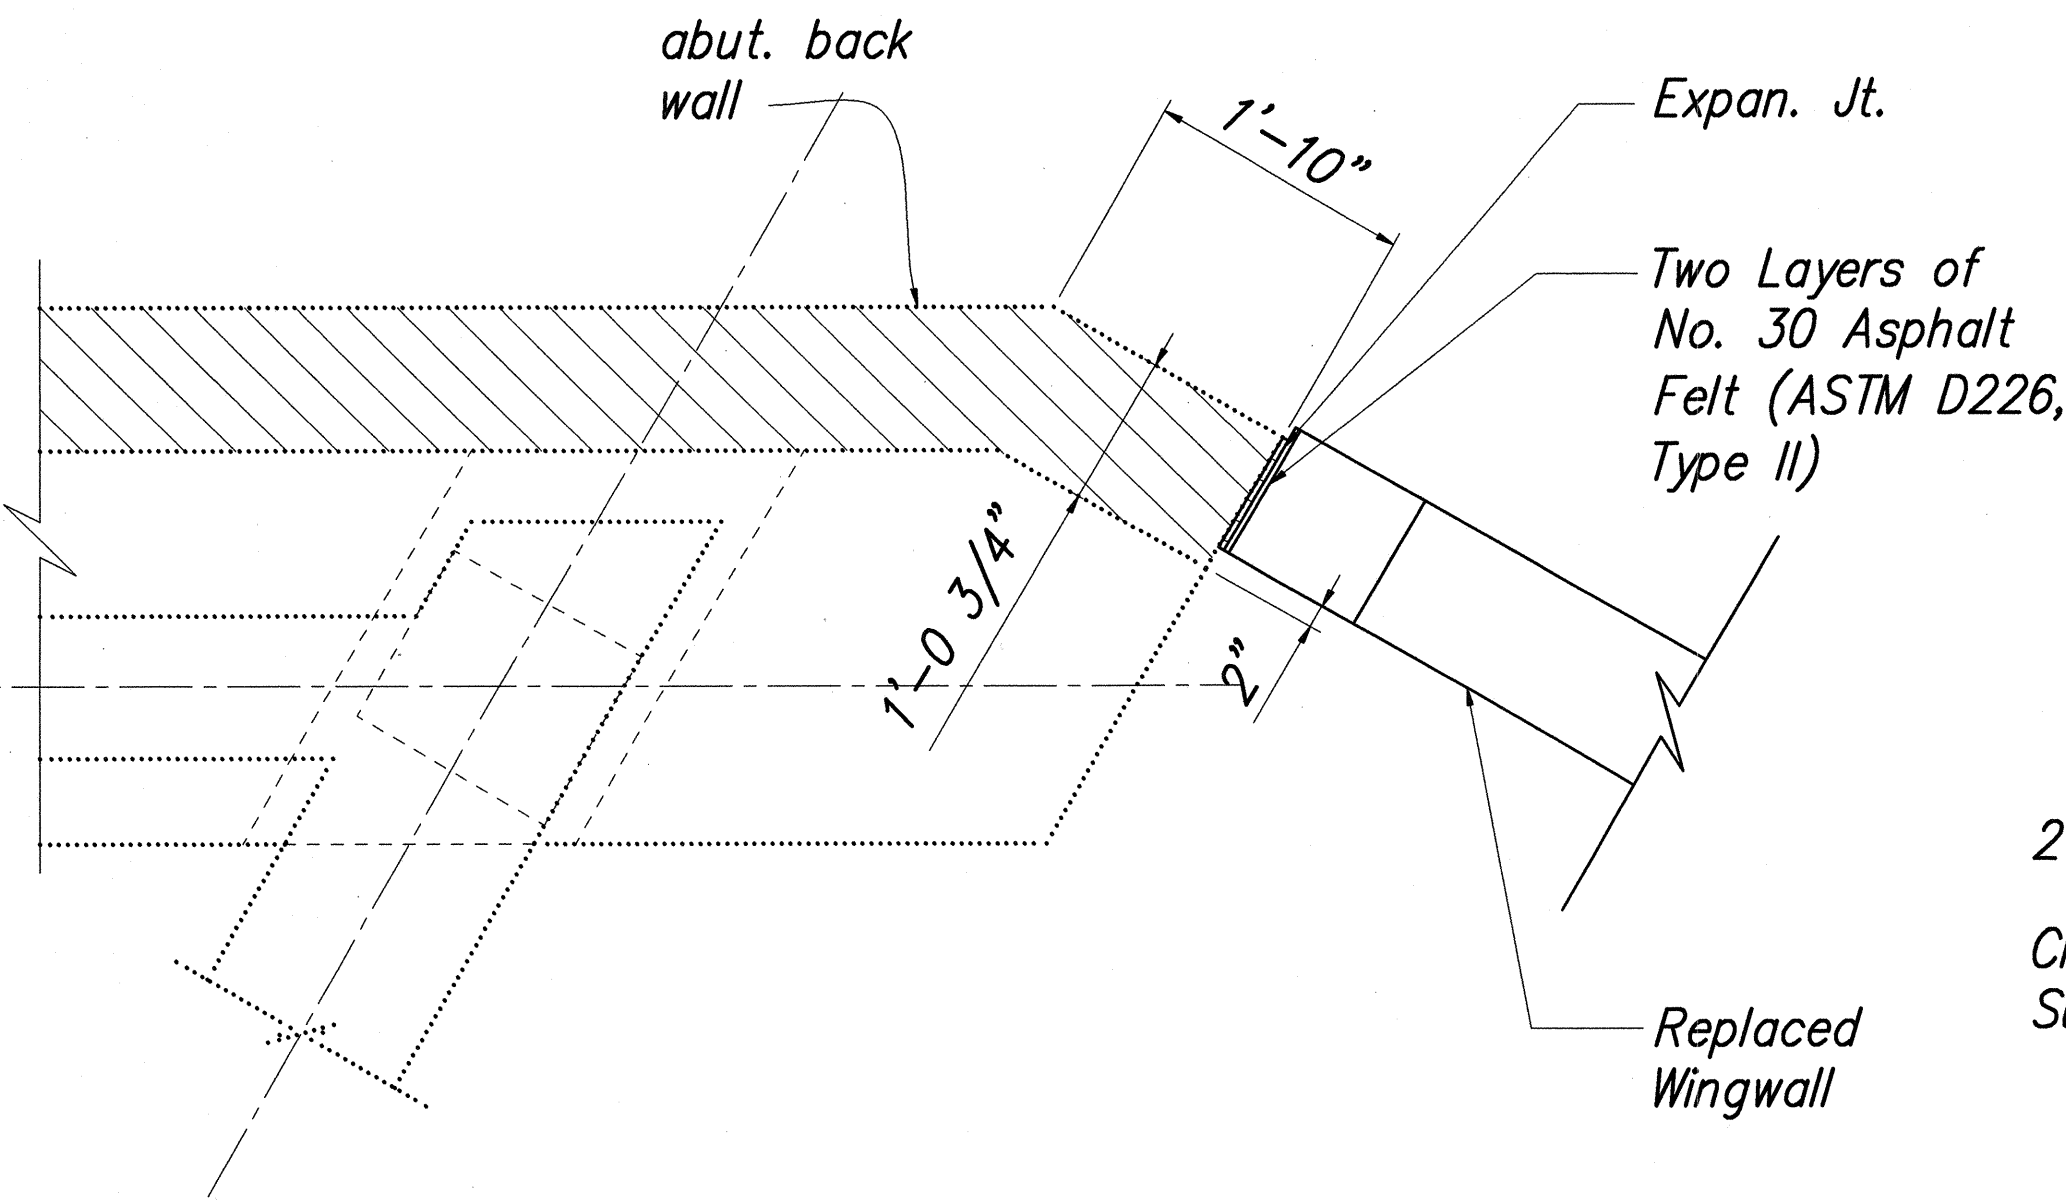


DETAIL 2
SCALE: 3/4"=1'-0"
S10/S16

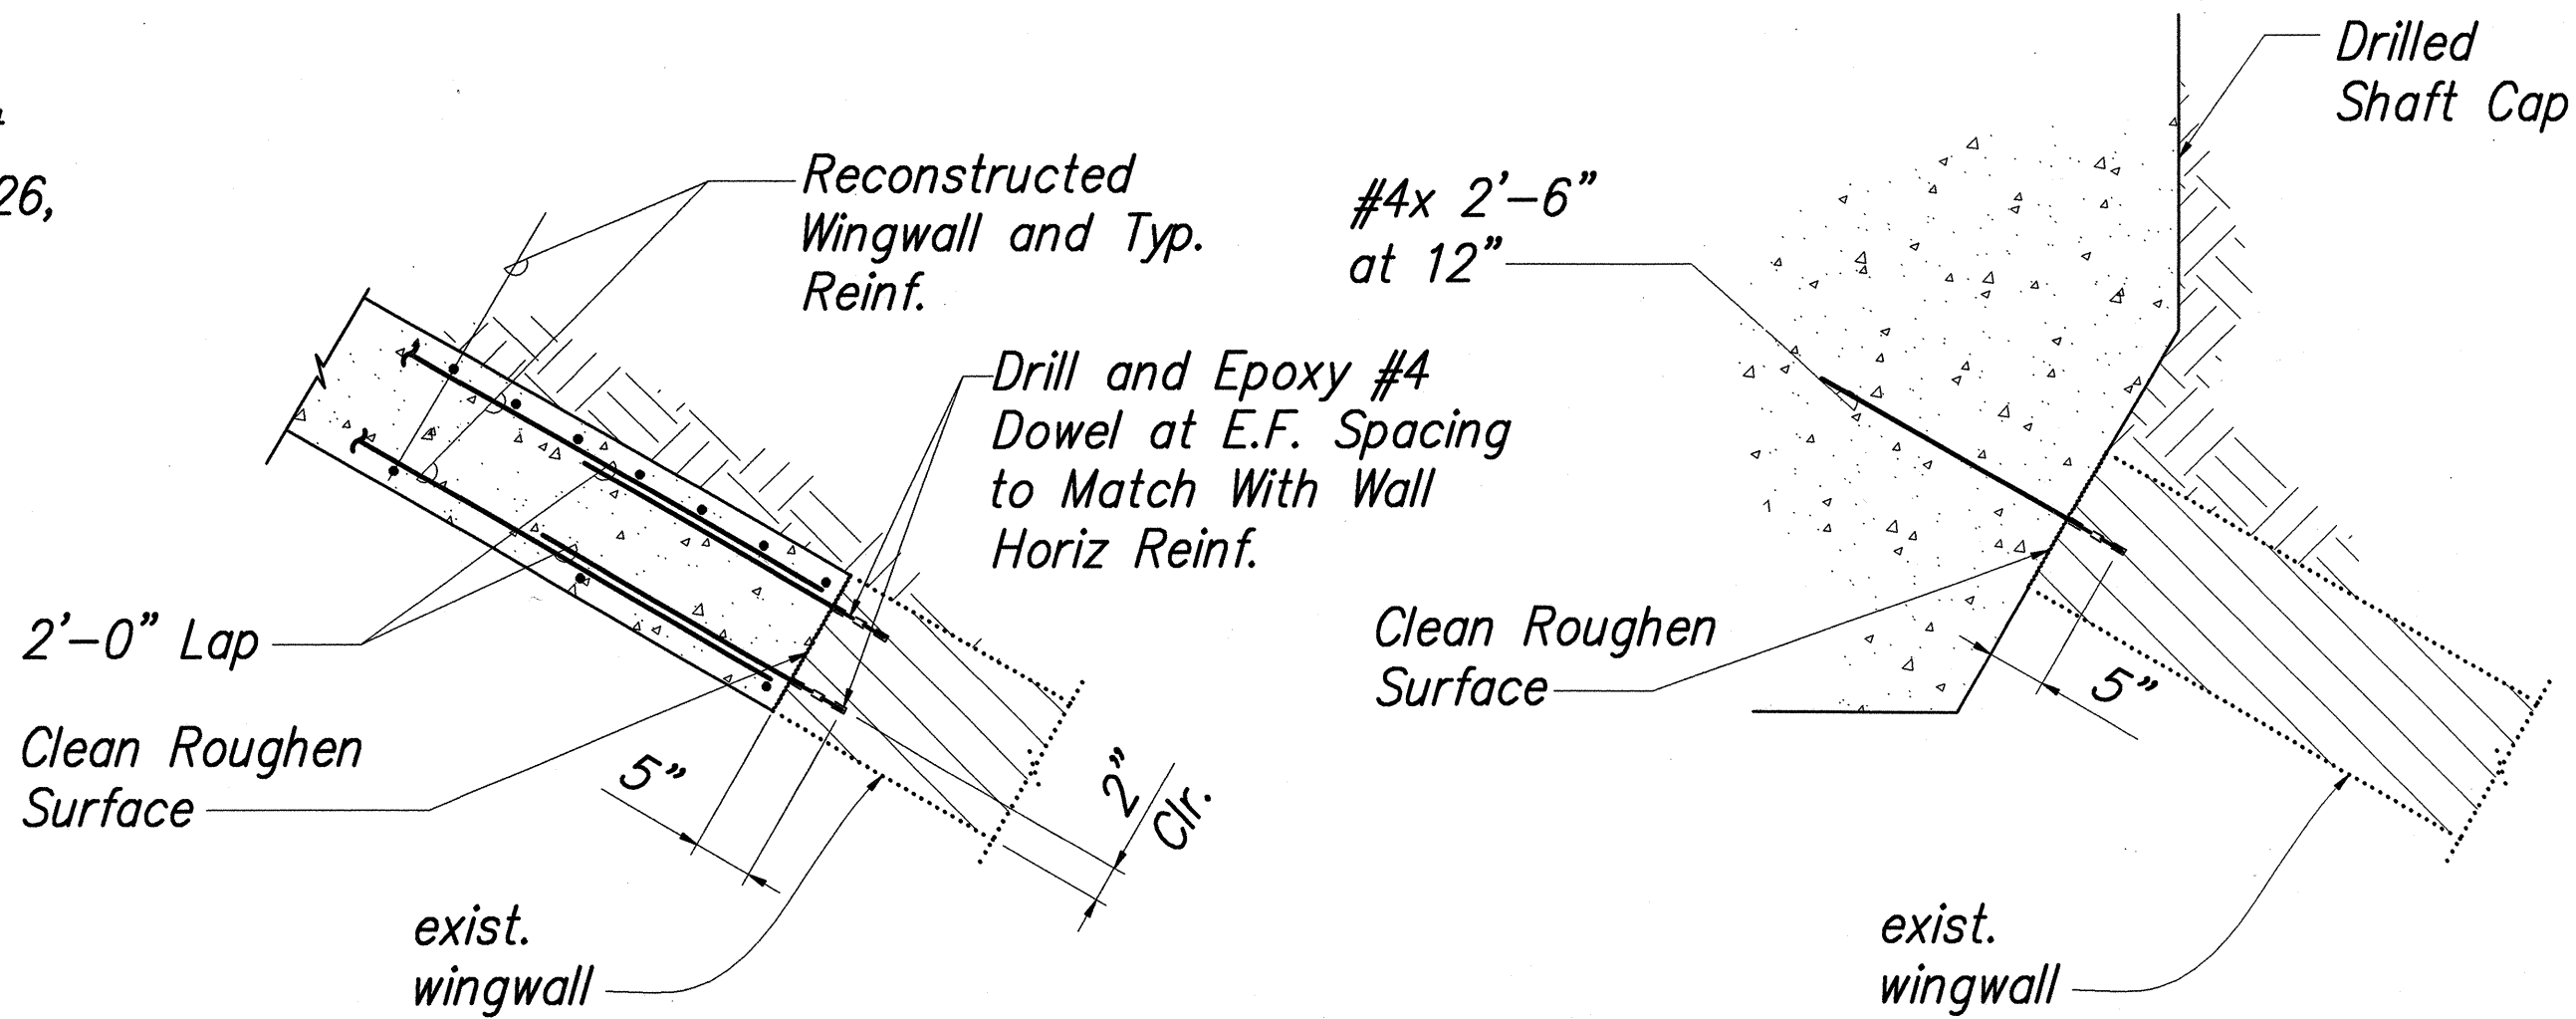


DETAIL 3
SCALE: 3/4"=1'-0"
S10/S16

DETAIL 4
SCALE: 3/4"=1'-0"
S10/S16

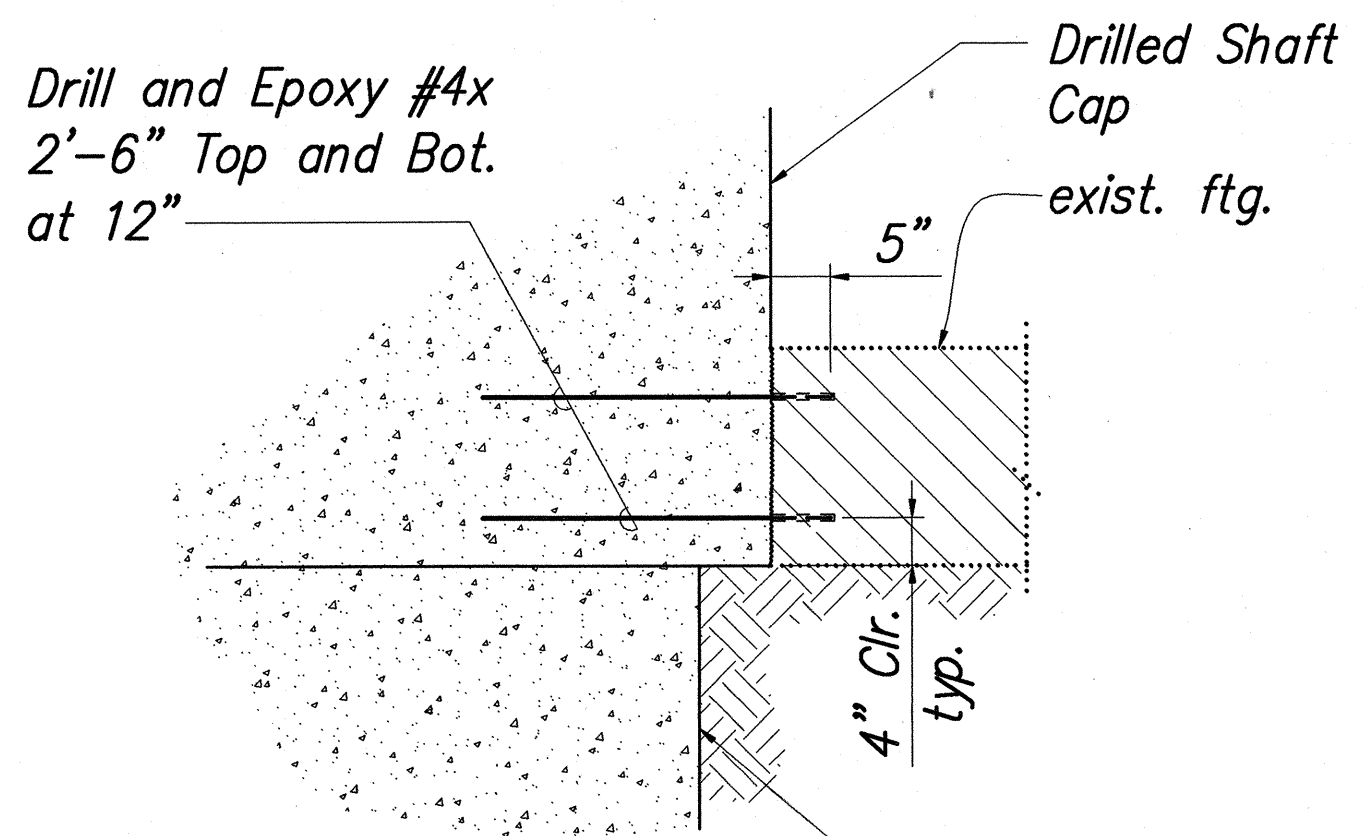

DETAIL 5
SCALE: 3/4"=1'-0"
S10/S16

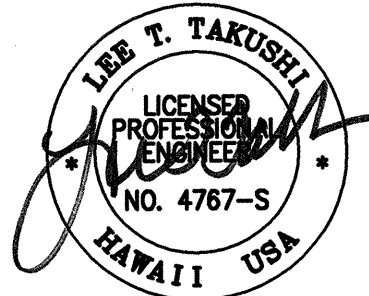

STATE OF HAWAII
DEPARTMENT OF TRANSPORTATION
HIGHWAYS DIVISION

MOANALULU BRIDGE
RETAINING WALL SECTIONS AND DETAILS

HAWAII BELT ROAD, SEISMIC RETROFIT OF VARIOUS BRIDGES,
VICINITY OF LAUPAHOEHOE
FEDERAL AID PROJECT NO. BR-019-2(44)
SCALE: AS NOTED
DATE: APRIL 1998

SHEET No. S16 OF 58 SHEETS