
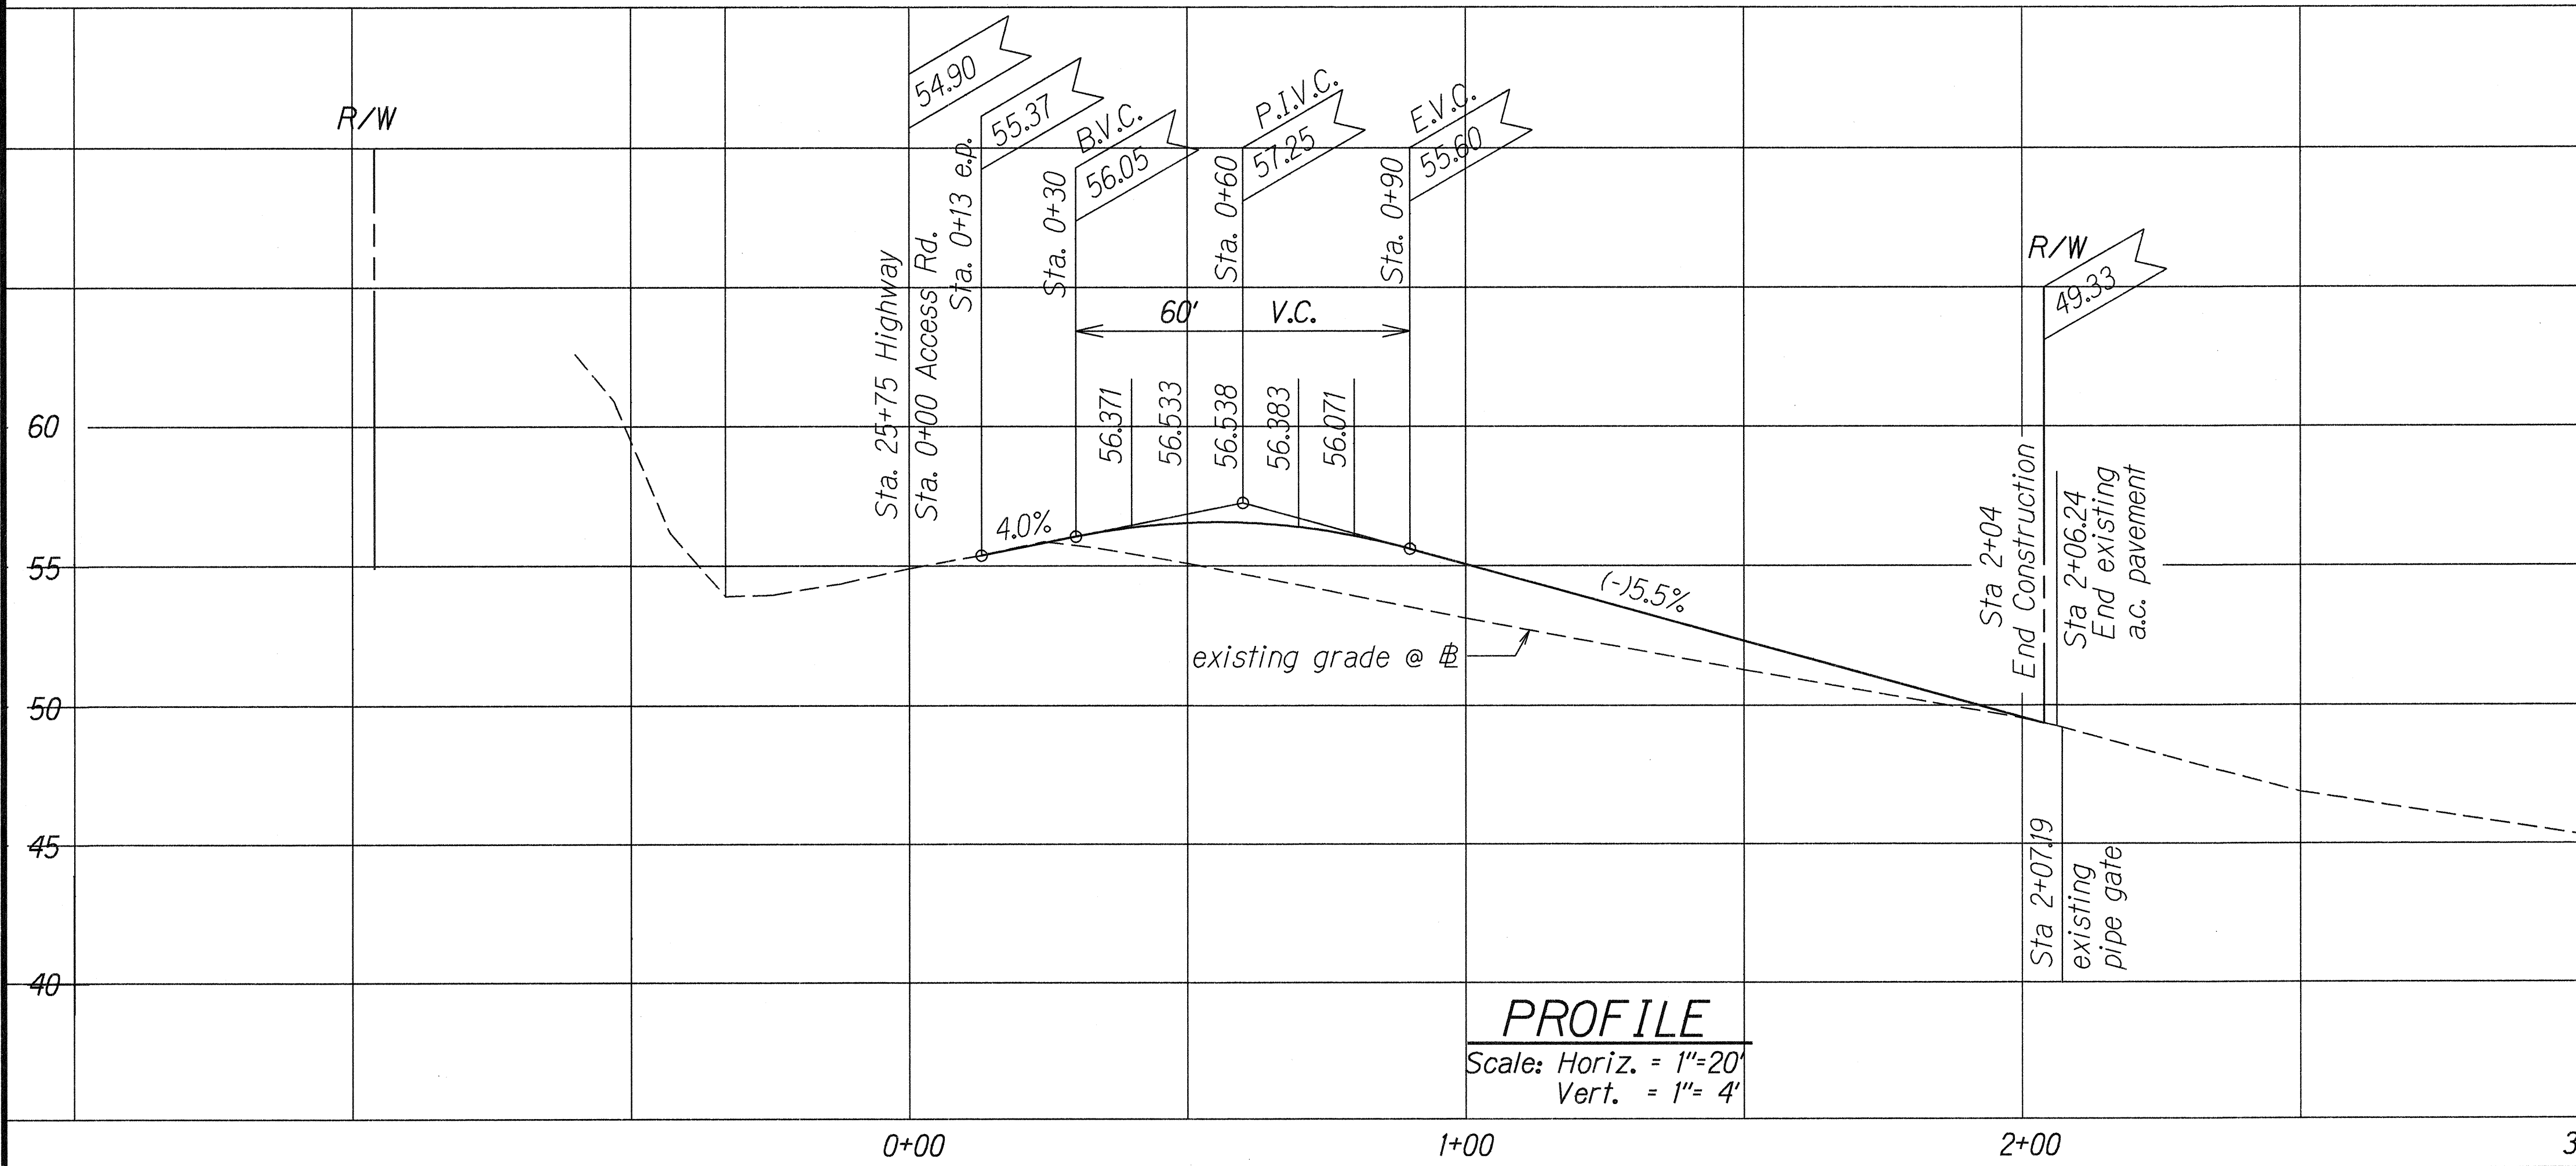
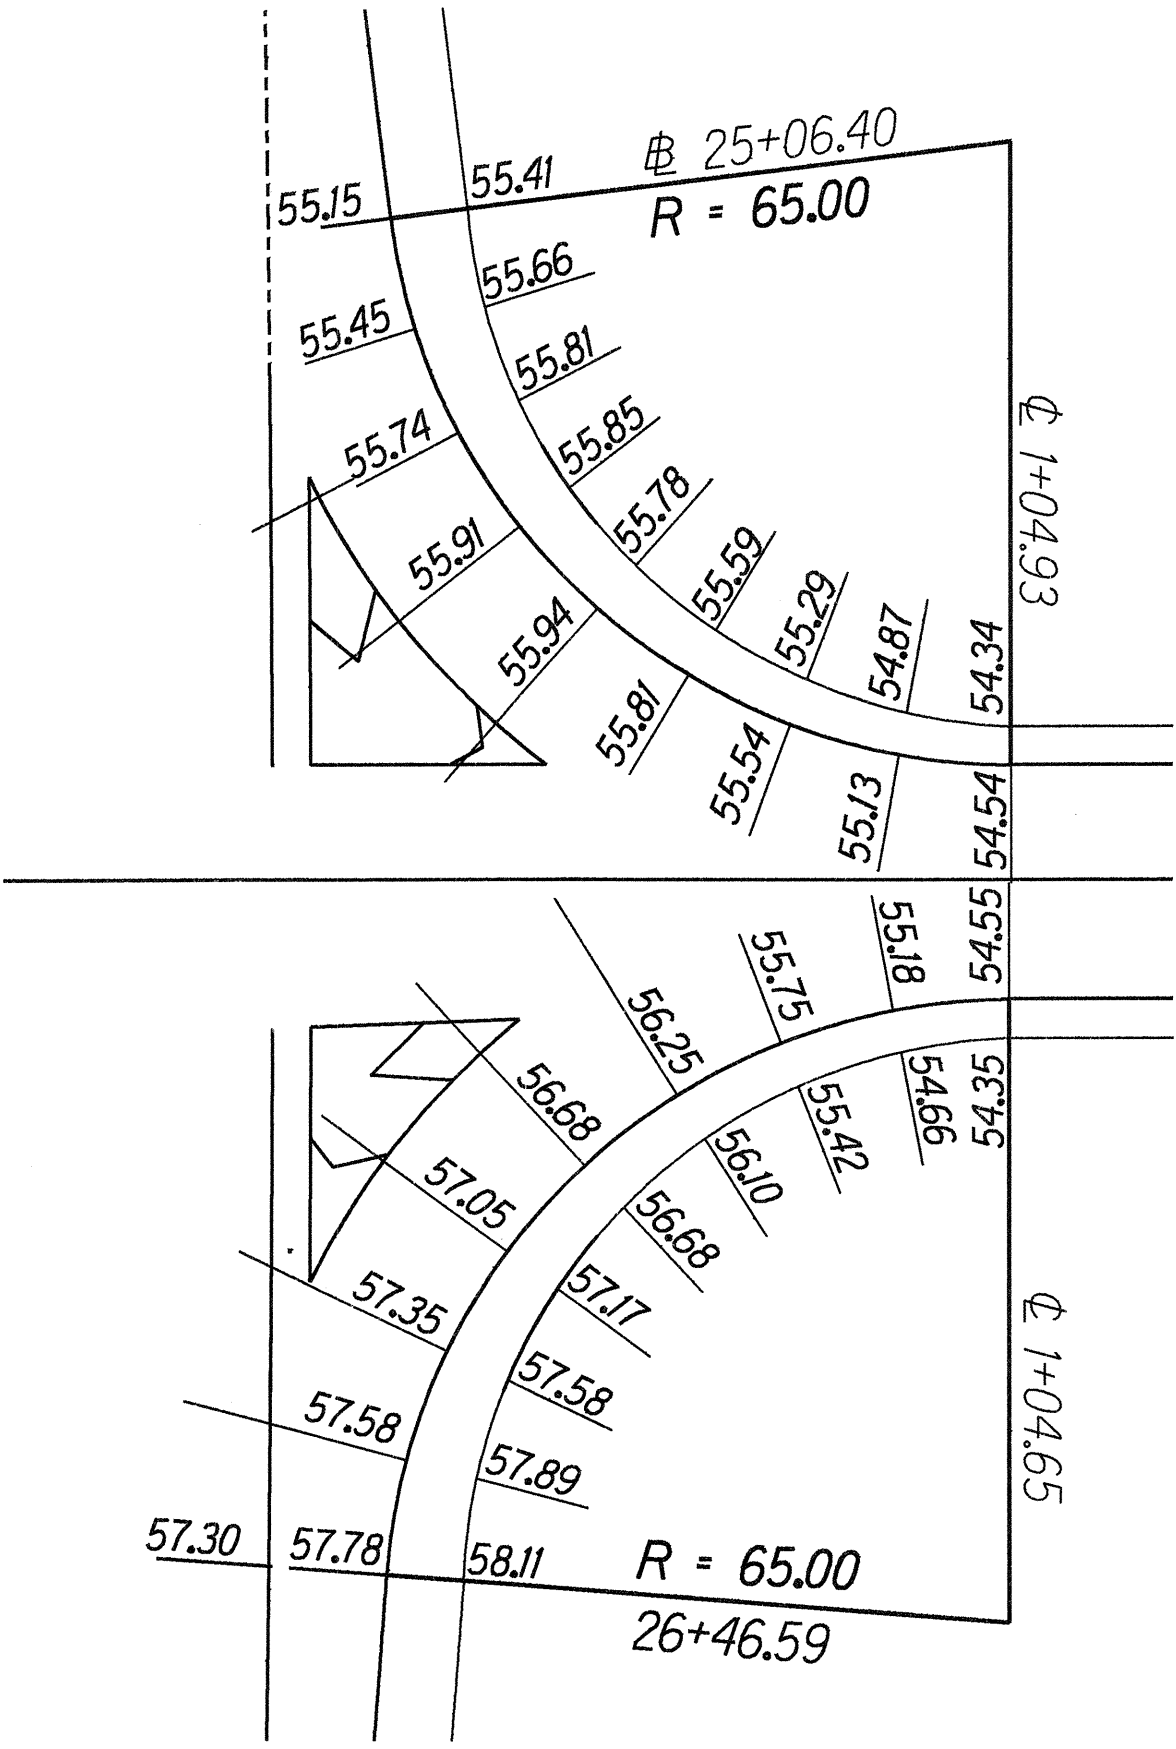


FED. ROAD DIST. NO.	STATE	FED. AID PROJ. NO.	FISCAL YEAR	SHEET NO.	TOTAL SHEETS
HAWAII	HAW.	FLH-019-1(26)	2000	10	46

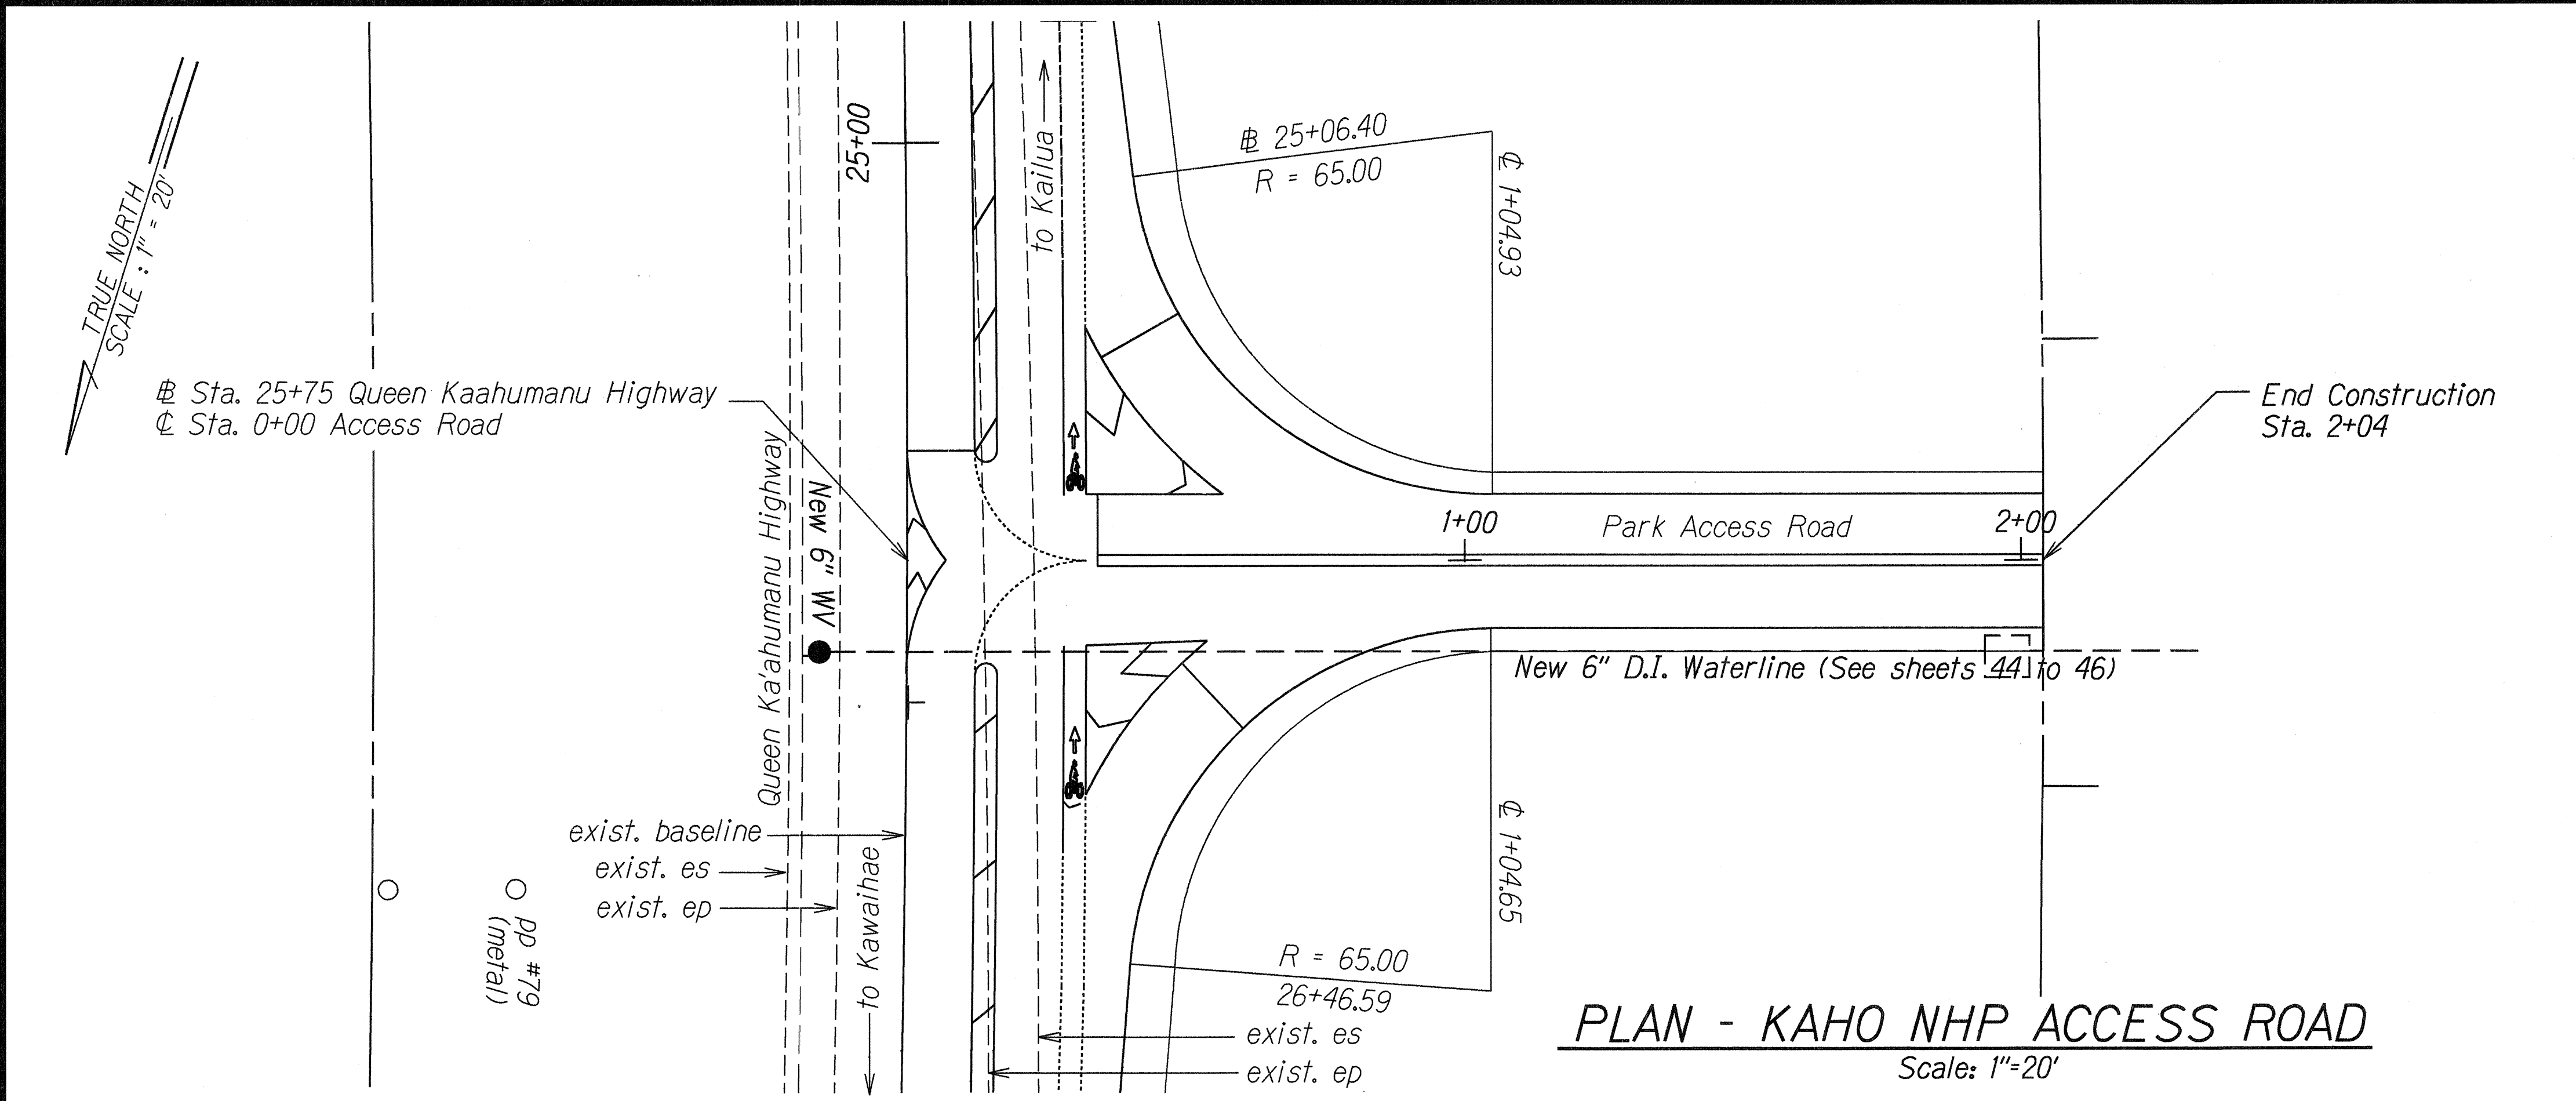

CURVE RETURN GRADE DATA
Scale: 1"=20'

PROFILE
Scale: Horiz. = 1"=20'
Vert. = 1"=4'

ORIGINAL PLAN	SURVEY PLATTED BY	DATE
NOTED BOOK	DRAWN BY	
DESIGNED BY	DESIGNED BY	
CHECKED BY	CHECKED BY	