


FED. ROAD DIST. NO.	STATE	PROJ. NO.	FISCAL YEAR	SHEET NO.	TOTAL SHEETS
HAWAII	HAW.	HWY-H-08-00M	2000	5	9

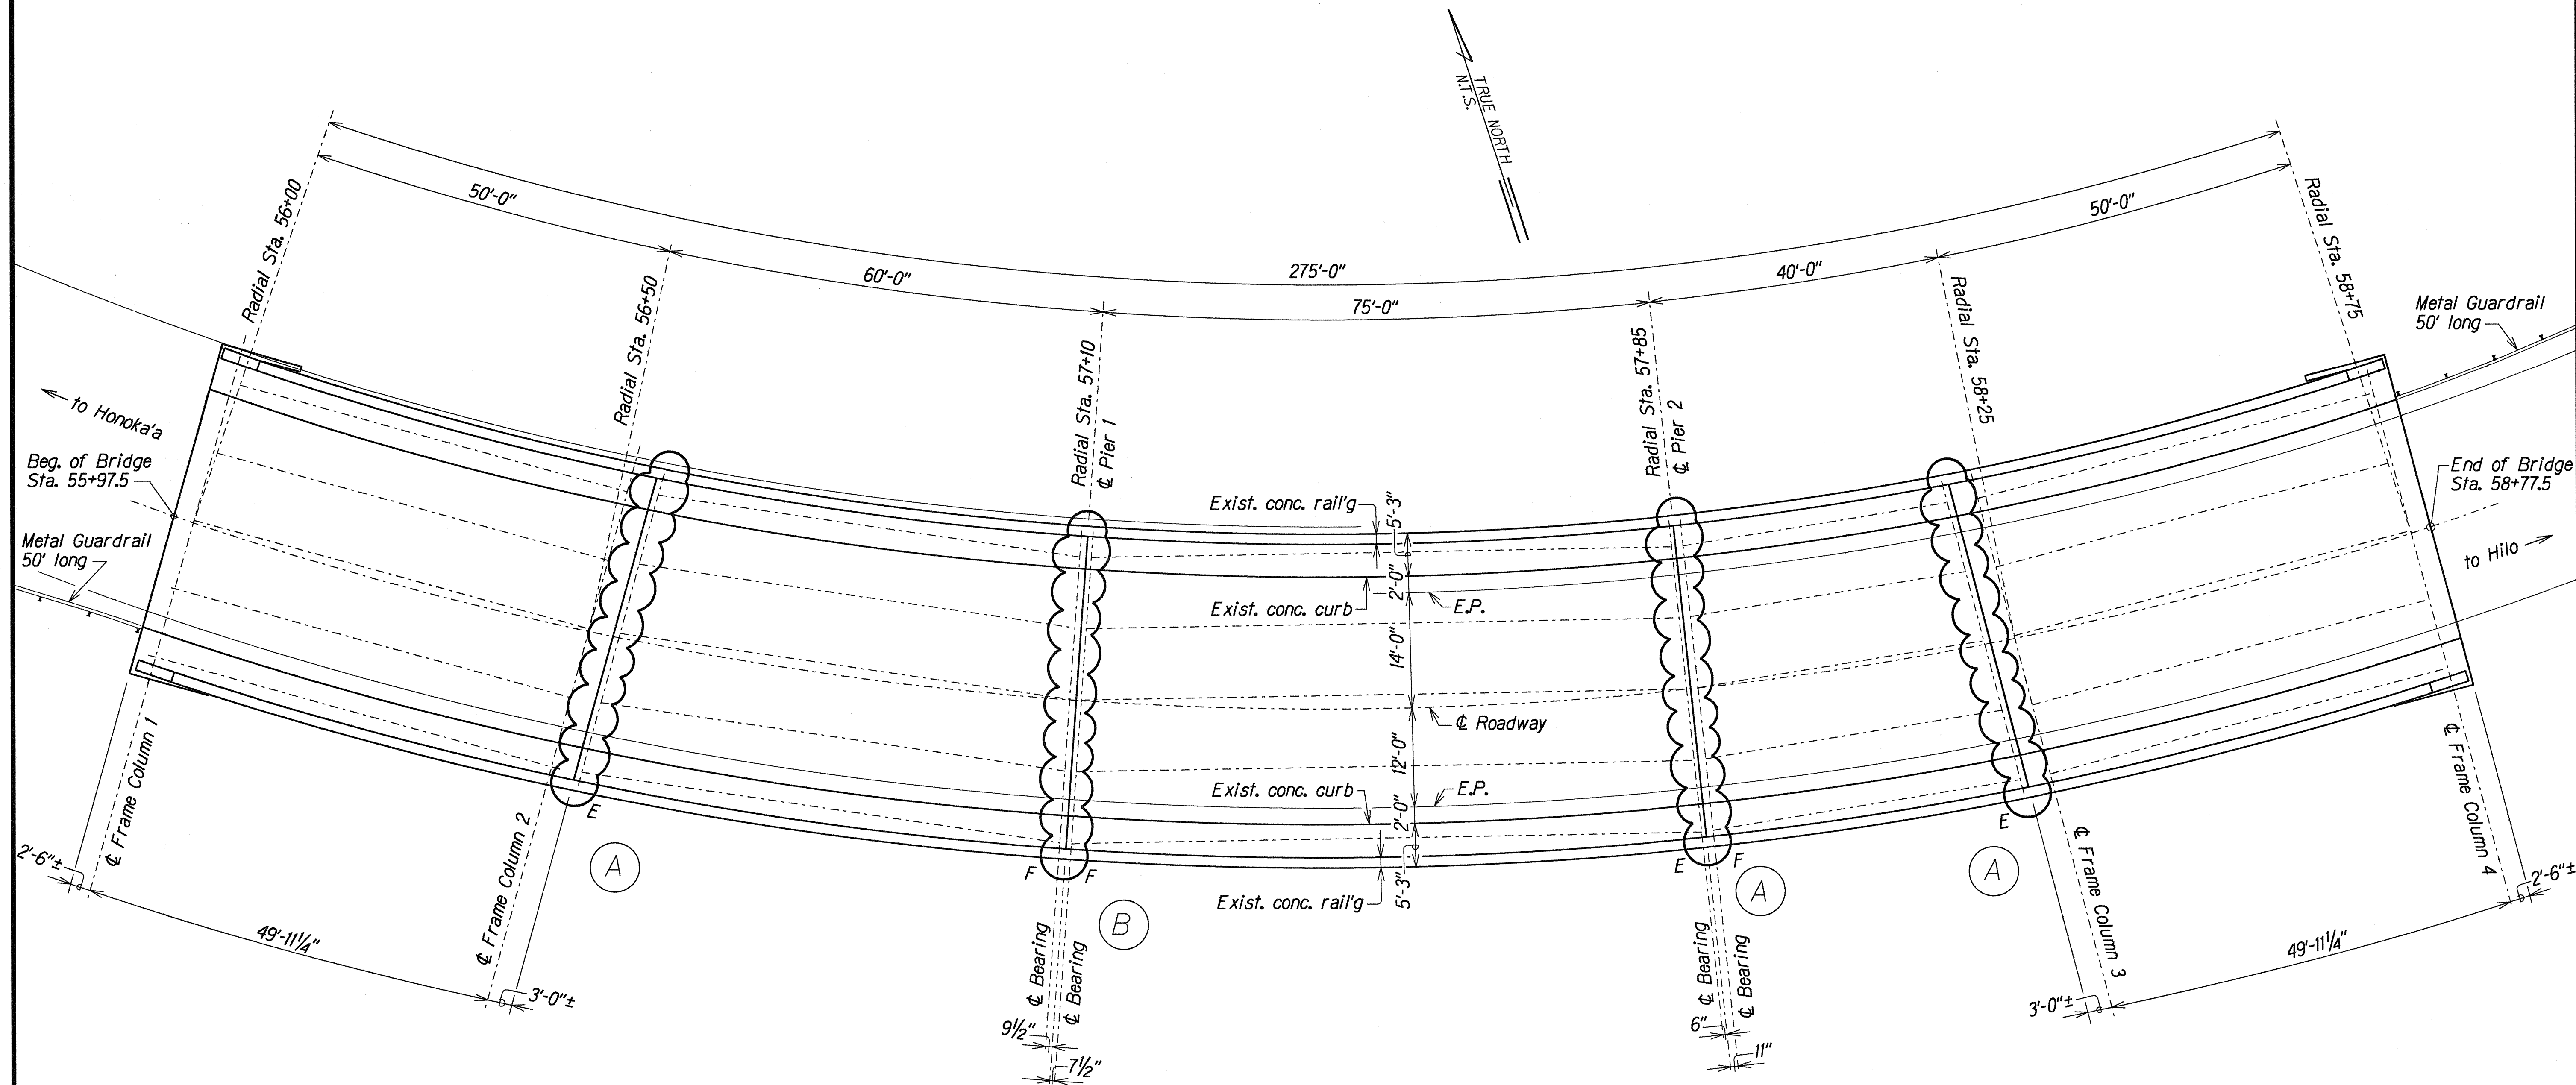


LAYOUT PLAN--MAULUA BRIDGE
Not to Scale

LEGEND

- (A) See Detail "A" Sheet 4. (Expansion Joint)
- (B) See Detail "B" Sheet 4. (Fixed Joint)

Key to Symbols

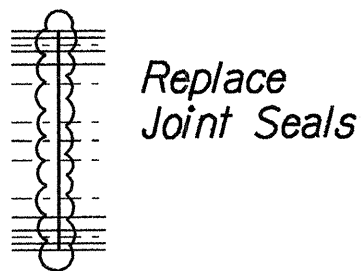

- E Expansion Bearings
- F Fixed Bearings

ORIGINAL PLAN	DATE
SURVEY PLOTTED BY	
DRAWN BY	
DESIGNED BY	
CHECKED BY	
BY	
DATE	

STATE OF HAWAII
DEPARTMENT OF TRANSPORTATION
HIGHWAYS DIVISION

MAULUA BRIDGE PLAN
MAULUA/PAHEEH/KAPE/PUKIHAE
BRIDGE JOINT REPAIRS
PROJ. NO. HWY-H-08-00M
Scale: None Date: March, 2000
SHEET No. 1 OF 4 SHEETS