



ORIGINAL	SURVEY PLOTTED BY	DATE
PLAN	DRAWN BY	
NOTE BOOK	TRACED BY	
No.	QUANTITIES BY	
	CHECKED BY	


FED. ROAD DIST. NO.	STATE	FED. AID PROJ. NO.	FISCAL YEAR	SHEET NO.	TOTAL SHEETS
HAWAII	HAW.	BR-019-2(26)	2002	43	155

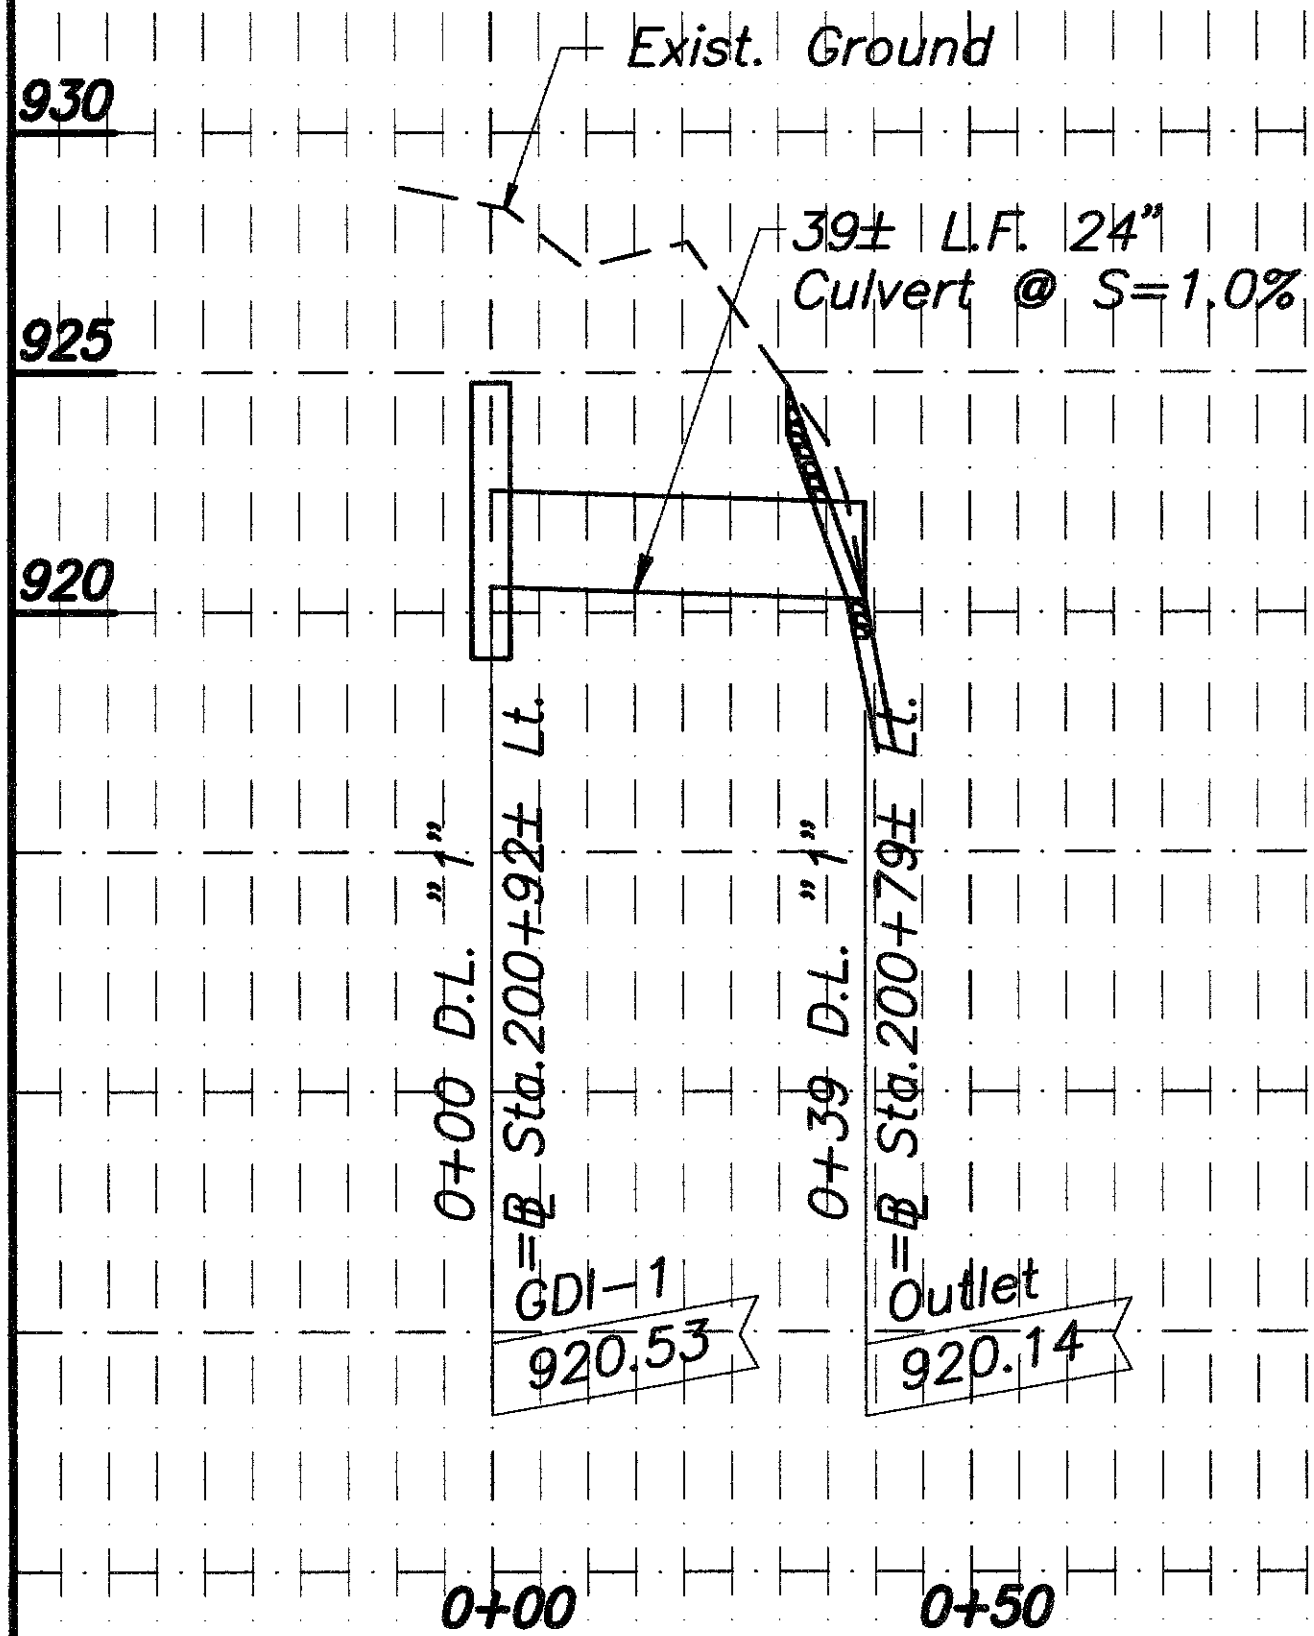


DRAINLINE NO. 1 PROFILE
SCALES: HORIZ. 1"=20'
VERT. 1"=4'

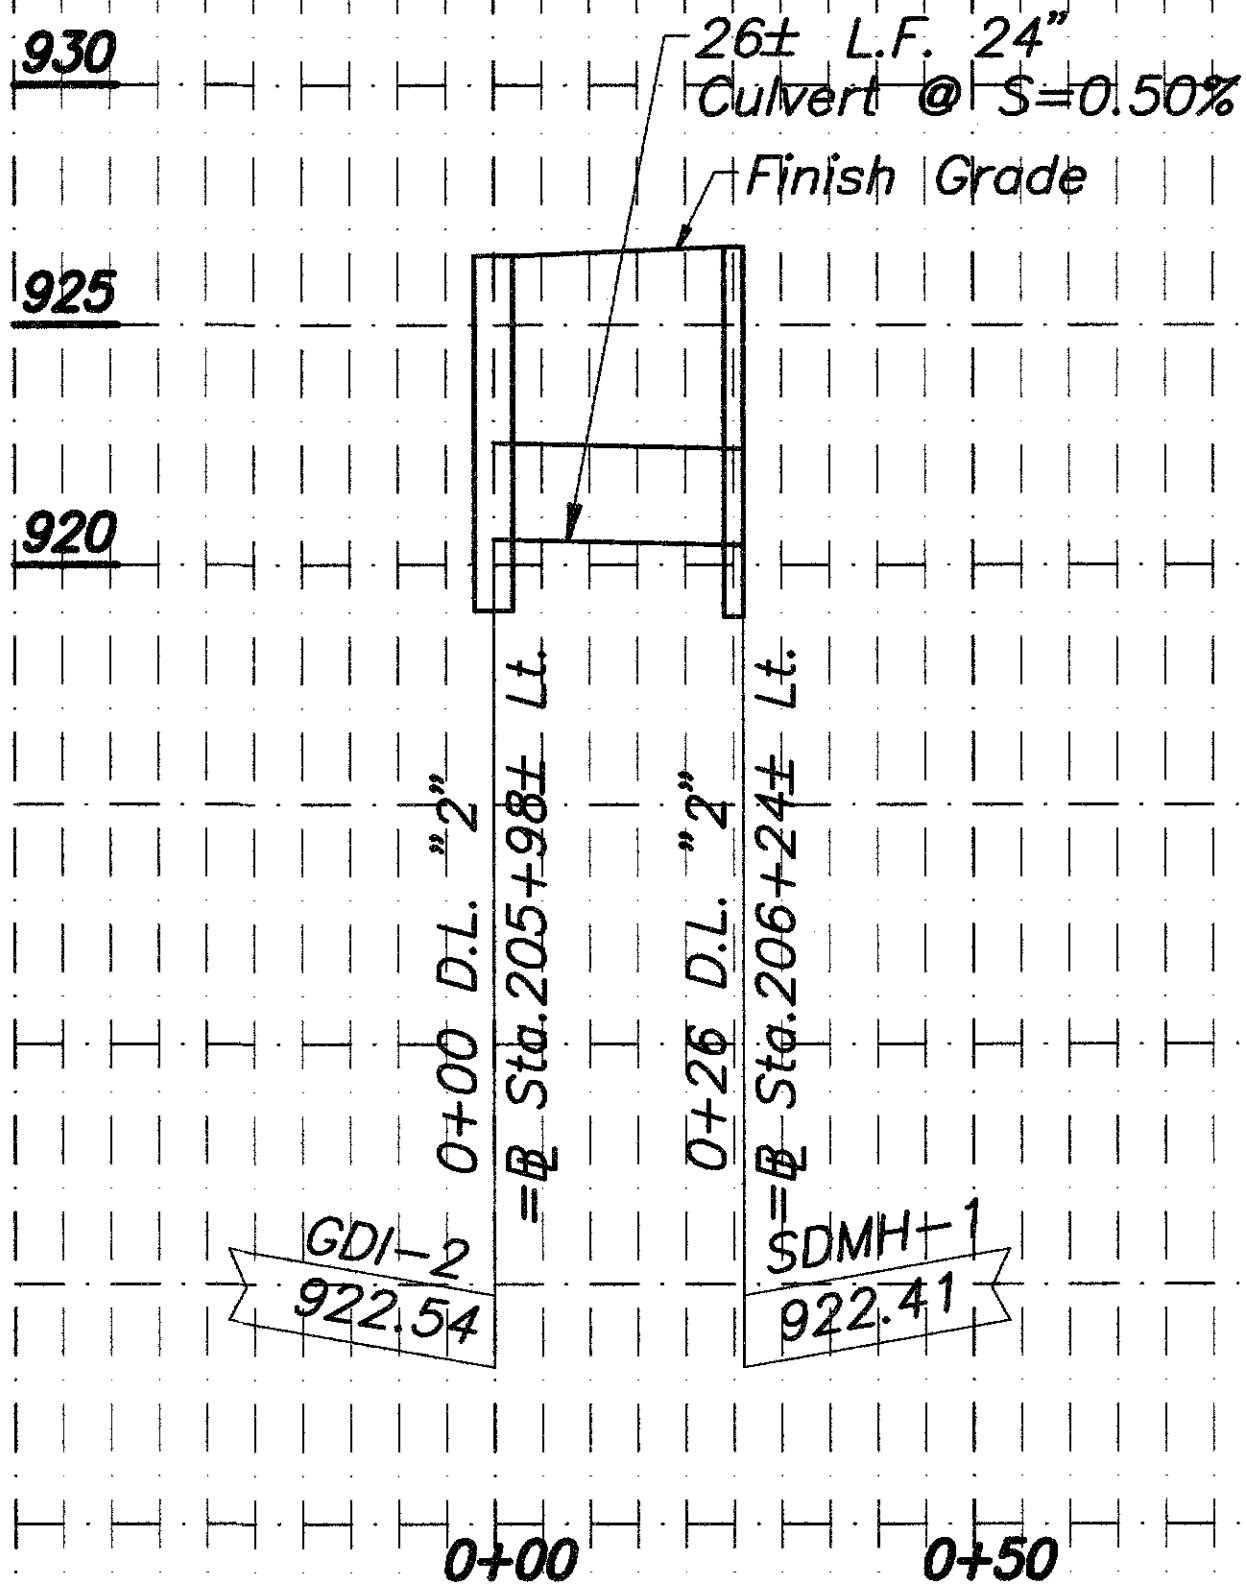

DRAINLINE NO. 2 PROFILE
SCALES: HORIZ. 1"=20'
VERT. 1"=4'

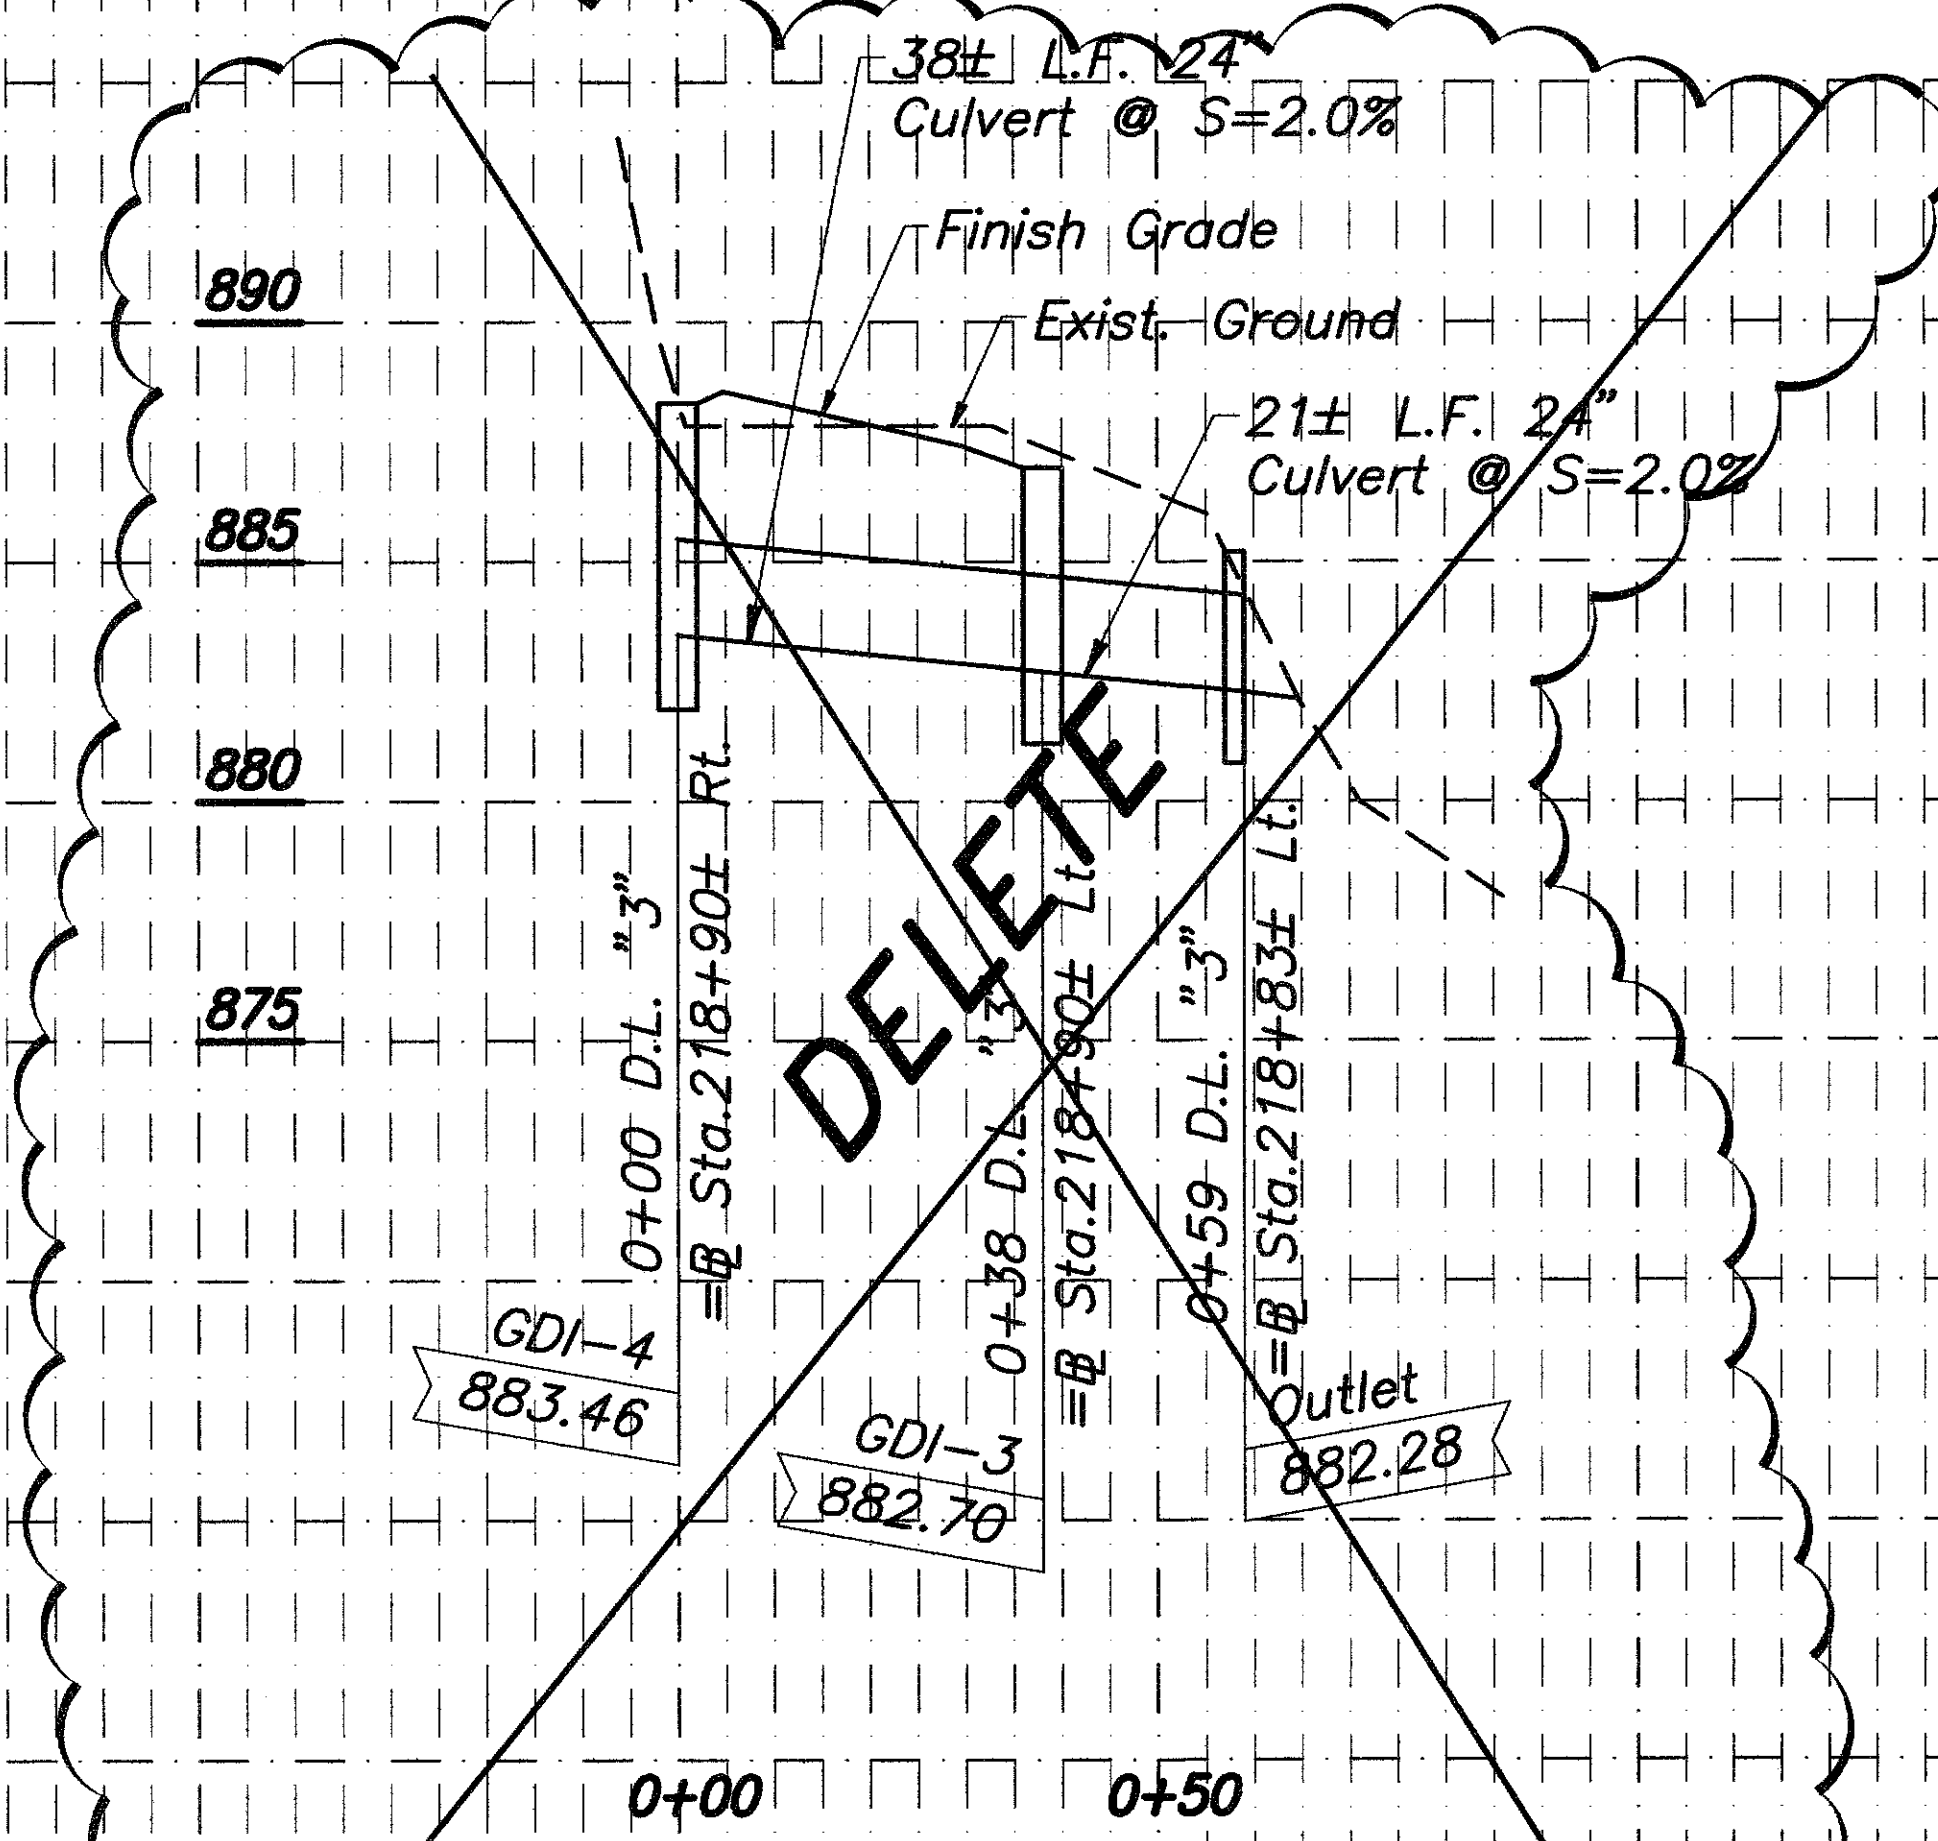


DRAINLINE NO. 3 PROFILE
SCALES: HORIZ. 1"=20'
VERT. 1"=4'

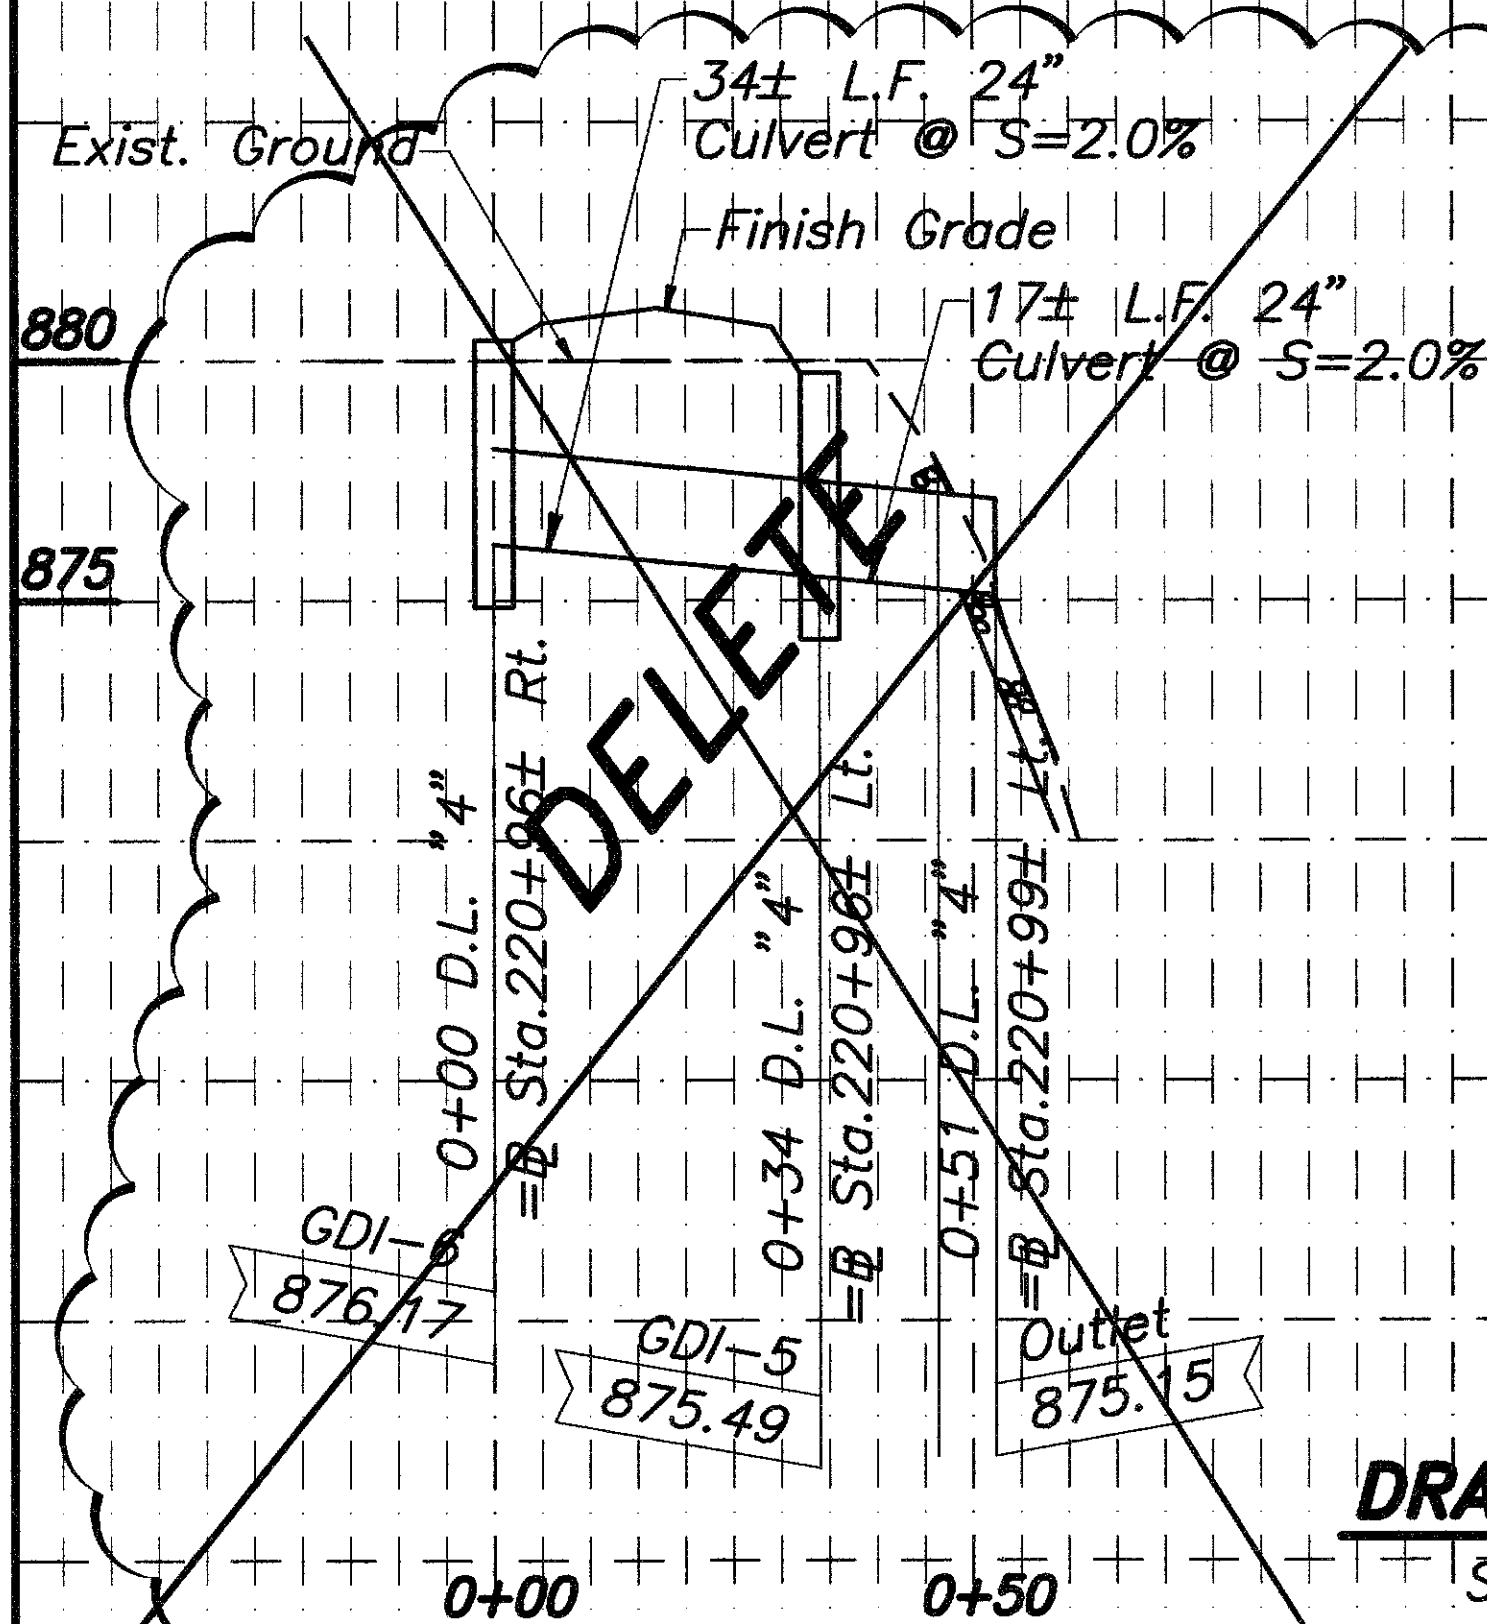

DRAINLINE NO. 4 PROFILE
SCALES: HORIZ. 1"=20'
VERT. 1"=4'

10/09/09 Delete Drainlines 3 & 4

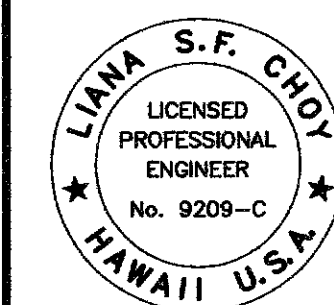

STATE OF HAWAII
DEPARTMENT OF TRANSPORTATION
HIGHWAYS DIVISION

DRAINLINE PROFILE

HAWAII BELT ROAD
KEALAKAHA STREAM BRIDGE REPLACEMENT
PROJECT NO. BR-019-2 (26)

SCALE: NONE DATE: NOVEMBER 2001

SHEET No. 1 OF 1 SHEETS

"AS-BUILT"