
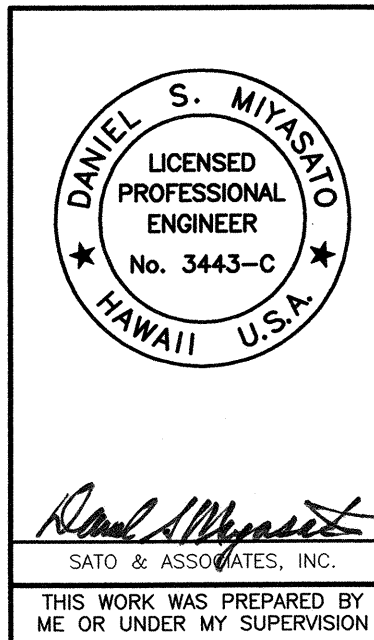


1/5/01

Proj. No. 96048-00

R:\kedoeng\PROFILE.DWG

|                   |                         |            |
|-------------------|-------------------------|------------|
| ORIGINAL<br>PLANT | SURVEY PLOTTED BY _____ | DATE _____ |
| NOTE BOOK         | DESIGNED BY _____       |            |
| No. _____         | QUANTITIES BY _____     |            |
|                   | CHECKED BY _____        |            |

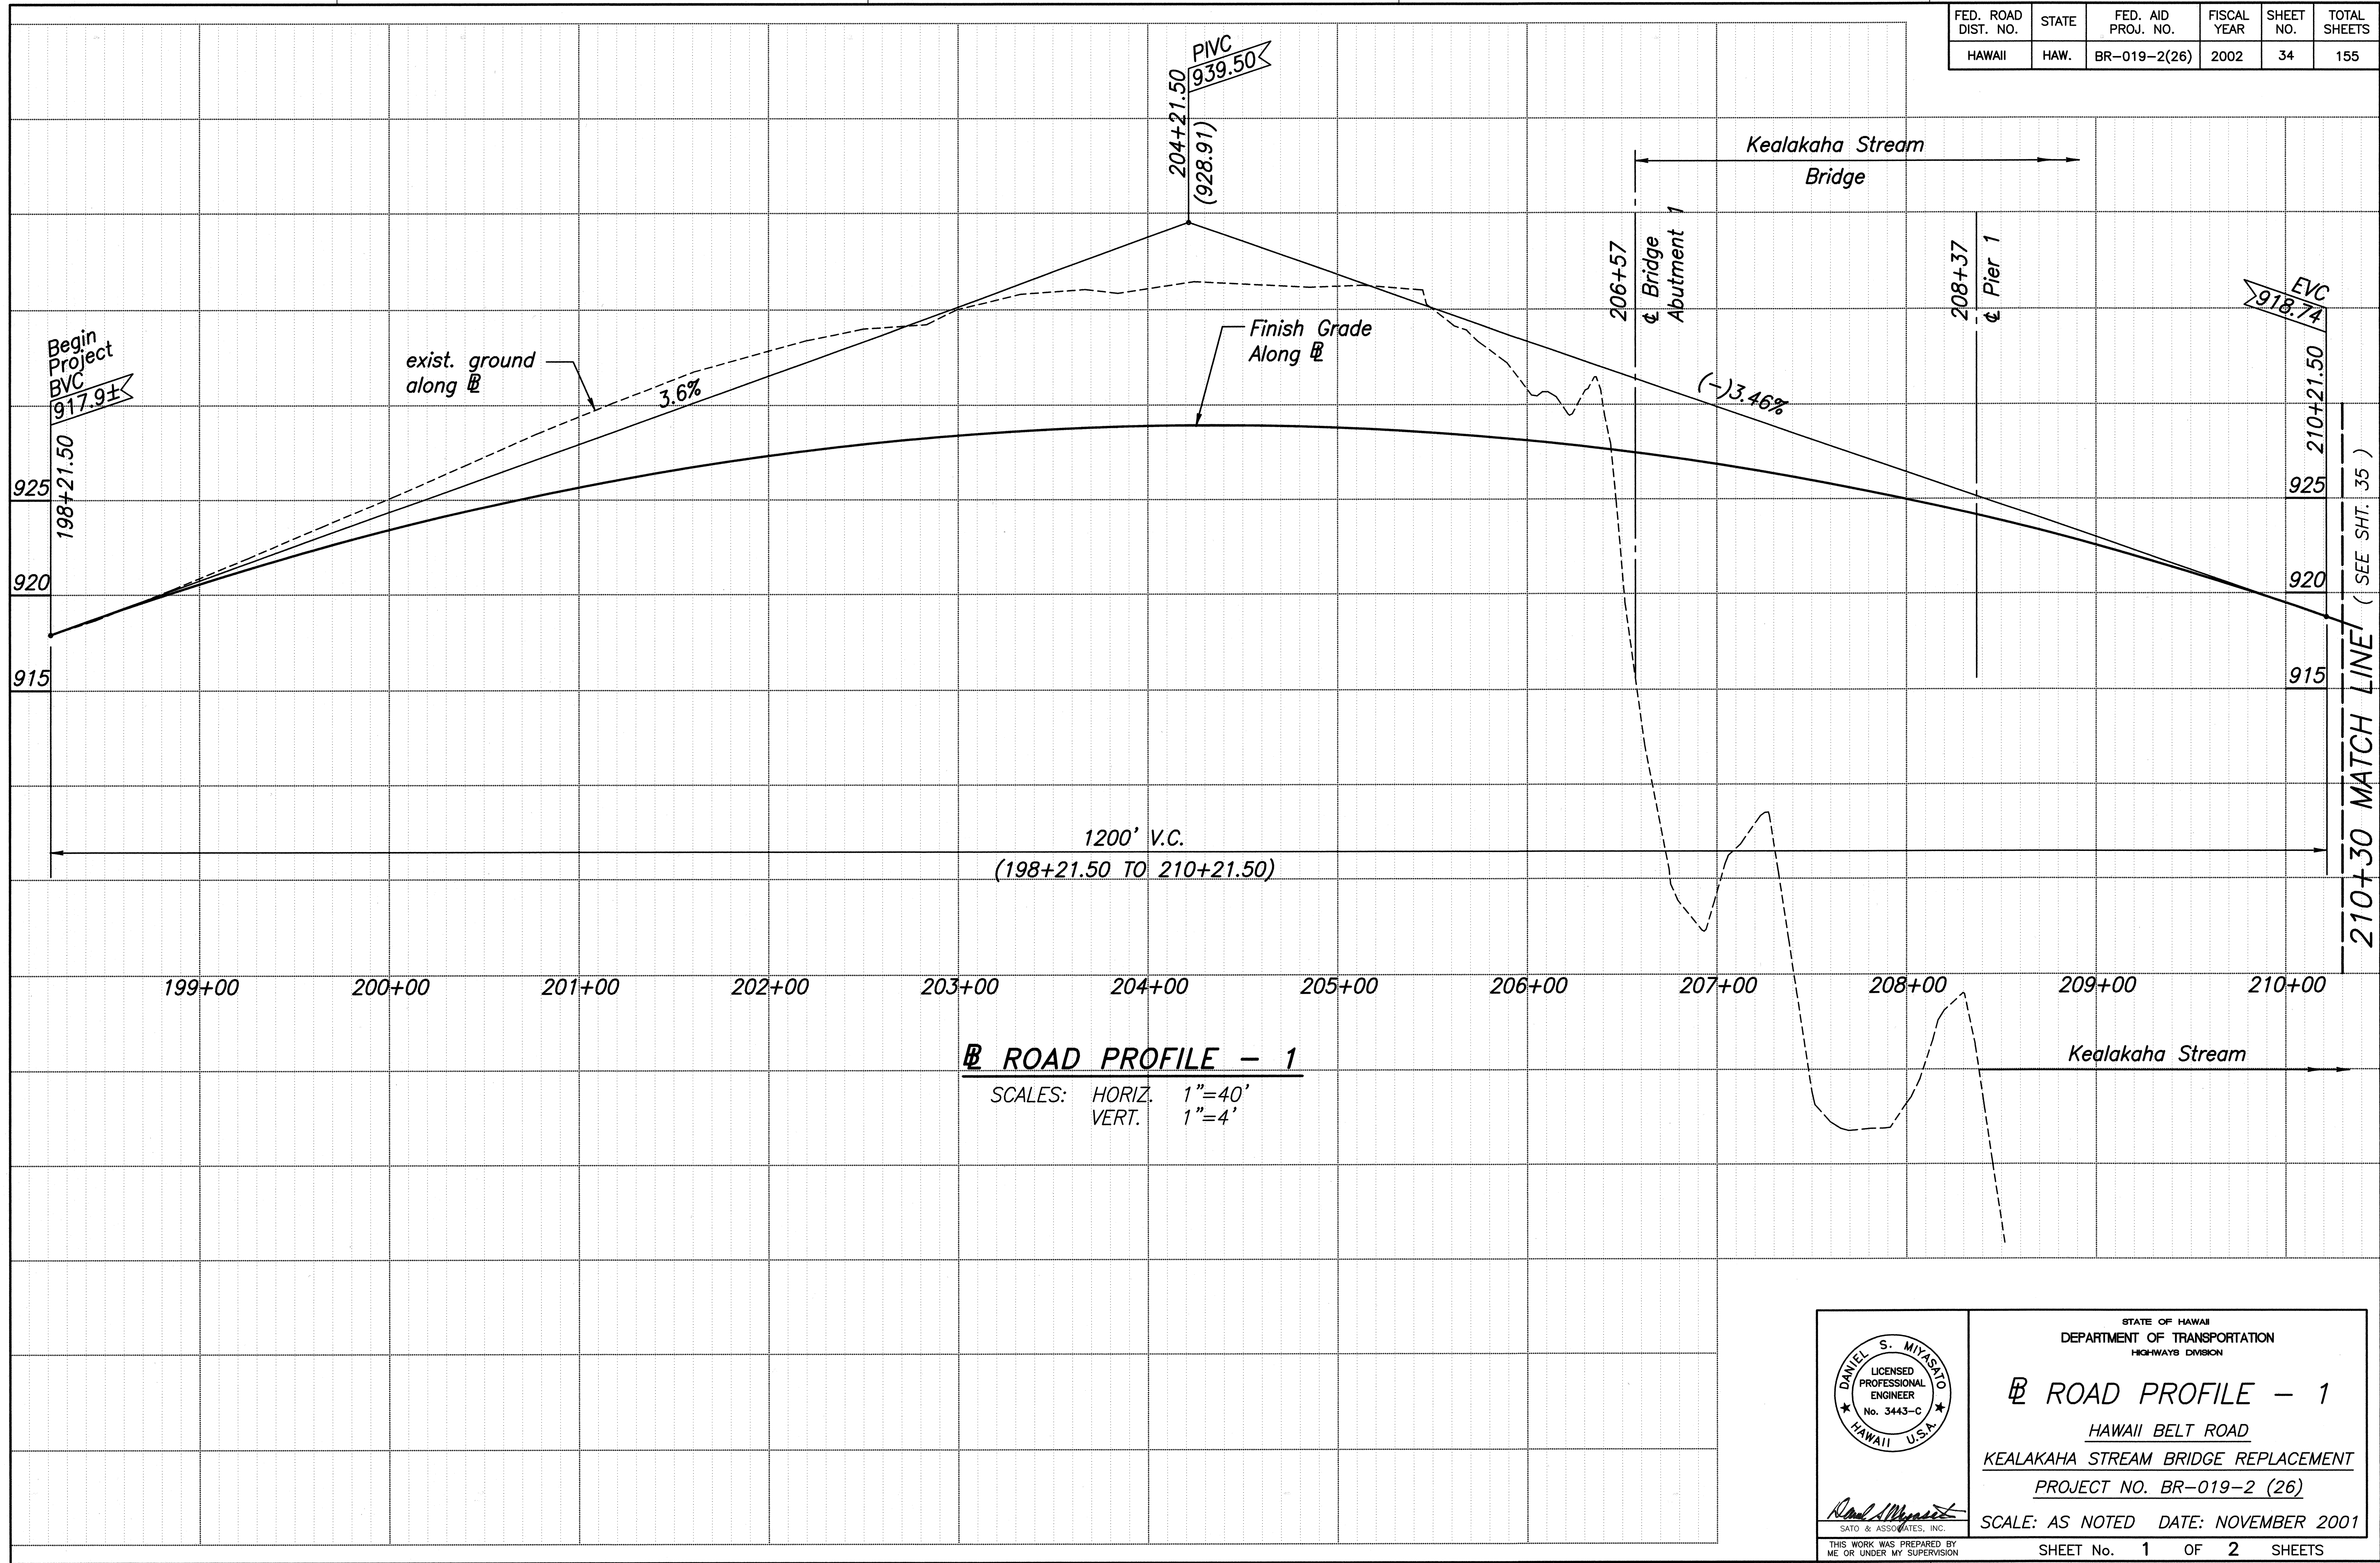

STATE OF HAWAII  
DEPARTMENT OF TRANSPORTATION  
HIGHWAYS DIVISION


**B ROAD PROFILE - 1**

HAWAII BELT ROAD  
KEALAKAHA STREAM BRIDGE REPLACEMENT  
PROJECT NO. BR-019-2 (26)

SCALE: AS NOTED DATE: NOVEMBER 2001

SHEET No. 1 OF 2 SHEETS

|                  |                   |      |
|------------------|-------------------|------|
| ORIGINAL<br>PLAN | SURVEY PLOTTED BY | DATE |
| NOTE BOOK        | DRAWN BY          |      |
| No.              | DESIGNED BY       |      |
|                  | CHECKED BY        |      |

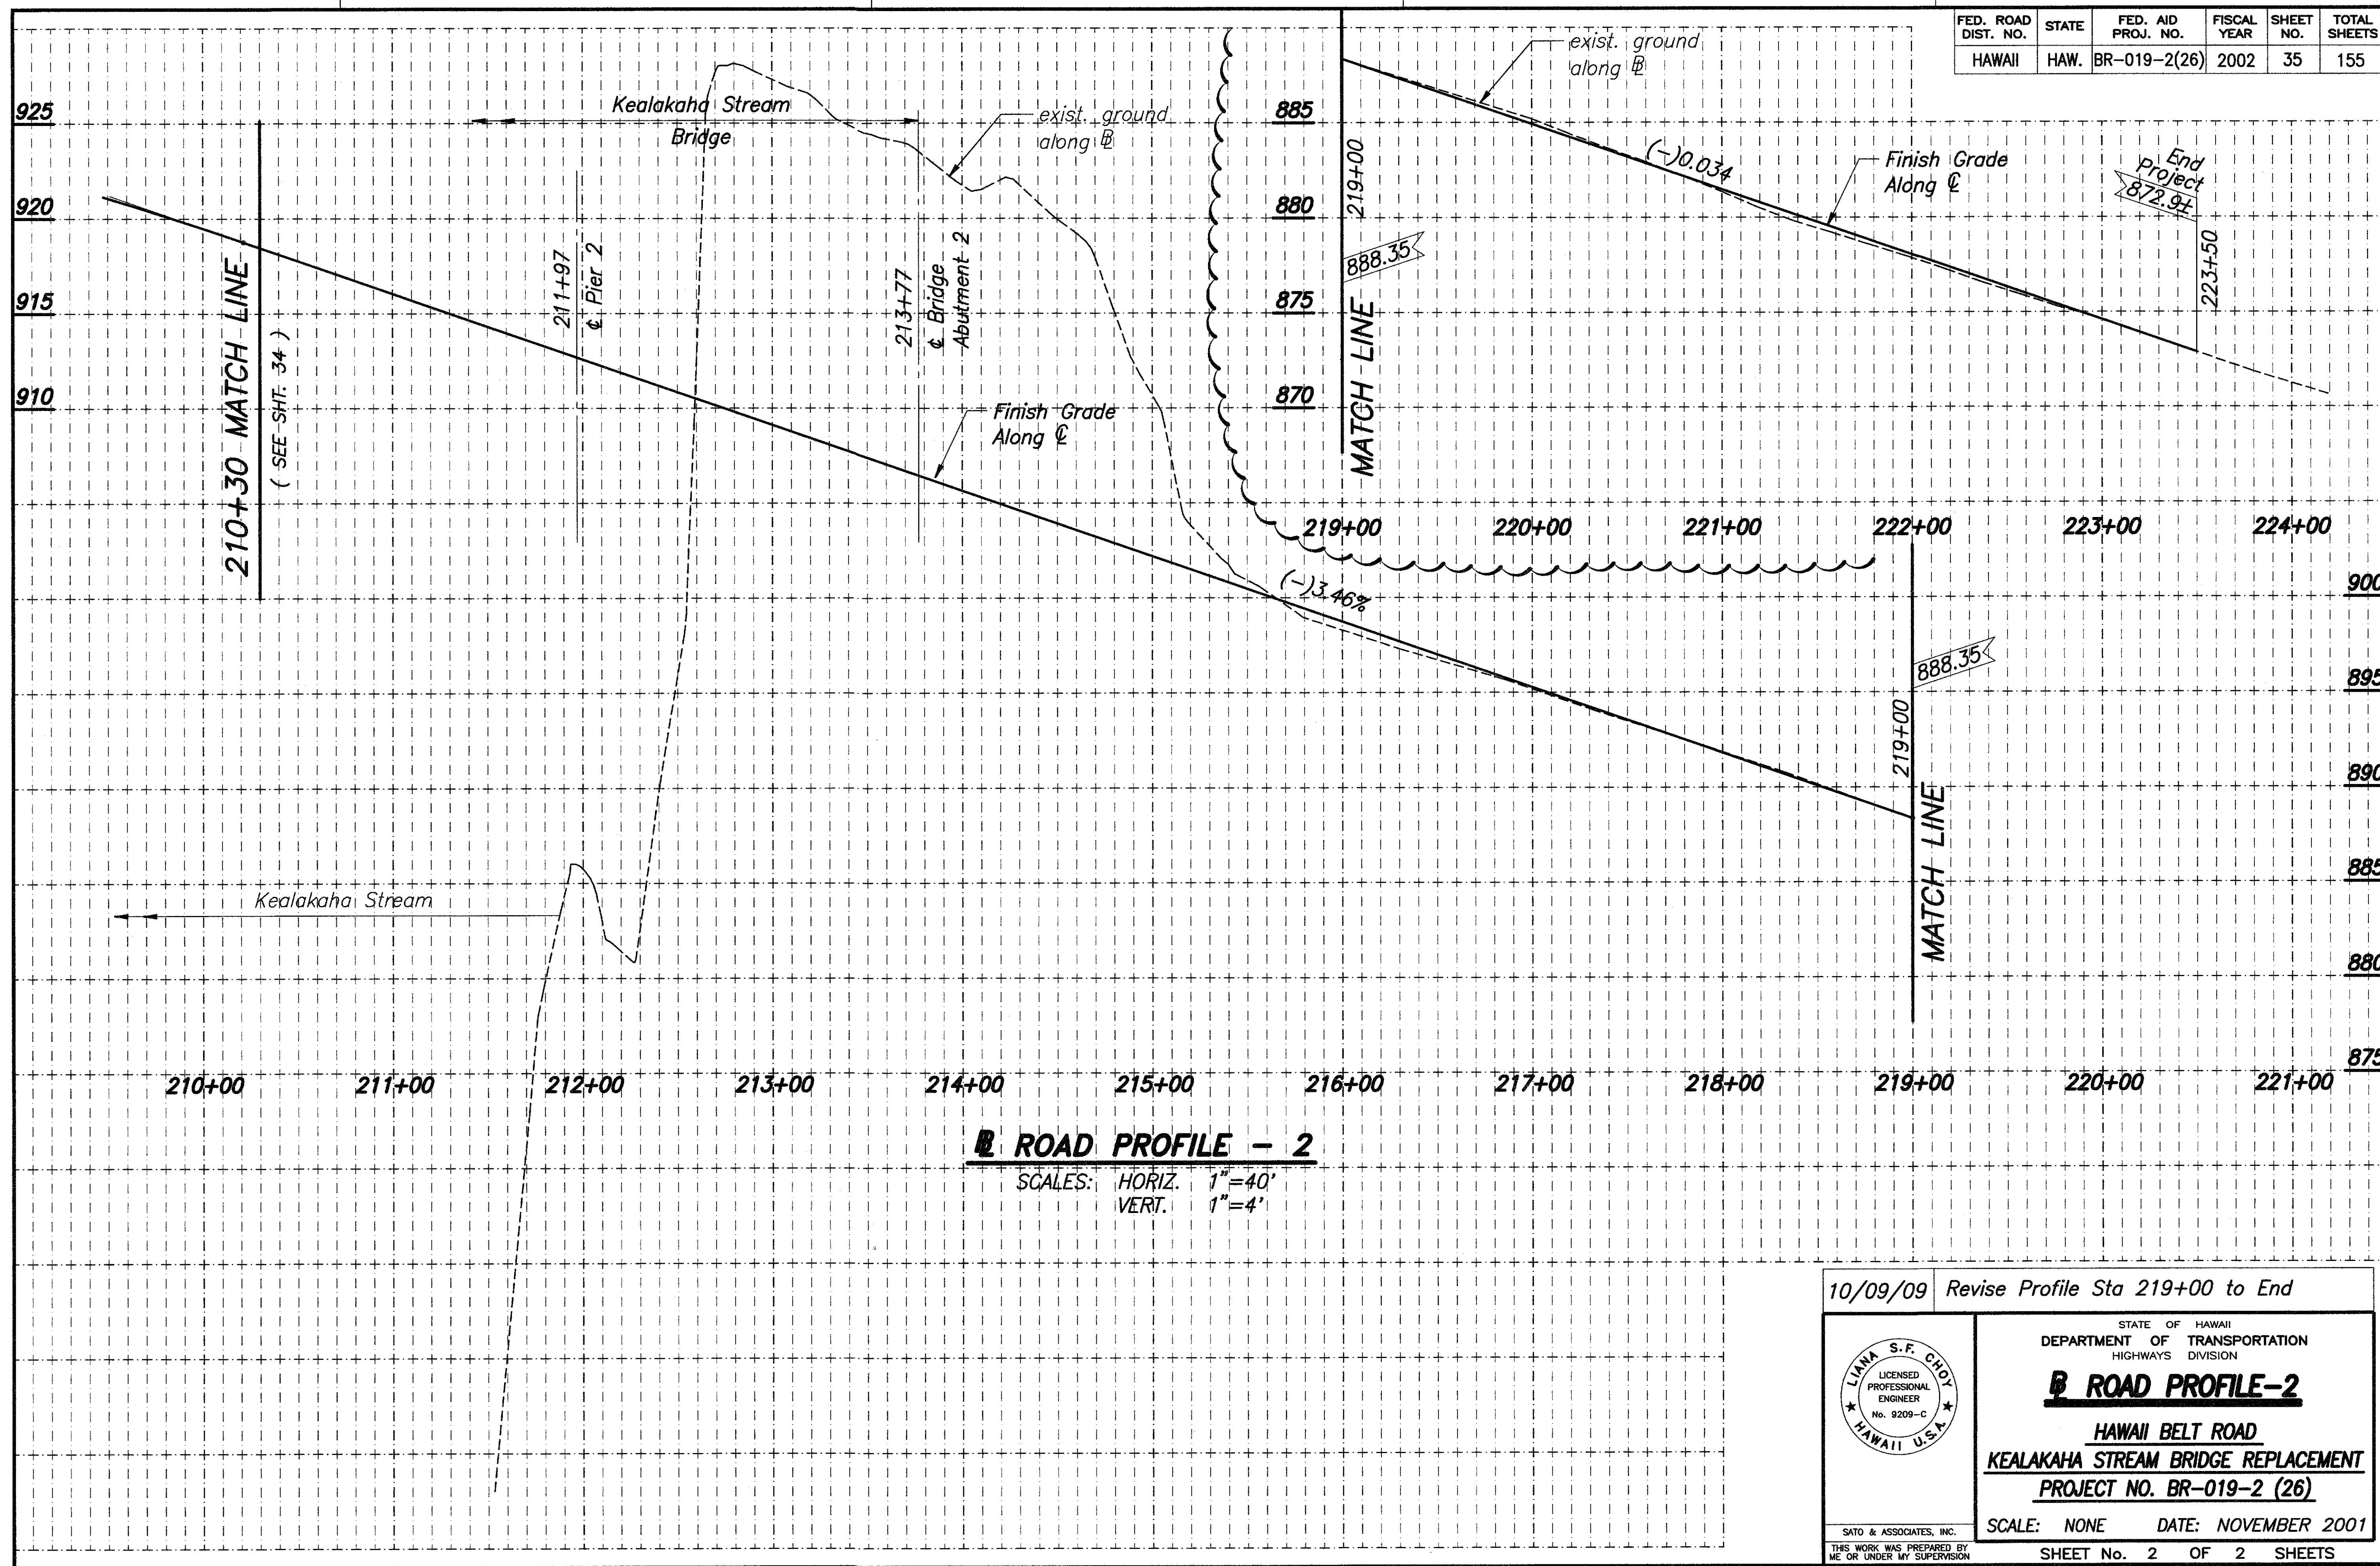

| FED. ROAD DIST. NO. | STATE | FED. AID PROJ. NO. | FISCAL YEAR | SHEET NO. | TOTAL SHEETS |
|---------------------|-------|--------------------|-------------|-----------|--------------|
| HAWAII              | HAW.  | BR-019-2(26)       | 2002        | 35        | 155          |

10/09/09

Revise Profile Sta 219+00 to End

STATE OF HAWAII  
 DEPARTMENT OF TRANSPORTATION  
 HIGHWAYS DIVISION

**B ROAD PROFILE-2**

HAWAII BELT ROAD  
 KEALAKAHA STREAM BRIDGE REPLACEMENT  
 PROJECT NO. BR-019-2 (26)

SCALE: NONE DATE: NOVEMBER 2001

SHEET No. 2 OF 2 SHEETS

"AS-BUILT"