
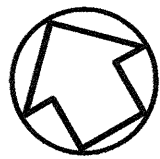



FED. ROAD DIST. NO.	STATE	FED. AID PROJ. NO.	FISCAL YEAR	SHEET NO.	TOTAL SHEETS
HAWAII	HAW.	BR-019-2(26)	2002	55	155

**RPM LEGEND**

- ▣ Type "C"
- Type "D"
- Type "H"
- Type "J"

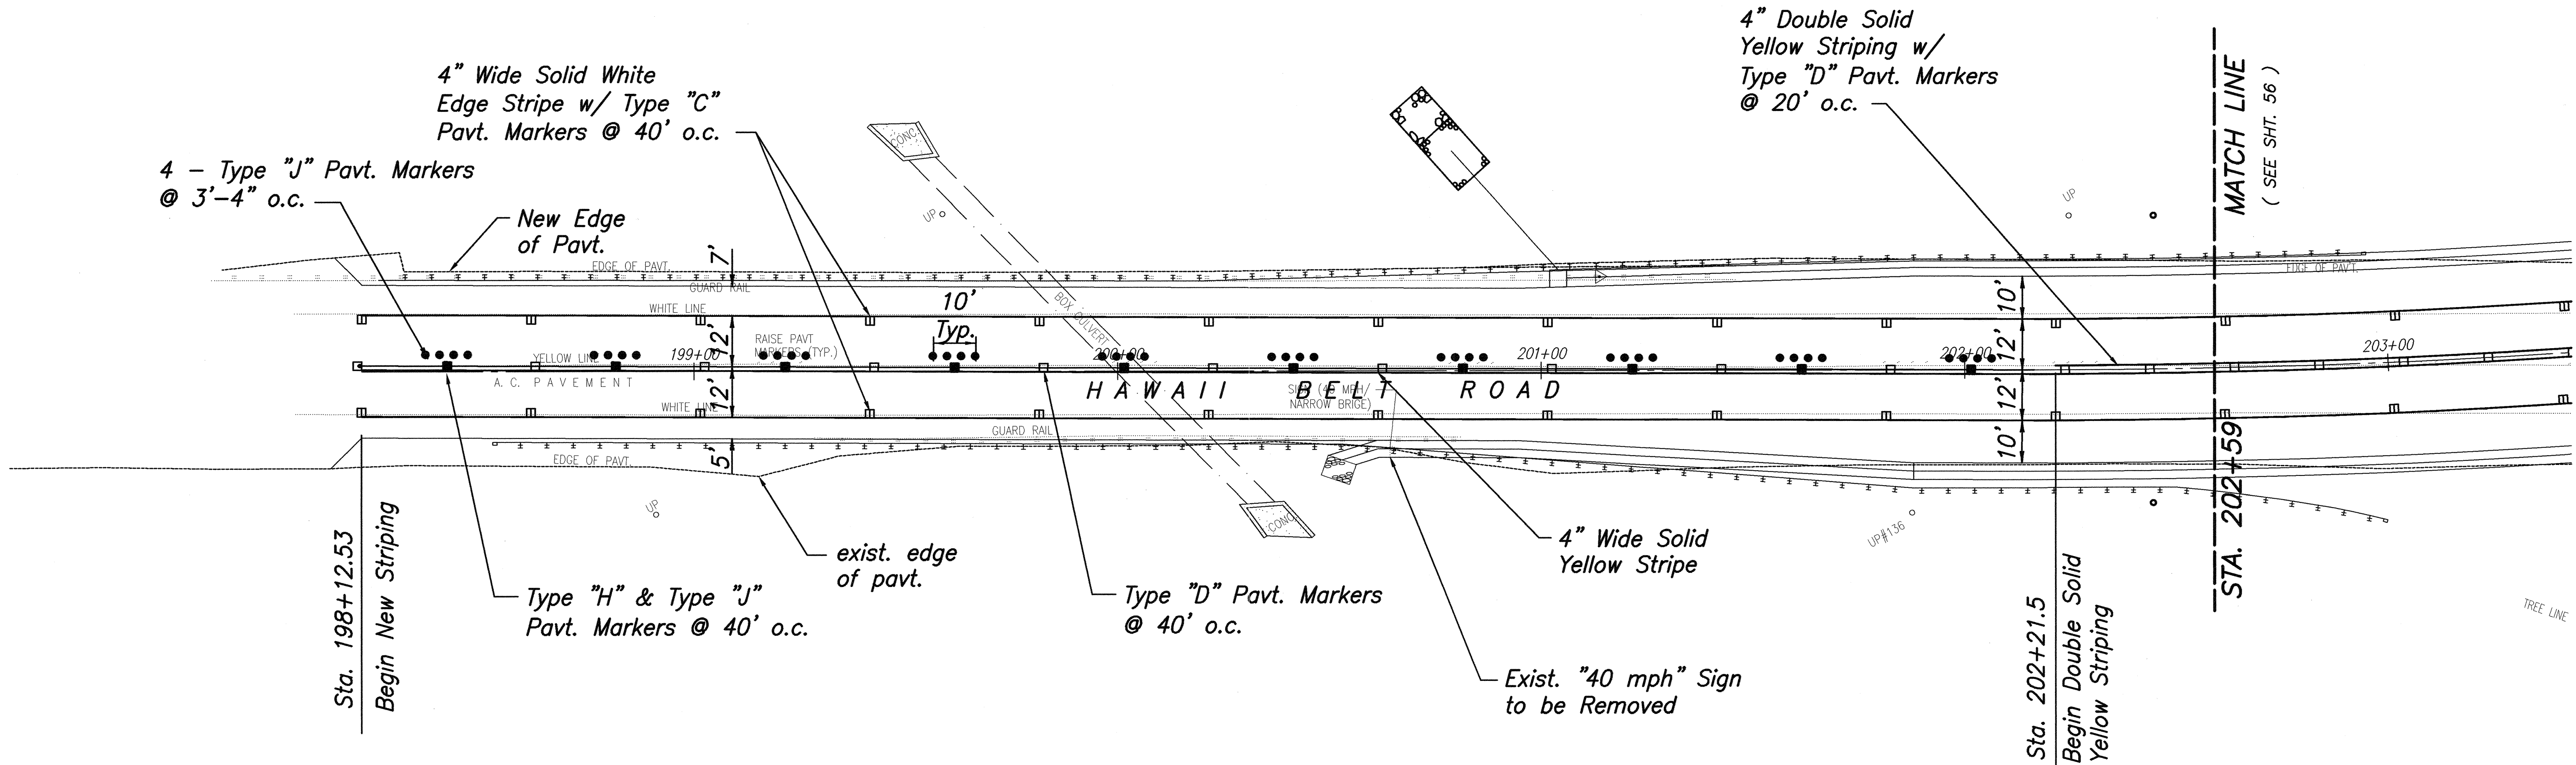


NORTH

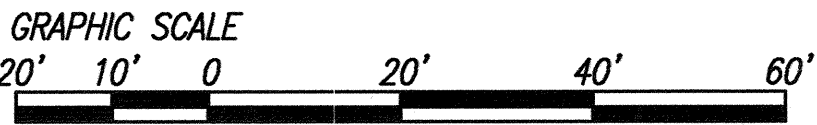

**SIGNING AND STRIPING PLAN 1**

SCALE: 1"=20'

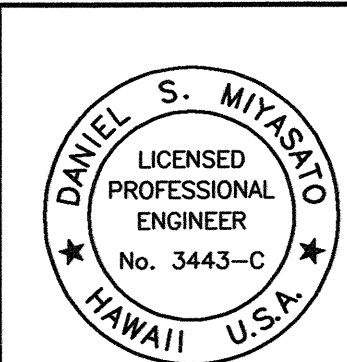

THIS WORK WAS PREPARED BY  
ME OR UNDER MY SUPERVISION

STATE OF HAWAII  
DEPARTMENT OF TRANSPORTATION  
HIGHWAYS DIVISION

**SIGNING AND STRIPING PLAN - 1**  
HAWAII BELT ROAD  
KEALAKAHA STREAM BRIDGE REPLACEMENT  
PROJECT NO. BR-019-2 (26)  
SCALE: AS NOTED DATE: NOVEMBER 2001

SHEET No. 1 OF 6 SHEETS

07/21/00


Proj. No. 96048-00

R:\ledaeng\SIGN.DWG


SURVEY PLOTTED BY	DATE
DRAWN BY	
DESIGNED BY	
QUANTITIES BY	
CHECKED BY	
ORIGINAL PLAN	
NOTE BOOK	
No.	

ORIGINAL	SURVEY PLOTTED BY	DATE
PLAN	DRAWN BY	
NOTE BOOK	DESIGNED BY	
No.	CHECKED BY	

FED. ROAD DIST. NO.	STATE	FED. AID PROJ. NO.	FISCAL YEAR	SHEET NO.	TOTAL SHEETS
HAWAII	HAW.	BR-019-2(26)	2002	56	155

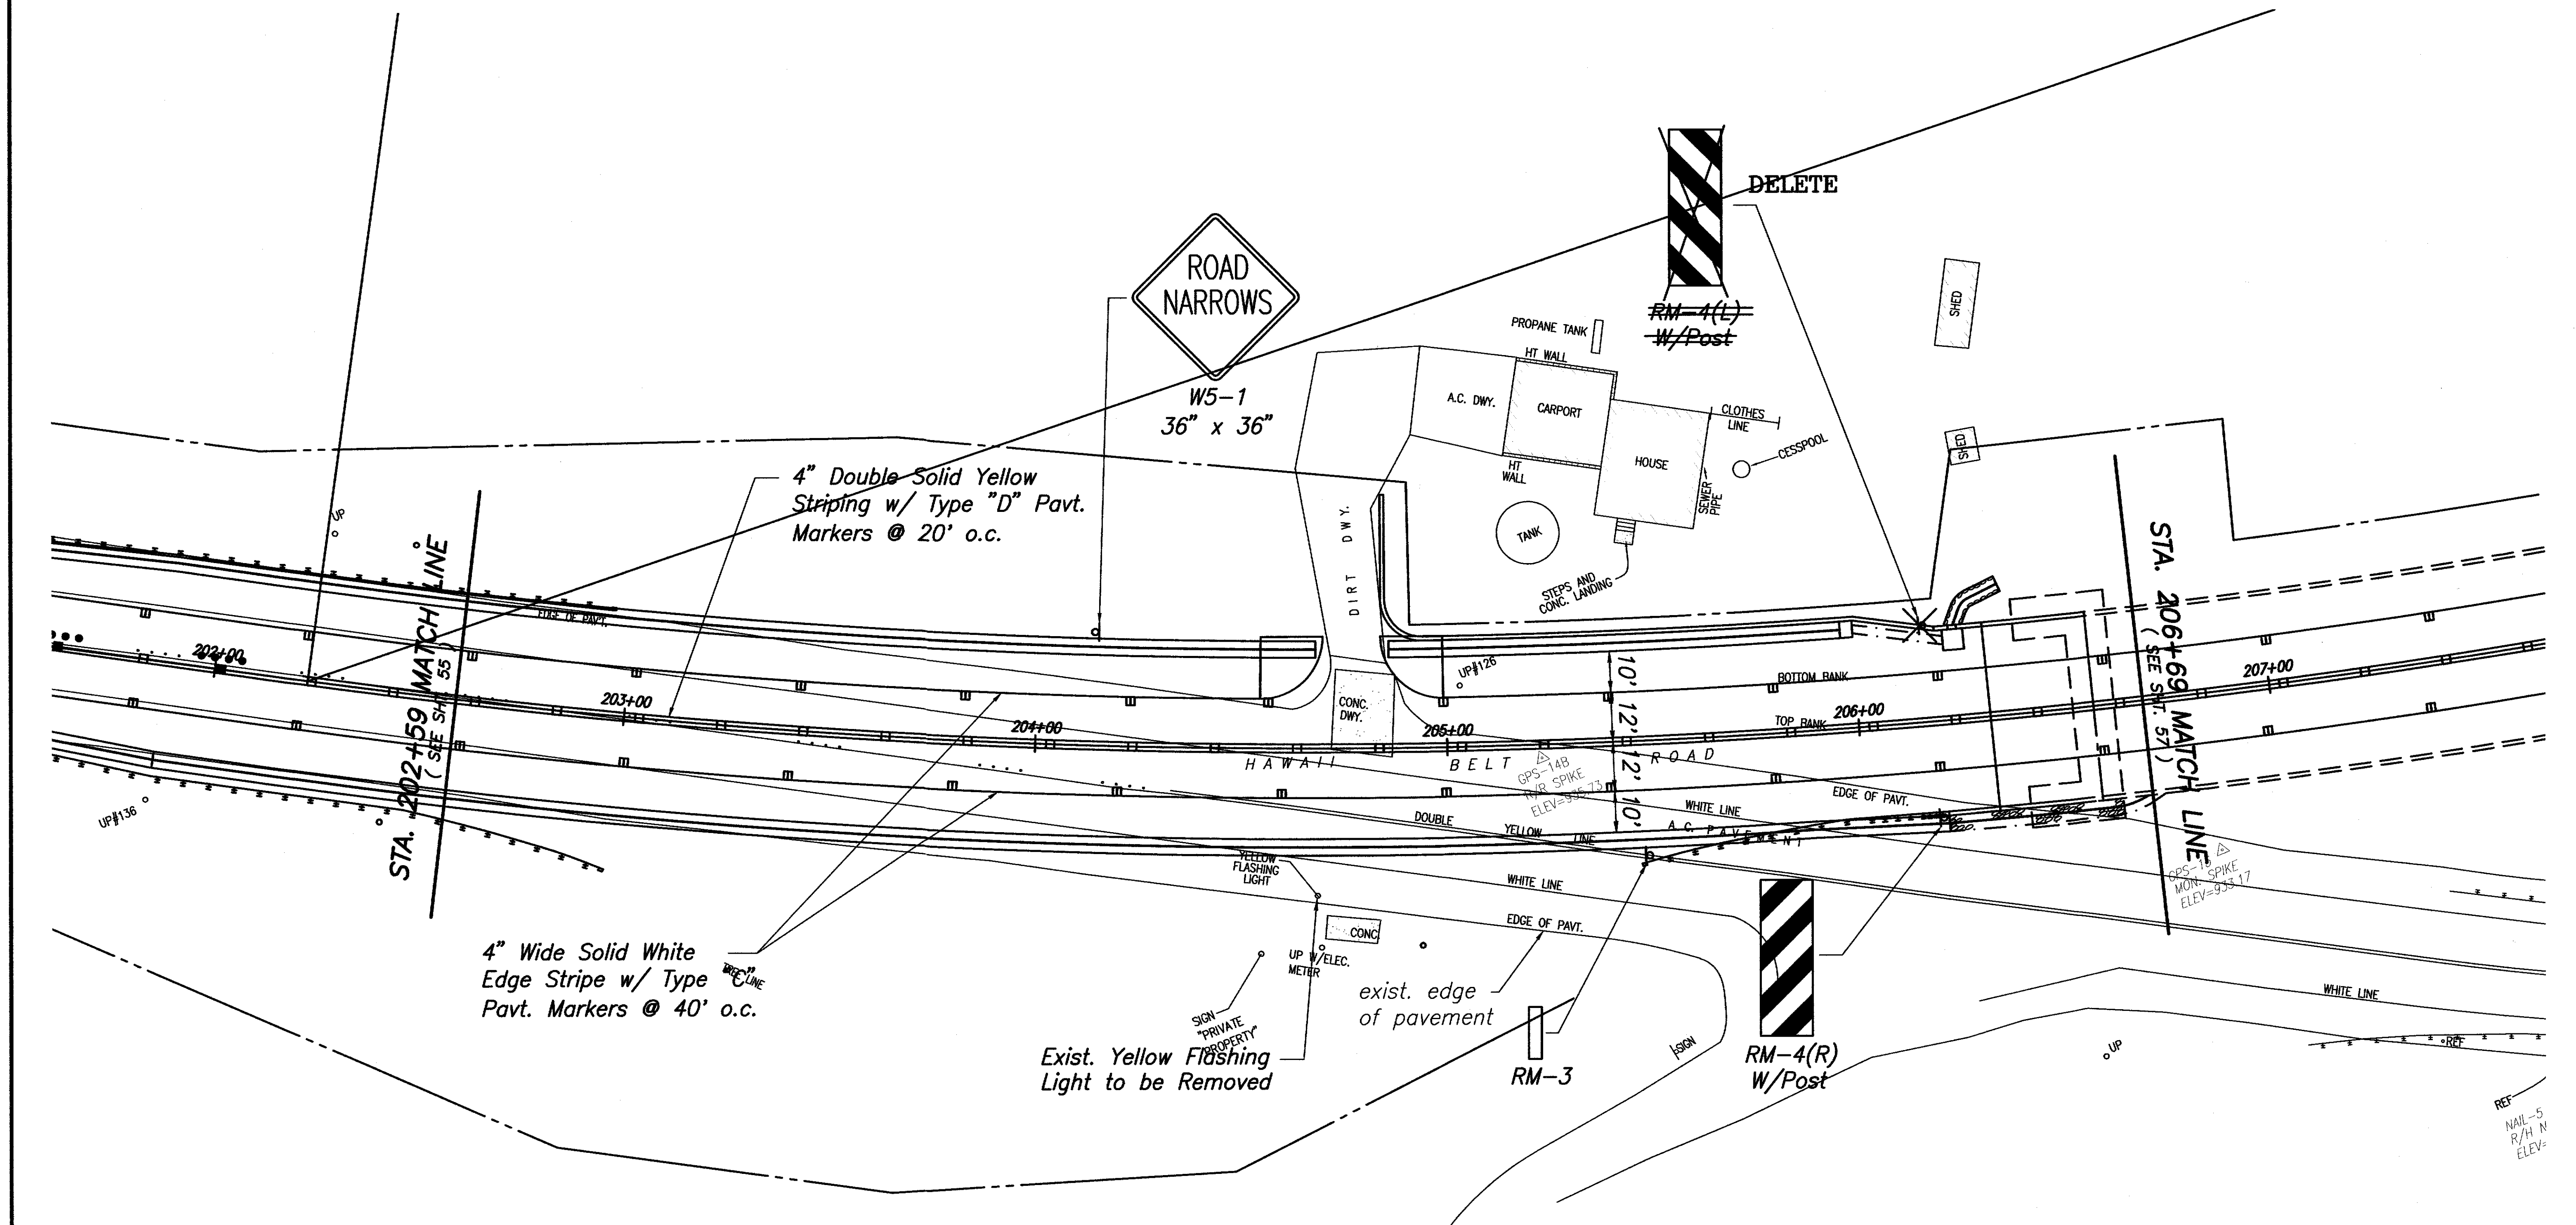

LEGEND FOR AS-BUILT POSTING	
	Squiggly line for as-built deletion
	Double line for as-built deletion
	"X" for as-built deletion
	Text for as-built posting

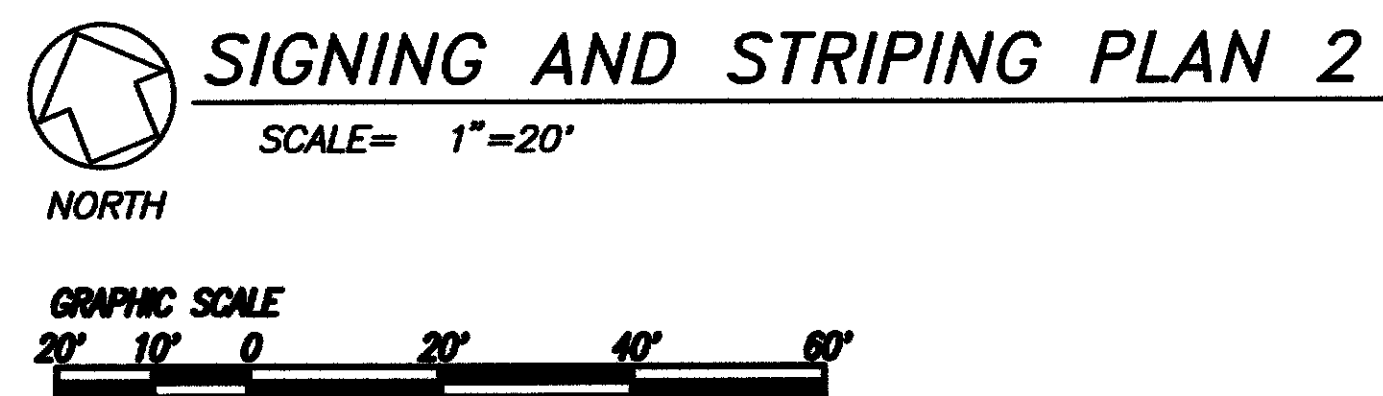

SATO & ASSOCIATES, INC.  
THIS WORK WAS PREPARED BY  
ME OR UNDER MY SUPERVISION

STATE OF HAWAII  
DEPARTMENT OF TRANSPORTATION  
HIGHWAYS DIVISION

**SIGNING AND STRIPING PLAN 2**  
HAWAII BELT ROAD  
KEALAKAHA STREAM BRIDGE REPLACEMENT  
PROJECT NO. BR-019-2 (26)



SCALE: 1"=20' DATE: NOVEMBER 2001

SHEET No. 2 OF 6 SHEETS

LIANA S.F. CHOY  
LICENSED PROFESSIONAL ENGINEER  
No. 9209-C  
HAWAII U.S.A.


"AS-BUILT"

FED. ROAD DIST. NO.	STATE	FED. AID PROJ. NO.	FISCAL YEAR	SHEET NO.	TOTAL SHEETS
HAWAII	HAW.	BR-019-2(26)	2002	57	155

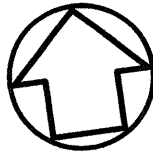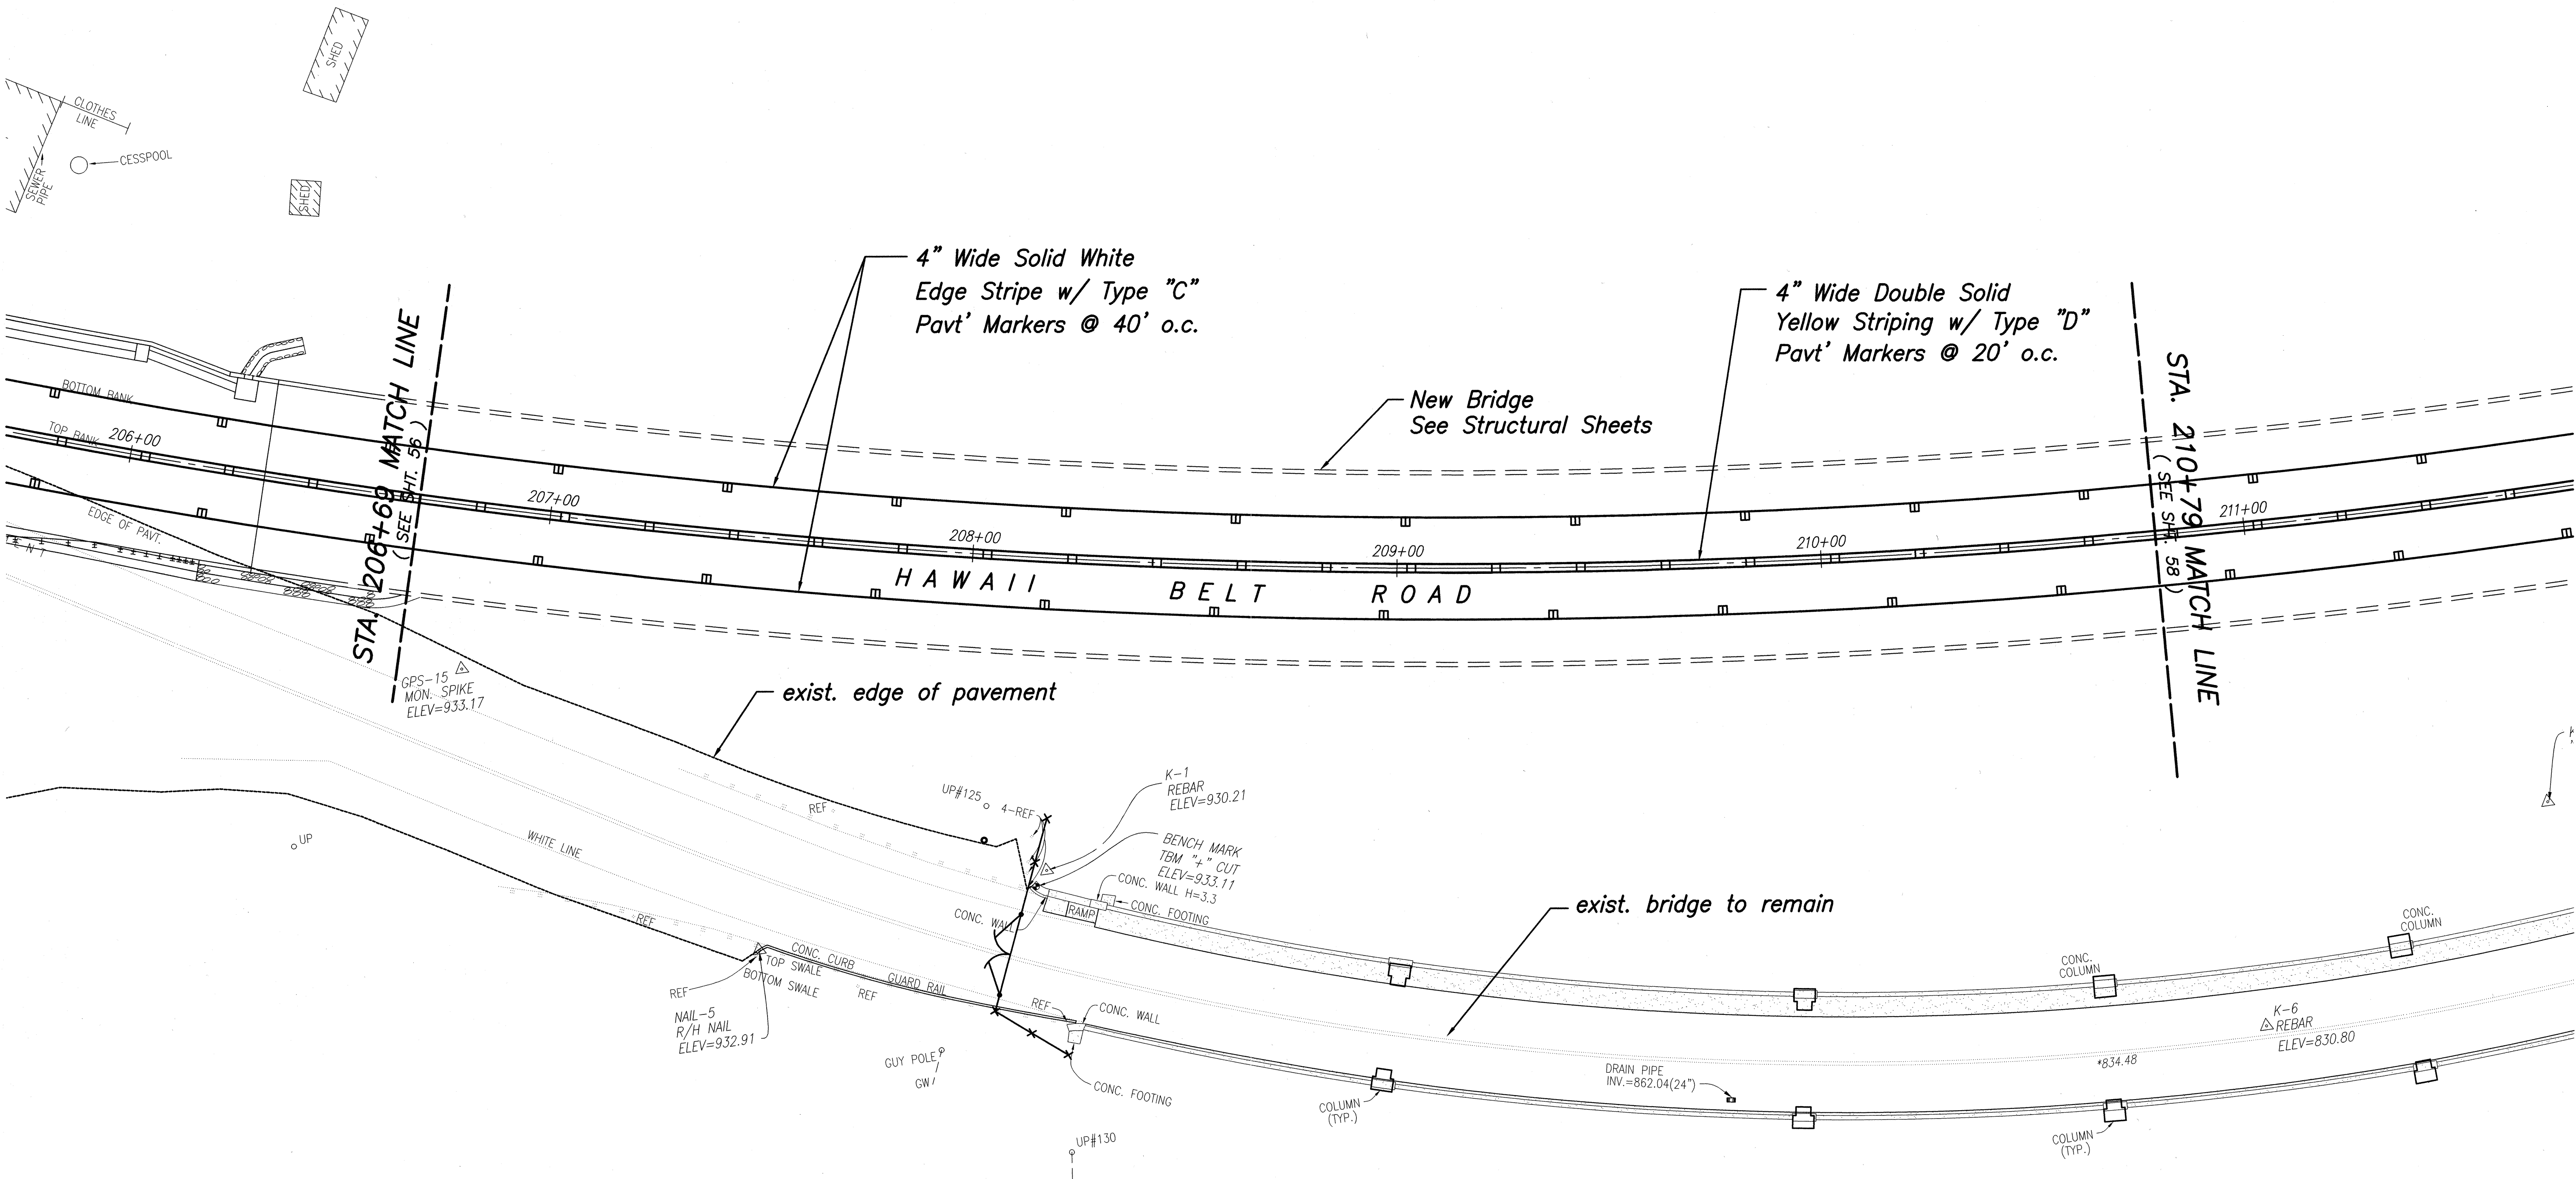


**SIGNING AND STRIPING PLAN 3**

SCALE= 1"=20'

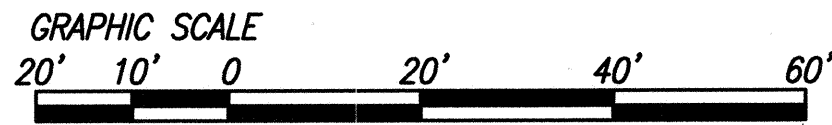

DATE	____
SURVEY PLOTTED BY	____
DESIGNED BY	____
TRACED BY	____
DESIGNED BY	____
QUANTITIES BY	____
CHECKED BY	____
ORIGINAL	____
NOTE BOOK	____
No.	____

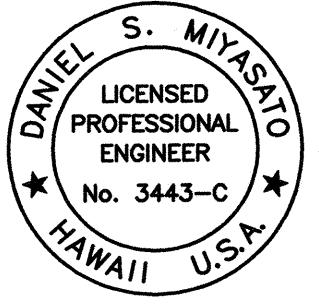

STATE OF HAWAII  
 DEPARTMENT OF TRANSPORTATION  
 HIGHWAYS DIVISION  
**SIGNING AND STRIPING PLAN - 3**  
 HAWAII BELT ROAD  
 KEALAKAHA STREAM BRIDGE REPLACEMENT  
 PROJECT NO. BR-019-2 (26)  
 SCALE: AS NOTED DATE: NOVEMBER 2001  
 SHEET No. **3** OF **6** SHEETS

THIS WORK WAS PREPARED BY  
 ME OR UNDER MY SUPERVISION

SATO & ASSOCIATES, INC.


07/21/00

Proj. No. 96048-00


R:\kedlaeng\SIGN.DWG



FED. ROAD DIST. NO.	STATE	FED. AID PROJ. NO.	FISCAL YEAR	SHEET NO.	TOTAL SHEETS
HAWAII	HAW.	BR-019-2(26)	2002	58	155

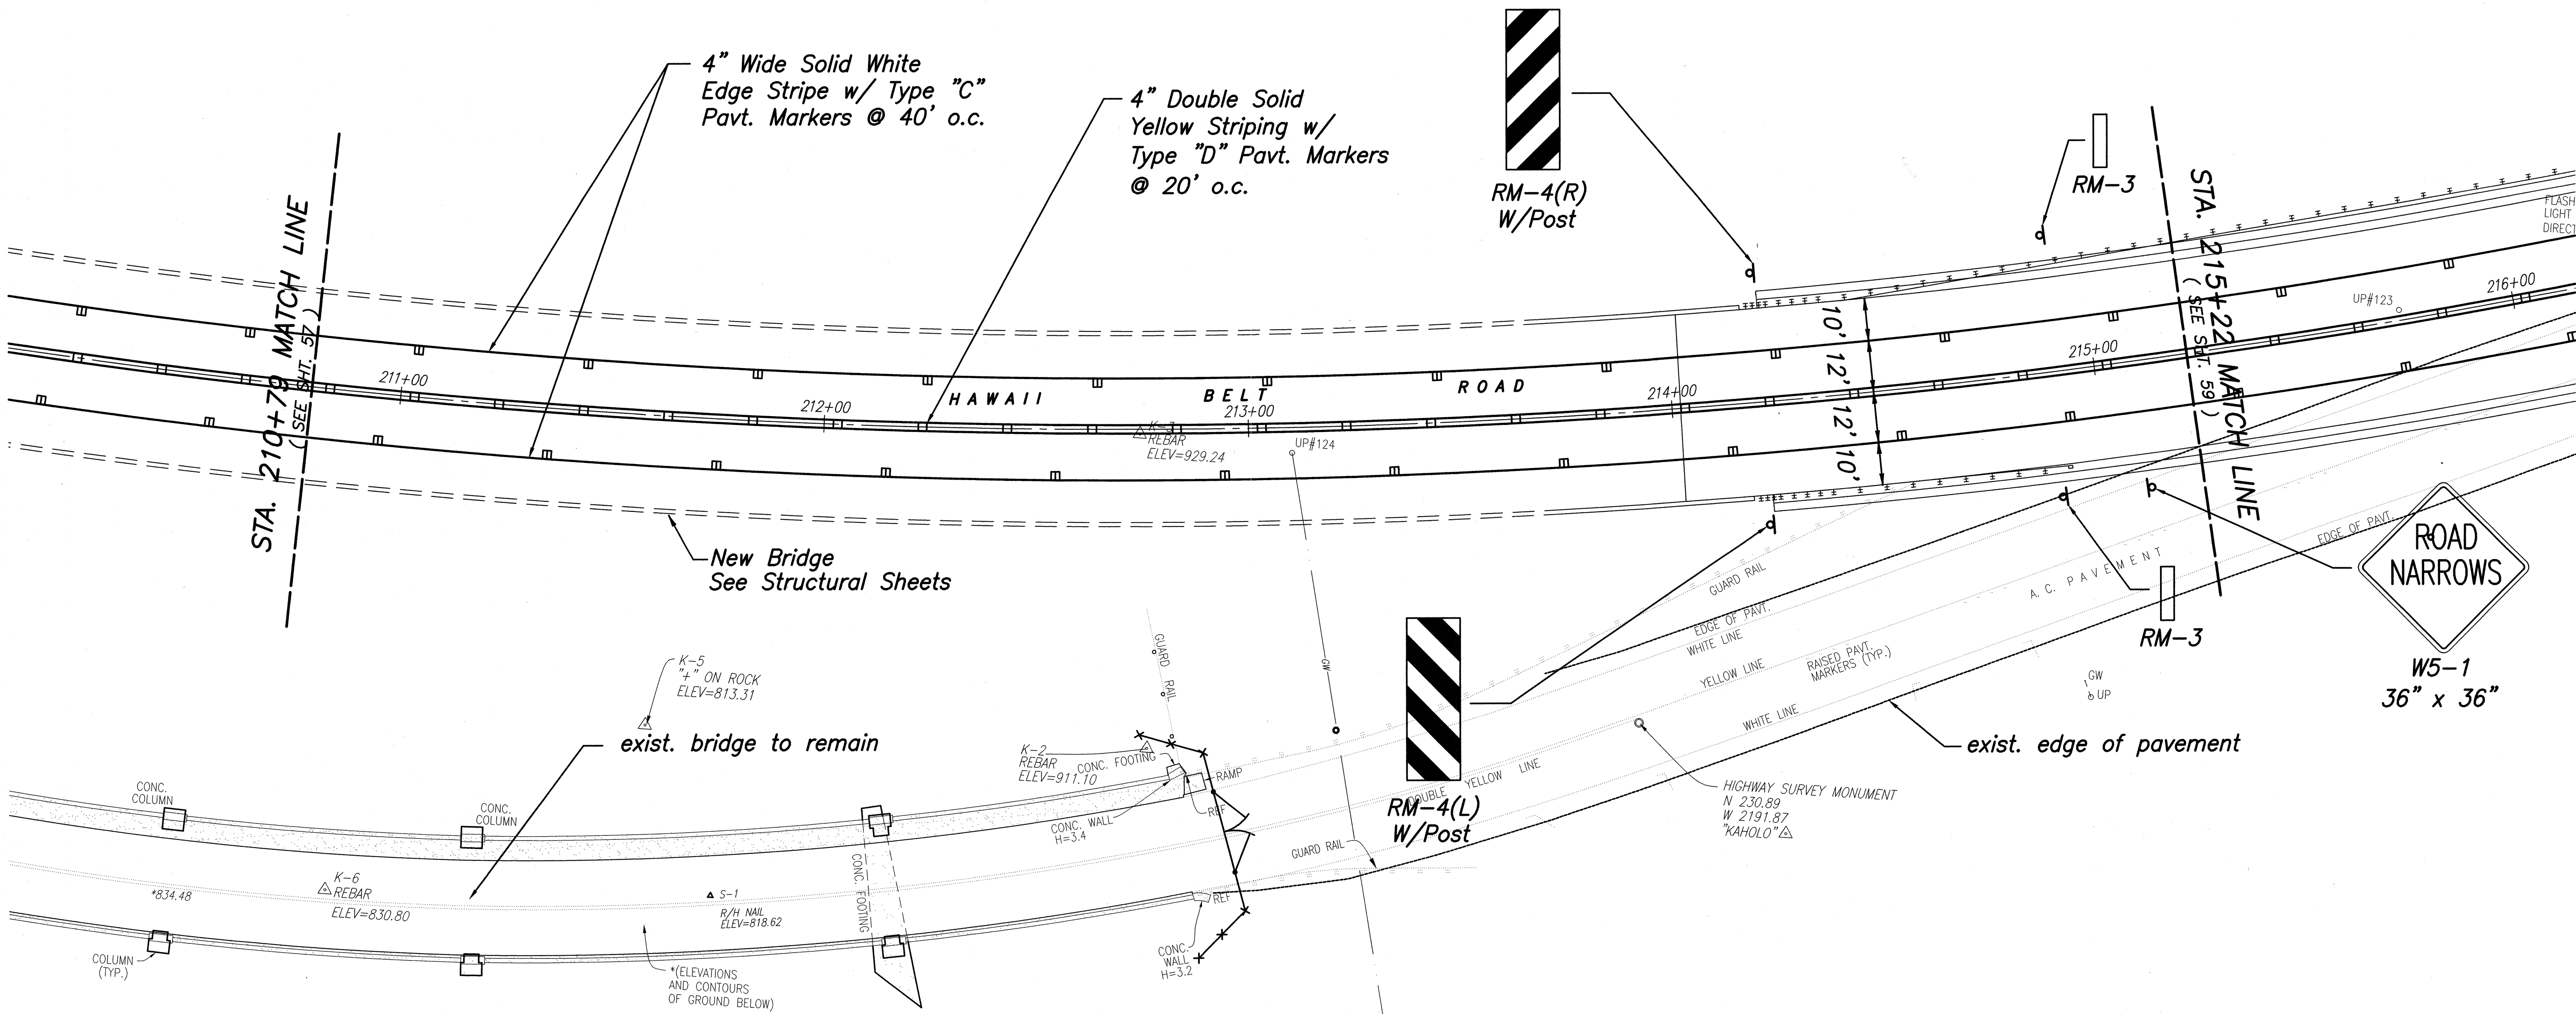

# **SIGNING AND STRIPING PLAN 4** SCALE= 1"=20' NORTH

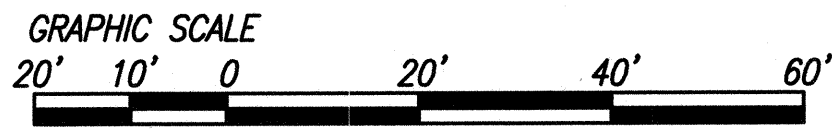

STATE OF HAWAII  
 DEPARTMENT OF TRANSPORTATION  
 HIGHWAYS DIVISION  
**SIGNING AND STRIPING PLAN - 4**  
 HAWAII BELT ROAD  
 KEALAKAHA STREAM BRIDGE REPLACEMENT  
 PROJECT NO. BR-019-2 (26)  
 SCALE: AS NOTED DATE: NOVEMBER 2001  
 SHEET No. 4 OF 6 SHEETS

THIS WORK WAS PREPARED BY ME OR UNDER MY SUPERVISION

SATO & ASSOCIATES, INC.


07/21/00

Proj. No. 96048-00

R:\kecladeng\SIGN.DWG

ORIGINAL	DATE
FILED	DATE
NOTE BOOK	DESIGNED BY
QUANTITIES BY	CHECKED BY
No.	No.

FED. ROAD DIST. NO.	STATE	FED. AID PROJ. NO.	FISCAL YEAR	SHEET NO.	TOTAL SHEETS
HAWAII	HAW.	BR-019-2(26)	2002	59	155

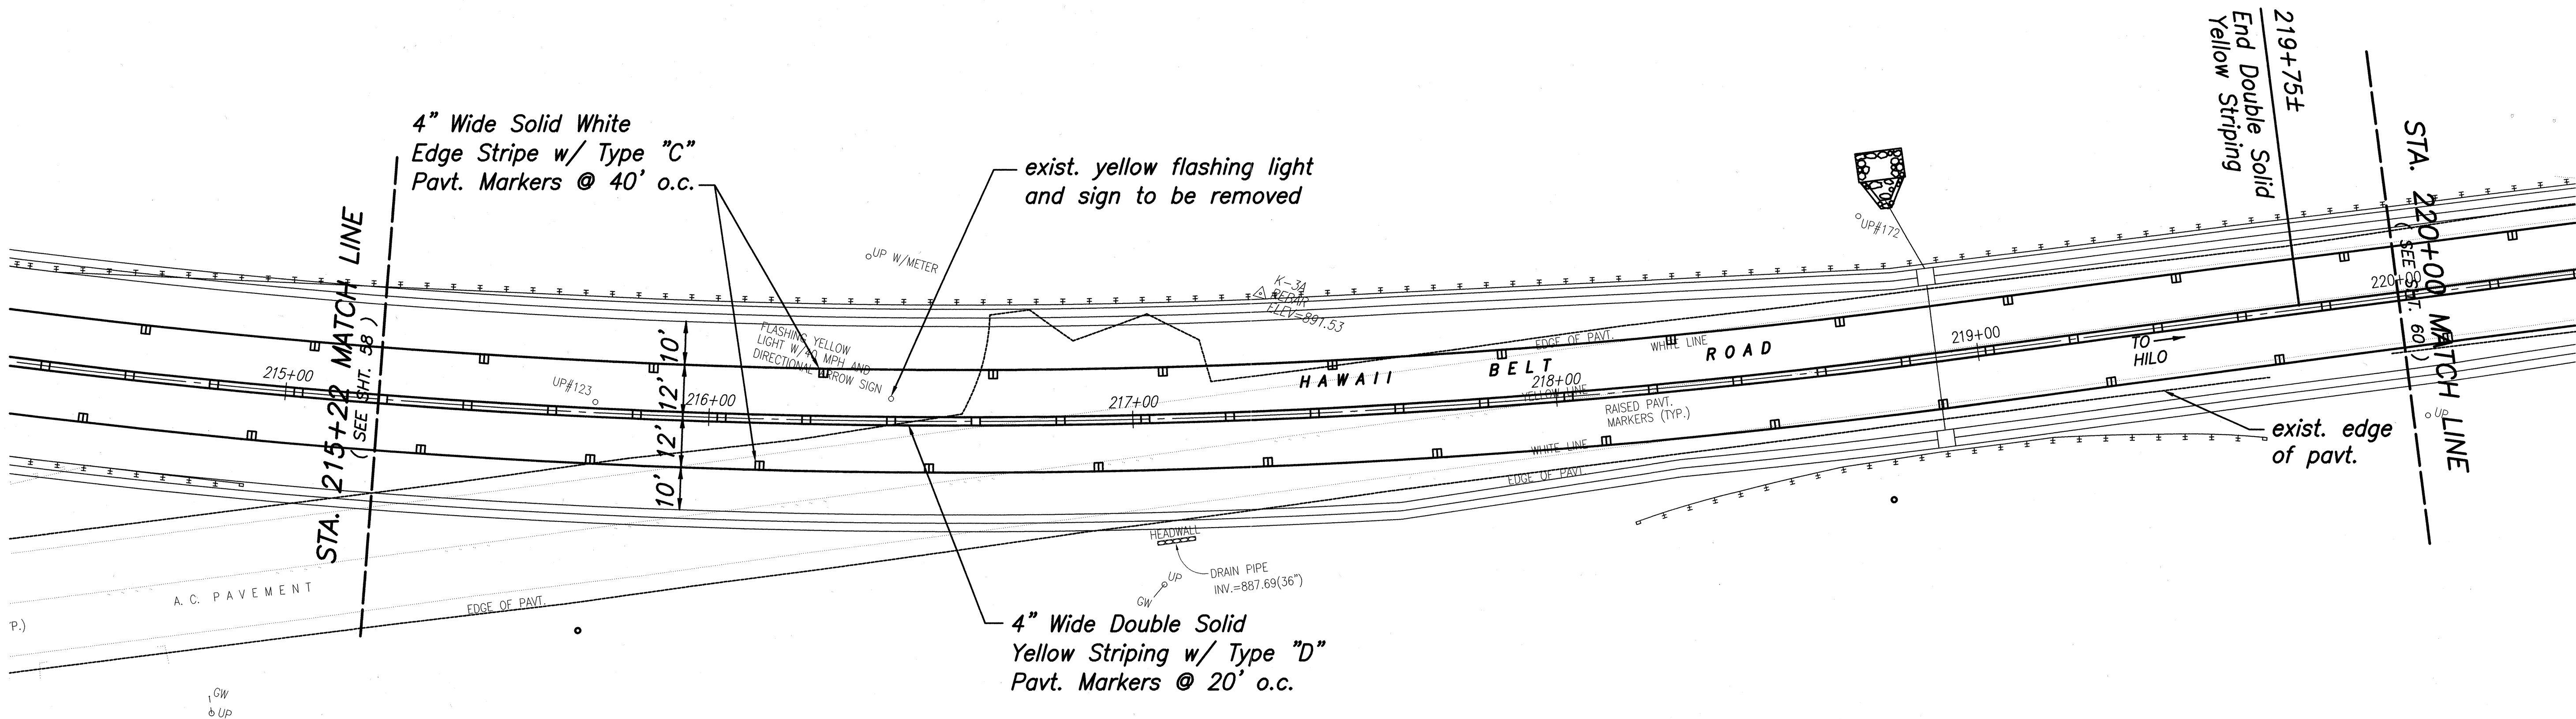

07/21/00

Proj. No. 96048-00


R:\keelakah\SIGN.DWG



ORIGINAL PLAN	SURVEY PLOTTED BY	DATE
	DRAWN BY	
NOTE BOOK	DESIGNED BY	
	QUANTITIES BY	
	CHECKED BY	
	No.	



# **SIGNING AND STRIPING PLAN 5**



SCALE= 1"=20'

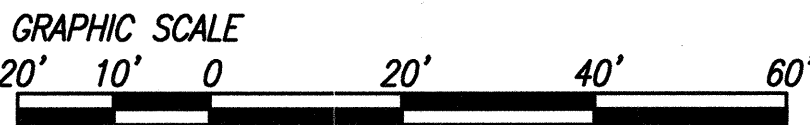

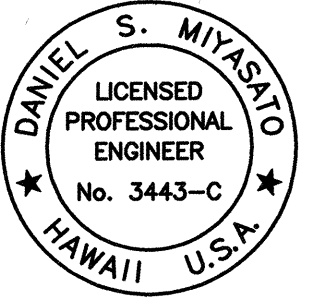   <small>SATO &amp; ASSOCIATES, INC.</small>	<small>STATE OF HAWAII</small> <small>DEPARTMENT OF TRANSPORTATION</small> <small>HIGHWAYS DIVISION</small> <h2>SIGNING AND STRIPING PLAN - 5</h2> <h3>HAWAII BELT ROAD</h3> <h4>KEALAKAHA STREAM BRIDGE REPLACEMENT</h4> <p>PROJECT NO. BR-019-2 (26)</p> <p>SCALE: AS NOTED DATE: NOVEMBER 2001</p>
	<p>SHEET No. 5 OF 6 SHEETS</p>

ORIGINAL	SURVEY PLOTTED BY	DATE
PLAN	DRAWN BY	
NOTE BOOK	DESIGNED BY	
No.	CHECKED BY	

FED. ROAD DIST. NO.	STATE	FED. AID PROJ. NO.	FISCAL YEAR	SHEET NO.	TOTAL SHEETS
HAWAII	HAW.	BR-019-2(26)	2002	60	155

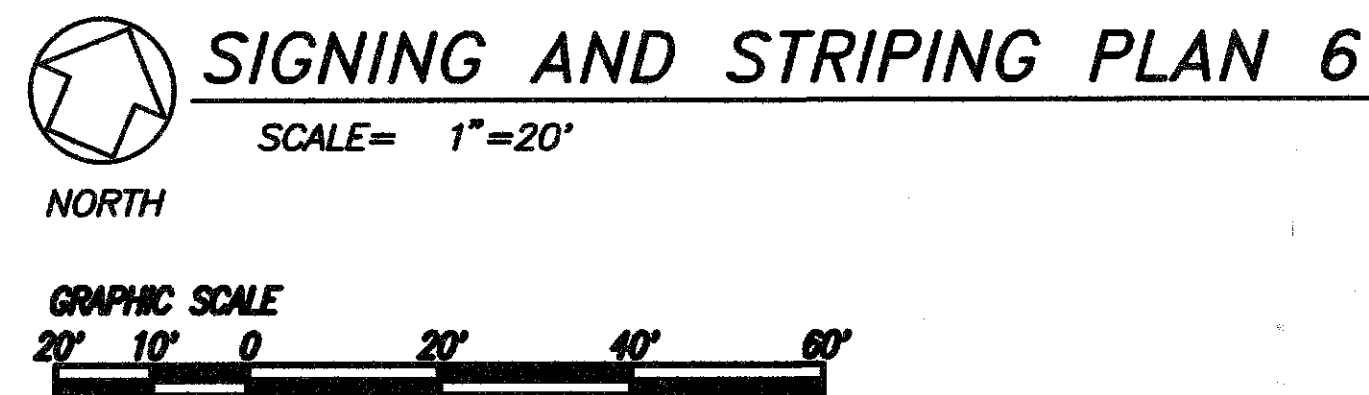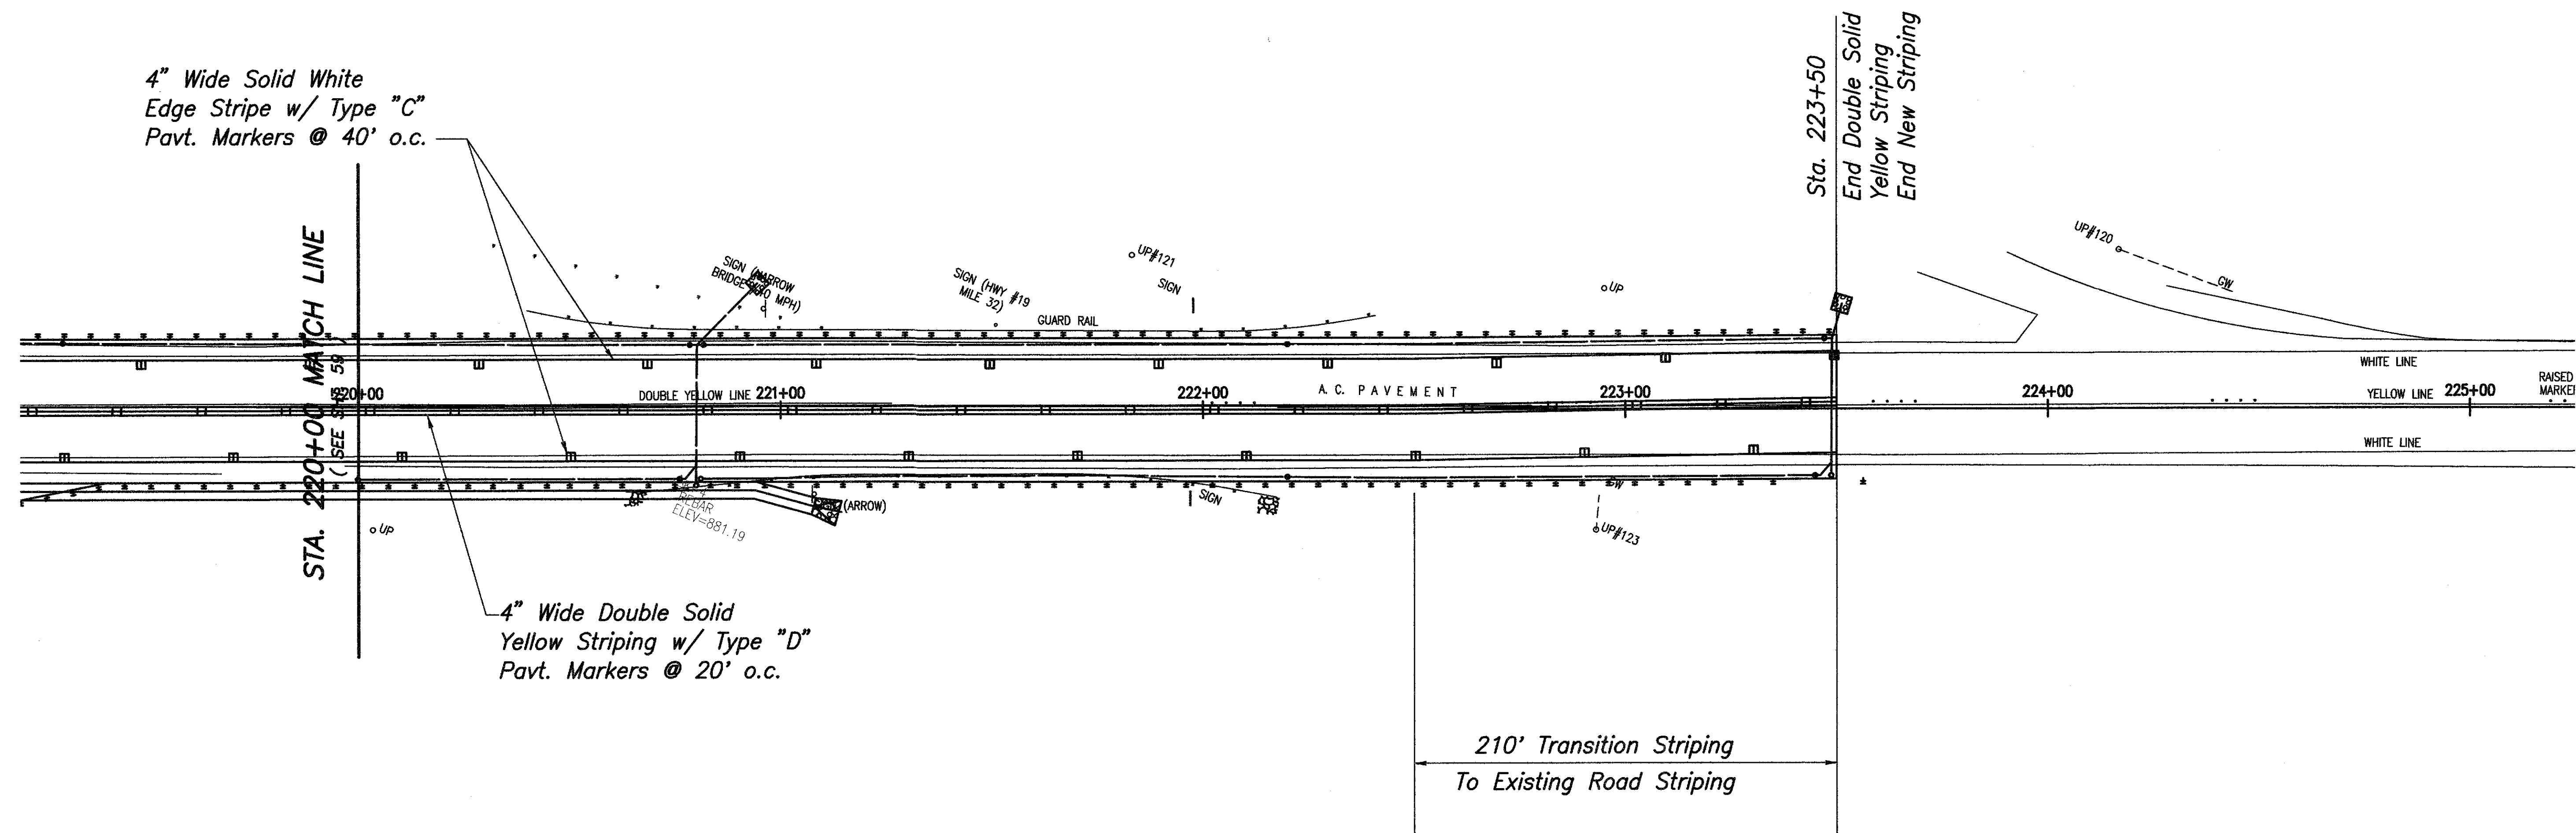

10/09/09		Extend Striping from 221+10 to 223+50	
	STATE OF HAWAII DEPARTMENT OF TRANSPORTATION HIGHWAYS DIVISION <b>SIGNING AND STRIPING PLAN 6</b> HAWAII BELT ROAD KEALAKAHA STREAM BRIDGE REPLACEMENT PROJECT NO. BR-019-2 (26)		
	SCALE: 1"=20'      DATE: NOVEMBER 2001		
	SHEET No. 6 OF 6 SHEETS		
	SATO & ASSOCIATES, INC. THIS WORK WAS PREPARED BY ME OR UNDER MY SUPERVISION		

"AS-BUILT"