


ORIGINAL PLAN	SURVEY PLOTTED BY	DATE
NOTE BOOK	DRAWN BY	
No.	DESIGNED BY	
	CHECKED BY	

FED. ROAD DIST. NO.	STATE	FED. AID PROJ. NO.	FISCAL YEAR	SHEET NO.	TOTAL SHEETS
HAWAII	HAW.	BR-019-2(26)	2002	36	155

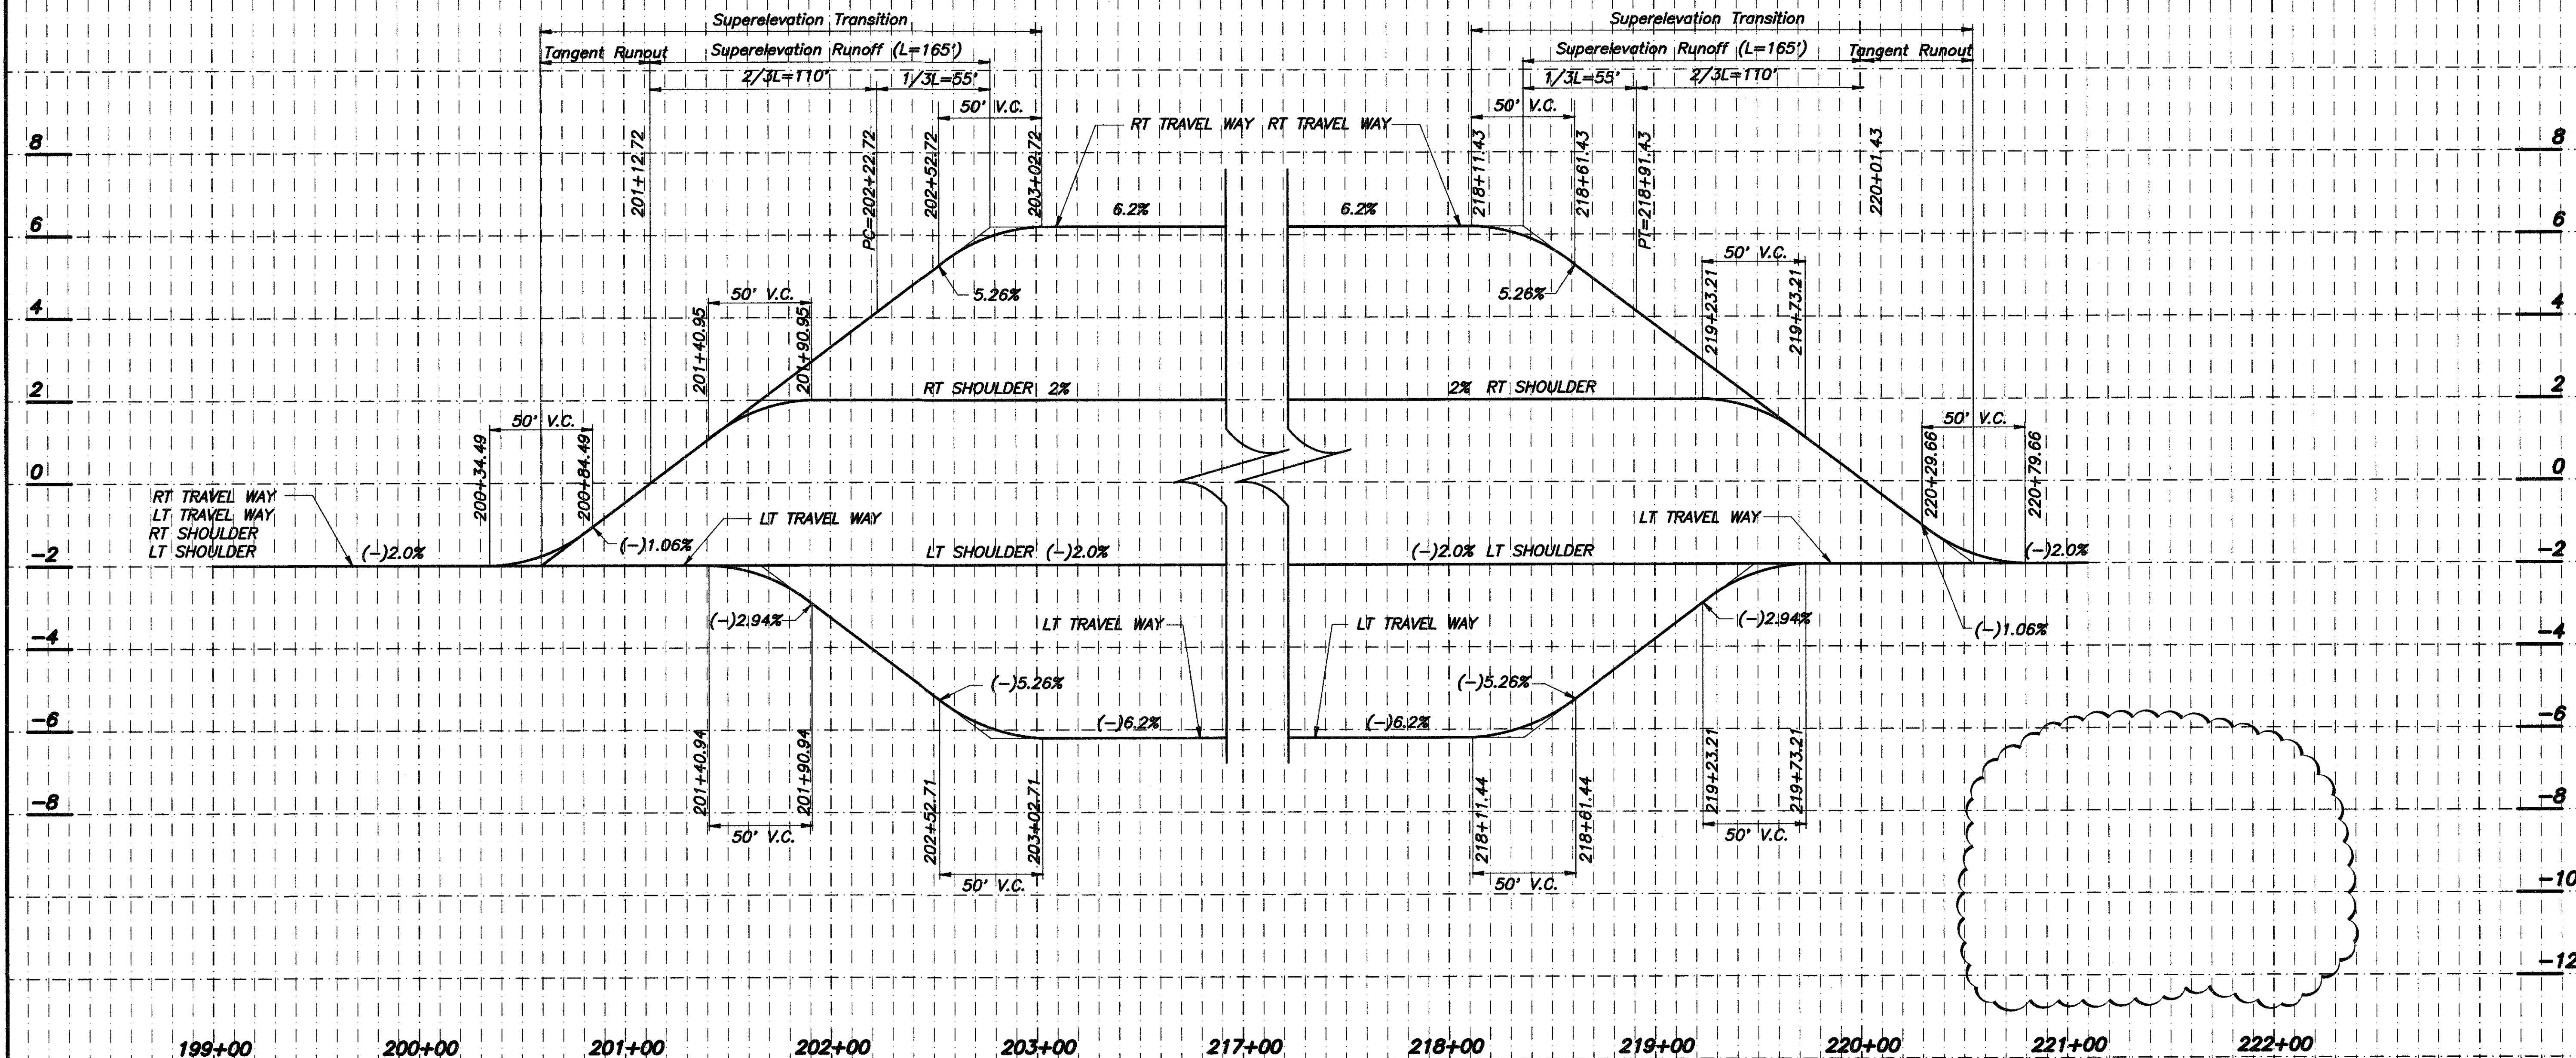

SUPERELEVATION DIAGRAM - STA 199+54.65 TO STA 220+79.66

SCALES: HORIZ. 1"=40'
VERT. 1"=2'

10/09/09
Revise shoulder super

STATE OF HAWAII
DEPARTMENT OF TRANSPORTATION
HIGHWAYS DIVISION
SUPERELEVATION DIAGRAM
HAWAII BELT ROAD
KEALAKAHA STREAM BRIDGE REPLACEMENT
PROJECT NO. BR-019-2 (26)
SCALE: NONE DATE: NOVEMBER 2001
SHEET No. 1 OF 1 SHEETS

"AS-BUILT"