

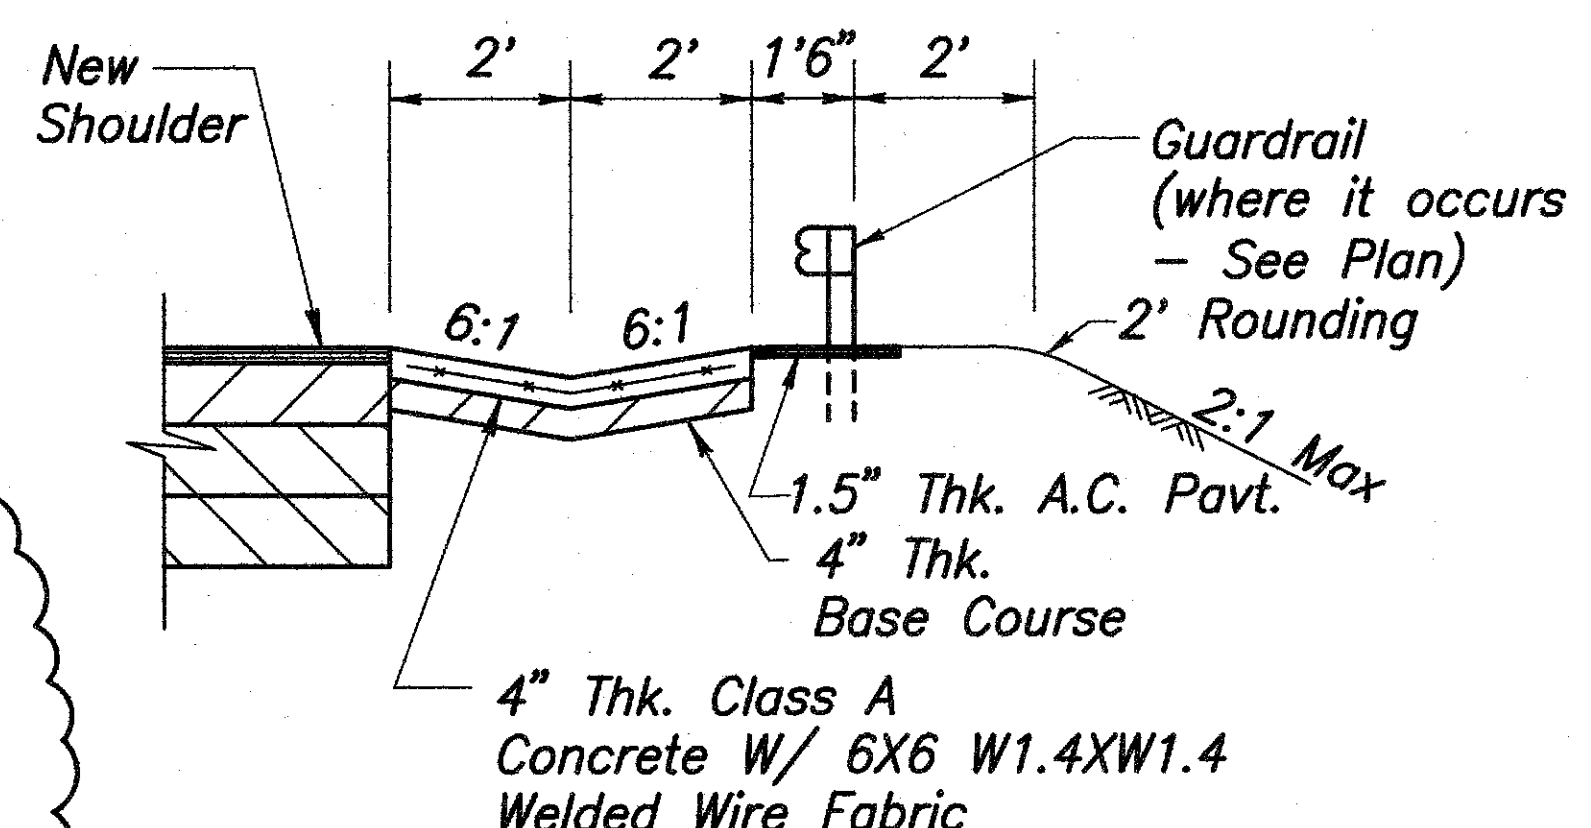
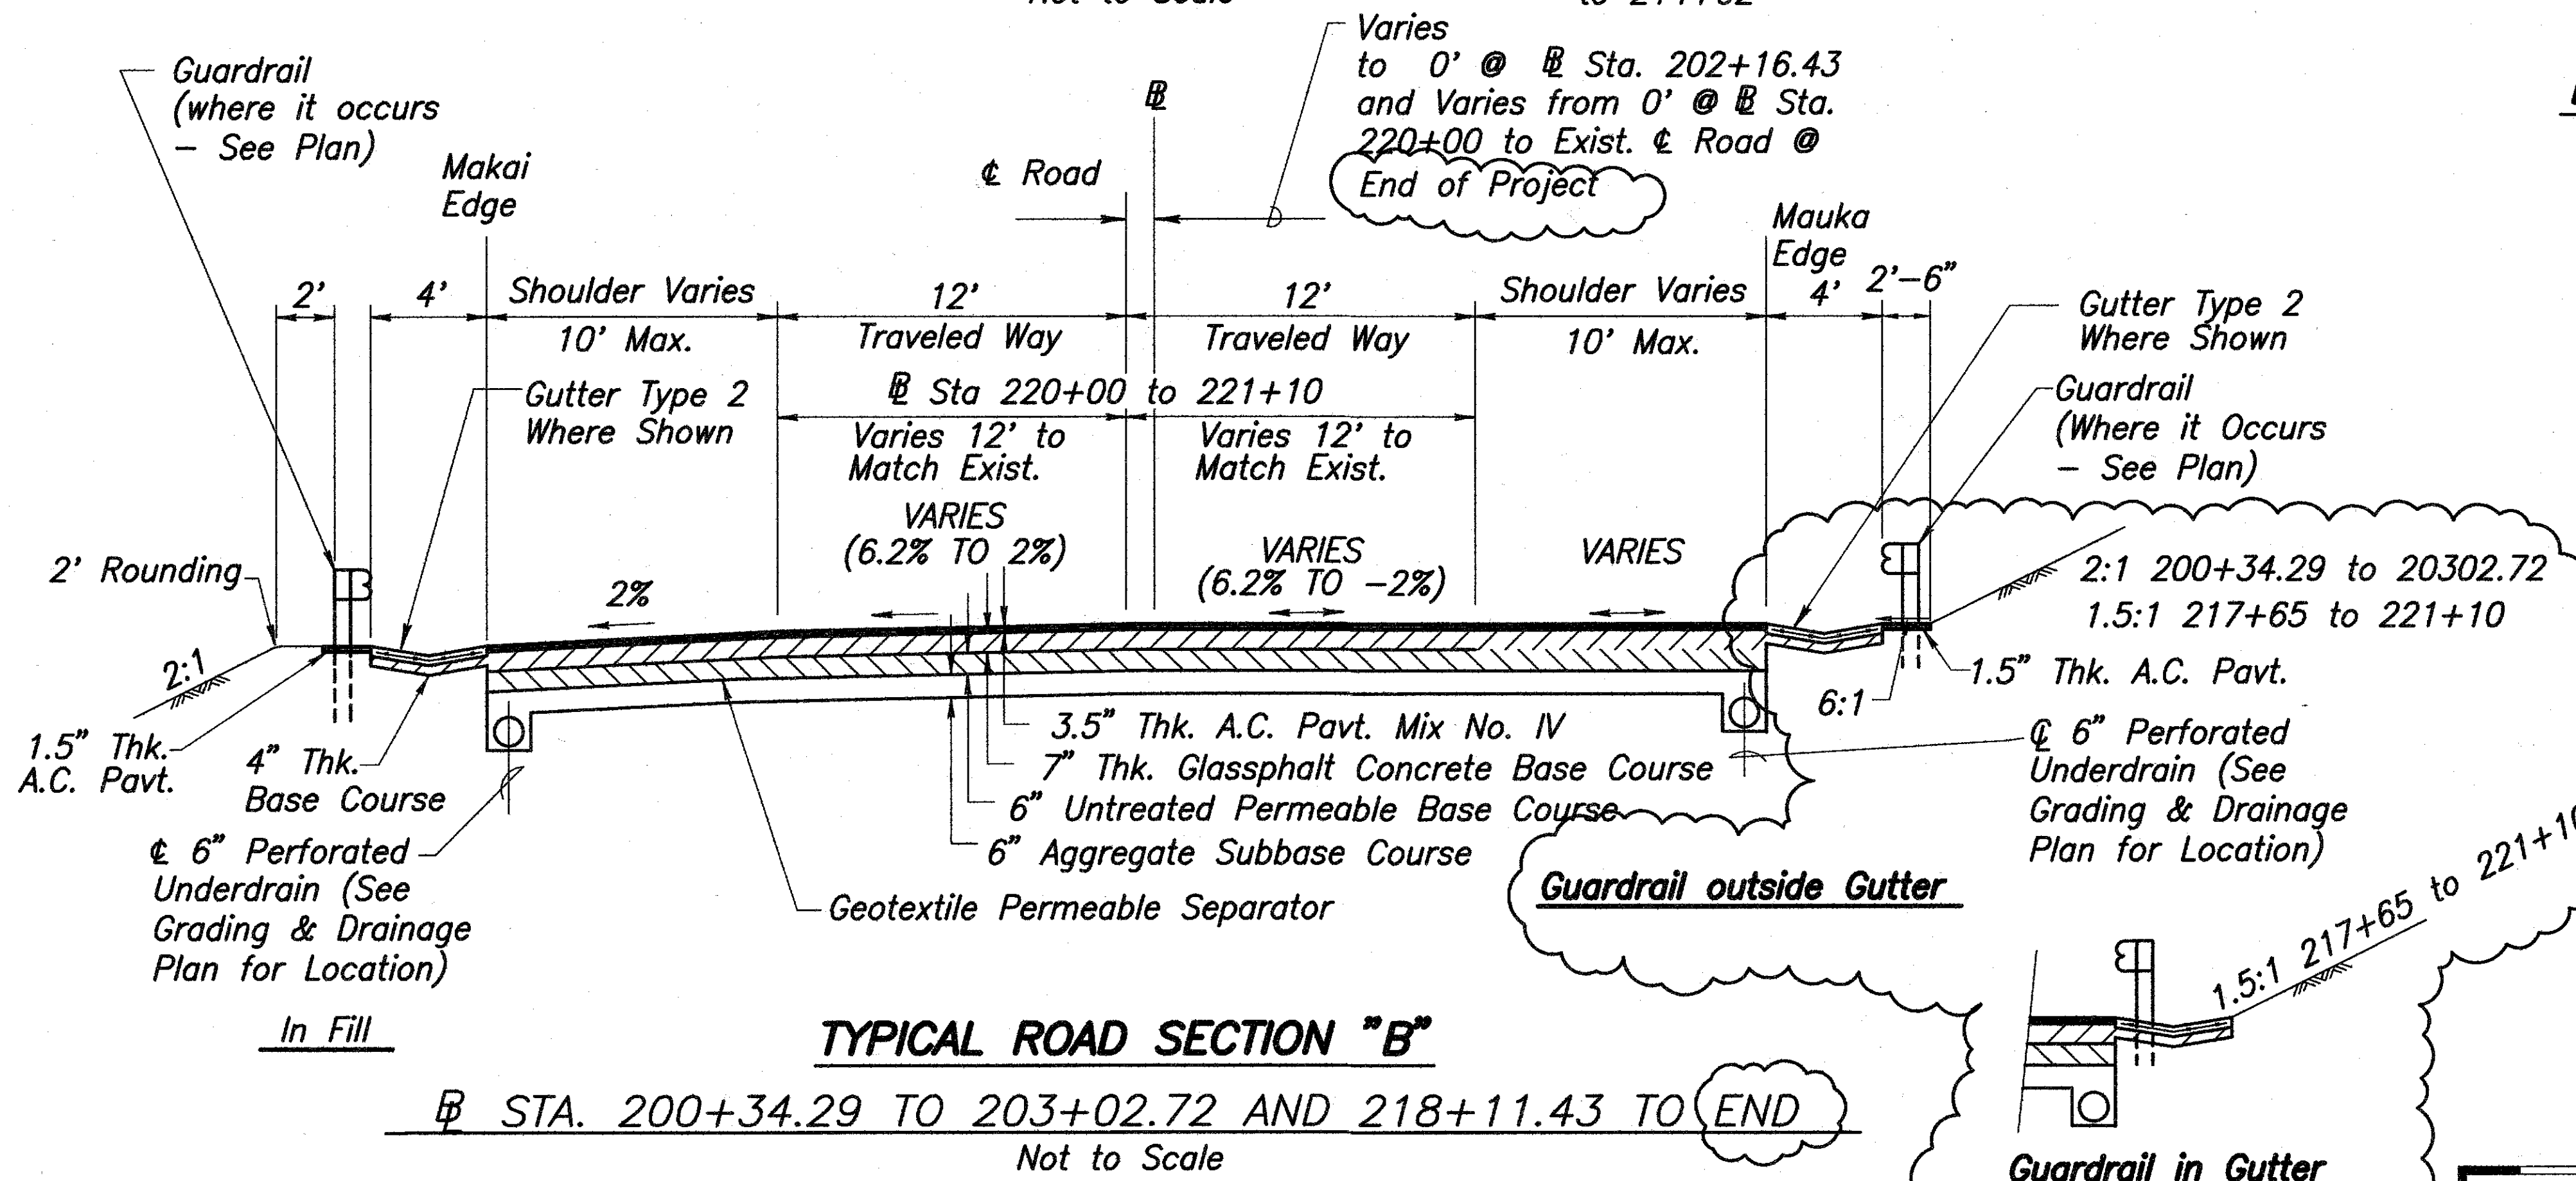
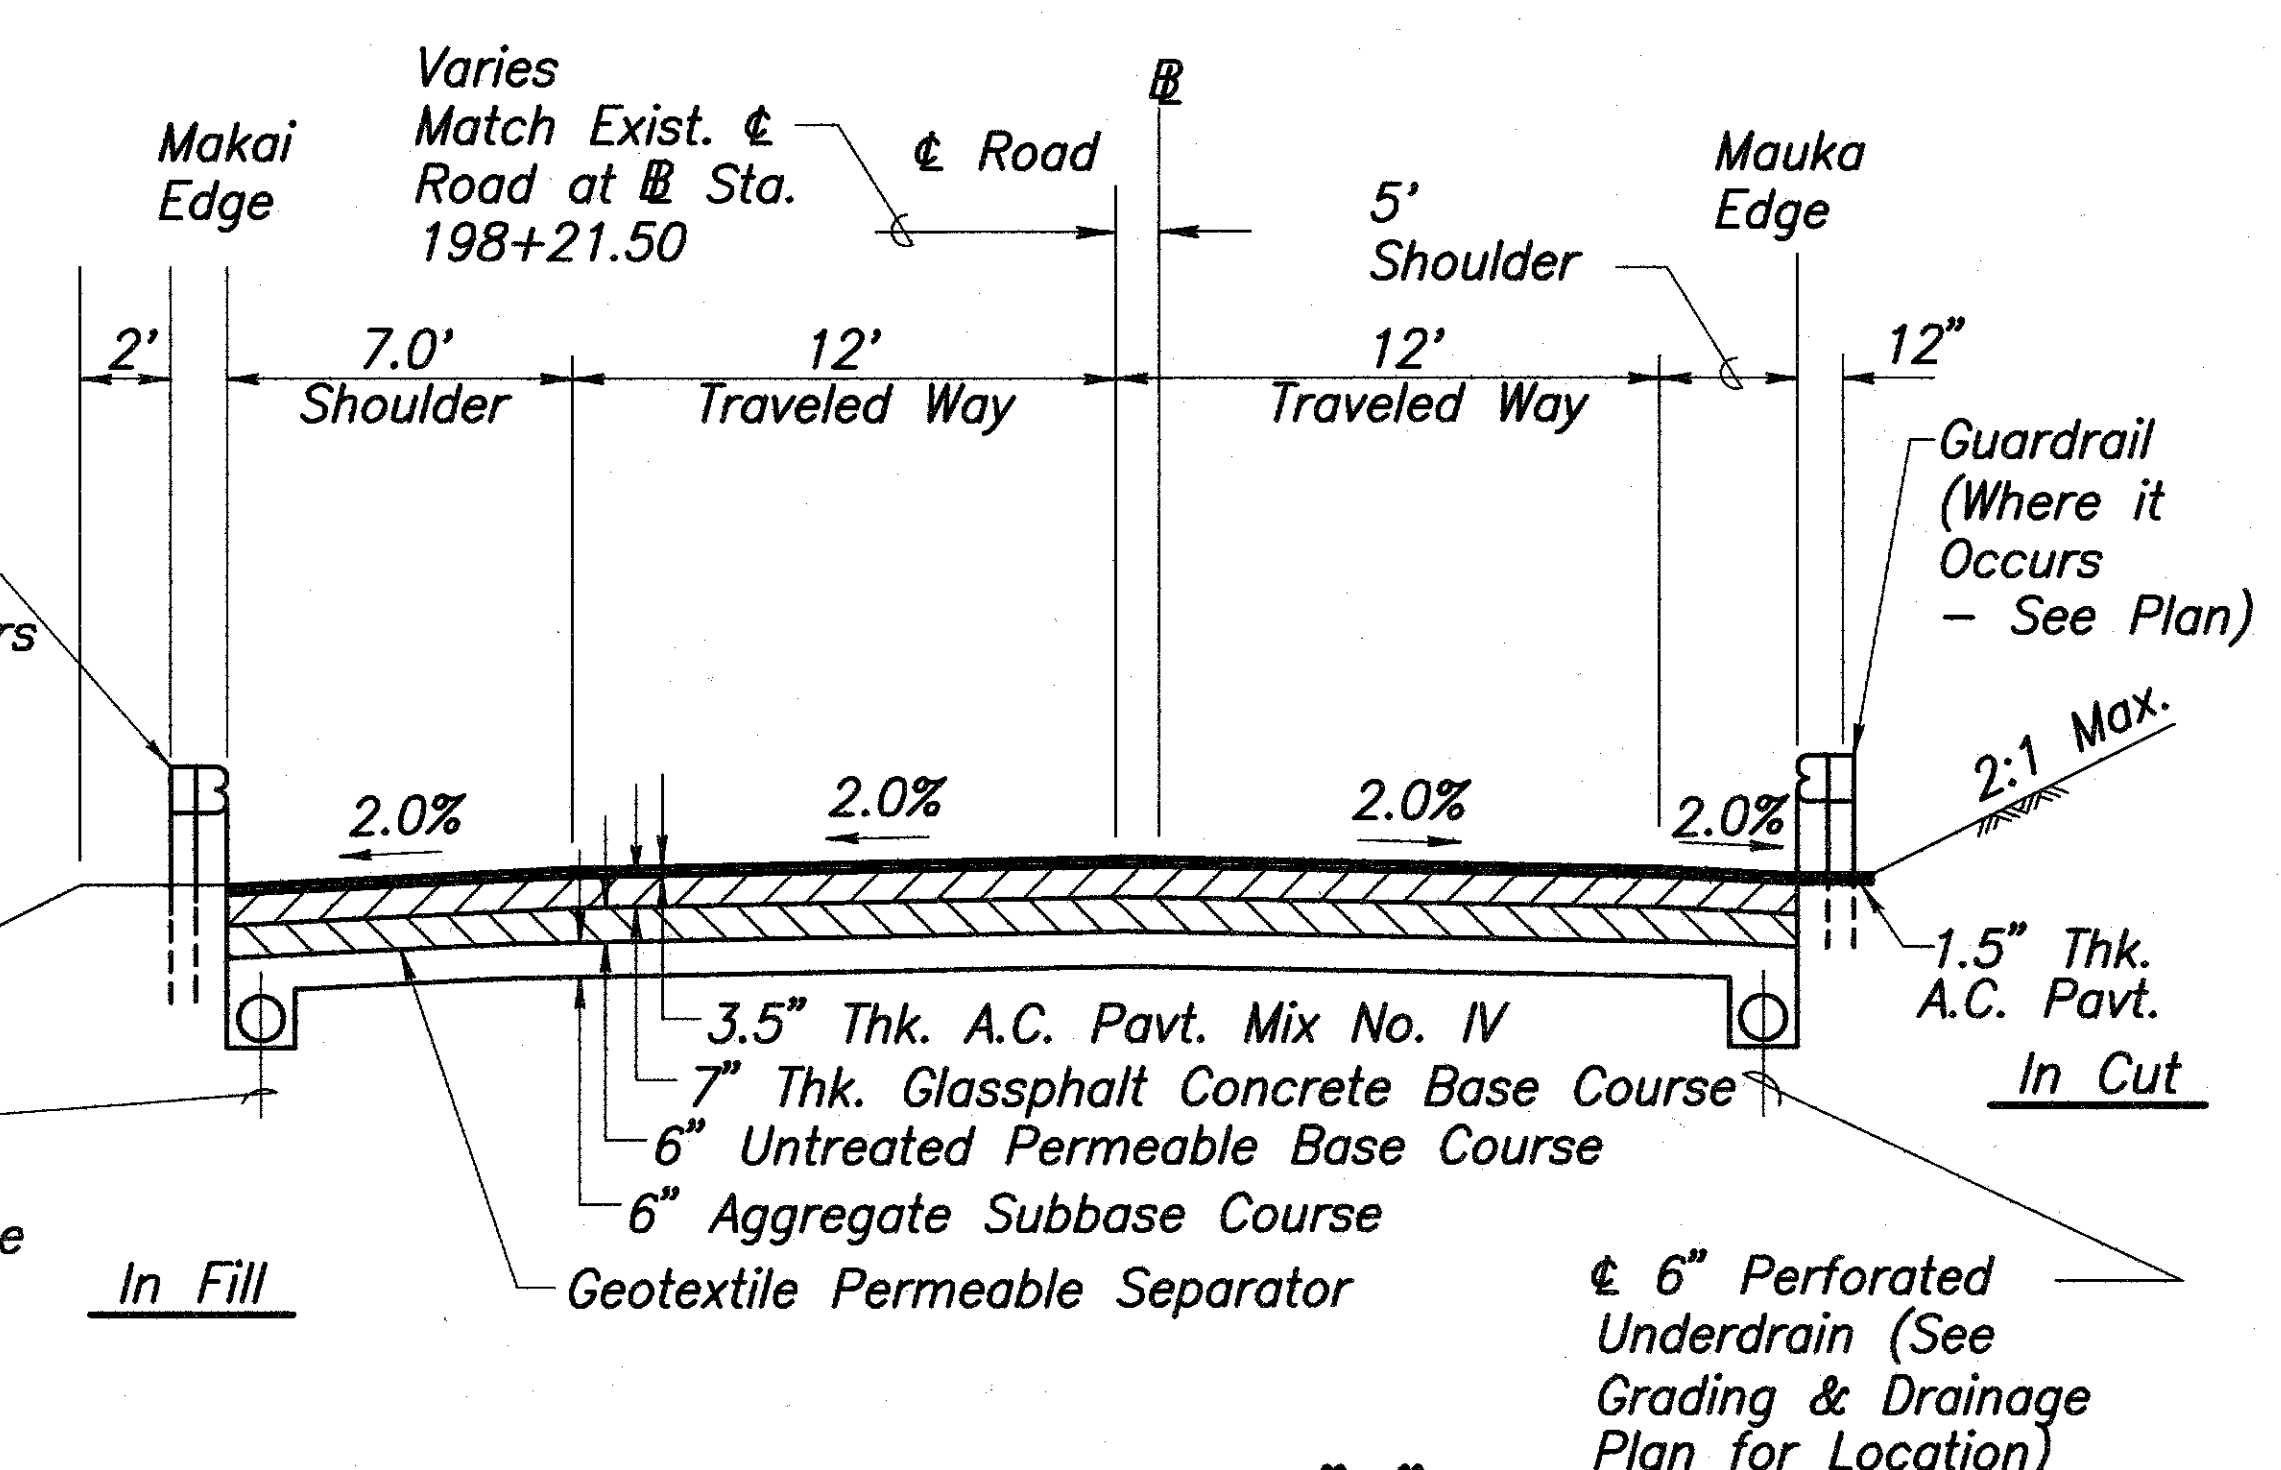


FED. ROAD DIST. NO.	STATE	FED. AID PROJ. NO.	FISCAL YEAR	SHEET NO.	TOTAL SHEETS
HAWAII	HAW.	BR-019-2(26)	2002	17	155

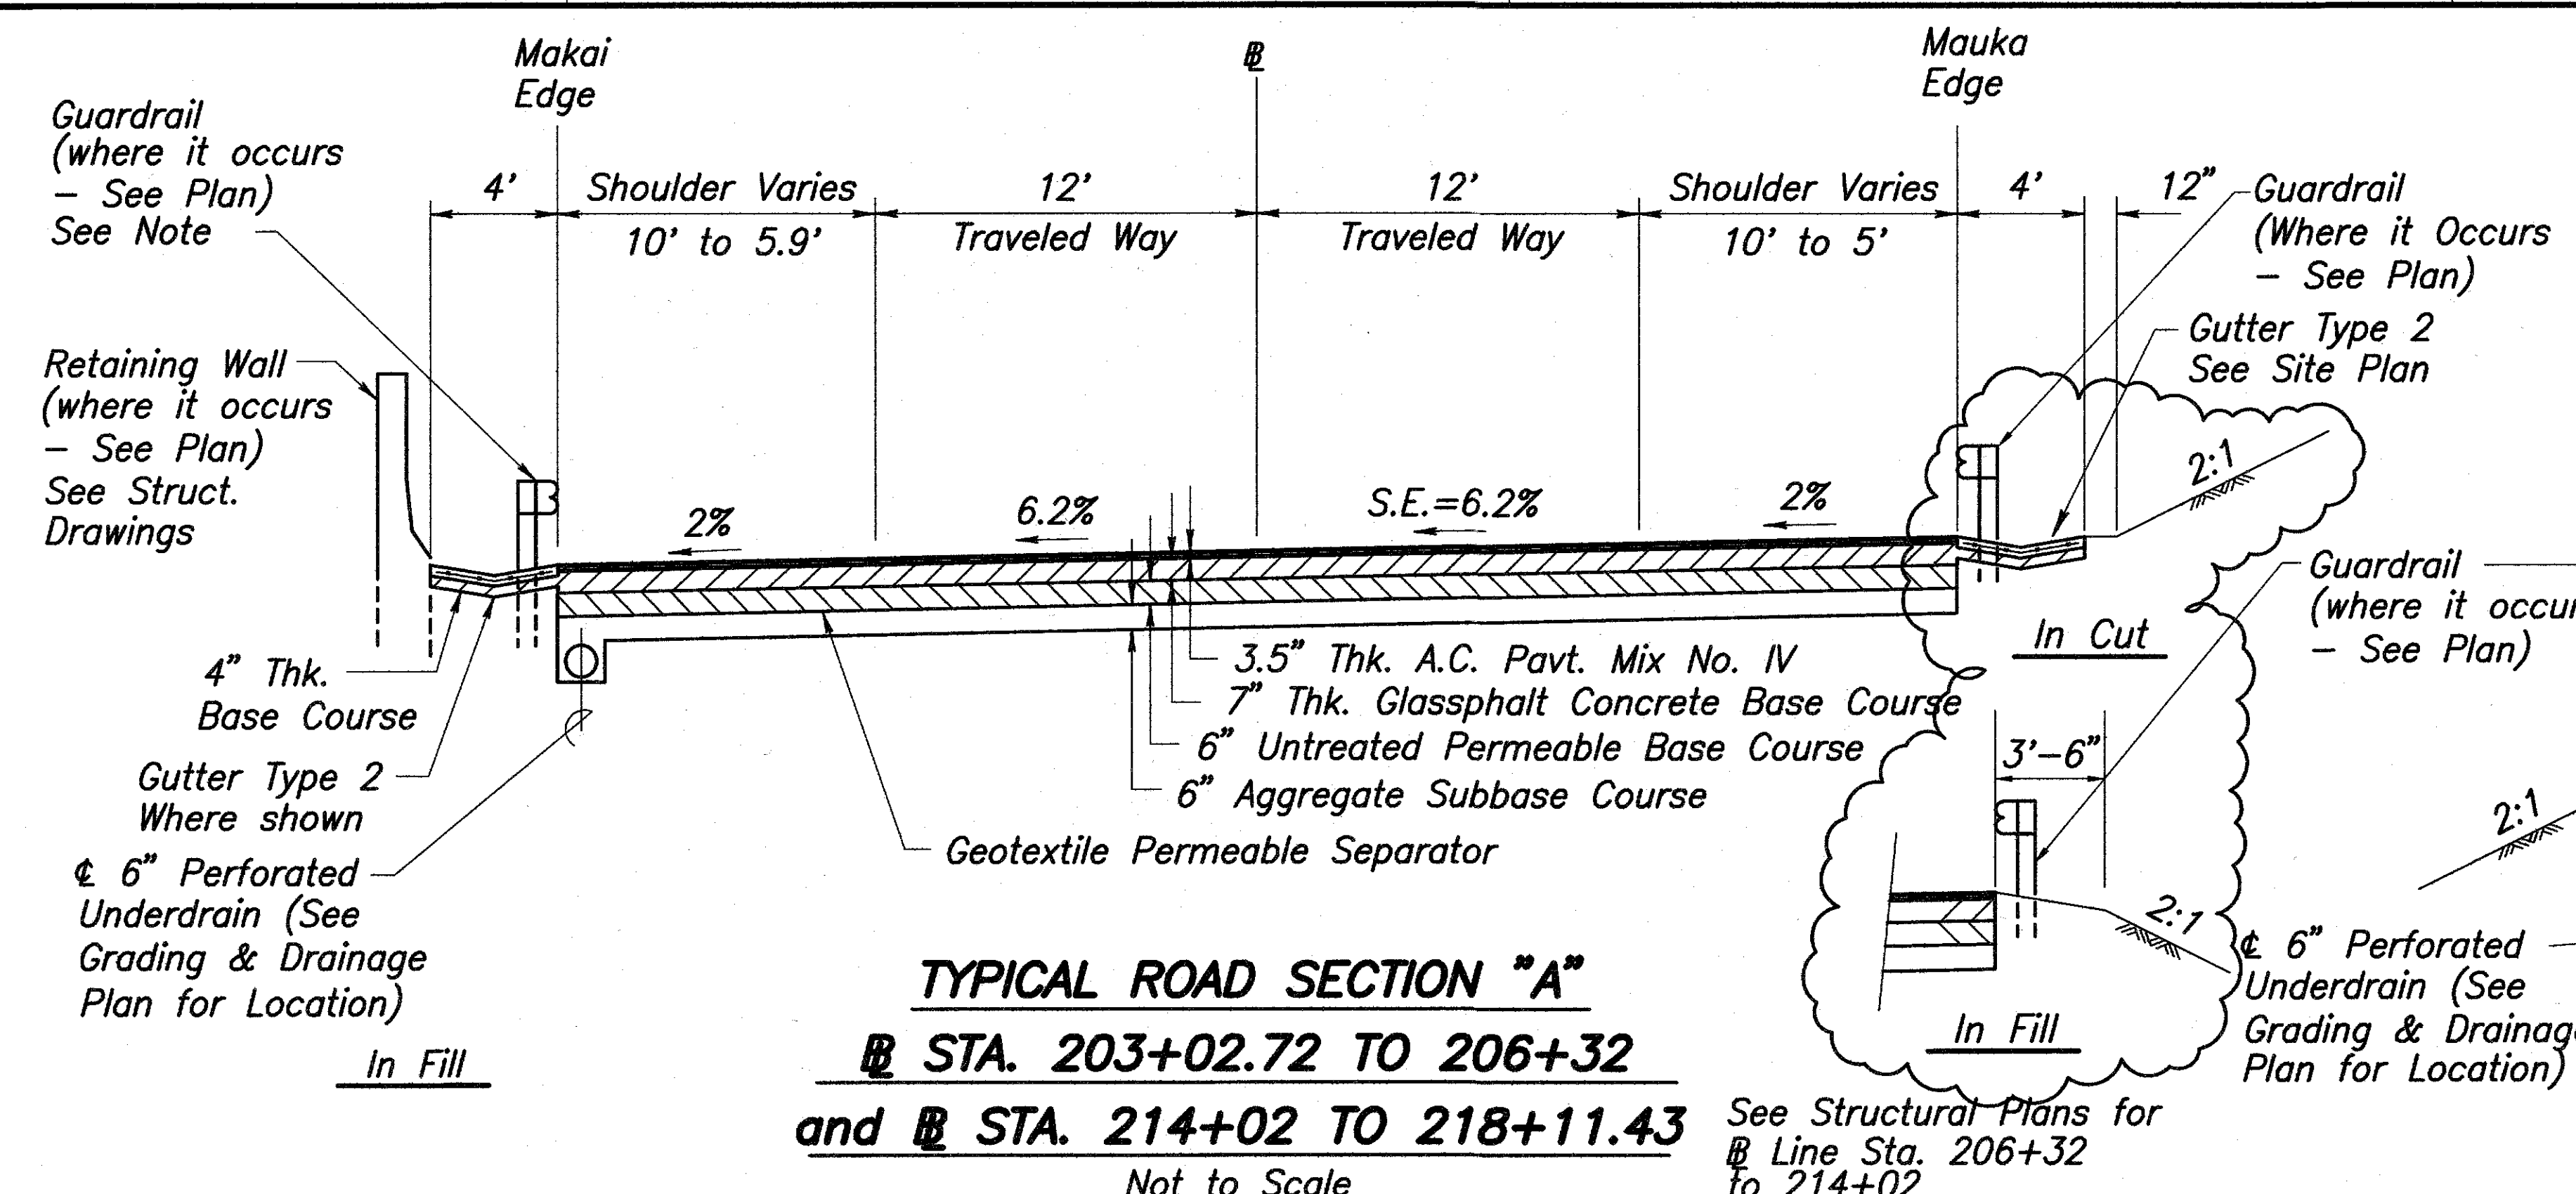

Guardrail in Gutter
 Note: See plan for guardrail crossover locations. Space posts to clear gutter invert.

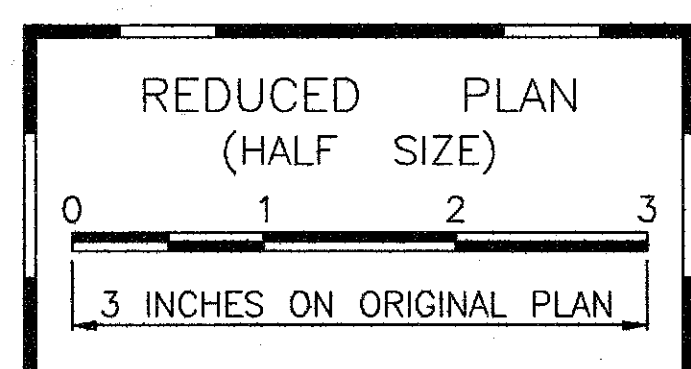

- Notes:
1. All graded slopes shall be planted with grass and/or ground covering.
 2. Guardrail Posts shall be located away from gutter/swale inverts.
 3. For Paving Under Guardrail See Sht. 18.

10/09/09

Revised Sections
DEPARTMENT OF TRANSPORTATION
HIGHWAYS DIVISION
TYPICAL ROAD SECTIONS
HAWAII BELT ROAD
KEALAKAHA STREAM BRIDGE REPLACEMENT
PROJECT NO. BR-019-2 (26)
SCALE: NONE DATE: NOVEMBER 2001
SHEET No. 1 OF 1 SHEETS

"AS-BUILT"

SURVEY PLOTTED BY	DATE
DESIGNED BY	DATE
CHECKED BY	DATE
NOTED BY	DATE
QUANTITIES BY	DATE
NO.	