




INDEX TO DRAWINGS	
SHEET NO.	DESCRIPTION
1	TITLE SHEET
2	STANDARD PLANS SUMMARY
3,4	INDEX TO DRAWINGS
5,6	ESTIMATED QUANTITIES
7	GENERAL NOTES
8-12	CIVIL PLANS
13-46	HANAWI BRIDGE
① 47-66	WAIAAMA BRIDGE
67,68	PEPEEKEO PLANTATION ROAD OVERPASS
② 69-71	PAHEEHÉE MAUKA BRIDGE NO. 3
72-84	PAHEEHÉE BRIDGE
85-88	CABLE RESTRAINER

Sheet Nos. ① 55S-1 and ② C.O. 71S-1 thru C.O. 71S-6 are Supplementary Sheets to this project. Total sheet count after "AS-BUILT" posting 95 sheets.

FED. ROAD DIST. NO.	STATE	FED. AID PROJ. NO.	FISCAL YEAR	SHEET NO.	TOTAL SHEETS
HAWAII	HAW.	BR-0100(57)	2001	1	88

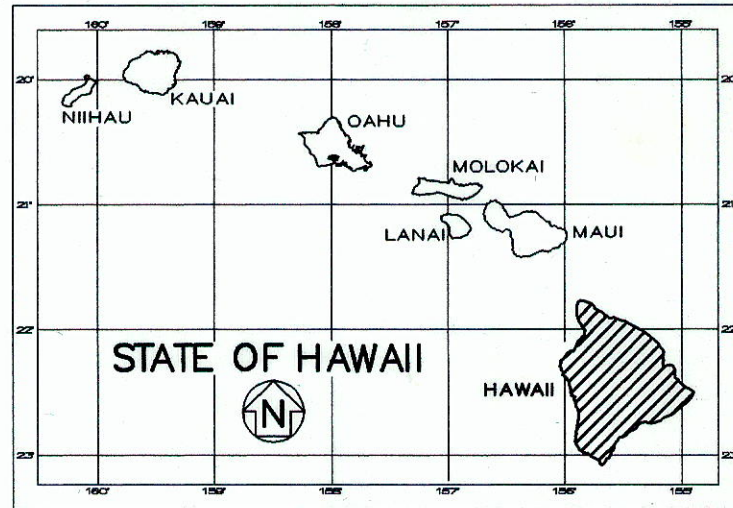

STATE OF HAWAII
DEPARTMENT OF TRANSPORTATION
HIGHWAYS DIVISION
HONOLULU, HAWAII
"AS-BUILT"
PLANS FOR
HAWAII BELT ROAD
SEISMIC RETROFIT OF VARIOUS BRIDGES
VICINITY OF PEPEEKEO - UNIT 1
FEDERAL-AID PROJECT NO. BR-0100(57)
DISTRICT OF SOUTH HILO
ISLAND OF HAWAII

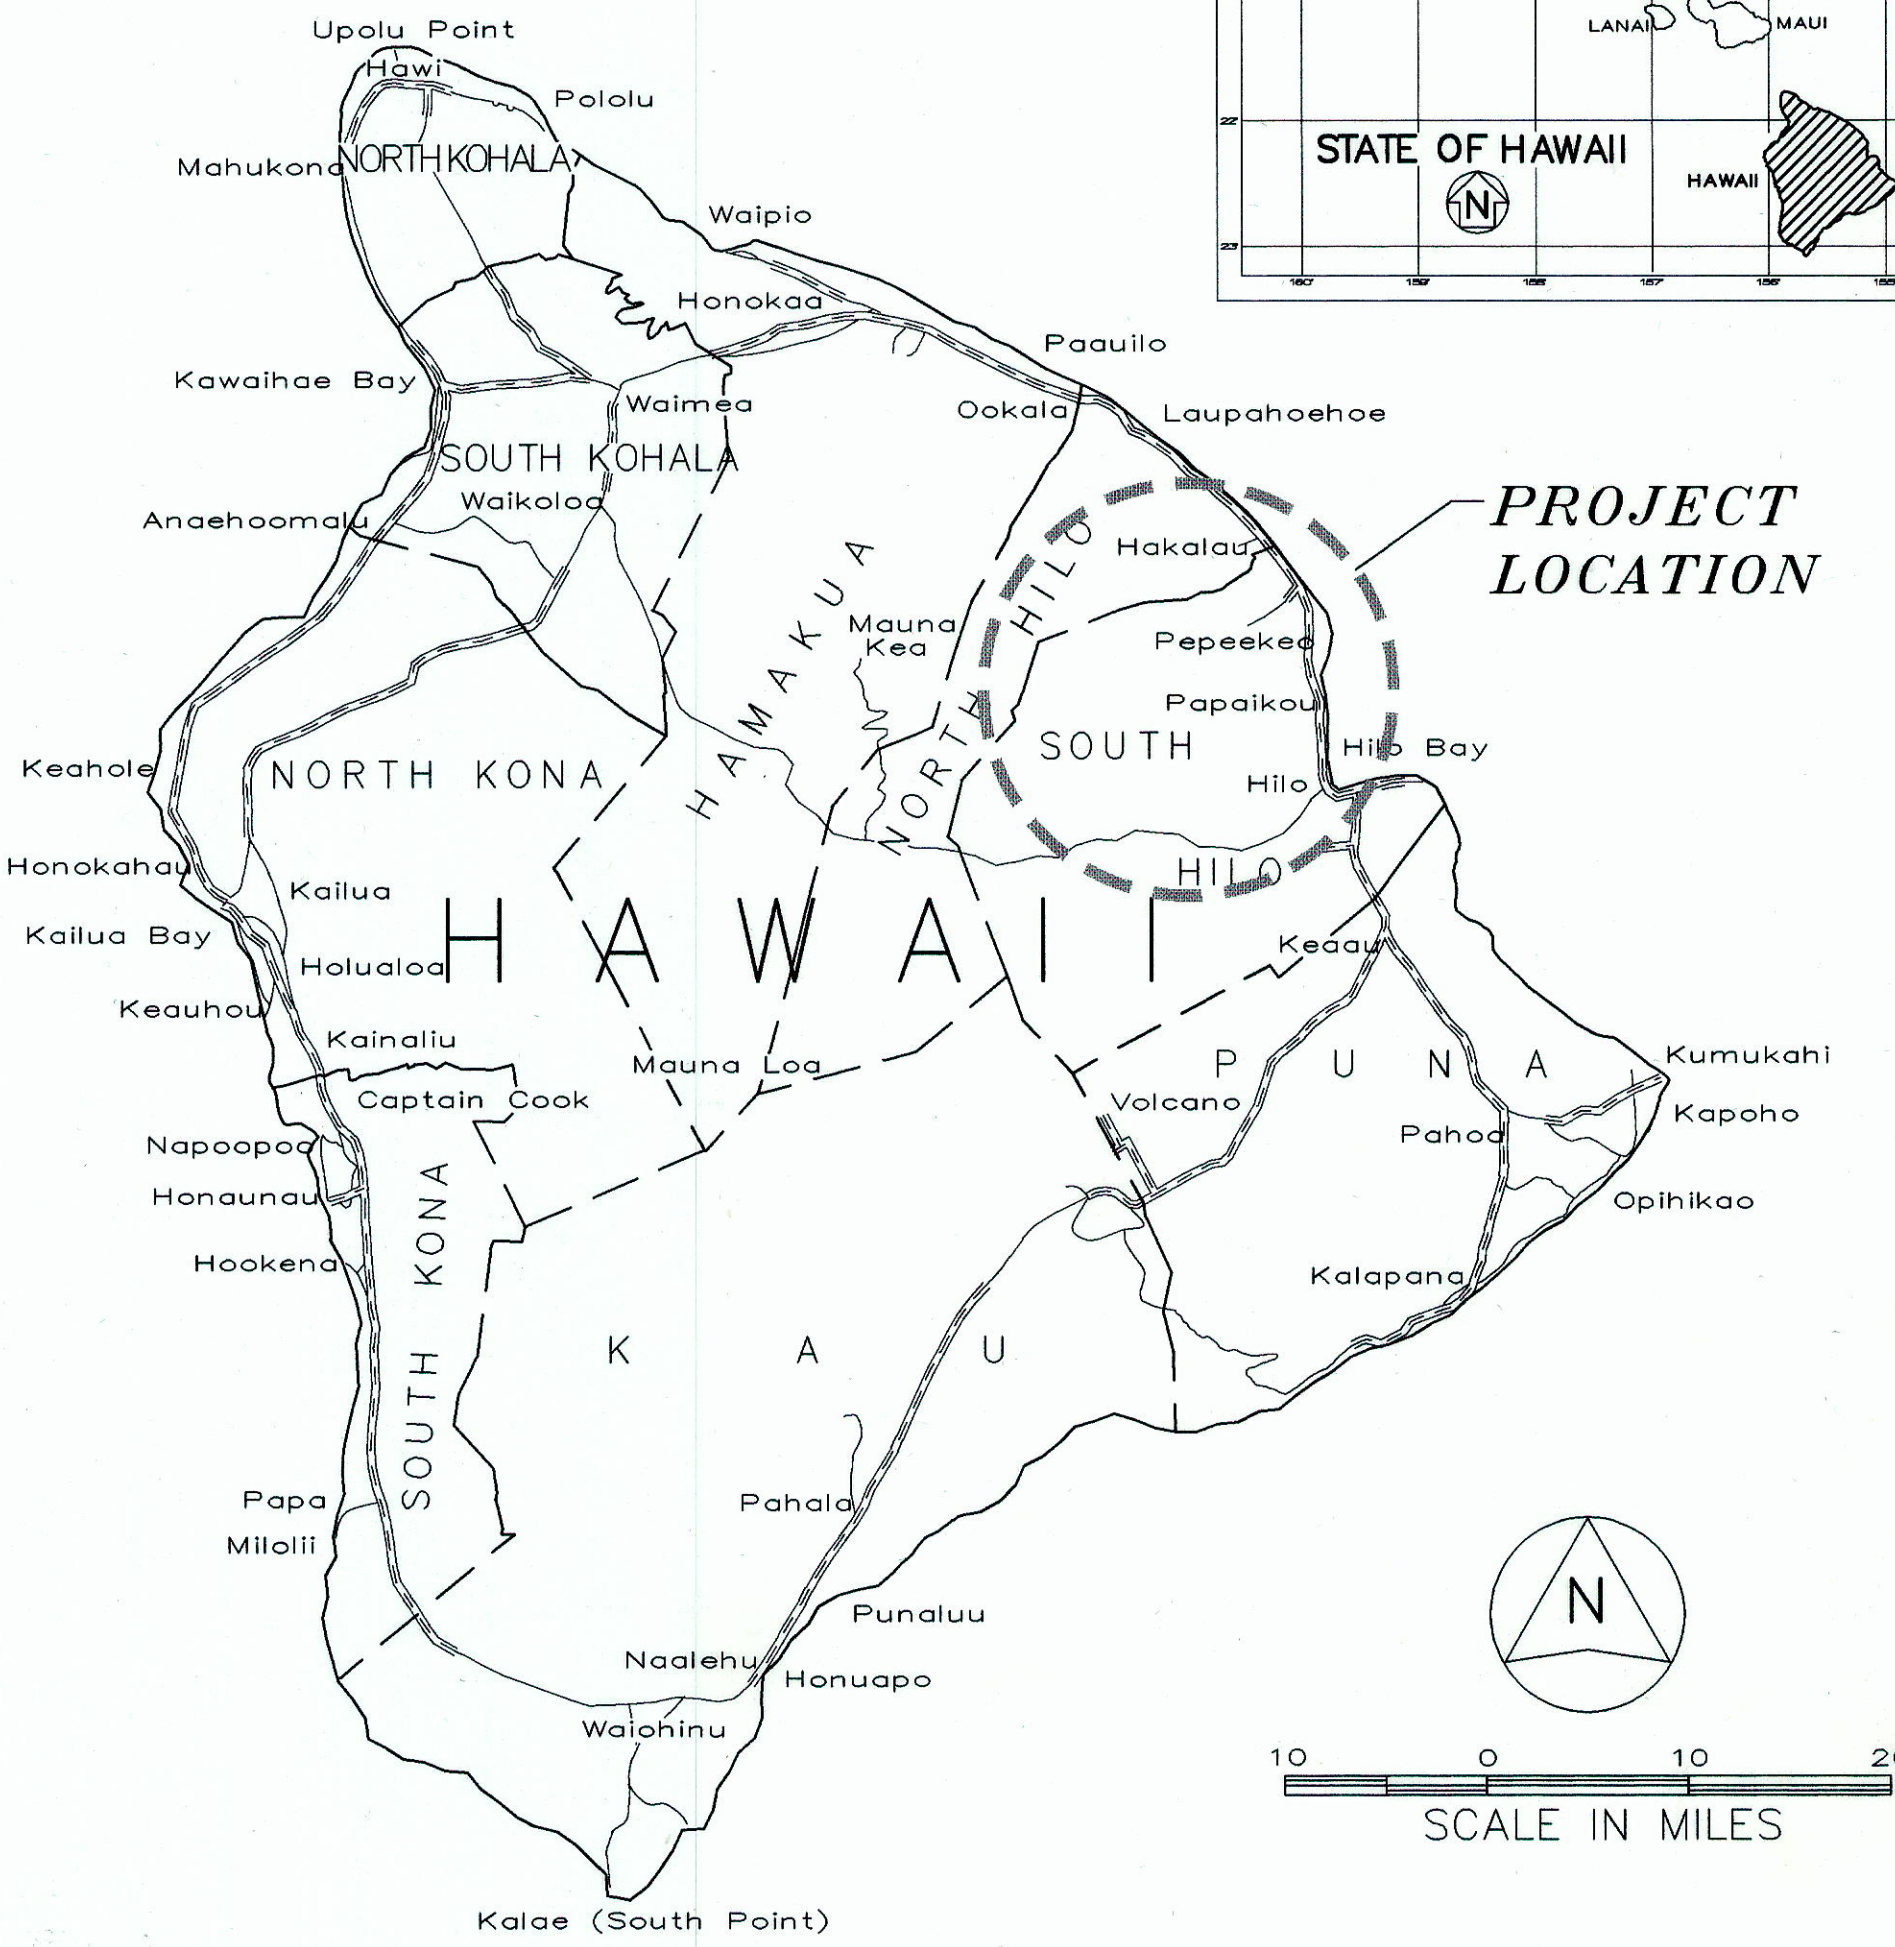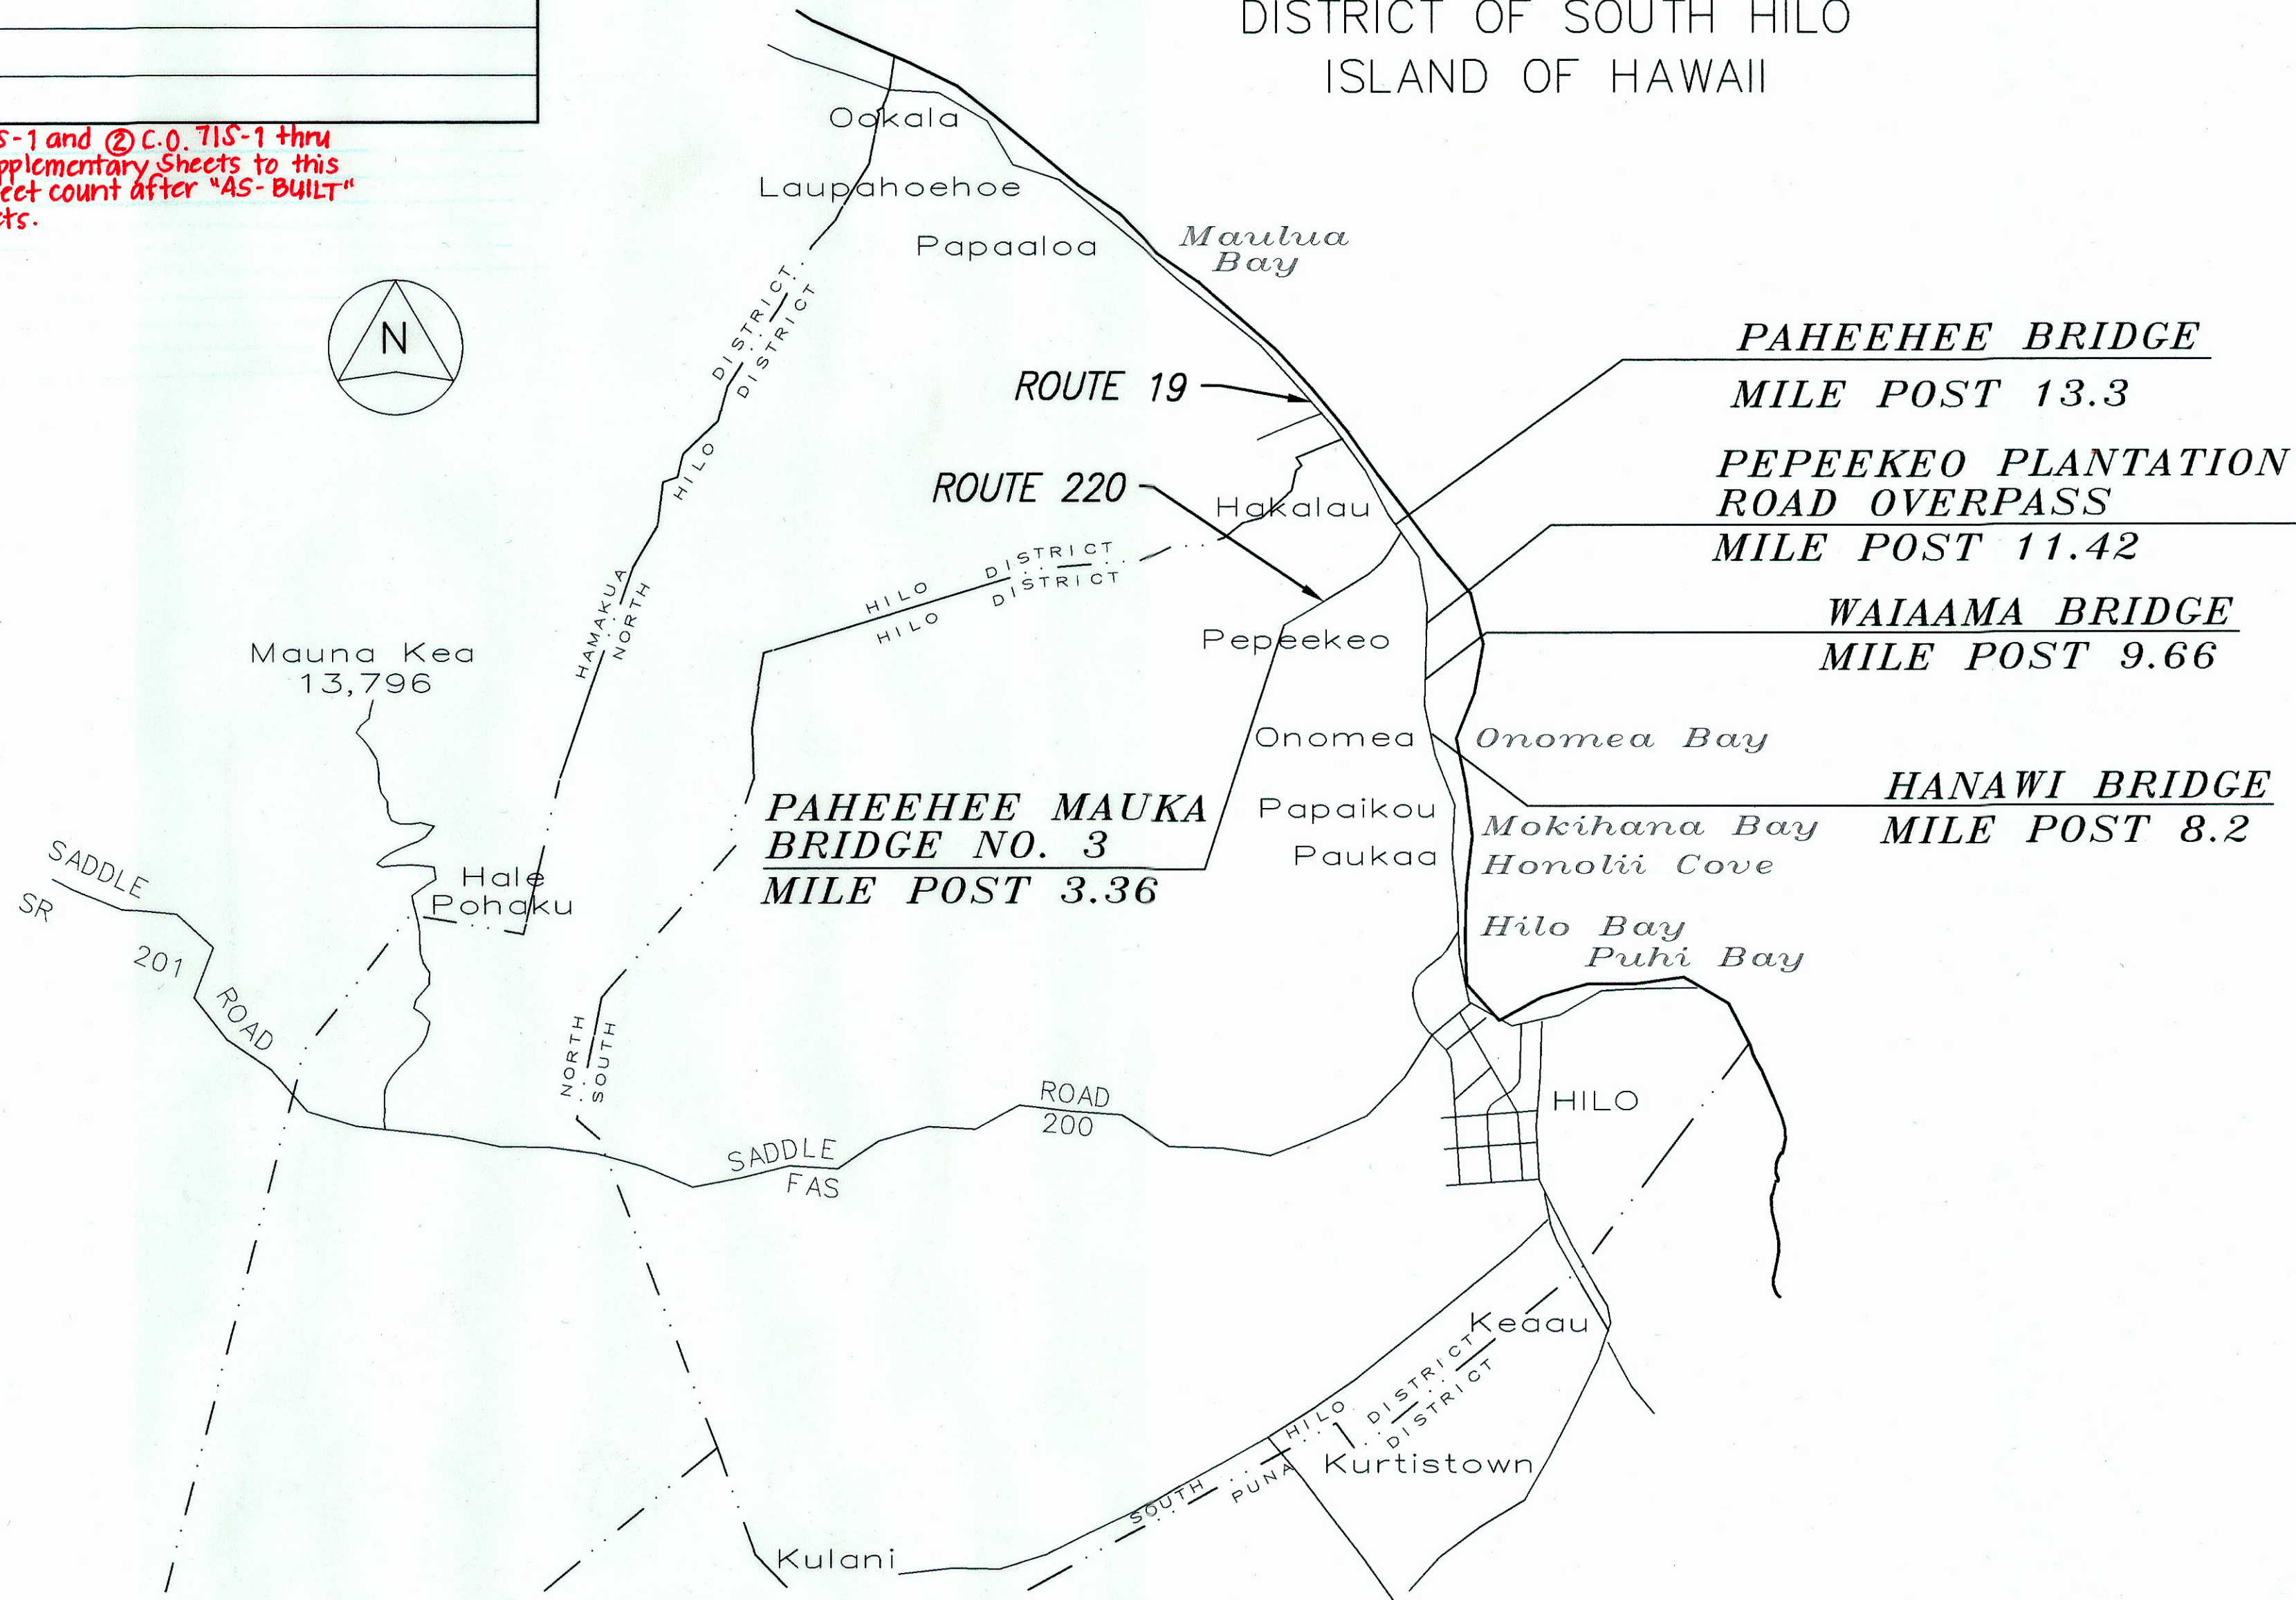

SURVEY PLOTTED BY	DATE
DRAWN BY	
DESIGNED BY	
QUANTITIES BY	
CHECKED BY	
No.	

KSF, INC. E. BARROGA, JR. 692-7546 1/2001
DESIGNED BY P. S. & E. BY PHONE DATE

CHANGES MADE DURING CONSTRUCTION HAVE BEEN INCORPORATED ON THESE PLANS EXCEPT CHANGES IN THE ORIGINAL THEORETICAL QUANTITIES. FOR ACTUAL QUANTITIES, REFER TO PROJECT LEDGER AND/OR COMPUTATION BOOK.
M. M. M. 9/18/01
RESIDENT ENGINEER DATE

DEPARTMENT OF TRANSPORTATION
STATE OF HAWAII
APPROVED:
Robert M. M. 3-28-01
DIR. OF TRANSPORTATION DATE
SHEET NO. 1 OF 1 SHEETS