

| FED. ROAD DIST. NO. | STATE | FED. AID PROJ. NO. | FISCAL YEAR | SHEET NO. | TOTAL SHEETS |
|---------------------|-------|--------------------|-------------|-----------|--------------|
| HAWAII              | HAW.  | BR-F-019-2(27)     | 1987        | 31        | 134          |

### Gas Notes:

- 1) Use High Density Polyethylene Plastic Piping Material Designation PE 3406 Or PE 3408 Conforming to ASTM D2513.
- 2) Use Heat Fused or Approved Mechanical Joints Installed By Qualified Personnel In Accordance With Section 192.285 Of The Code Of Federal Regulations.
- 3) Install Number 12 Insulated Copper Tracer Wire Approximately 6 Inches Above Plastic Pipe.
- 4) Pipe To Be Installed By Gas Company.

### Water Note:

1. Polyethylene Loose Wrap Corrosion Protection of New Waterlines And Appurtenances Installed Shall Be Provided

\$ Sta. 28+38  
o/s = 34.0 ± Rt.  
1-12" X 6 Tee  
1-6" G.V. & Valve Box  
140 L.F. 6" Pipe  
1-6" X 4 Reducer  
1-6" Tee  
1-FH Connection Per Water System Standards Det. No. 28  
1-6" Cap Tapped 2" IPT  
1-2" Cleanout Unit

1-METER BOX PER STD Detail No "46" & "47"  
Connect to Exist. Customer Line, Contractor to Coordinate With State D.O.T., Harbors Division.  
1-2" Type "A" Service Lateral Per Std. Det. No. 75.  
1-6" X 1 1/2" Double Strap Service Saddle  
1-Conc. Blk.

\$ Sta. 25+50 ±  
o/s = 34 ± Rt.  
1-12" Solid Body Sleeve  
\$ Sta. 0+00  
Access Rd.  
\$ Sta. 60+03  
Hawaii Belt Rd.

\$ Sta. 25+38 ±  
o/s = 32 ± Rt.  
1-12" X 12" Wye w/ Retainer Gland  
1-12" Solid Body Sleeve w/ Ret. Gl.  
(Wye To Be Plugged When Existing 12" W.L. Is Cut off)  
\$ Hawaii Belt Rd. = G.C.L.

\$ Sta. 28+77  
o/s = 62.5 ± Rt.  
Construct New SMH #1A, Type "F"  
Over Exist. 15" Sewerline  
Cut And Abandon Line  
As Shown See

\$ Sta. 29+72.5  
o/s = 92 ± Lt.  
Construct New SMH #1B, Type "F" (C.C.O. #54 1st Supp.)

\$ Sta. 28+55 ±  
o/s = 67 ± Lt.  
1-Meter Box  
15" Gate Valve  
\$ Sta. 28+38  
o/s = 31 ± Rt.  
2-6" Solid Body Sleeves (3' Apart)

TRUE NORTH  
Scale: 1" = 40'

Wailoa River Moorage Basin

New Harbor Comfort Station Facility

For Gas Location See Detail Sheet J4

\$ Sta. 28+49  
o/s = 45 ± Rt.  
1-2" Gas Service Lateral Connect to Exist. Gas Meter

\$ WL Sta. 3+16 - 4" WL Sta. 0+00 o/s = 45 ± Rt.  
1-6" Tee  
1-6" X 4" Reducer  
1-FH Connection Per Water System Std. Detail No. 28-30  
1-6" Nipple  
1-Conc. Blk.

Hilo Iron Works  
4" WL Sta. 0+46  
1-1 1/4" Type "A" Service Lateral Connect to Exist. Customer Line  
4" WL Sta. 0+59  
1-4" Cap Tapped 2" IPT w/ Retainer Gland  
1-2" Cleanout Unit

\$ Sta. 26+46  
o/s = 57 ± Rt.  
4" Gas In 6" Steel Casing Through Coping  
6" WL Sta. 0+46  
1-6" X 1/4" Bend  
1-Conc. Blk.

6" WL Sta. 0+55  
1-FH Connection Per Water System Std. Detail No. 30

6" WL Sta. 2+99 ±  
Sta. 3+37 & 0+28  
10 L.F. Conc. Jacket  
6" WL Sta. 2+85 ±  
Conc. Jacket Over 6" Pili Pipe & Under 6" Concrete Drain Pipe.

\$ Sta. 26+31.6  
o/s = 50 ± Rt.  
Gas Inc. Shall Connect to Exist. 4" Gas, Provide Trench and Backfill.  
6" WL Sta. 0+16  
10 L.F. Conc. Jacket

6" WL Sta. 0+30  
10 L.F. Conc. Jacket

\$ Sta. 25+40 ±  
o/s = 64 ± Rt.  
Adjust SMH Frame & Cover

\$ Sta. 25+35 ±  
o/s = 30 ± Rt.  
Conn. to Exist. 12" W.L. Remove & Salvage Exist. 12" Bend  
1-12" Solid Body Sleeve

\$ Sta. 25+20 ±  
o/s = 30 ± Rt.  
1-12" X 6" Tee (M.J.)  
1-12" B.F.V.  
1-6" G.V.  
1-Conc. Blk.  
2-Valve Boxes

\$ Sta. 23+32 ±  
o/s = 5 ± Rt.  
Adjust WVB Frame & Cover

\$ Sta. 23+15 ±  
o/s = 25 ± Rt.  
Adjust SMH Frame & Cover  
\$ Sta. 23+30 (±)  
o/s 4' Lt.  
1-12" Butterfly Water Valve  
1-Valve Box


\$ Kam Ave. Sta. 19+50 to Sta. 26+20  
Remove Existing 6" C.I. Pipe. Install & Lower New 6" D.I. Pipe, Class 52 (C.C.O. #68)

\$ Sta. 20+69  
o/s = 15 ± Rt.  
Adjust SMH Frame and Cover (C.C.O. #67)

\$ Sta. 20+00 to Sta. 25+50 ± Rt.  
Abandon in place 550 ± L.F. of Existing 12" C.I. Waterline.

APPROVED  
CHIEF, WASTEWATER & SOLID WASTE DIVISION  
MANAGER, DEPARTMENT OF WATER SUPPLY  
GASCO, INC.

PLAN

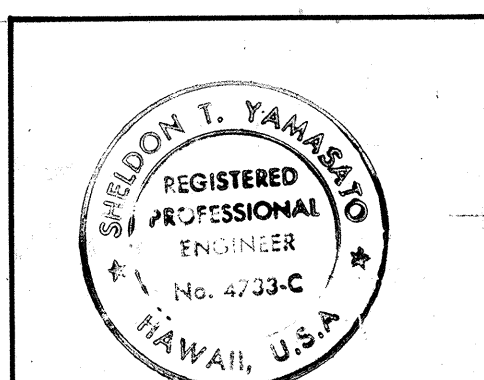


THIS WORK WAS PREPARED BY ME OR UNDER MY SUPERVISION

STATE OF HAWAII  
DEPARTMENT OF TRANSPORTATION  
HIGHWAYS DIVISION  
**UTILITY PLAN**  
B. STA. 52+10.91 TO 63+00  
HAWAII BELT ROAD/KAMEHAMEHA AVENUE  
Wailoa Bridge Replacement And Approaches  
FEDERAL AID PROJECT NO. BR-F-019-2(27)  
SCALE: AS NOTED DATE: SEPT., 1986  
SHEET NO. 31 OF 8 SHEETS

| DATE    | REVISION                                                                                                                                                  |
|---------|-----------------------------------------------------------------------------------------------------------------------------------------------------------|
| 6/16/89 | Revised Water Line & Added Gas Notes                                                                                                                      |
| 5/11/89 | Revised Water Line                                                                                                                                        |
| 11/1/88 | Relocated Gas line, Added New location of Harbor Comfort Station Facility, Added Sewer and Revised Water line size to New Harbor Comfort Station Facility |

C.O. 31

| FED. ROAD<br>DIST. NO. | STATE | FED. AID<br>PROJ. NO. | FISCAL<br>YEAR | SHEET<br>NO. | TOTAL<br>SHEETS |
|------------------------|-------|-----------------------|----------------|--------------|-----------------|
| HAWAII                 | HAW.  | BR-F-019-2(27)        | 1987           | 32           | 134             |

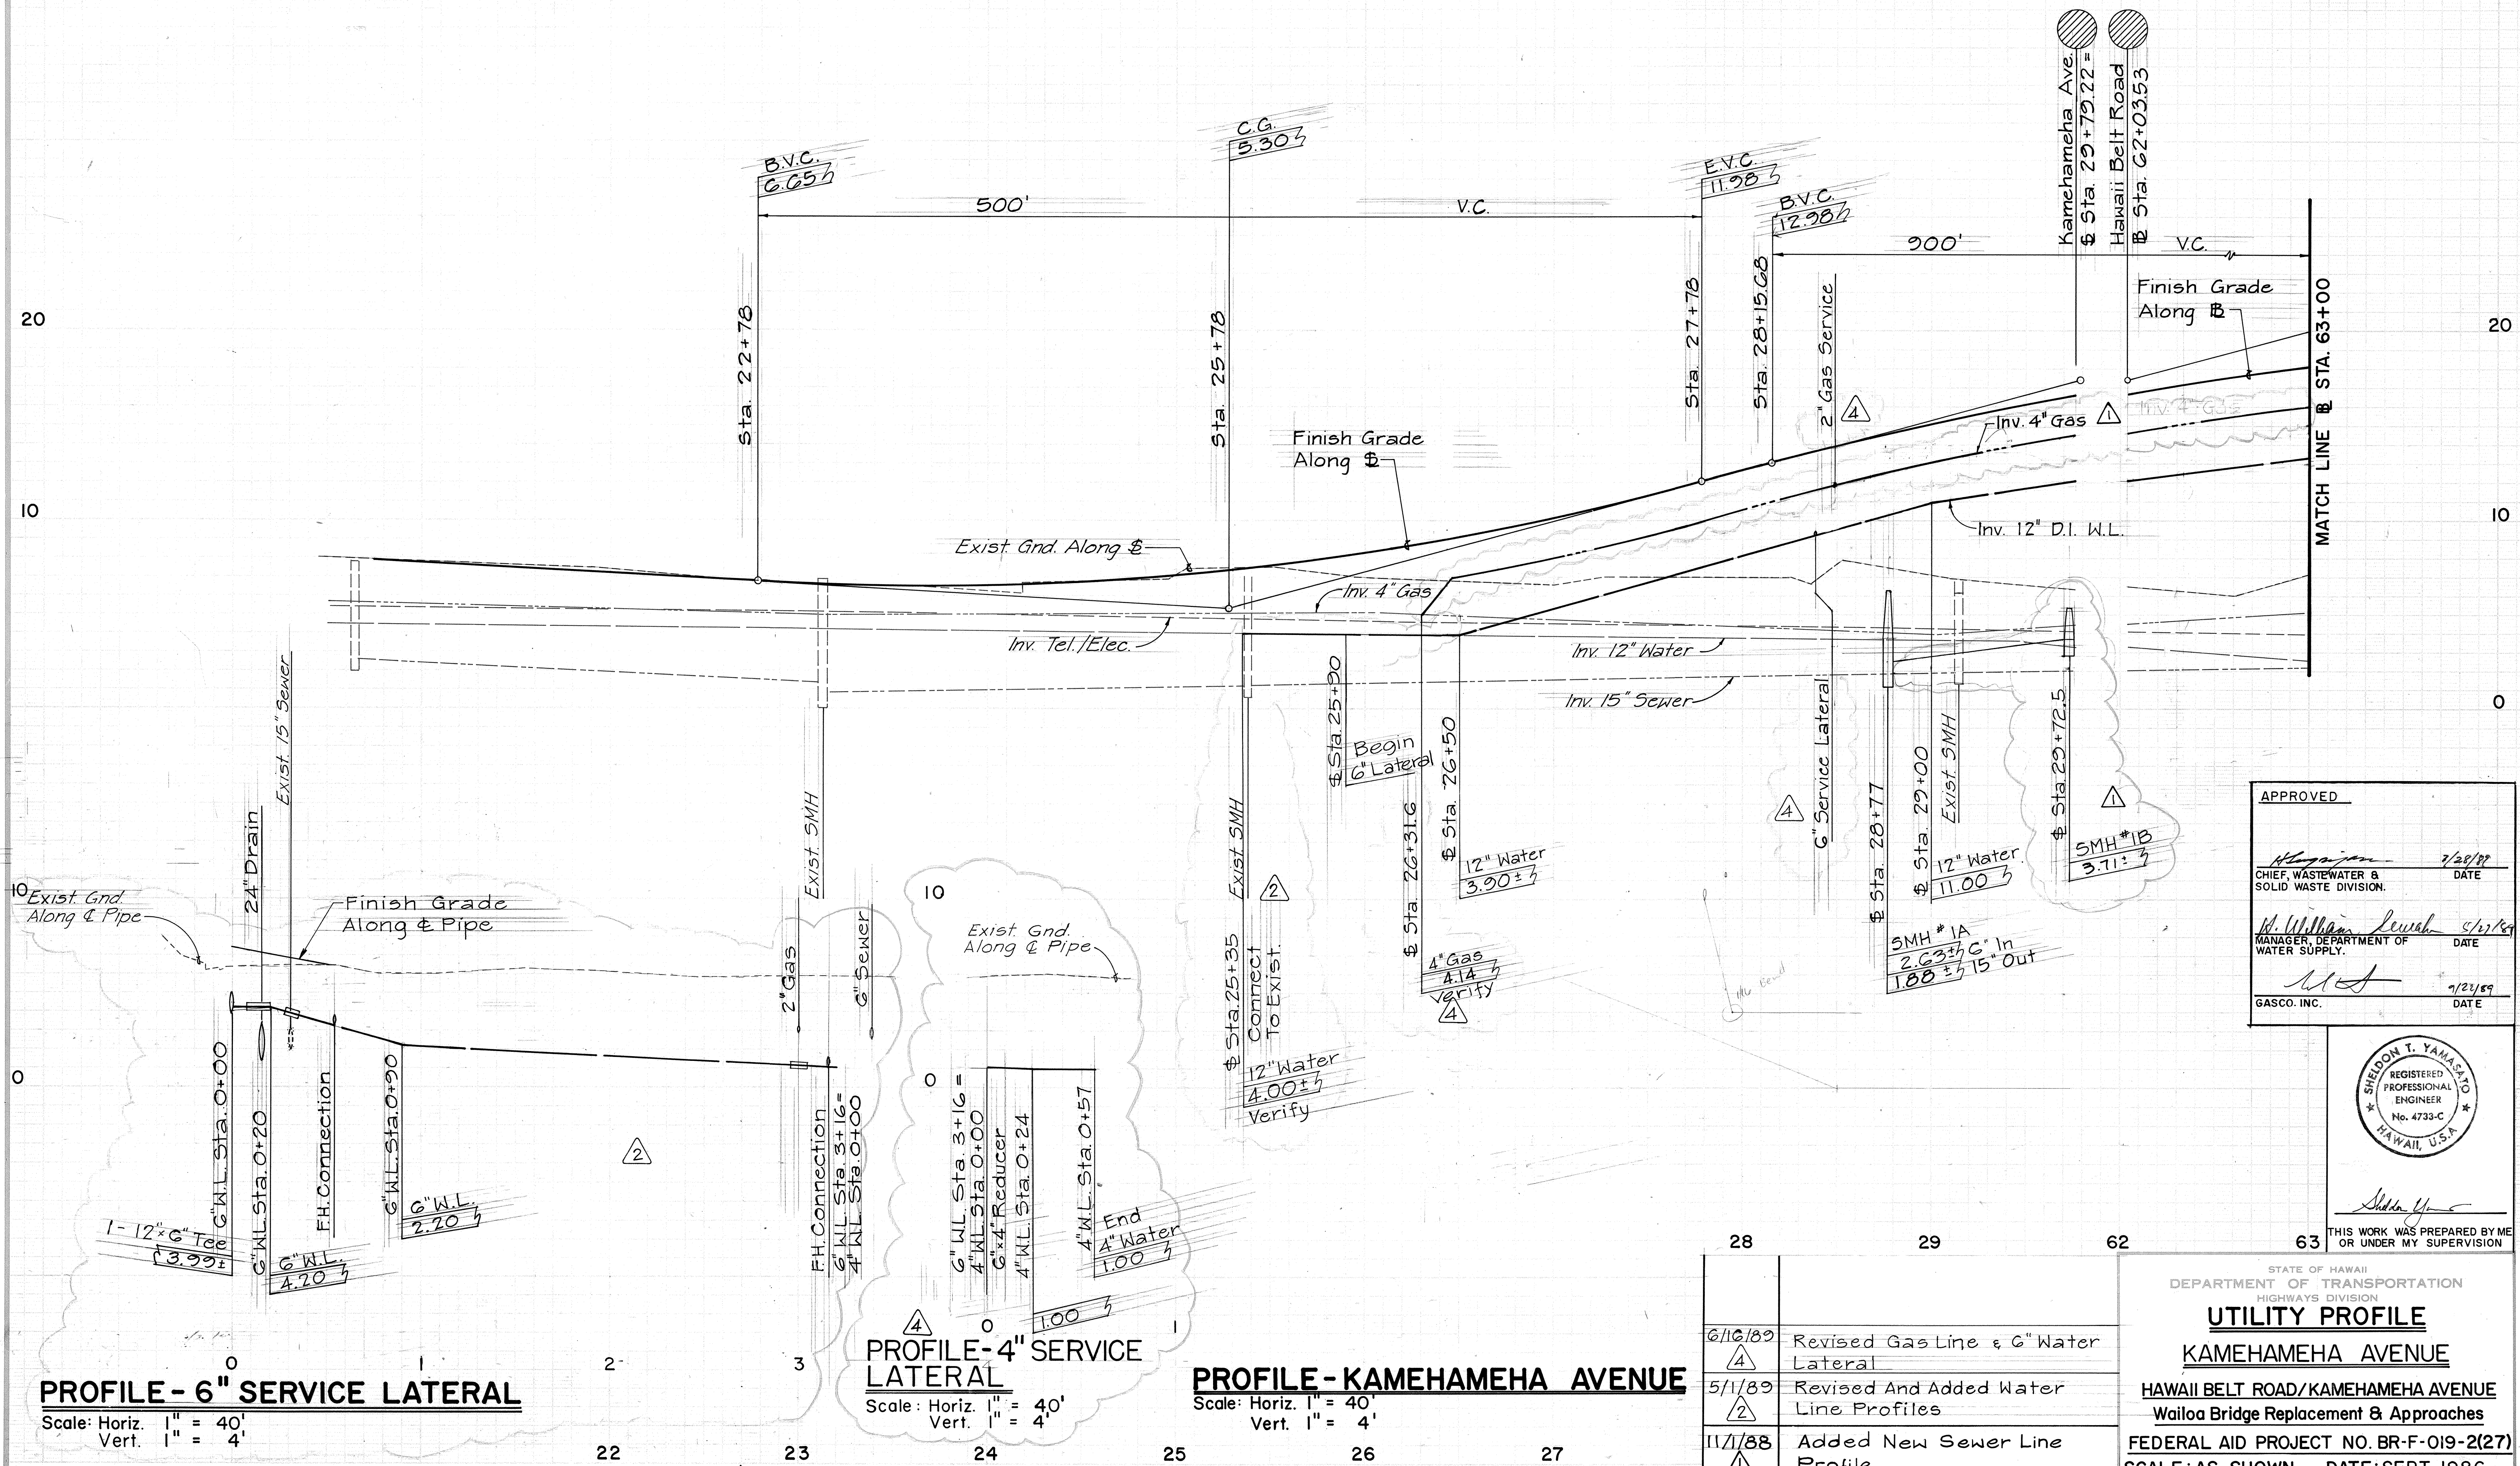

|      |          |    |                                                                              |                                                         |
|------|----------|----|------------------------------------------------------------------------------|---------------------------------------------------------|
| 28   | 29       | 62 | 63                                                                           | THIS WORK WAS PREPARED BY ME<br>OR UNDER MY SUPERVISION |
|      |          |    | STATE OF HAWAII<br>DEPARTMENT OF TRANSPORTATION<br>HIGHWAYS DIVISION         |                                                         |
|      |          |    | <u>UTILITY PROFILE</u>                                                       |                                                         |
|      |          |    | <u>KAMEHAMEHA AVENUE</u>                                                     |                                                         |
|      |          |    | HAWAII BELT ROAD/KAMEHAMEHA AVENUE<br>Wailoa Bridge Replacement & Approaches |                                                         |
|      |          |    | FEDERAL AID PROJECT NO. BR-F-019-2(27)                                       |                                                         |
|      |          |    | SCALE: AS SHOWN DATE: SEPT, 1986                                             |                                                         |
| DATE | REVISION |    | SHEET No. J2 OF 8 SHEETS                                                     |                                                         |

C.O. 32

| FED. ROAD DIST. NO. | STATE | FED. AID PROJ. NO. | FISCAL YEAR | SHEET NO. | TOTAL SHEETS |
|---------------------|-------|--------------------|-------------|-----------|--------------|
| HAWAII              | HAW.  | BR-F-019-2(27)     | 1987        | 33        | 134          |

TRUE NORTH  
Scale: 1" = 40'

Sta. 64+90±  
O/S = 38.67' Rt.  
1- C & C Type "DB" Frame  
1- Water Manhole Cover  
See Detail On Sheet 91  
Wailoa River  
Moorage Basin

Sta. 67+70±  
O/S = 31' Lt.  
Cut & Plug Exist. 30" No. 3

Sta. 67+77  
O/S = 31' Lt.  
Connect to Exist.  
30" S.F.M.  
1- 30" 1/8 Bend  
1- Conc. Blk.  
See A  
J3 JB

Sta. 71+90±  
O/S = 12' Rt.  
Adjust 3-WVB  
Frame & Cover

Sta. 71+96  
O/S = 12' Rt.  
Adjust GMH  
Frame & Cover

Sta. 72+18  
Remove Exist.  
Fire Hydrant Unit

Sta. 63+80  
O/S = 35' Rt.  
4" Gas In 6"  
Steel Casing  
Through Coping

Sta. 63+90  
O/S = 38.67' Rt.  
1- 12" B.F.V.  
1- Valve Box

Sta. 65+90  
O/S = 44.25' Rt.  
1- Ball Valve  
1- Valve Box

Sta. 66+58.75  
O/S = 38.67' Rt.  
1- 12" x 12" Gross M.J.  
5- 12" Nipples (24" Long)  
3- 12" B.F.V. (M.J.)  
1- 8" G.V. (M.J.) CL 250  
1- 12" x 8" Reducer M.J.  
1- Conc. Blk.  
4- Valve Boxes

Sta. 66+70±  
O/S = 38.67' Rt.  
1- Air Relief Valve Unit  
1- Valve Box

Sta. 66+70.92  
FC Sta. 66+70.92

Sta. 67+20±  
O/S = 15' Rt.  
1- 12" 1/2 Bend M.J.  
1- Retainer Gland  
1- Conc. Blk.

Sta. 68+95  
O/S = 24' Rt.  
12" L.F. Conc. Jacket

Sta. 70+58.07  
PT. Sta. 70+58.07  
R = 5000

Sta. 71+20±  
O/S = 15' Rt.  
1- 12" 1/2 Bend M.J.  
1- Retainer Gland  
1- Conc. Blk.

Sta. 71+30±  
O/S = 14' Rt.  
Connect to Exist.  
12" C.I. Water Line  
1- 12" Transition Coupling  
1- 12" Nipple (Cut to Fit)  
2- 12" Solid Body Sleeves

Sta. 71+34±  
O/S = 18' Rt.  
Connect to Exist.  
4" Gas Line

Sta. 71+36±  
O/S = 18' Rt.  
Connect to Exist.  
4" Gas Line

Sta. 71+40±  
O/S = 18' Rt.  
Connect to Exist.  
4" Gas Line

Sta. 71+46±  
O/S = 18' Rt.  
Connect to Exist.  
4" Gas Line

Sta. 71+76±  
O/S = 18' Rt.  
Connect to Exist.  
4" Gas Line

Sta. 72+30±  
O/S = 14' Rt.  
Connect to Exist.  
12" C.I. Water Line  
1- 12" Transition Coupling  
1- 12" Nipple (Cut to Fit)  
2- 12" Solid Body Sleeves

# PLAN

V.C.

Finish Grade Along B

Inv. 12" D.I. Waterline  
Exist. Gnd. Along B


Inv. 12" W.L.

# PROFILE

Scale: Horiz. 1" = 40'  
Vert. 1" = 4'

| DATE    | REVISION                                                        |
|---------|-----------------------------------------------------------------|
| 6/16/89 | Added Ball Valves, 12" Tr. Flex Restrained Joint & Steel Casing |
| 5/1/89  | Revised Water Line                                              |
| 11/1/88 | Relocated Gas Line                                              |


STATE OF HAWAII  
DEPARTMENT OF TRANSPORTATION  
HIGHWAYS DIVISION  
**UTILITY PLAN**  
B. STA. 63+00 TO 73+00  
HAWAII BELT ROAD/KAMEHAMEHA AVENUE  
Wailoa Bridge Replacement And Approaches  
FEDERAL AID PROJECT NO. BR-F-019-2(27)  
SCALE: AS NOTED DATE: SEPT., 1986  
SHEET NO. J3 OF 8 SHEETS

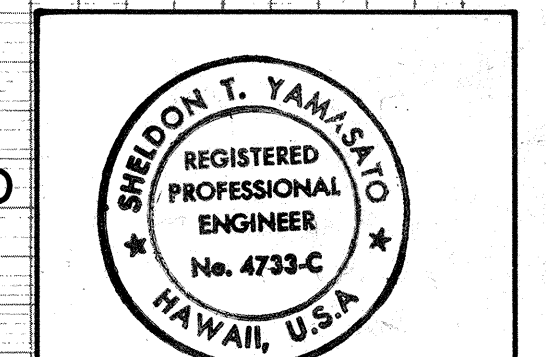

THIS WORK WAS PREPARED BY ME OR UNDER MY SUPERVISION

| ORIGINAL PLAN | DATE |
|---------------|------|
| DESIGNED BY   |      |
| NOTED BY      |      |
| CHECKED BY    |      |
| NO.           |      |



| APPROVED                                  | DATE    |
|-------------------------------------------|---------|
| CHIEF, WASTE WATER & SOLID WASTE DIVISION | 9/20/89 |
| MANAGER, DEPARTMENT OF WATER SUPPLY       | 9/20/89 |
| GAS CO. INC.                              | DATE    |

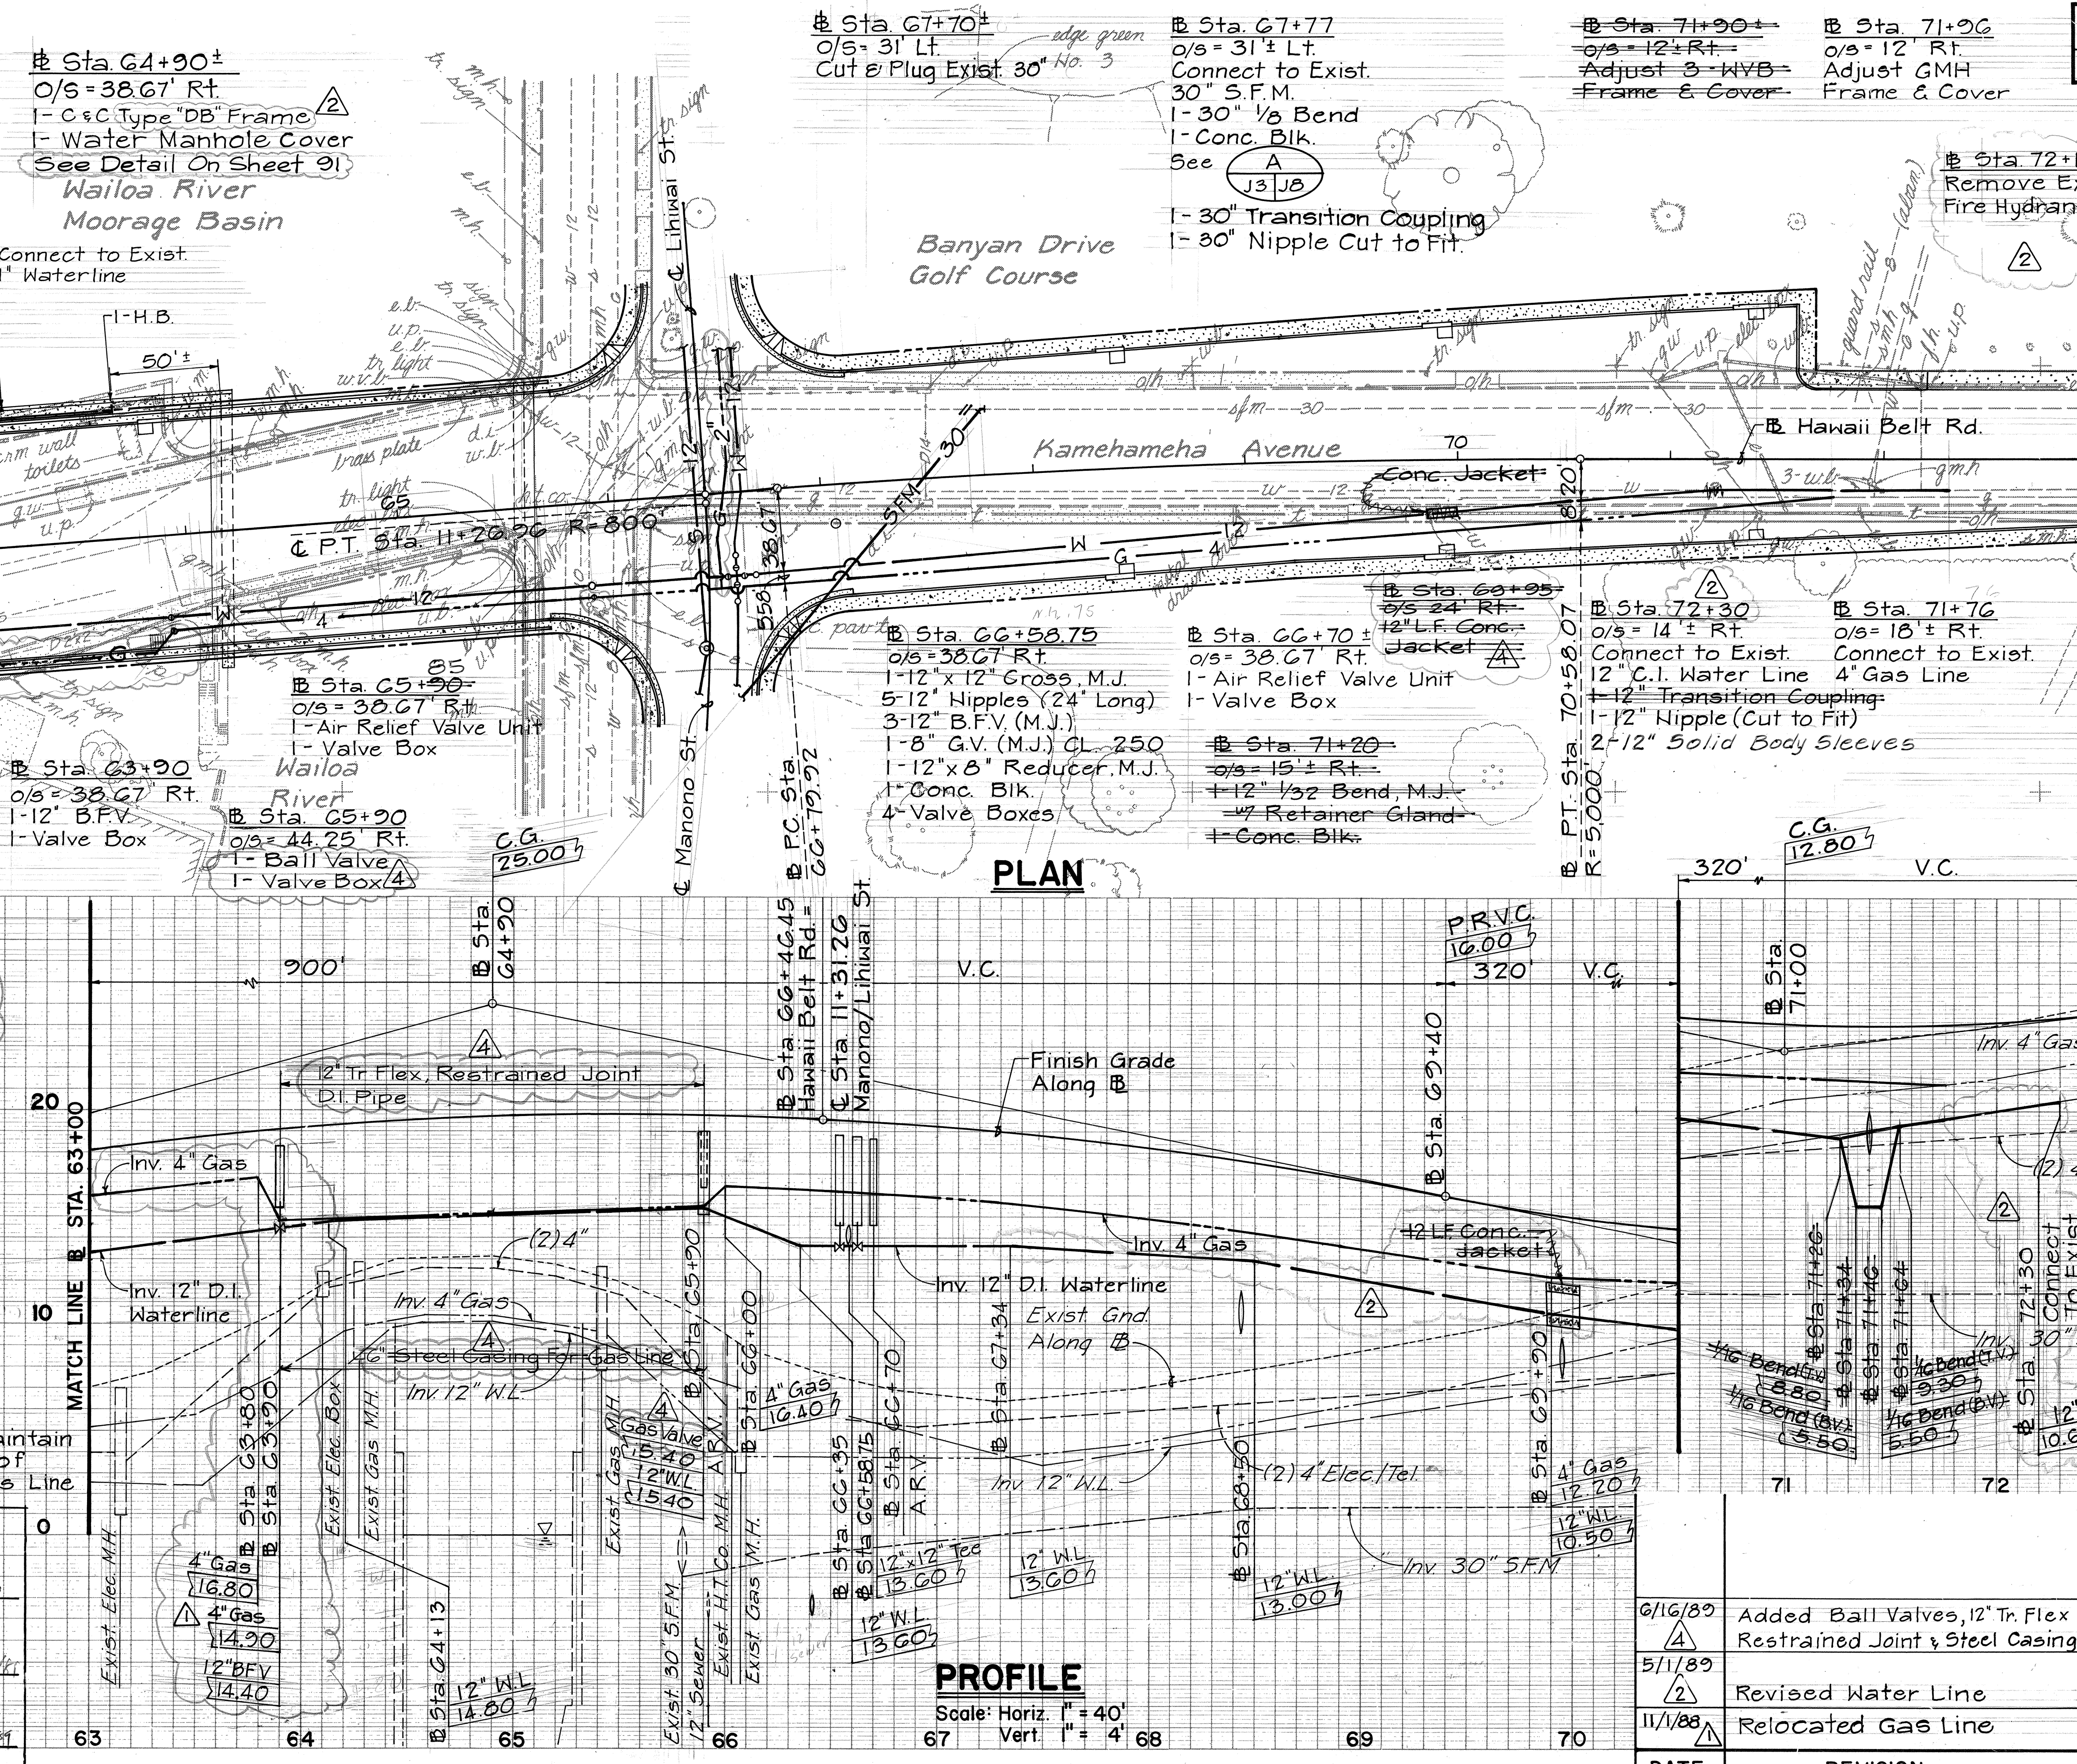


| FED. ROAD DIST. NO. | STATE | FED. AID PROJ. NO. | FISCAL YEAR | SHEET NO. | TOTAL SHEETS |
|---------------------|-------|--------------------|-------------|-----------|--------------|
| HAWAII              | HAW.  | BR-F-019-2(27)     | 1987        | 34        | 134          |

TRUE NORTH

Scale: 1" = 40'

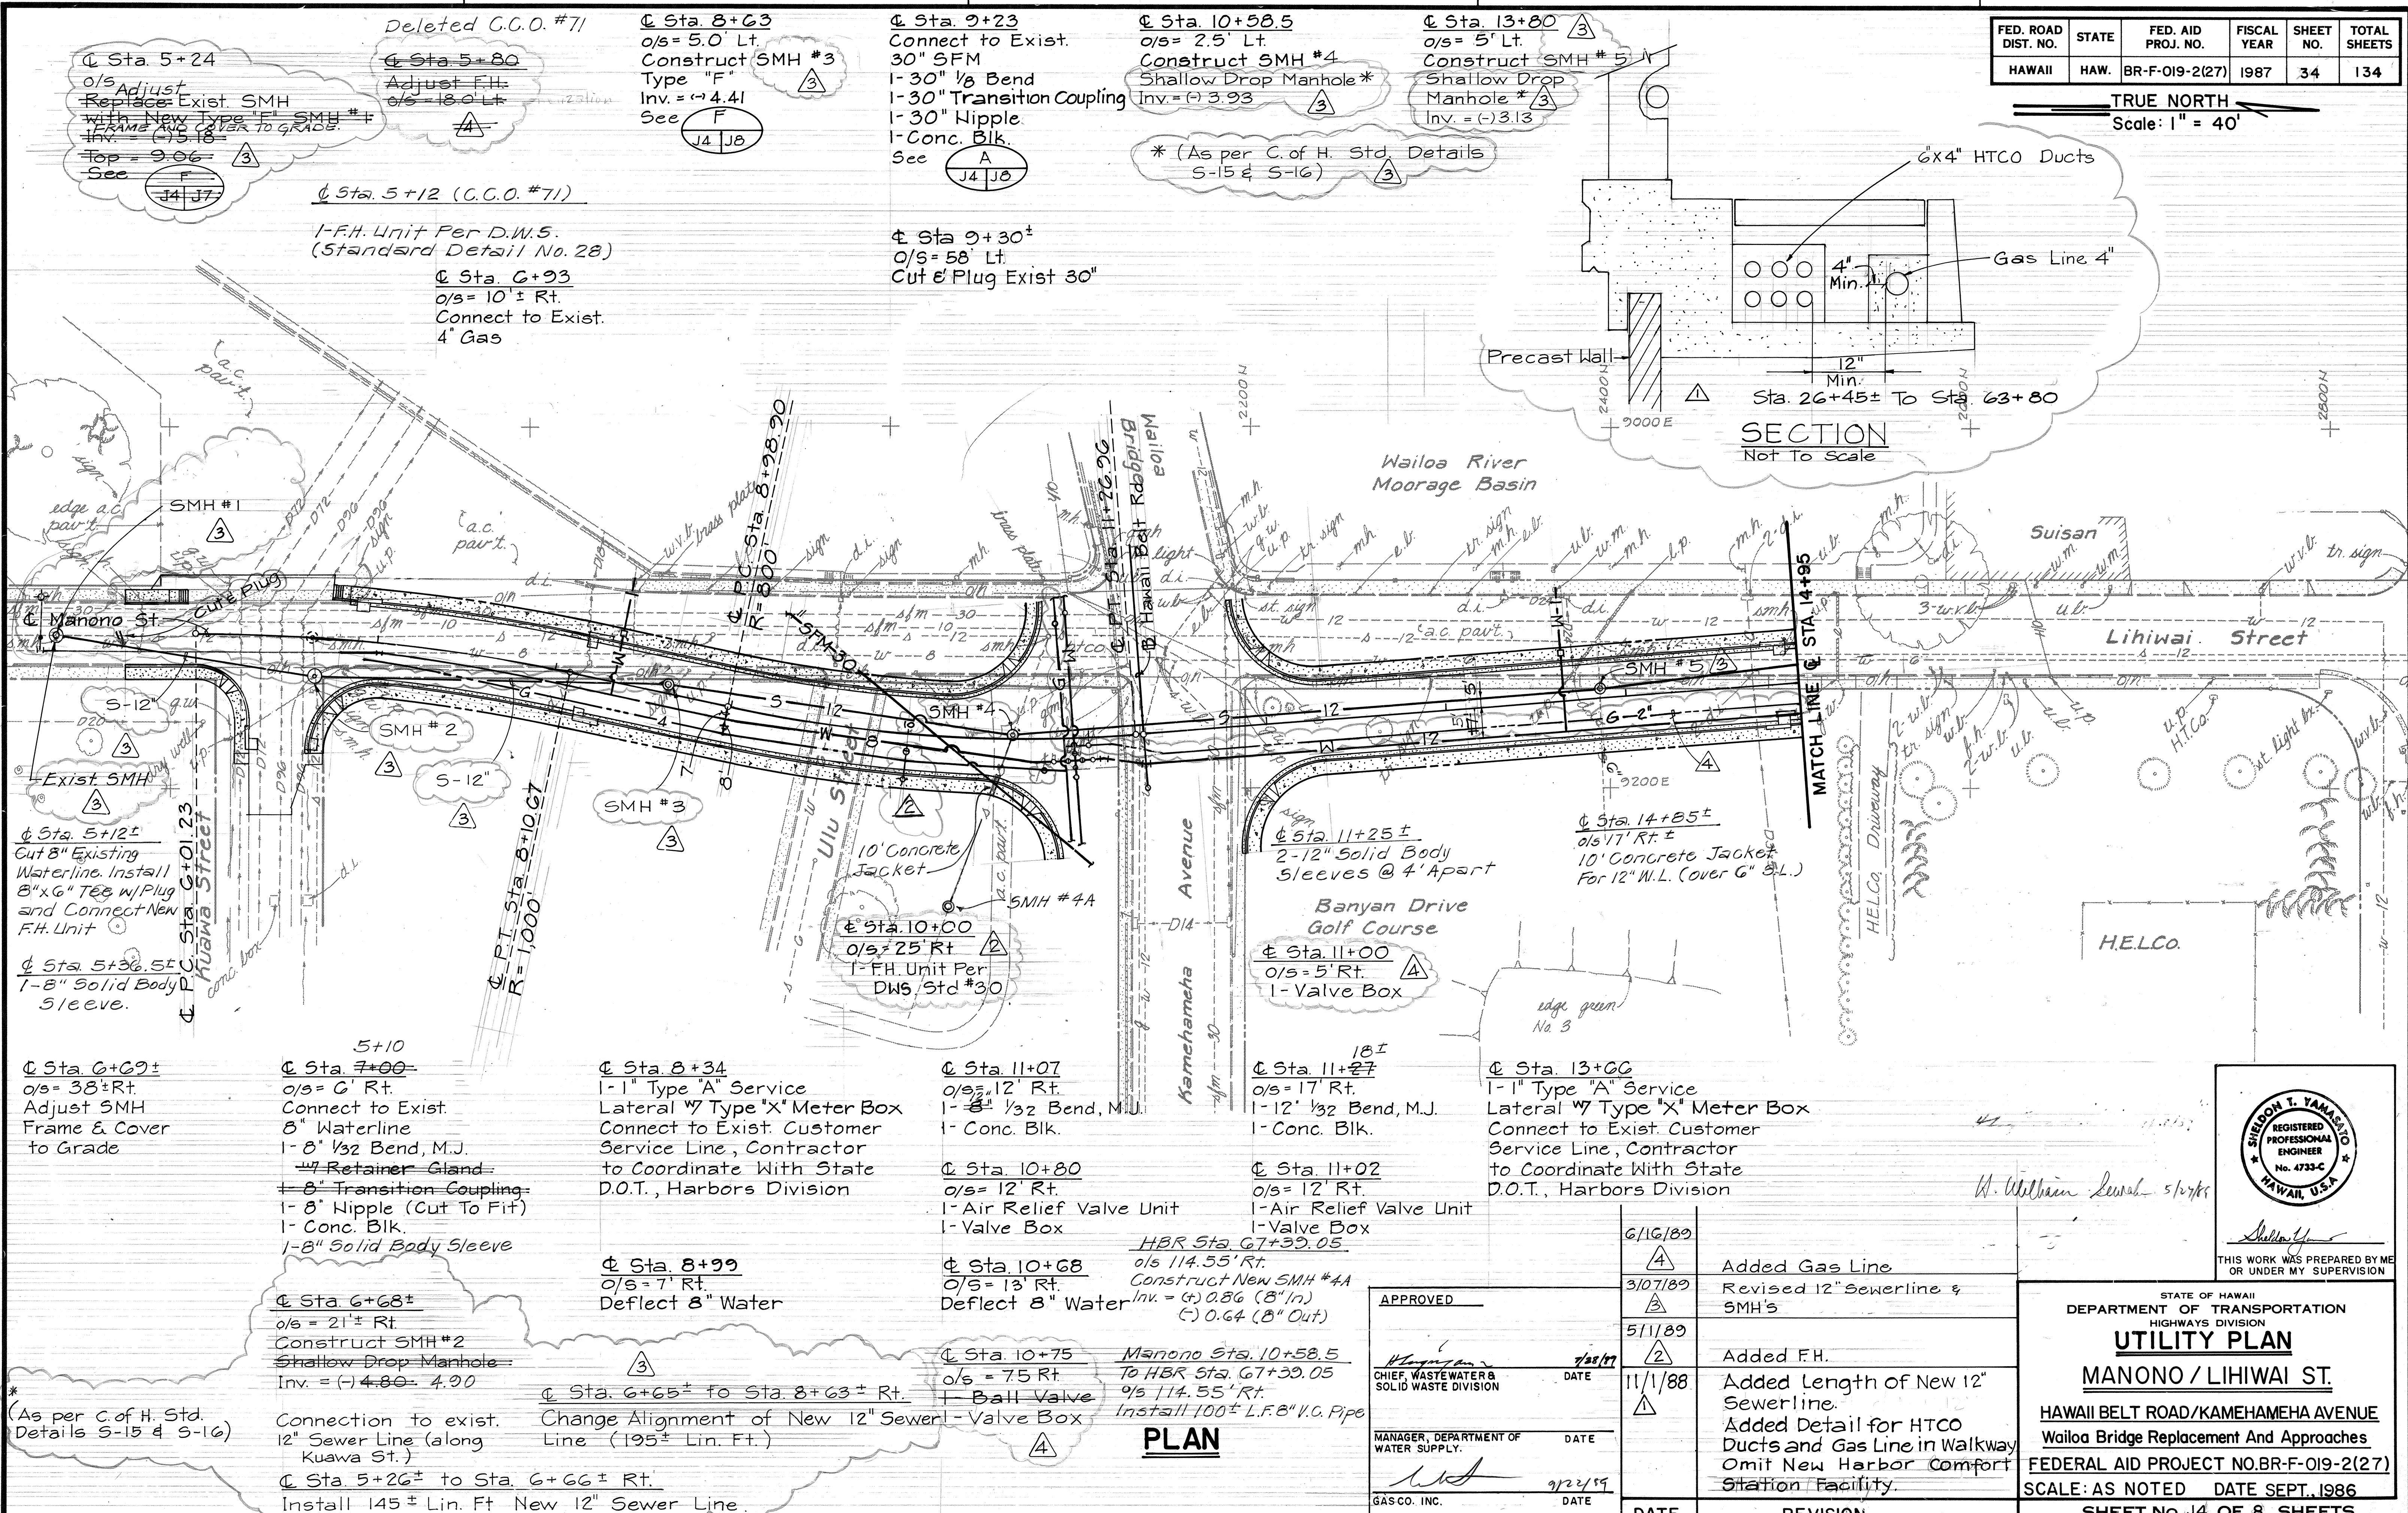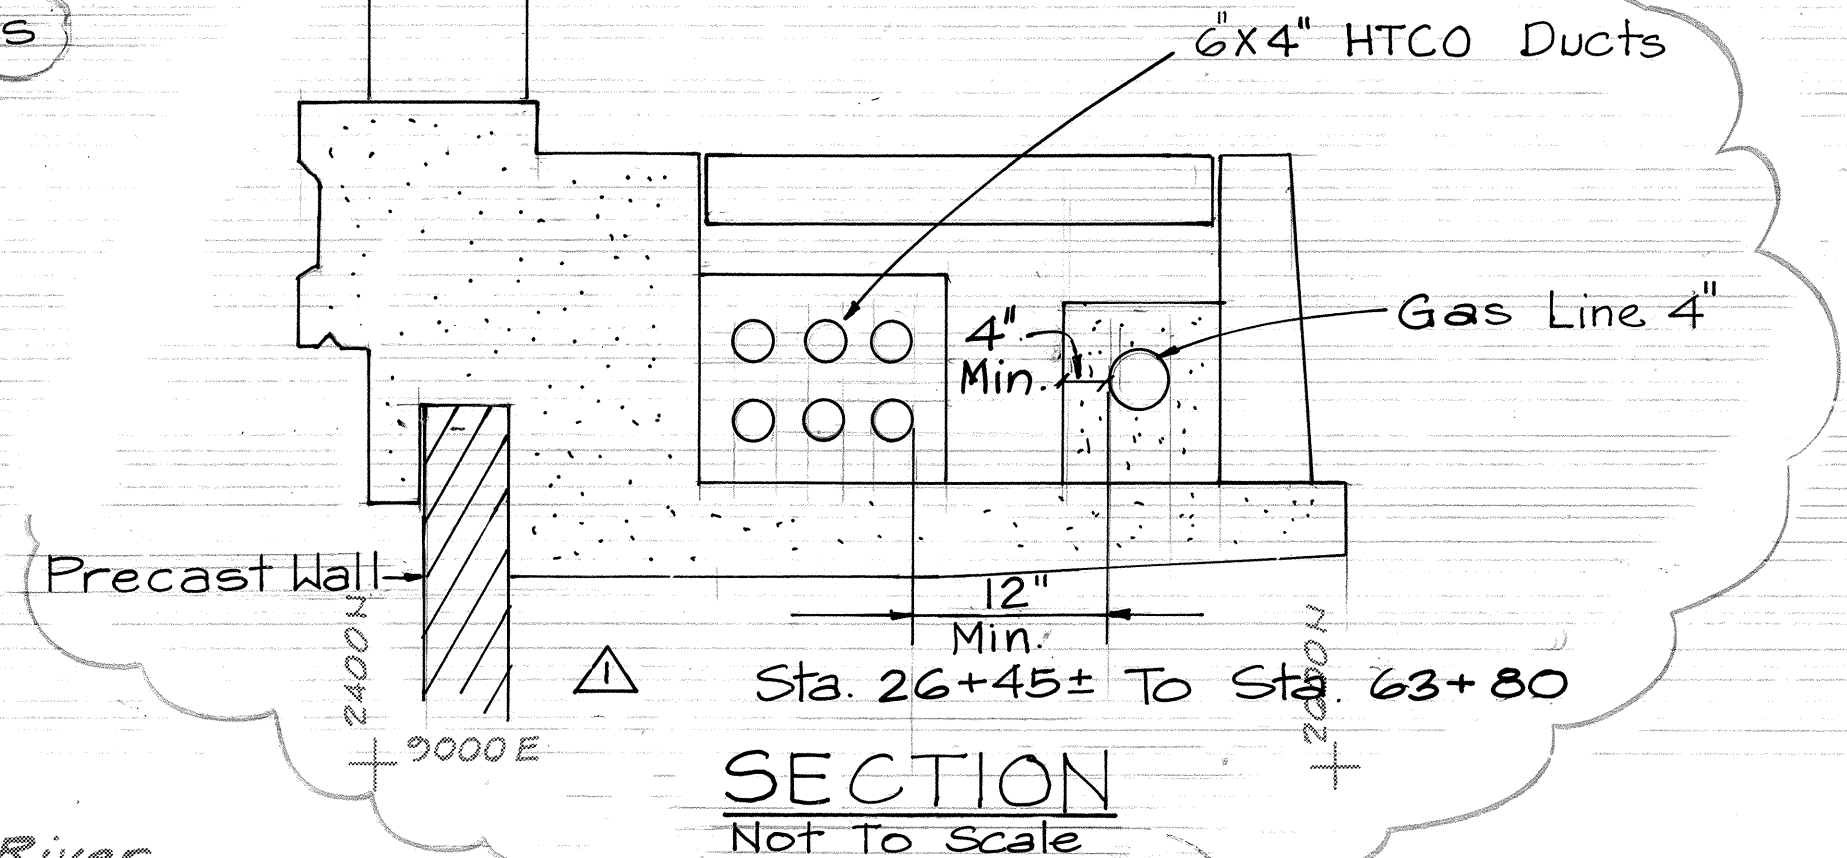

|                   |       |
|-------------------|-------|
| DATE              | ..... |
| SURVEY PLOTTED BY | ..... |
| DRAWN BY          | ..... |
| TRACED BY         | ..... |
| NOTED BY          | ..... |
| CHECKED BY        | ..... |
| ORIGINAL PLAN     | ..... |
| NOTE BOOK         | ..... |
| NO.               | ..... |

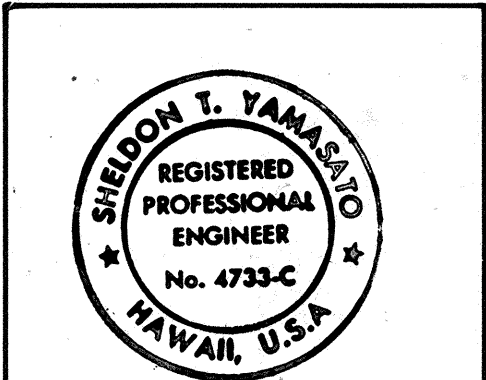


THIS WORK WAS PREPARED BY ME OR UNDER MY SUPERVISION

| DATE    | REVISION                                                                                                                               |
|---------|----------------------------------------------------------------------------------------------------------------------------------------|
| 6/16/89 | Added Gas Line                                                                                                                         |
| 3/07/89 | Revised 12" Sewerline & SMH's                                                                                                          |
| 5/11/89 | Added F.H.                                                                                                                             |
| 11/1/88 | Added Length of New 12" Sewerline.<br>Added Detail for HTCO Ducts and Gas Line in Walkway<br>Omit New Harbor Comfort Station Facility. |

STATE OF HAWAII  
DEPARTMENT OF TRANSPORTATION  
HIGHWAYS DIVISION  
**UTILITY PLAN**  
**MANONO / LIHIWAI ST.**  
HAWAII BELT ROAD/KAMEHAMEHA AVENUE  
Wailoa Bridge Replacement And Approaches  
FEDERAL AID PROJECT NO. BR-F-019-2(27)  
SCALE: AS NOTED DATE SEPT. 1986  
SHEET No. 34 OF 8 SHEETS

PLAN

| FED. ROAD<br>DIST. NO. | STATE | FED. AID<br>PROJ. NO. | FISCAL<br>YEAR | SHEET<br>NO. | TOTAL<br>SHEETS |
|------------------------|-------|-----------------------|----------------|--------------|-----------------|
| HAWAII                 | HAW.  | BR-F-019-2(27)        | 1987           | 35           | 134             |

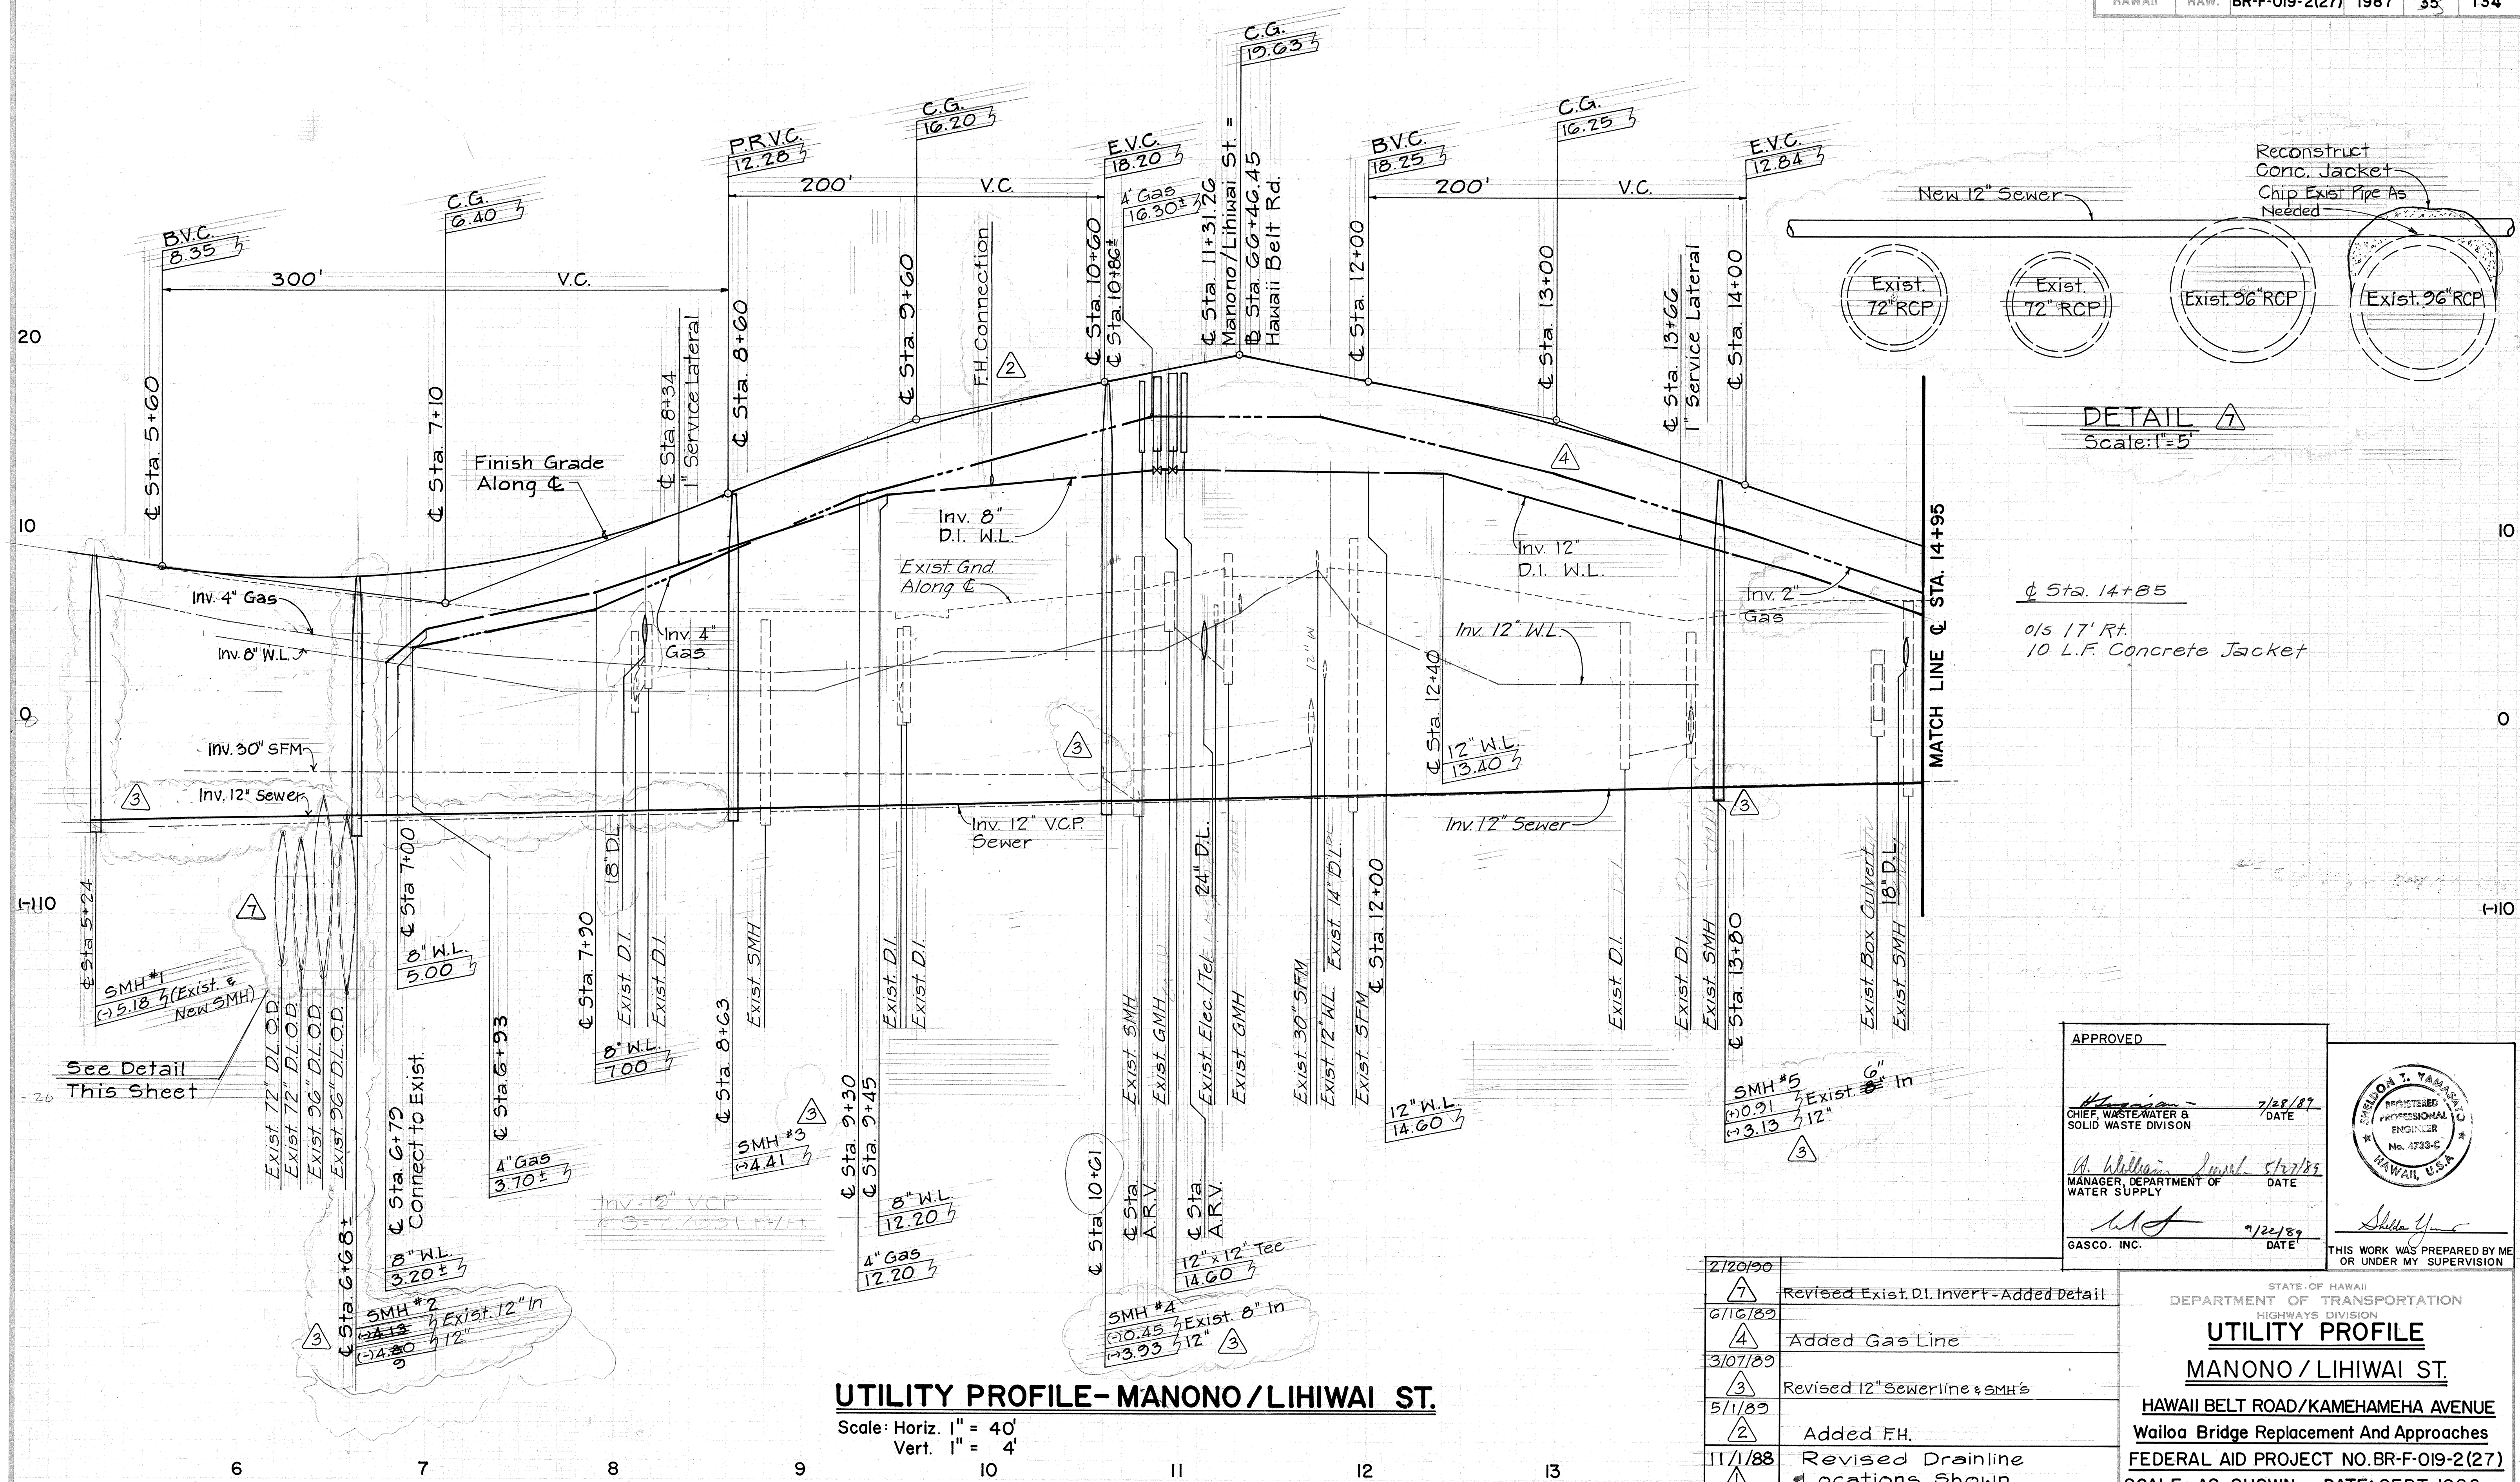

|         |   |                                           |
|---------|---|-------------------------------------------|
| 2/20/90 | 7 | Revised Exist. D.I. Invert - Added Detail |
| 6/16/89 | 4 | Added Gas Line                            |
| 3/07/89 | 3 | Revised 12" Sewerline & SMH's             |
| 5/1/89  | 2 | Added F.H.                                |
| 11/1/88 | 1 | Revised Drainline<br>• Locations Shown    |
| DATE    |   | REVISION                                  |

APPROVED \_\_\_\_\_

*H. Wilson* 7/28/89  
CHIEF, WASTE WATER &  
SOLID WASTE DIVISION DATE


*A. Williams* 5/27/89  
MANAGER, DEPARTMENT OF  
WATER SUPPLY DATE

*W. J.* 7/22/89  
GASCO, INC. DATE

THE WORK WAS PREPARED BY ME  
OR UNDER MY SUPERVISION.

STATE OF HAWAII  
DEPARTMENT OF TRANSPORTATION  
HIGHWAYS DIVISION  
**UTILITY PROFILE**  
**MANONO / LIHIWAI ST.**  
**HAWAII BELT ROAD/KAMEHAMEHA AVENUE**  
**Wailoa Bridge Replacement And Approaches**  
**FEDERAL AID PROJECT NO.BR-F-019-2(27)**  
**SCALE: AS SHOWN      DATE: SEPT.,1986**  
**SHEET No. J5 OF 8 SHEETS**

C.O. 35

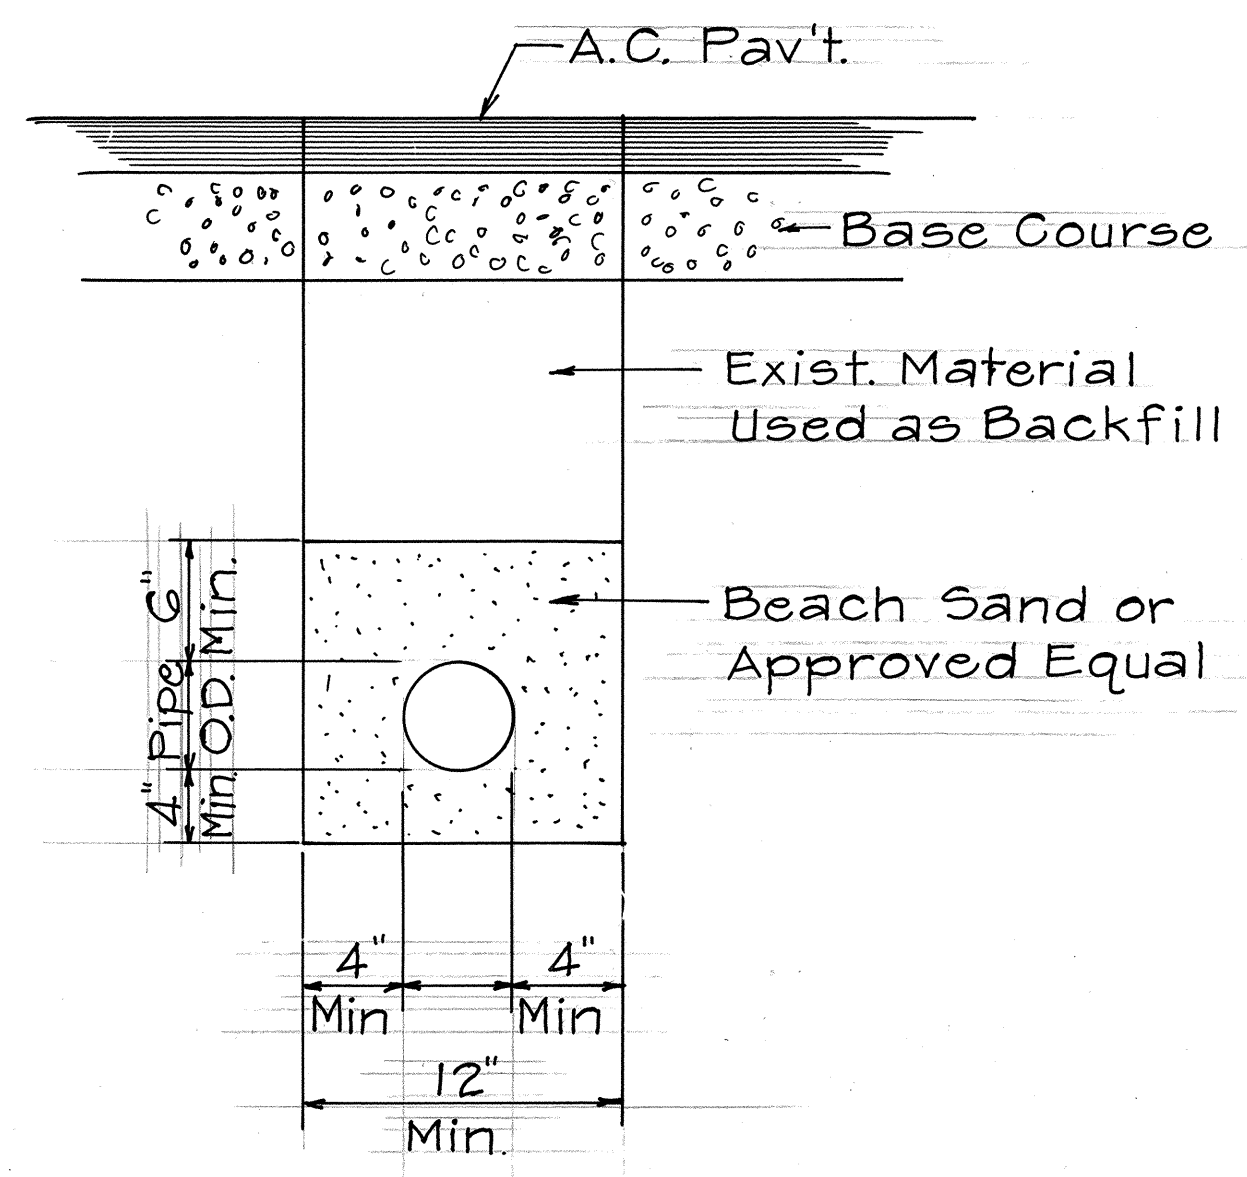

**GAS LINE TRENCH DETAIL**  
Not to Scale

Sta. 16+25  
2 1/2" Copper Service  
Lateral Connect To Existing  
2" G.I. Customer Line  
1-2" Gate Valve

Sta. 15+25±  
Cut and Cap 12" Line

15+88±  
Sta. 16+05±  
o/s = 17 Rt.  
1-4" Compound Meter Box  
Installation Per Water  
System Std. Detail No. 53  
4" Compound Meter to be  
Furnished & Installed By  
D.W.S., Connect to Exist.  
Customer Service Line.  
1-12" B.F.V. (C.C.O. #82)

16+20.6  
Sta. 16+43.5±  
o/s = 17 Rt.  
1- F.H. Connection  
Per Water System  
Std. Detail No. 30.

Sta. 15+50  
o/s = 7.0 ± LT  
Construct SMH #6  
Type "F"  
Inv. = (-) 2.78  
See Detail

Sta. 16+48.52  
1-1" Type "A" Copper  
Service Lateral  
Connect to Exist  
Customer Service  
Line.

Sta. 18+40  
o/s = 15 Rt.  
End Gas Line

Sta. 18+00±  
2-12" Solid Body Sleeves

Existing 3"x3" Tee  
Cut and Cap  
Existing Service  
To Suisan's  
2" Meter

Sta. 16+02± & 16+08±  
2-12" Solid Body Sleeves

Sta. 16+63  
o/s = 17 Rt.  
10 LF Concrete  
Jacket

Sta. 16+84±  
2" Plastic  
Service Lateral  
(Gas)


| FED. ROAD DIST. NO. | STATE | FED. AID PROJ. NO. | FISCAL YEAR | SHEET NO. | TOTAL SHEETS |
|---------------------|-------|--------------------|-------------|-----------|--------------|
| HAWAII              | HAW.  | BR-F-019-2(27)     | 1987        | 36        | 134          |

TRUE NORTH  
Scale: 1" = 40'

Sta. 18+30±  
o/s = 13 Rt.  
Connect to Exist.  
6" Waterline  
1-6" Nipple (Cut to Fit)  
1-6" Transition Coupling


Sta. 18+21±  
o/s = 18 Rt.  
Connect to Exist. 12"  
Waterline  
1-12"x12" Tee  
1-12" B.F.V., M.J.  
1-6" G.V., M.J. (Cl. 250)  
3-12" Nipples (24" Long)  
1-12" Transition Coupling  
1-12" Solid Body Sleeve  
1-12"x6" Reducer, M.J.  
1-12" Bend, M.J.  
1-6" Nipple (24" Long)  
1-Valve Box  
2-Conc. Blk.  
50-LF 6" Pipe

**PLAN - LIHIWAI ST.**

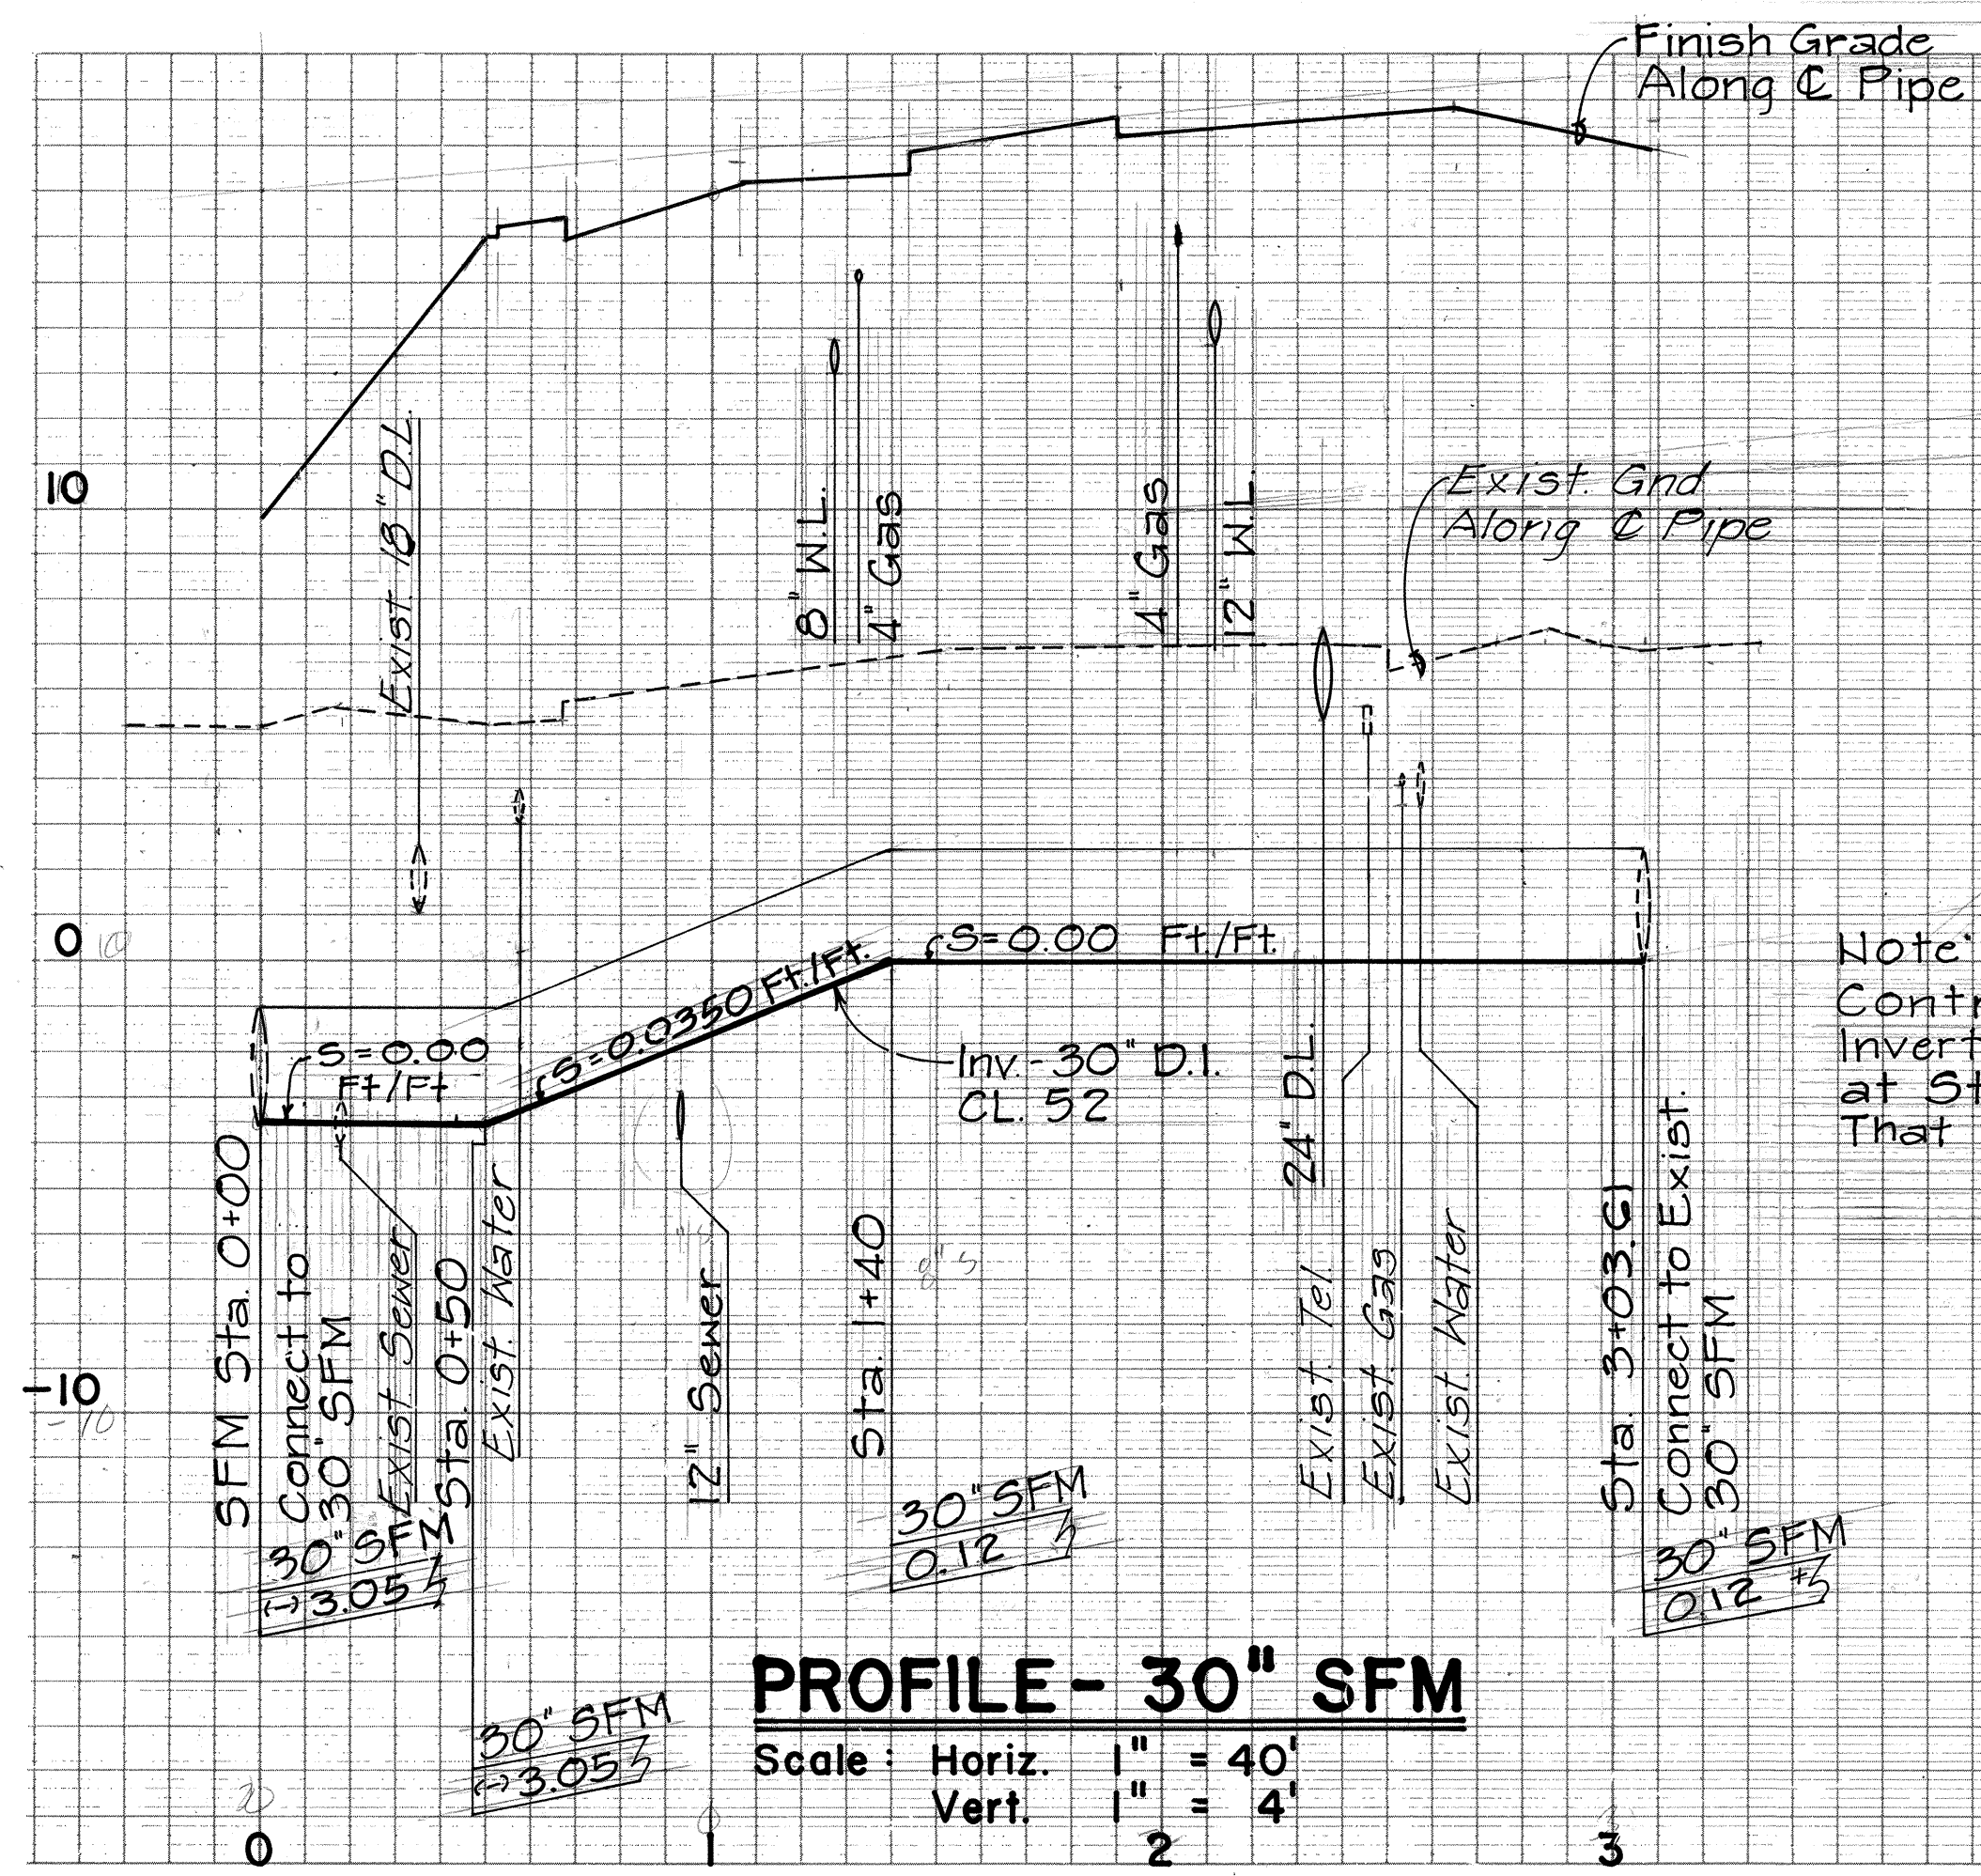

**PROFILE - 30" SFM**  
Scale: Horiz. 1" = 40'  
Vert. 1" = 4'


Note:  
Contractor to Verify The  
Invert at Sta. 3+07, Inv.  
at Sta. 1+40 to Match  
That of Sta. 3+07.

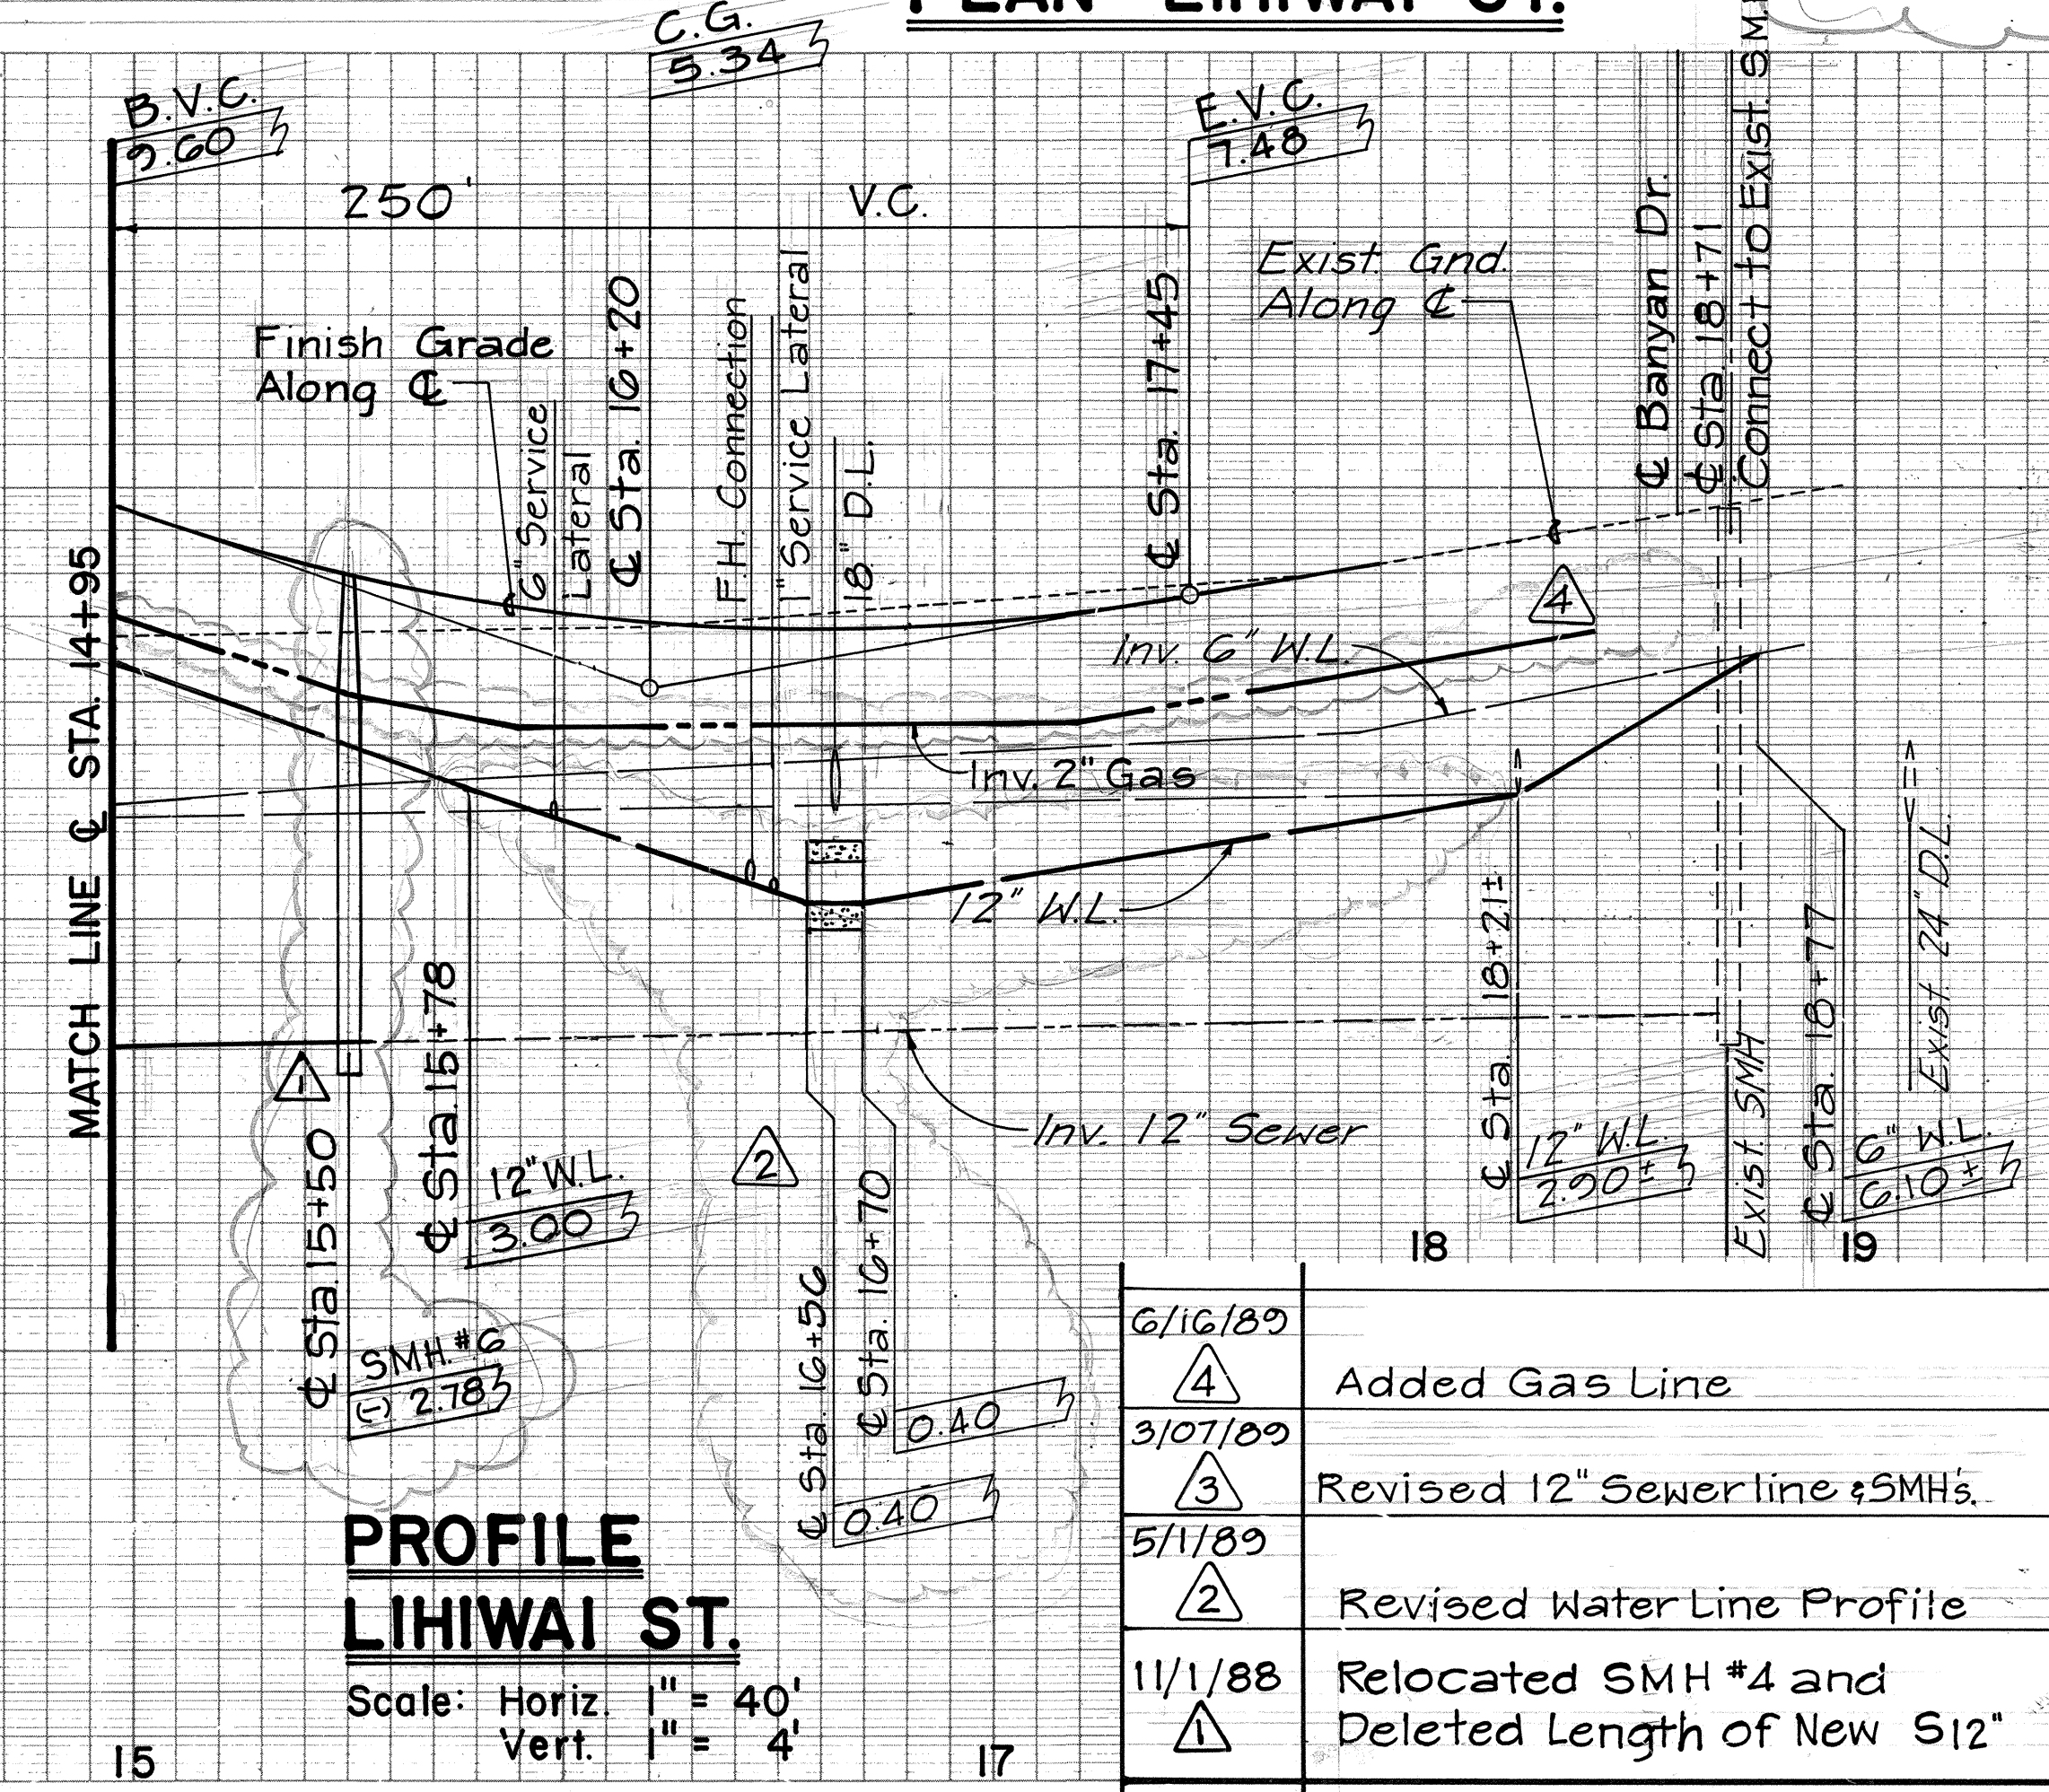

**PROFILE LIHIWAI ST.**  
Scale: Horiz. 1" = 40'  
Vert. 1" = 4'

| DATE    | REVISION                                        |
|---------|-------------------------------------------------|
| 6/16/89 | Added Gas Line                                  |
| 3/07/89 | Revised 12" Sewerline & SMH's.                  |
| 5/1/89  | Revised Water Line Profile                      |
| 11/1/88 | Relocated SMH #4 and Deleted Length of New S12" |








APPROVED  
CHIEF, WASTE WATER & SOLID WASTE DIVISION  
MANAGER, DEPARTMENT OF WATER SUPPLY  
GASCO INC.

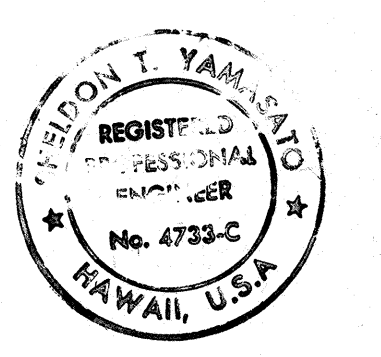









STATE OF HAWAII  
DEPARTMENT OF TRANSPORTATION  
HIGHWAYS DIVISION  
**UTILITY PLAN**  
**LIHIWAI ST.**  
HAWAII BELT ROAD/KAMEHAMEHA AVENUE  
Wailoa Bridge Replacement And Approaches  
FEDERAL AID PROJECT NO. BR-F-019-2(27)  
SCALE: AS NOTED DATE SEPT., 1986  
SHEET No. 36 OF 8 SHEETS

C.O.36

| FED. ROAD DIST. NO. | STATE | FED. AID PROJ. NO. | FISCAL YEAR | SHEET NO. | TOTAL SHEETS |
|---------------------|-------|--------------------|-------------|-----------|--------------|
| HAWAII              | HAW.  | BR-F-019-2(27)     | 1987        | 37        | 134          |

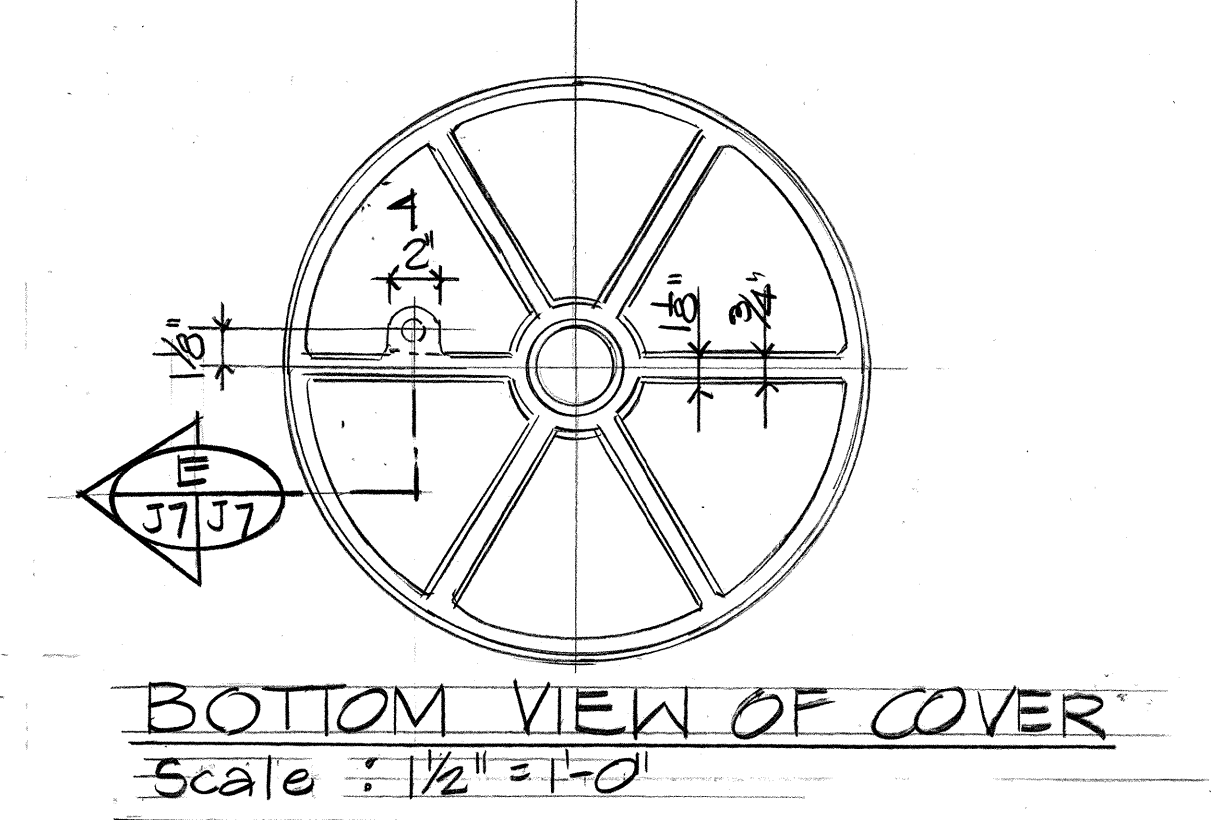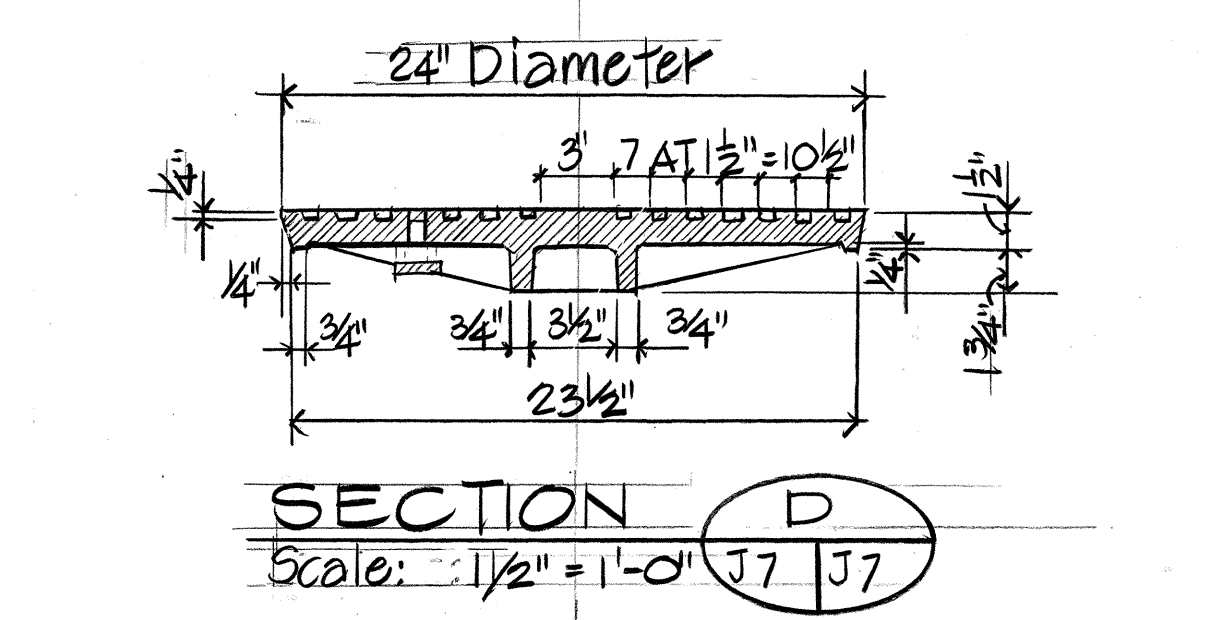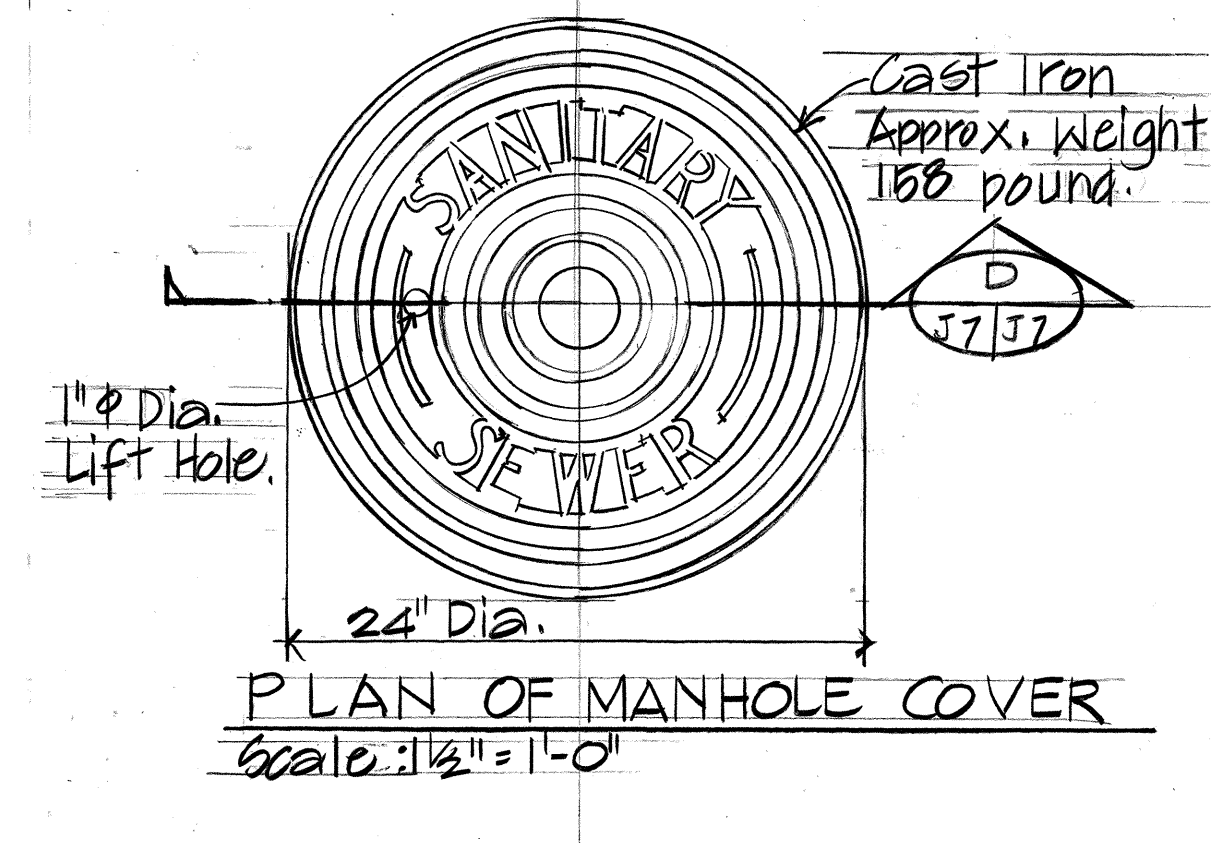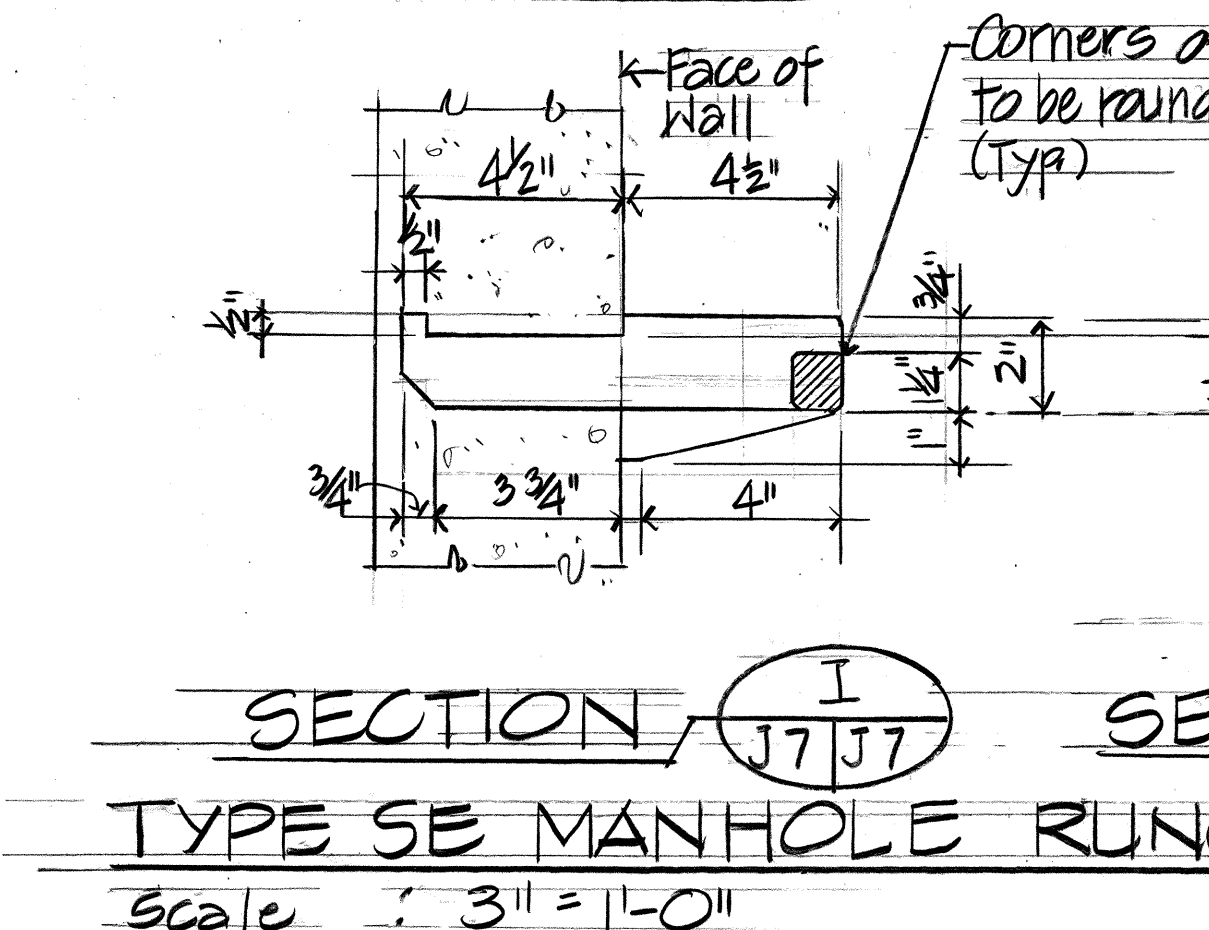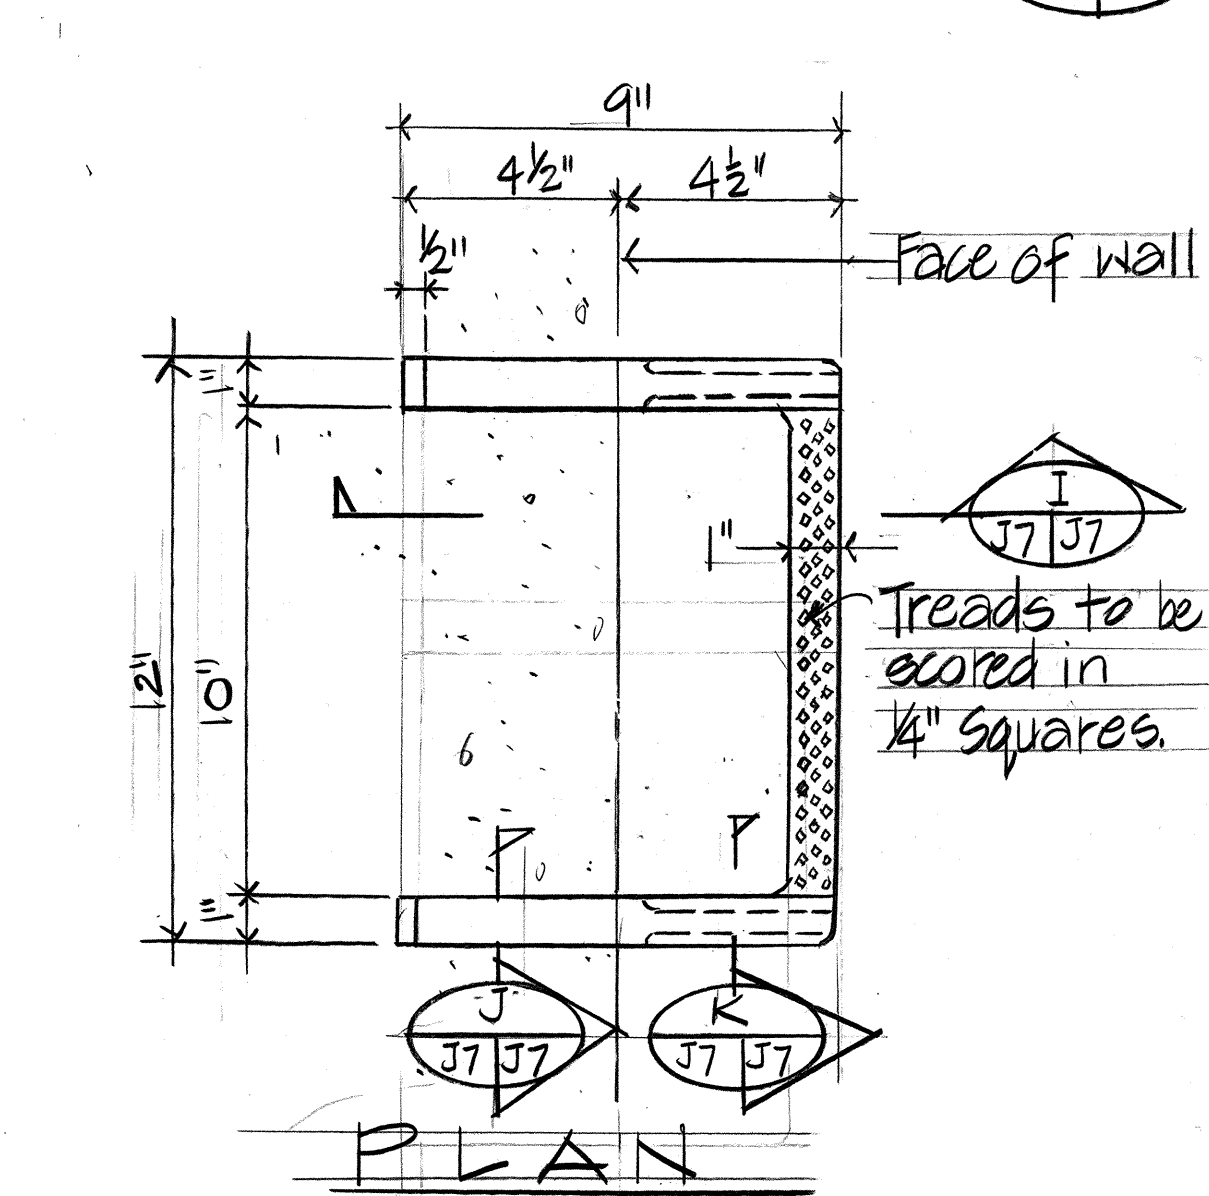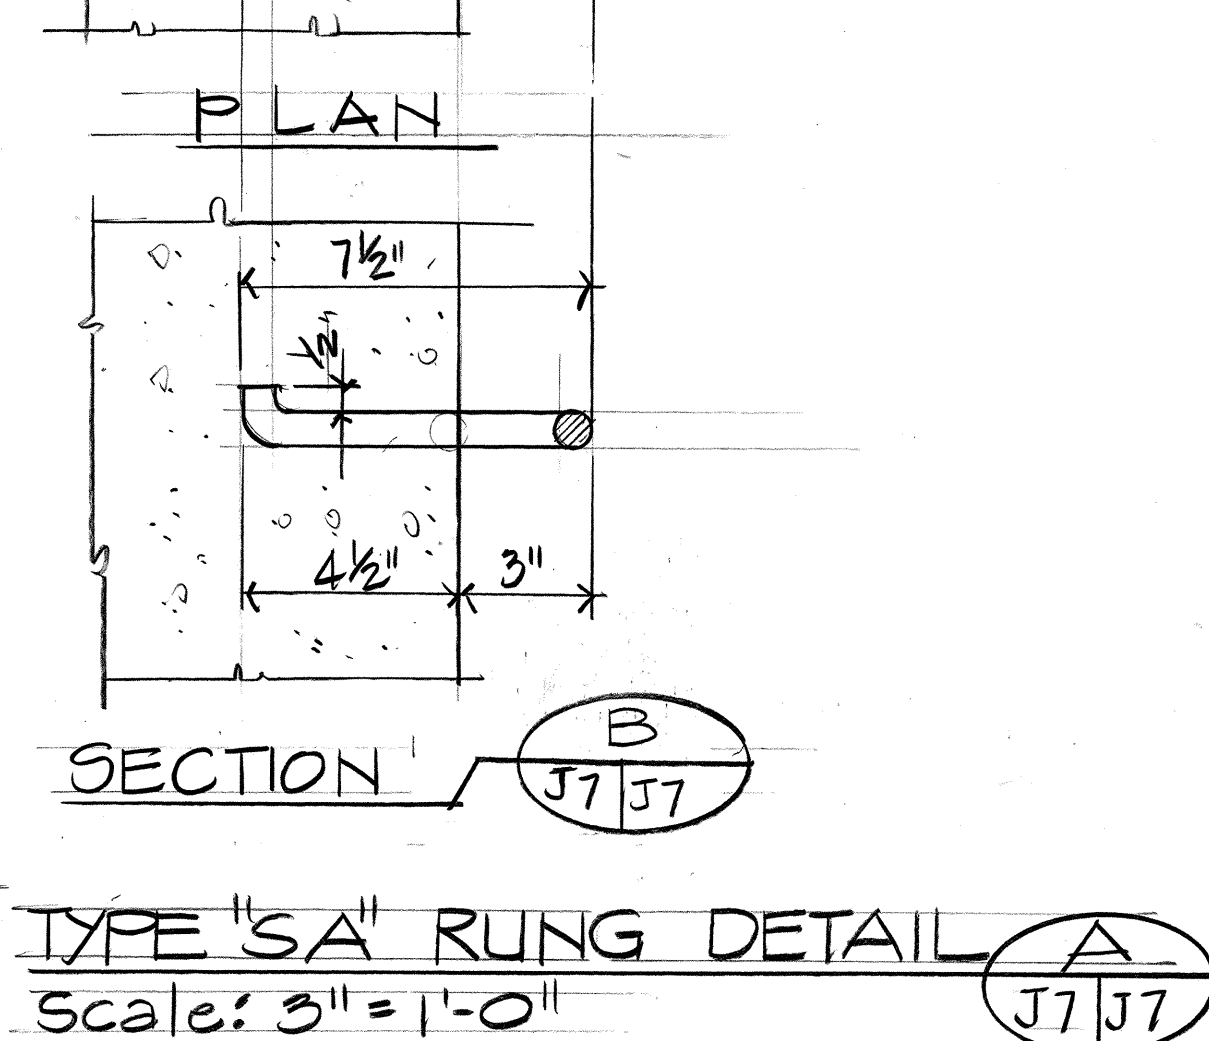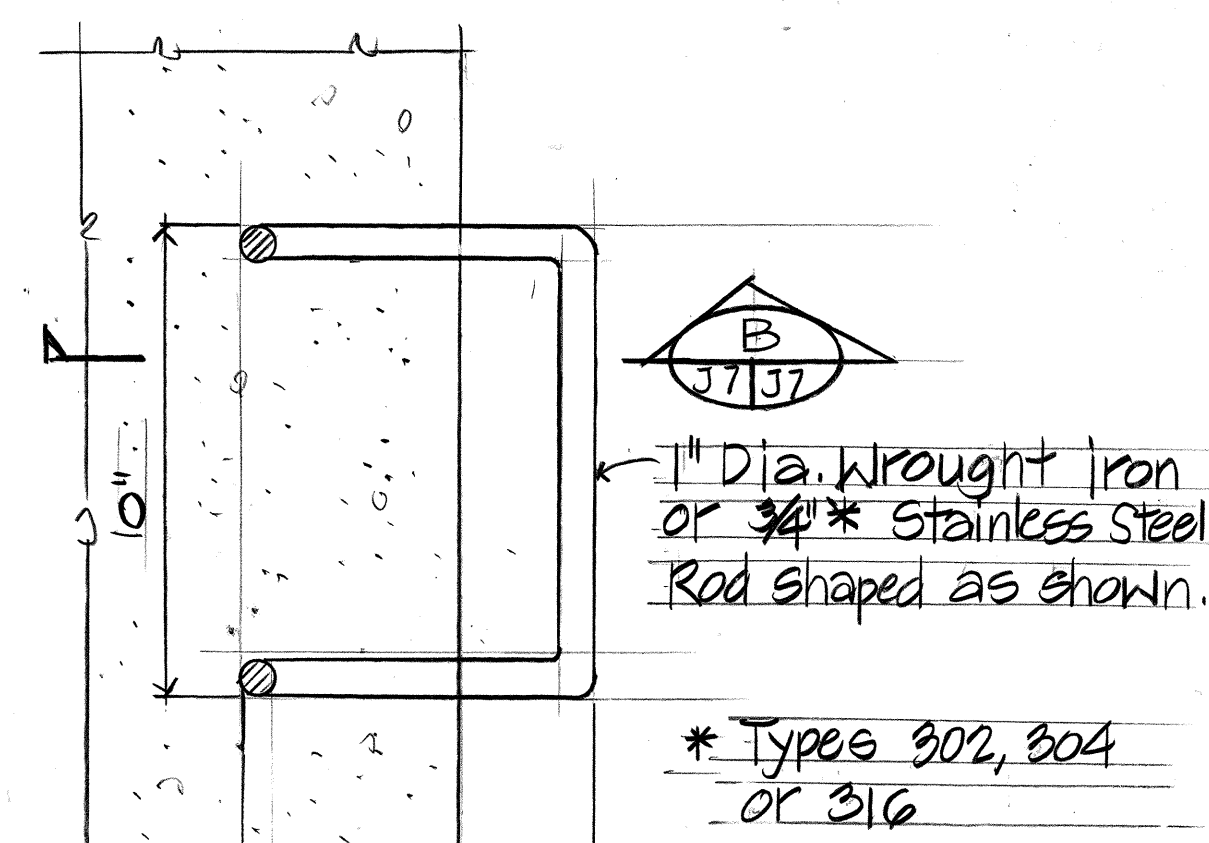

Notes:  
1. Cast Iron or Ductile Iron.

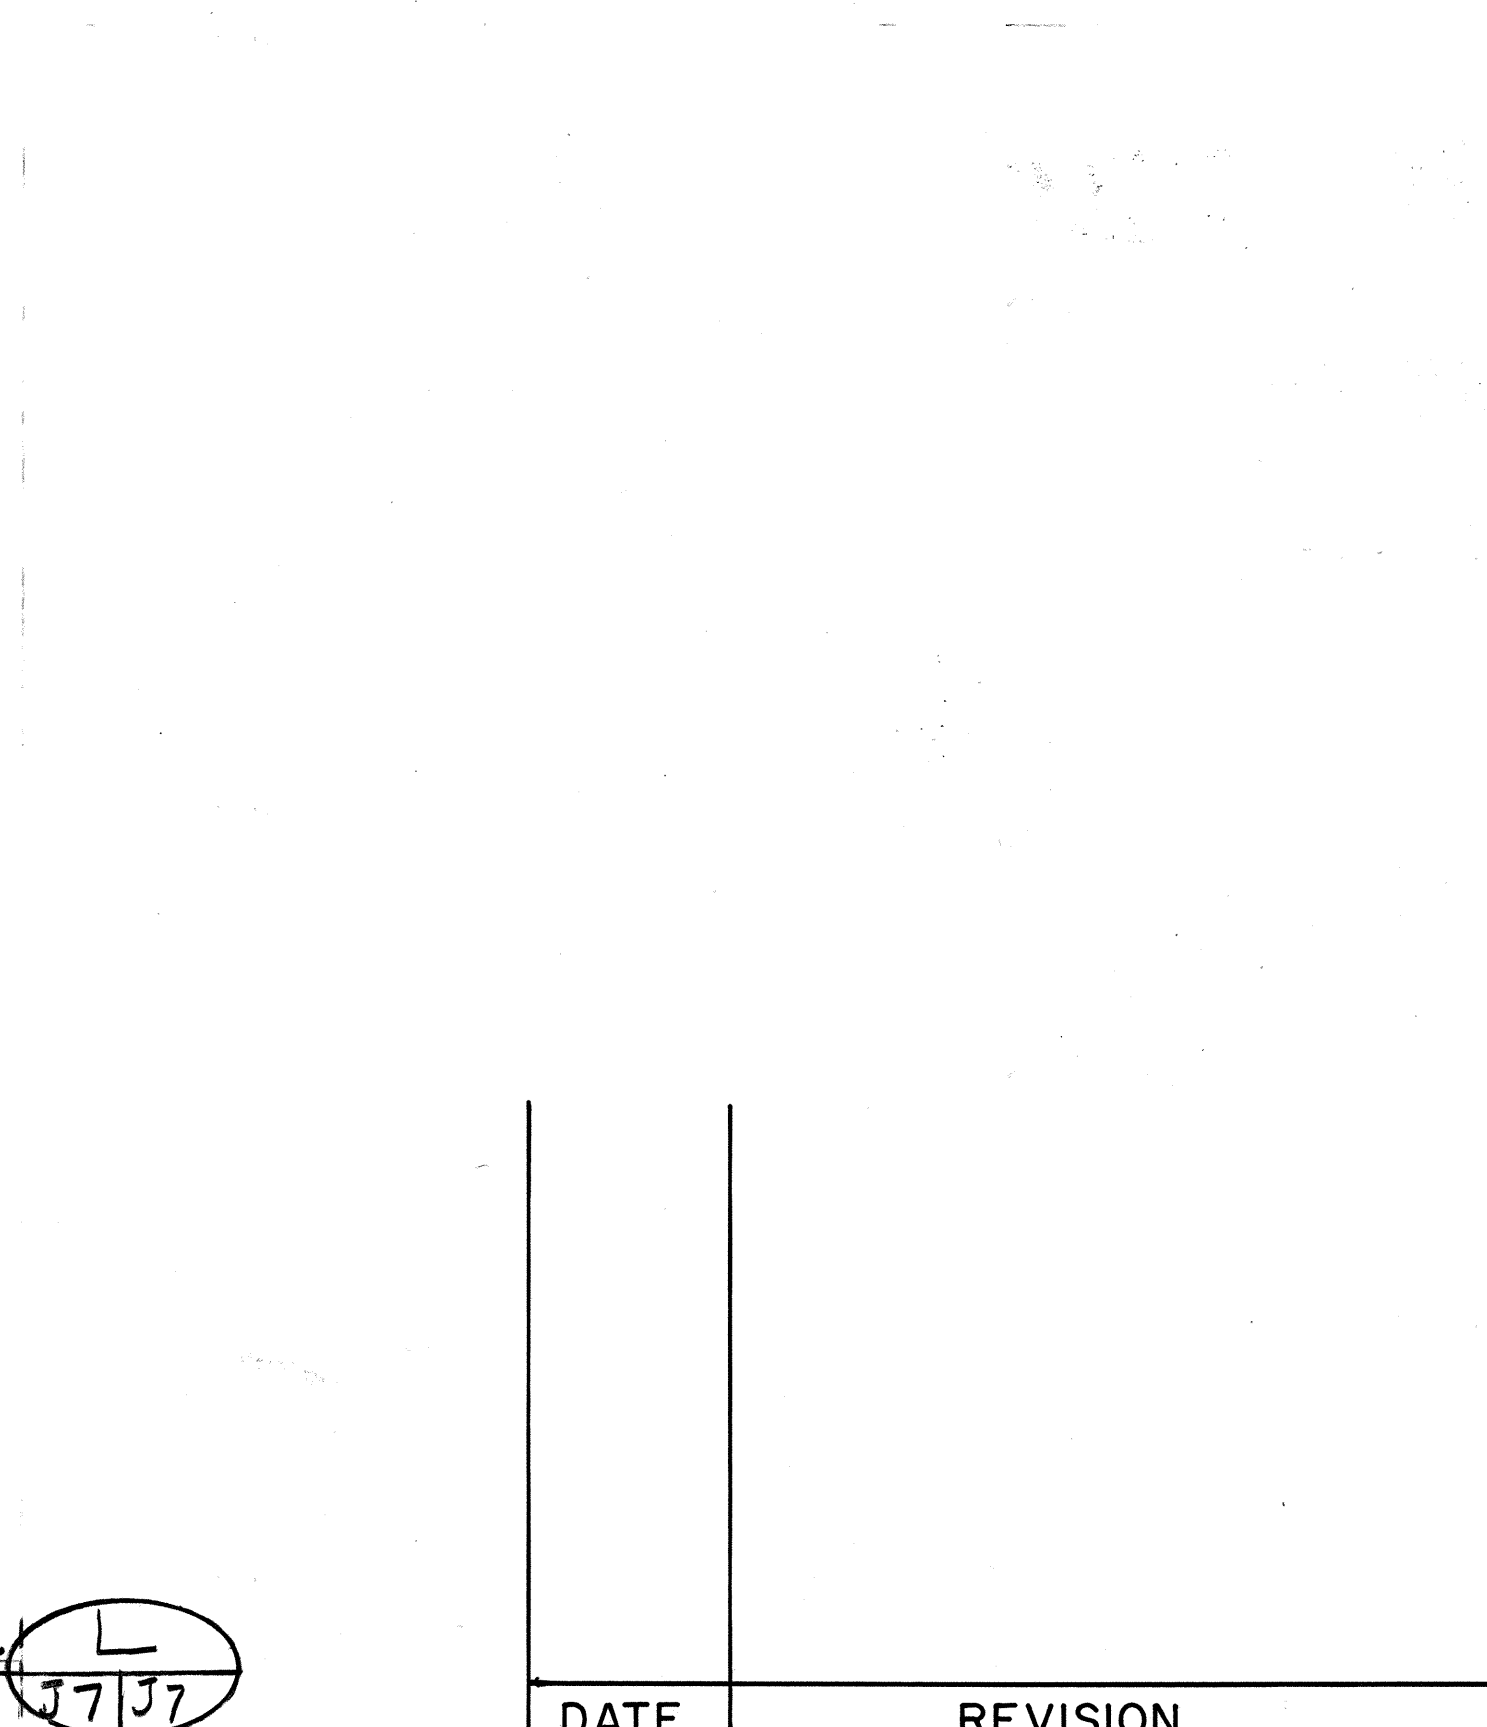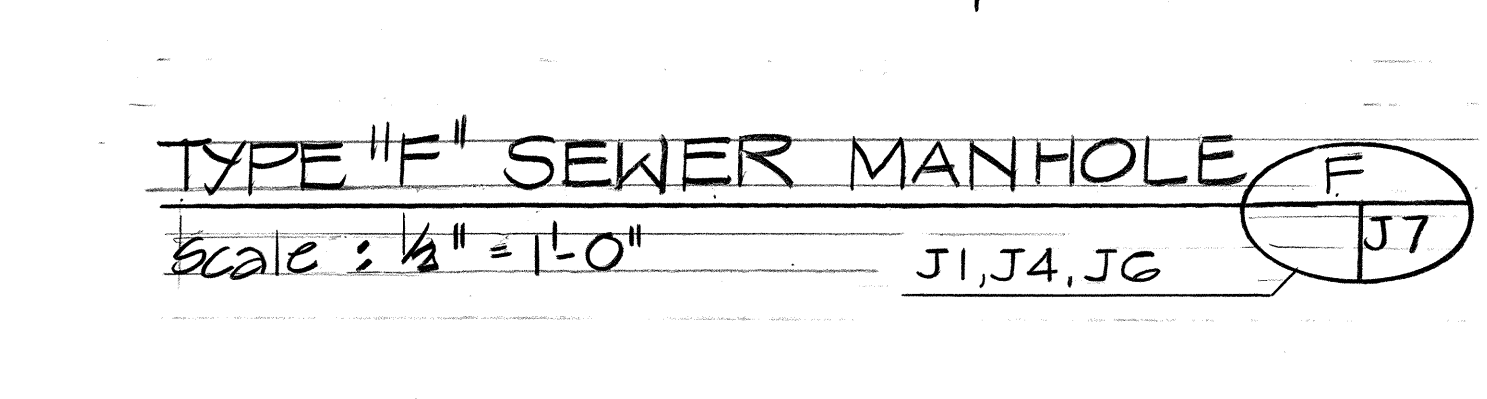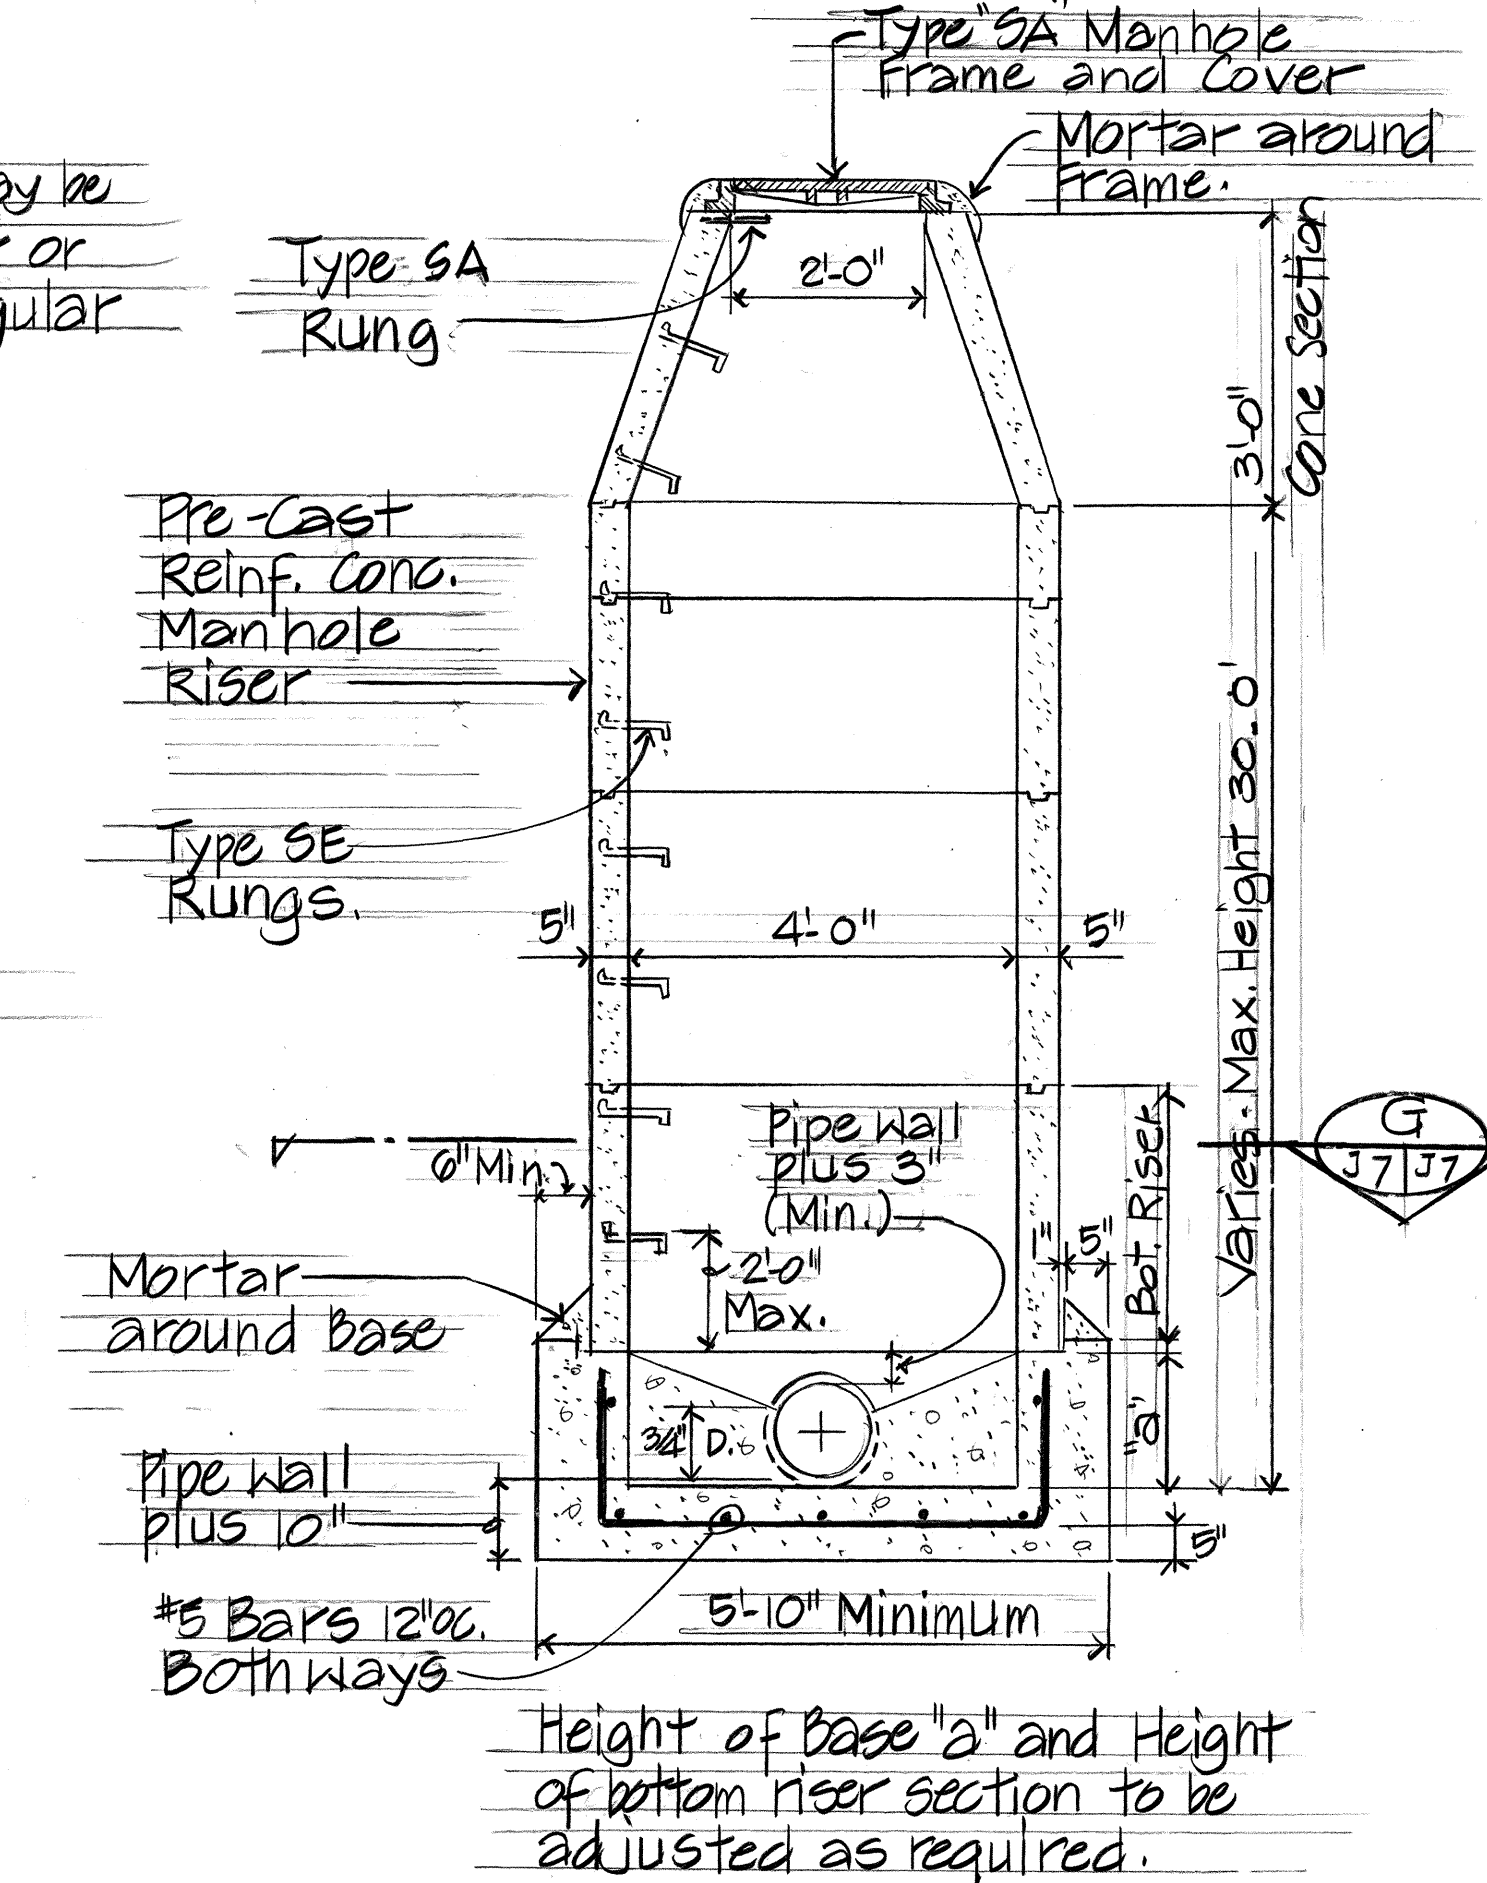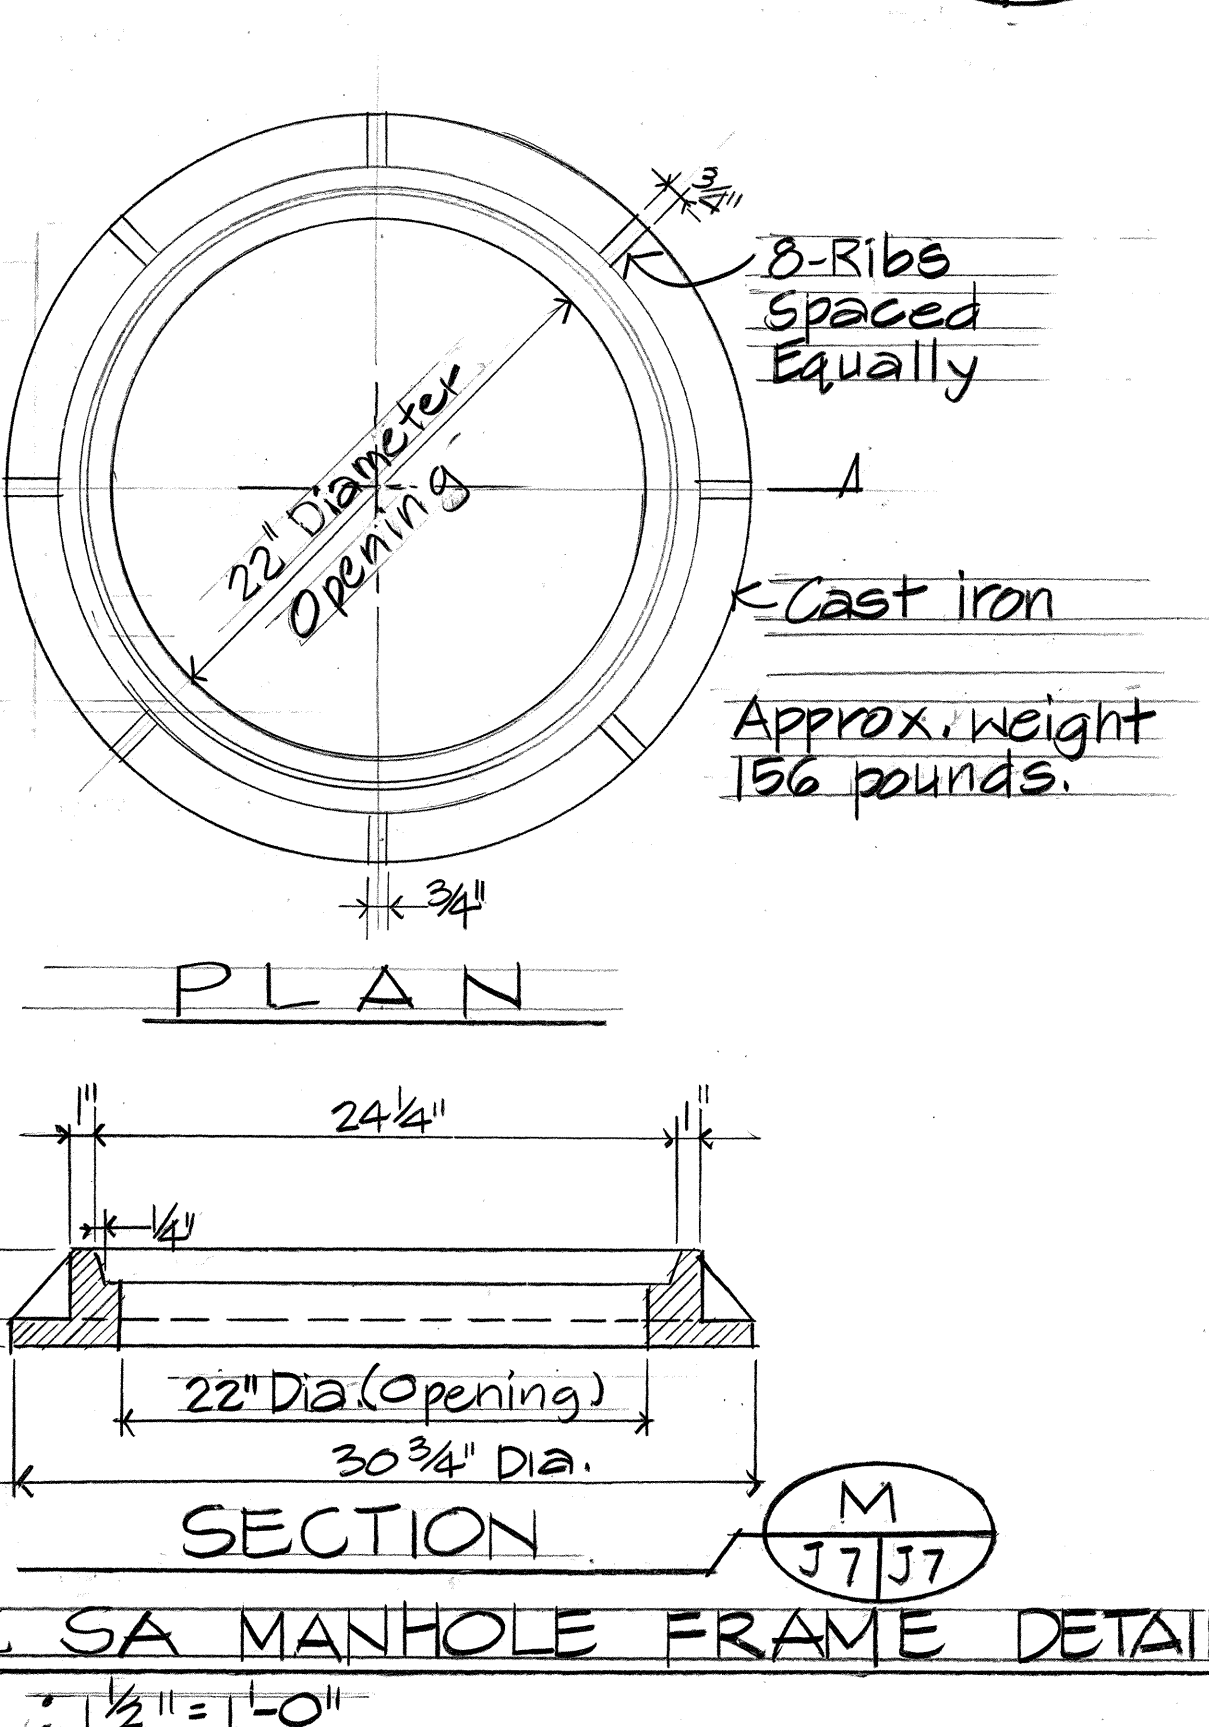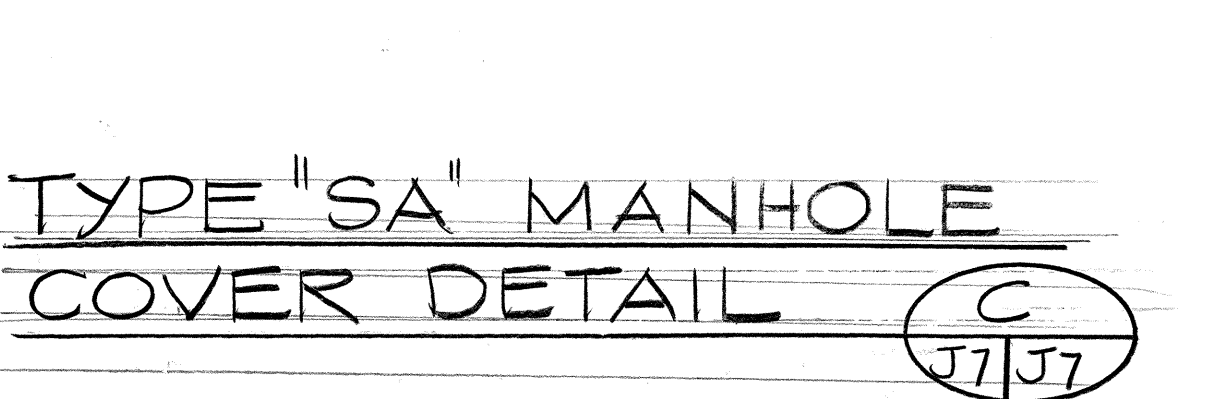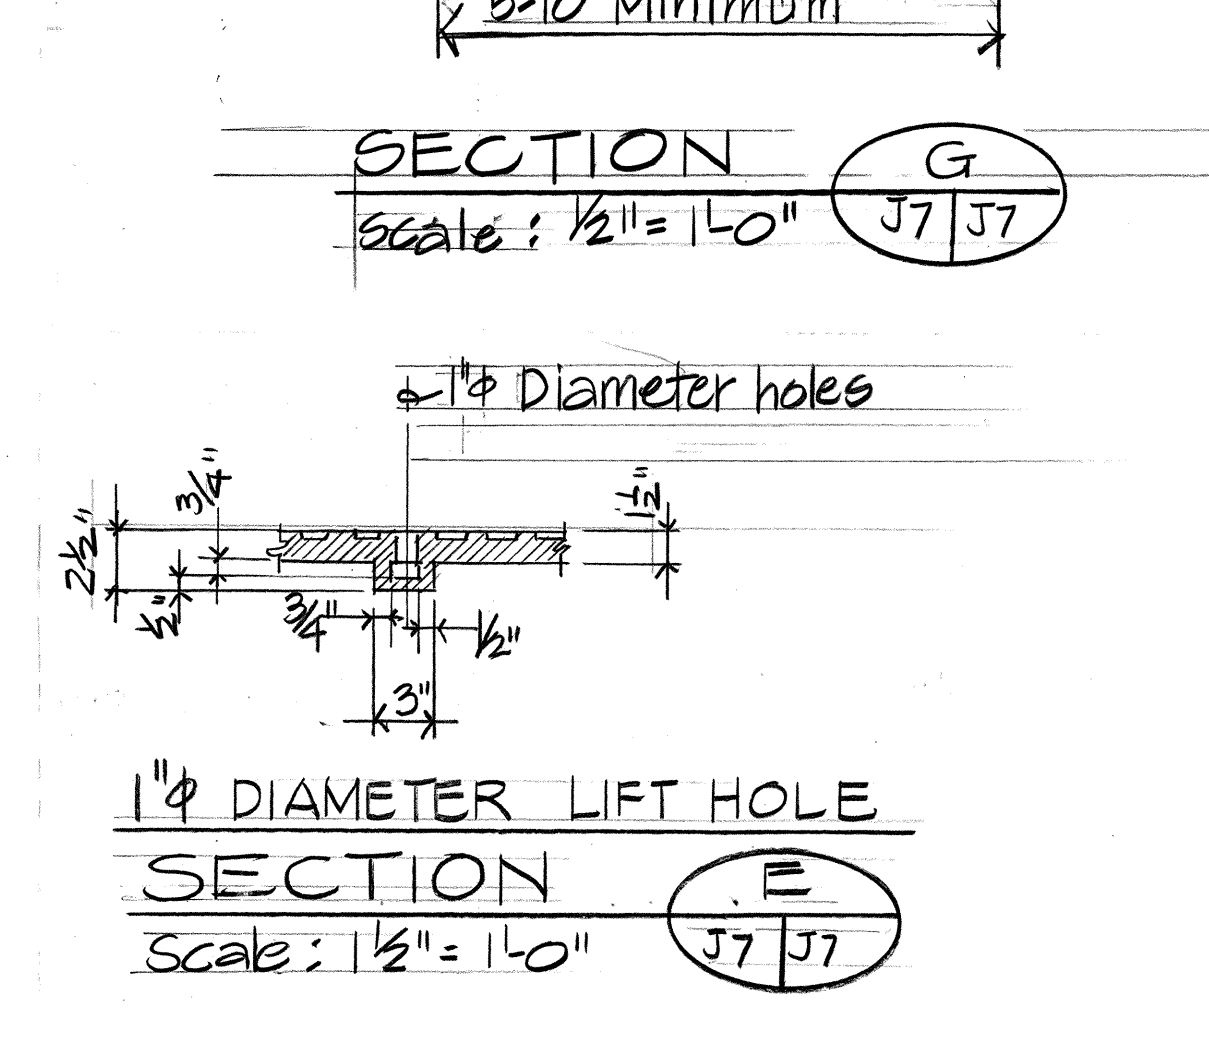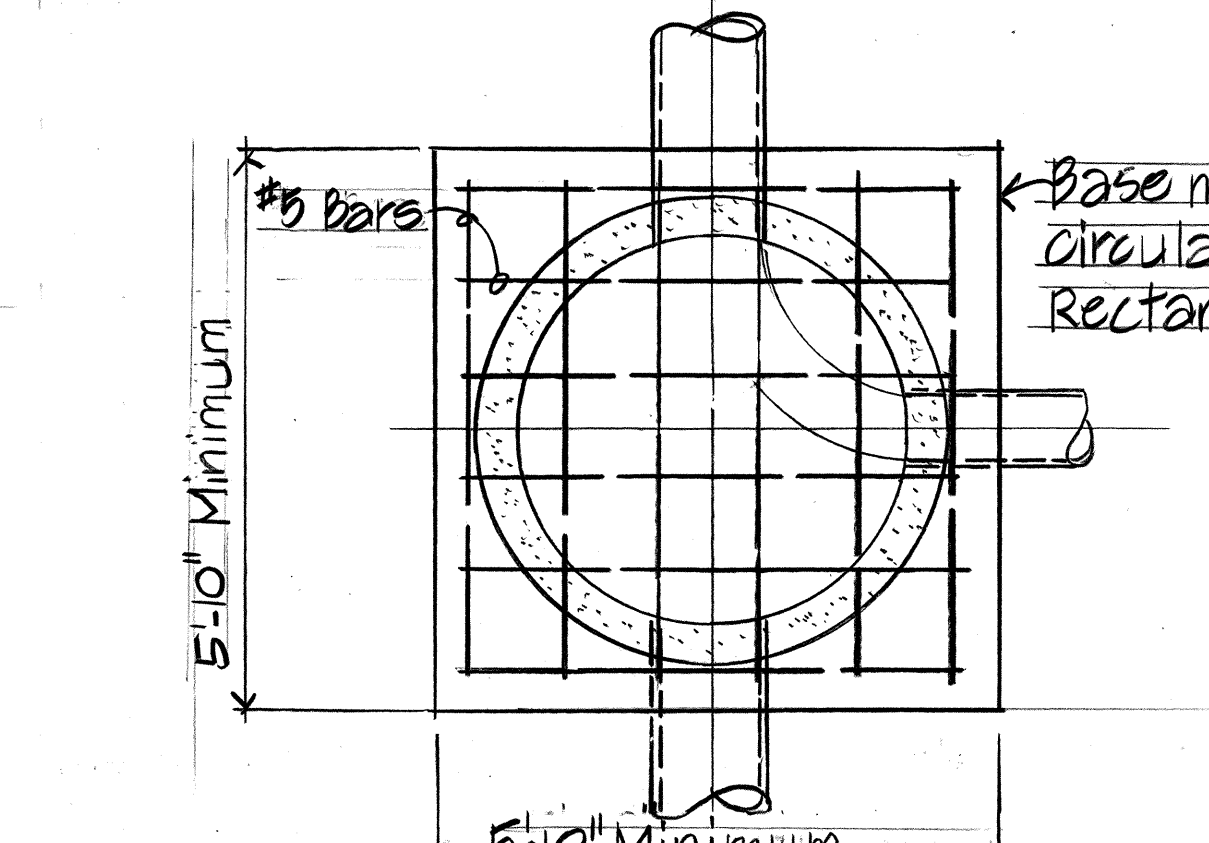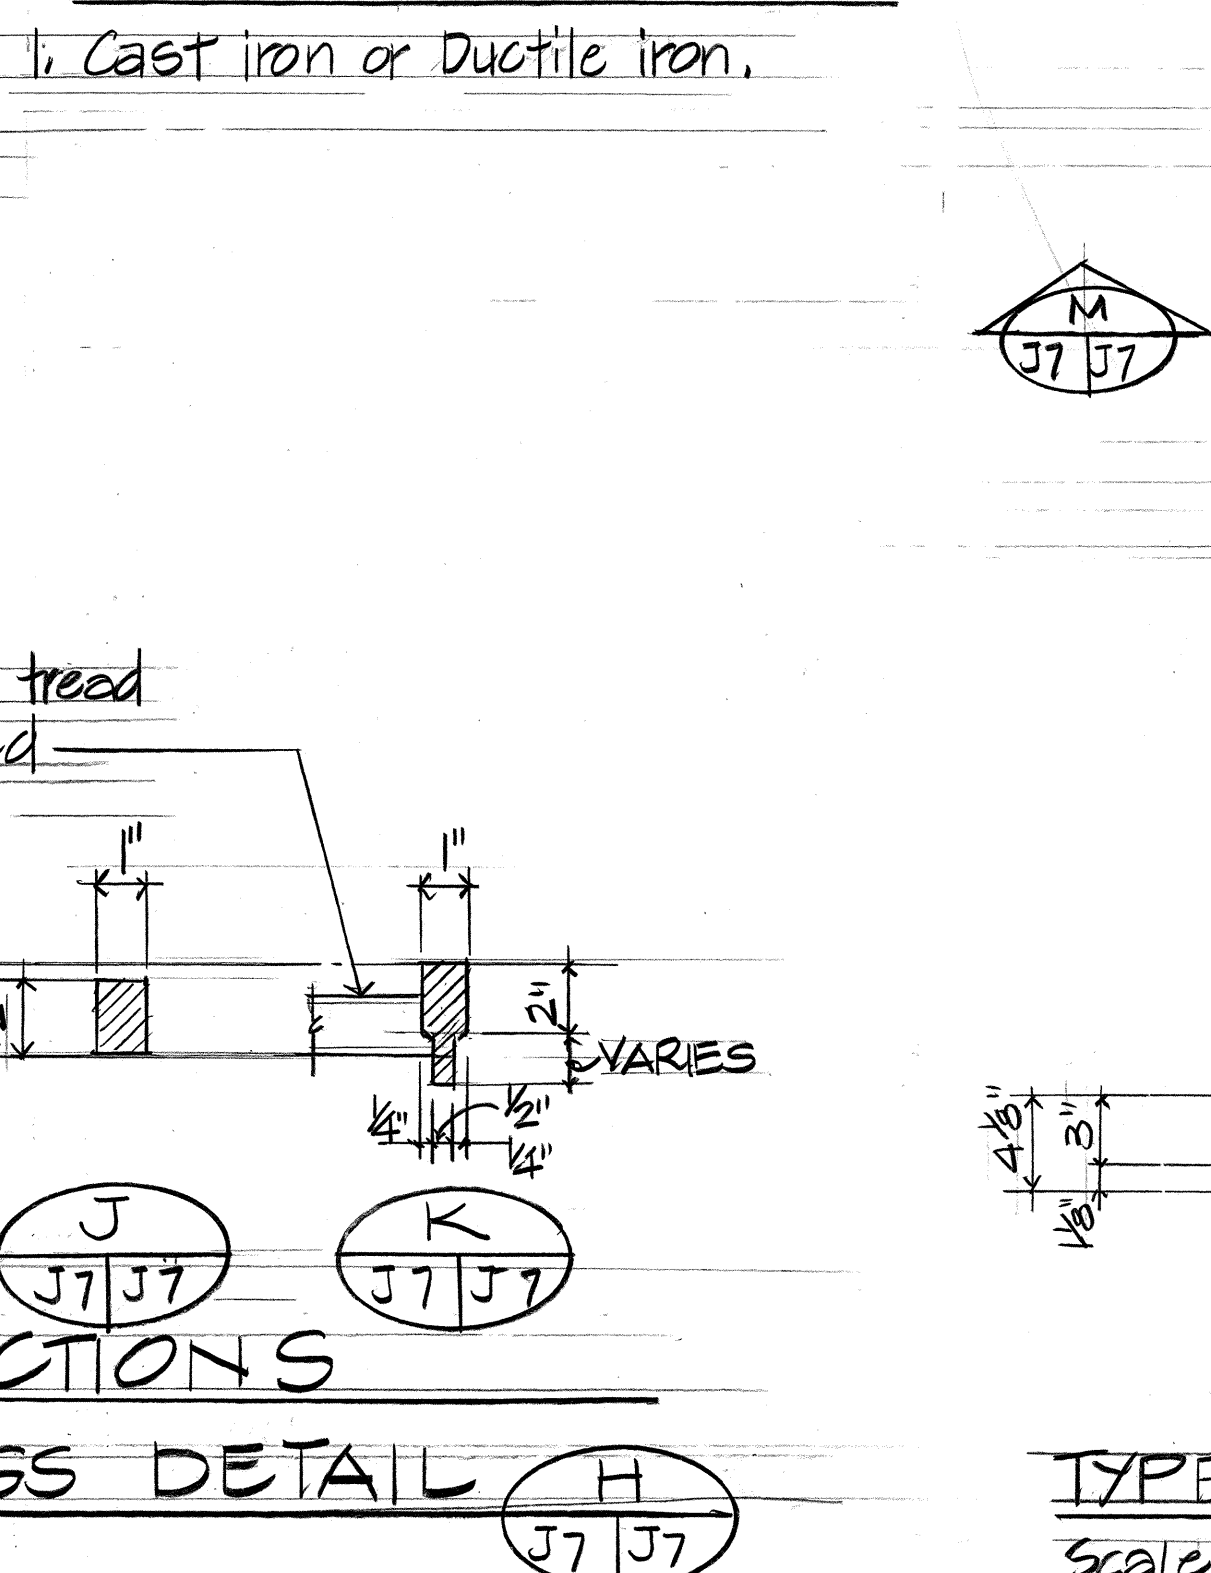

Shilton T. Yamada  
THIS WORK WAS PREPARED BY ME OR UNDER MY SUPERVISION


STATE OF HAWAII  
DEPARTMENT OF TRANSPORTATION  
HIGHWAYS DIVISION

SEWER DETAILS


HAWAII BELT ROAD/KAMEHAMEHA AVENUE  
Wailoa Bridge Replacement And Approaches  
FEDERAL AID PROJECT NO. BR-F-019-2(27)  
SCALE: AS NOTED DATE: SEPT. 1986  
SHEET NO. 37 OF 8 SHEETS

|               |      |
|---------------|------|
| ORIGINAL PLAN | DATE |
| DRAWN BY      |      |
| TRACED BY     |      |
| DESIGNED BY   |      |
| CHECKED BY    |      |
| NO.           |      |


| FED. ROAD DIST. NO. | STATE | FED. AID PROJ. NO. | FISCAL YEAR | SHEET NO. | TOTAL SHEETS |
|---------------------|-------|--------------------|-------------|-----------|--------------|
| HAWAII              | HAW.  | BR-F-019-2(27)     | 1987        | 38        | 134          |

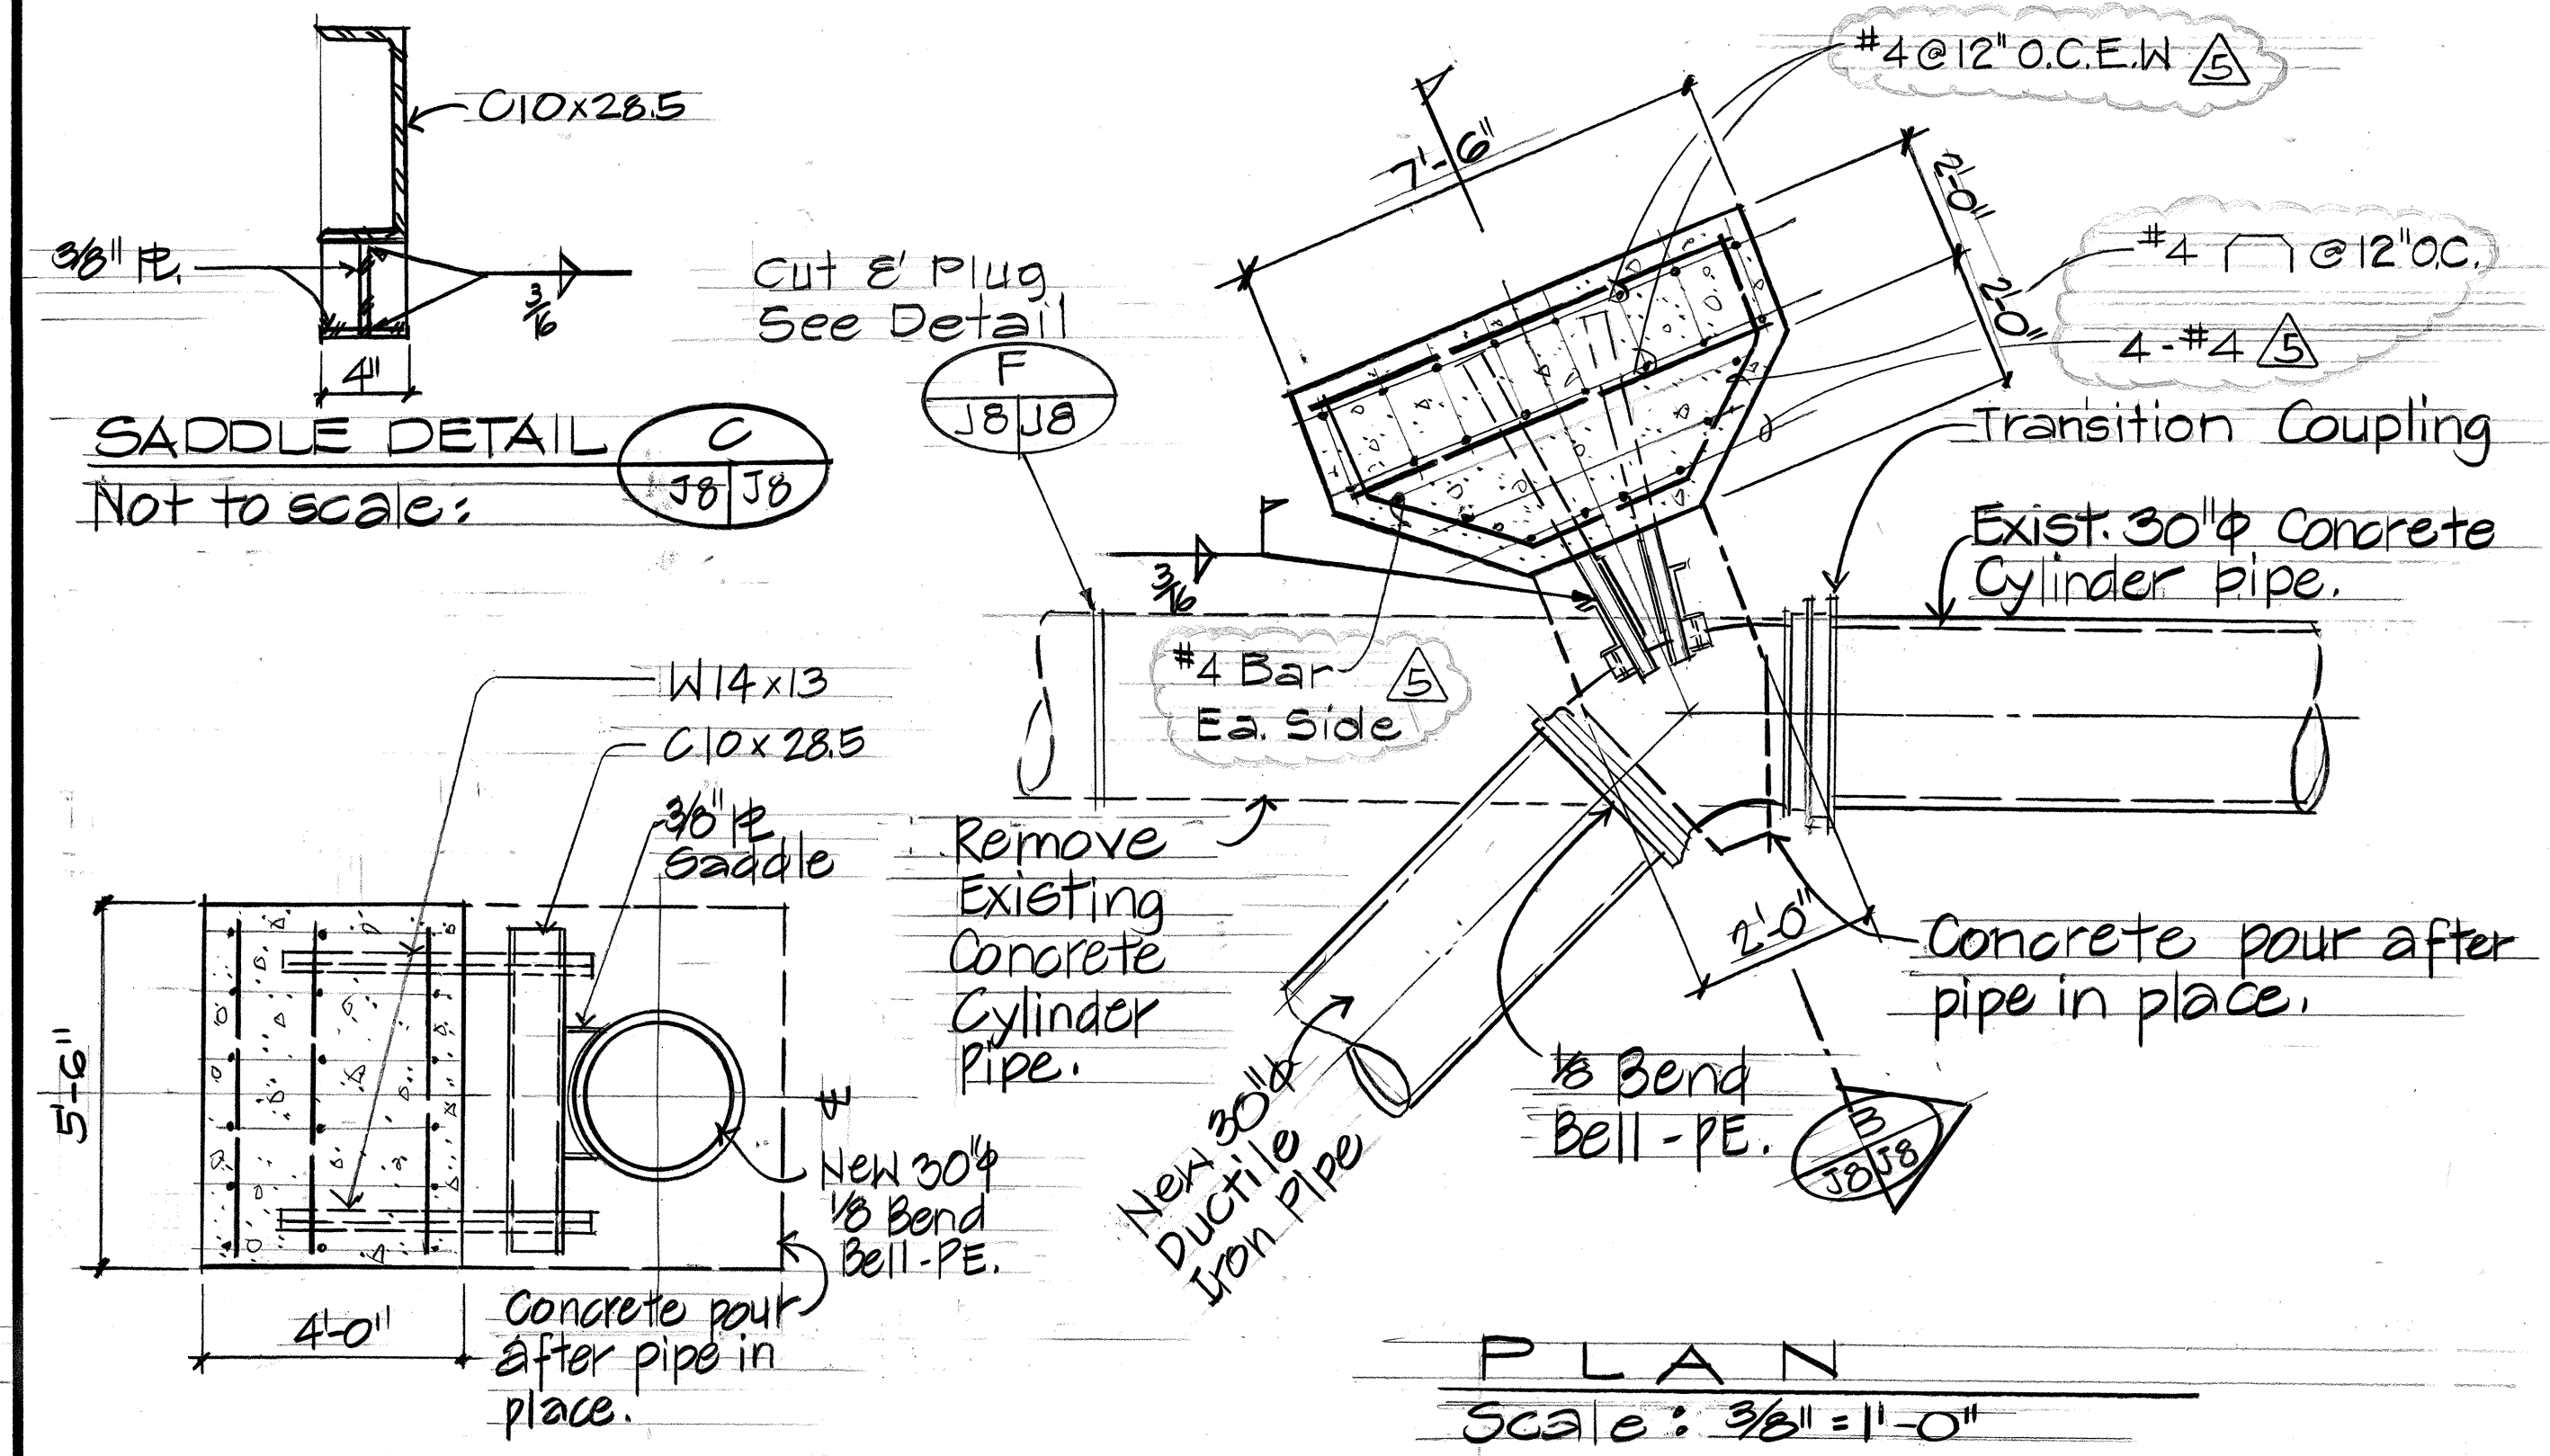


SECTION **B**  
Scale: 3/8" = 1'-0" J8/J8  
REACTION BLOCK AT 1/8 BEND  
BELL DETAIL  
J4 J3 J8

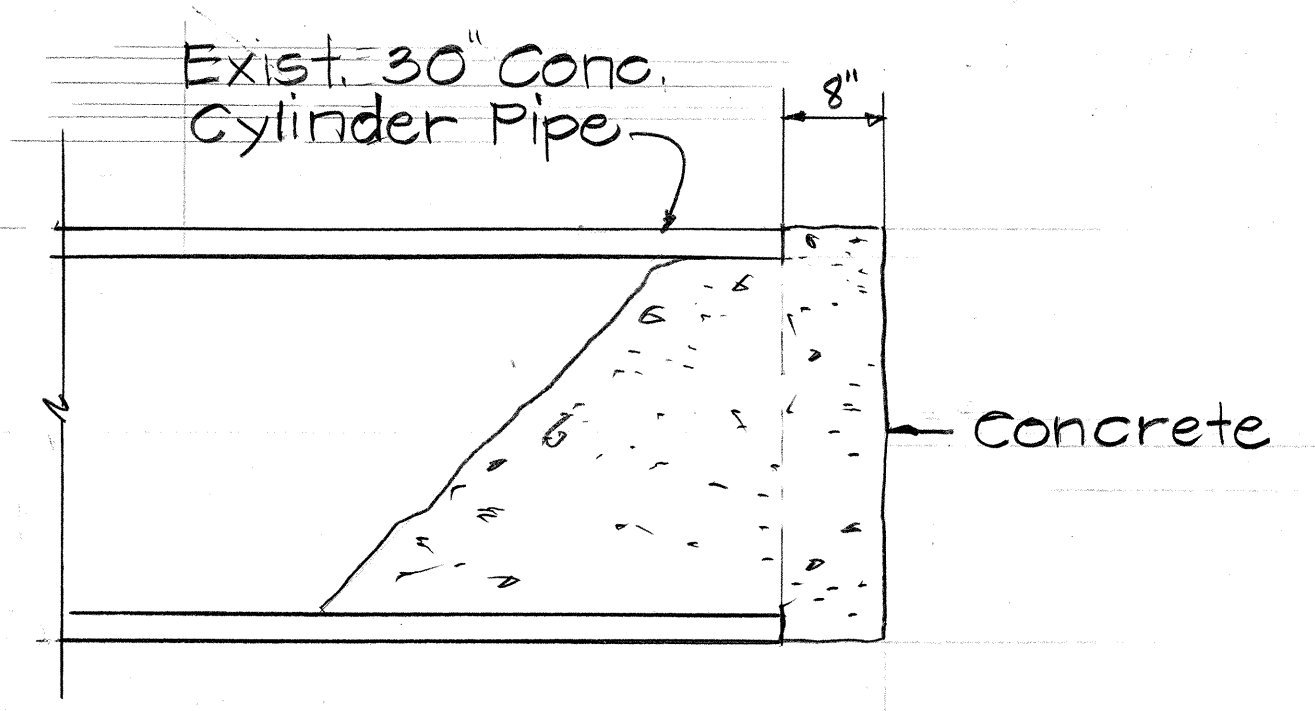

PLUG DETAIL **F**  
N.T.S. J8/J8

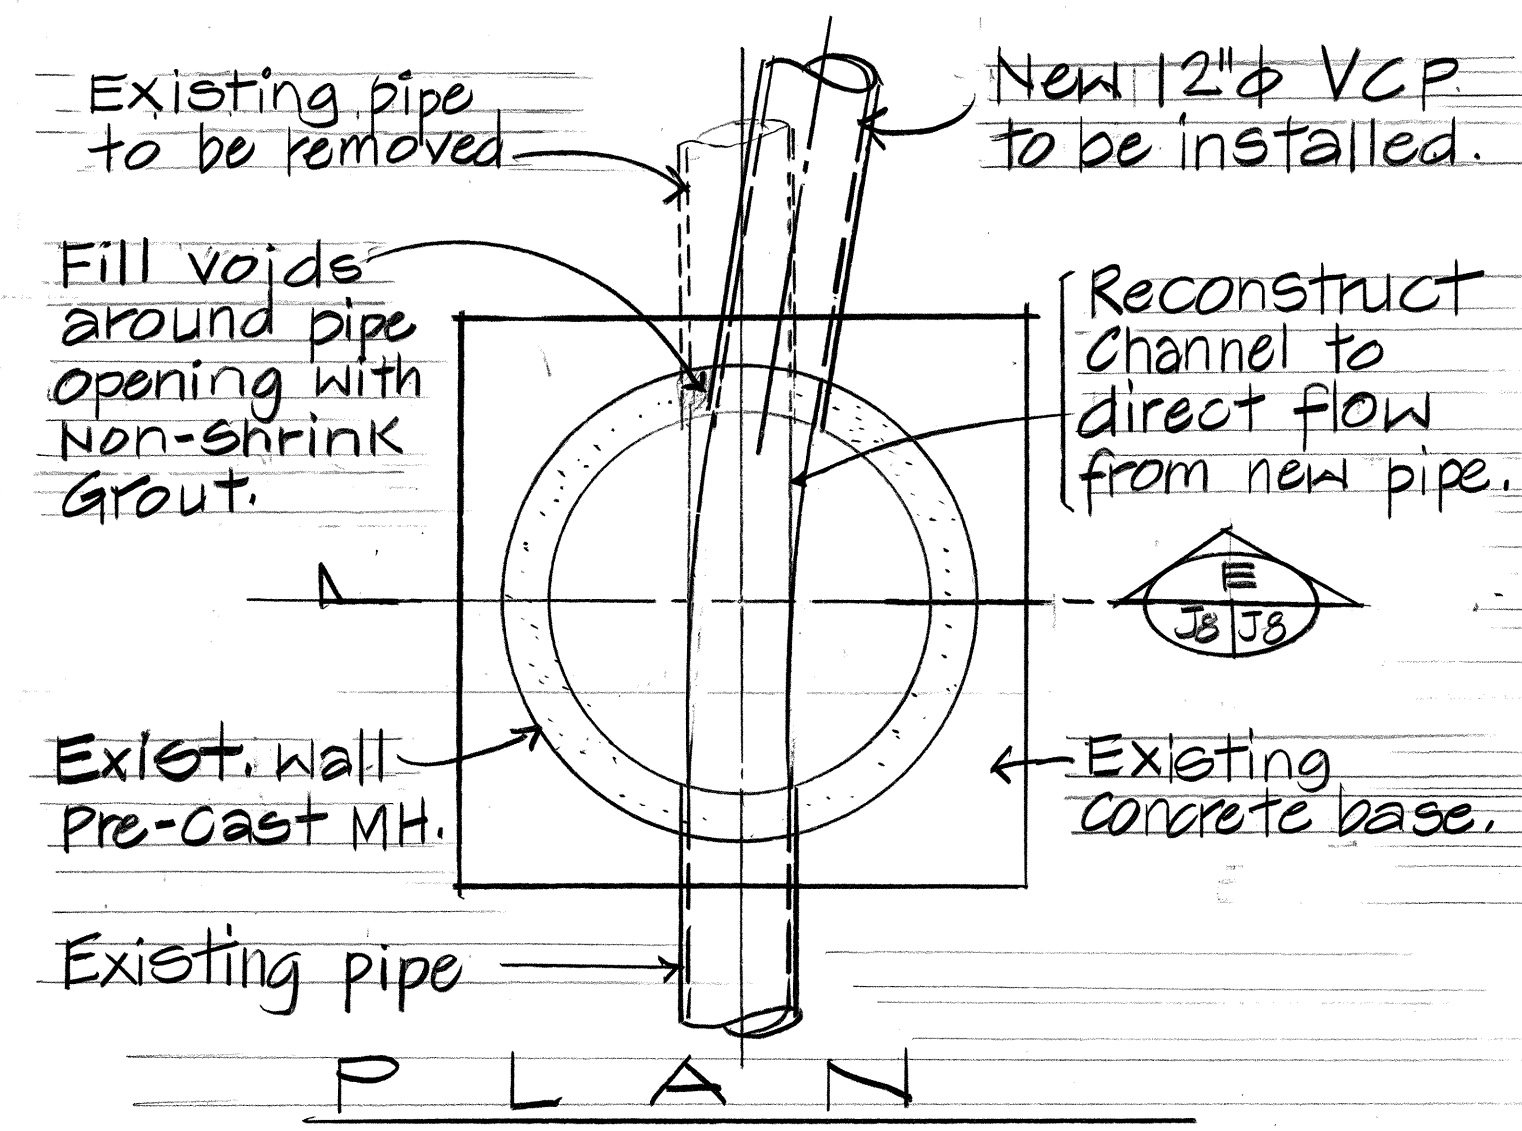


NEW 12" V.C.P. AT EXISTING M.H. DETAIL **D**  
Not to scale. J1, J4 J6 J8

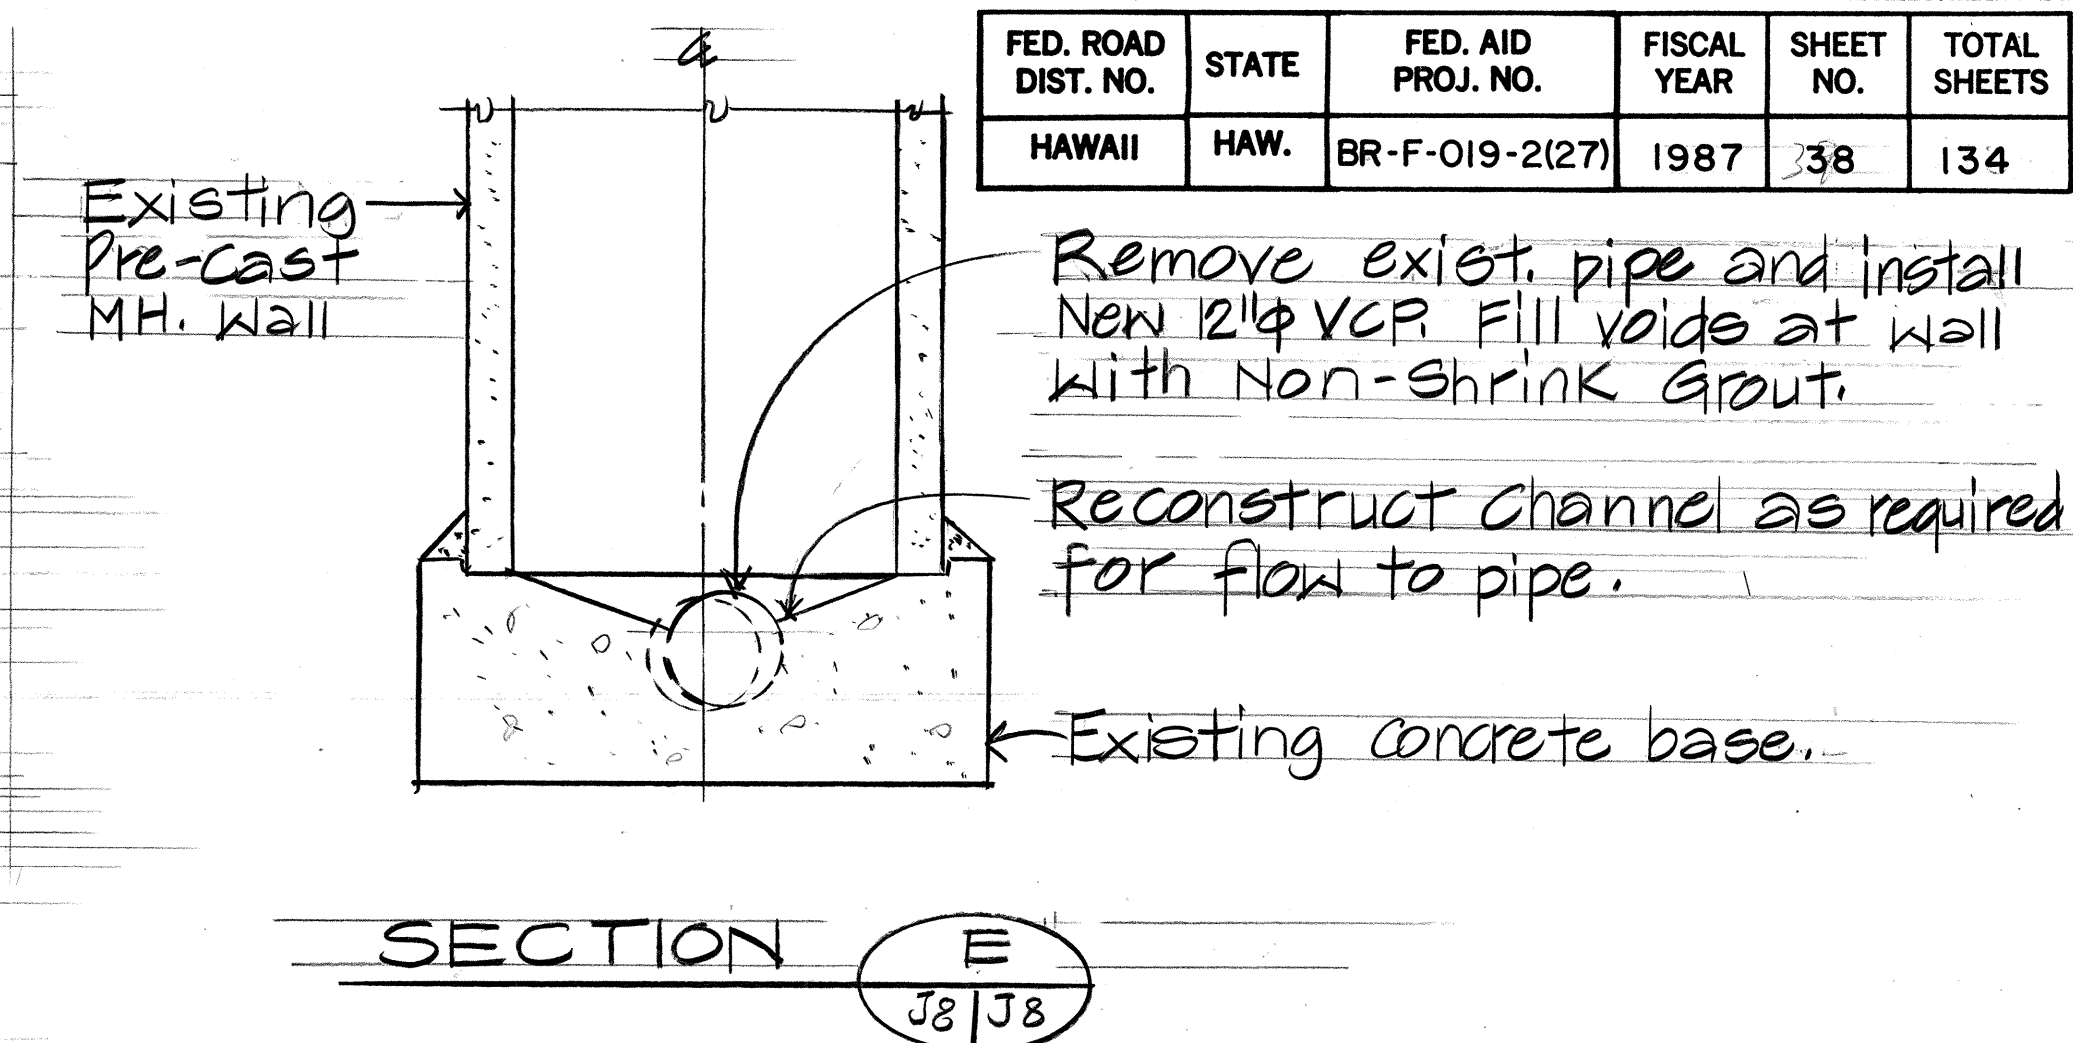

SECTION **E**  
J8/J8

|               |      |
|---------------|------|
| ORIGINAL PLAN | DATE |
| DRAWN BY      |      |
| DESIGNED BY   |      |
| CHECKED BY    |      |
| NOTED BY      |      |
| NO.           |      |

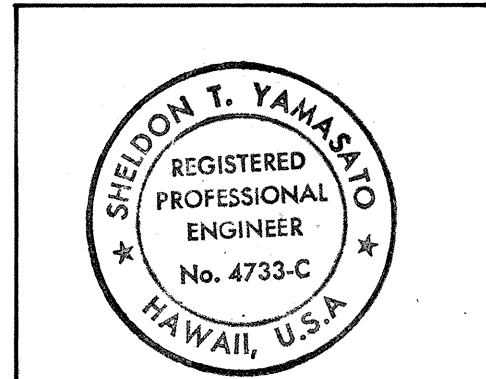

THIS WORK WAS PREPARED BY ME OR UNDER MY SUPERVISION

STATE OF HAWAII  
DEPARTMENT OF TRANSPORTATION  
HIGHWAYS DIVISION

**SEWER DETAILS**

HAWAII BELT ROAD/KAMEHAMEHA AVENUE  
Wailoa Bridge Replacement And Approaches

FEDERAL AID PROJECT NO. BR-F-019-2(27)  
SCALE: AS NOTED DATE: SEPT, 1986

SHEET NO. J8 OF 8 SHEETS

|        |                      |
|--------|----------------------|
| 9/1/89 | Revised Reinf. Bars. |
| DATE   | REVISION             |