

FED. ROAD DIST. NO.	STATE	FED. AID PROJ. NO.	FISCAL YEAR	SHEET NO.	TOTAL SHEETS
HAWAII	HAW.	BR-019-2(38)	2002	C.O. ADD. 13	73

**LEGEND FOR
AS-BUILT POSTINGS**

	Squiggly line for as-built deletion
	Double line for as-built deletion
Roadway	Text for as-built posting

Scale: 1" = 20'
True North

LEGEND

	Limits of A.C. Pavement Overlay
	Limits of New A.C. Pavment
	Demolition of Existing Structure(s)

NOTE:



1. Approximately 1-1/2" thick a. c. pavement to be removed from exist. bridge deck. Approximately 3" conc. pavement to be placed over exist. and new bridge deck (see Structural Plans). Contractor shall verify new finish grade at bridge.

02/17/04	Revised Finish Grades
02/05/03	Revised Guardrail and End Treatment
07/09/02	Revised Shoulder
DATE	REVISION




THIS WORK WAS PREPARED BY
ME OR UNDER MY SUPERVISION.
Peter L. Mow
ENGINEERS SURVEYORS HAWAII, INC.
06.08.07

STATE OF HAWAII
DEPARTMENT OF TRANSPORTATION
HIGHWAYS DIVISION
GRADING PLAN
HAWAII BELT ROAD
Kupapaulua Bridge Widening
Hamakua District
Federal-Aid Project No. BR-019-2(38)
Scale: As Noted Date: Feb. 2004
SHEET No. C-11 OF 41 SHEETS

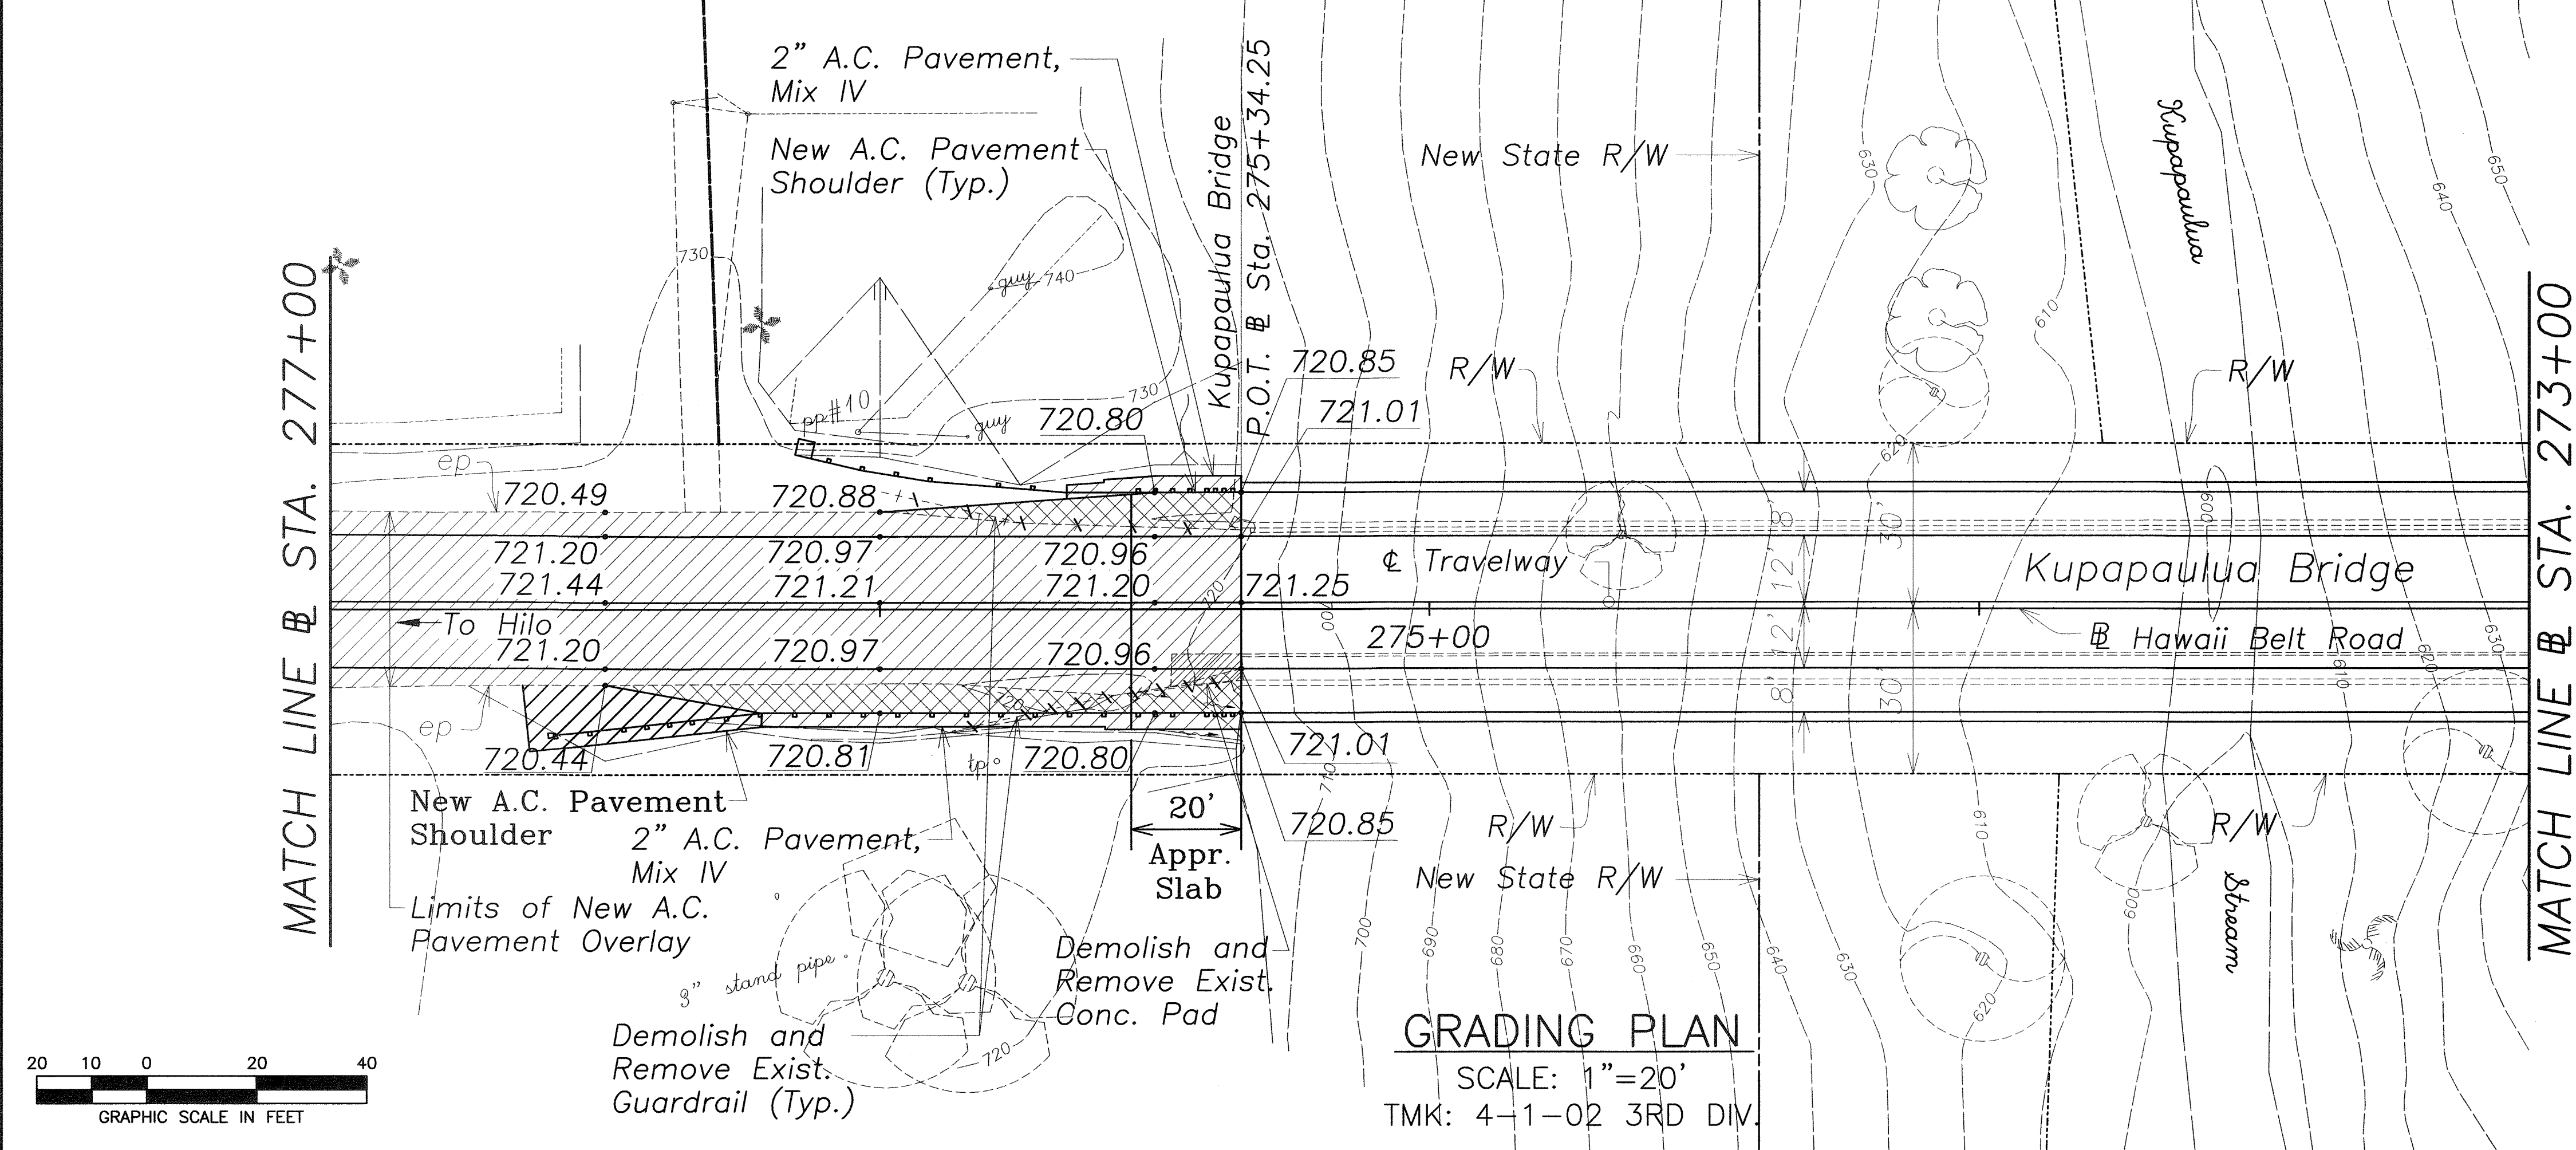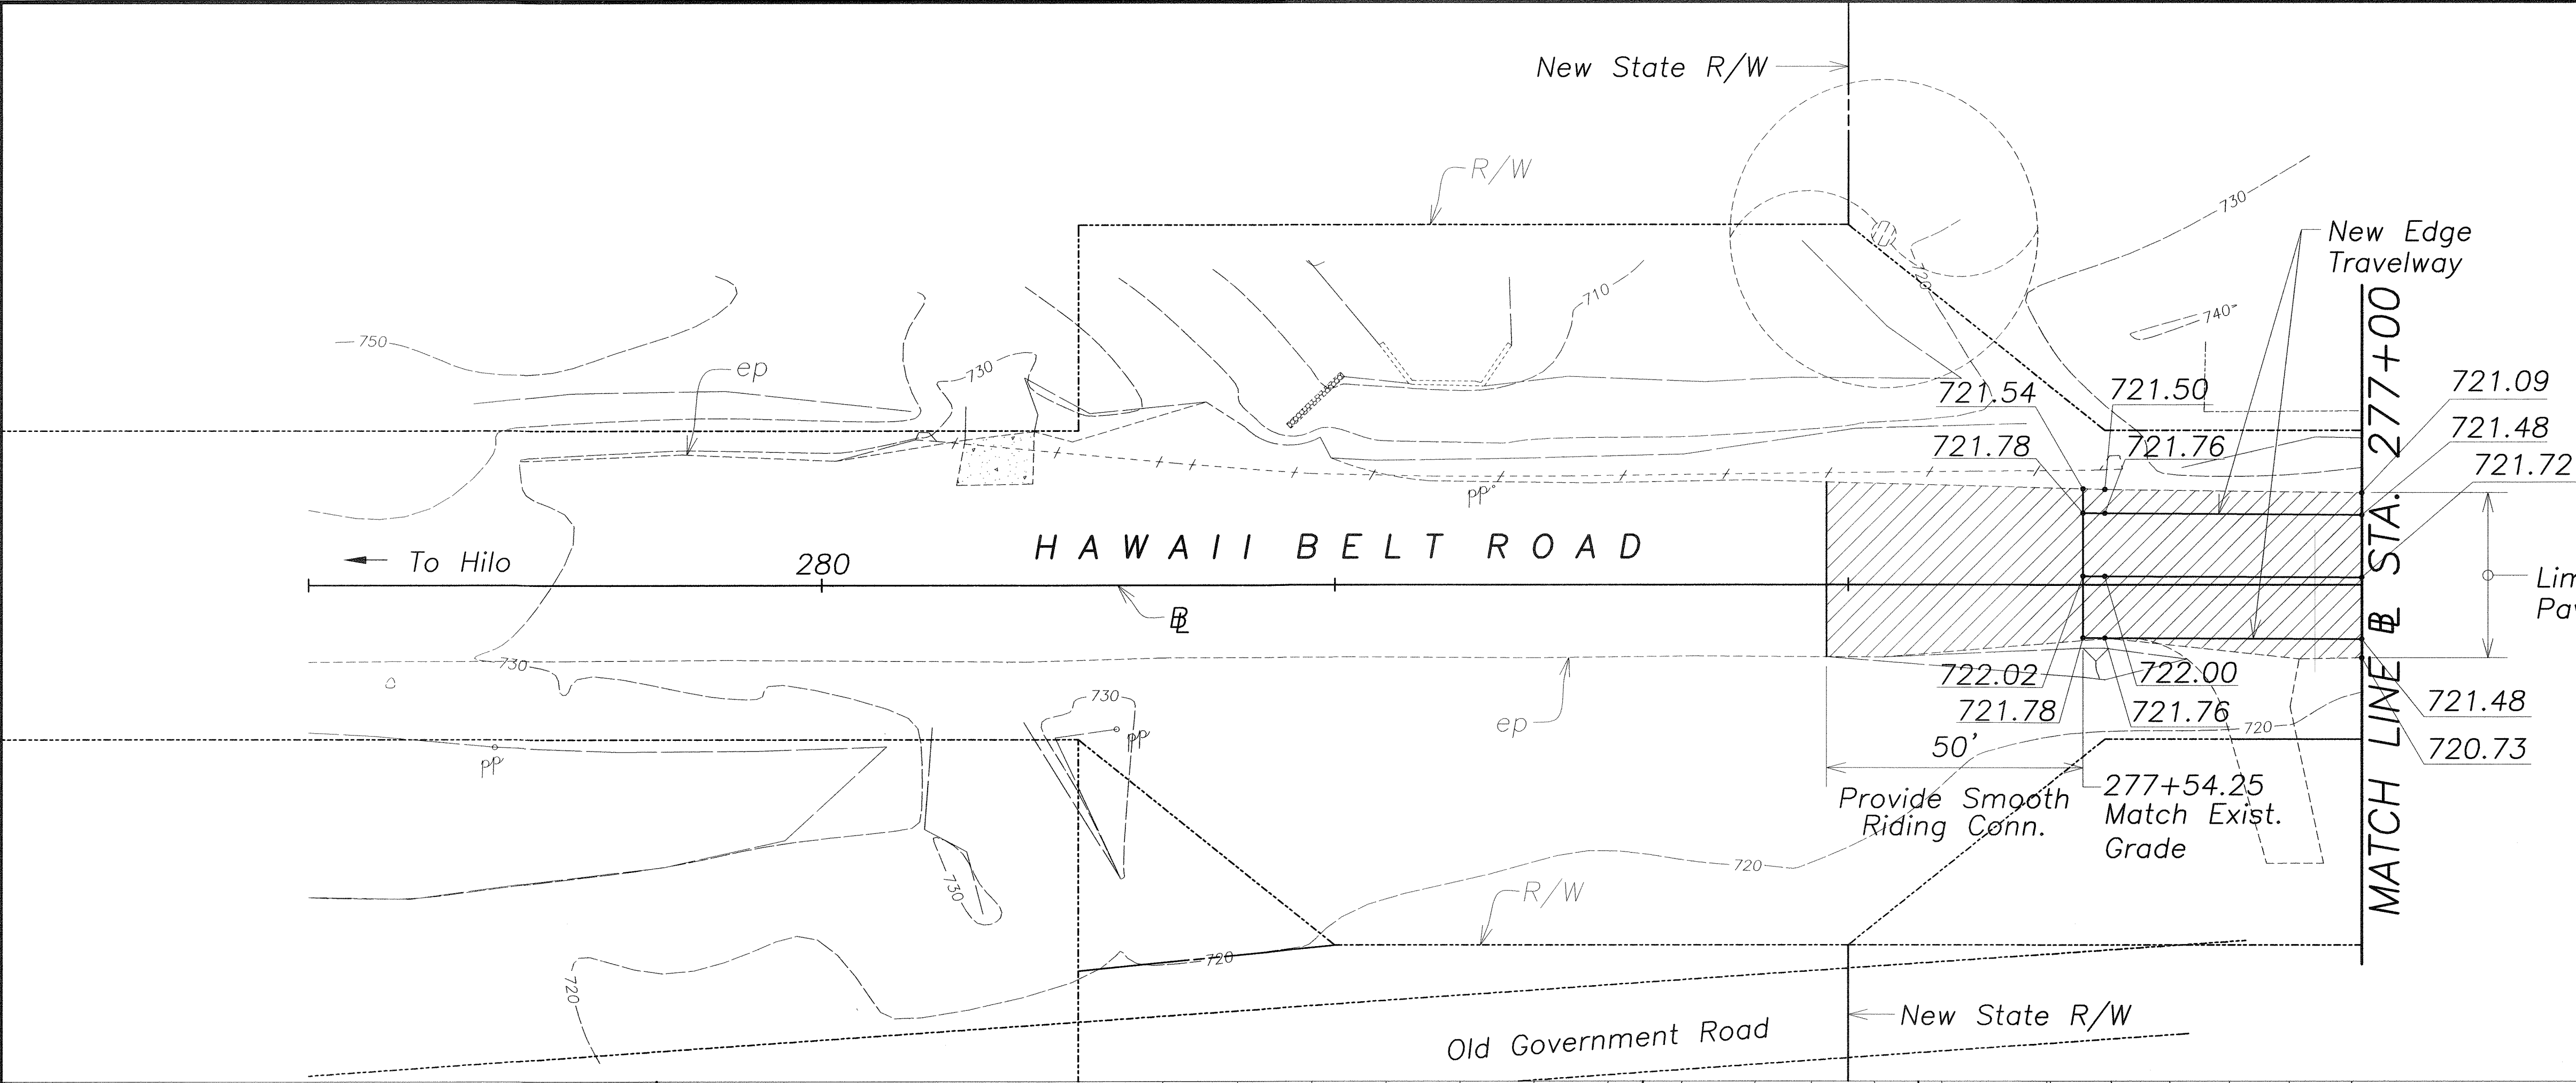


SURVEY PLOTTED BY	DATE
DESIGNED BY	
TRACED BY	
NOTED BY	
CHECKED BY	

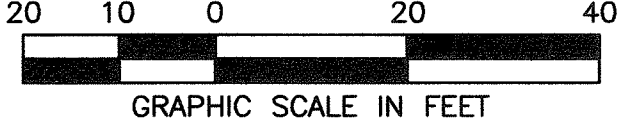

"AS-BUILT"


FED. ROAD DIST. NO.	STATE	FED. AID PROJ. NO.	FISCAL YEAR	SHEET NO.	TOTAL SHEETS
HAWAII	HAW.	BR-019-2(38)	2002	C.O. ADD. 14	73

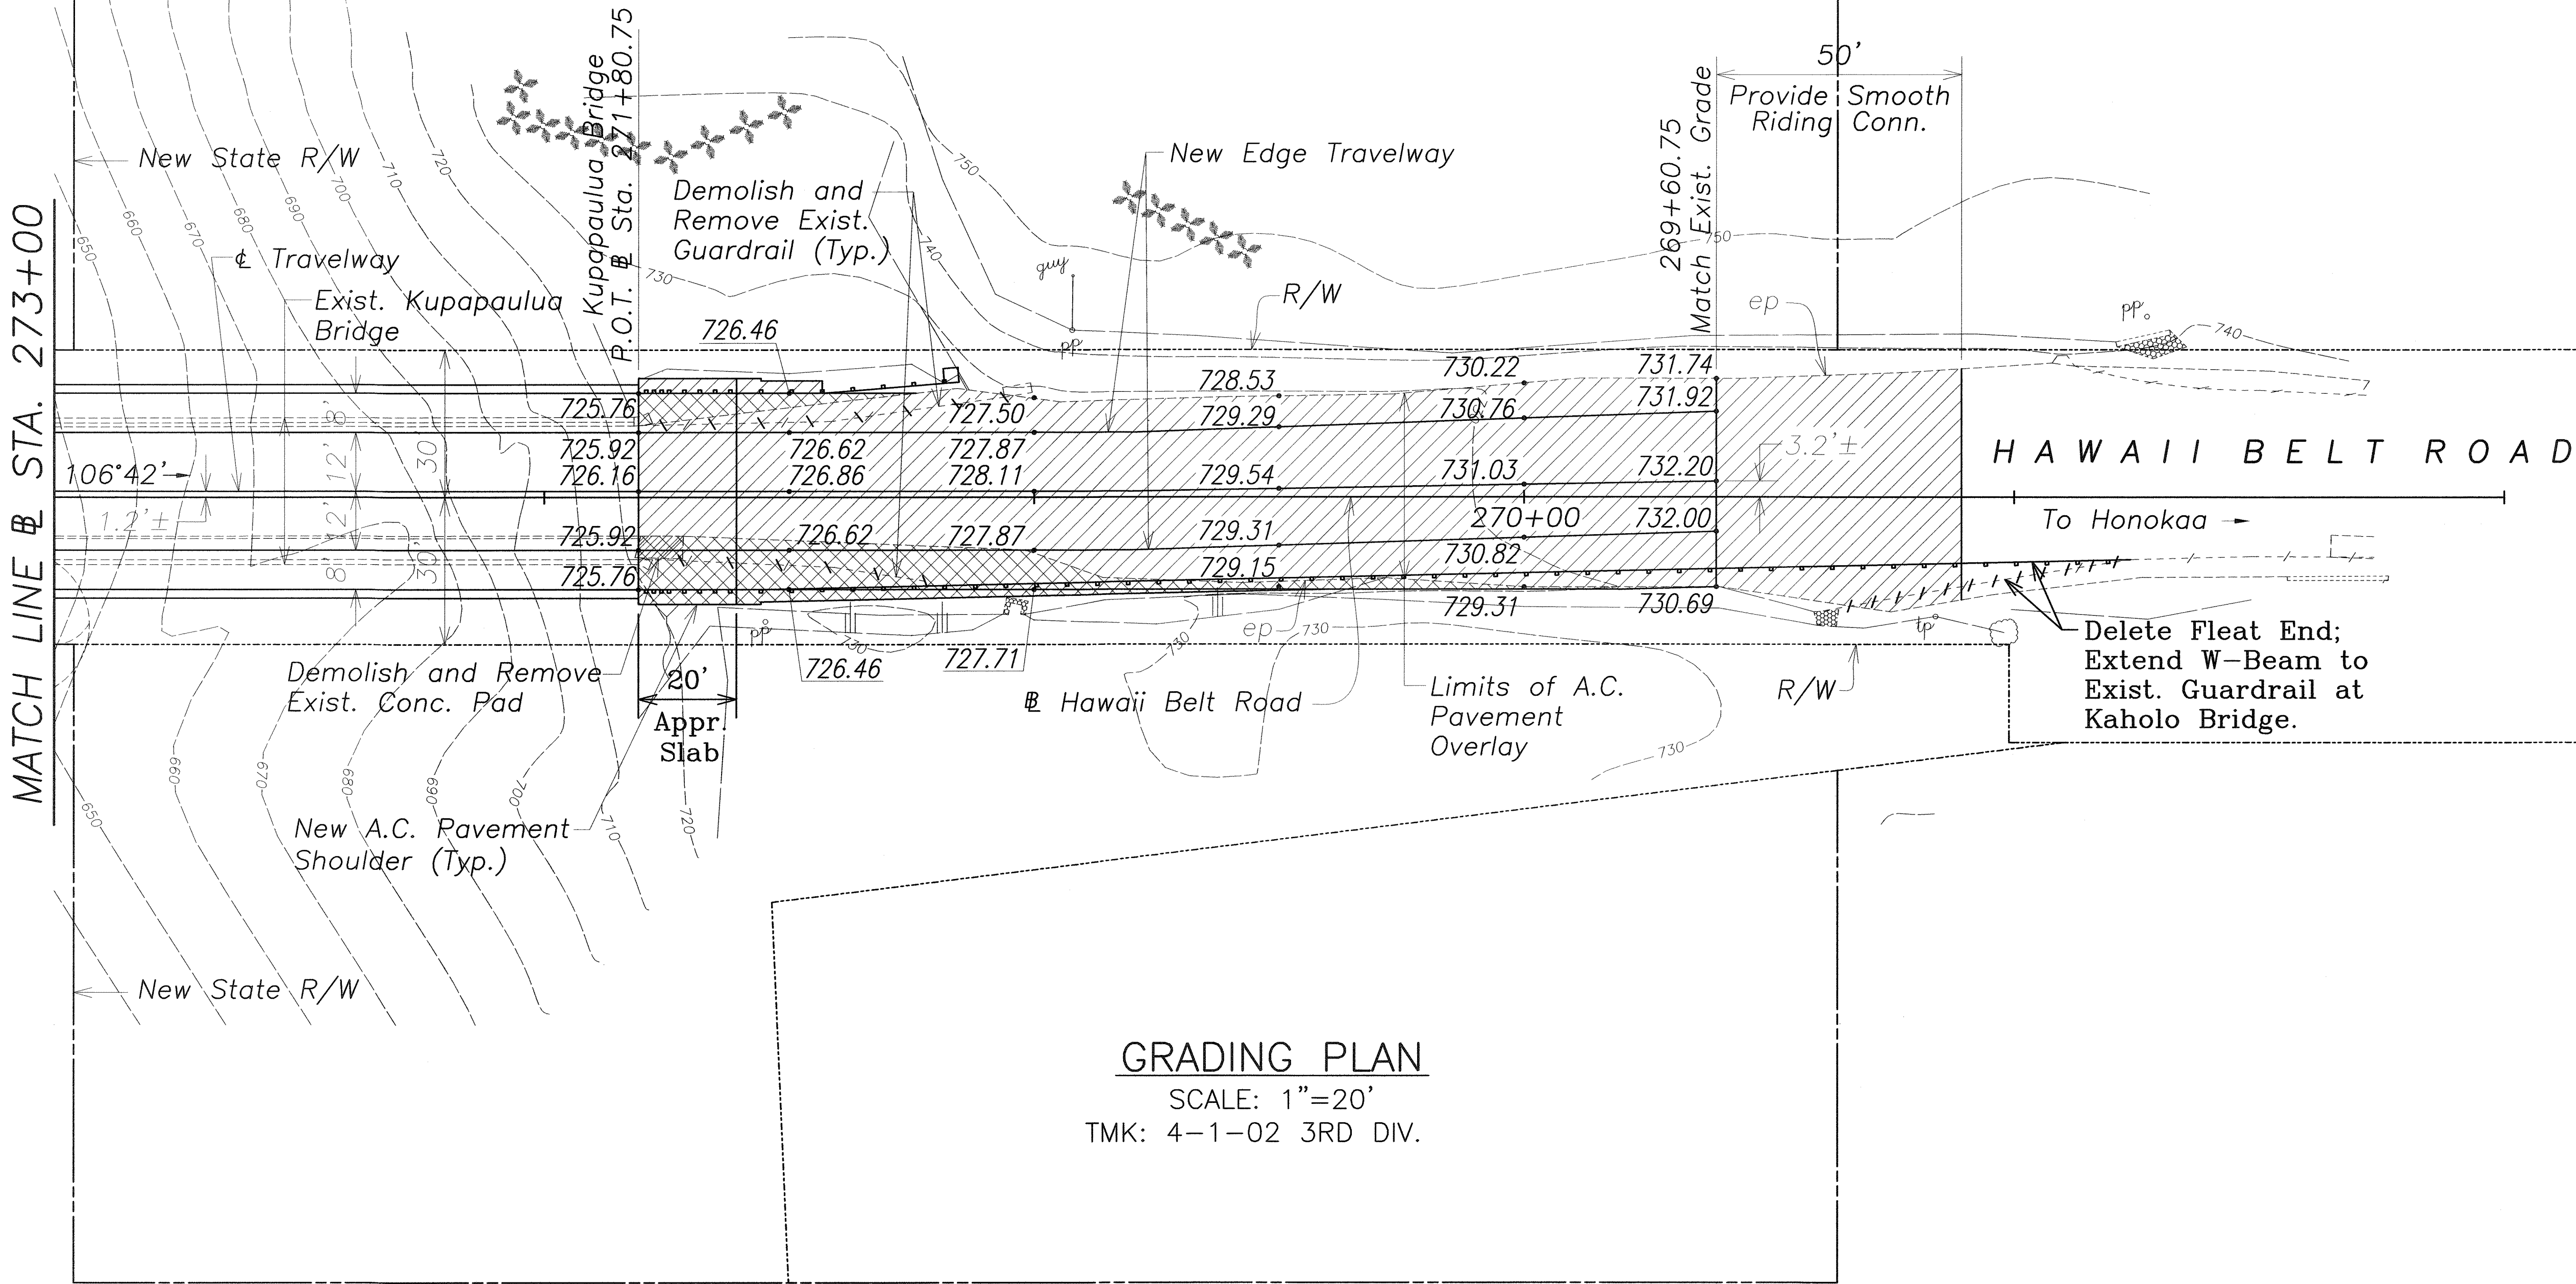

GRADING PLAN
SCALE: 1"=20'
TMK: 4-1-02 3RD DIV.

LEGEND

- Limits of A.C. Pavement Overlay
- Limits of New A.C. Pavment
- Demolition of Existing Structure(s)

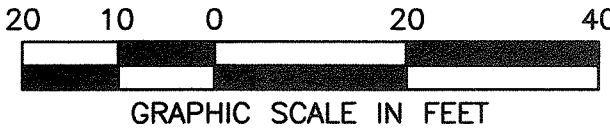

LEGEND FOR
AS-BUILT POSTINGS

- Squiggly line for as-built deletion
- Double line for as-built deletion
- Roadway Text for as-built posting



THIS WORK WAS PREPARED BY
ME OR UNDER MY SUPERVISION.
Peter L. Mow
ENGINEERS SURVEYORS HAWAII, INC.
03.08.07

06/09/04	Revised Guardrail
02/17/04	Revised Finish Grades
02/05/03	Revised Guardrail and End Treatment
07/09/02	Revised Shoulder
DATE	REVISION

STATE OF HAWAII
DEPARTMENT OF TRANSPORTATION
HIGHWAYS DIVISION
GRADING PLAN
HAWAII BELT ROAD
Kupapaulua Bridge Widening
Hamakua District
Federal-Aid Project No. BR-019-2(38)
Scale: As Noted Date: Feb. 2004
SHEET No. C-12 OF 41 SHEETS

"AS-BUILT"

C.O. ADD. 14