
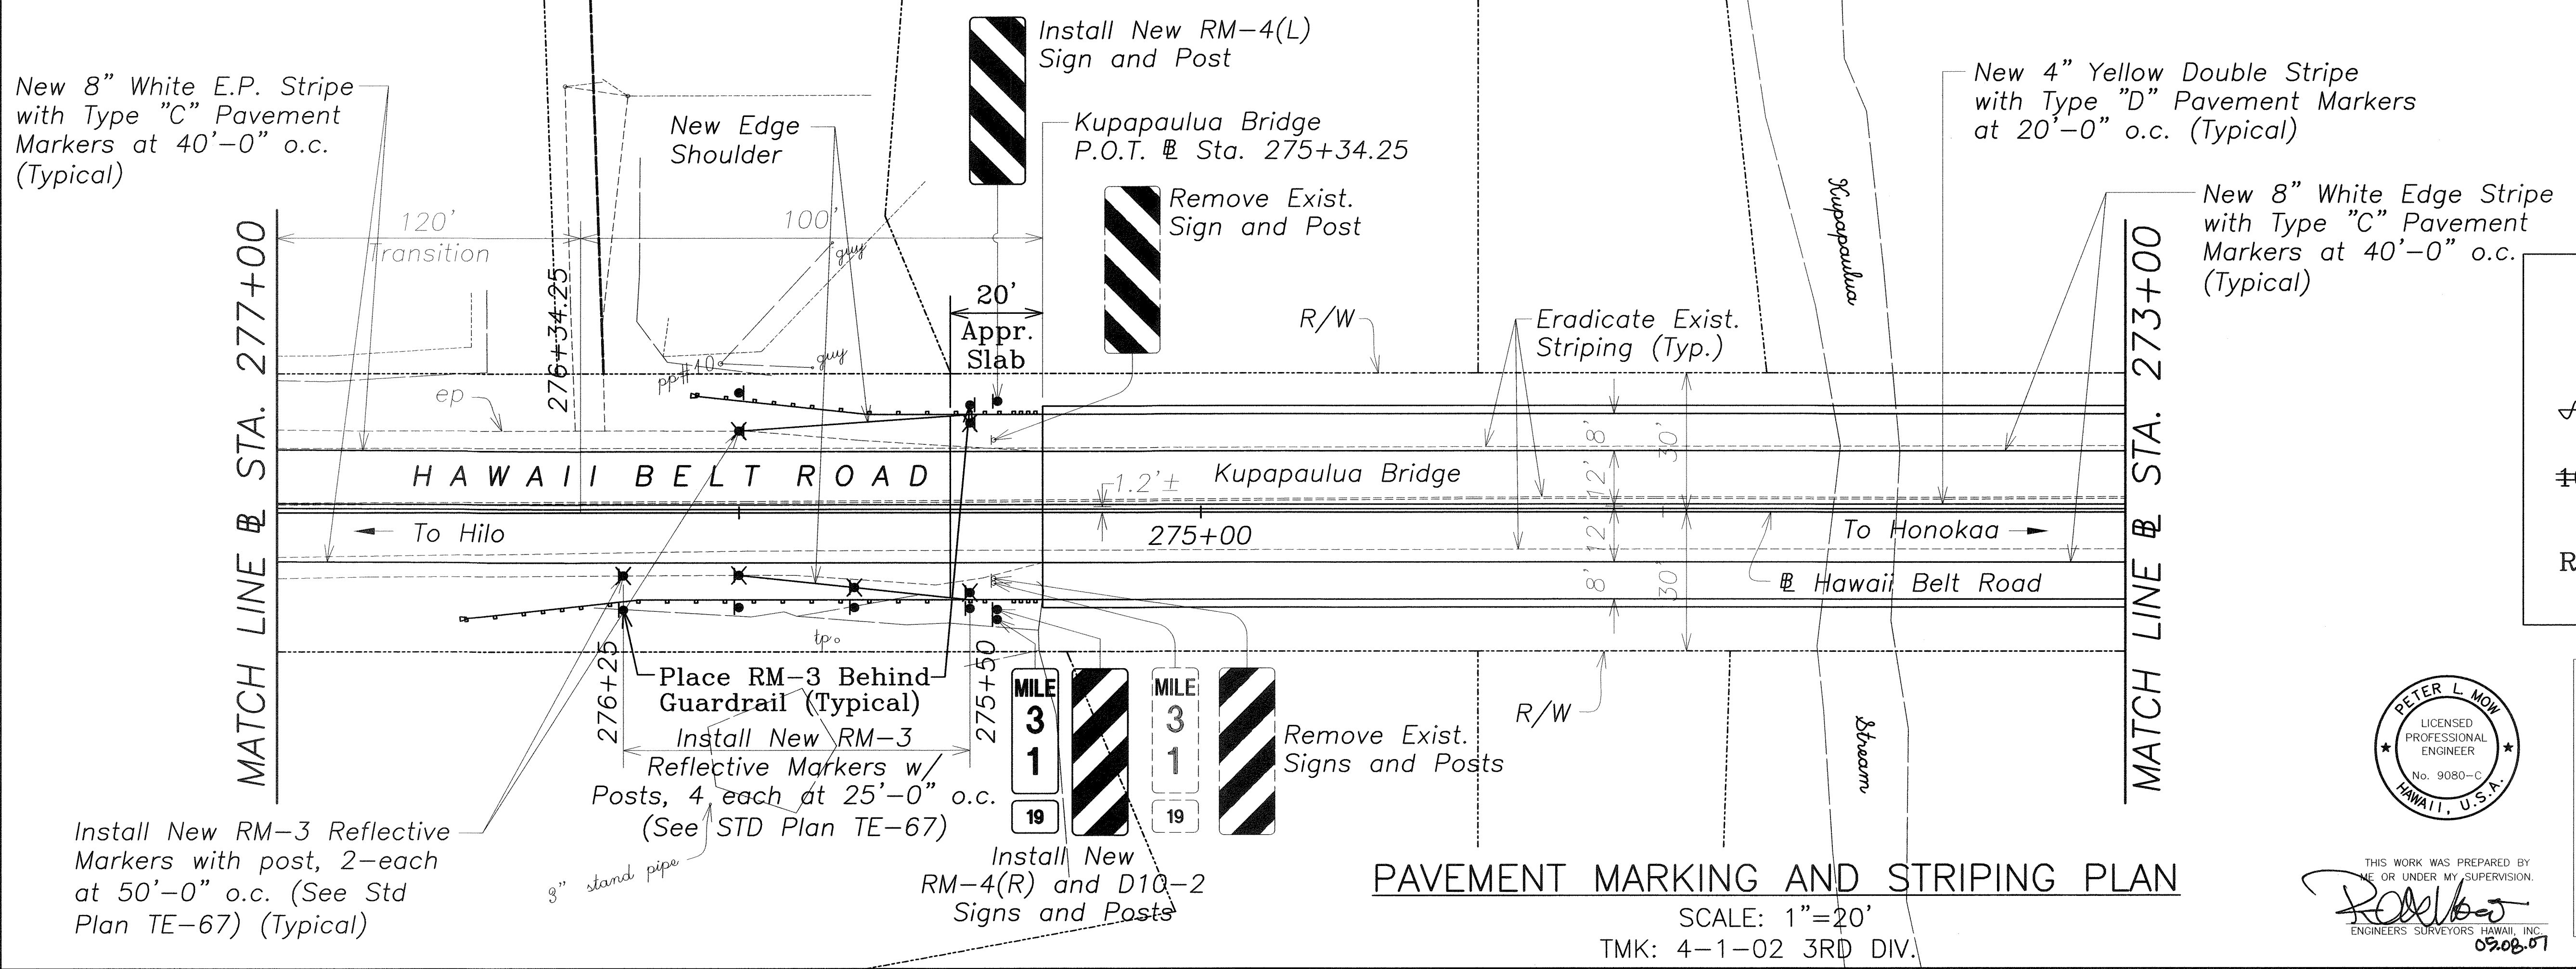
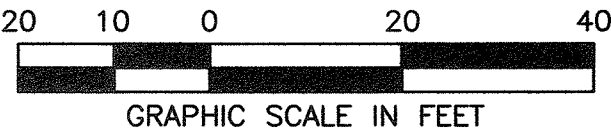


FED. ROAD DIST. NO.	STATE	FED. AID PROJ. NO.	FISCAL YEAR	SHEET NO.	TOTAL SHEETS
HAWAII	HAW.	BR-019-2(38)	2002	15	73

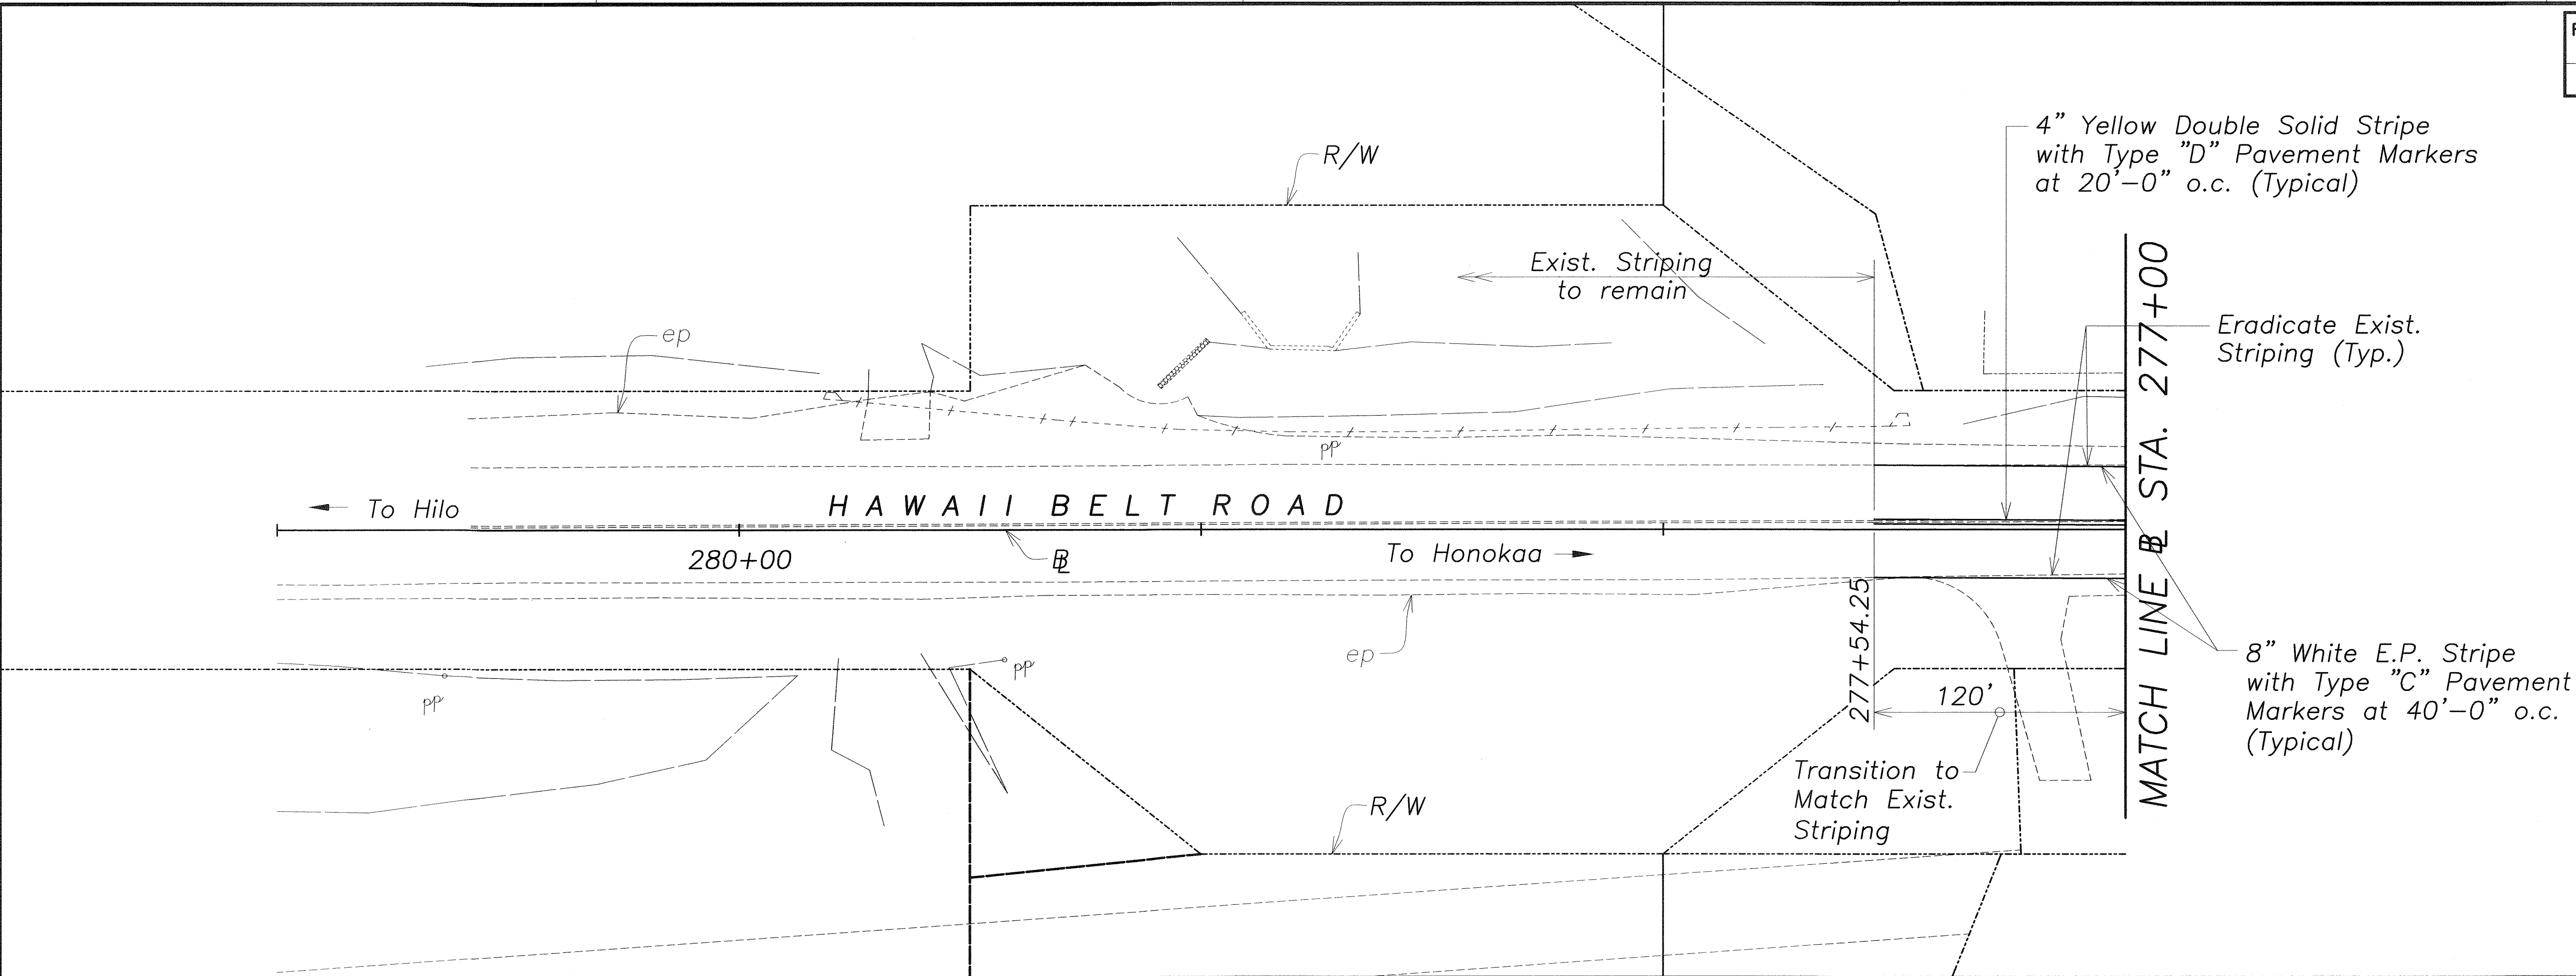

LEGEND FOR AS-BUILT POSTINGS	
	Squiggly line for as-built deletion
	Double line for as-built deletion
Roadway	Text for as-built posting

STATE OF HAWAII
DEPARTMENT OF TRANSPORTATION
HIGHWAYS DIVISION

PAVEMENT MARKING AND STRIPING PLAN
HAWAII BELT ROAD
Kupapaulua Bridge Widening
Hamakua District
Federal-Aid Project No. BR-019-2(38)

Scale: As Noted
Date: Oct 2001

SHEET No. C-13 OF 41 SHEETS


PETER L. NOW
LICENSED PROFESSIONAL ENGINEER
No. 9080-C
HAWAII, U.S.A.

THIS WORK WAS PREPARED BY ME OR UNDER MY SUPERVISION.
[Signature]
ENGINEERS SURVEYORS HAWAII, INC.
09208.01


SURVEY PLOTTED BY	DATE
DESIGNED BY	
NOTED BY	
CHECKED BY	
ORIGINAL PLAN	
NOTE BOOK	
NO.	

"AS-BUILT"


FED. ROAD DIST. NO.	STATE	FED. AID PROJ. NO.	FISCAL YEAR	SHEET NO.	TOTAL SHEETS
HAWAII	HAW.	BR-019-2(38)	2002	16	73

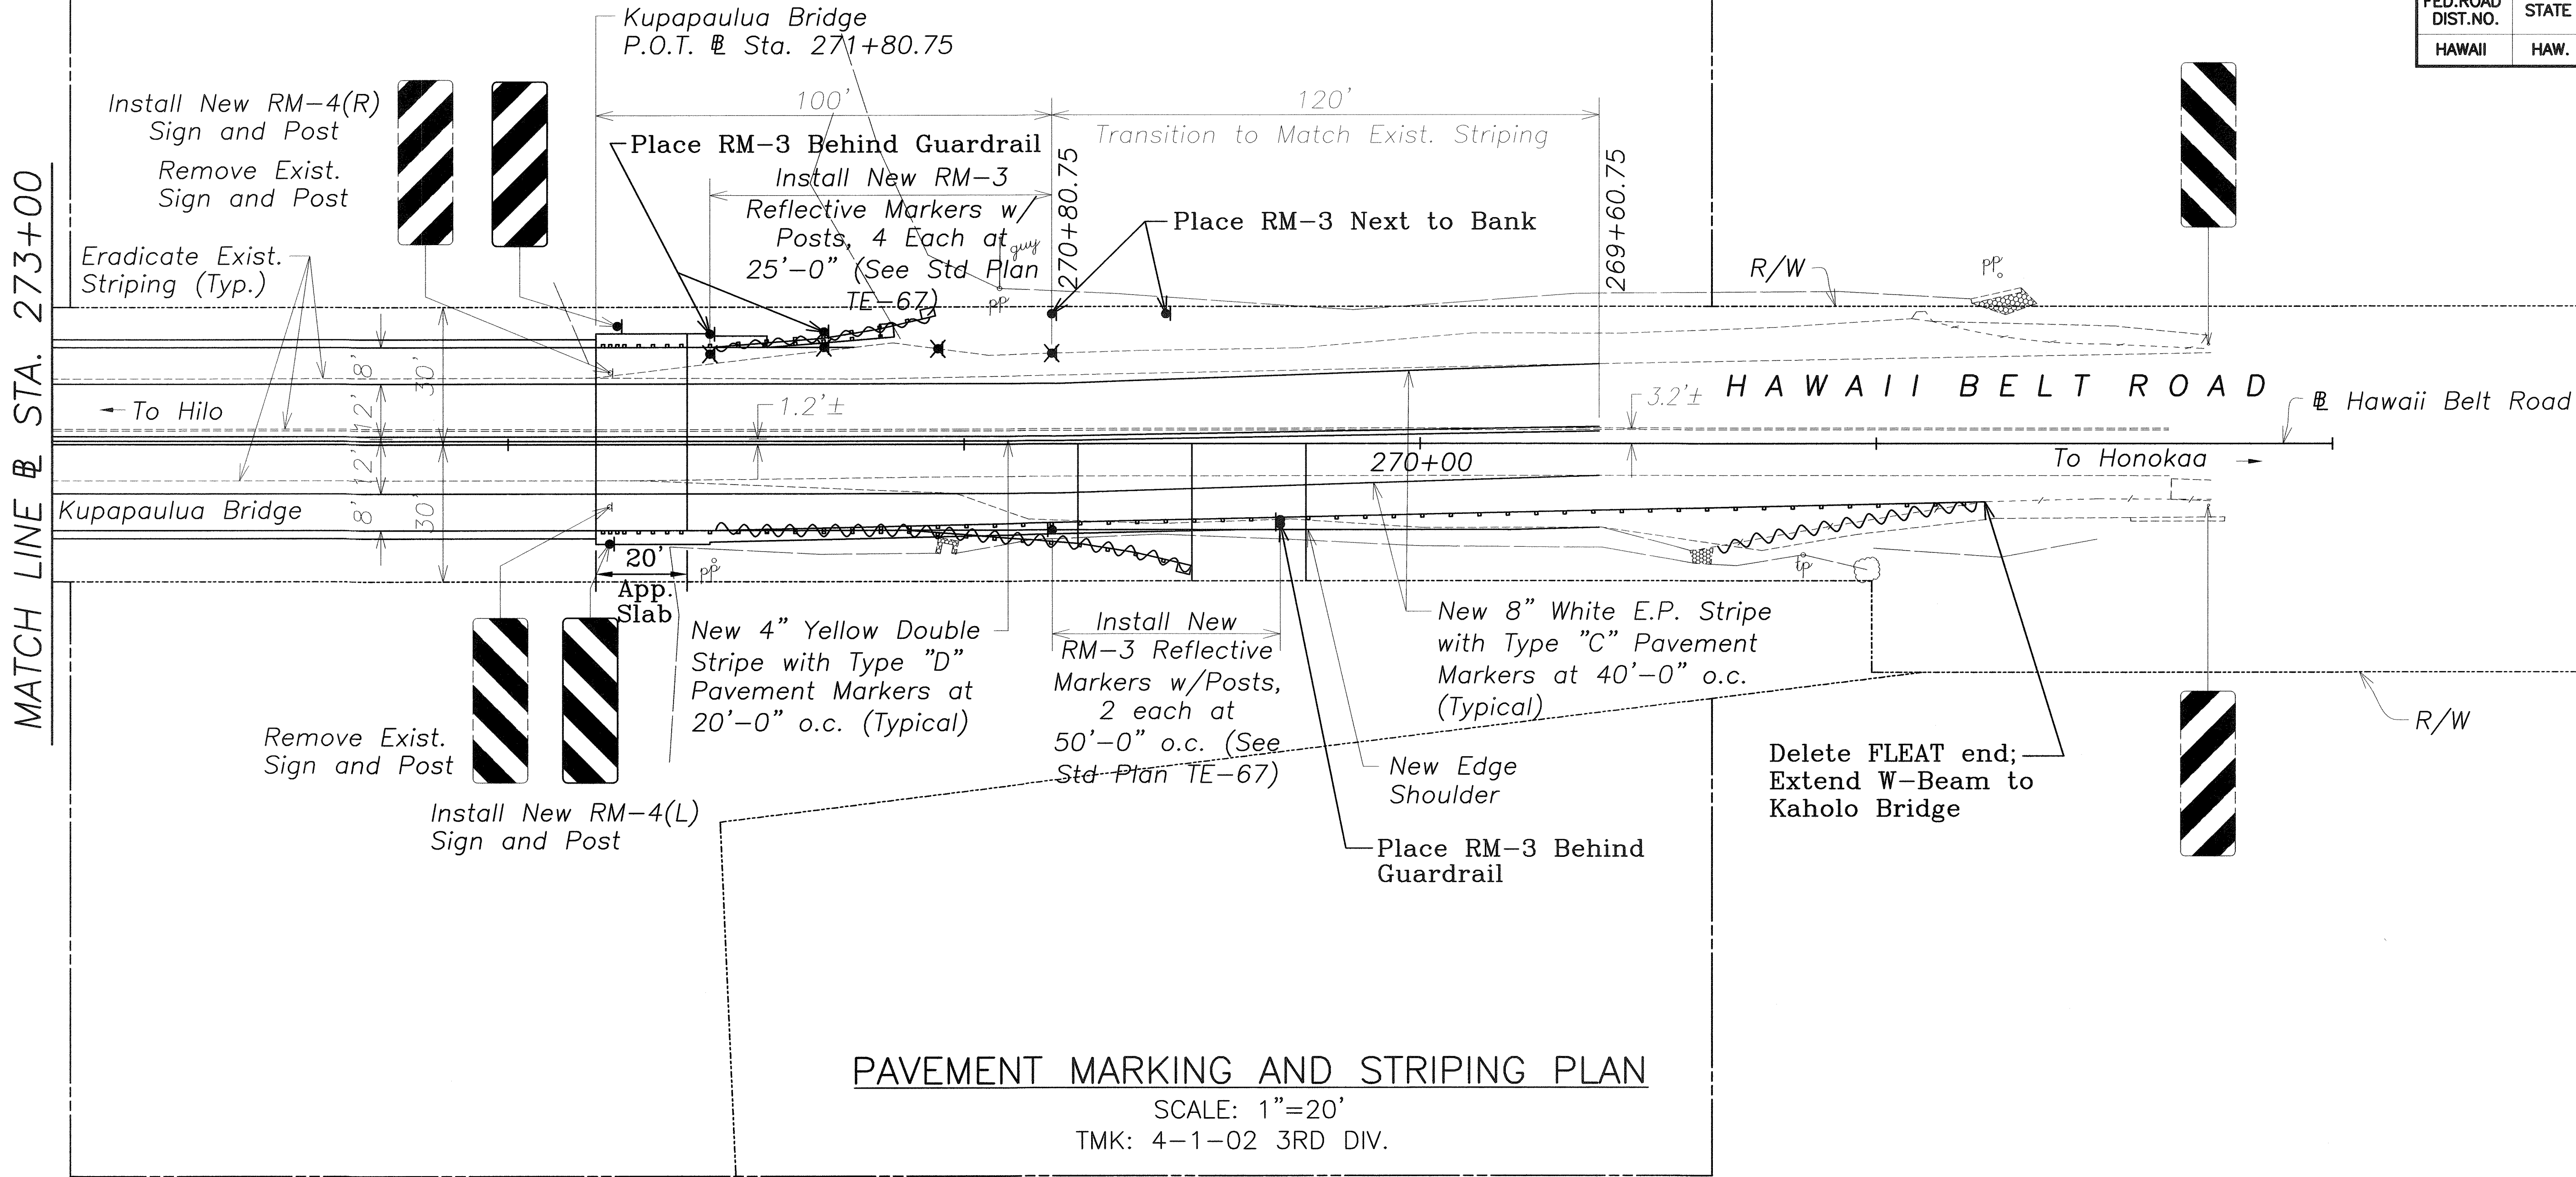

SURVEY PLOTTED BY	DATE
DESIGNED BY	
NOTED BY	
CHECKED BY	
ORIGINAL PLAN	
NOTE BOOK	
No.	

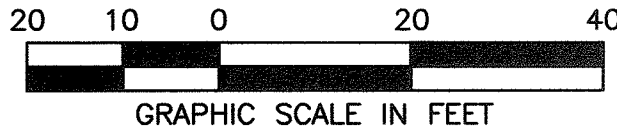

LEGEND FOR AS-BUILT POSTINGS	
	Squiggly line for as-built deletion
	Double line for as-built deletion
Roadway	Text for as-built posting

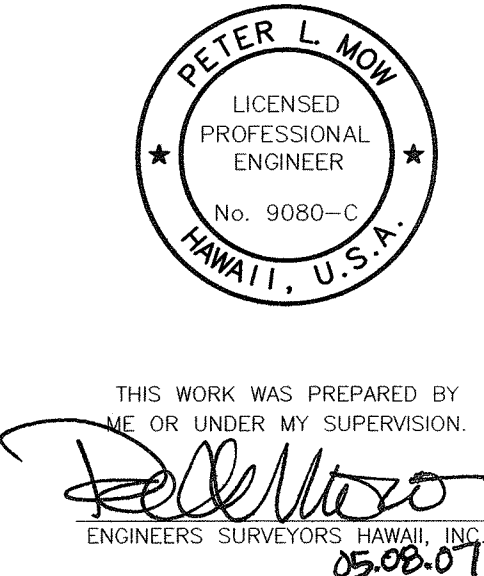

STATE OF HAWAII
DEPARTMENT OF TRANSPORTATION
HIGHWAYS DIVISION

PAVEMENT MARKING AND STRIPING PLAN

HAWAII BELT ROAD
Kupapaulua Bridge Widening
Hamakua District
Federal-Aid Project No. BR-019-2(38)

Scale: As Noted Date: Oct 2001

SHEET No. C-14 OF 41 SHEETS

"AS-BUILT"