

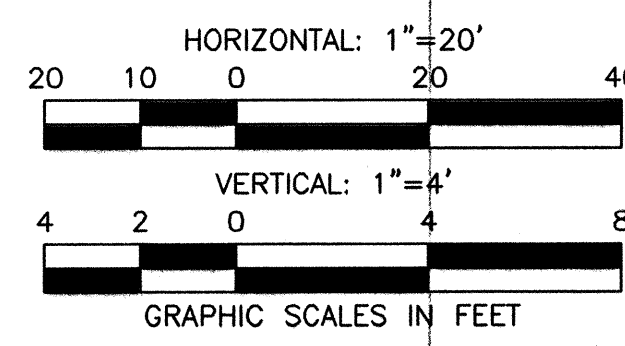
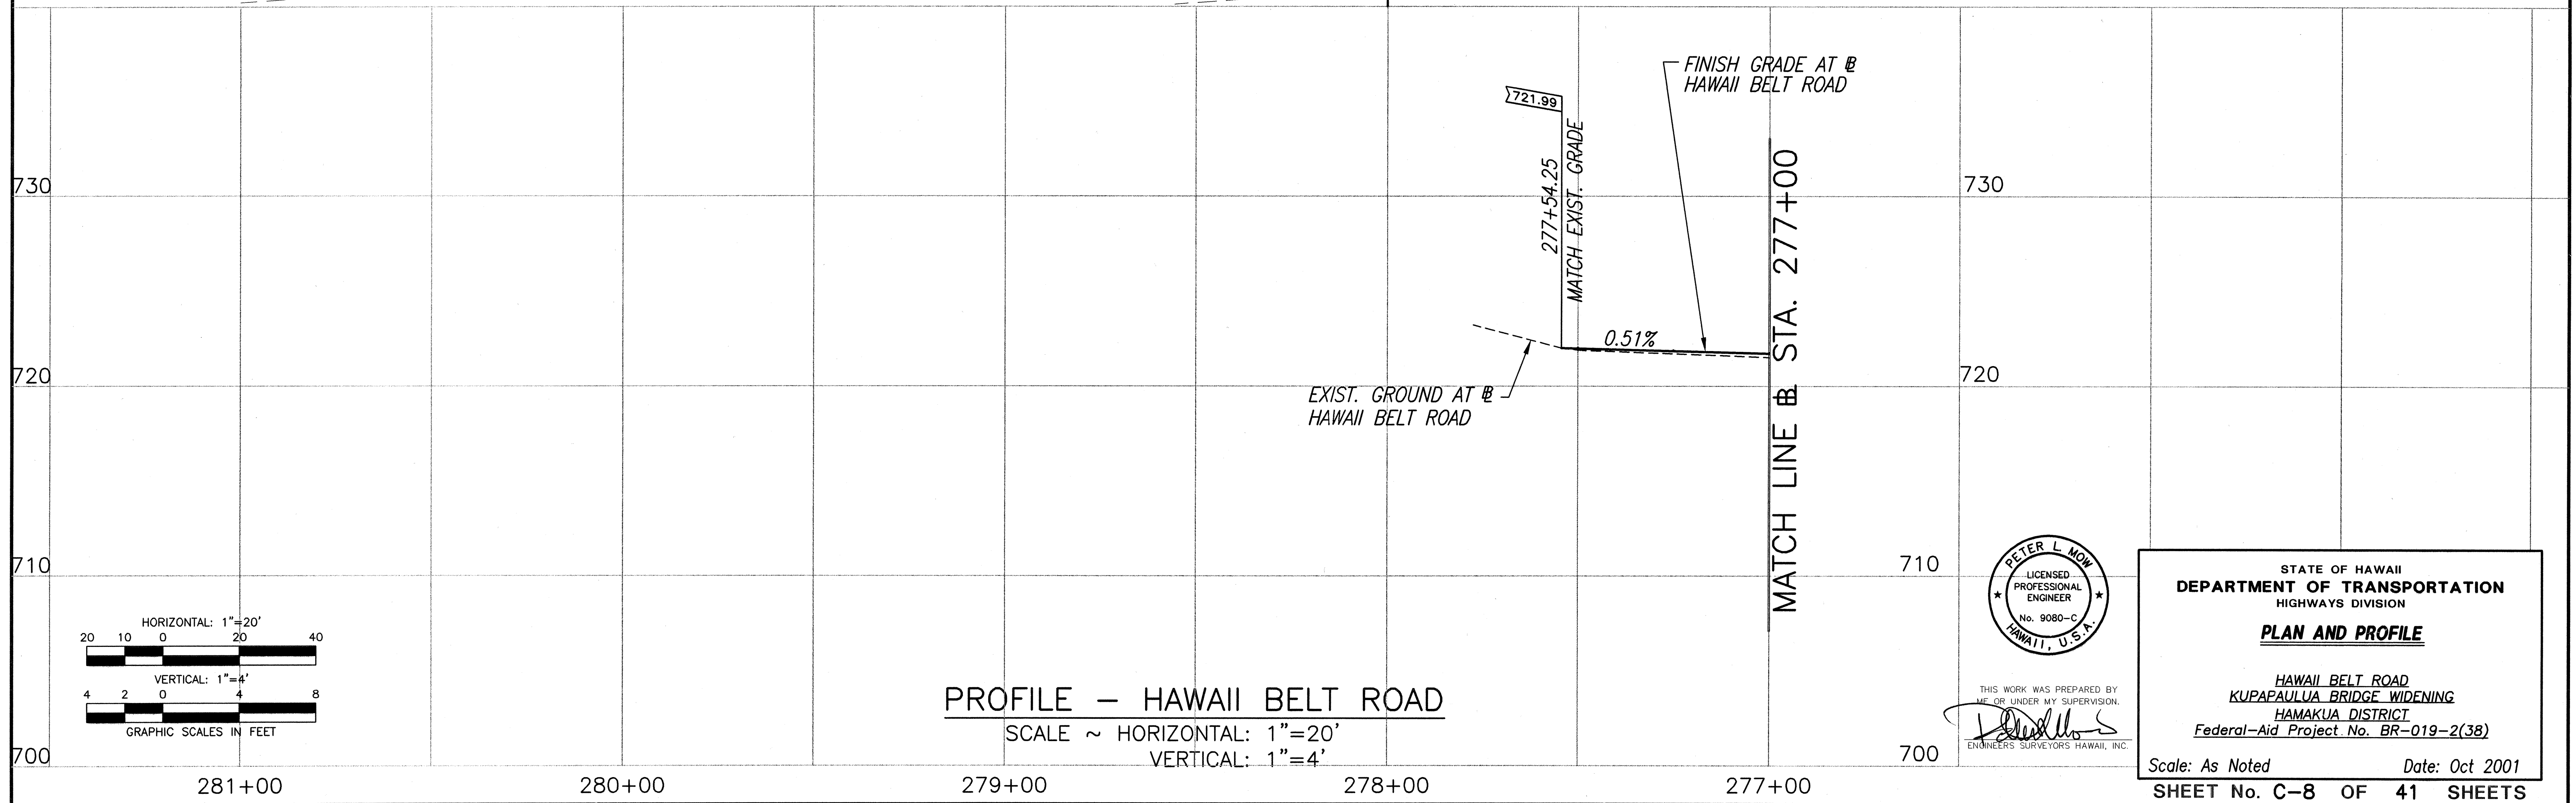
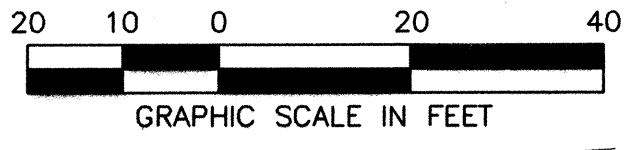


| FED. ROAD DIST. NO. | STATE | FED. AID PROJ. NO. | FISCAL YEAR | SHEET NO. | TOTAL SHEETS |
|---------------------|-------|--------------------|-------------|-----------|--------------|
| HAWAII              | HAW.  | BR-019-2(38)       | 2002        | 10        | 73           |

True North  
Scale: 1" = 20'

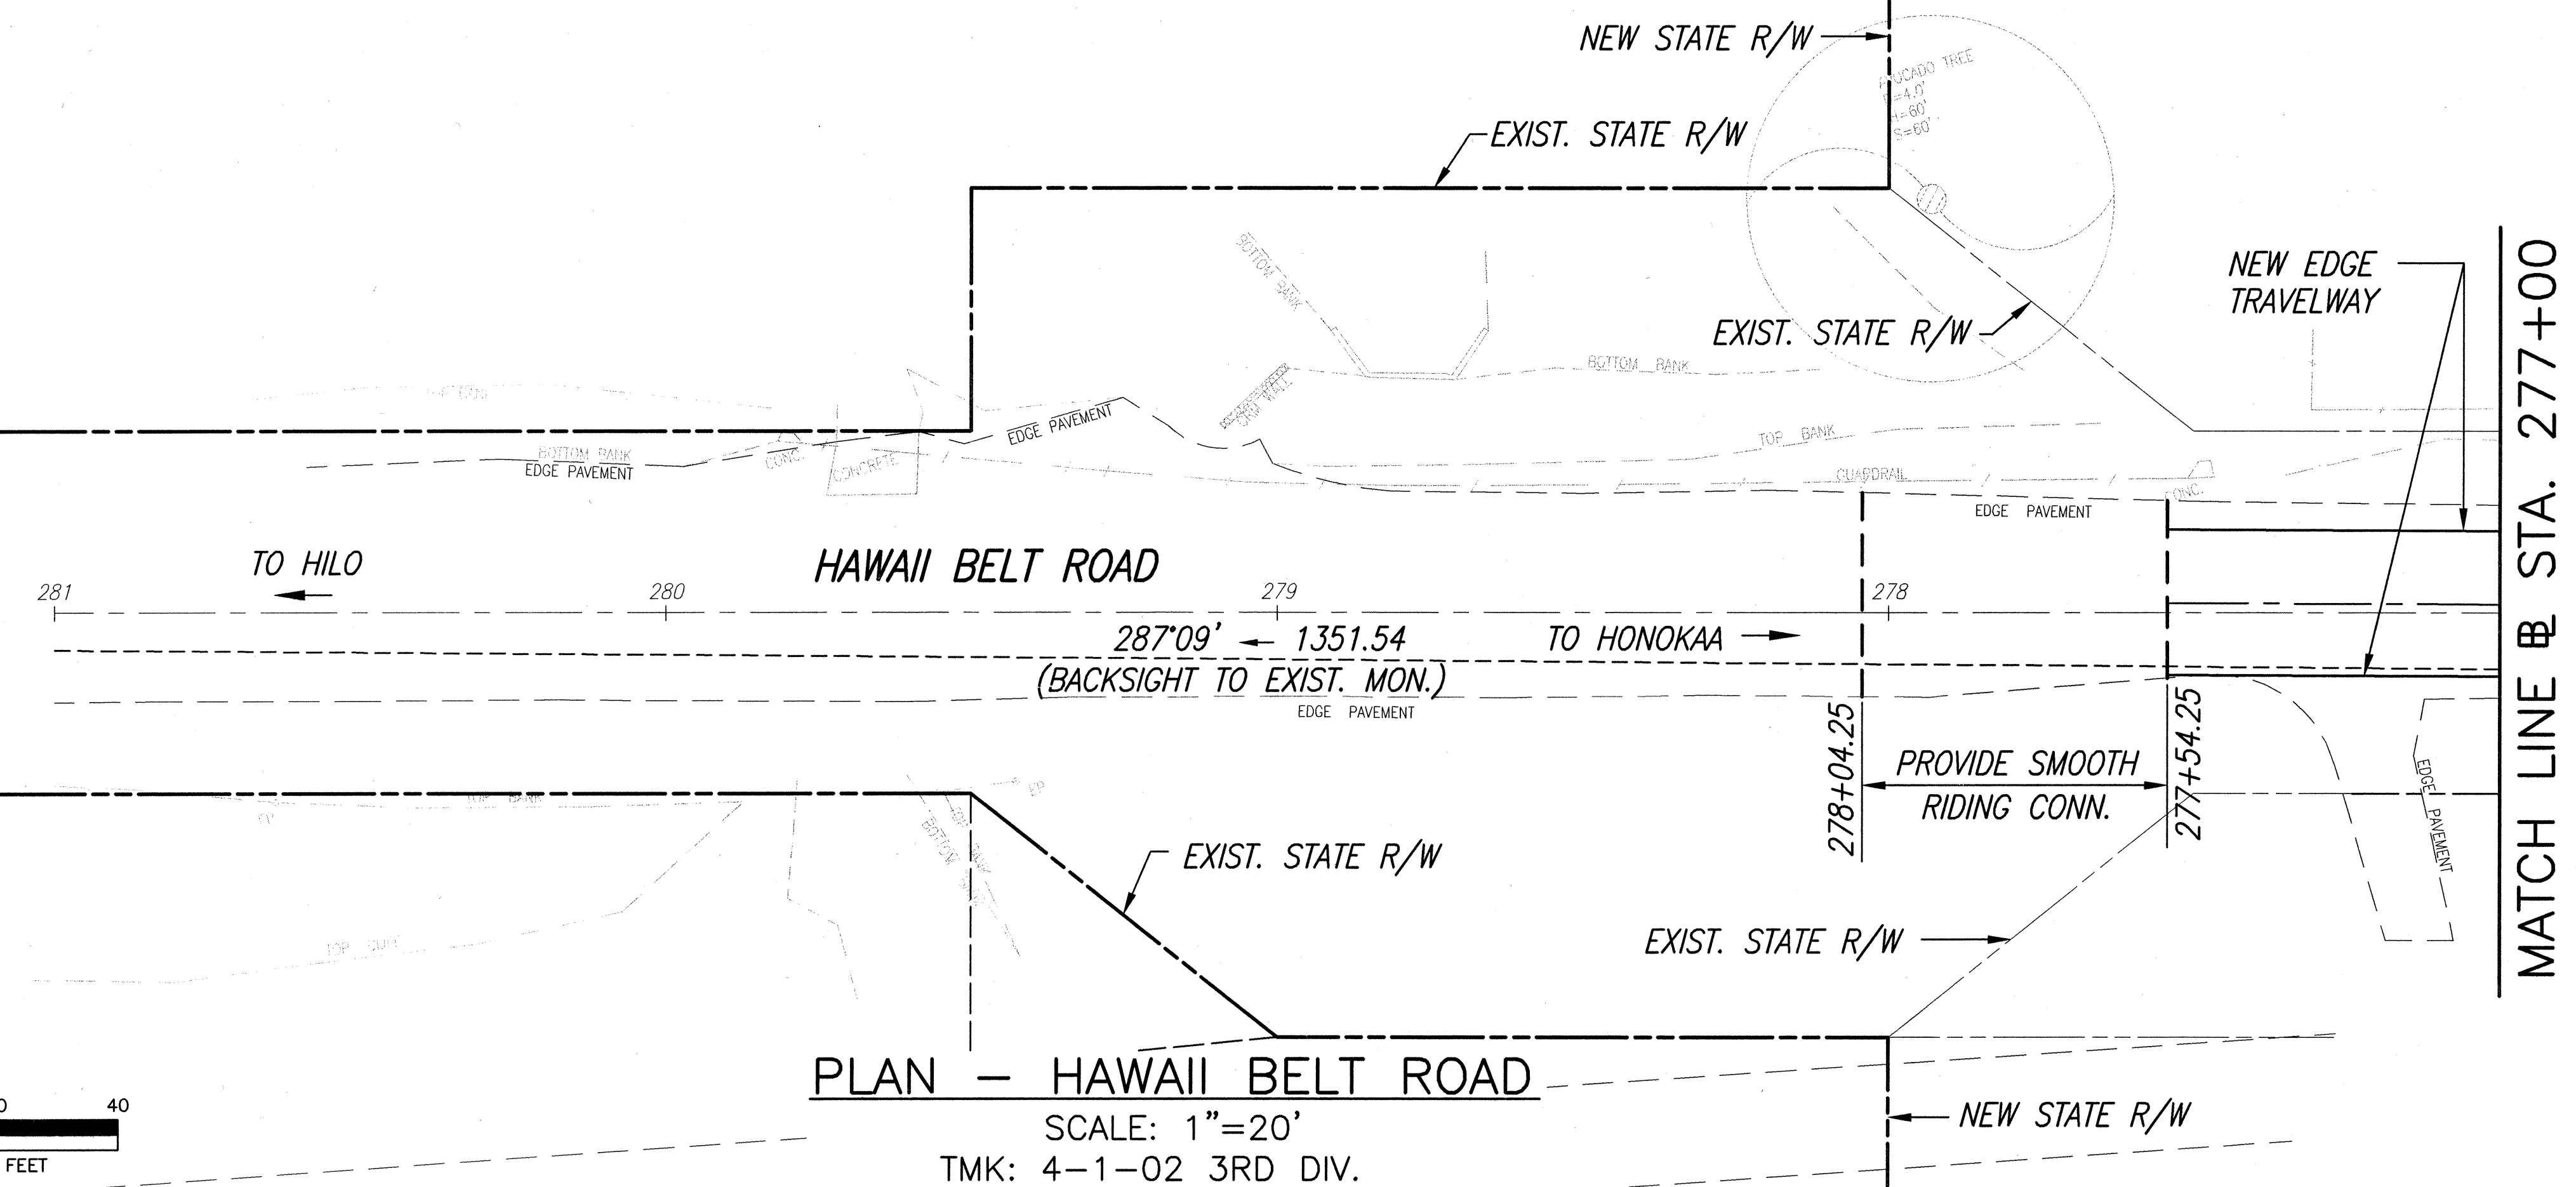

|               |                   |      |
|---------------|-------------------|------|
| ORIGINAL PLAN | SURVEY PLOTTED BY | DATE |
| DESIGNED BY   | DRAWN BY          |      |
| CHECKED BY    | NOTED BY          |      |
| NO.           |                   |      |

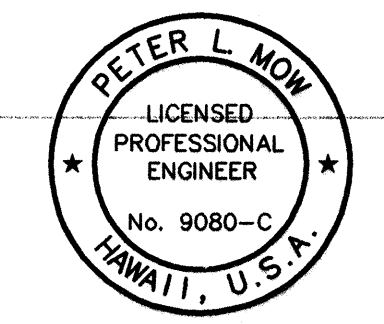

THIS WORK WAS PREPARED BY ME OR UNDER MY SUPERVISION.  
ENGINEERS SURVEYORS HAWAII, INC.

STATE OF HAWAII  
DEPARTMENT OF TRANSPORTATION  
HIGHWAYS DIVISION

**PLAN AND PROFILE**

HAWAII BELT ROAD  
KUPAPAAULUA BRIDGE WIDENING  
HAMAKUA DISTRICT  
Federal-Aid Project No. BR-019-2(38)

Scale: As Noted Date: Oct 2001  
SHEET No. C-8 OF 41 SHEETS







True North

Magnetic North

20°

Scale : 1" = 20'

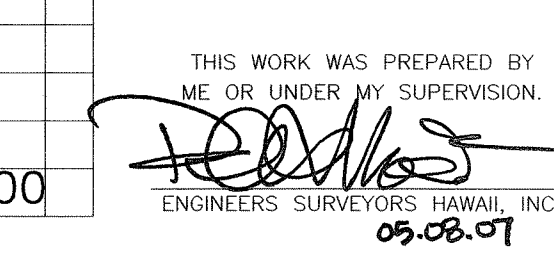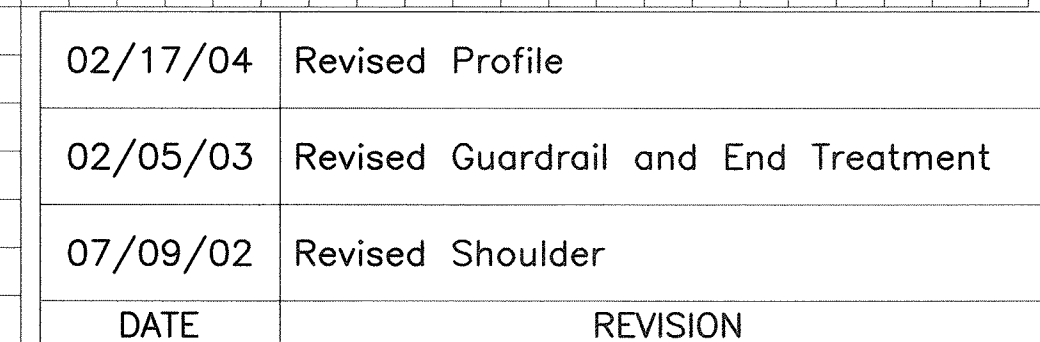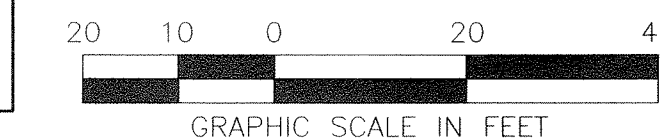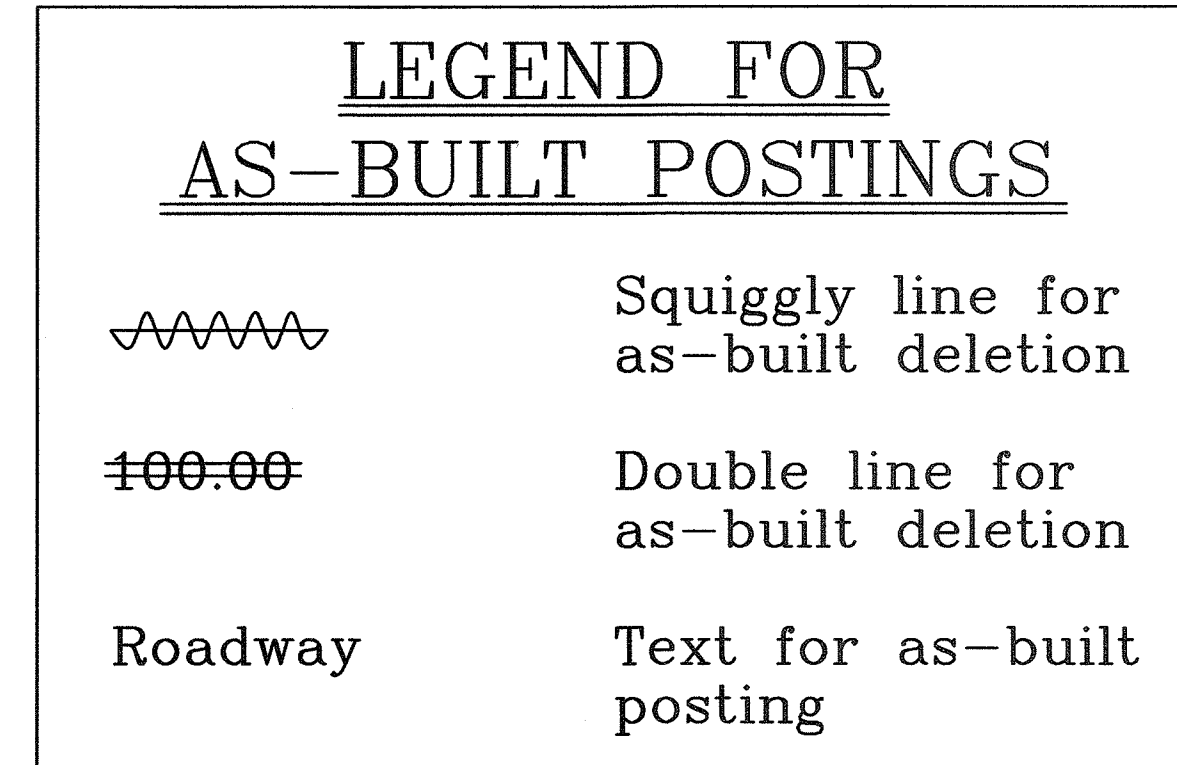

STATE OF HAWAII  
DEPARTMENT OF TRANSPORTATION  
HIGHWAYS DIVISION

**PLAN AND PROFILE**


**HAWAII BELT ROAD**  
**Kupapaulua Bridge Widening**  
**Hamakua District**  
**Federal-Aid Project No. BR-019-2(38)**

Scale: As Noted Date: Feb. 2004

SHEET No. C-9 OF 41 SHEETS




| FED. ROAD DIST. NO. | STATE | FED. AID PROJ. NO. | FISCAL YEAR | SHEET NO.    | TOTAL SHEETS |
|---------------------|-------|--------------------|-------------|--------------|--------------|
| HAWAII              | HAW.  | BR-019-2(38)       | 2002        | C.O. ADD. 12 | 73           |

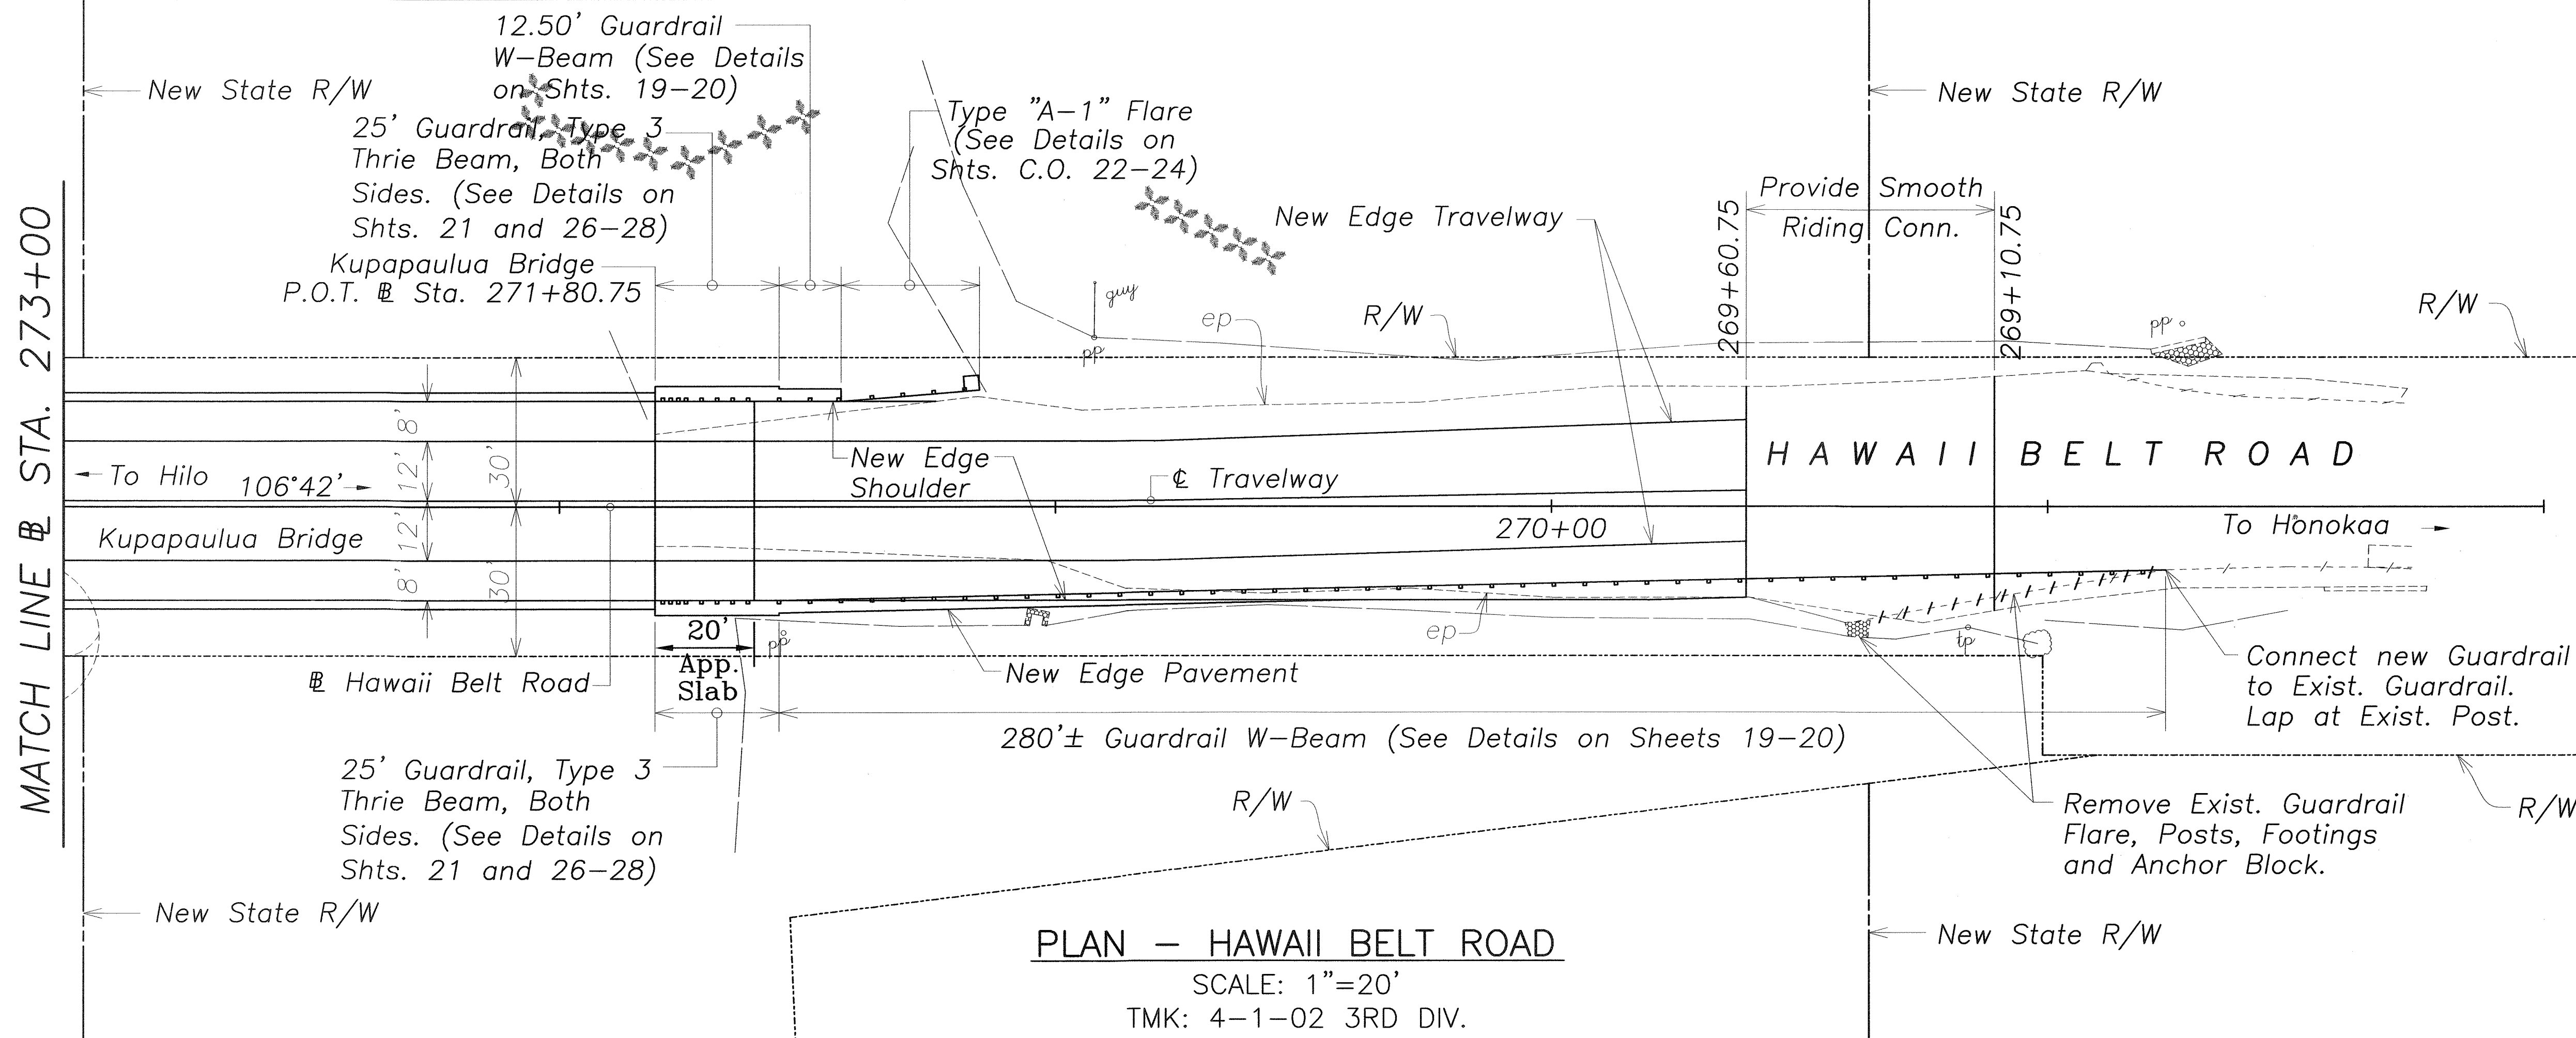


| LEGEND FOR AS-BUILT POSTINGS |                                     |
|------------------------------|-------------------------------------|
|                              | Squiggly line for as-built deletion |
|                              | Double line for as-built deletion   |
| Roadway                      | Text for as-built posting           |

| DATE     | REVISION                            |
|----------|-------------------------------------|
| 06/09/04 | Revised Guardrail                   |
| 02/17/04 | Revised Profile                     |
| 02/05/03 | Revised Guardrail and End Treatment |
| 07/09/02 | Revised Shoulder                    |

MATCH LINE @ STA. 273+00

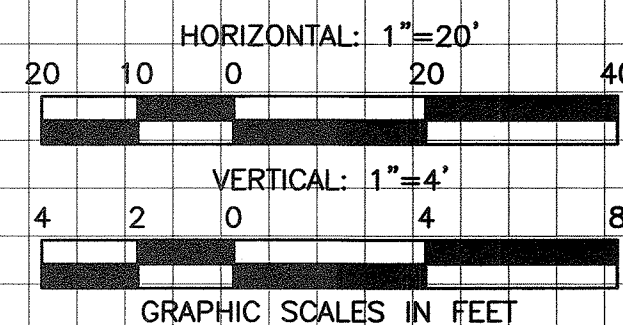

**PROFILE - HAWAII BELT ROAD**  
 SCALE ~ HORIZONTAL: 1"=20'  
 VERTICAL: 1"=4'

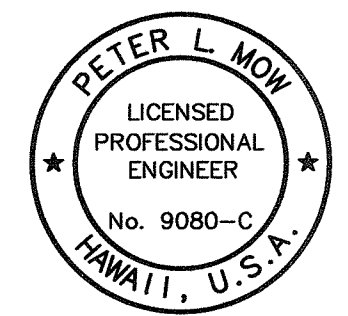

THIS WORK WAS PREPARED BY ME OR UNDER MY SUPERVISION.  
*Peter L. Mow*  
 ENGINEERS SURVEYORS HAWAII, INC.  
 07.08.07

STATE OF HAWAII  
 DEPARTMENT OF TRANSPORTATION  
 HIGHWAYS DIVISION  
**PLAN AND PROFILE**  
**HAWAII BELT ROAD**  
**Kupapaulua Bridge Widening**  
**Hamakua District**  
**Federal-Aid Project No. BR-019-2(38)**  
 Scale: As Noted Date: June 2004  
 SHEET No. C-10 OF 41 SHEETS

"AS-BUILT"

C.O. ADD. 12