

ORIGINAL PLAN	No.	SURVEY PLOTTED BY _____ DATE _____	DRAWN BY _____	DESIGNED BY _____	NOTED BY _____	CHECKED BY _____

INDEX TO DRAWINGS	
DRAW NO.	DESCRIPTION
S-1	INDEX TO DRAWINGS, ABBREVIATIONS, SUMMARY OF ESTIMATED QUANTITIES
S-2	STRUCTURAL NOTES
S-3	CONSTRUCTION SEQUENCE
S-4	EXISTING BRIDGE PLAN, EXISTING BRIDGE HALF SECTION/ELEVATION, TYPICAL SECTION THRU ARCH
S-5	EXISTING BRIDGE DEMOLITION PLANS
S-6	DEMOLITION CROSS SECTIONS, SIDEWALK DEMOLITION
S-7	NEW BRIDGE LAYOUT PLAN, NEW BRIDGE ELEVATION
S-8	NEW BRIDGE LONGITUDINAL SECTION, TYPICAL NEW DECK SECTION
S-9	ABUTMENT / WING WALL ELEVATION
S-10	NEW ABUTMENT NO. 1 FOUNDATION PLAN, DRILLED SHAFT DETAILS
S-11	FOUNDATION SECTIONS AND DETAILS
S-12	FOUNDATION SECTIONS AND DETAILS
S-13	FOUNDATION SECTIONS AND DETAILS
S-14	ABUTMENT NO. 2 FOUNDATION PLAN, FOUNDATION SECTION
S-15	FOUNDATION SECTIONS AND DETAILS
S-16	FOUNDATION SECTIONS
S-17	PARTIAL ARCH BEAM ELEVATION, COLUMN SEAT
S-18	ARCH BEAM PLAN, ARCH BEAM ELEVATION, ARCH BEAM SECTIONS
S-19	ARCH BEAM SECTIONS
S-20	BRIDGE DECK FRAMING PLAN, TYPICAL DECK SECTION
S-21	TYPICAL BEAM ELEVATIONS, COLUMN DETAIL
S-22	BEAM SECTIONS, CONCRETE PARAPET, DRIP DETAIL
S-23	ABUTMENT WALL SECTIONS
S-24	ABUTMENT WALL SECTION, EDGE BEAM DETAILS, ELASTOMERIC BEARING PAD DETAILS
S-25	TYPICAL DECK SECTION AT WING WALLS, CONCRETE TOPPING DETAILS
S-26	TYPICAL GUARDRAIL TO END POST CONNECTION DETAIL
S-27	METAL RAIL DETAILS, EXPANSION JOINT DETAILS
S-28	SERVICE STAIR DETAILS
S-29	SERVICE STAIR DETAILS
S-30	DECK ELEVATION LAYOUT PLAN, TYPICAL DECK DRAIN DETAIL
S-31	PRESTRESSED PLANK NOTES
S-32	MISCELLANEOUS DETAILS
S-33	FOUNDATION SECTIONS AND DETAILS
S-34	CATWALK PLAN & DETAILS AT ABUTMENT NO. 1 & NO. 2
S-35	MISCELLANEOUS DETAILS
S-36	PARTIAL PLAN, SECTIONS AND DETAILS

SUMMARY OF ESTIMATED QUANTITIES			
ITEM NO.	CONTRACT ITEM	QUANTITY	UNIT
202.0441	REMOVAL OF PORTION OF EXISTING CONCRETE STRUCTURE	(180)	(C.Y.) L.S.
202.0442	REMOVAL OF ASPHALT CONCRETE PAVEMENT	(7800)	(S.F.) L.S.
206.6000	STRUCTURE EXCAVATION FOR BRIDGE	6100	C.Y.
206.7000	STRUCTURE BACKFILL	800	C.Y.
206.7300	LOW-DENSITY CONCRETE BACKFILL	7250	C.Y.
206.7400	CLASS A CONCRETE BACKFILL	370	C.Y.
206.8000	FILTER MATERIAL	15	C.Y.
503.1092	CONCRETE IN BRIDGE (EXCLUDING ABUTMENT WALLS, WING WALLS, STAIRS, AND BRIDGE FOOTINGS)	(1550)	(C.Y.) L.S.
503.1093	CONCRETE IN ABUTMENT WALLS, WING WALLS, AND STAIRS (EXCLUDING BRIDGE FOOTINGS)	(1030)	(C.Y.) L.S.
503.1094	CONCRETE IN BRIDGE FOOTINGS	(1840)	(C.Y.) L.S.
504.0100	PRESTRESSED CONCRETE PLANKS	(4510)	(S.F.) L.S.
507.1501	METAL RAILING - TWO RAILS ON PARAPET FOR BRIDGE	690	L.F.
507.7001	CONCRETE PARAPET FOR BRIDGE (INCLUDING END POST)	735	L.F.
511.0020	LOAD TEST	1	EACH
511.0100	DRILLED SHAFT DS-1 - 48 INCH DIAMETER	960	L.F.
511.0101	DRILLED SHAFT DS-2 - 48 INCH DIAMETER	370	L.F.
511.0200	UNCLASSIFIED SHAFT EXCAVATION (DS-1 AND DS-2)	1330	L.F.
511.0300	UNCLASSIFIED EXTRA DEPTH EXCAVATION (DS-1 AND DS-2)	70	L.F.
511.0400	DRILLED SHAFT SIDEWALL OVERREAMING (DS-1 AND DS-2)	70	L.F.
511.0500	TRIAL SHAFT HOLES	57	L.F.
602.0091	REINFORCING STEEL IN BRIDGE (INCLUDING ABUTMENT WALLS, WING WALLS, STAIRS, AND BRIDGE FOOTINGS)	(1,050,000)	(LBS.) L.S.



ABBREVIATIONS

φ DIAMETER
NUMBER OR POUND
A.B. ANCHOR BOLT
A.C. ASPHALT CONCRETE
AZ. AZIMUTH
BOT., BOTT., B BOTTOM
C.J. CONSTRUCTION JOINT
Q CENTERLINE
C.G. CENTER OF GRAVITY
CLR., CL. CLEAR
CONC. CONCRETE
CONT. CONTINUOUS
C.Y. CUBIC YARD
DBL. DOUBLE
DET. DETAIL
D.I. DUCTILE IRON
DIA. DIAMETER
DN. DOWN
DWG. DRAWING
E.F. EACH FACE
E.J. EXPANSION JOINT
ELEV., EL. ELEVATION
E.W. EACH WAY
EXP. EXPANSION

F.B. FLAT BAR
F.F. FAR FACE
F.S. FAR SIDE
G GIRDER
GALV. GALVANIZED
G.J. GROOVED JOINT
HORIZ., H HORIZONTAL
IN. INCH
JT. JOINT
K KIPS
KSI KIPS PER SQUARE INCH
LB., LBS. POUND, POUNDS
L.F. LINEAR FEET
L.S. LUMP SUM
MAX. MAXIMUM
MIN. MINIMUM
NO., # NUMBER
N.F. NEAR FACE
N.T.S. NOT TO SCALE
O.C. ON CENTER

PCF POUNDS PER CUBIC FEET
PL., PL. PLATE
PSF POUNDS PER SQUARE FEET
PSI POUNDS PER SQUARE INCH
PVC. POLYVINYL CHLORIDE
R, RAD. RADIUS
REBAR REINFORCING BAR
REF. REFERENCE
REINF. REINFORCED, REINFORCING, REINFORCEMENT
R.O.W. RIGHT-OF-WAY
SHT. SHEET
SL. SLOPE
STA. STATION
STD. STANDARD
STIRR. STIRRUP
SYM., SYMM. SYMMETRICAL
THK., TH. THICK
TYP. TYPICAL
VERT., V VERTICAL
W/ WITH

FED. ROAD DIST. NO.	STATE	FED. AID PROJ. NO.	FISCAL YEAR	SHEET NO.	TOTAL SHEETS
HAWAII	HAW.	BR-019-2(38)	2002	44A	79

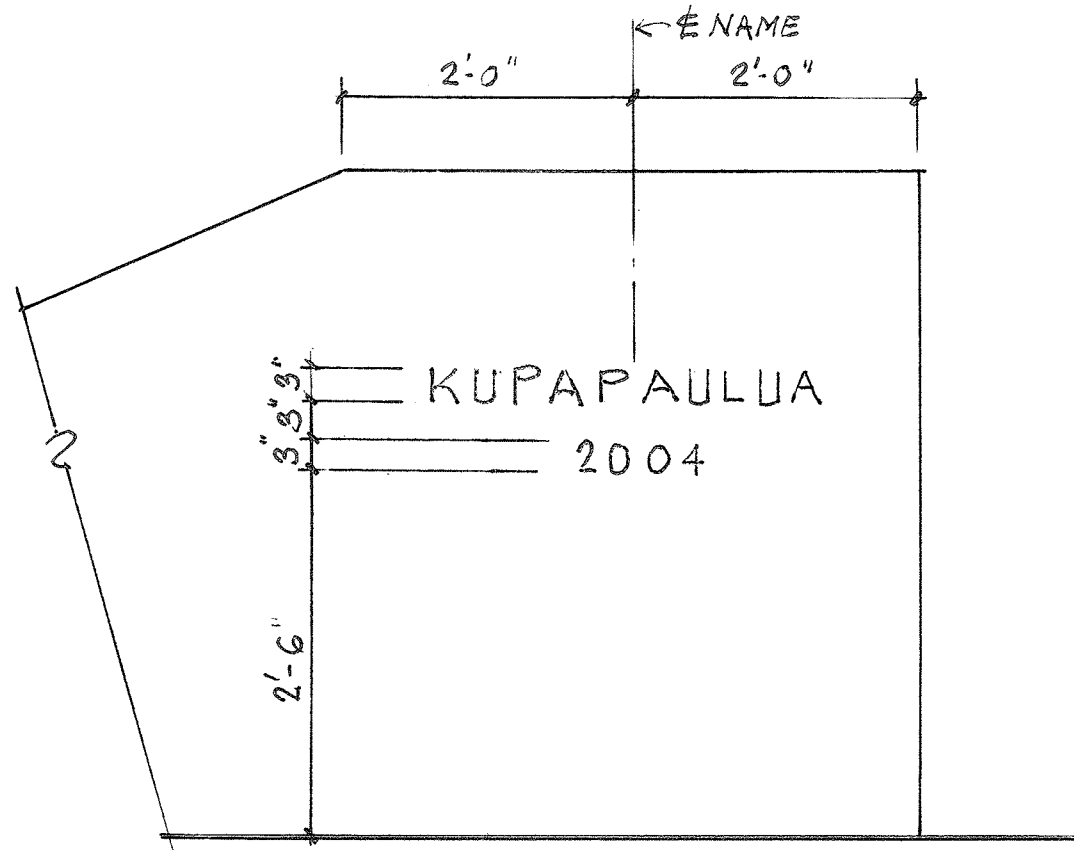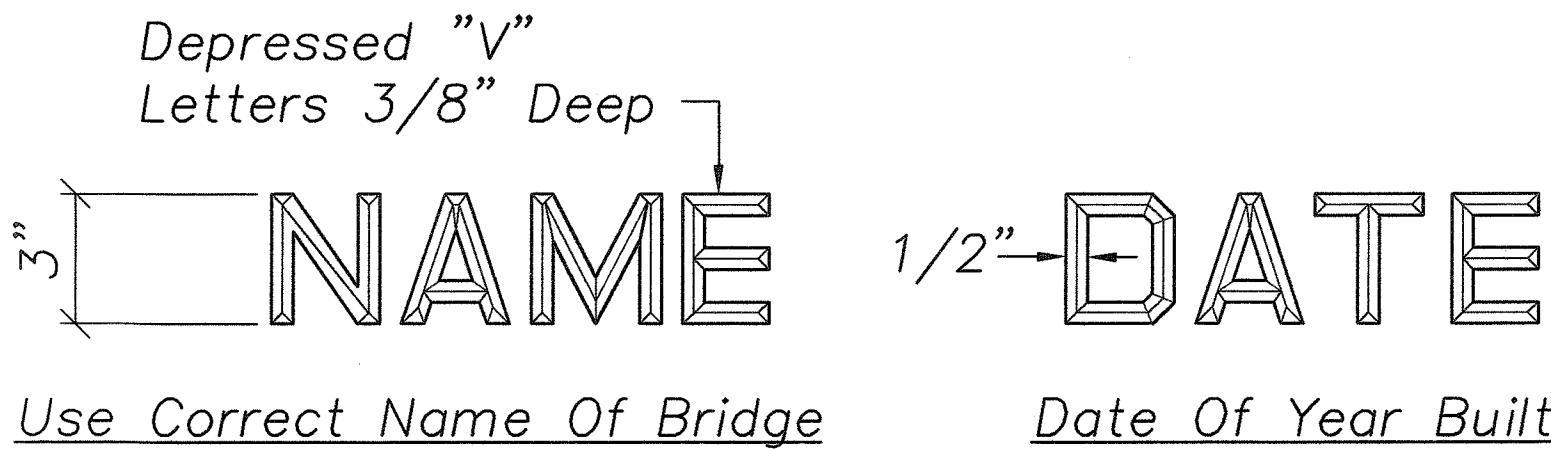


- Note:
- Name And Date Shall Be Placed At The Trailing End Post On Each Side Of The Roadway.
 - Exact Details And Spacing Of Letters And Figures And Location Shall Be As Directed By The Engineer. Gothic Letters And Figures Approximating Dimensions Shown Will Be Acceptable If Approved By The Engineer. See Adjacent Elevation.

ELEVATION N.T.S.

NOTE: Spacing between letters shall be such that it is legible, and concrete will not spall when removing form.

TYPICAL DETAIL OF LETTERS AND FIGURES AT CONCRETE END POST

Not To Scale

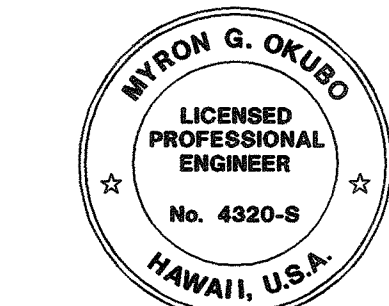

THIS WORK WAS PREPARED BY ME OR UNDER MY SUPERVISION

Myron Okubo

DATE	REVISION
STATE OF HAWAII DEPARTMENT OF TRANSPORTATION HIGHWAYS DIVISION INDEX TO DRAWINGS, ABBREVIATIONS, SUMMARY OF ESTIMATED QUANTITIES HAWAII BELT ROAD KUPAPAPULUA BRIDGE WIDENING HAMAKUA DISTRICT Federal Aid Project No. BR-019-2(38) Scale: As Noted Date: June 23, 2003	

SHEET No. S-1 OF 36 SHEETS

STRUCTURAL NOTES


FED. ROAD DIST. NO.	STATE	FED. AID PROJ. NO.	FISCAL YEAR	SHEET NO.	TOTAL SHEETS
HAWAII	HAW.	BR-019-2(38)	2002	45	73

1. GENERAL SPECIFICATIONS: HAWAII STANDARD SPECIFICATIONS FOR ROAD, BRIDGE, AND PUBLIC WORKS CONSTRUCTION, 1994, TOGETHER WITH SPECIAL PROVISIONS PREPARED FOR THIS CONTRACT.
2. DESIGN SPECIFICATIONS: AASHTO LRFD BRIDGE DESIGN SPECIFICATIONS, 2nd EDITION, 1998, INCLUDING SUBSEQUENT INTERIM SPECIFICATION.
3. LOADS:
- A. DEAD LOAD: AN ALLOWANCE OF 2 INCHES OF ASPHALT CONCRETE PAVEMENT HAS BEEN PROVIDED FOR IN THE DESIGN.
- B. LIVE LOAD: HL-93
- C. SEISMIC LOAD: ACCELERATION COEFFICIENT = 0.36
SEISMIC PERFORMANCE ZONE = 4
IMPORTANCE CATEGORY = CRITICAL BRIDGE
SOIL PROFILE TYPE I
- D. RAILING TEST LEVEL = TL-4
4. MATERIALS:
- A. ALL CONCRETE SHALL BE 4,000 PSI (AT 28 DAYS) MINIMUM, UNLESS OTHERWISE NOTED. THE MAXIMUM W/C RATIO SHALL BE 0.45.
- B. ALL REINFORCING STEEL SHALL CONFORM TO ASTM A615, GRADE 60, UNLESS OTHERWISE NOTED.
- C. ALL MISCELLANEOUS STEEL SHALL CONFORM TO ASTM A36 AND BE HOT-DIP GALVANIZED AFTER FABRICATION, UNLESS OTHERWISE NOTED.
- D. ALL PIPE SECTIONS SHALL CONFORM TO ASTM A53 (TYPE E), GRADE B, AND BE HOT-DIP GALVANIZED AFTER FABRICATION.
- E. ALL STRUCTURAL TUBE SECTIONS SHALL CONFORM TO ASTM A500, GRADE B, AND BE HOT-DIP GALVANIZED AFTER FABRICATION.
- F. ALL ANCHOR BOLTS SHALL CONFORM TO ASTM A307, GRADE A. ALL NUTS SHALL CONFORM TO ASTM A563, GRADE DH. ALL WASHERS, WHERE REQUIRED, SHALL CONFORM TO ASTM F436, TYPE 1. ALL BOLTS, NUTS, AND WASHERS SHALL BE HOT-DIP GALVANIZED AFTER FABRICATION, UNLESS OTHERWISE NOTED.
- G. ELASTOMERIC BEARING PADS SHALL BE 70 HARDNESS.
- H. LOW-DENSITY CONCRETE BACKFILL SHALL BE AN ENGINEERED FILL WITH A MAXIMUM WET PLASTIC DENSITY OF 35 PCF AND WITH A MINIMUM COMPRESSIVE STRENGTH (AT 28 DAYS) OF 50 PSI.
- J. TETRAGUARD AS20 SHRINKAGE REDUCING ADMIXTURE, OR AN APPROVED EQUAL, SHALL BE INCLUDED IN THE CONCRETE MIX FOR THE ARCH BEAMS, BEAMS, WIDENED BRIDGE DECK AND EDGE BEAMS, CONCRETE PARAPET, AND CONCRETE TOPPING. THE REQUIRED DOSAGE SHALL BE 96 OUNCES PER CUBIC YARD OF CONCRETE. ADDITION OF SHRINKAGE REDUCING ADMIXTURE SHALL BE AS RECOMMENDED BY THE MANUFACTURER.
5. REINFORCEMENT:
- A. UNLESS OTHERWISE NOTED, THE COVERING MEASURED FROM THE SURFACE OF THE CONCRETE TO THE FACE OF ANY REINFORCING BARS SHALL BE AS FOLLOWS:
1. DECK SLABS TOP AND BOTTOM BARS = 1-1/2" CLR
2. RAILINGS AND PARAPETS = 2" CLR
3. FORMED SURFACES EXPOSED TO EARTH AND WEATHER = 2" CLR
4. BOTTOM AND SIDES OF FOOTINGS AND WHERE CONCRETE DEPOSITED ON GRADE = 3" CLR
5. DRILLED SHAFTS = 3" CLR (TO SPIRALS)
- B. MINIMUM CLEAR SPACING BETWEEN PARALLEL BARS SHALL BE 1-1/2 TIMES THE DIAMETER OF THE BAR (FOR NON BUNDLED BARS) OR 1-1/2 TIMES THE DIAMETER DERIVED FROM THE EQUIVALENT TOTAL AREA OF THE BARS (FOR BUNDLED BARS), BUT IN NO CASE SHALL THE CLEAR DISTANCE BETWEEN THE PARALLEL BARS BE LESS THAN 1-1/2 TIMES THE MAXIMUM SIZE OF THE COARSE AGGREGATE OR 1-1/2 INCHES.
- C. ALL DIMENSIONS RELATING TO REINFORCING BARS (E.G. SPACING OF BARS, ETC.) ARE TO CENTER OF BARS, UNLESS OTHERWISE NOTED.
- D. ALL DIMENSIONS RELATING TO NEW REINFORCING BARS WERE DETERMINED BASED ON THE LOCATION OF THE EXISTING REINFORCING BARS AS INDICATED ON THE EXISTING DRAWINGS. CONTRACTOR SHALL VERIFY THE LOCATION OF ALL EXISTING REINFORCING BARS PRIOR TO DRILLING FOR EPOXY EMBEDMENT OF NEW REINFORCING BARS.
- E. EXISTING REINFORCING BARS SHALL NOT BE CUT, UNLESS OTHERWISE NOTED ON THE BRIDGE DEMOLITION PLANS.
- F. ALL DRILLED HOLES IN THE EXISTING STRUCTURE SHALL BE CLEANED, FILLED WITH EPOXY, AND REINFORCING BARS SET IN PLACE WITHIN AN EIGHT (8) HOUR WORK DAY
- G. ALL SPLICES IN REINFORCING BARS SHALL BE WITH A MECHANICAL CONNECTOR, UNLESS OTHERWISE NOTED.
- H. REINFORCING BARS SHALL BE DETAILED IN ACCORDANCE WITH ACI MANUAL OF STANDARD PRACTICE FOR DETAILING REINFORCED CONCRETE HIGHWAY STRUCTURES, UNLESS OTHERWISE NOTED.
- I. REINFORCING BARS SHALL BE SECURELY TIED AT ALL INTERSECTIONS AND LAP SPLICES EXCEPT WHERE THE SPACING OF INTERSECTIONS IS LESS THAN 12 INCHES IN EACH DIRECTION, IN WHICH CASE ALTERNATE INTERSECTIONS SHALL BE TIED.
6. GENERAL CONSTRUCTION NOTES:
- A. SEE STANDARD SPECIFICATIONS AND SPECIAL PROVISIONS.
- B. ALL ITEMS NOTED INCIDENTAL WILL NOT BE PAID FOR SEPARATELY.
- C. STANDARD DETAIL DRAWINGS REFER TO ALL STRUCTURES IN GENERAL, EXCEPT FOR MODIFICATIONS AS MAY BE REQUIRED FOR SPECIAL CONDITIONS. FOR SUCH MODIFICATIONS, REFER TO THE CORRESPONDING DETAILED DRAWINGS.
- D. THE CONTRACTOR SHALL COMPLY WITH ALL CONSTRUCTION PERMITS FOR THIS PROJECT. IN ADDITION, THE CONTRACTOR SHALL COMPLY WITH ALL APPLICABLE LAWS OF THE FEDERAL, STATE AND COUNTY GOVERNMENTS.

- E. IN THE EVENT THAT ANY UNANTICIPATED SITES OF REMAINS SUCH AS BONES OR CHARCOAL DEPOSITS, HUMAN BURIALS, ROCK OR CORAL ALIGNMENTS, PAVINGS OR WALLS ARE ENCOUNTERED, THE CONTRACTOR SHALL STOP WORK IN THE AREA OF THE FIND AND CONTACT THE RESIDENT ENGINEER IMMEDIATELY. IN ADDITION, THE STATE HISTORIC PRESERVATION DIVISION SHALL BE CONTACTED IMMEDIATELY AT (808) 692-8015. WORK MAY RECOMMENCE ONLY WITH THE ENGINEER'S APPROVAL.
- F. UNLESS OTHERWISE NOTED, ALL VERTICAL DIMENSIONS ARE MEASURED PLUMB.
- G. THE CONTRACTOR SHALL VERIFY ALL SITE CONDITIONS BEFORE COMMENCING WITH WORK.
- H. THE CONTRACTOR SHALL VERIFY THE LOCATION OF ALL UNDERGROUND UTILITY LINES AND NOTIFY THE RESPECTIVE OWNERS BEFORE COMMENCING THE WORK OF EXCAVATION OR DRILLED SHAFTS. THE CONTRACTOR SHALL VERIFY THE LOCATION AND AVOID ALL OVERHEAD UTILITY LINES DURING CONSTRUCTION. THE CONTRACTOR MAY RELOCATE AND REPLACE THE OVERHEAD UTILITY LINES, IF DEEMED NECESSARY, AT NO COST TO THE STATE.
- I. THE CONTRACTOR SHALL REFER TO THE EXISTING DRAWINGS FOR THE APPROXIMATE LOCATION AND SIZE OF ALL EXISTING REINFORCING BARS PRIOR TO DRILLING.
- J. THE CONTRACTOR SHALL OFFSET NEW REINFORCING BARS AS REQUIRED TO AVOID EXISTING REINFORCING BARS.
- K. FOR CONCRETE FINISH, SEE STANDARD SPECIFICATIONS.
- L. UNLESS OTHERWISE NOTED, ALL EXPOSED CONCRETE EDGES SHALL BE CHAMFERED 3/4" X 3/4".
- M. WHERE NEW REINFORCING BARS TERMINATE AT THE EXISTING STRUCTURE, DRILL AND EPOXY REINFORCING BARS INTO EXISTING WITH 12 INCHES MINIMUM EMBEDMENT, UNLESS OTHERWISE NOTED.
- N. DRILLED HOLES IN EXISTING CONCRETE SHALL BE CLEANED, FILLED WITH EPOXY, AND REINFORCING BAR SET IN PLACE WITHIN AN EIGHT (8) HOUR WORK DAY.
- O. ELASTOMERIC BEARING PADS SHALL BE SECURED TO THE CONCRETE BEARING SURFACE WITH ADHESIVES OR OTHER MEANS NECESSARY AS APPROVED BY THE ENGINEER.
- P. FINISH GRADES SHOWN ON THE PLANS ARE FOR BIDDING PURPOSES ONLY. CONTRACTOR SHALL VERIFY AND SUBMIT THE GRADES FOR THE EXISTING CONCRETE DECK TO THE ENGINEER SO THAT FINAL FINISH GRADES MAY BE VERIFIED.
- Q. NEW DECK SLAB AND CONCRETE TOPPING SHALL NOT BE OPEN TO TRAFFIC UNTIL CONCRETE HAS ATTAINED ITS DESIGN STRENGTH, BUT NOT LESS THAN 7 DAYS.
7. SURFACE PREPARATION OF EXISTING CONCRETE:
- A. ALL EXISTING CONCRETE SURFACES WHERE FRESH CONCRETE IS TO BE PLACED AGAINST SHALL BE ROUGHENED BY SAND-BLASTING ONLY. ONLY IMMEDIATE SURFACE NEEDS TO BE REMOVED SUCH THAT SURFACE IS NOT SMOOTH.
- B. PRIOR TO PLACEMENT OF REINFORCING STEEL AND FRESH CONCRETE, EXISTING CONCRETE SURFACES SHALL BE CLEANED AND FREE OF LAITANCE.
- C. EXISTING CONCRETE SURFACES SHALL BE DAMPENED WITH CLEAN POTABLE WATER PRIOR TO PLACEMENT OF FRESH CONCRETE. HOWEVER, FRESH CONCRETE SHALL NOT BE PLACED IN FREESTANDING OR PUDDLED WATER.
- D. EXISTING CONCRETE SURFACES TO RECEIVE AN EPOXY BONDING ADHESIVE PRIOR TO PLACEMENT OF FRESH CONCRETE SHALL BE PREPARED AS RECOMMENDED BY THE MANUFACTURER.
8. CONSTRUCTION OF ABUTMENT FOOTINGS:
- A. EXISTING FOOTINGS AND BENCHED CUT-SLOPES SHALL BE BRACED DURING EXCAVATION AND BACKFILL. BRACING SUCH AS SHEETPIILING, GUNITE AND SOIL NAILING, ETC. SHALL BE THE RESPONSIBILITY OF THE CONTRACTOR AND SHALL BE DESIGNED AND STAMPED BY A LICENSED PROFESSIONAL ENGINEER IN THE STATE OF HAWAII. COSTS SHALL BE BORNE BY THE CONTRACTOR.
- B. CONSTRUCT BOTTOM HALF OF ABUTMENT FOOTING AS SHOWN ON THE PLANS.
- C. PRIOR TO POURING TOP HALF OF ABUTMENT FOOTING, APPLY EPOXY BONDING ADHESIVE TO THE CONCRETE SURFACE.
9. PLACEMENT OF REINFORCING TIES IN EXISTING ARCH BEAMS:
- A. PLACEMENT OF REINFORCING TIES SHALL BE SUCH THAT THE BEND IN THE TIES ARE IN CONTACT WITH THE MAIN REINFORCING BARS OF THE ARCH BEAM. REFER TO "TYPICAL TIE DETAIL" A/S-16 FOR CLARIFICATION.
- B. ONLY TWO (2) ADJACENT FACES OF EXISTING ARCH BEAMS SHALL BE DRILLED AT A TIME FOR DRILL AND EPOXY PLACEMENT OF REINFORCING TIES.
- C. DRILLED HOLES IN EXISTING ARCH BEAMS SHALL BE CLEANED, FILLED WITH EPOXY, AND REINFORCING TIES SET IN PLACE WITHIN AN EIGHT (8) HOUR WORK DAY.
10. DEMOLITION OF EXISTING SIDEWALK AND RAILINGS:
- A. REMOVAL OF EXISTING SIDEWALK AND RAILINGS SHALL BE AS SHOWN ON THE DRAWINGS.
- B. PRIOR TO REMOVAL OF EXISTING SIDEWALK AND RAILINGS OVER ARCH BEAM PORTION OF BRIDGE, EXISTING END GIRDERS AND ADJACENT DECK SLABS SHALL BE SHORED. SHORING MAY BE FROM NEW BUILT-UP ARCH BEAMS BELOW AND SHALL REMAIN UNTIL COMPLETION OF NEW WIDENED DECK.
- C. EXISTING SIDEWALK AND RAILINGS AT ABUTMENT ENDS OF BRIDGE SHALL NOT BE REMOVED UNTIL ABUTMENT BACKFILL HAS BEEN COMPLETED.
11. FOUNDATION:
- THESE FOUNDATION NOTES WERE BASED ON RECOMMENDATIONS CONTAINED IN A FOUNDATION INVESTIGATION REPORT BY ERNEST K. HIRATA & ASSOCIATES, INC. DATED JUNE 2, 1999. THE REPORT SHALL BE CONSIDERED AS PART OF THE CONSTRUCTION DOCUMENTS AND ITS RECOMMENDATIONS SHALL BE IMPLEMENTED UNLESS OTHERWISE DIRECTED BY THE SOILS ENGINEER. CONTRACTOR MAY OBTAIN A COPY OF THE REPORT AT THE STATE OF HAWAII, DEPARTMENT OF TRANSPORTATION -HIGHWAYS DIVISION UPON REQUEST.

- A. DRILLED SHAFTS:
1. THE VERTICAL BEARING LOAD CAPACITY FOR THE 48 INCHES DIAMETER DRILLED SHAFTS ARE FROM FRICTION BETWEEN THE SHAFT AND THE SURROUNDING SOIL AND BASALT. THE FOLLOWING NET VERTICAL BEARING LOAD PARAMETERS WERE USED FOR DESIGN:
- A. ABUTMENT FOOTINGS (DS-1):
- STRENGTH LIMIT STATE = 2850 KIPS
- EXTREME EVENT LIMIT STATE = 4400 KIPS
- B. WING WALL FOOTINGS (DS-2):
- STRENGTH LIMIT STATE = 1500 KIPS
- EXTREME EVENT LIMIT STATE = 2300 KIPS
2. THE VERTICAL UPLIFT LOAD CAPACITY FOR THE 48 INCHES DIAMETER DRILLED SHAFTS ARE FROM FRICTION BETWEEN THE SHAFT AND THE SURROUNDING SOIL AND BASALT. THE FOLLOWING NET VERTICAL UPLIFT LOAD PARAMETERS WERE USED FOR DESIGN:
- A. ABUTMENT FOOTINGS (DS-1):
- STRENGTH LIMIT STATE = -2400 KIPS
- EXTREME EVENT LIMIT STATE = -4400 KIPS
- B. WING WALL FOOTINGS (DS-2):
- STRENGTH LIMIT STATE = -1300 KIPS
- EXTREME EVENT LIMIT STATE = -2300 KIPS
3. THE FOLLOWING LATERAL LOAD CAPACITIES FOR 48 INCH DRILLED SHAFTS (FIXED-HEAD CONDITION) WERE USED FOR DESIGN:
- A. ABUTMENT FOOTINGS (DS-1) = 320 KIPS
- B. WING WALL FOOTINGS (DS-2) = 208 KIPS
4. THE DRILLED SHAFT ESTIMATED TIP ELEVATIONS SHOWN ON THE PLANS ARE BASED ON THE BORING DATA. THE ACTUAL TIP ELEVATIONS COULD CHANGE DUE TO VARYING SUBSURFACE CONDITIONS. SOILS ENGINEER OF RECORD SHALL BE PRESENT DURING THE DRILLING OPERATION TO DETERMINE THAT THE ACTUAL SUBSURFACE CONDITIONS ARE CONSISTENT WITH THE CONDITIONS ASSUMED FOR DESIGN. BASED ON THE RECOMMENDATIONS, THE TIP ELEVATIONS COULD CHANGE. THE CONTRACTOR SHALL MAKE PROVISIONS FOR EXTENSION OF THE REINFORCING STEEL CAGES FOR THE DRILLED SHAFTS TO ACCOUNT FOR VARIATIONS IN THE FINAL TIP ELEVATIONS.
5. THE CONTRACTOR SHALL EXERCISE CARE IN DRILLING THE SHAFT HOLES AND IN PLACING CONCRETE INTO THE HOLES. ROCK DRILLING/CORING EQUIPMENT WILL BE REQUIRED FOR DRILLED SHAFTS EXTENDING THROUGH HARD BASALT LAYERS. TEMPORARY CASING MAY BE NEEDED TO REDUCE THE POTENTIAL FOR CAVING IN OF THE HOLES. THE USE OF PERMANENT CASING WILL NOT BE ALLOWED.
6. DRILLING SHALL NOT BE CONDUCTED BY METHODS UTILIZING DRILLING FLUIDS.
7. CONCRETE FOR DRILLED SHAFTS SHALL BE PLACED WITHIN 24 HOURS AFTER DRILLING TO REDUCE THE POTENTIAL FOR CAVING IN. DRILLED SHAFTS SHALL BE POURED IN ONE CONTINUOUS LIFT.
8. IF WATER IS ENCOUNTERED IN THE DRILLED HOLES, PLACEMENT OF CONCRETE SHALL BE BY TREMIE METHODS. A MINIMUM OF 5 FEET OF CONCRETE HEAD SHALL BE MAINTAINED ABOVE THE BOTTOM OF THE TREMIE PIPE DURING PLACEMENT OF CONCRETE.
- B. ABUTMENTS AND WING WALLS:
1. ACTIVE EARTH PRESSURE:
- A. FREESTANDING CONDITION:
- CLAYEY SILT = 40 PCF
- HIGHLY TO COMPLETELY WEATHERED BASALT = 25 PCF
- MODERATELY TO SLIGHTLY WEATHERED BASALT = 20 PCF
- B. RESTRAINED CONDITION:
- CLAYEY SILT = 55 PCF
- HIGHLY TO COMPLETELY WEATHERED BASALT = 38 PCF
- MODERATELY TO SLIGHTLY WEATHERED BASALT = 35 PCF
2. PASSIVE EARTH PRESSURE:
- A. CLAYEY SILT = 300 PCF
- B. HIGHLY TO COMPLETELY WEATHERED BASALT = 420 PCF
- C. MODERATELY TO SLIGHTLY WEATHERED BASALT = 950 PCF
3. BACKFILL AND STRUCTURAL FILL MATERIAL:
- A. IN AREAS TO RECEIVE FILL PLACEMENT, THE EXISTING GROUND SHALL FIRST BE SCARIFIED TO A DEPTH OF 6 INCHES, MOISTENED TO SLIGHTLY ABOVE THE OPTIMUM MOISTURE CONTENT, AND COMPACTED TO A MINIMUM 90 PERCENT COMPACTION AS DETERMINED BY AASHTO T-180.
- B. THE ONSITE CLAYEY SILT AND HIGHLY TO COMPLETELY WEATHERED BASALT MAY BE REUSED AS BACKFILL AND STRUCTURAL FILL PROVIDED ALL ROCK FRAGMENTS LARGER THAN 6 INCHES IN MAXIMUM DIMENSION ARE REMOVED PRIOR TO COMPACTION.
- C. IMPORTED GRANULAR STRUCTURAL FILL SHALL BE IN ACCORDANCE WITH REQUIREMENTS FOR STRUCTURAL BACKFILL MATERIAL A AS INDICATED IN SECTION 703.20 OF THE HAWAII STANDARD SPECIFICATIONS FOR ROAD, BRIDGE AND PUBLIC WORKS CONSTRUCTION, 1994 AND THE SPECIAL PROVISIONS.
- D. FILL PLACEMENT SHALL BE IN ACCORDANCE WITH THE HAWAII STANDARD SPECIFICATIONS FOR ROAD, BRIDGE AND PUBLIC WORKS CONSTRUCTION, 1994 AND THE SPECIAL PROVISIONS.

ORIGINAL PLAN	DATE	SURVEY PLOTTED BY
NOTE BOOK		
DESIGNED BY		
QUANTITIES BY		
CHECKED BY		

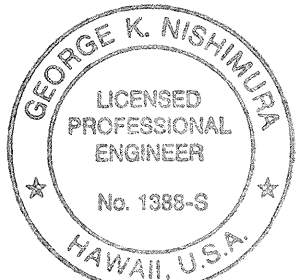

THIS WORK WAS PREPARED BY
ME UNDER MY SUPERVISION.

STATE OF HAWAII
DEPARTMENT OF TRANSPORTATION
HIGHWAYS DIVISION
STRUCTURAL NOTES

HAWAII BELT ROAD
KUPAPAUULA BRIDGE WIDENING
HAMAKUA DISTRICT
Federal Aid Project No. BR-019-2(38)


SCALE: AS NOTED DATE: OCT., 2001

SHEET No. S-2 OF 30 SHEETS

FED. ROAD DIST. NO.	STATE	FED. AID PROJ. NO.	FISCAL YEAR	SHEET NO.	TOTAL SHEETS
HAWAII	HAW.	BR-019-2(38)	2002	ADD. 46	73


CONSTRUCTION SEQUENCE

- REMOVE EXISTING A.C. PAVEMENT BY COLD-PLANING AND VERIFY EXISTING CONCRETE BRIDGE DECK GRADES. CONTRACTOR SHALL SUBMIT EXISTING GRADES TO THE ENGINEER SO THAT FINAL FINISH GRADES MAY BE VERIFIED.
- CONSTRUCT DRILLED SHAFTS.
- CONSTRUCT CURTAIN WALLS AND BACKFILL TO BOTTOM OF ABUTMENT FOOTINGS.
- CONSTRUCT ABUTMENT FOOTINGS.
 - CONSTRUCTION OF ABUTMENT FOOTINGS SHALL BE AS INDICATED IN THE STRUCTURAL NOTES-8.
- CONSTRUCT WING WALL FOOTINGS.
- CONSTRUCT ABUTMENT WALLS, WING WALLS, AND SERVICE STAIRS CONCURRENTLY WITH THE PLACEMENT OF CONCRETE BACKFILL.
 - AT NO TIME SHALL ABUTMENT AND WING WALLS BE MORE THAN 6'-0" ABOVE THE CONCRETE BACKFILL.
 - THREADED ROD TIE BACKS IN WING WALLS SHALL BE INSTALLED PRIOR TO PLACEMENT OF CONCRETE BACKFILL.
 - DRAINAGE BLANKETS SHALL BE PROVIDED BETWEEN THE LOW-DENSITY CONCRETE BACKFILL AND THE BENCHED CUT-SLOPE.
 - LOW-DENSITY CONCRETE BACKFILL SHALL BE POURED AT A MAXIMUM RATE OF 3'-0" PER DAY.
 - TOP 2'-0" OF CLASS A CONCRETE BACKFILL SHALL BE POURED 120 DAYS AFTER LAST POUR OF LOW-DENSITY CONCRETE BACKFILL.
- CONSTRUCT BUILT-UP ARCH BEAMS.
 - PLACEMENT OF REINFORCING TIES IN EXISTING ARCH BEAMS SHALL BE AS INDICATED IN STRUCTURAL NOTES-9.
 - CONSTRUCTION WORK ON ARCH BEAMS SHALL BE IN THE FOLLOWING CONCRETE POUR SEQUENCE:

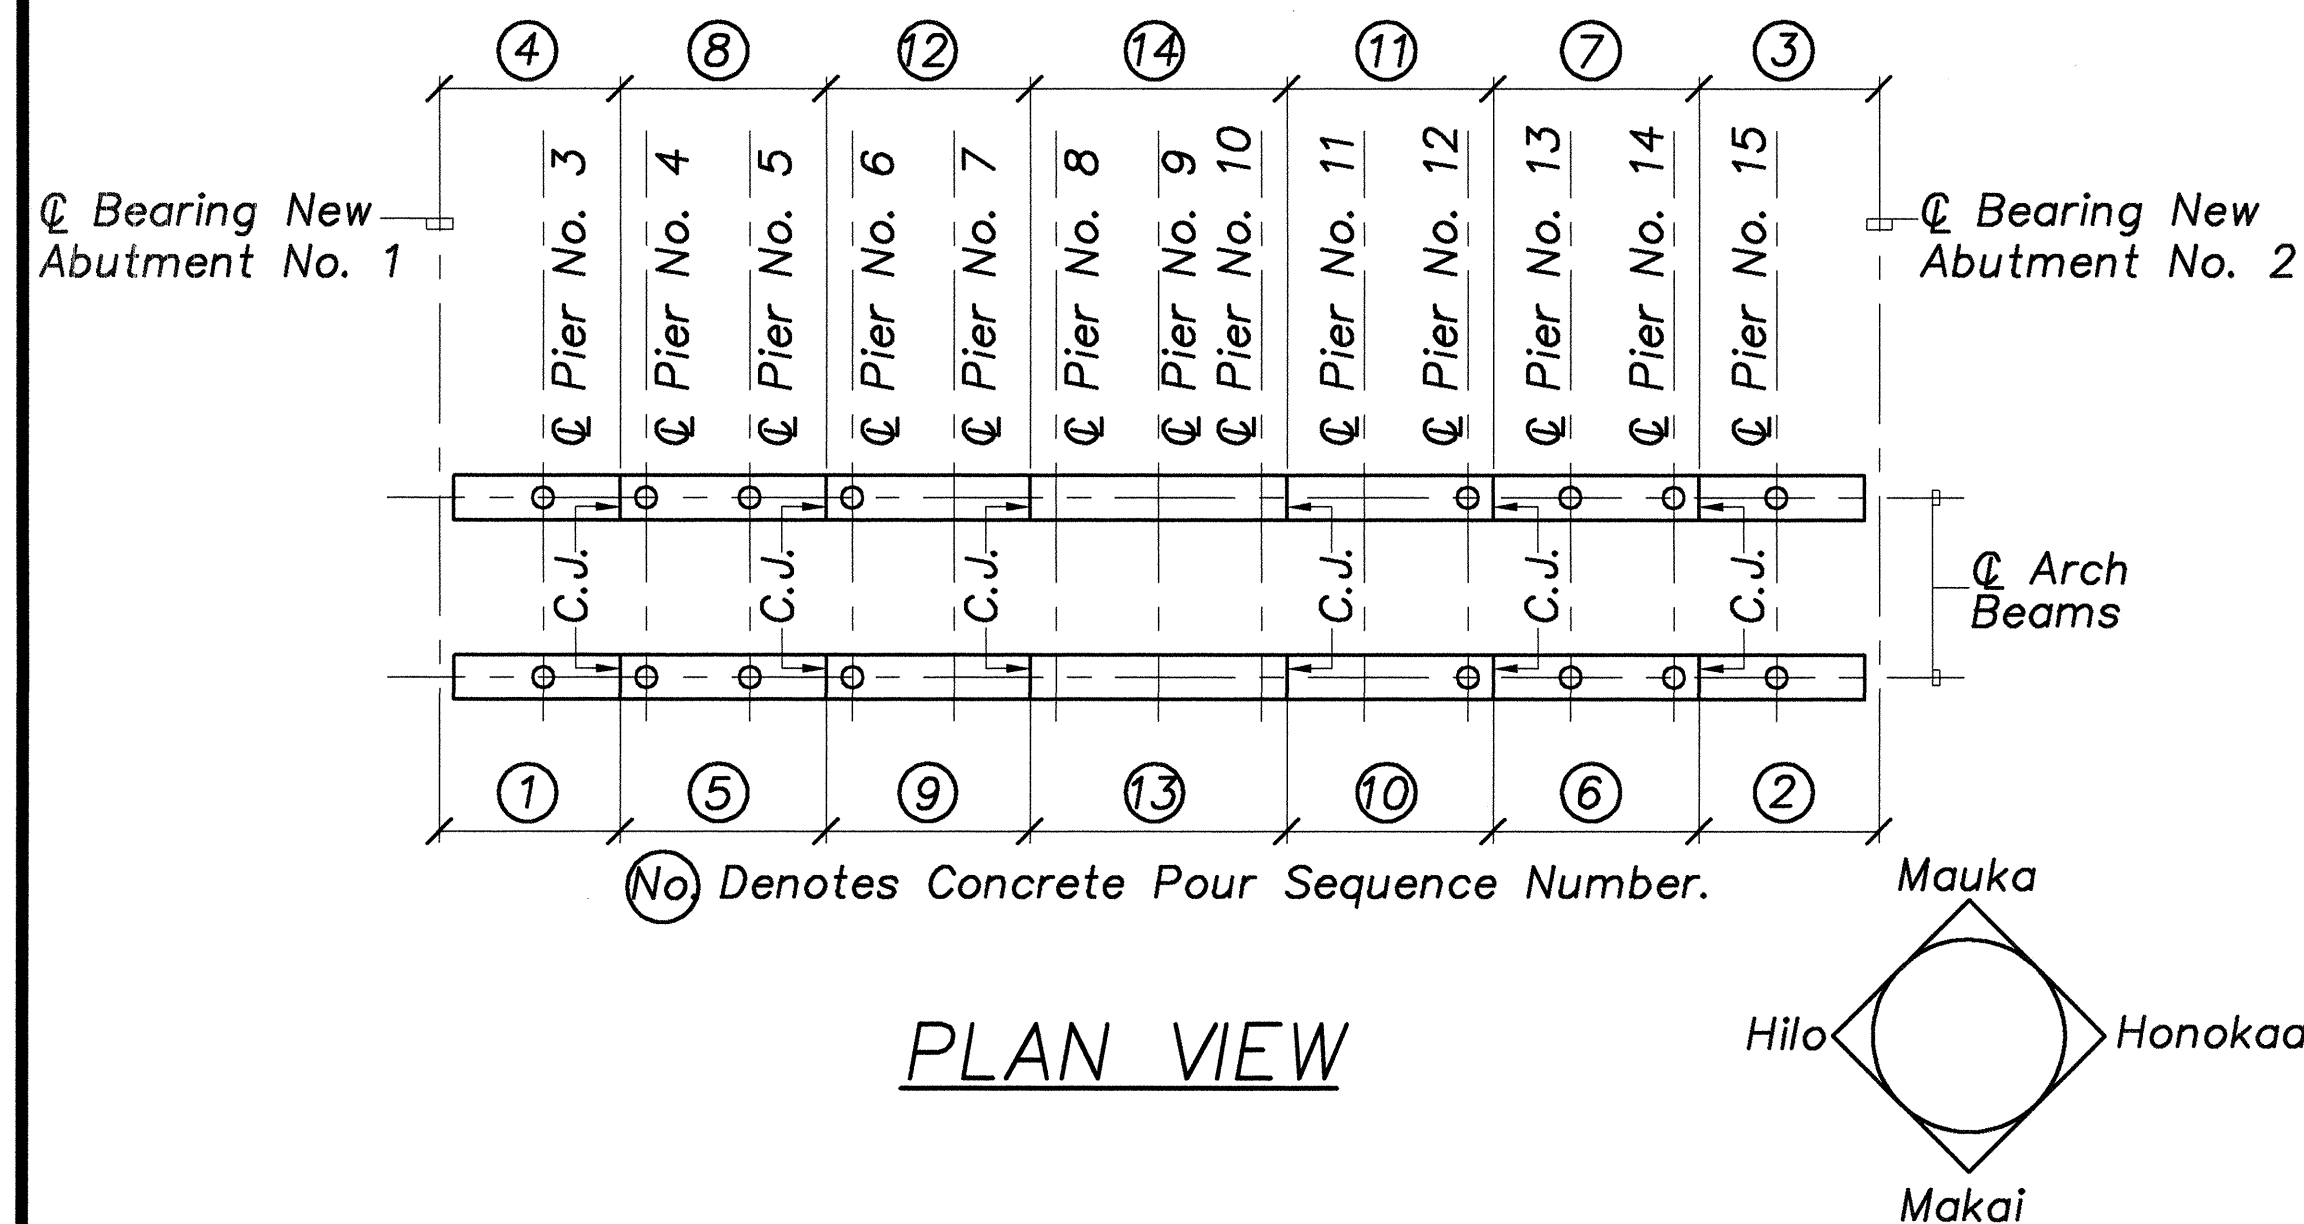

PLAN VIEW


- CONCRETE POURS SHALL BE TO CONSTRUCTION JOINT (C.J.) AS SHOWN ON SHEET S-17.
 - CONSECUTIVE CONCRETE POUR SEQUENCES MAY BE COMBINED. HOWEVER, PREVIOUSLY PLACED CONCRETE SHALL BE ALLOWED TO CURE FOR A MINIMUM OF 24 HOURS PRIOR TO COMING INTO CONTACT WITH NEW FRESH CONCRETE.
- CONSTRUCT BUILT-UP COLUMNS.
 - CONSTRUCT EXTENDED BEAMS.
 - CONSTRUCTION OF BEAMS SHALL BE TO CONSTRUCTION JOINT (C.J.) AS SHOWN ON SHEET S-21.
 - CONSTRUCT NEW DECK SLAB ON "MAKAI SIDE."
 - DEMOLITION OF EXISTING SIDEWALK AND RAILINGS SHALL BE AS SHOWN ON THE "EXISTING BRIDGE DEMOLITION PLANS" ON SHEET S-5 AND S-6. REFER TO STRUCTURAL NOTES-10 FOR CONSTRUCTION REQUIREMENTS PRIOR TO DEMOLITION.
 - CONSTRUCTION WORK ON NEW WIDENED PORTION OF SLAB SHALL BE IN THE FOLLOWING SEQUENCE:

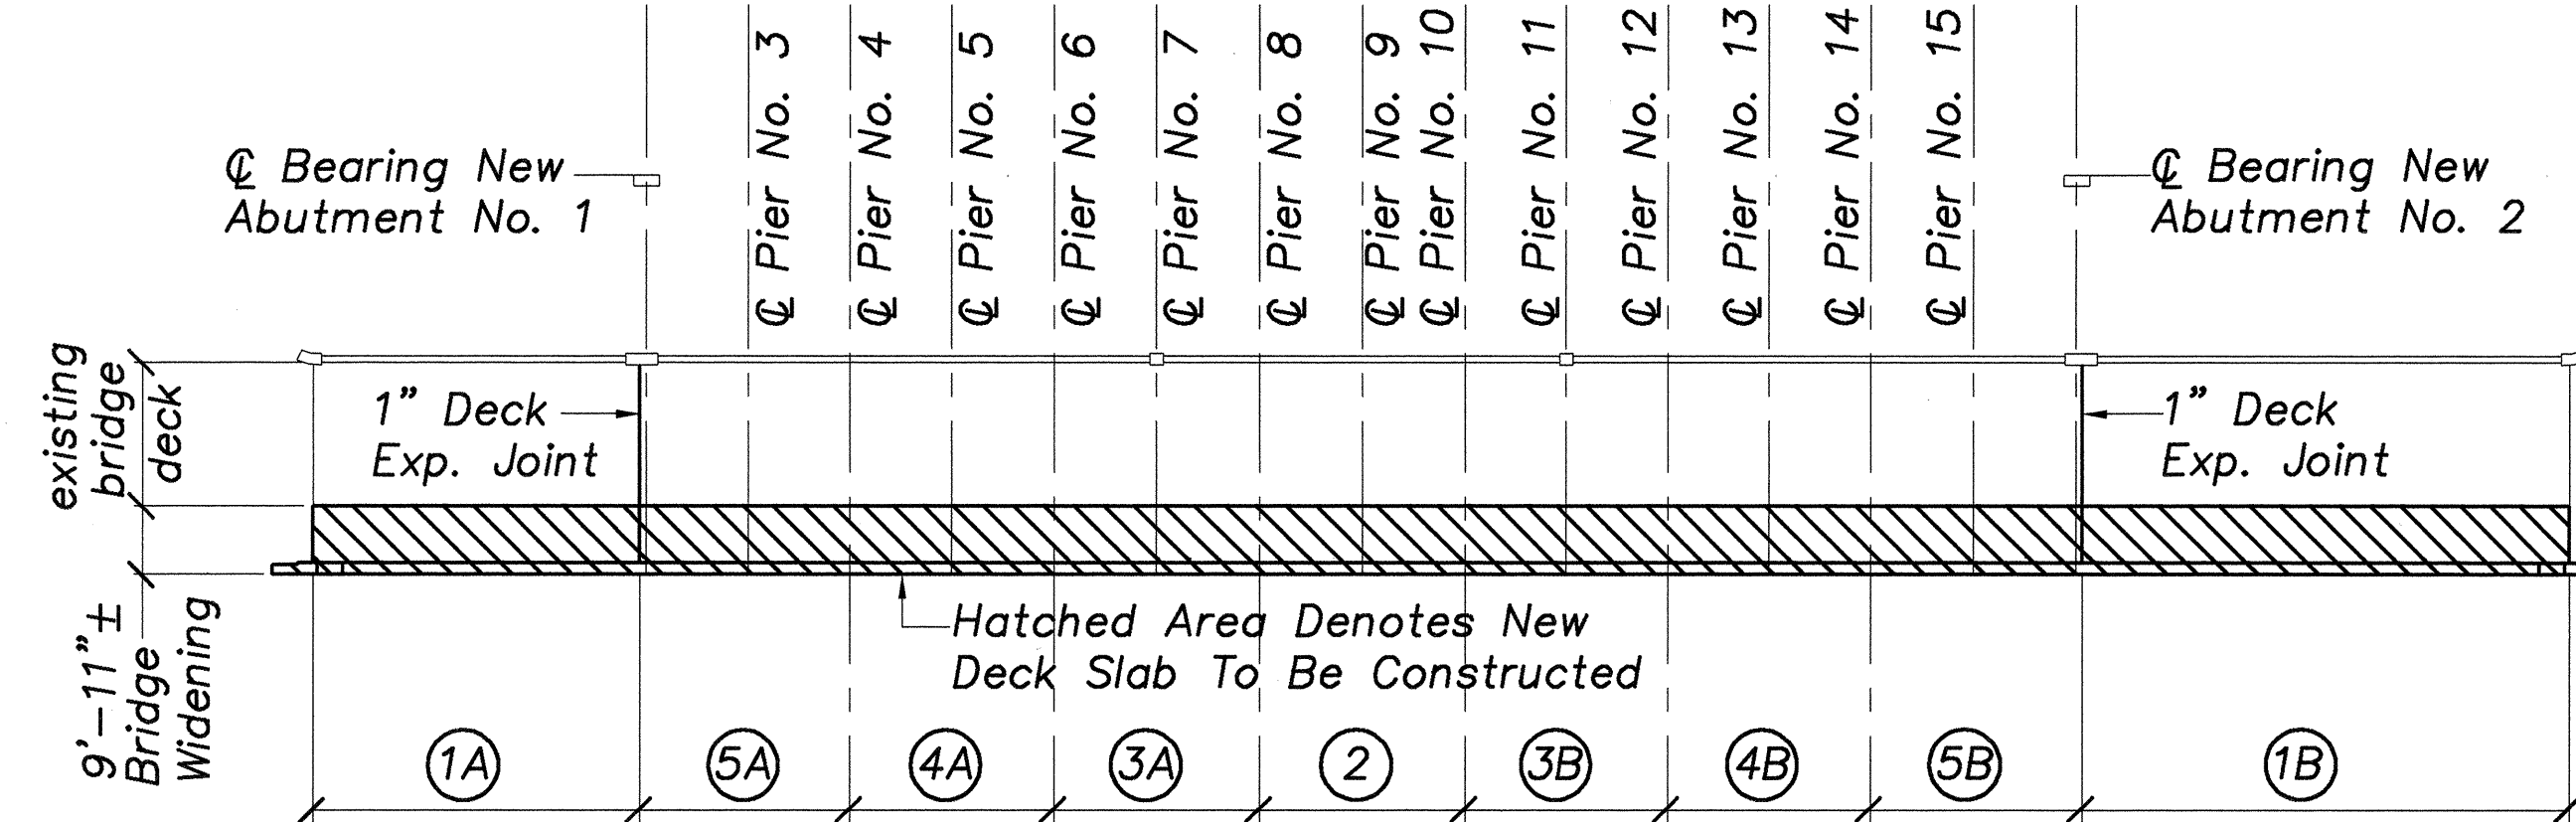

(No) Denotes Concrete Pour Sequence Number.

PLAN VIEW


- MINIMUM TIME INTERVAL BETWEEN CONCRETE POUR SEQUENCES SHALL BE 24 HOURS.
- CONSTRUCT CONCRETE PARAPET, METAL RAIL, AND END POSTS ON "MAKAI SIDE."
 - CONSTRUCT NEW DECK SLAB ON "MAUKA SIDE."
 - DEMOLITION OF EXISTING RAILINGS SHALL BE AS SHOWN ON THE "EXISTING BRIDGE DEMOLITION PLANS" ON SHEET S-5 AND S-6. REFER TO STRUCTURAL NOTES-10 FOR CONSTRUCTION REQUIREMENTS PRIOR TO DEMOLITION.
 - CONSTRUCTION WORK ON NEW WIDENED PORTION OF SLAB SHALL BE IN THE FOLLOWING SEQUENCE:

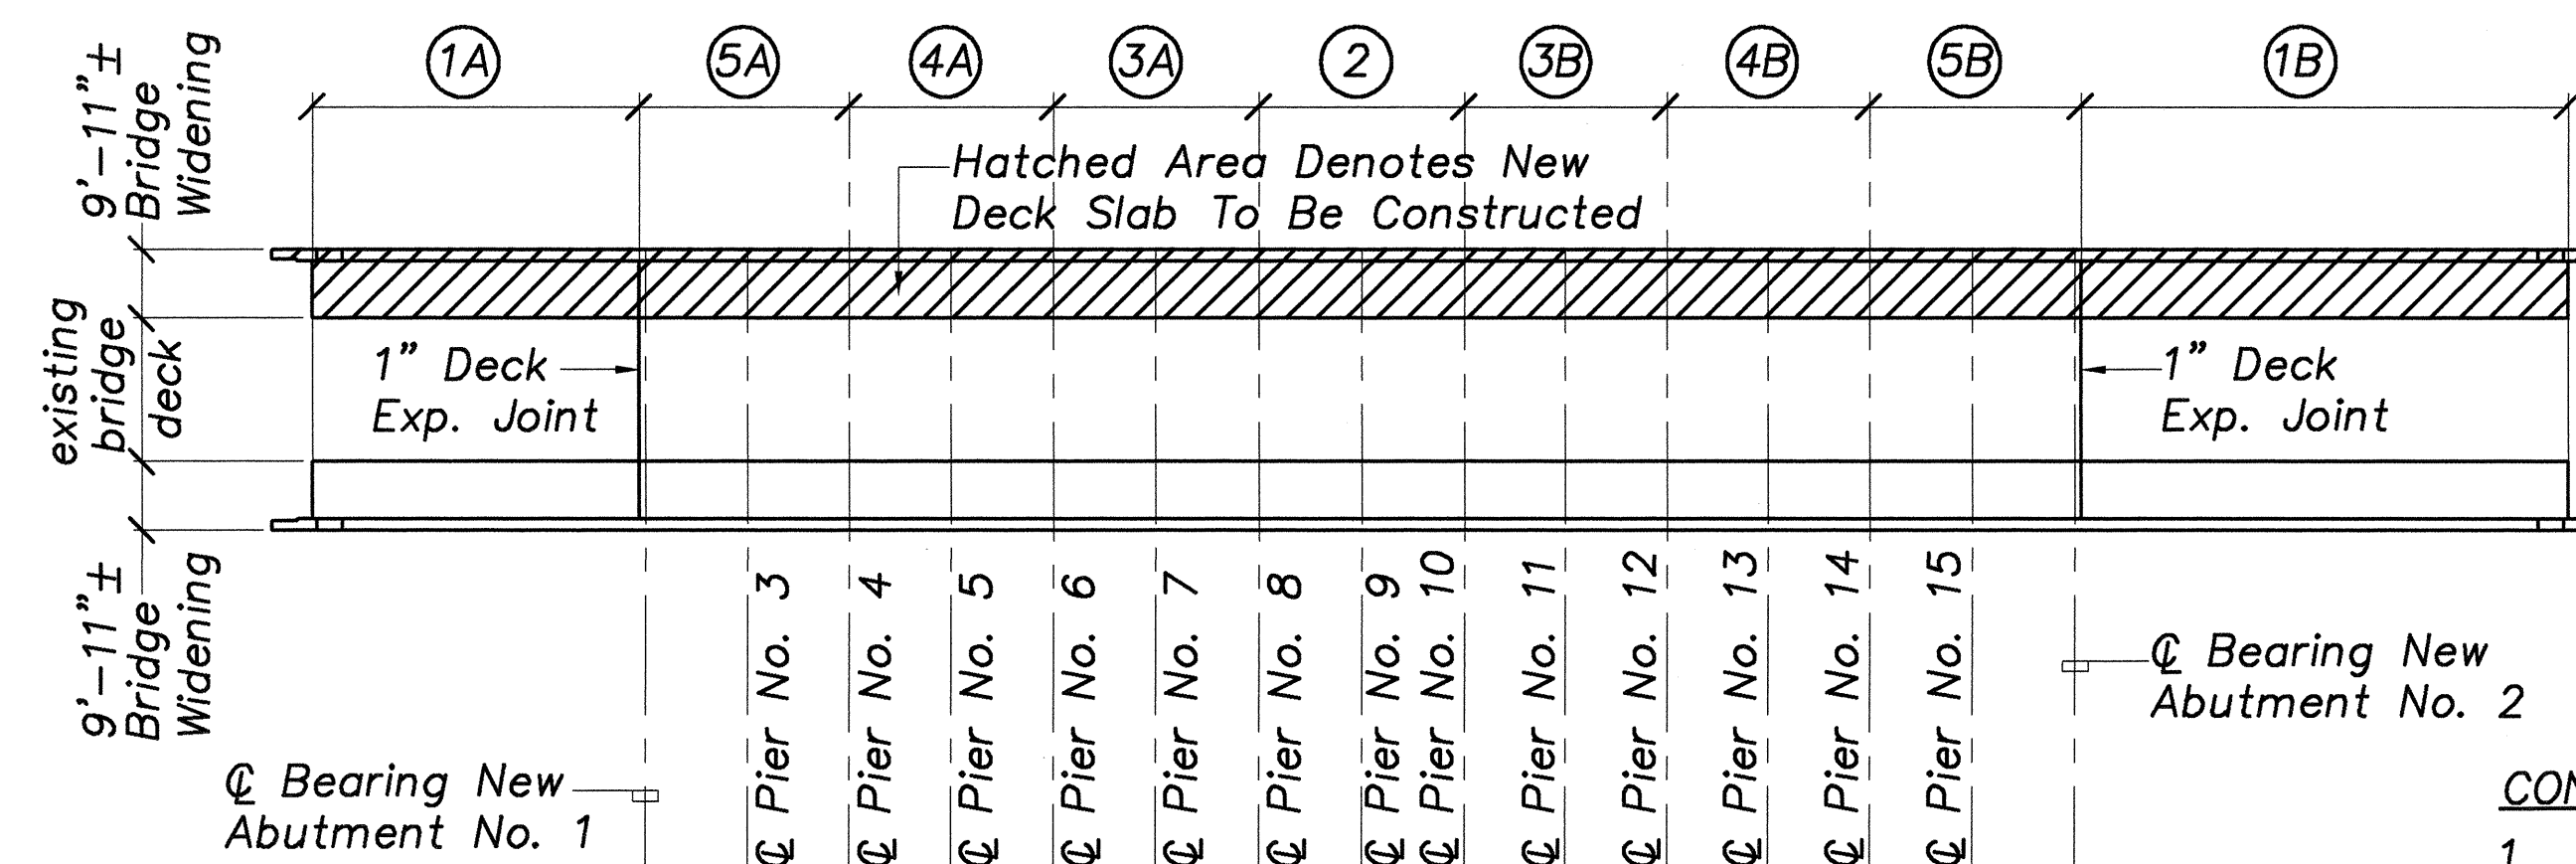

(No) Denotes Concrete Pour Sequence Number.

PLAN VIEW


- MINIMUM TIME INTERVAL BETWEEN CONCRETE POUR SEQUENCES SHALL BE 24 HOURS.
- CONSTRUCT CONCRETE PARAPET, METAL RAIL, AND END POSTS ON "MAUKA SIDE."
 - CONSTRUCT NEW CONCRETE TOPPING.
 - PRIOR TO PLACEMENT OF NEW CONCRETE TOPPING, APPLY EPOXY BONDING ADHESIVE TO EXISTING SURFACE.
 - NEW CONCRETE TOPPING SHALL BE POURED IN THE FOLLOWING SEQUENCE:

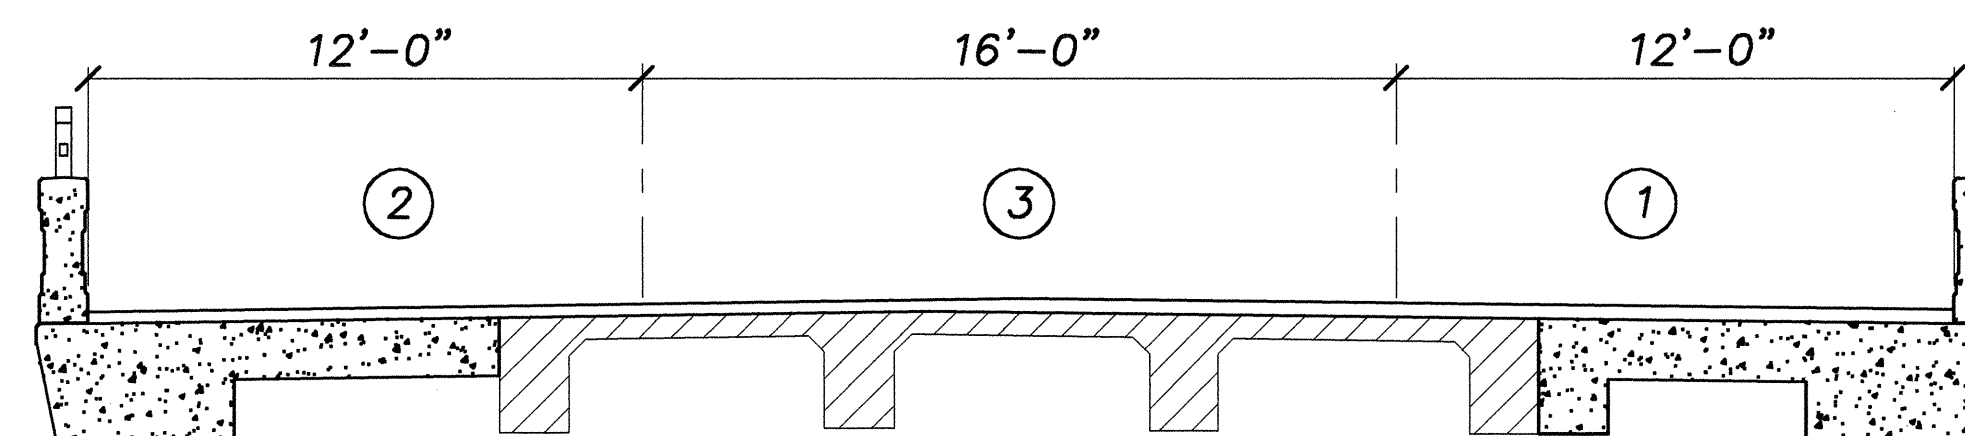

(No) Denotes Concrete Pour Sequence Number.

DECK SECTION

- INSTALL NEW DECK EXPANSION JOINTS AT NEW ABUTMENT NO. 1 AND NO. 2. REFER TO SHEET S-27 FOR DETAILS.

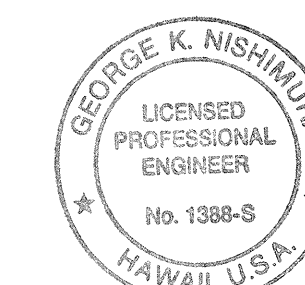






THIS WORK WAS PREPARED BY ME OR UNDER MY SUPERVISION
Signature: [Signature]
08/30/09
Expiration Date of Professional License

CONSTRUCTION SEQUENCE NOTES:

- CONSTRUCTION WORK ON STEP (6) AND STEPS (7) THRU (9) MAY BE DONE CONCURRENTLY.
- CONSTRUCTION WORK ON STEP (10) SHALL NOT BEGIN UNTIL STEPS (1) THRU (9) HAVE BEEN COMPLETED.
- NEW DECK SLAB AND CONCRETE TOPPING SHALL NOT BE OPEN TO TRAFFIC UNTIL CONCRETE HAS ATTAINED ITS DESIGN STRENGTH, BUT NOT LESS THAN 7 DAYS.
- IN STEPS (10B) AND (12B), CONCRETE POUR SEQUENCE "A" AND "B" MAY BE DONE SEPARATELY, OR TOGETHER. HOWEVER, BOTH "A" AND "B" MUST BE COMPLETED BEFORE PROCEEDING TO THE NEXT POUR SEQUENCE NUMBER.

4/15/02	REVISED BRIDGE WIDENING DIMENSION ON "PLAN VIEW" AT STAGES 10 AND 12.
DATE	REVISION
STATE OF HAWAII DEPARTMENT OF TRANSPORTATION HIGHWAYS DIVISION CONSTRUCTION SEQUENCE	
HAWAII BELT ROAD KUPAPAPUA BRIDGE WIDENING HAMAKUA DISTRICT Federal Aid Project No. BR-019-2(38)	
SCALE: AS NOTED	DATE: AUG., 2001
SHEET No. S-3 OF 30 SHEETS	




FED. ROAD DIST. NO.	STATE	FED. AID PROJ. NO.	FISCAL YEAR	SHEET NO.	TOTAL SHEETS
HAWAII	HAW.	BR-019-2(38)	2002	47	73

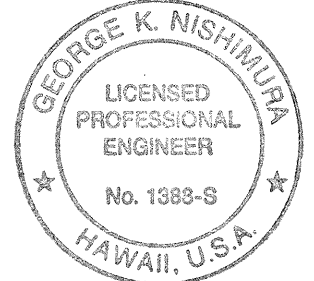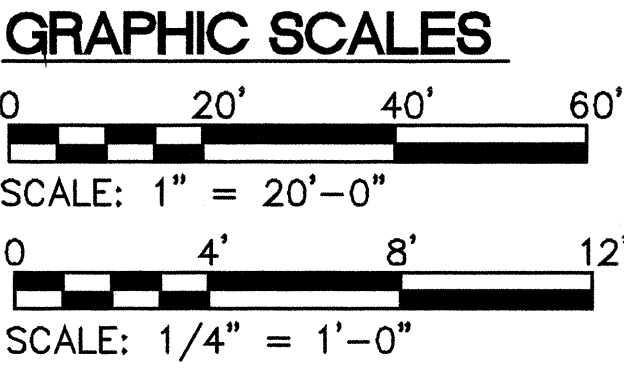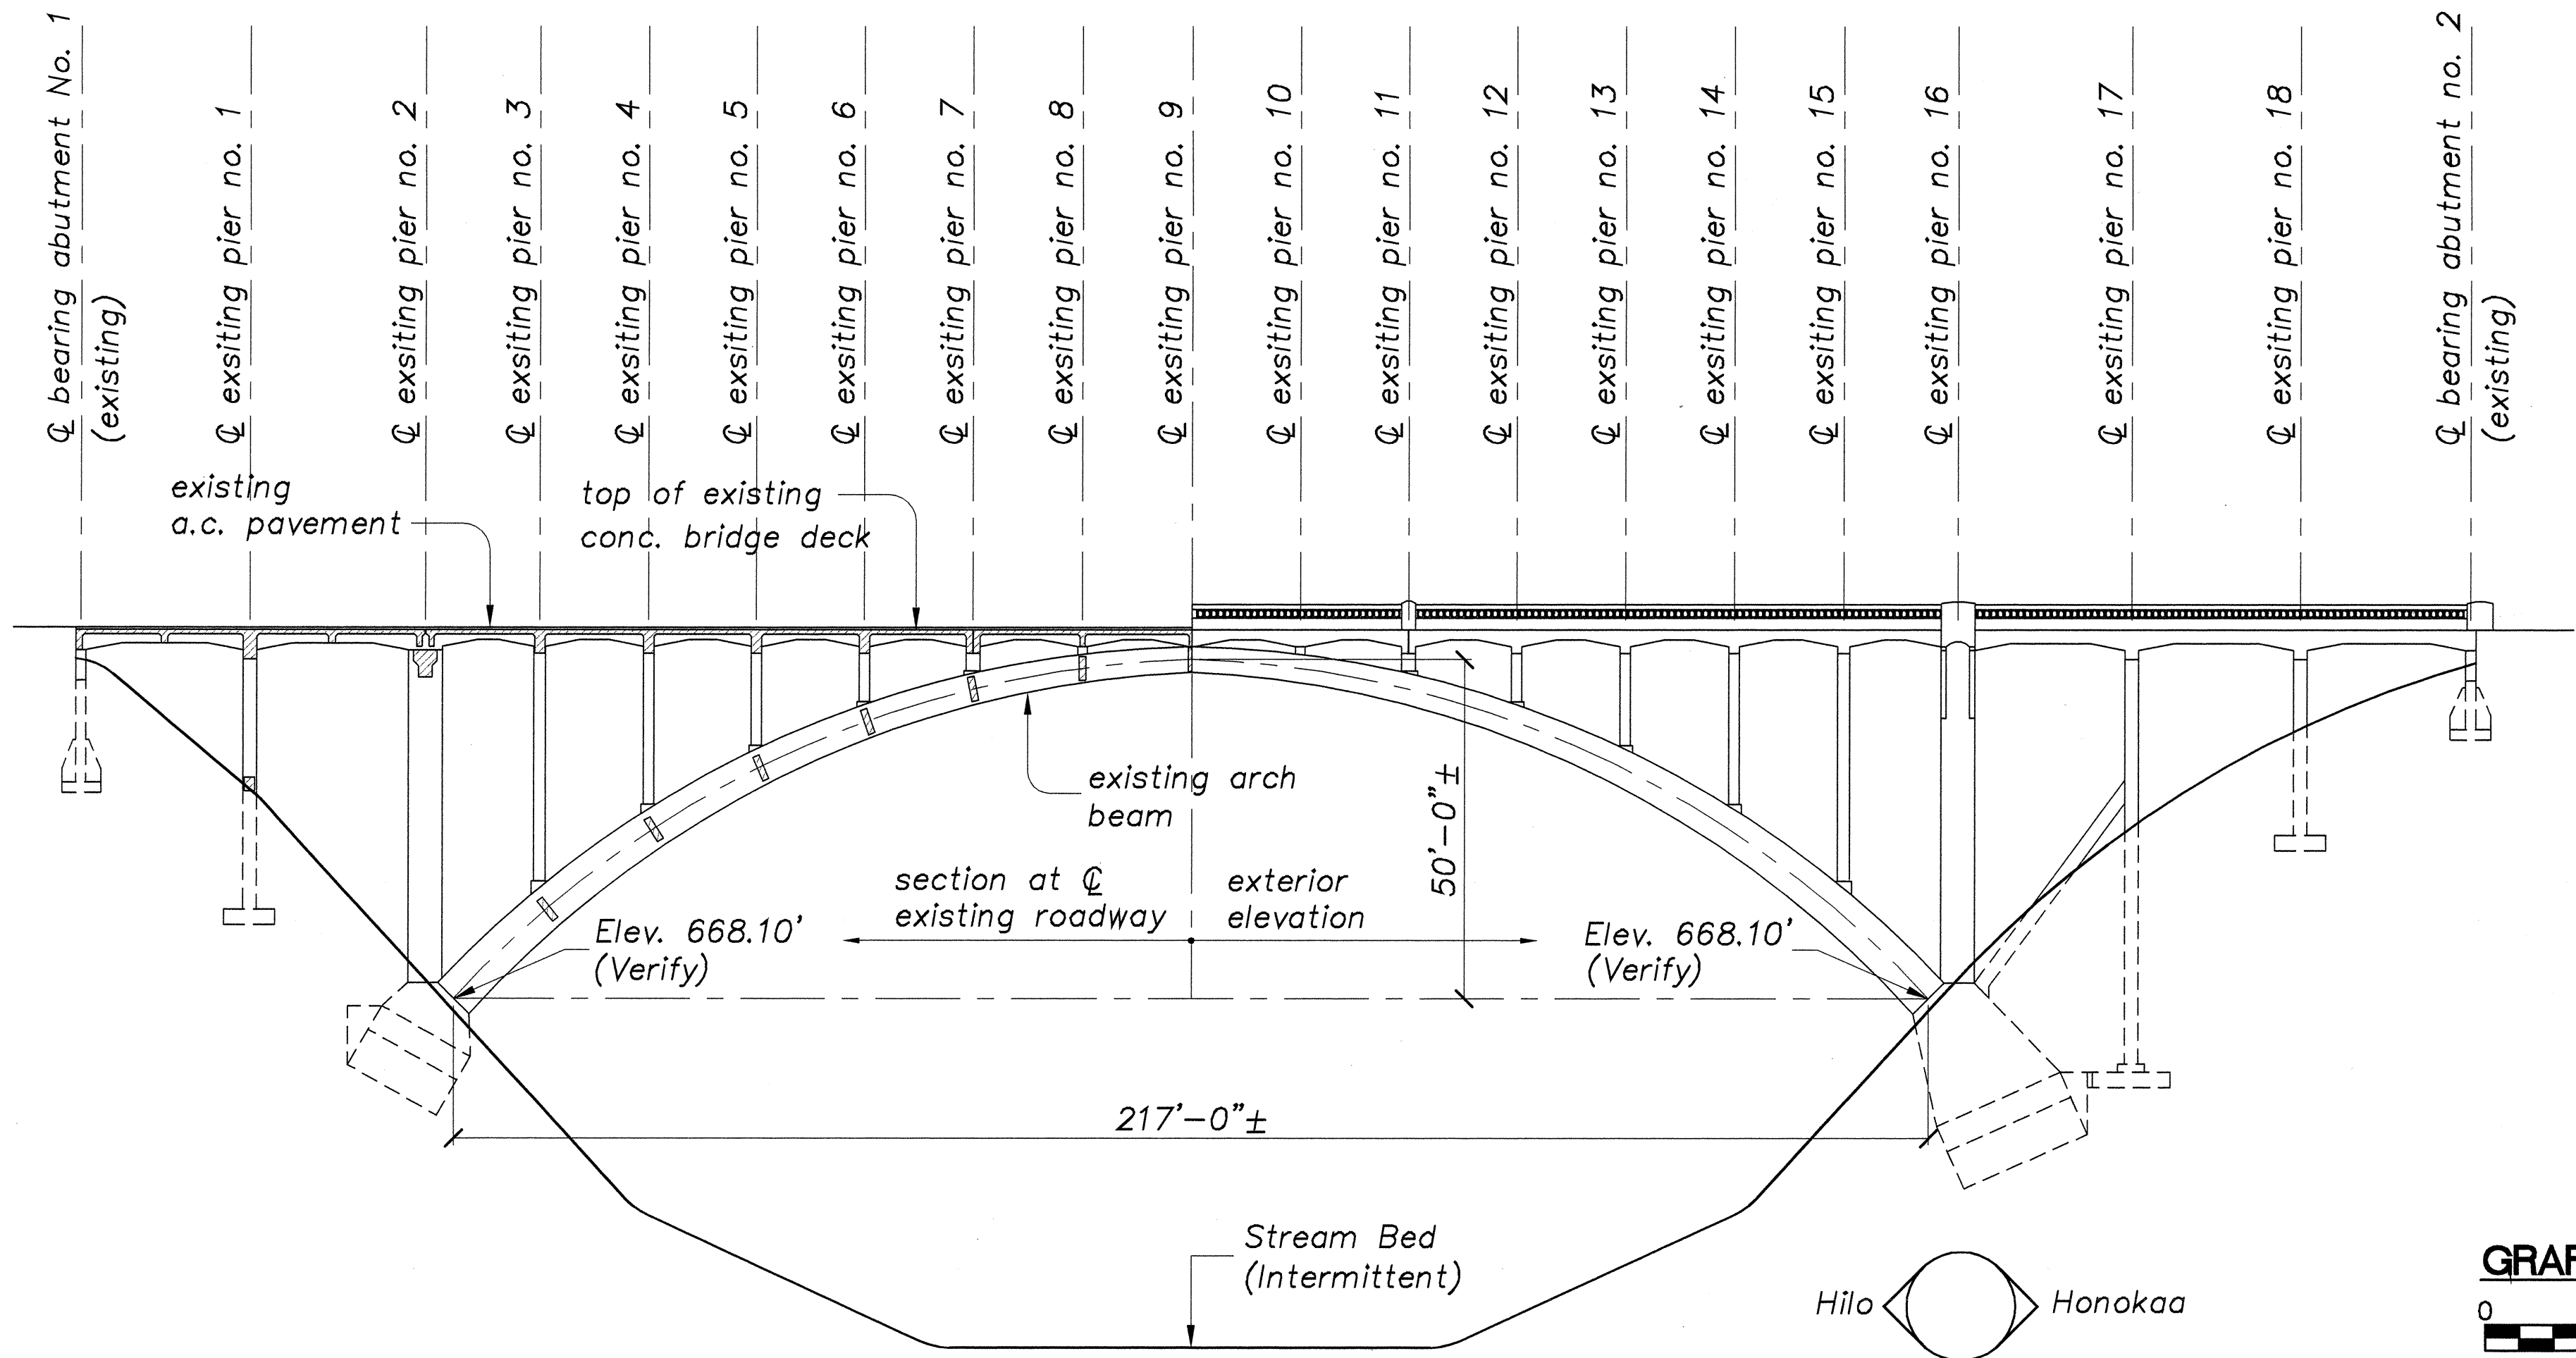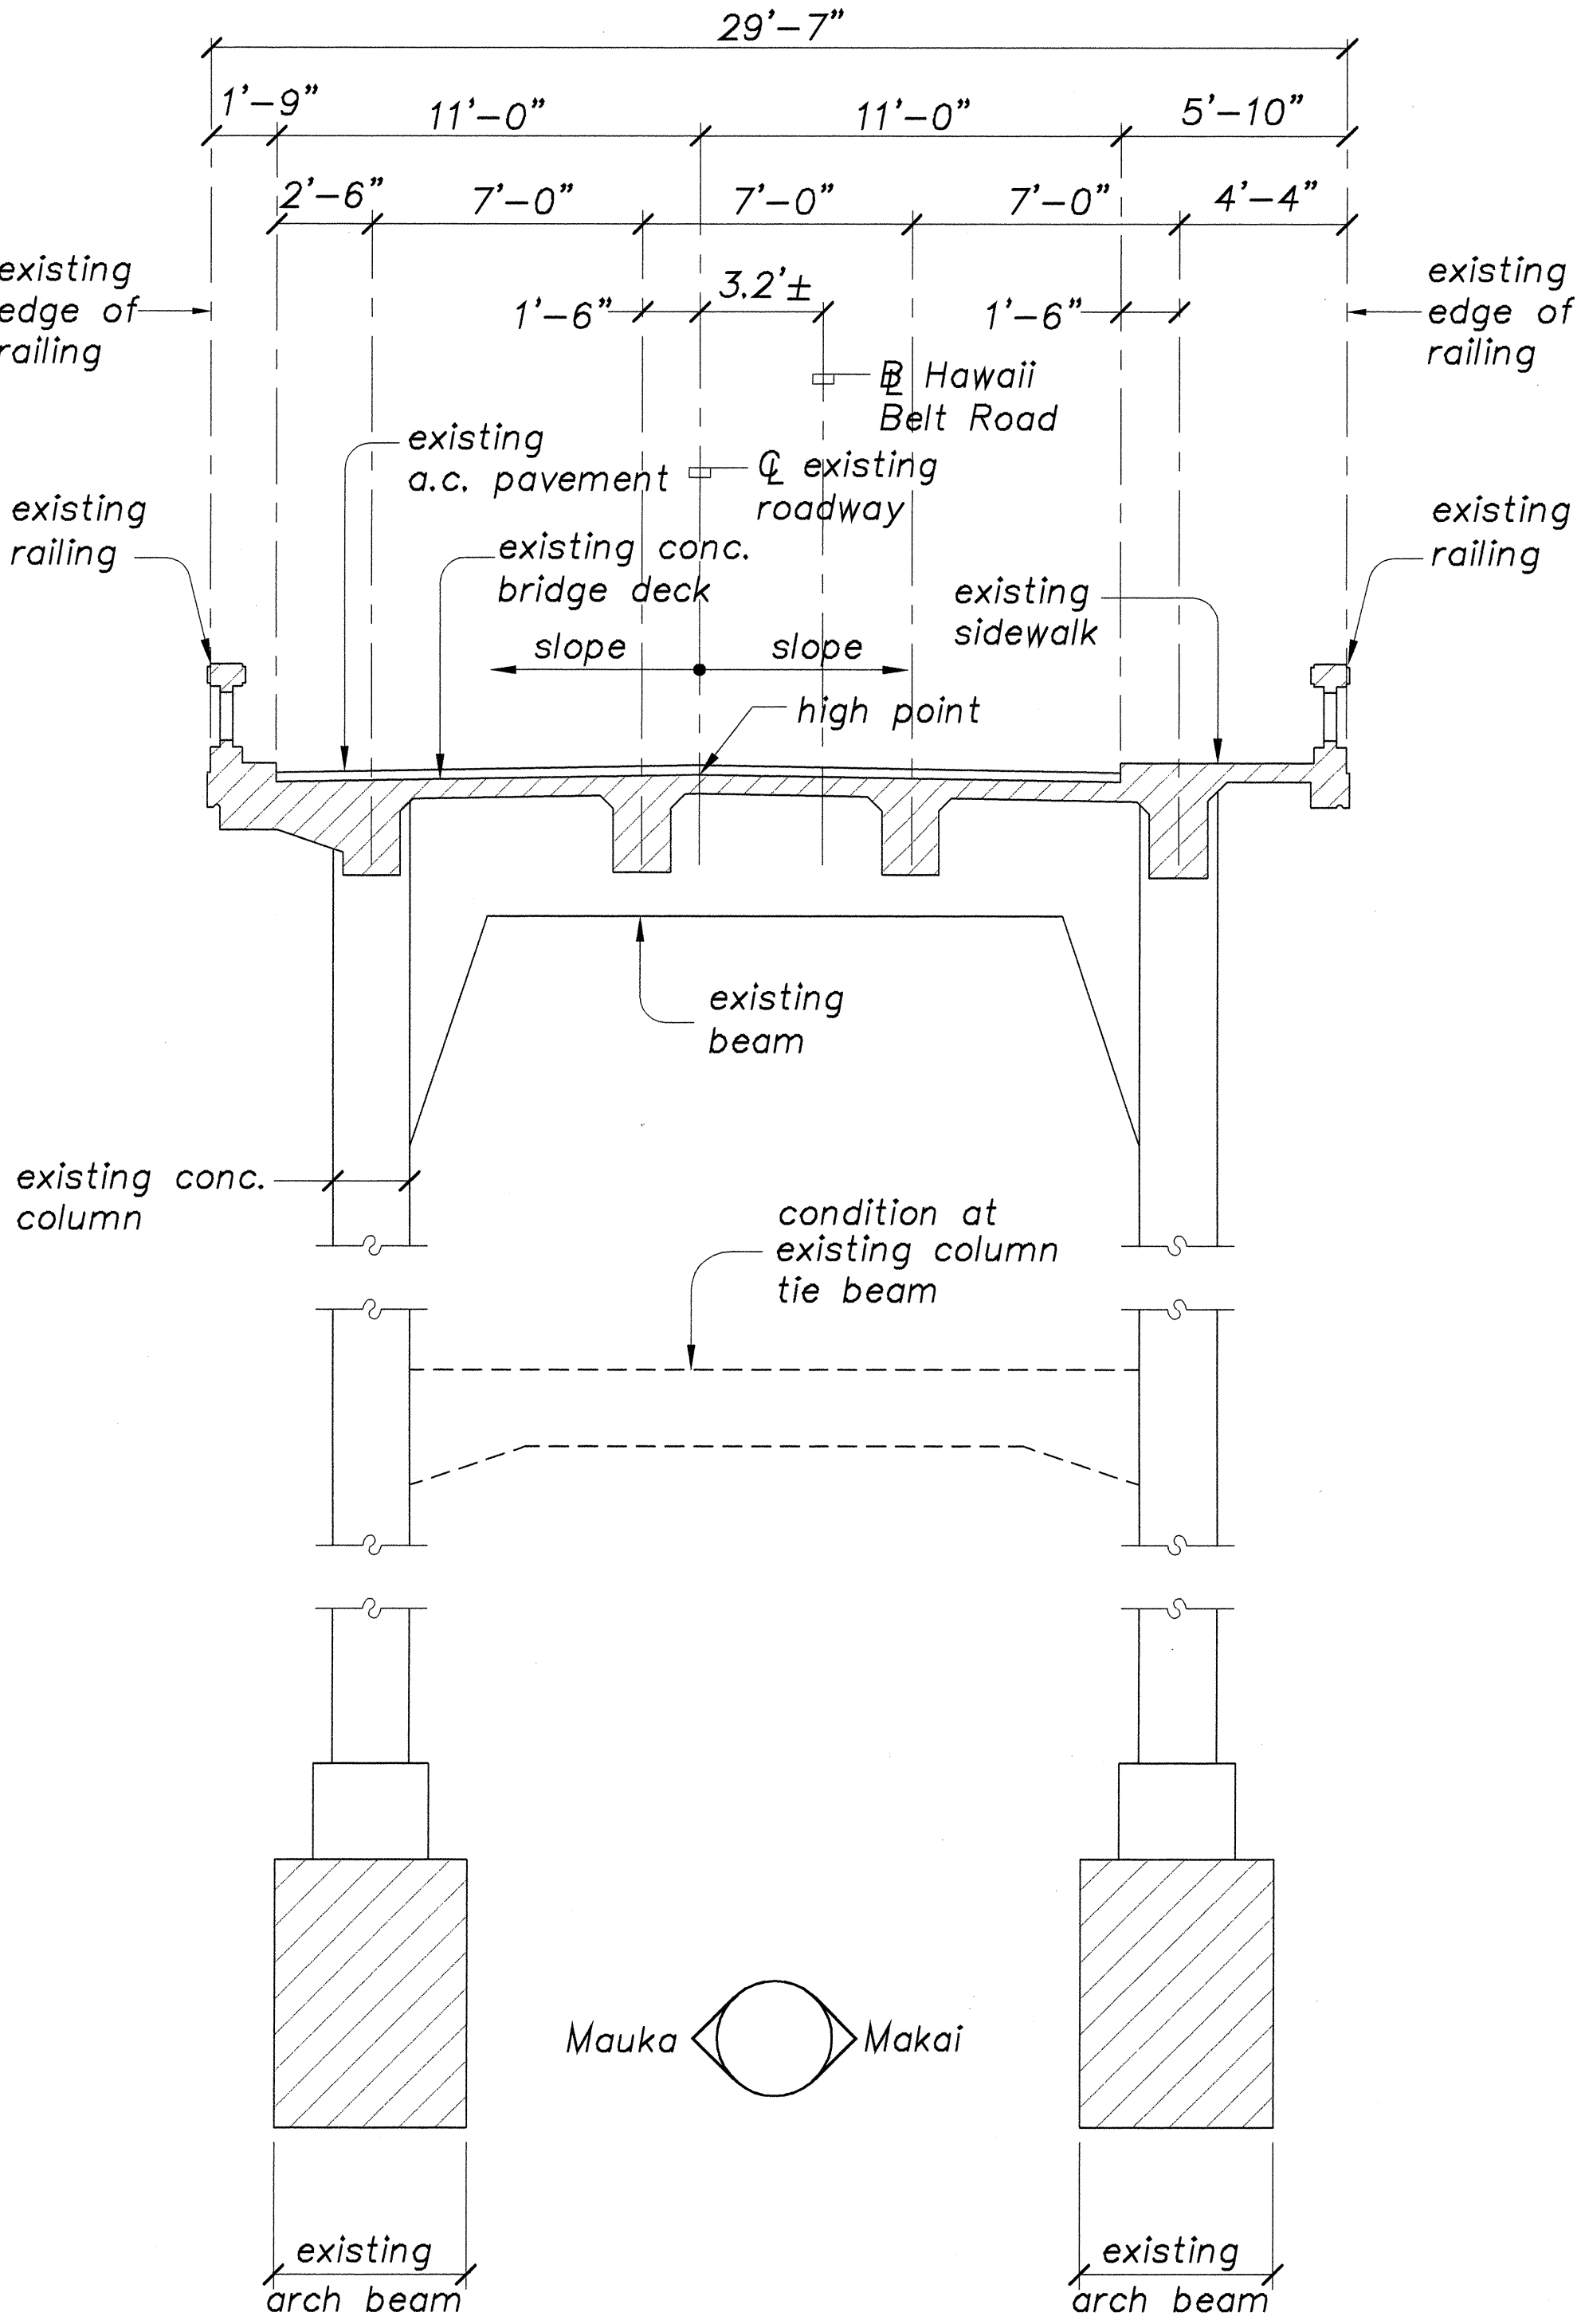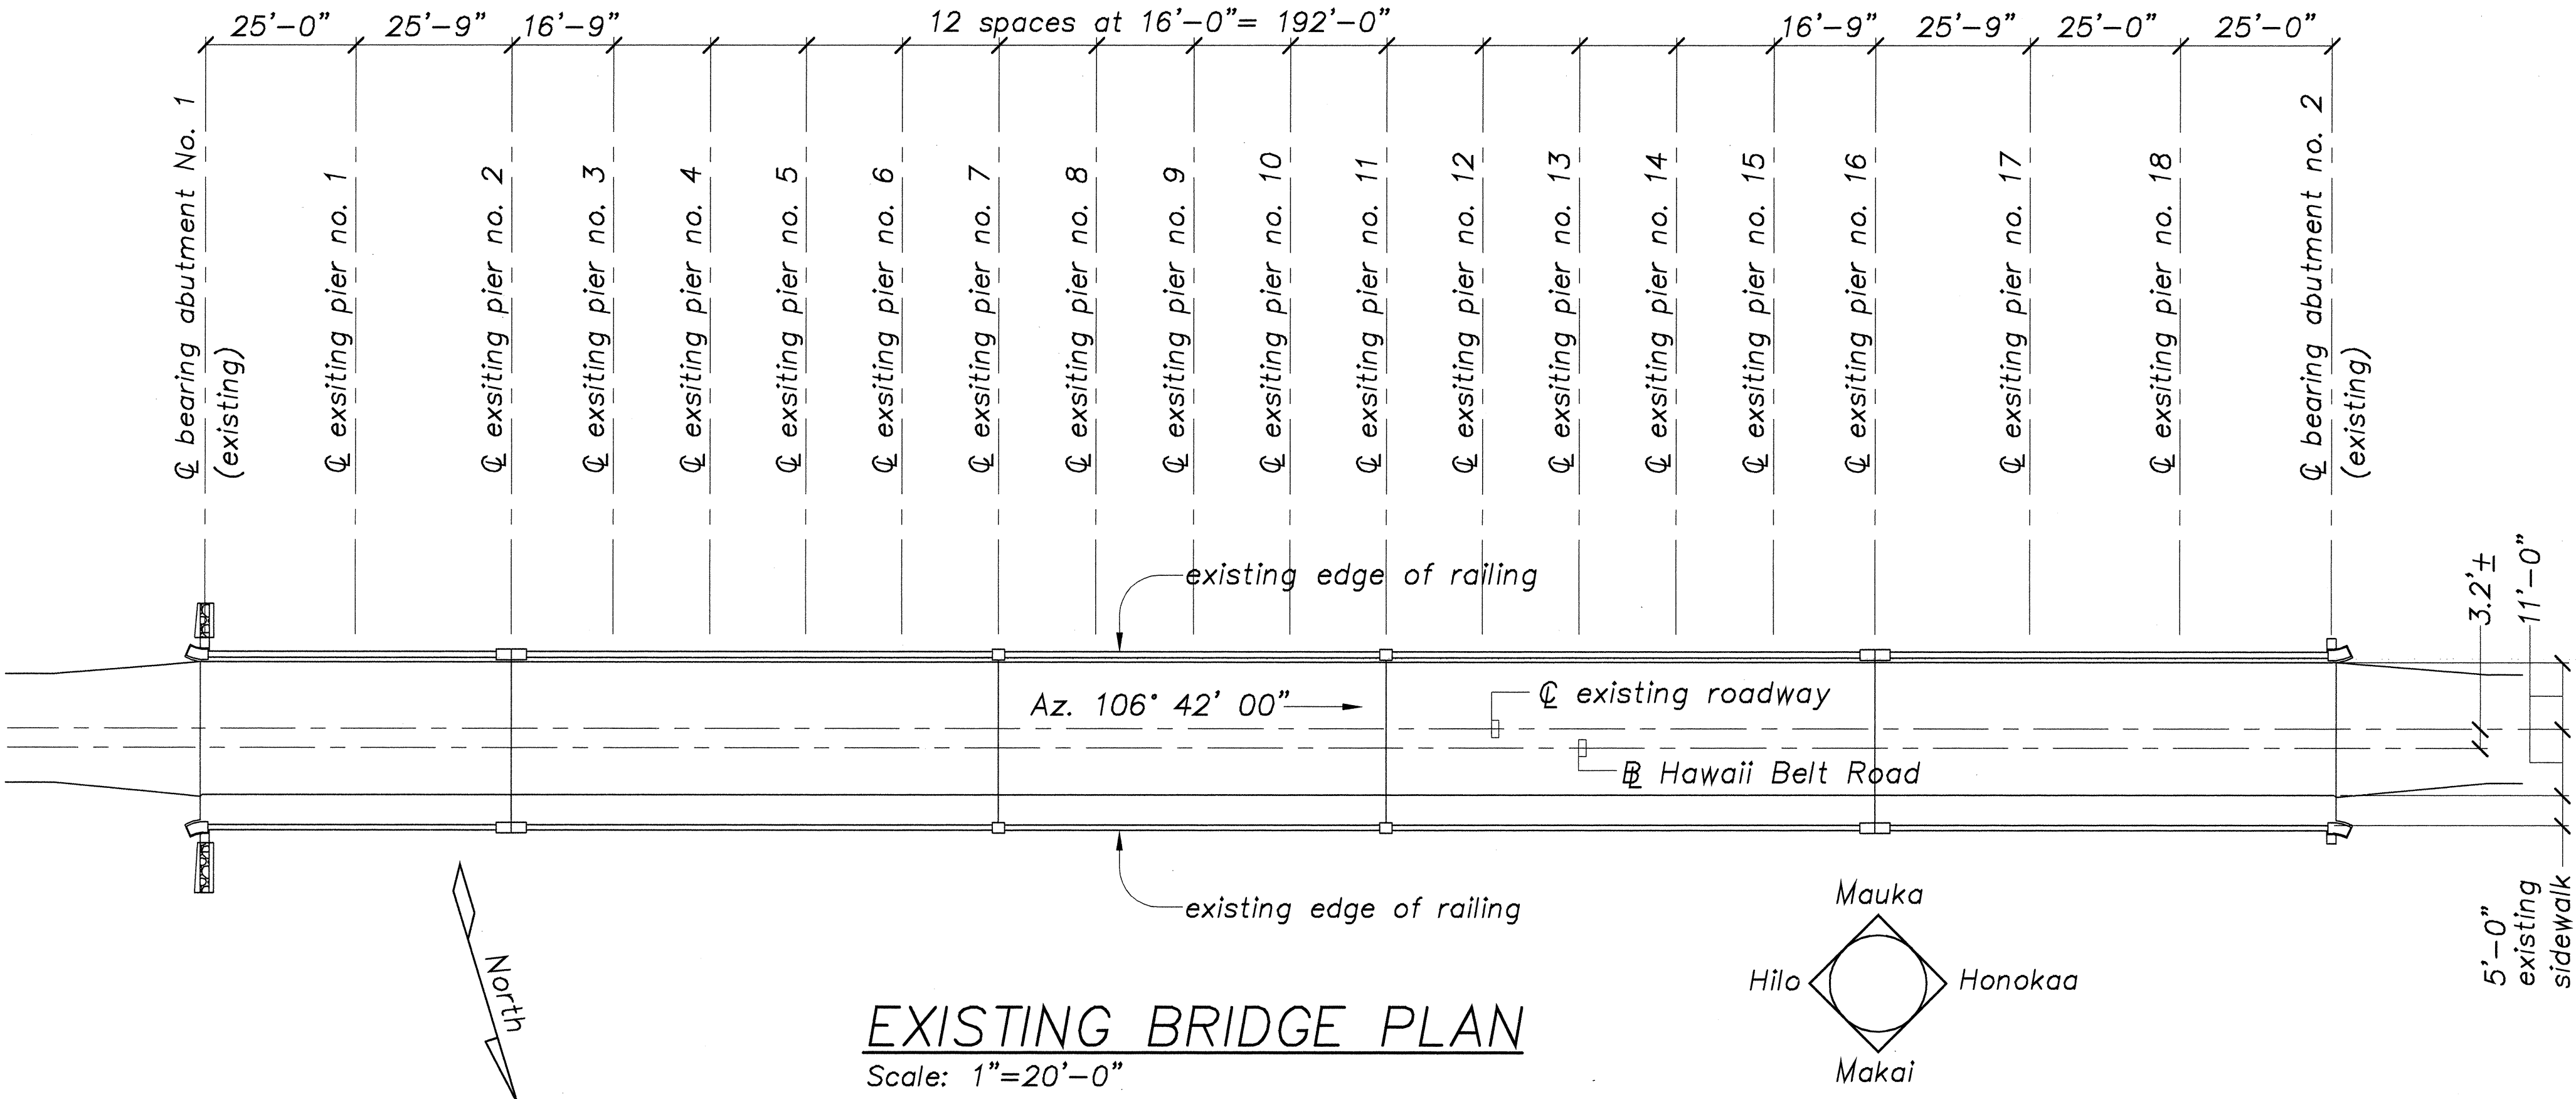



STATE OF HAWAII
DEPARTMENT OF TRANSPORTATION
HIGHWAYS DIVISION
EXISTING BRIDGE PLAN, EXISTING
BRIDGE HALF SECTION/ELEVATION,
TYPICAL SECTION THRU ARCH
HAWAII BELT ROAD
KUPAPAU LUA BRIDGE WIDENING
HAMAKUA DISTRICT
Federal Aid Project No. BR-019-2(38)
SCALE: AS NOTED DATE: OCT., 2001
SHEET No. S-4 OF 30 SHEETS

ORIGINAL PLAN
DATE
DRAWN BY
DESIGNED BY
NOTED BY
CHECKED BY
No.

FED. ROAD DIST. NO.	STATE	FED. AID PROJ. NO.	FISCAL YEAR	SHEET NO.	TOTAL SHEETS
HAWAII	HAW.	BR-019-2(38)	2002	48	73

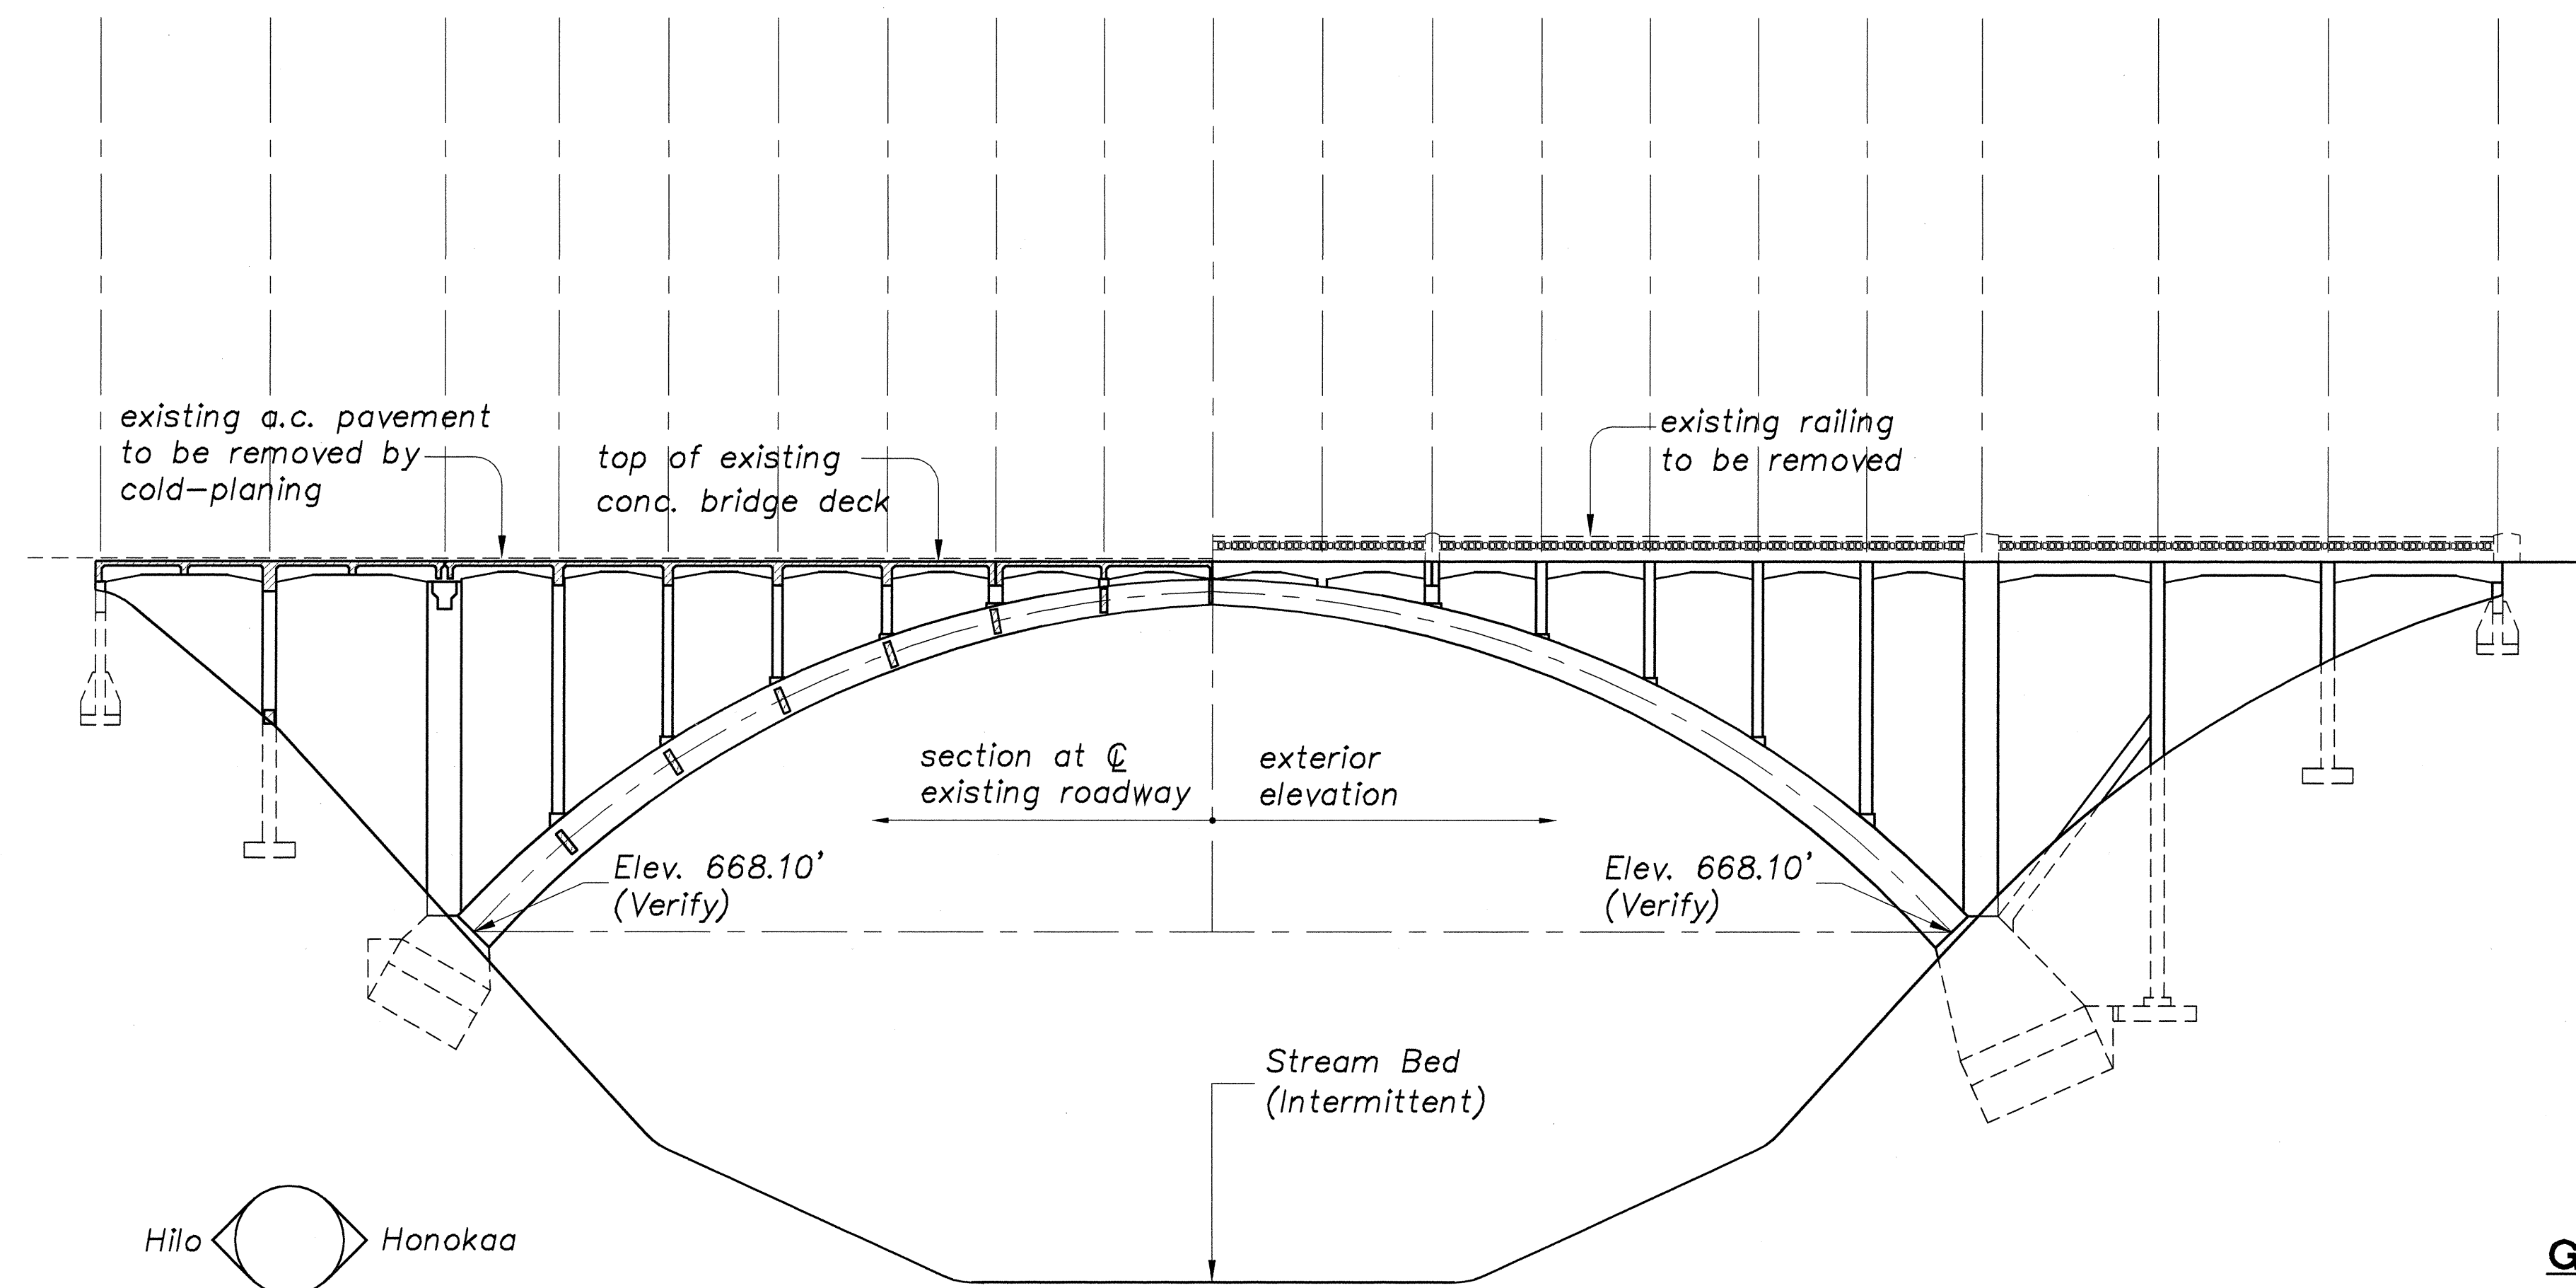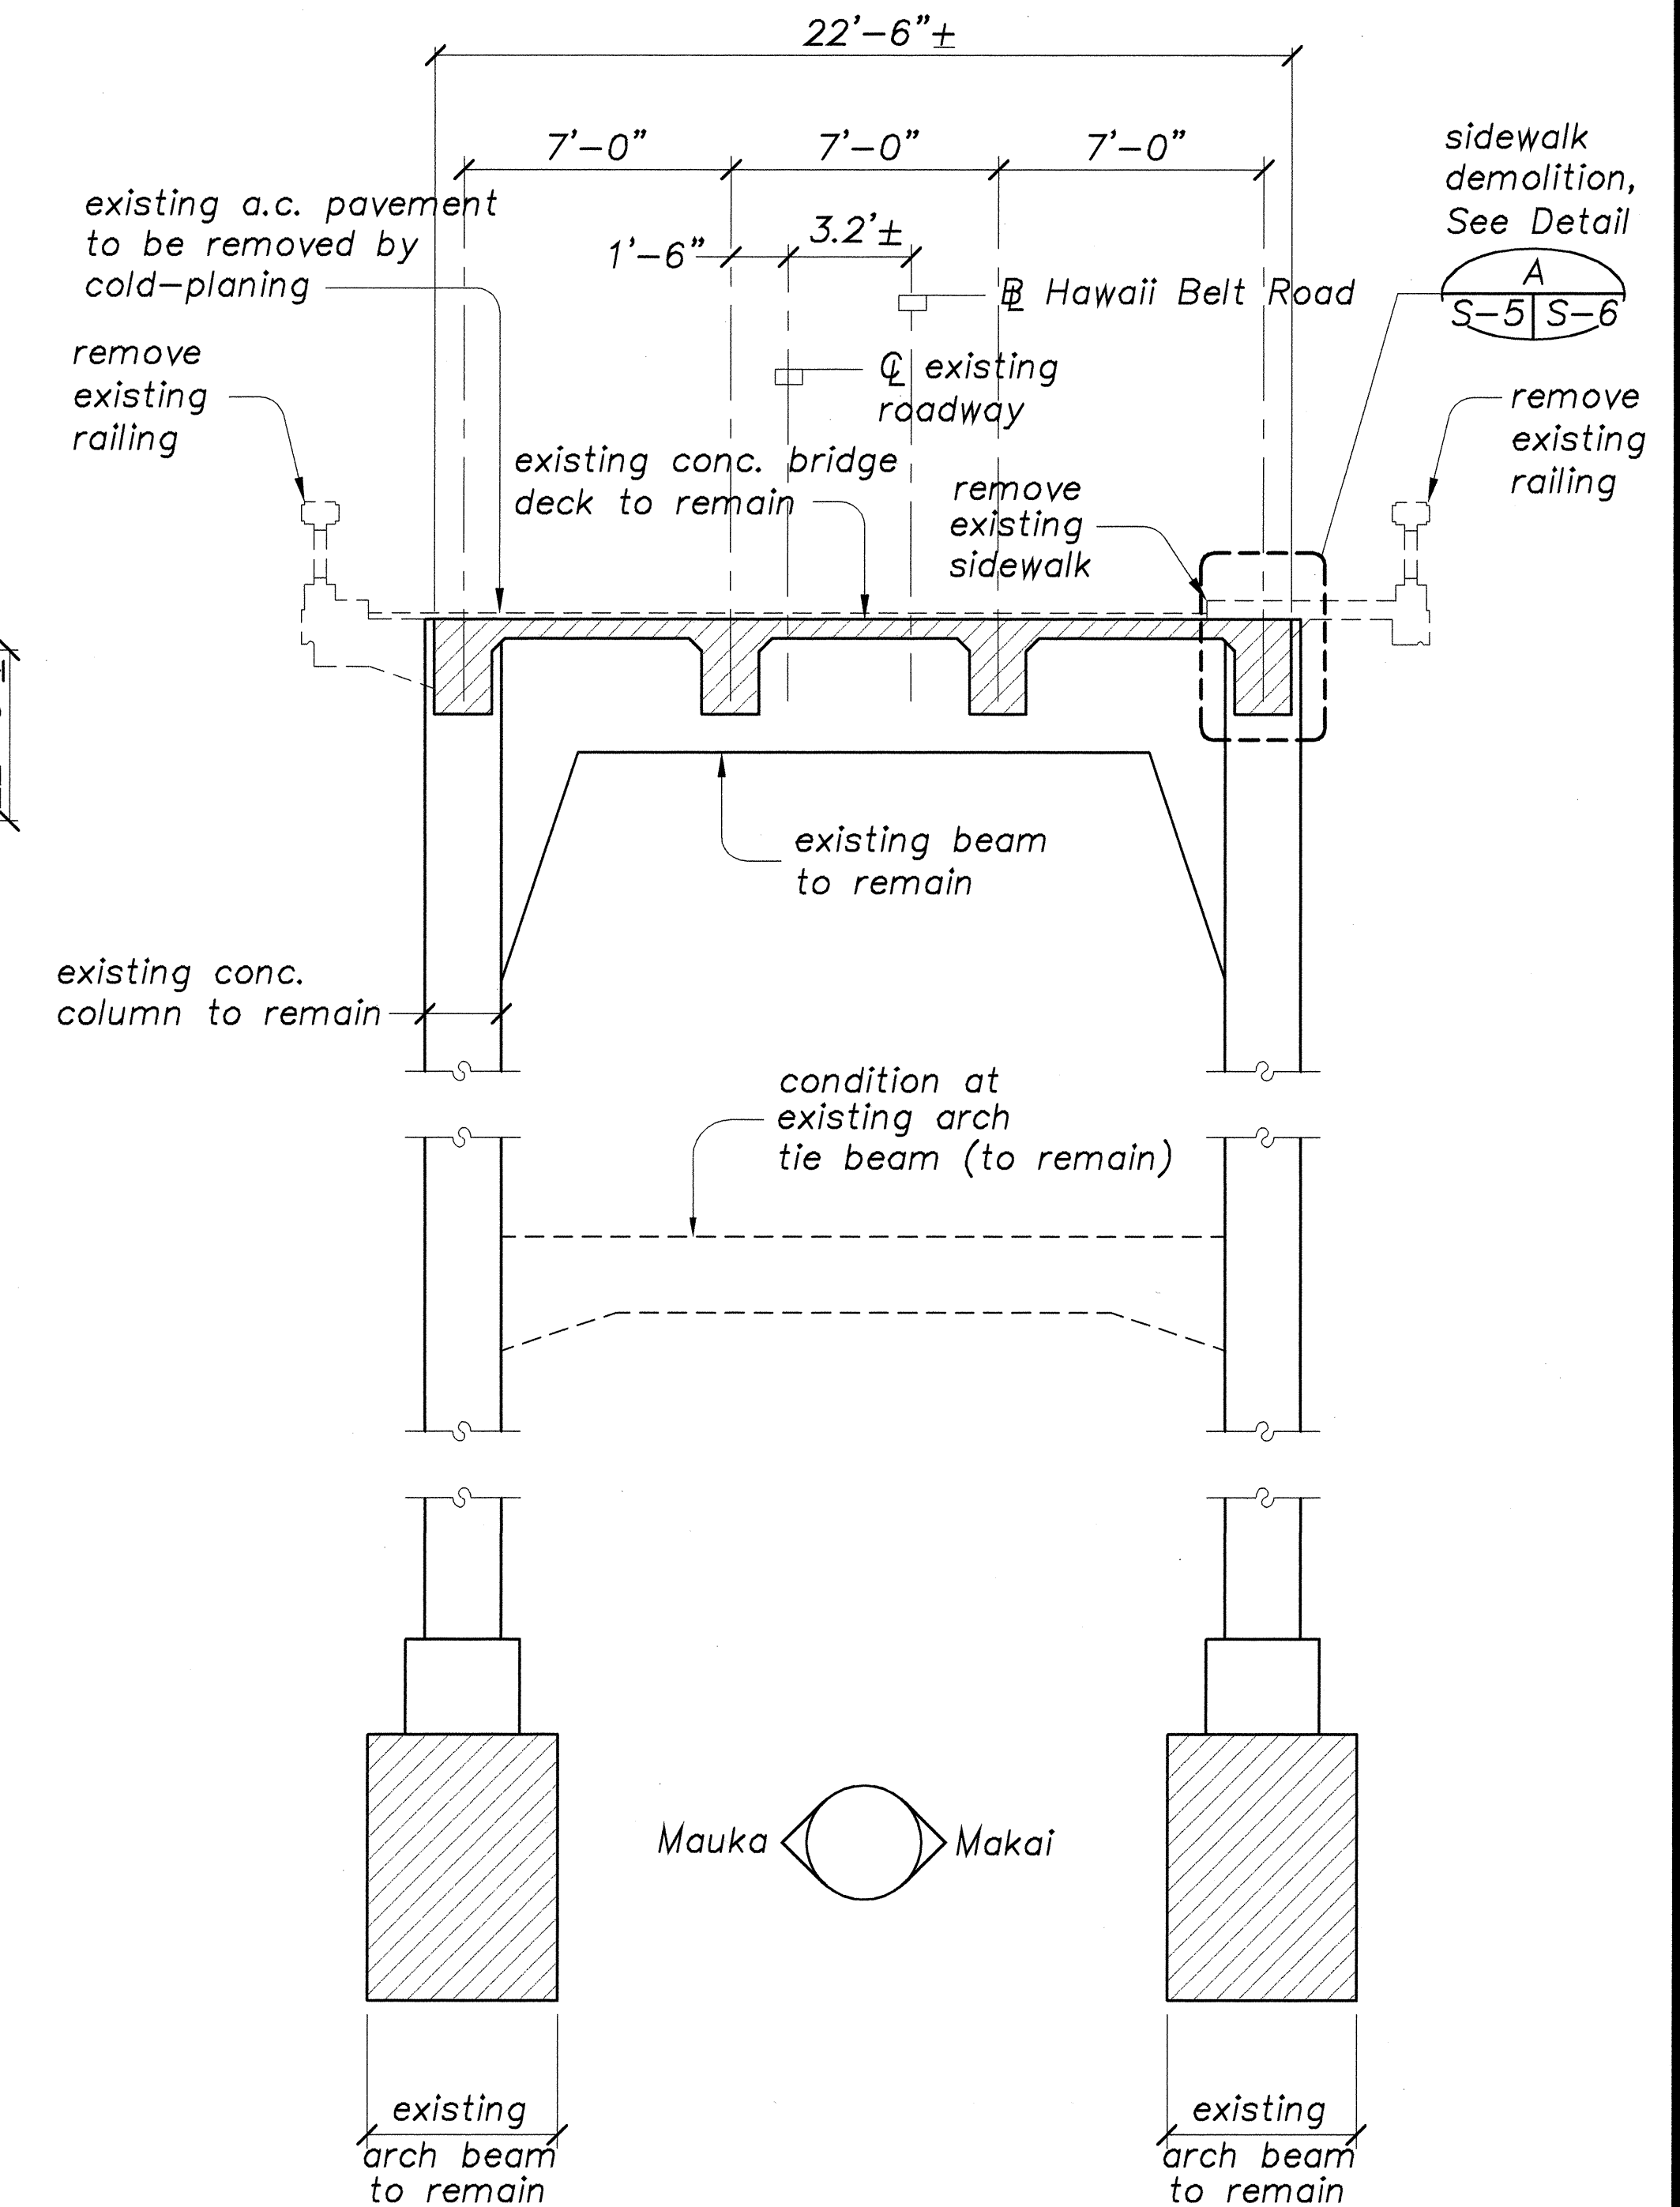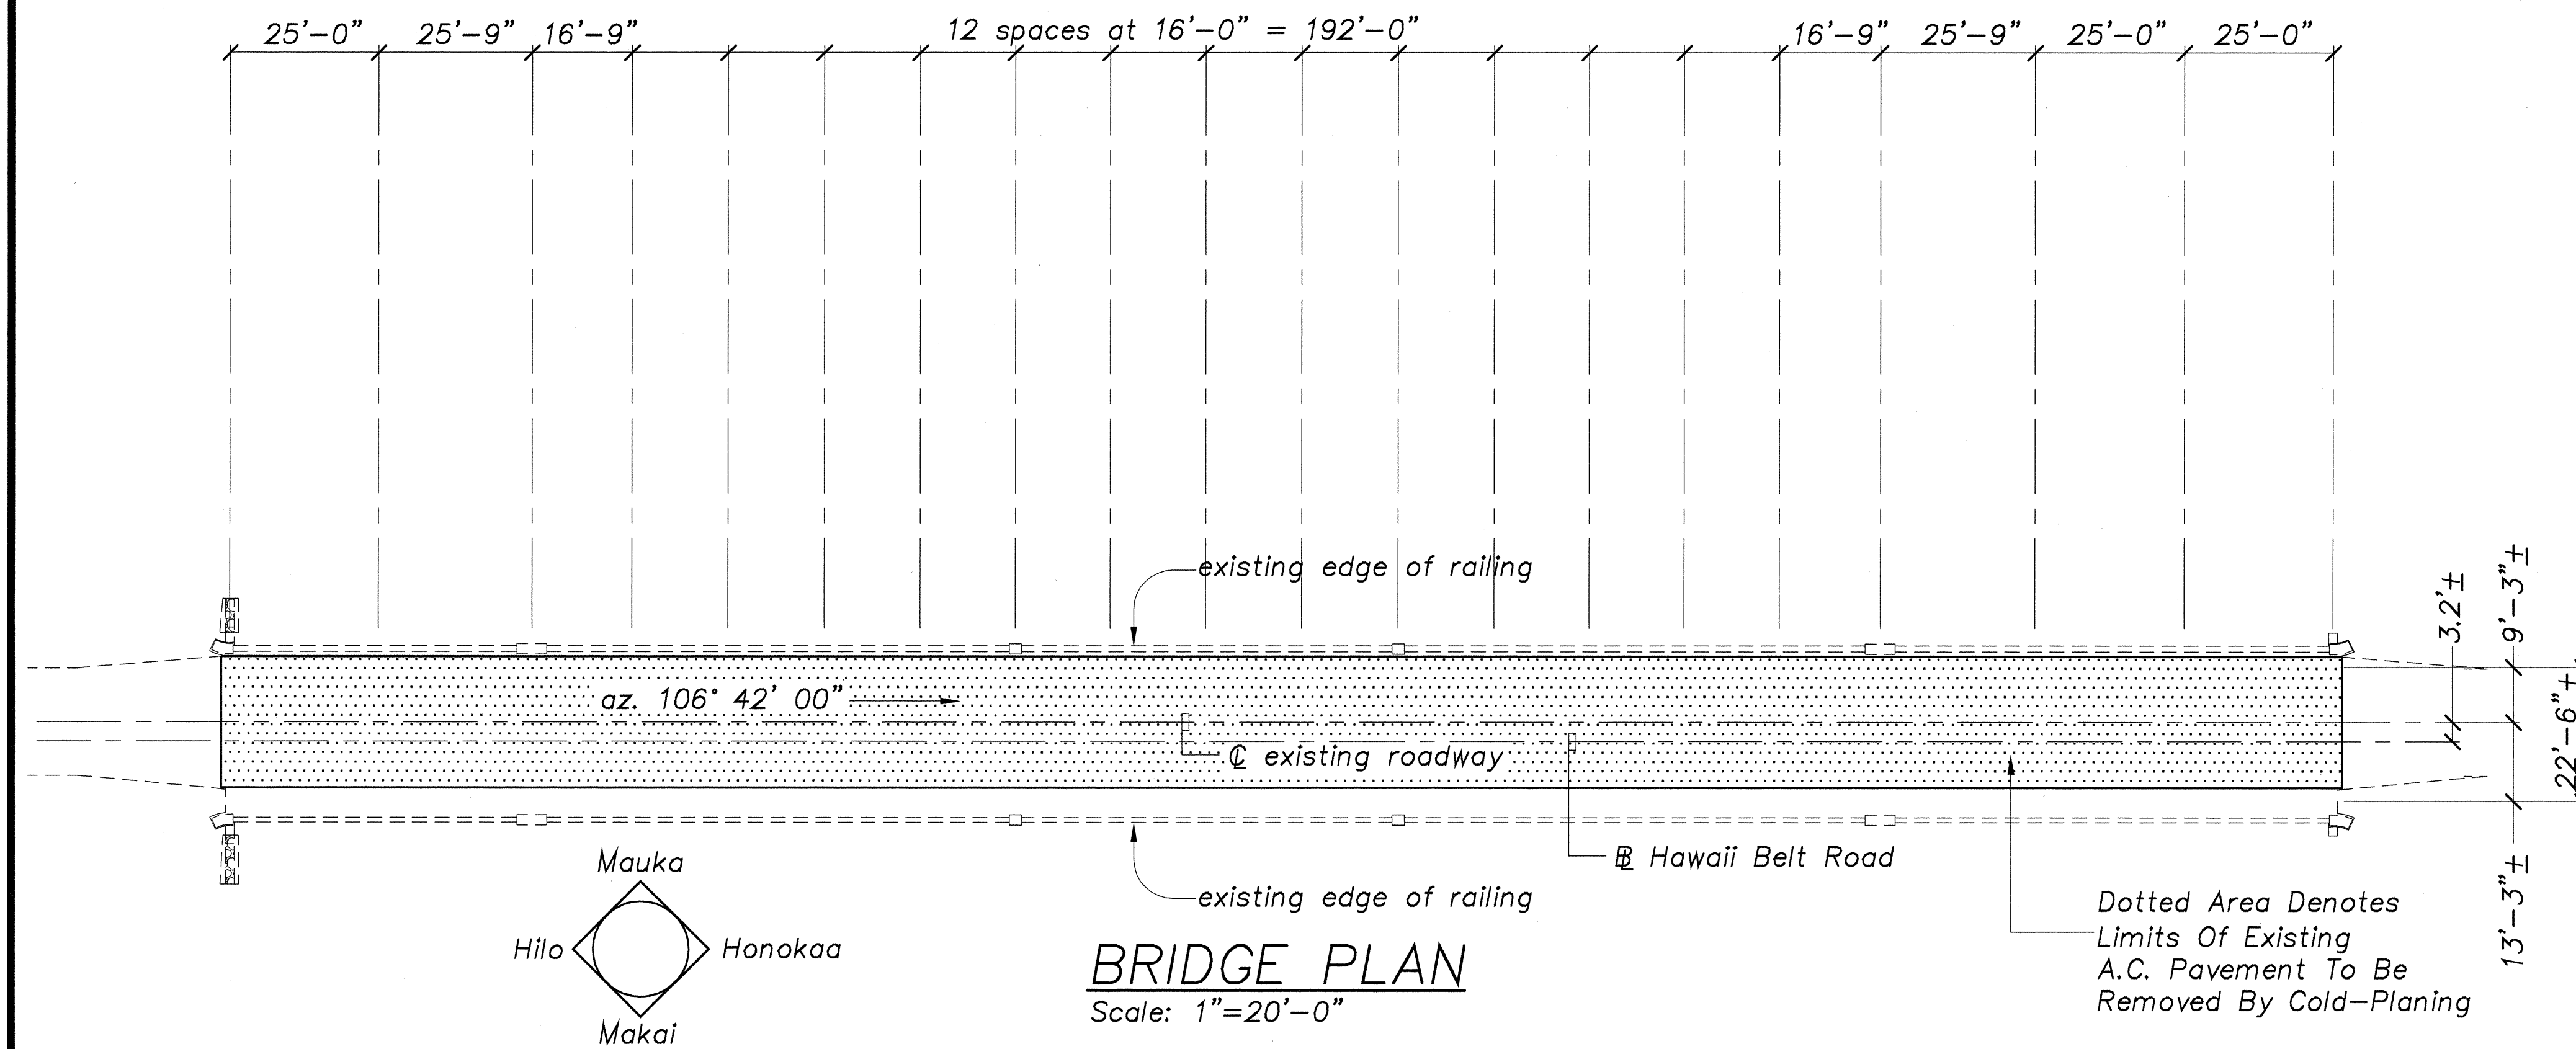

GRAPHIC SCALES

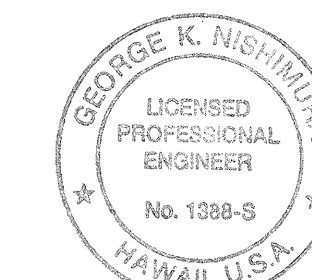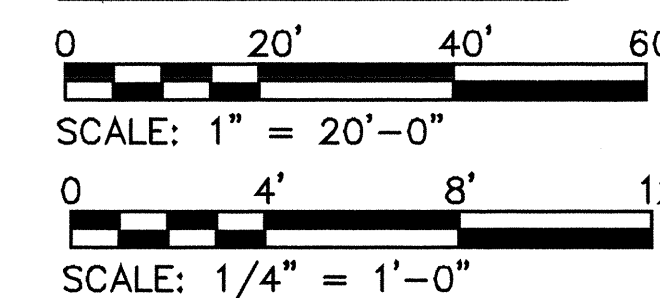

THIS WORK WAS PREPARED BY
MECHANICAL SUPERVISOR
[Signature]


STATE OF HAWAII
DEPARTMENT OF TRANSPORTATION
HIGHWAYS DIVISION
EXISTING BRIDGE DEMOLITION PLANS

HAWAII BELT ROAD
KUPAPAU LUA BRIDGE WIDENING
HAMAKUA DISTRICT
Federal Aid Project No. BR-019-2(38)


SCALE: AS NOTED DATE: OCT., 2001

SHEET No. S-5 OF 30 SHEETS


FED. ROAD DIST. NO.	STATE	FED. AID PROJ. NO.	FISCAL YEAR	SHEET NO.	TOTAL SHEETS
HAWAII	HAW.	BR-019-2(38)	2002	49	73

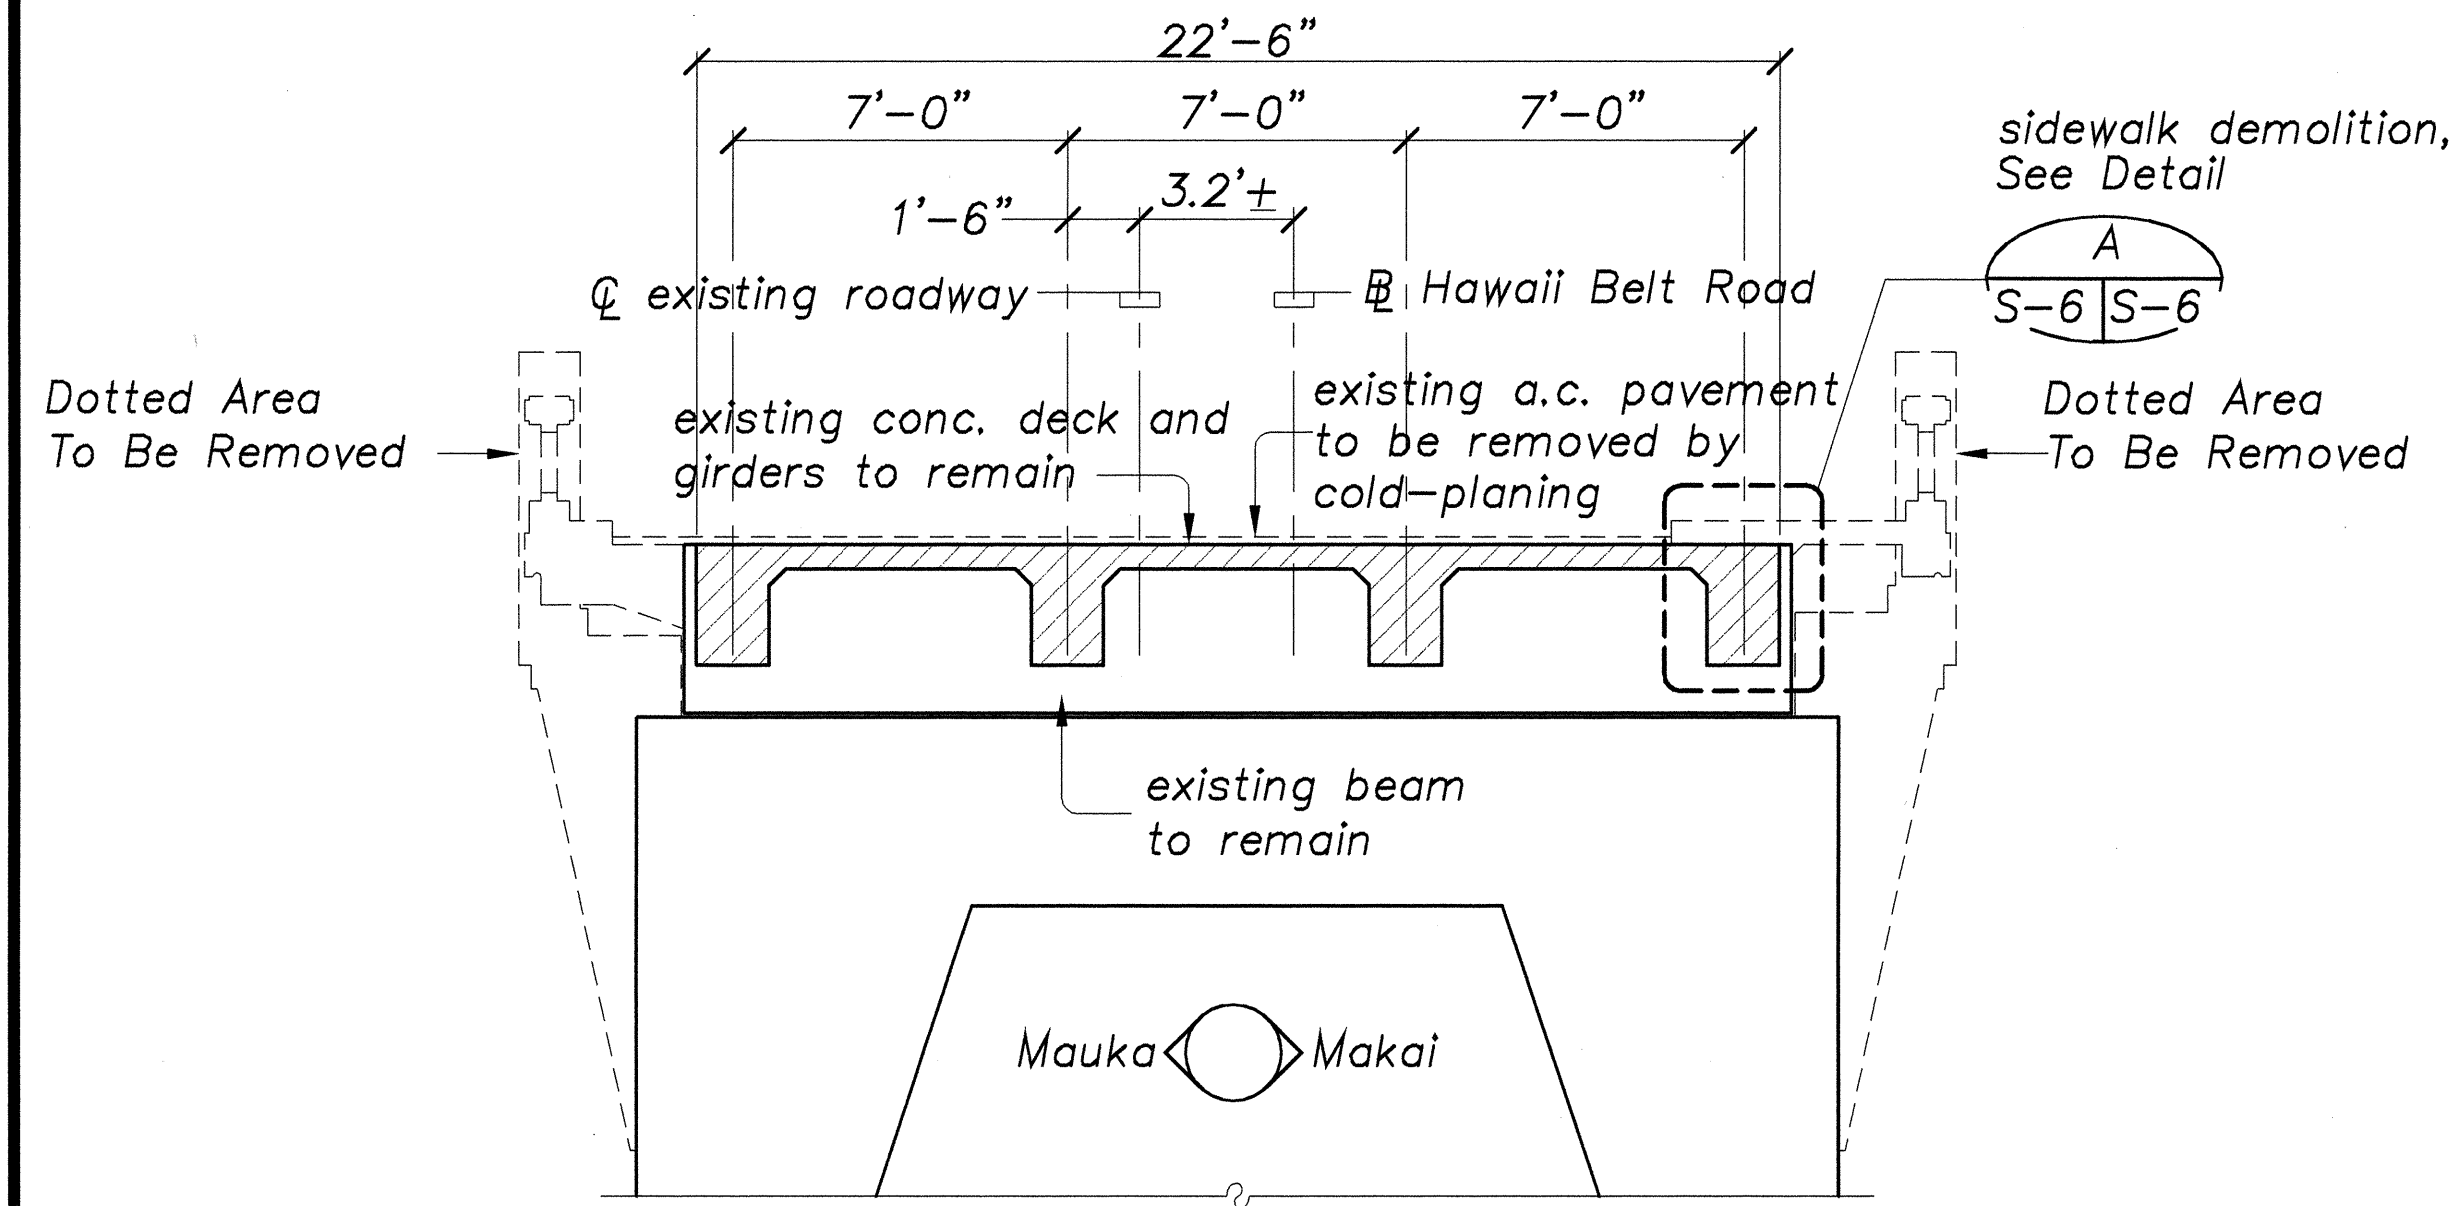


EXISTING PIER NO. 2 AND EXISTING PIER NO. 16

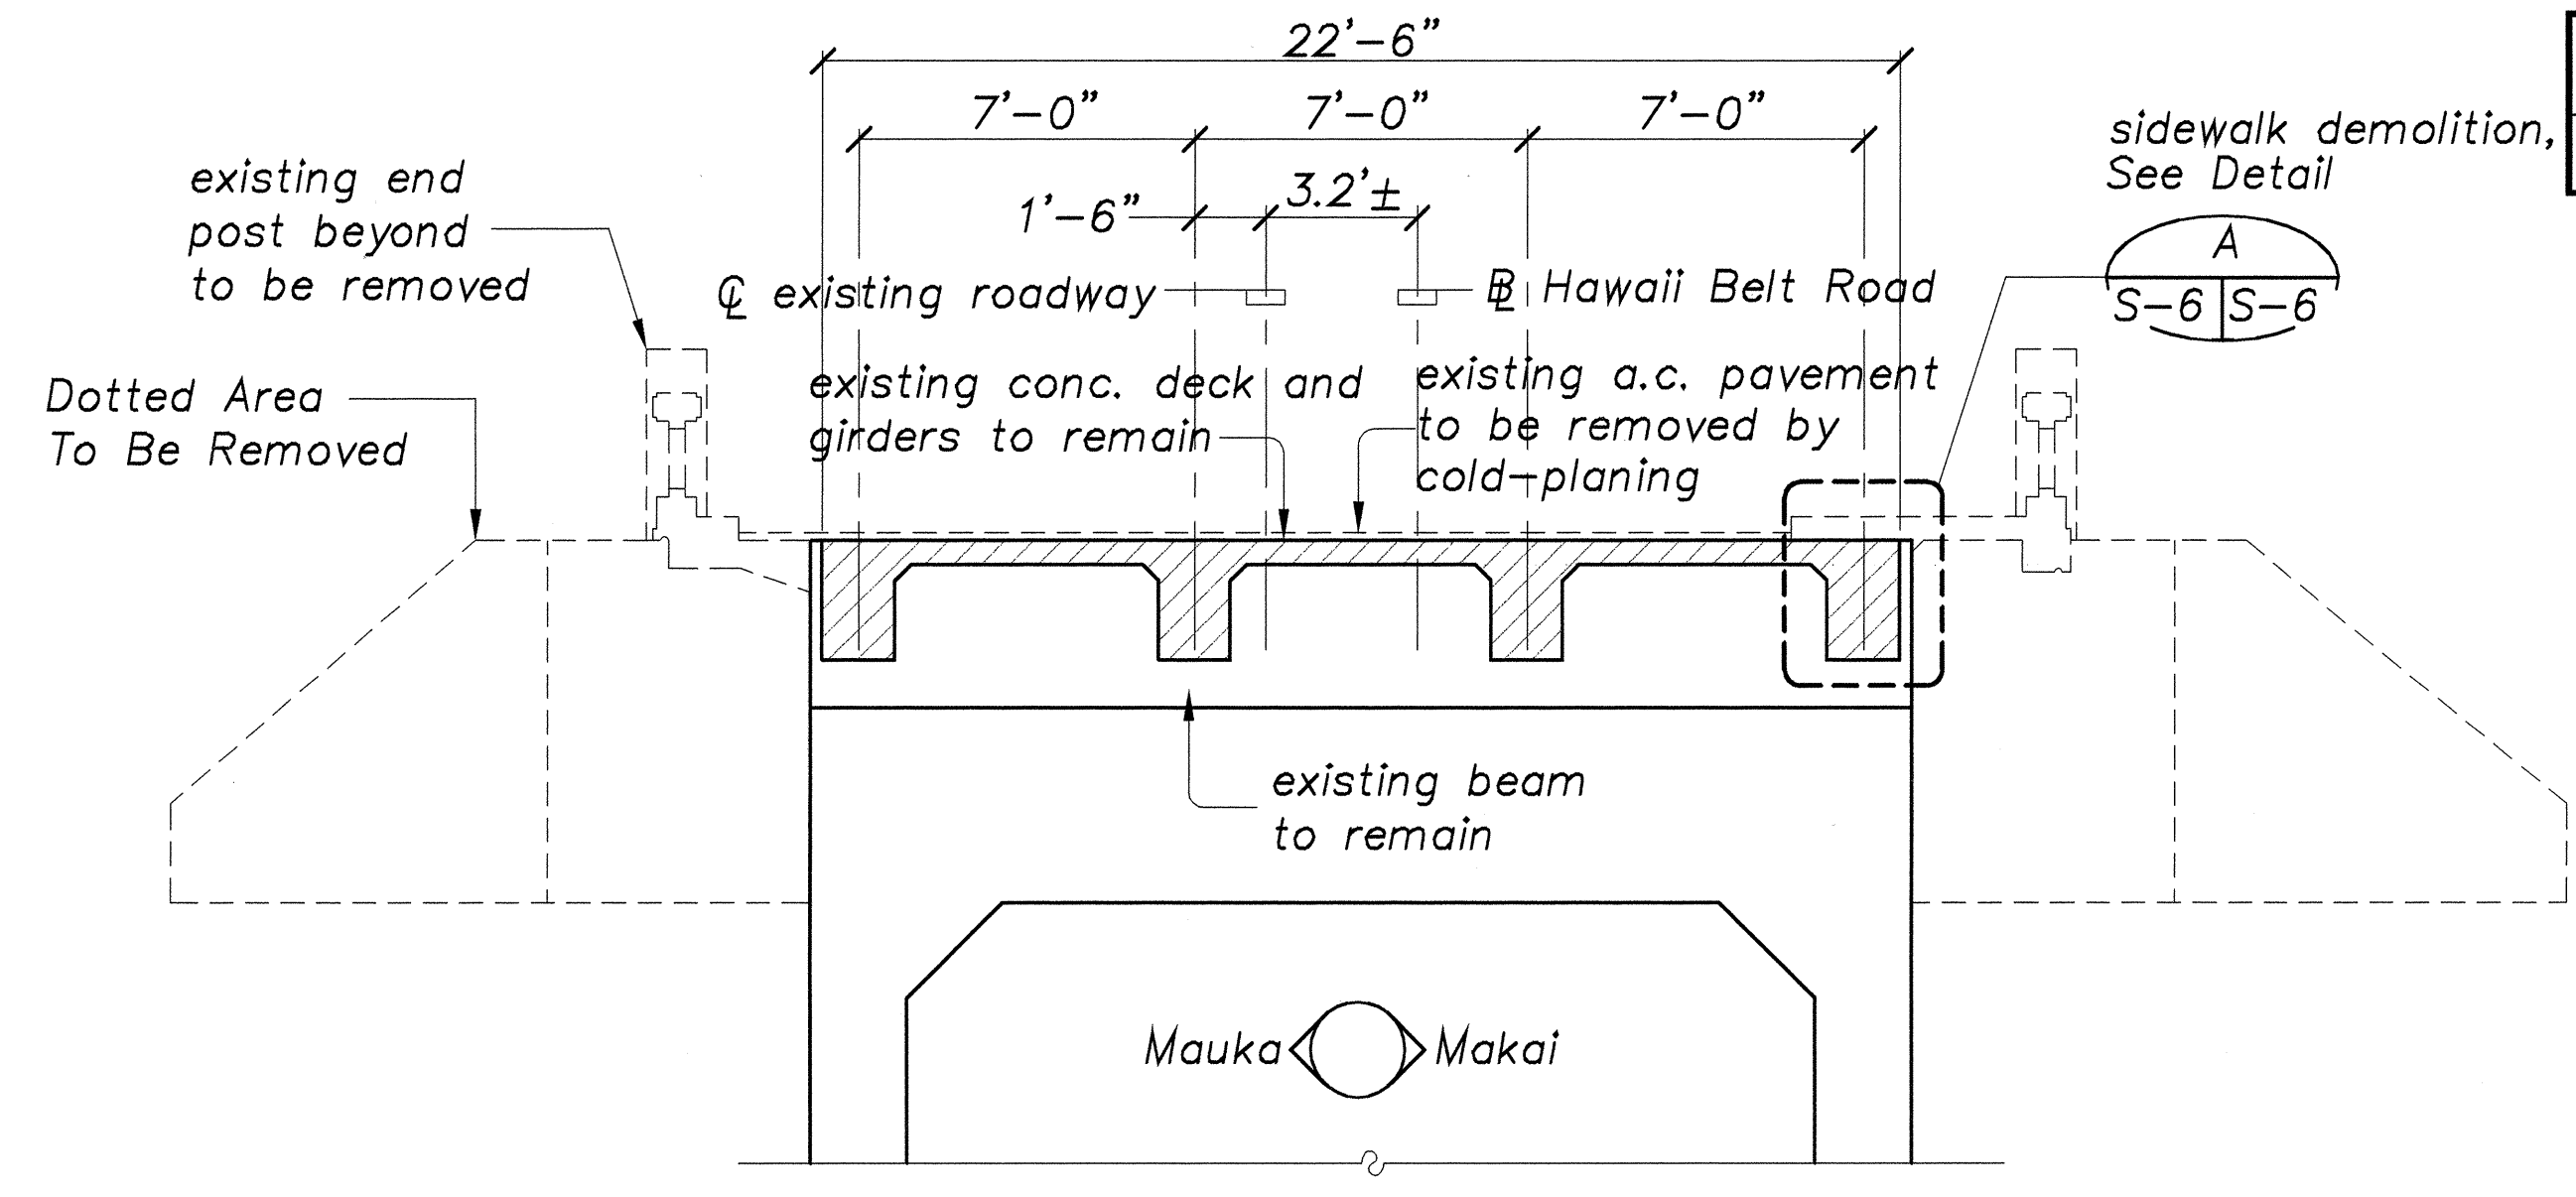



EXISTING ABUTMENT NO. 1

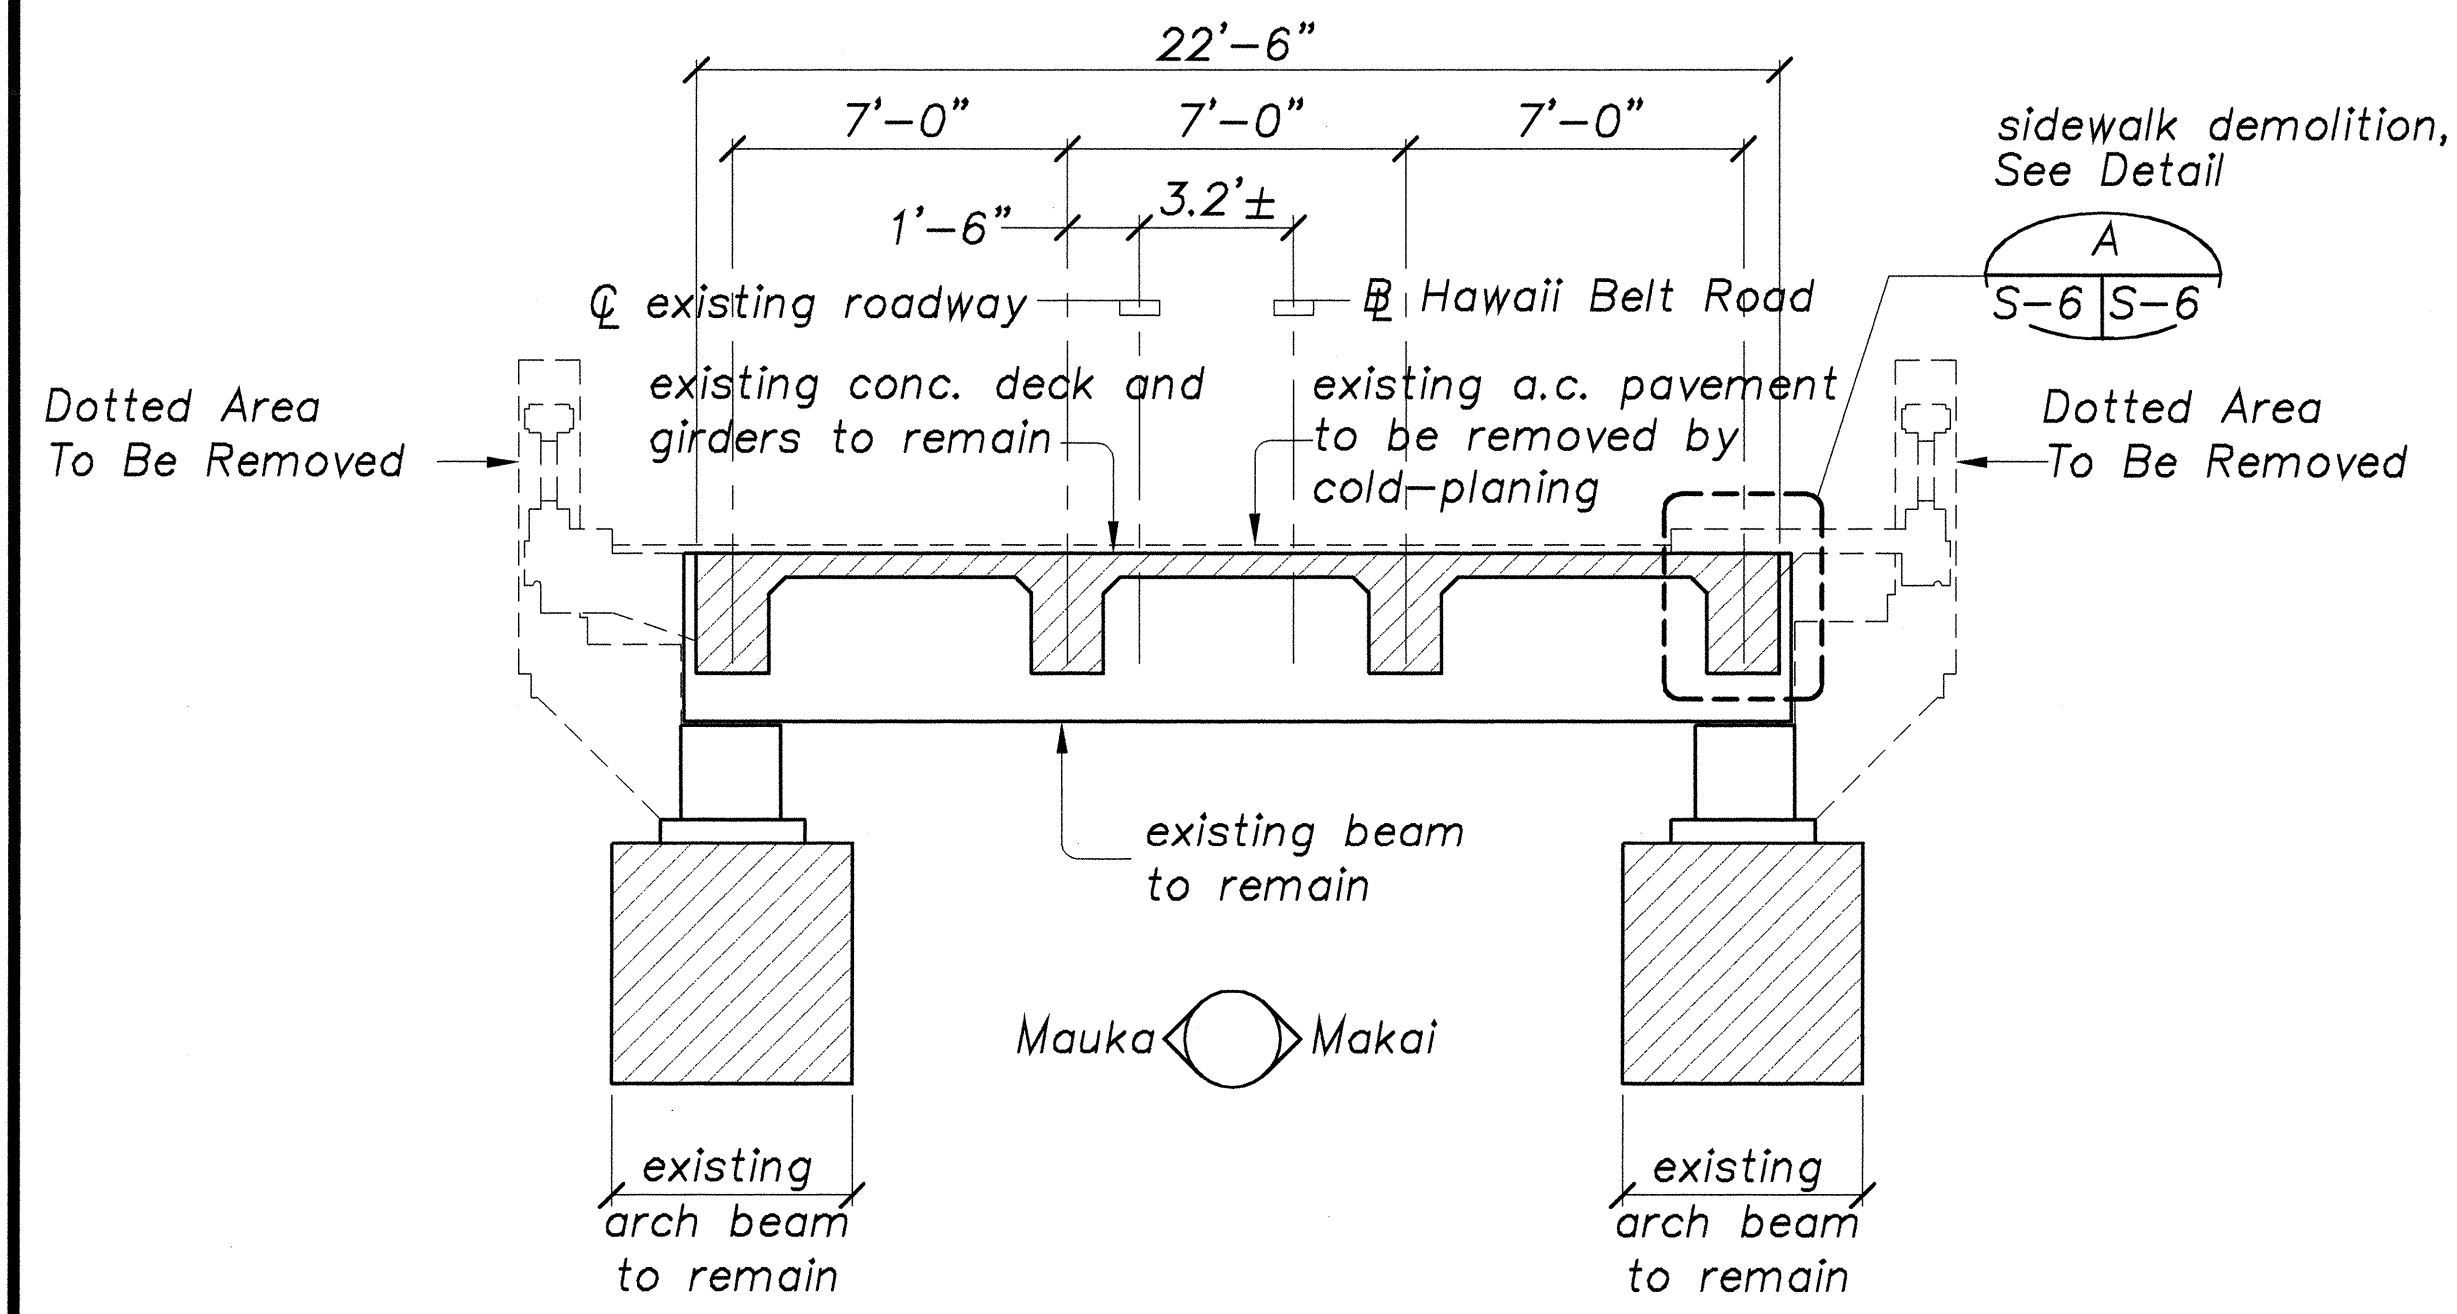

EXISTING PIER NO. 7 AND EXISTING PIER NO. 11

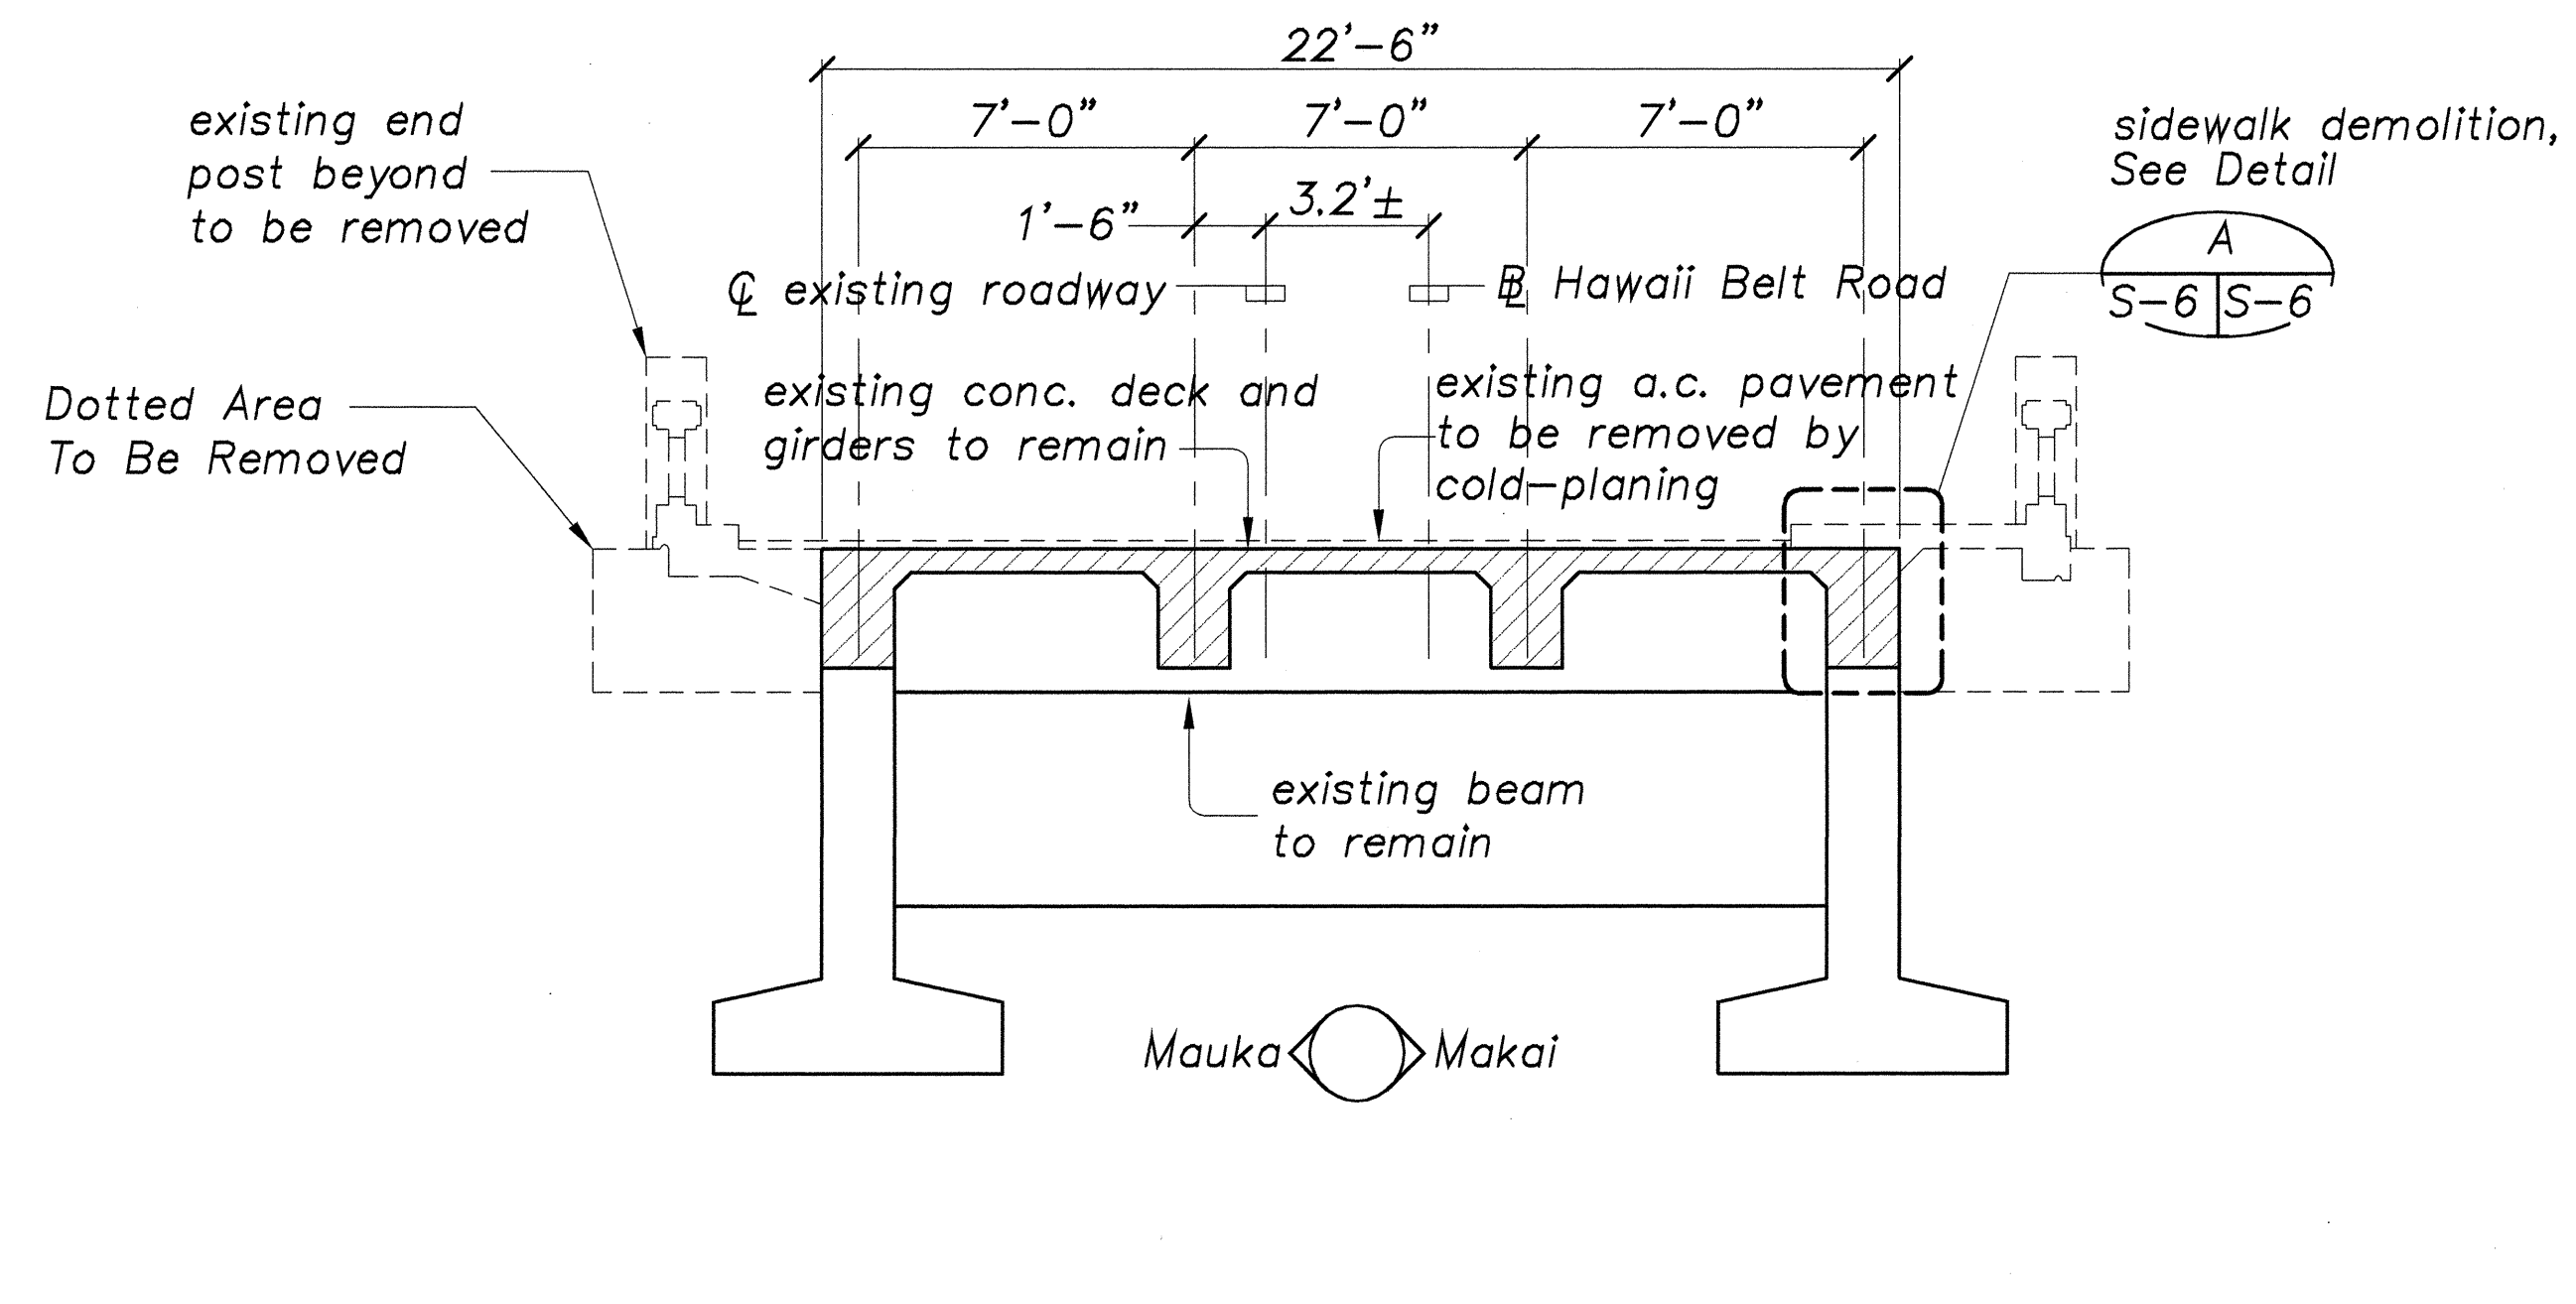


EXISTING ABUTMENT NO. 2

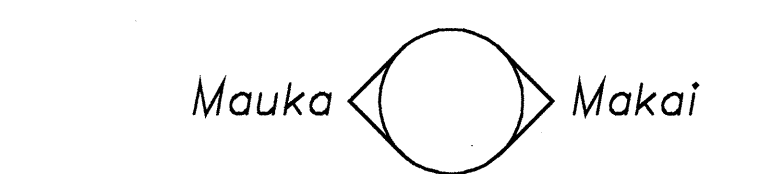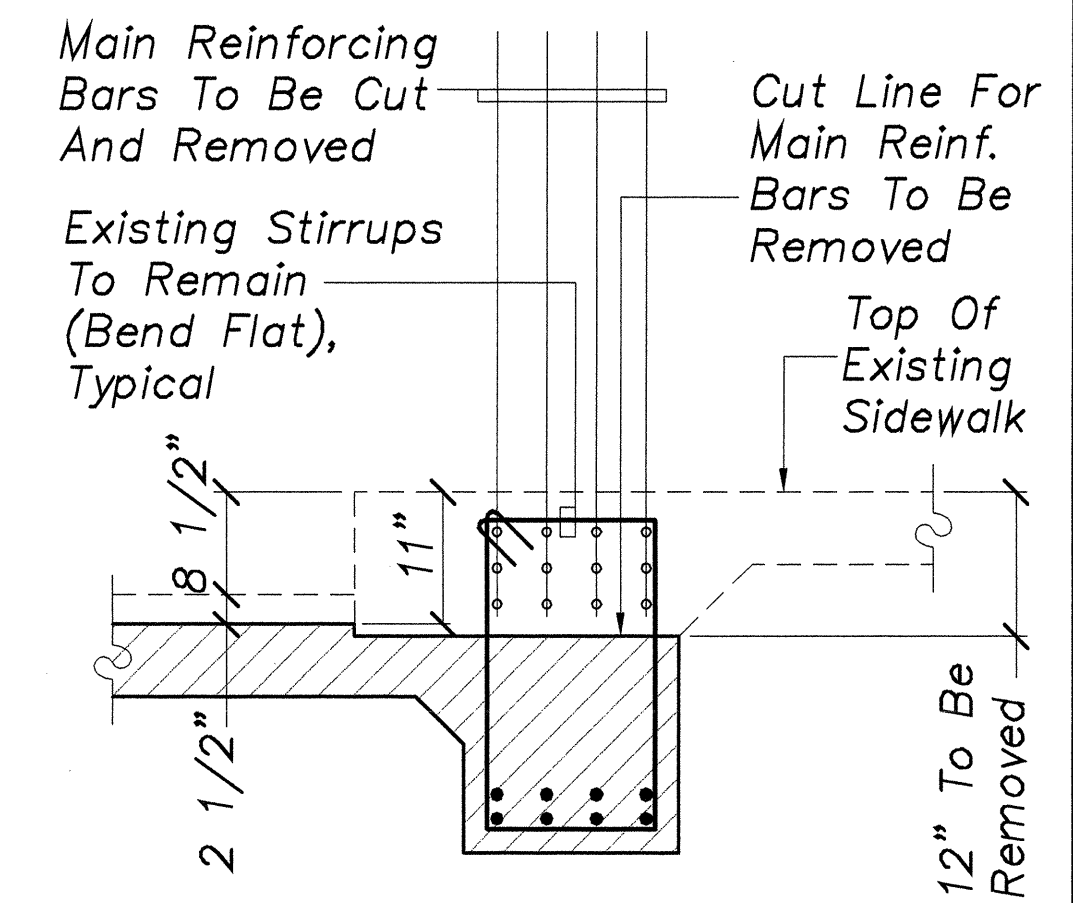

SECTION
Scale: 3/4"=1'-0"



DEMOLITION CROSS SECTIONS

Scale: 1/4"=1'-0"

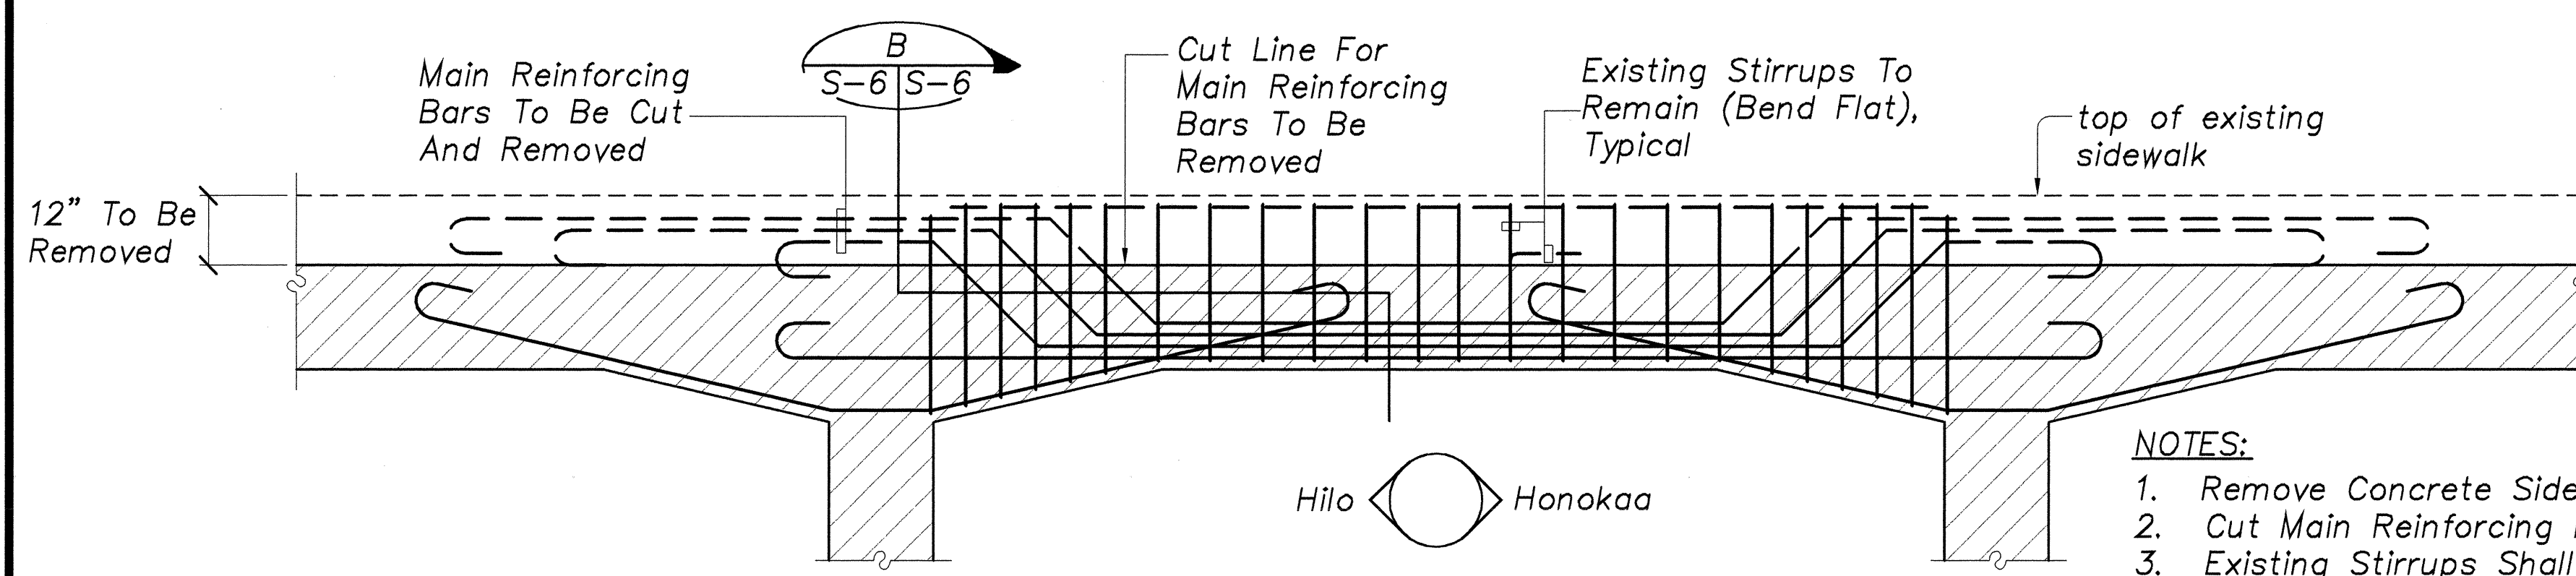

SIDEWALK DEMOLITION DETAIL
Scale: 1/2"=1'-0"

- NOTES:
1. Remove Concrete Sidewalk To Cut Line As Shown.
 2. Cut Main Reinforcing Bars At Cut Line.
 3. Existing Stirrups Shall Remain And Shall Be Bent Flat Into Horizontal Plane.
 4. Refer To "Structural Notes 10" For Additional Notes.
 5. Reinforcing Overlapping From Adjoining Spans Not Shown.

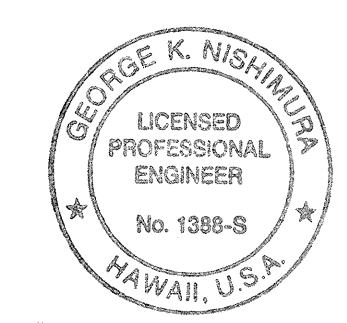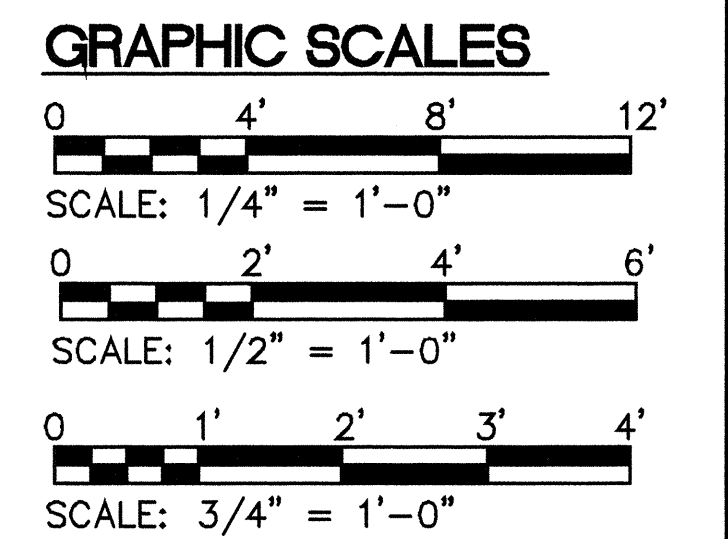

THIS WORK WAS PREPARED BY
ME OR UNDER MY SUPERVISION
[Signature]


STATE OF HAWAII
DEPARTMENT OF TRANSPORTATION
HIGHWAYS DIVISION
DEMOLITION CROSS SECTIONS,
SIDEWALK DEMOLITION

HAWAII BELT ROAD
KUPAPAUOLA BRIDGE WIDENING
HAMAKUA DISTRICT
Federal Aid Project No. BR-019-2(38)
SCALE: AS NOTED DATE: OCT., 2001
SHEET No. S-6 OF 30 SHEETS


SURVEY PLOTTED BY	DATE
DESIGNED BY	
NOTED BY	
CHECKED BY	
ORIGINAL PLAN	
NOTE BOOK	
No.	

Note:
Pier No. Refers To
Existing Identification
Number.


FED. ROAD DIST. NO.	STATE	FED. AID PROJ. NO.	FISCAL YEAR	SHEET NO.	TOTAL SHEETS
HAWAII	HAW.	BR-019-2(38)	2002	50A S-1	79

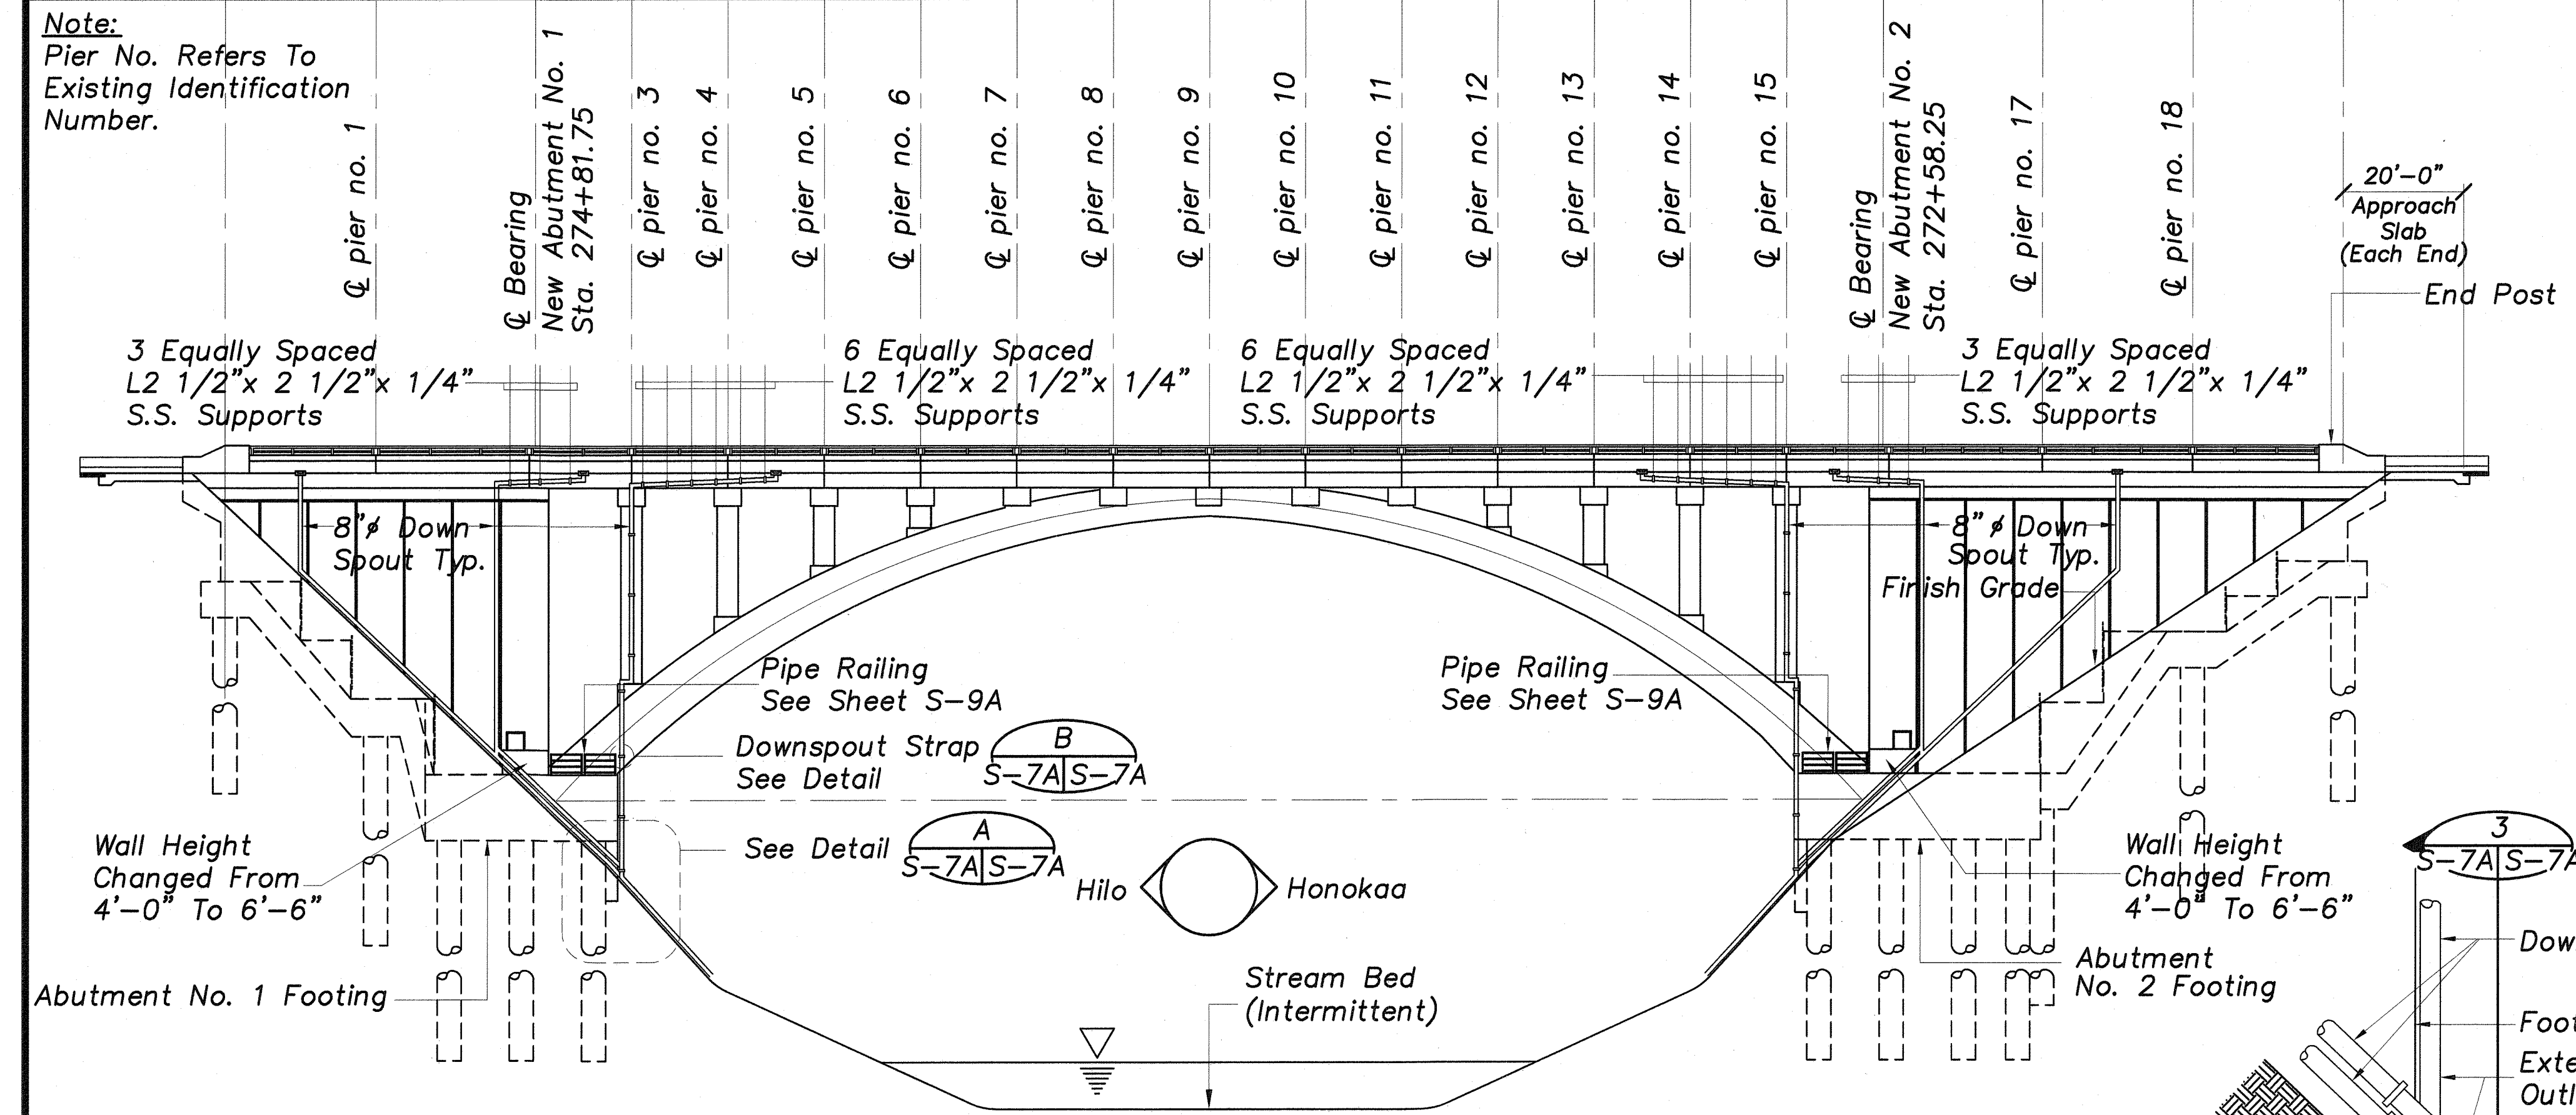


BRIDGE ELEVATION W/ DOWNSPOUTS
Scale: 1"=20'-0"

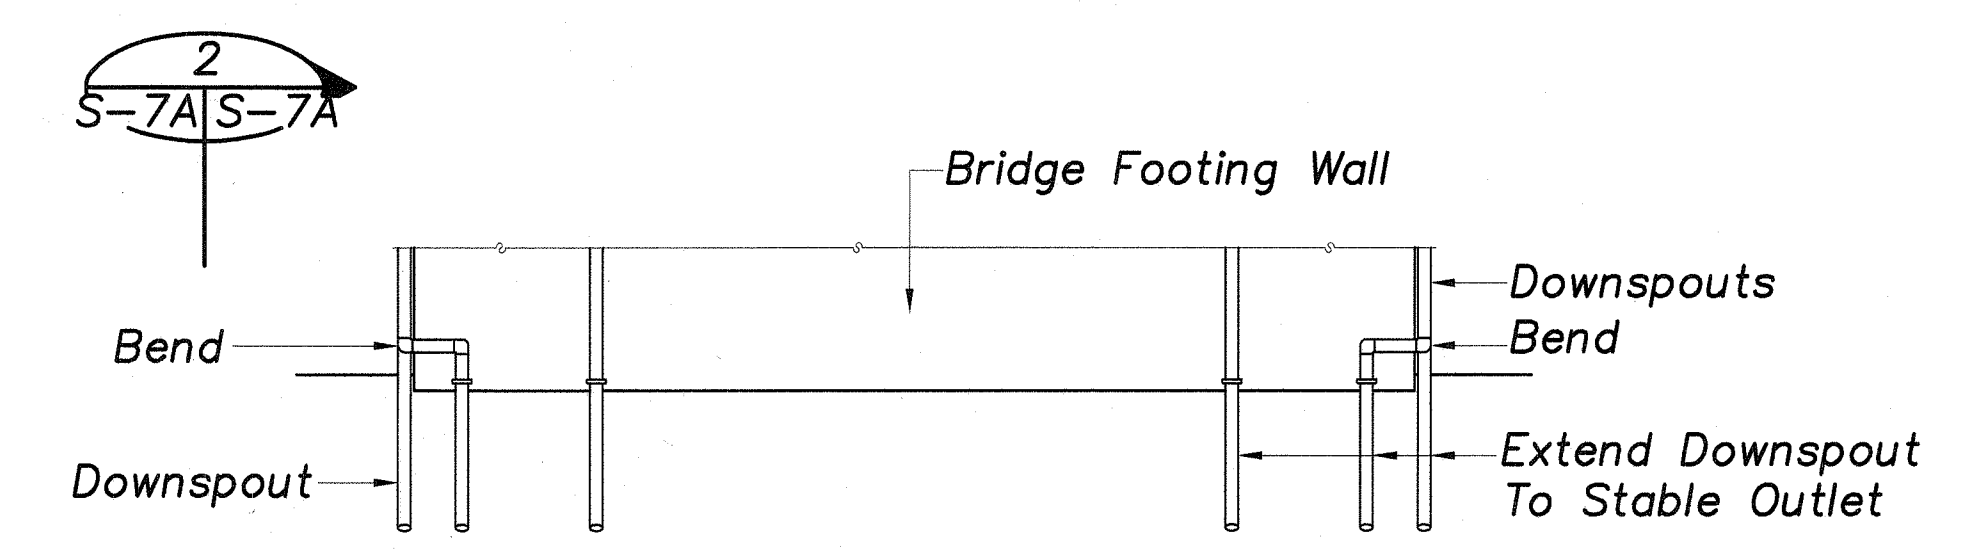


DOWNSPOUT ELEVATION
Scale: 1"=10'-0"

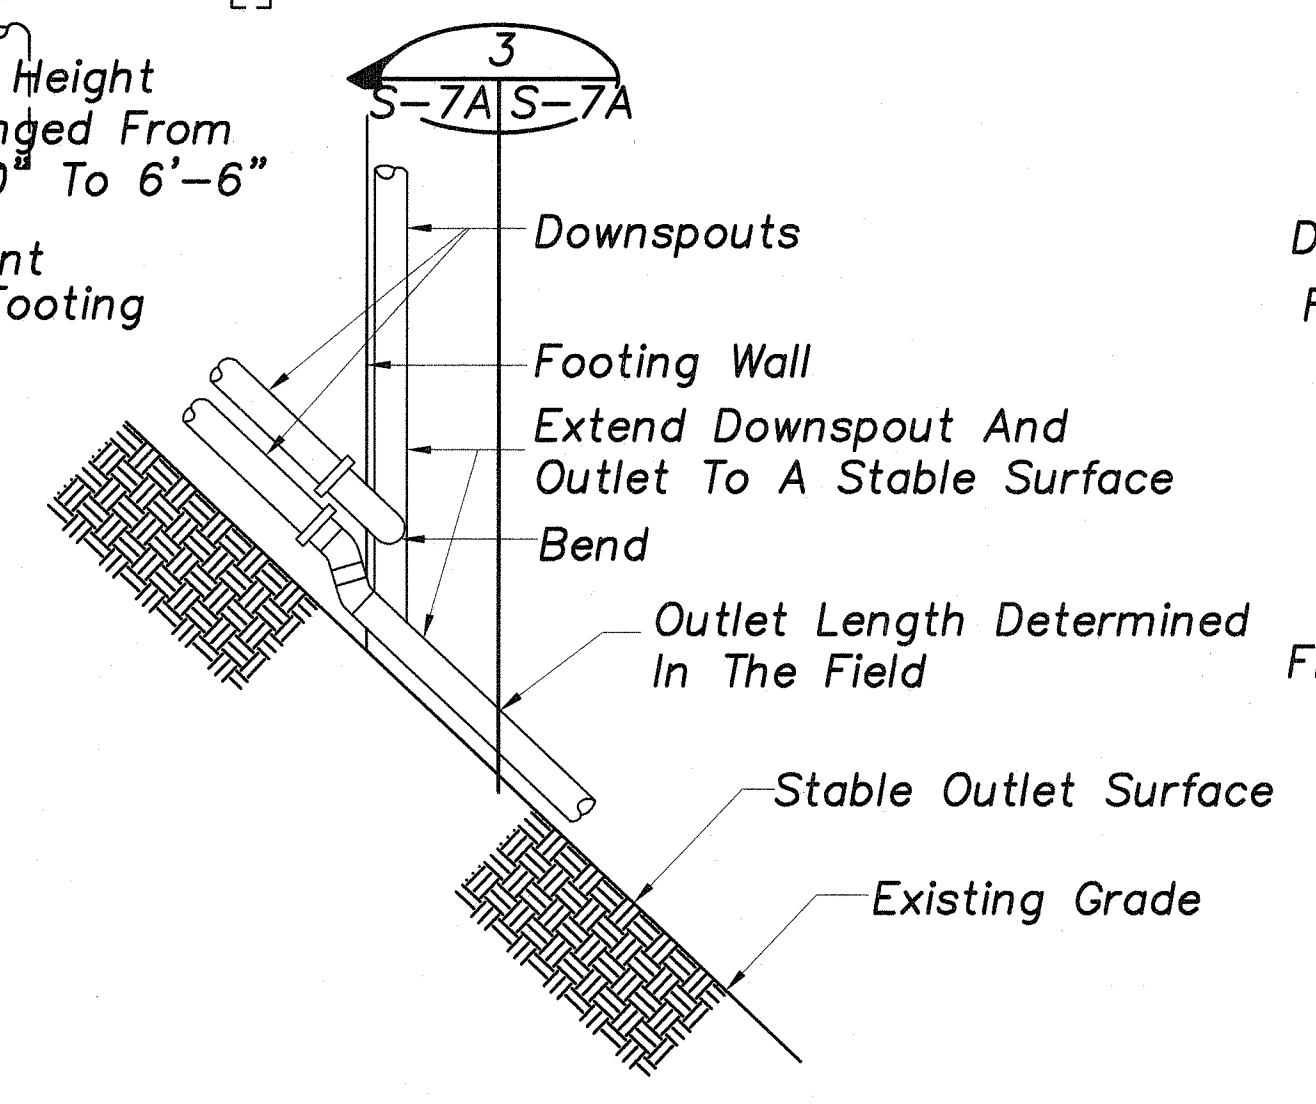


DETAIL
Scale: 1/4"=1'-0"

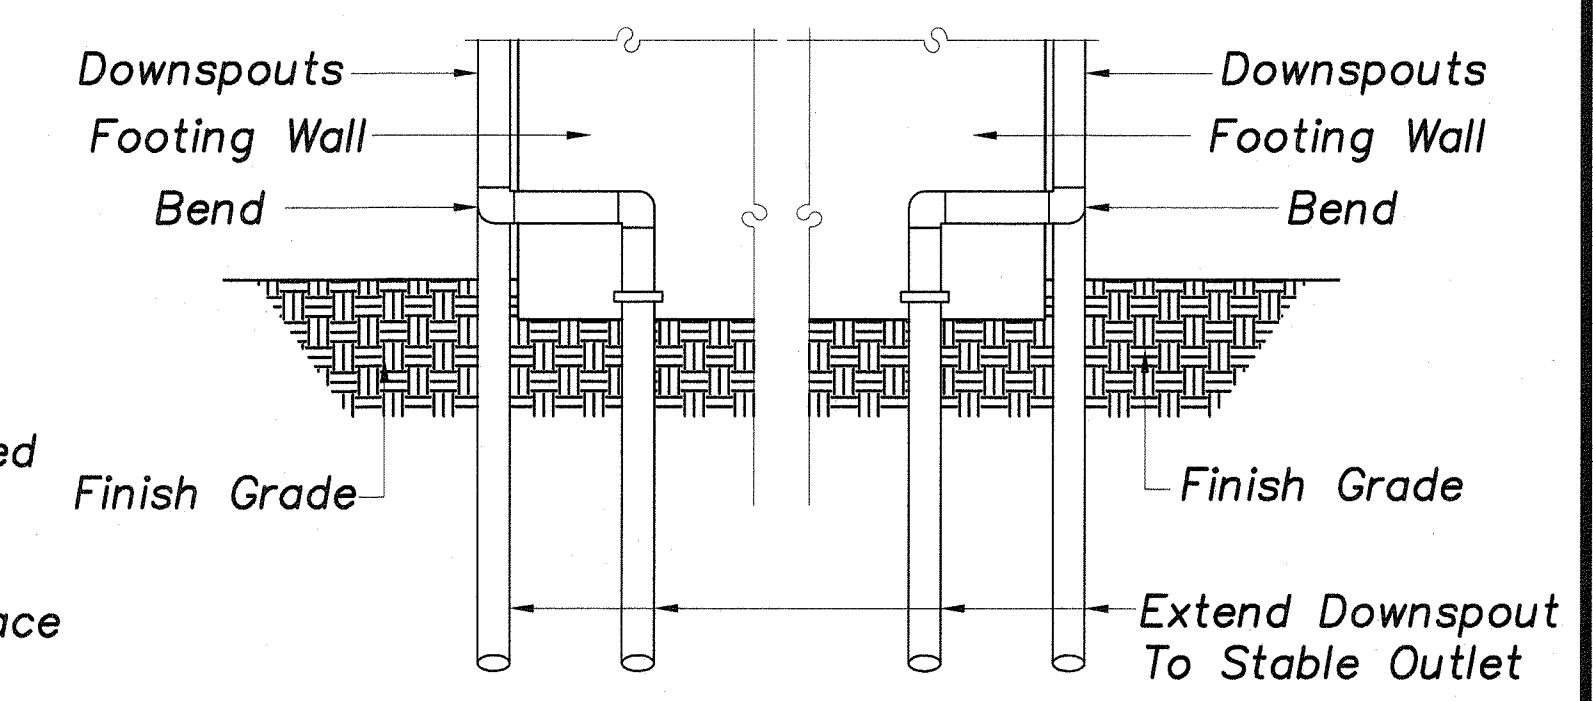


SECTION
Scale: 1/4"=1'-0"

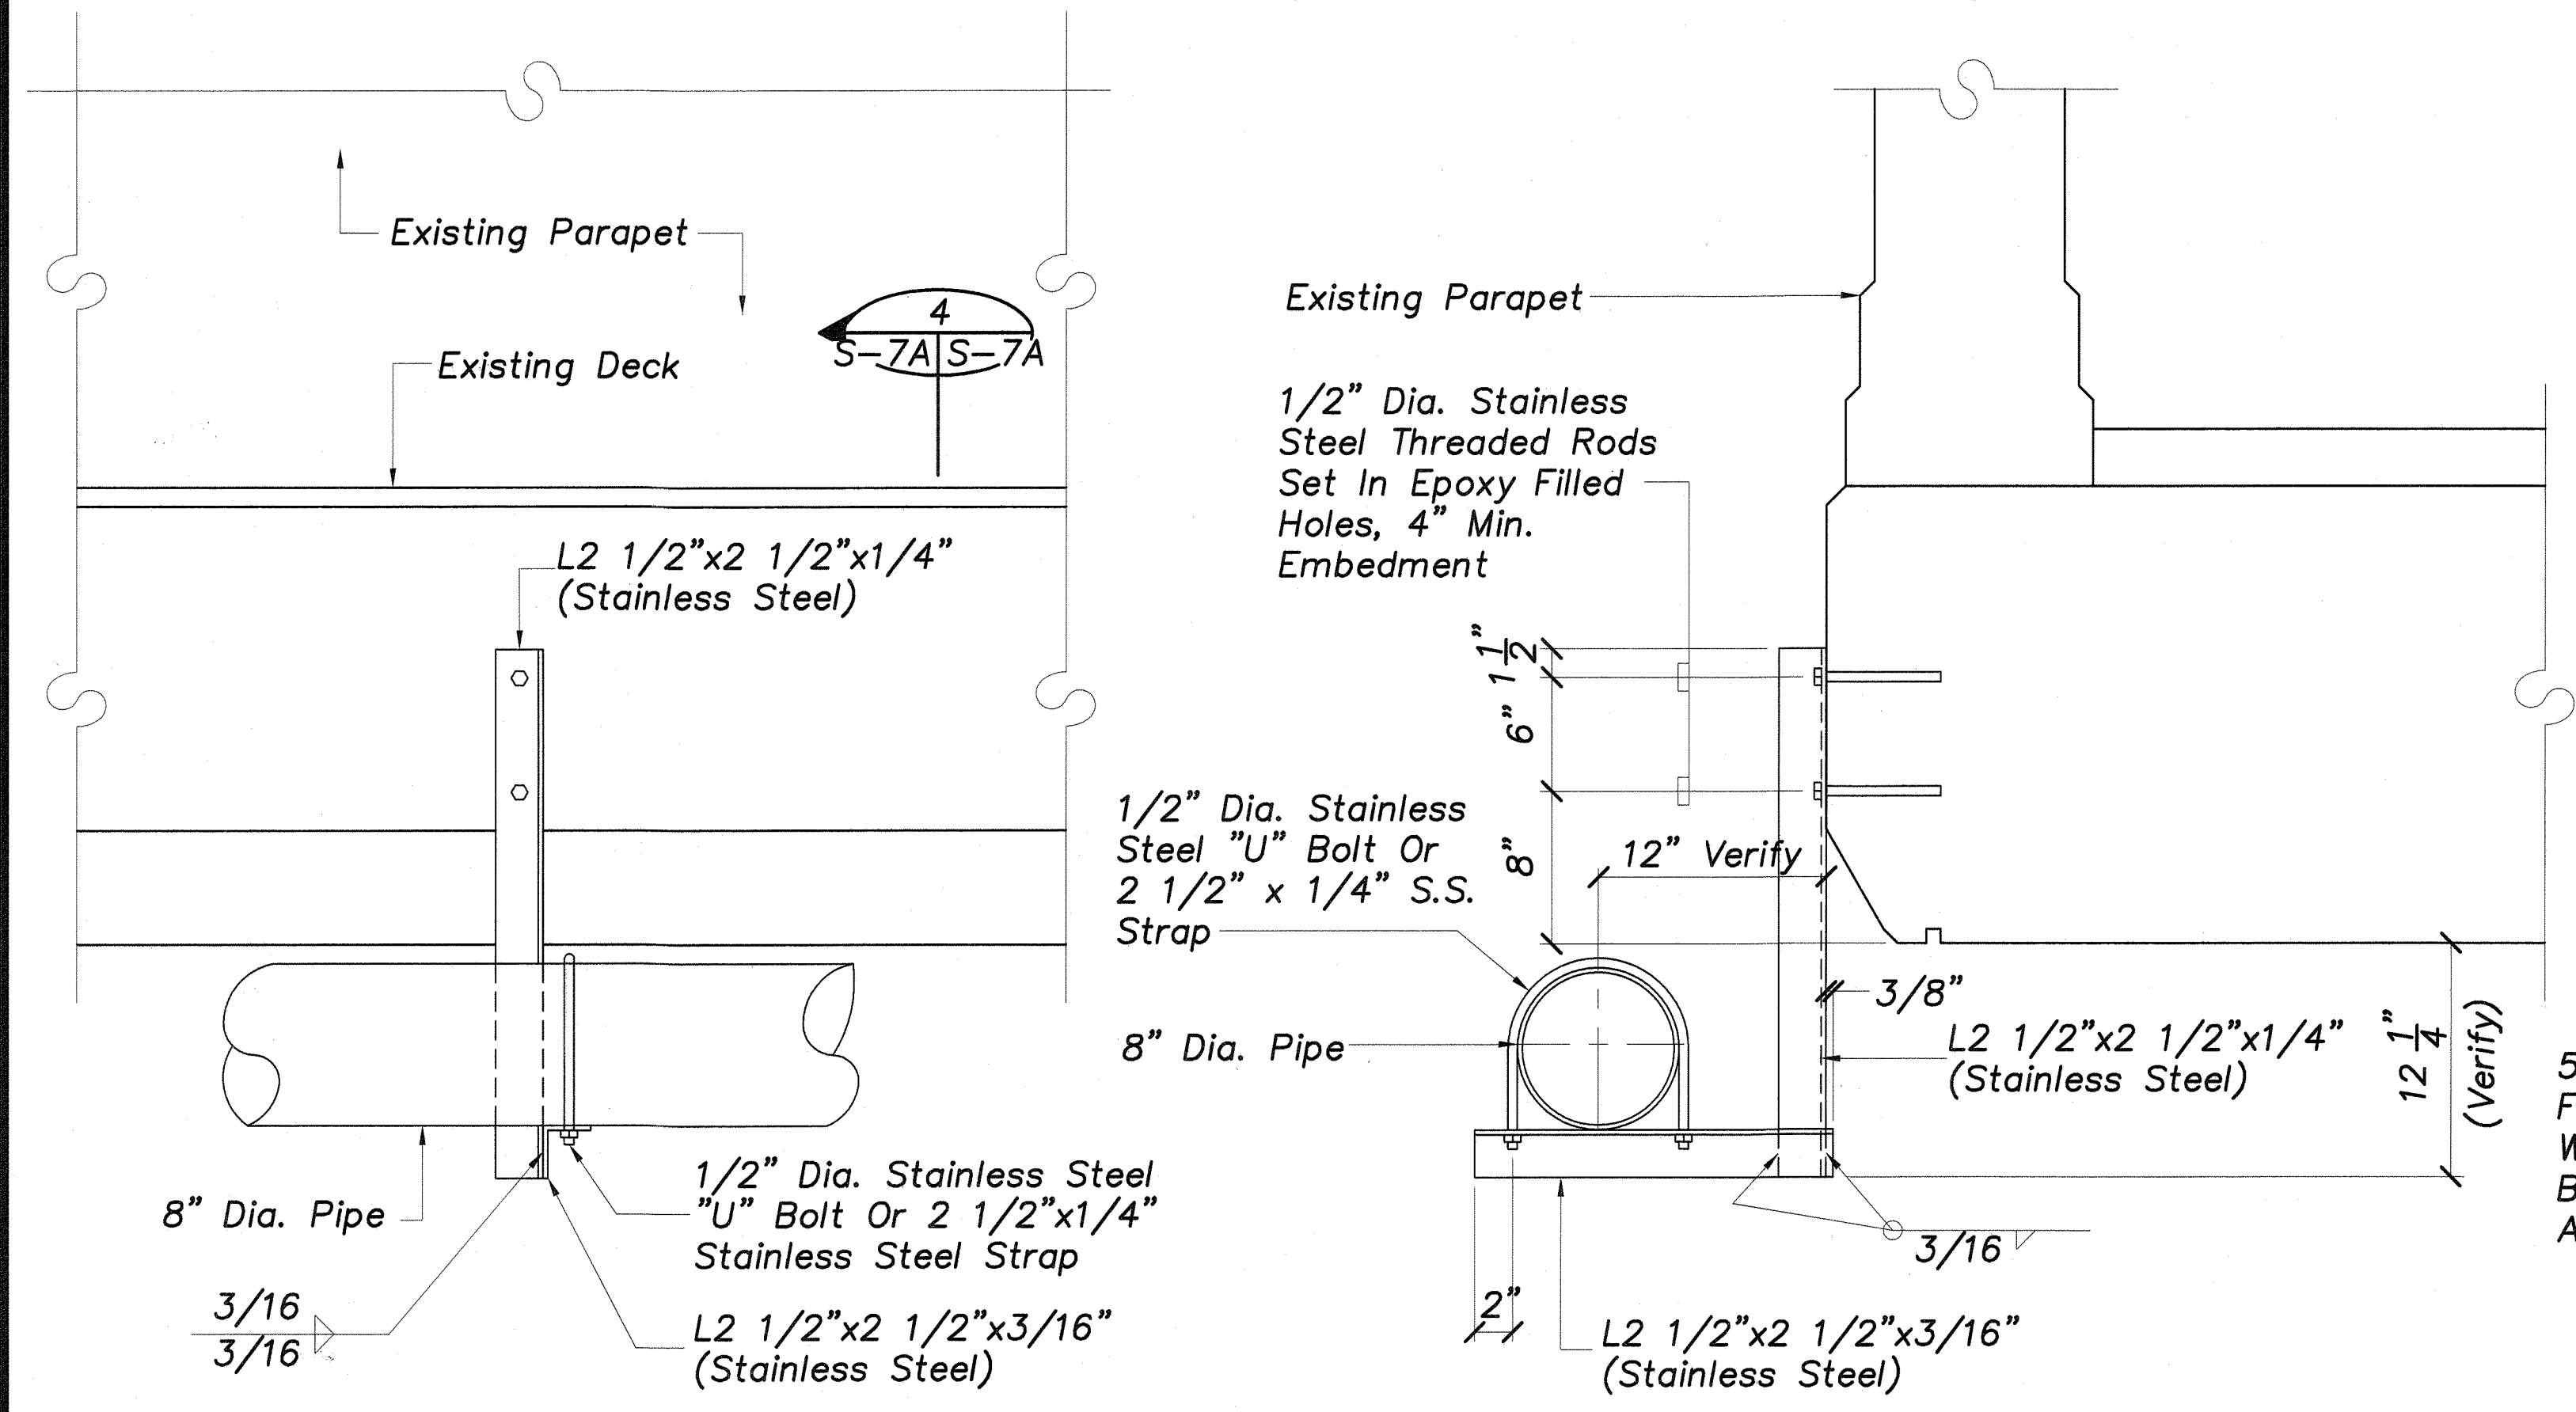

PIPE SUPPORT ELEVATION
Scale: 1 1/2"=1'-0"

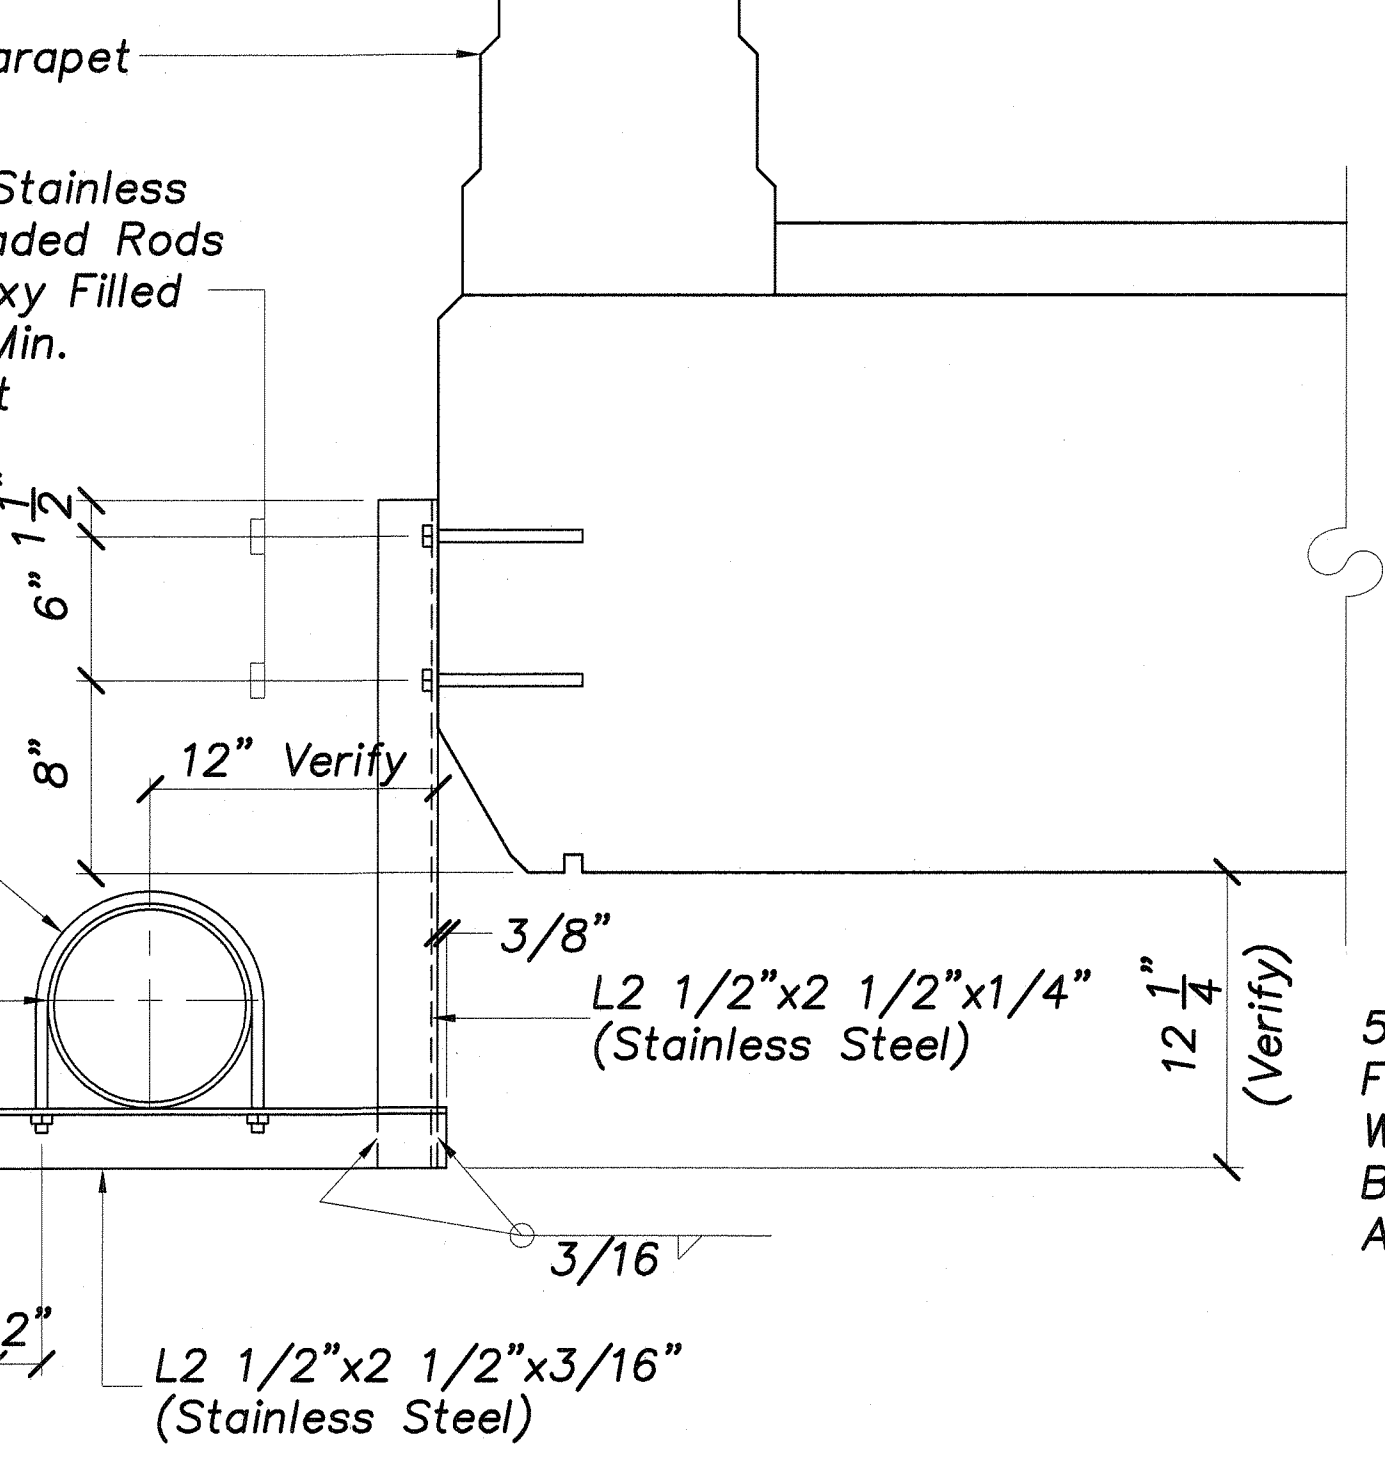


SECTION
Scale: 1 1/2"=1'-0"

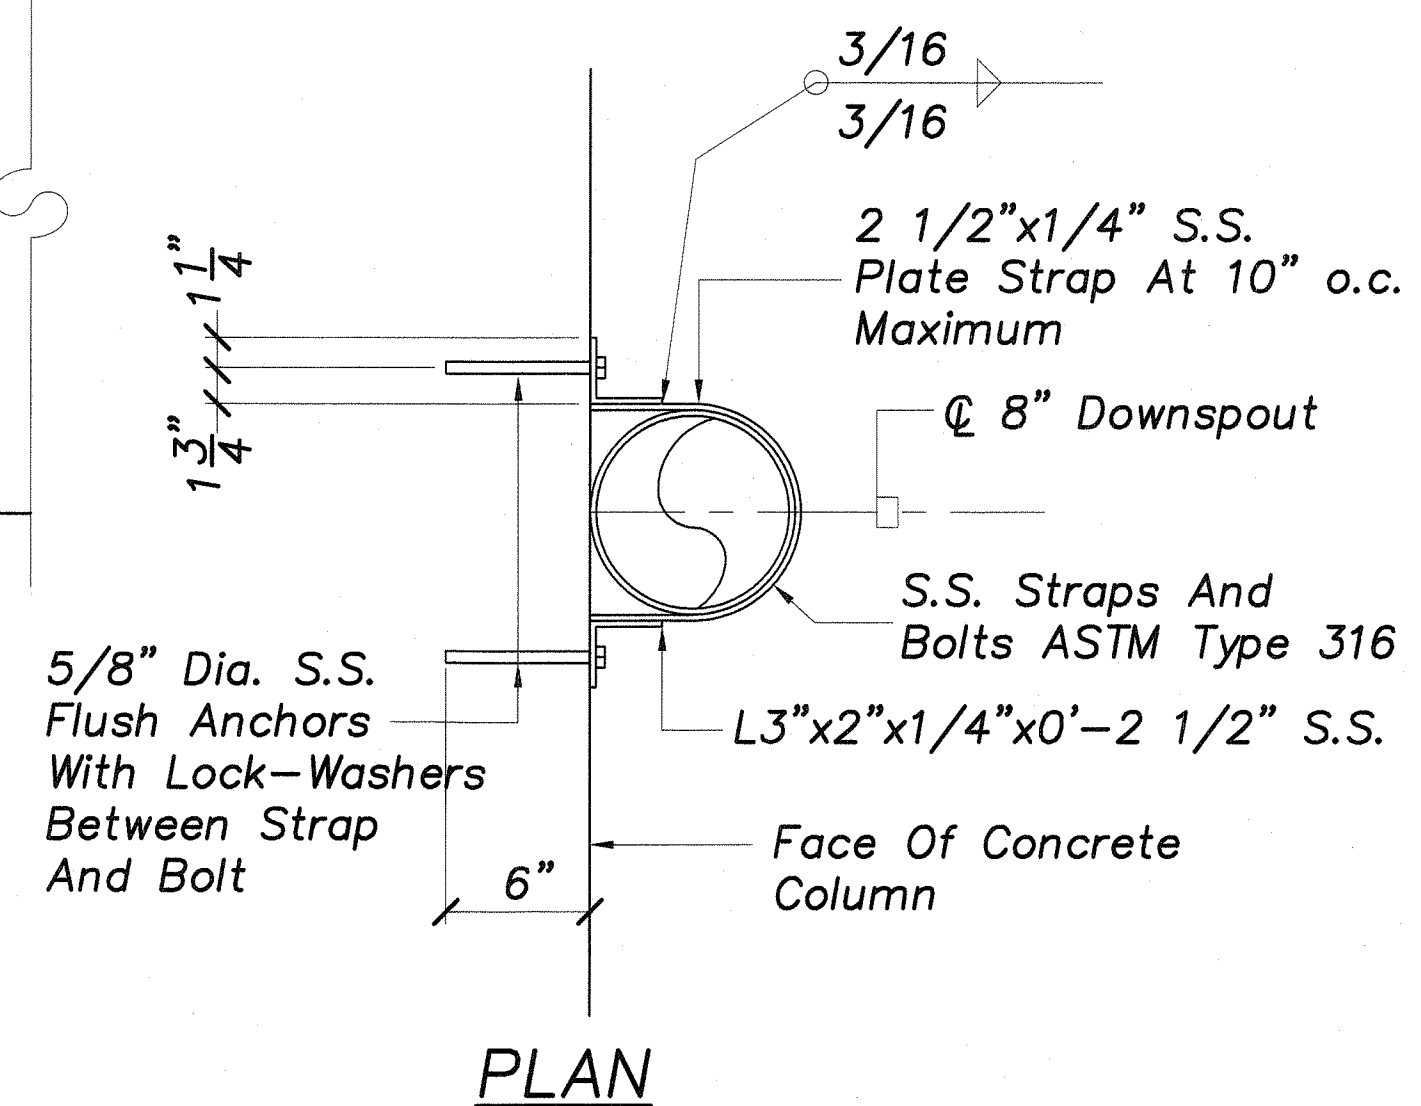

STRAP AT DOWNSPOUT
Scale: 1-1/2"=1'-0"

Note:
This Tracing Prepared During
"As-Built" Posting.

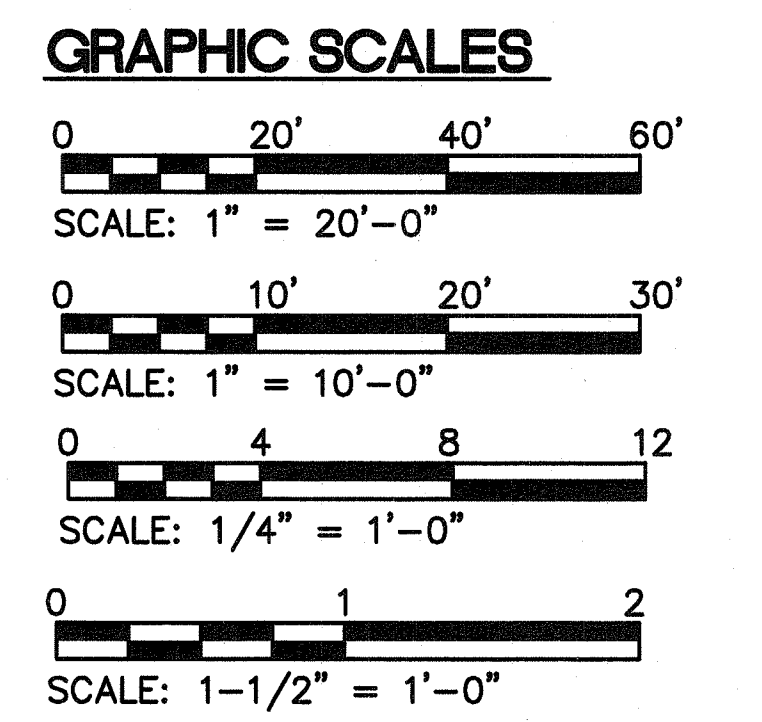


DATE	REVISION
	STATE OF HAWAII DEPARTMENT OF TRANSPORTATION HIGHWAYS DIVISION DOWNSPOUT LAYOUT AND DETAILS HAWAII BELT ROAD KUPAPULUA BRIDGE WIDENING HAMAKUA DISTRICT Federal Aid Project No. BR-019-2(38) Scale: As Noted Date: June 23, 2003 SHEET No. S-7A OF 36 SHEETS

SURVEY PLOTTED BY	DATE
DRAWN BY	
DESIGNED BY	
CHECKED BY	
ORIGINAL PLAN	
NO.	

"AS-BUILT"


50A S-1

FED. ROAD DIST. NO.	STATE	FED. AID PROJ. NO.	FISCAL YEAR	SHEET NO.	TOTAL SHEETS
HAWAII	HAW.	BR-019-2(38)	2002	51A	79

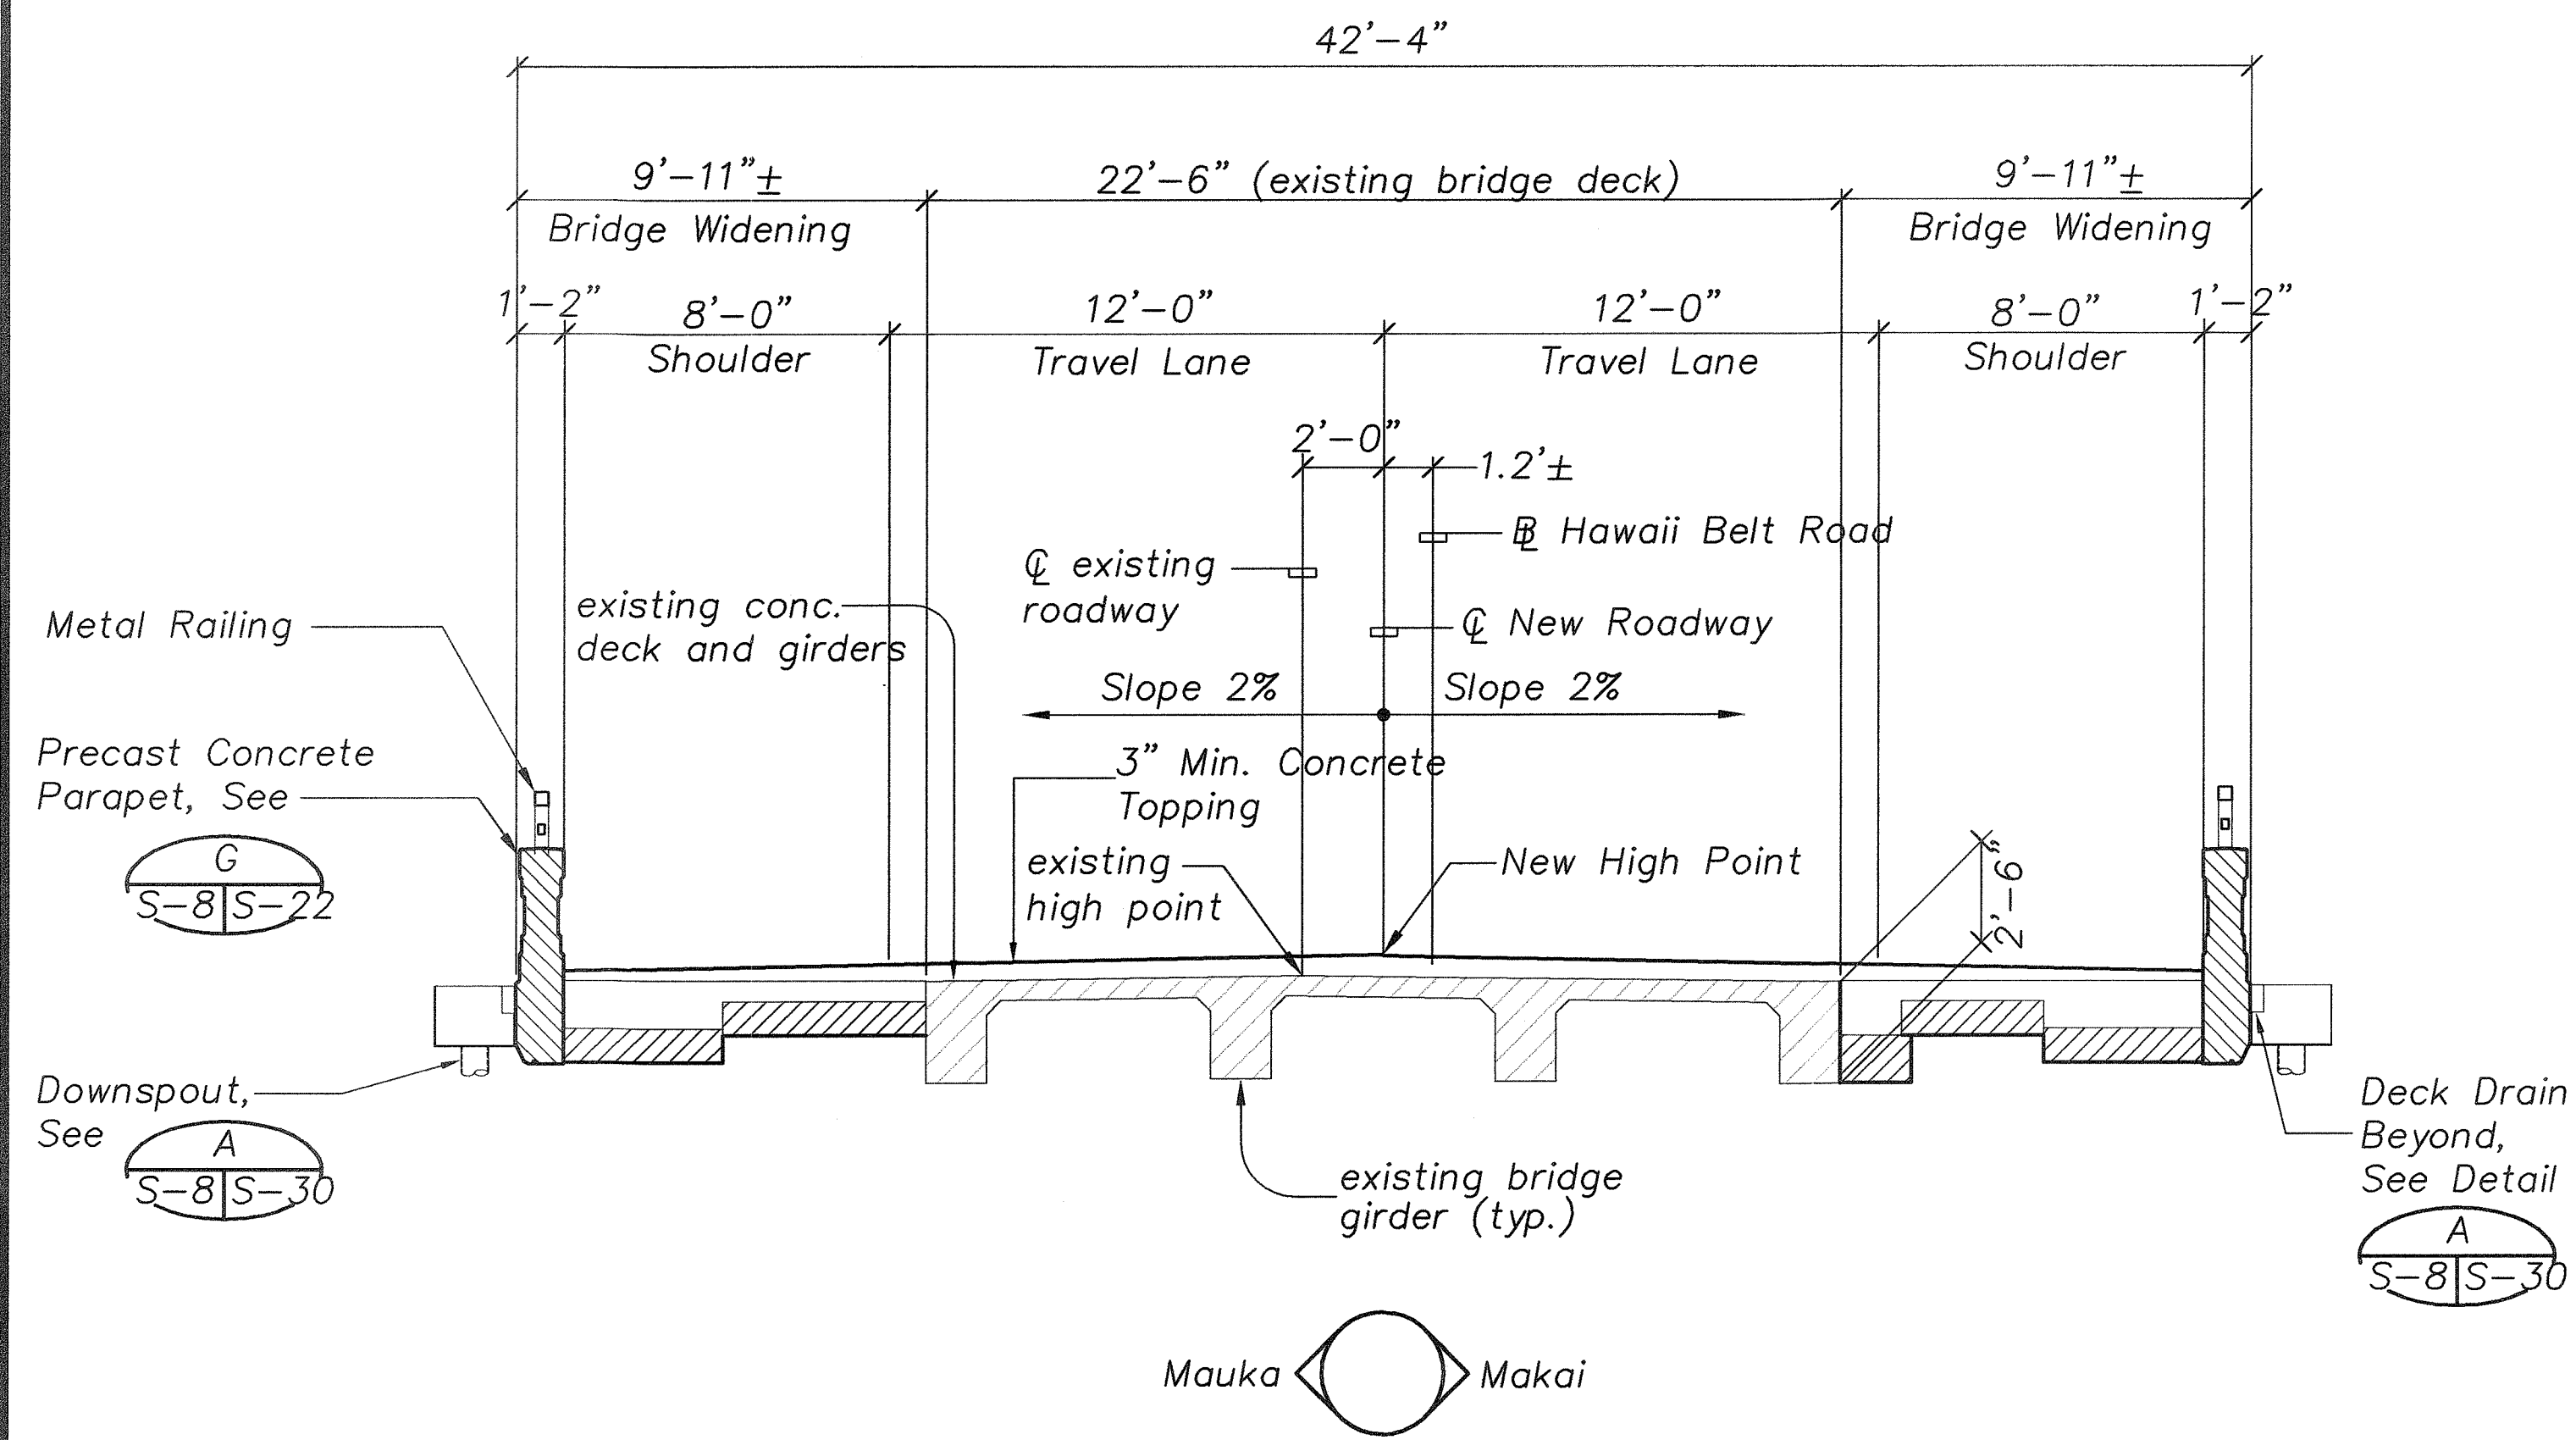

TYPICAL NEW DECK SECTION

Scale: 1/4"=1'-0"

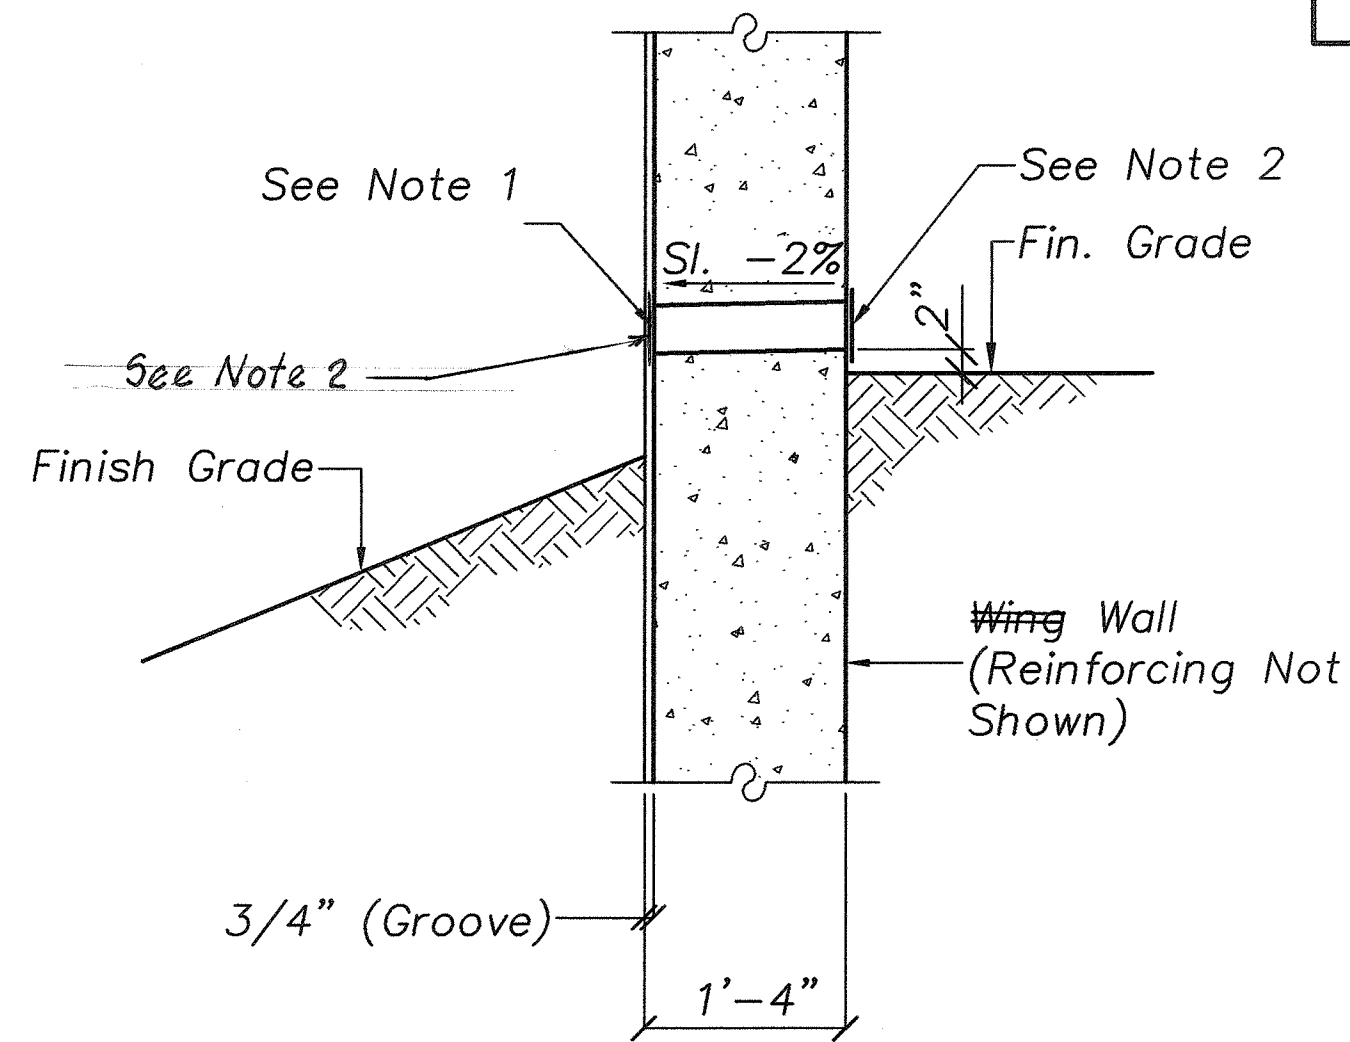


Notes:

- Provide 4" Diameter PVC Pipe Drains at 8'-0" o.c.. Maximum 2" above Top of Abutment Footings in Abutment Walls. Adjust Reinforcing Bars, as Required, To Clear Drains.
- 6" Square ~~Galvanized Steel Wire 1/4" Mesh Hardware Cloth~~ (Minimum Wire Diameter 0.025"). Anchor Firmly To ~~Back face~~ both face of ~~Wing Wall~~.

WEEPHOLE DETAIL

S-8, S-9
S-11, S-14



Scale: 3/4"=1'-0"

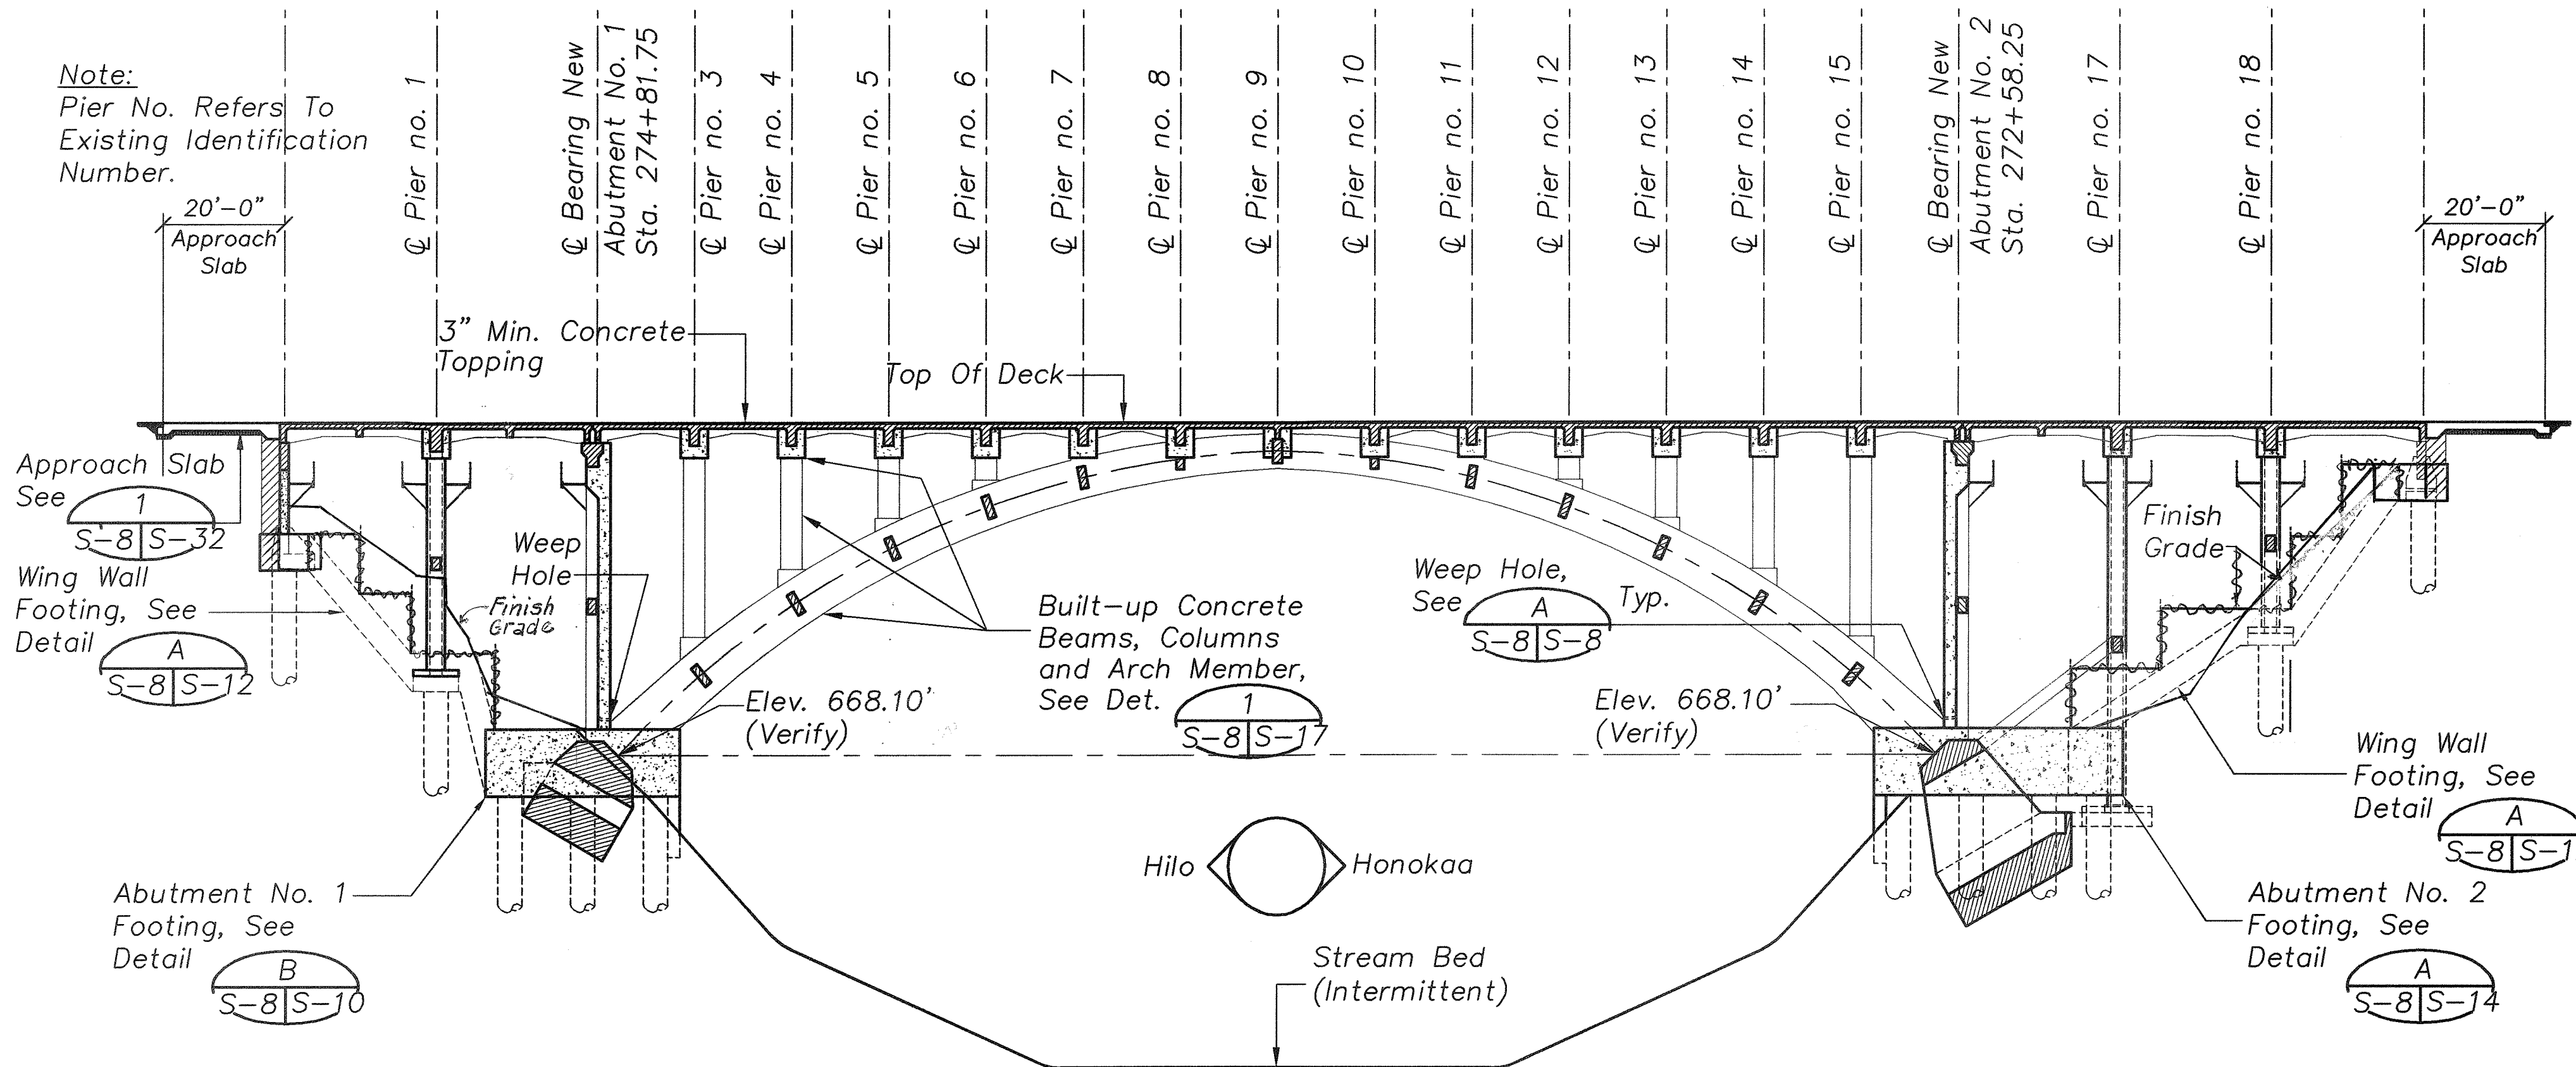

NEW BRIDGE SECTION AT & NEW ROADWAY

Scale: 1"=20'-0"

GRAPHIC SCALES

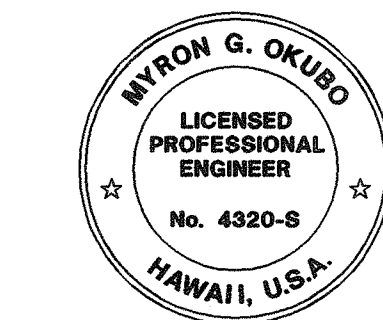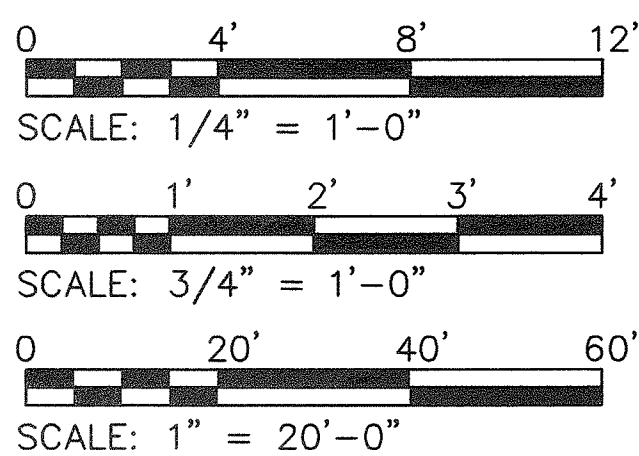


THIS WORK WAS PREPARED BY ME OR UNDER MY SUPERVISION

Myron Okubo

DATE	REVISION
STATE OF HAWAII DEPARTMENT OF TRANSPORTATION HIGHWAYS DIVISION	
NEW BRIDGE LONGITUDINAL SECTION, TYPICAL NEW DECK SECTION HAWAII BELT ROAD KUPAPAUUA BRIDGE WIDENING HAMAKUA DISTRICT Federal Aid Project No. BR-019-2(38)	
Scale: As Noted	Date: June 23, 2003

SHEET No. S-8 OF 36 SHEETS

FED. ROAD DIST. NO.	STATE	FED. AID PROJ. NO.	FISCAL YEAR	SHEET NO.	TOTAL SHEETS
HAWAII	HAW.	BR-019-2(38)	2002	52A	79


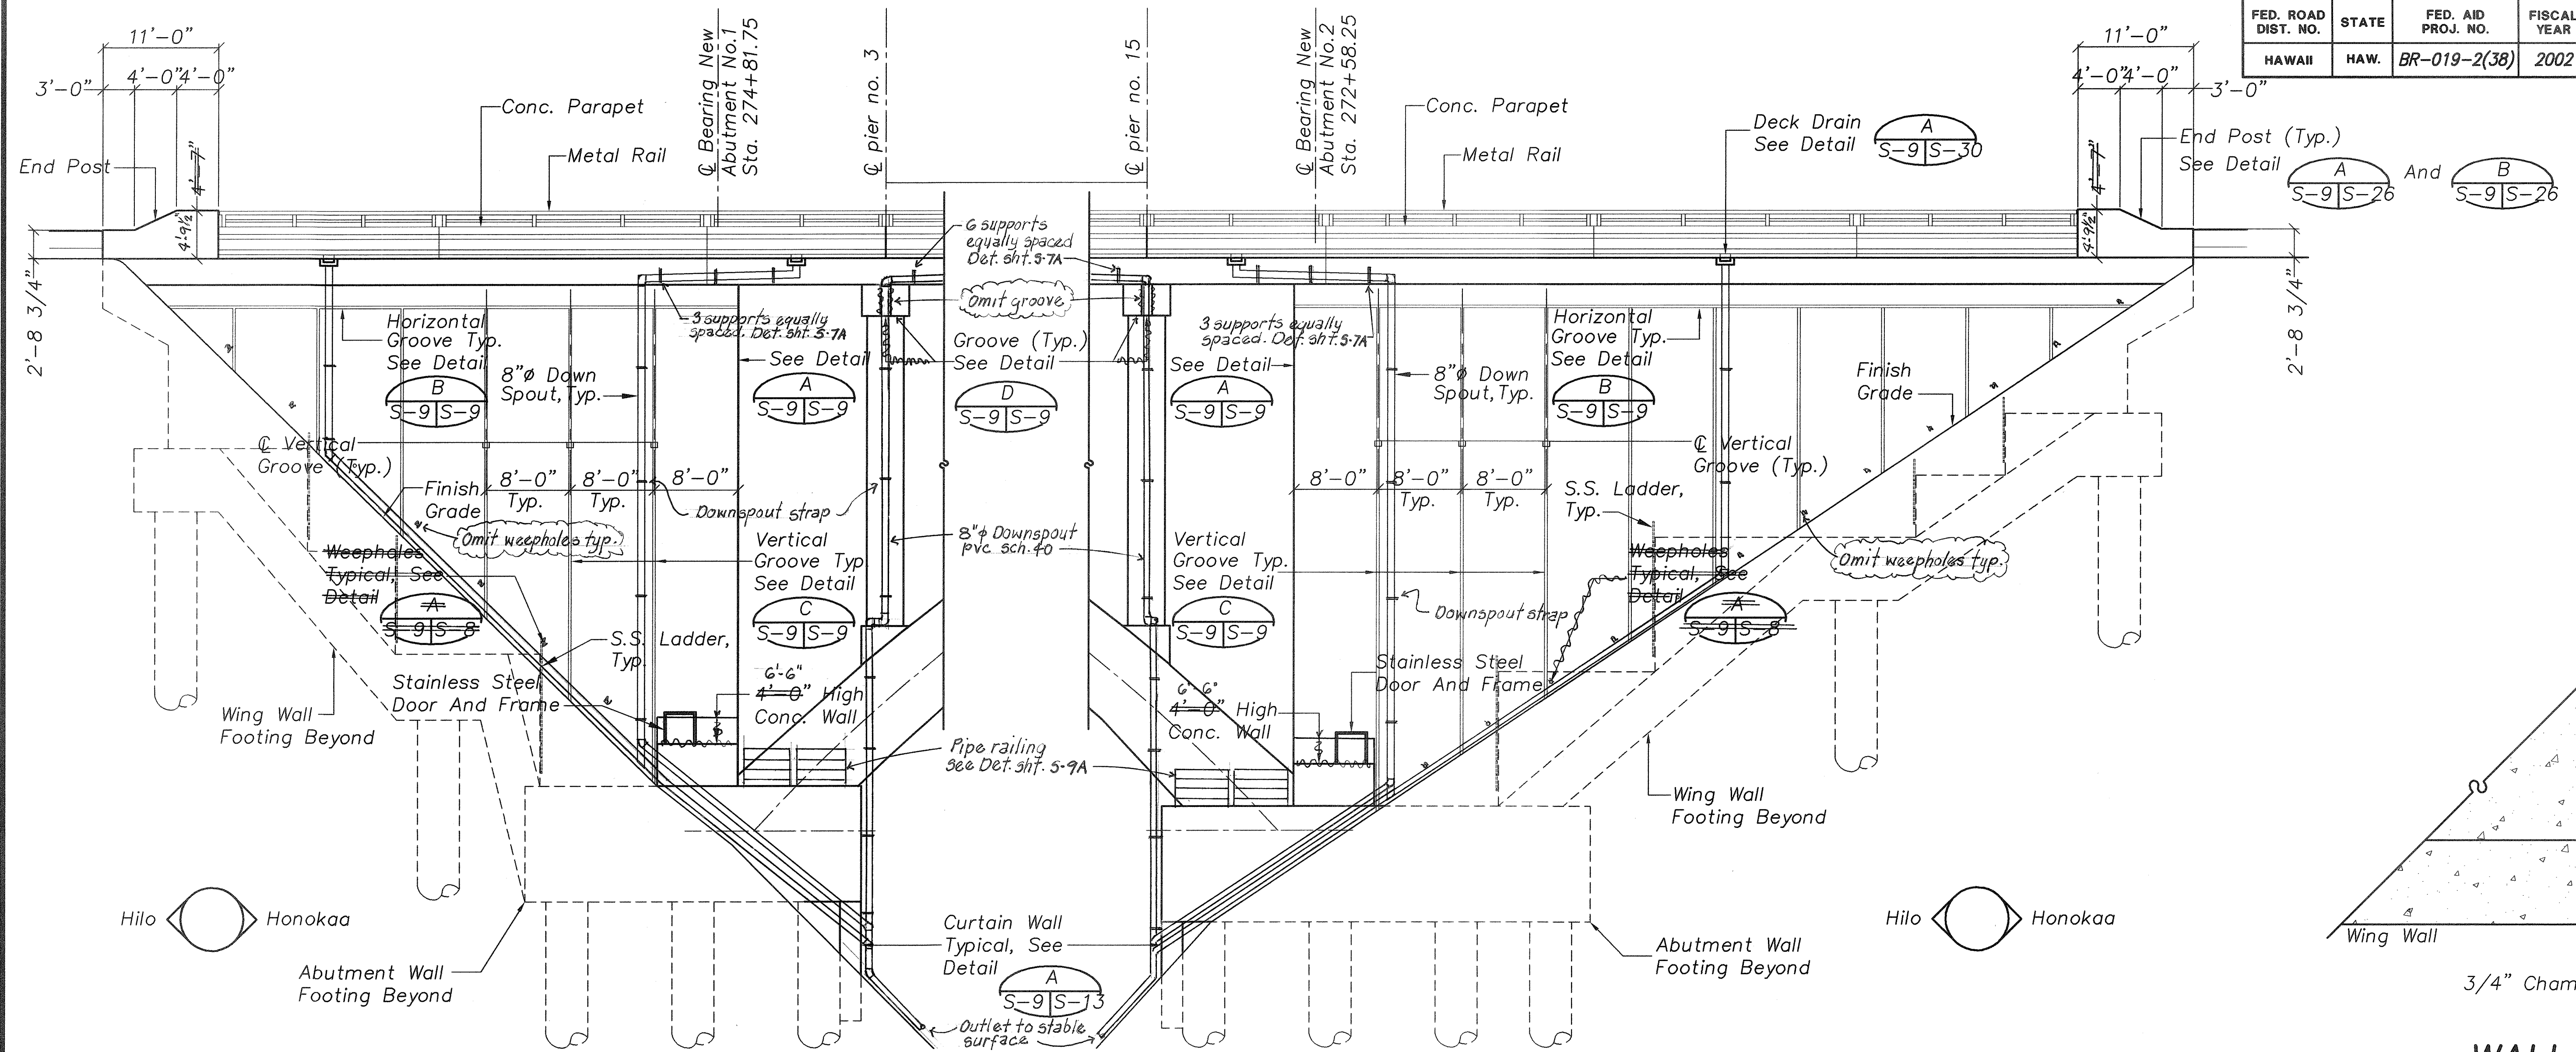


ABUTMENT NO. 1 / WING WALL MAKAI ELEVATION


Scale: 1/8"=1'-0" (Mauka Elevation Similar)

ABUTMENT NO. 2 / WING WALL MAKAI ELEVATION


Scale: 1/8"=1'-0" (Mauka Elevation Similar)

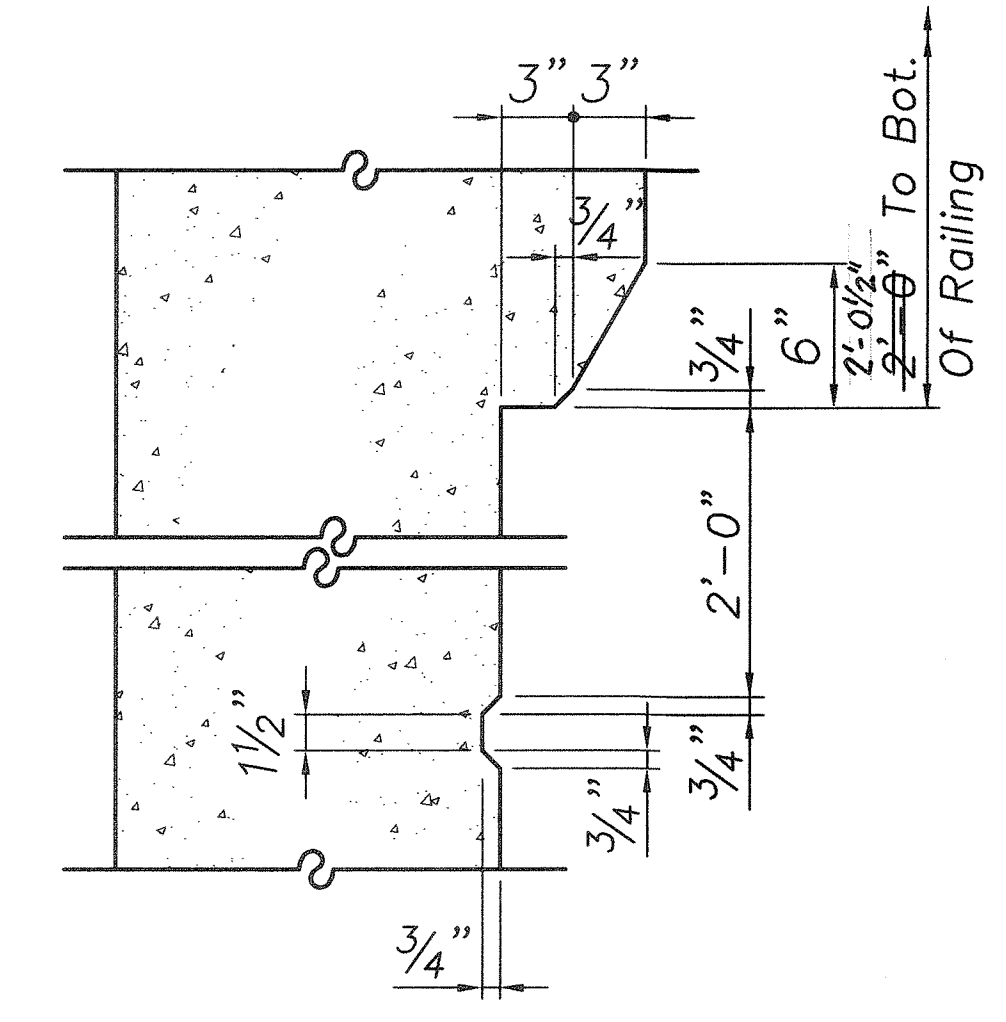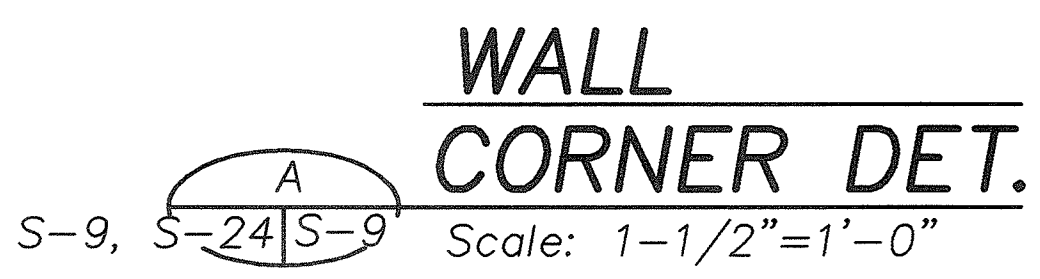


HORIZONTAL GROOVE DET.

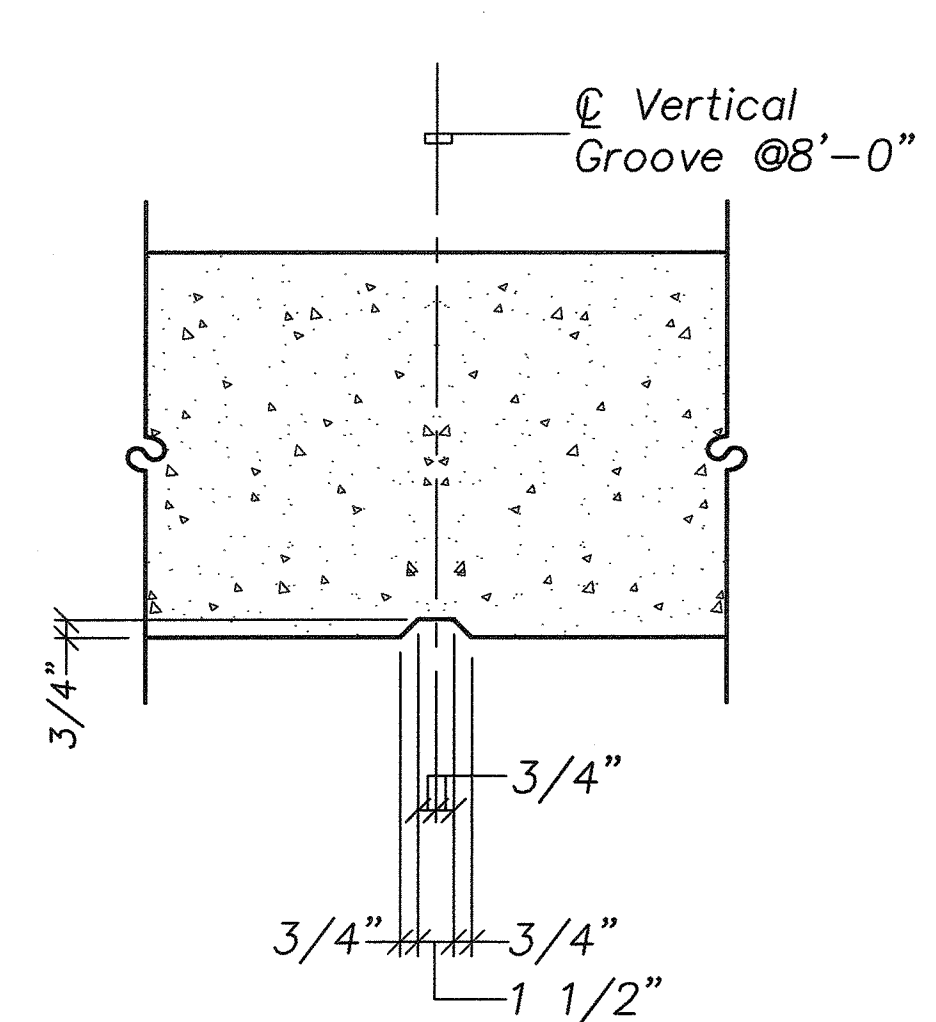


VERTICAL GROOVE DET.

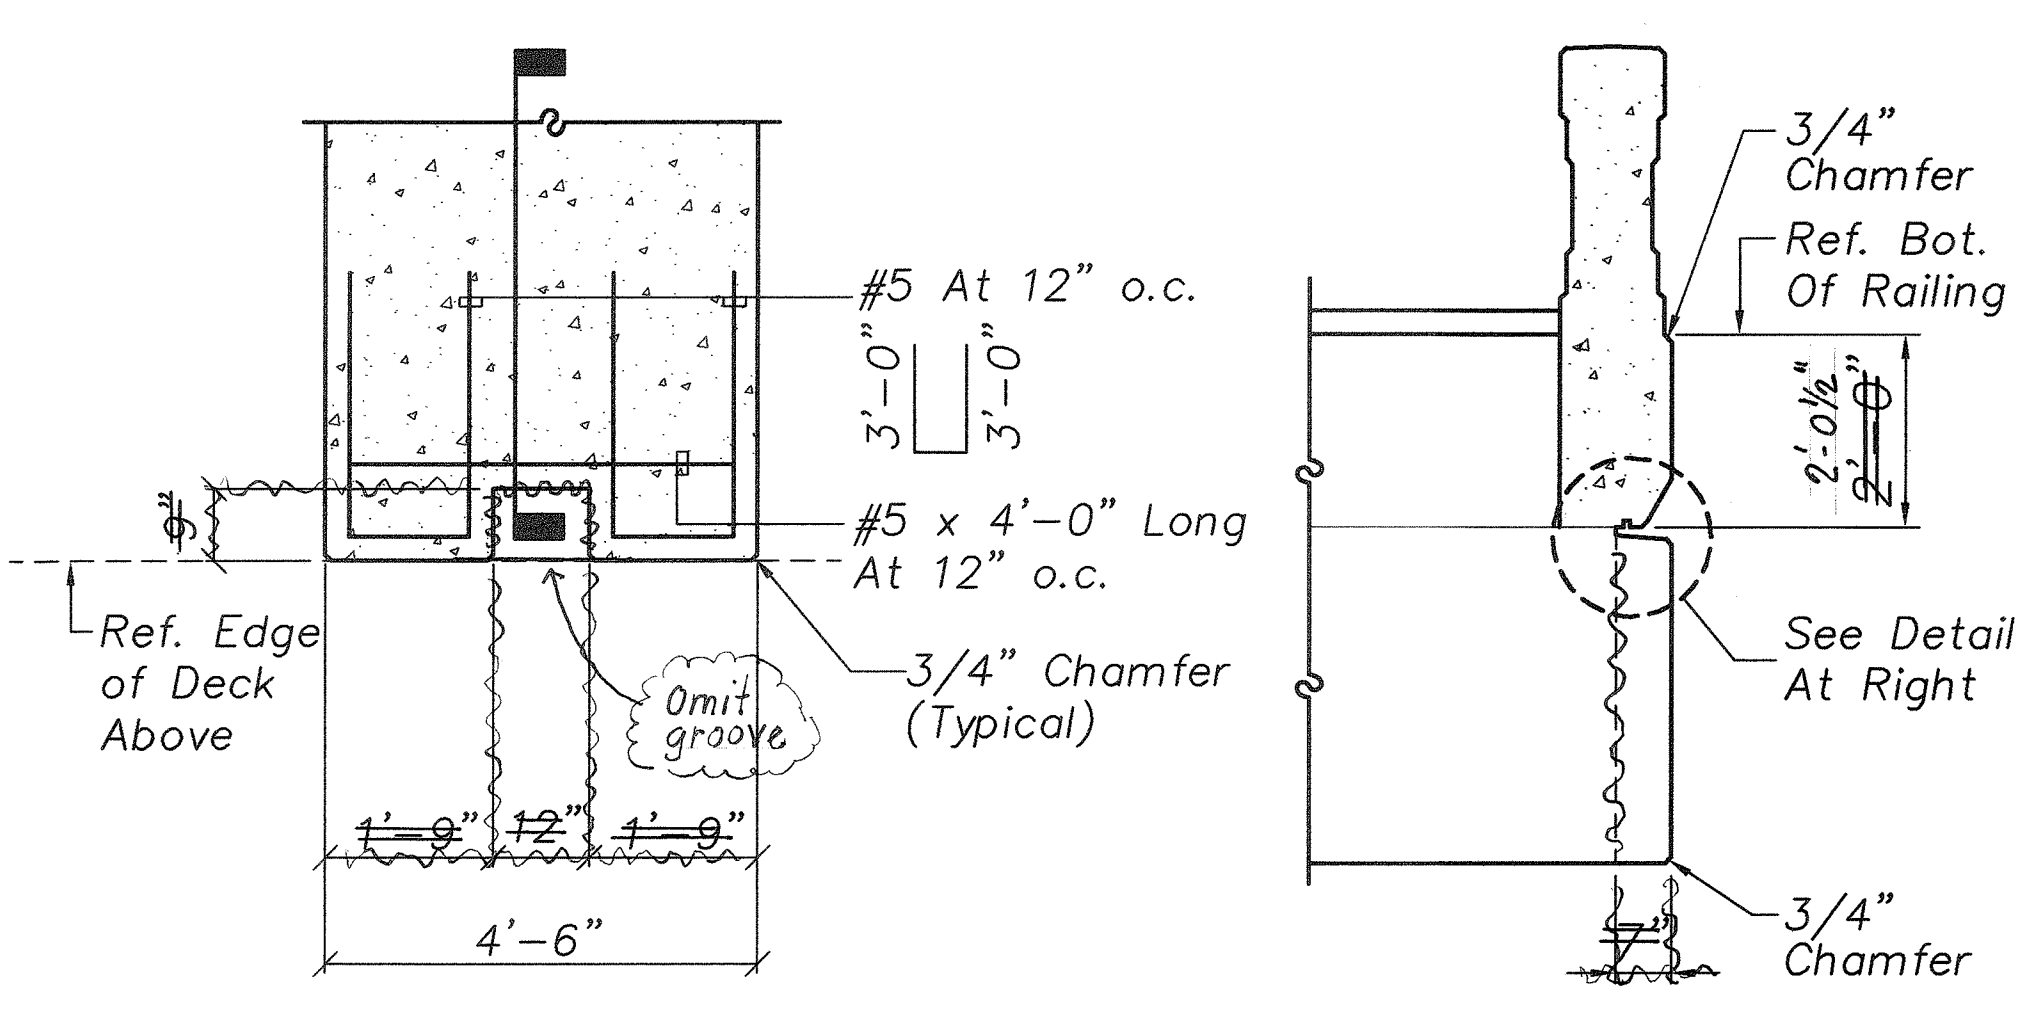


GROOVE DETAIL AT BEAM

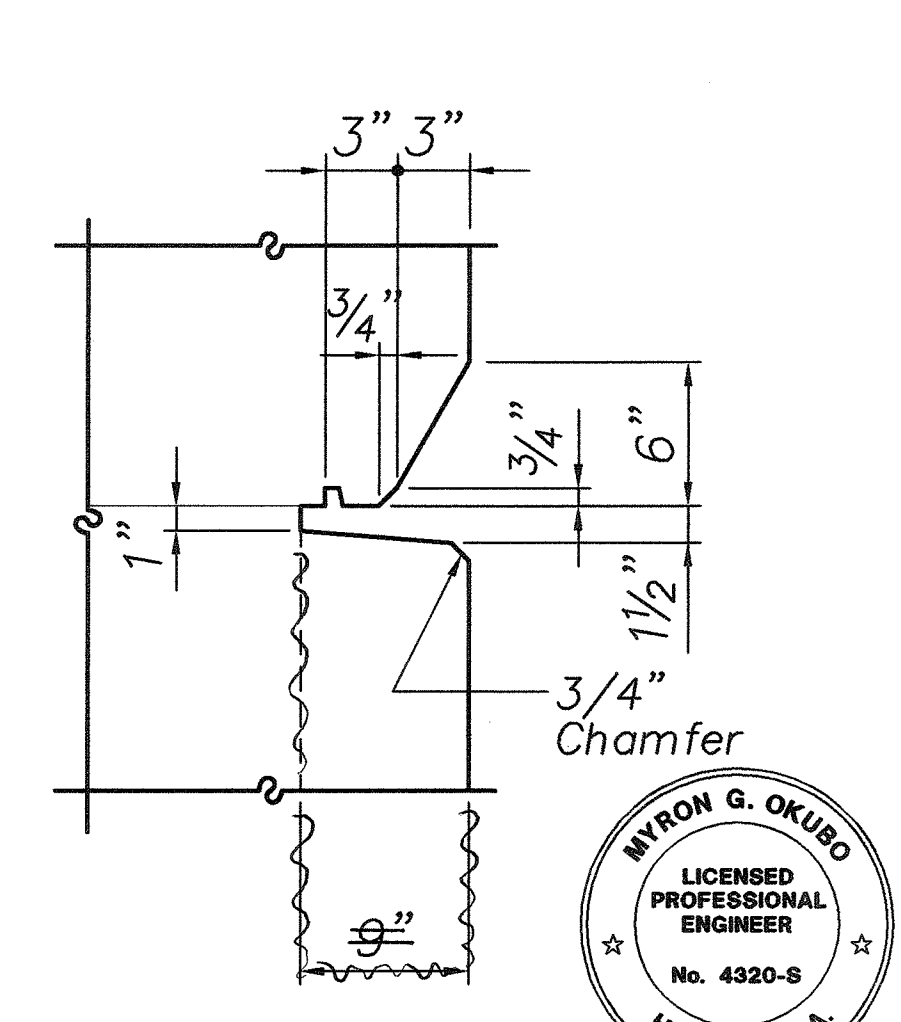

DETAIL

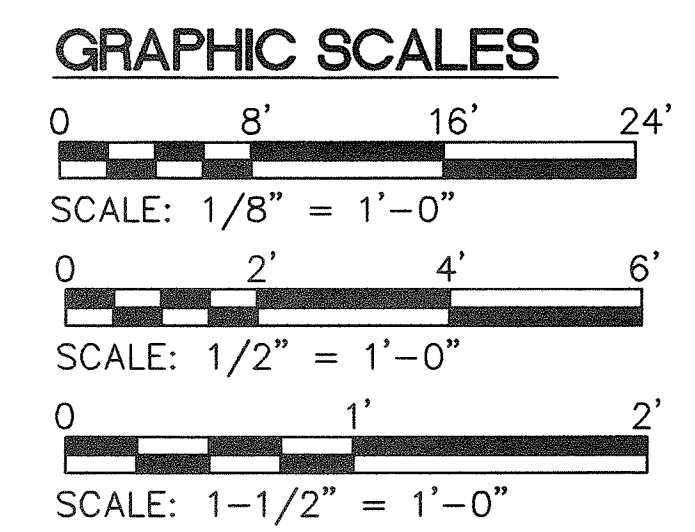

DATE	REVISION
	STATE OF HAWAII DEPARTMENT OF TRANSPORTATION HIGHWAYS DIVISION ABUTMENT/WING WALL AND DETAILS HAWAII BELT ROAD KUPAPAULUA BRIDGE WIDENING HAMAKUA DISTRICT Federal Aid Project No. BR-019-2(38) Scale: As Noted Date: June 23, 2003


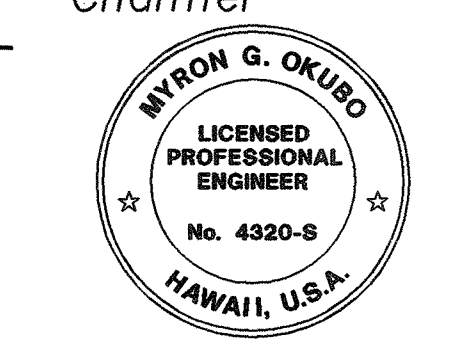


THIS WORK WAS PREPARED BY ME OR UNDER MY SUPERVISION


Myron Okubo

Path: L:\W04\6670-01 Kupapaaulua Bridge\Downsp... File Name: S9 Plot Date: Sep 25, 2006 07:50:56pm CAD User: skidam Xref File Name: | Border | AUTODATE |


FED. ROAD DIST. NO.	STATE	FED. AID PROJ. NO.	FISCAL YEAR	SHEET NO.	TOTAL SHEETS
HAWAII	HAW.	BR-019-2(38)	2002	52A S-1	79

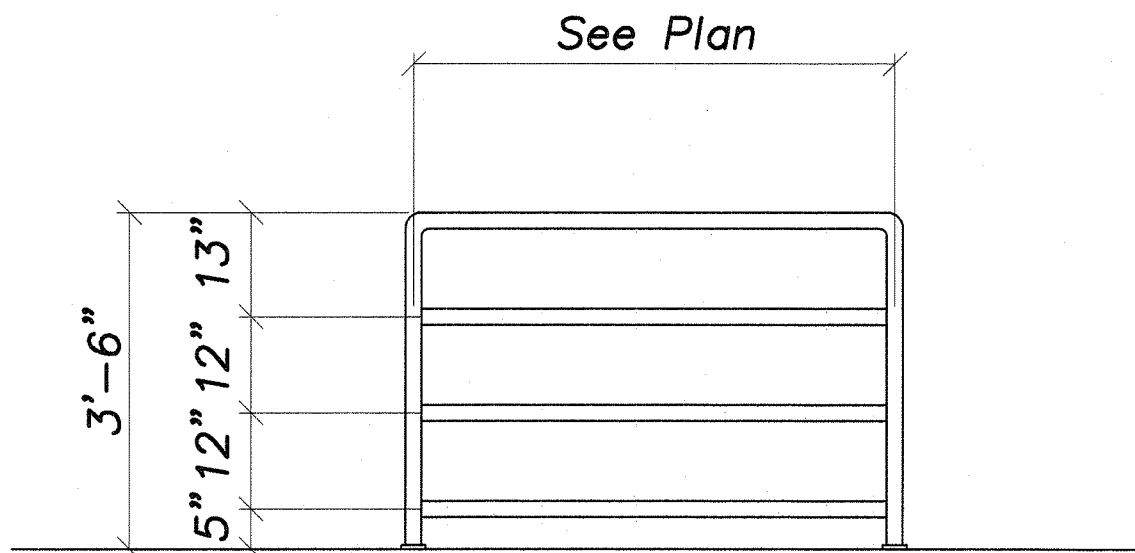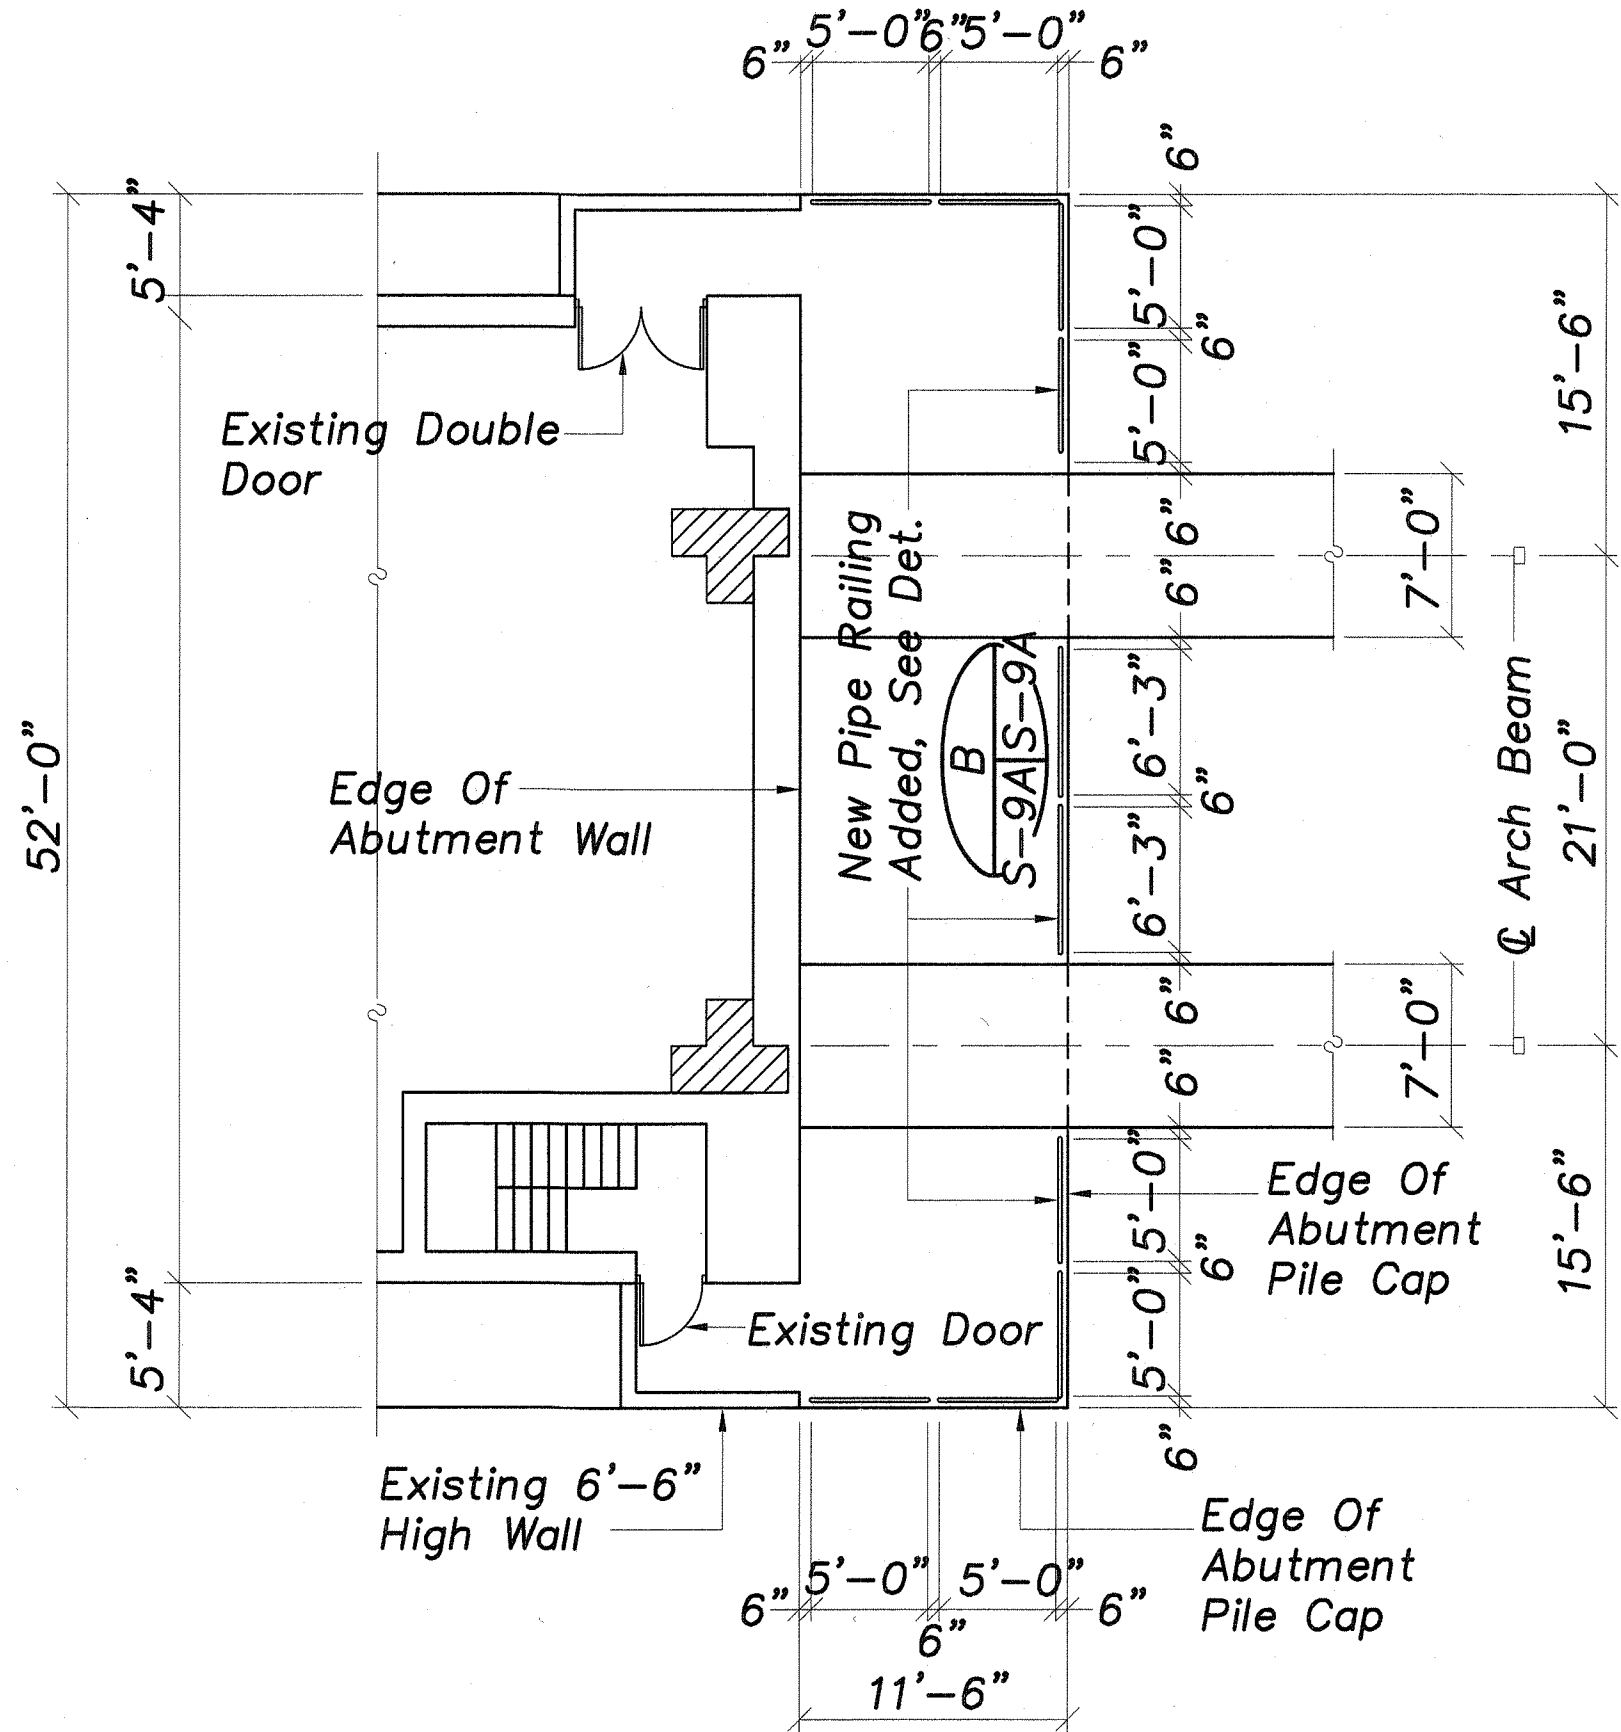

ELEVATION
Scale: 1/2"=1'-0"

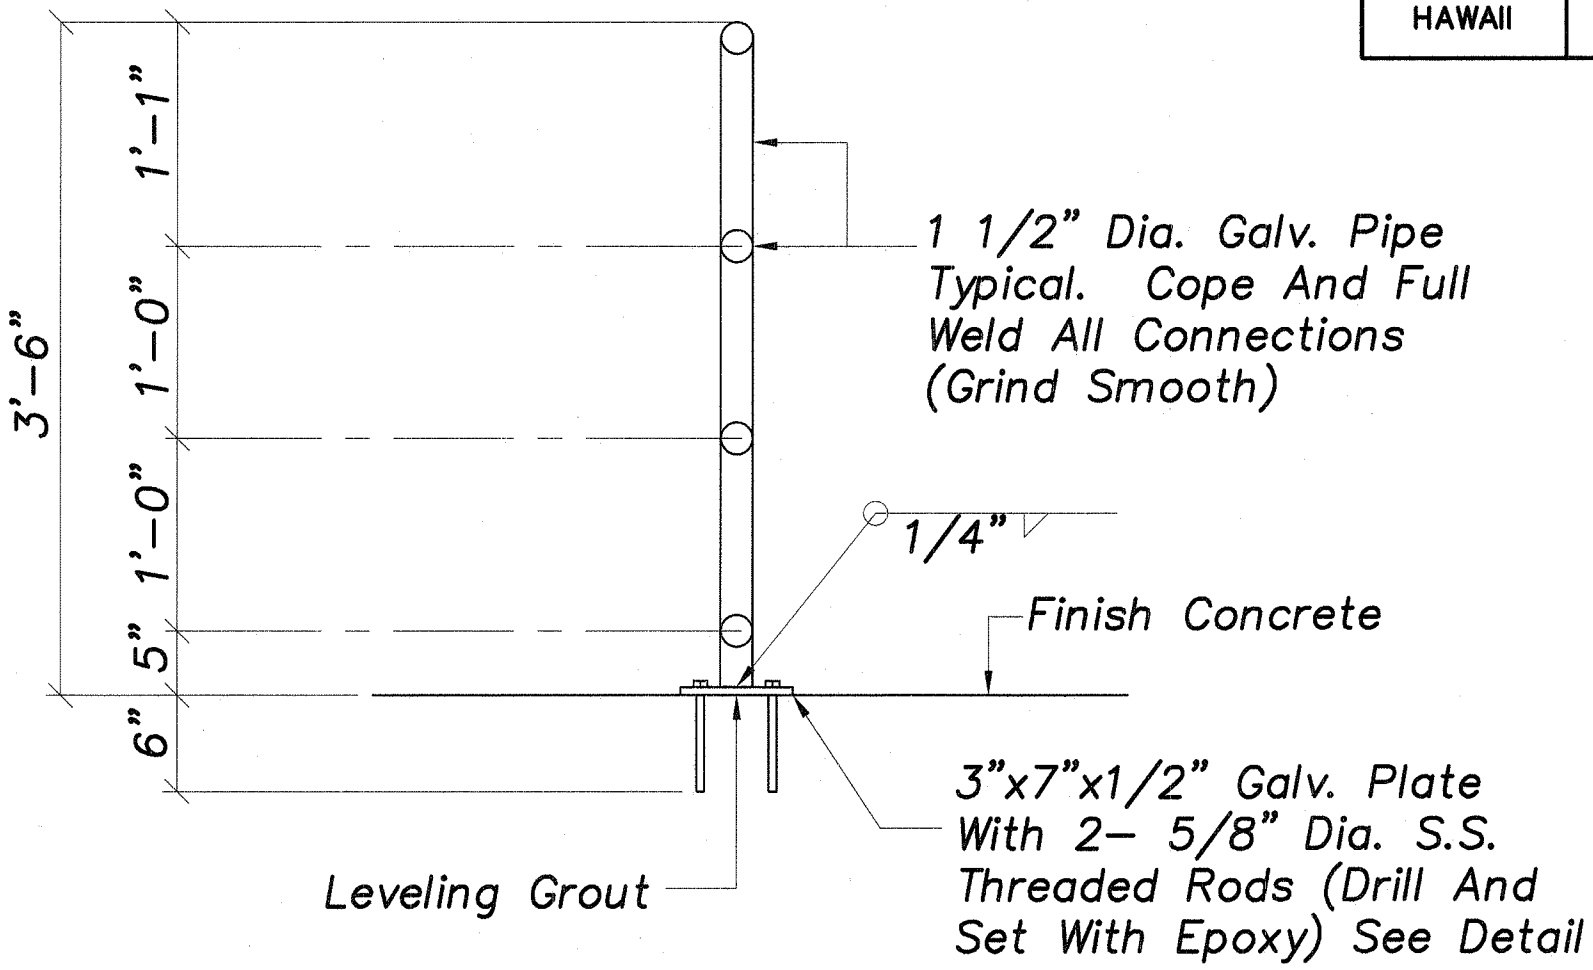

SECTION
Scale: 1"=1'-0"

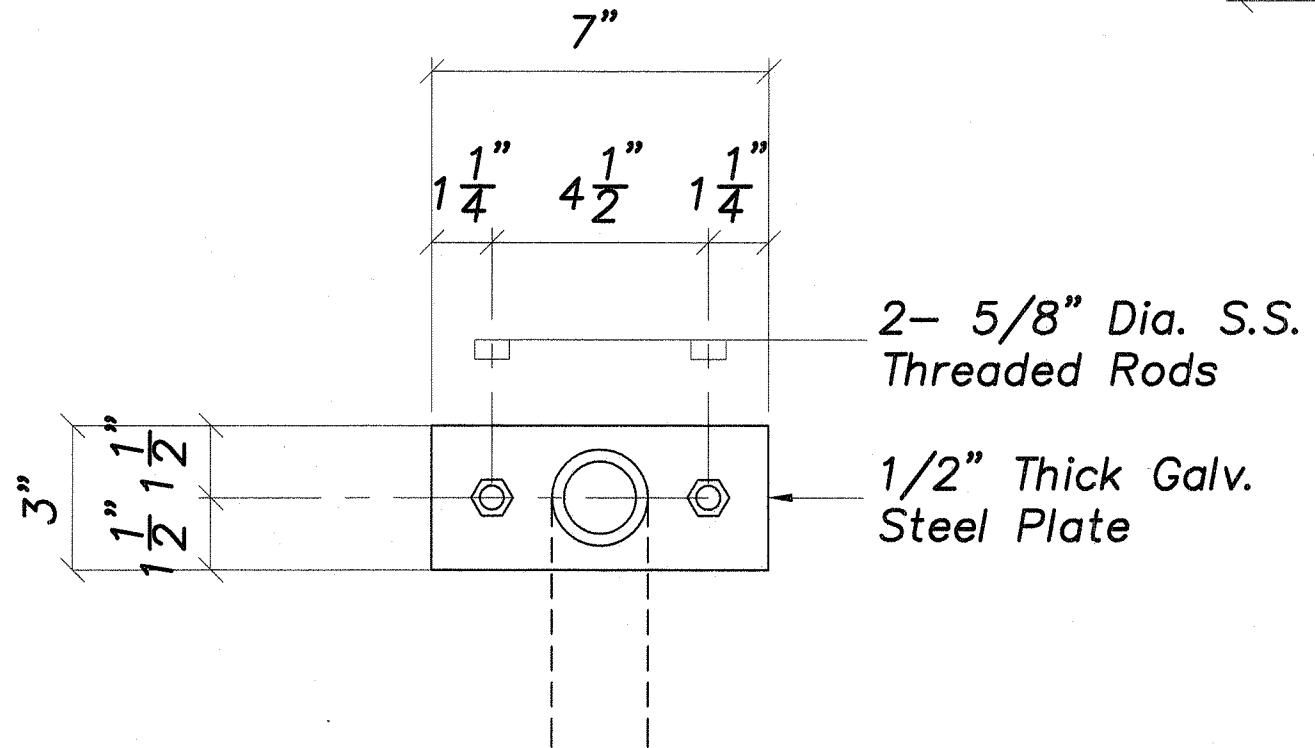


ANCHOR PLATE DETAIL
Scale: 3"=1'-0"

NEW RAILING AT ABUTMENT PILE CAP PLAN

Scale: 1/8"=1'-0"
S-7 S-9A
S-7A
S-9

NEW RAILING DETAIL


Scale: As Noted
S-9 S-9A

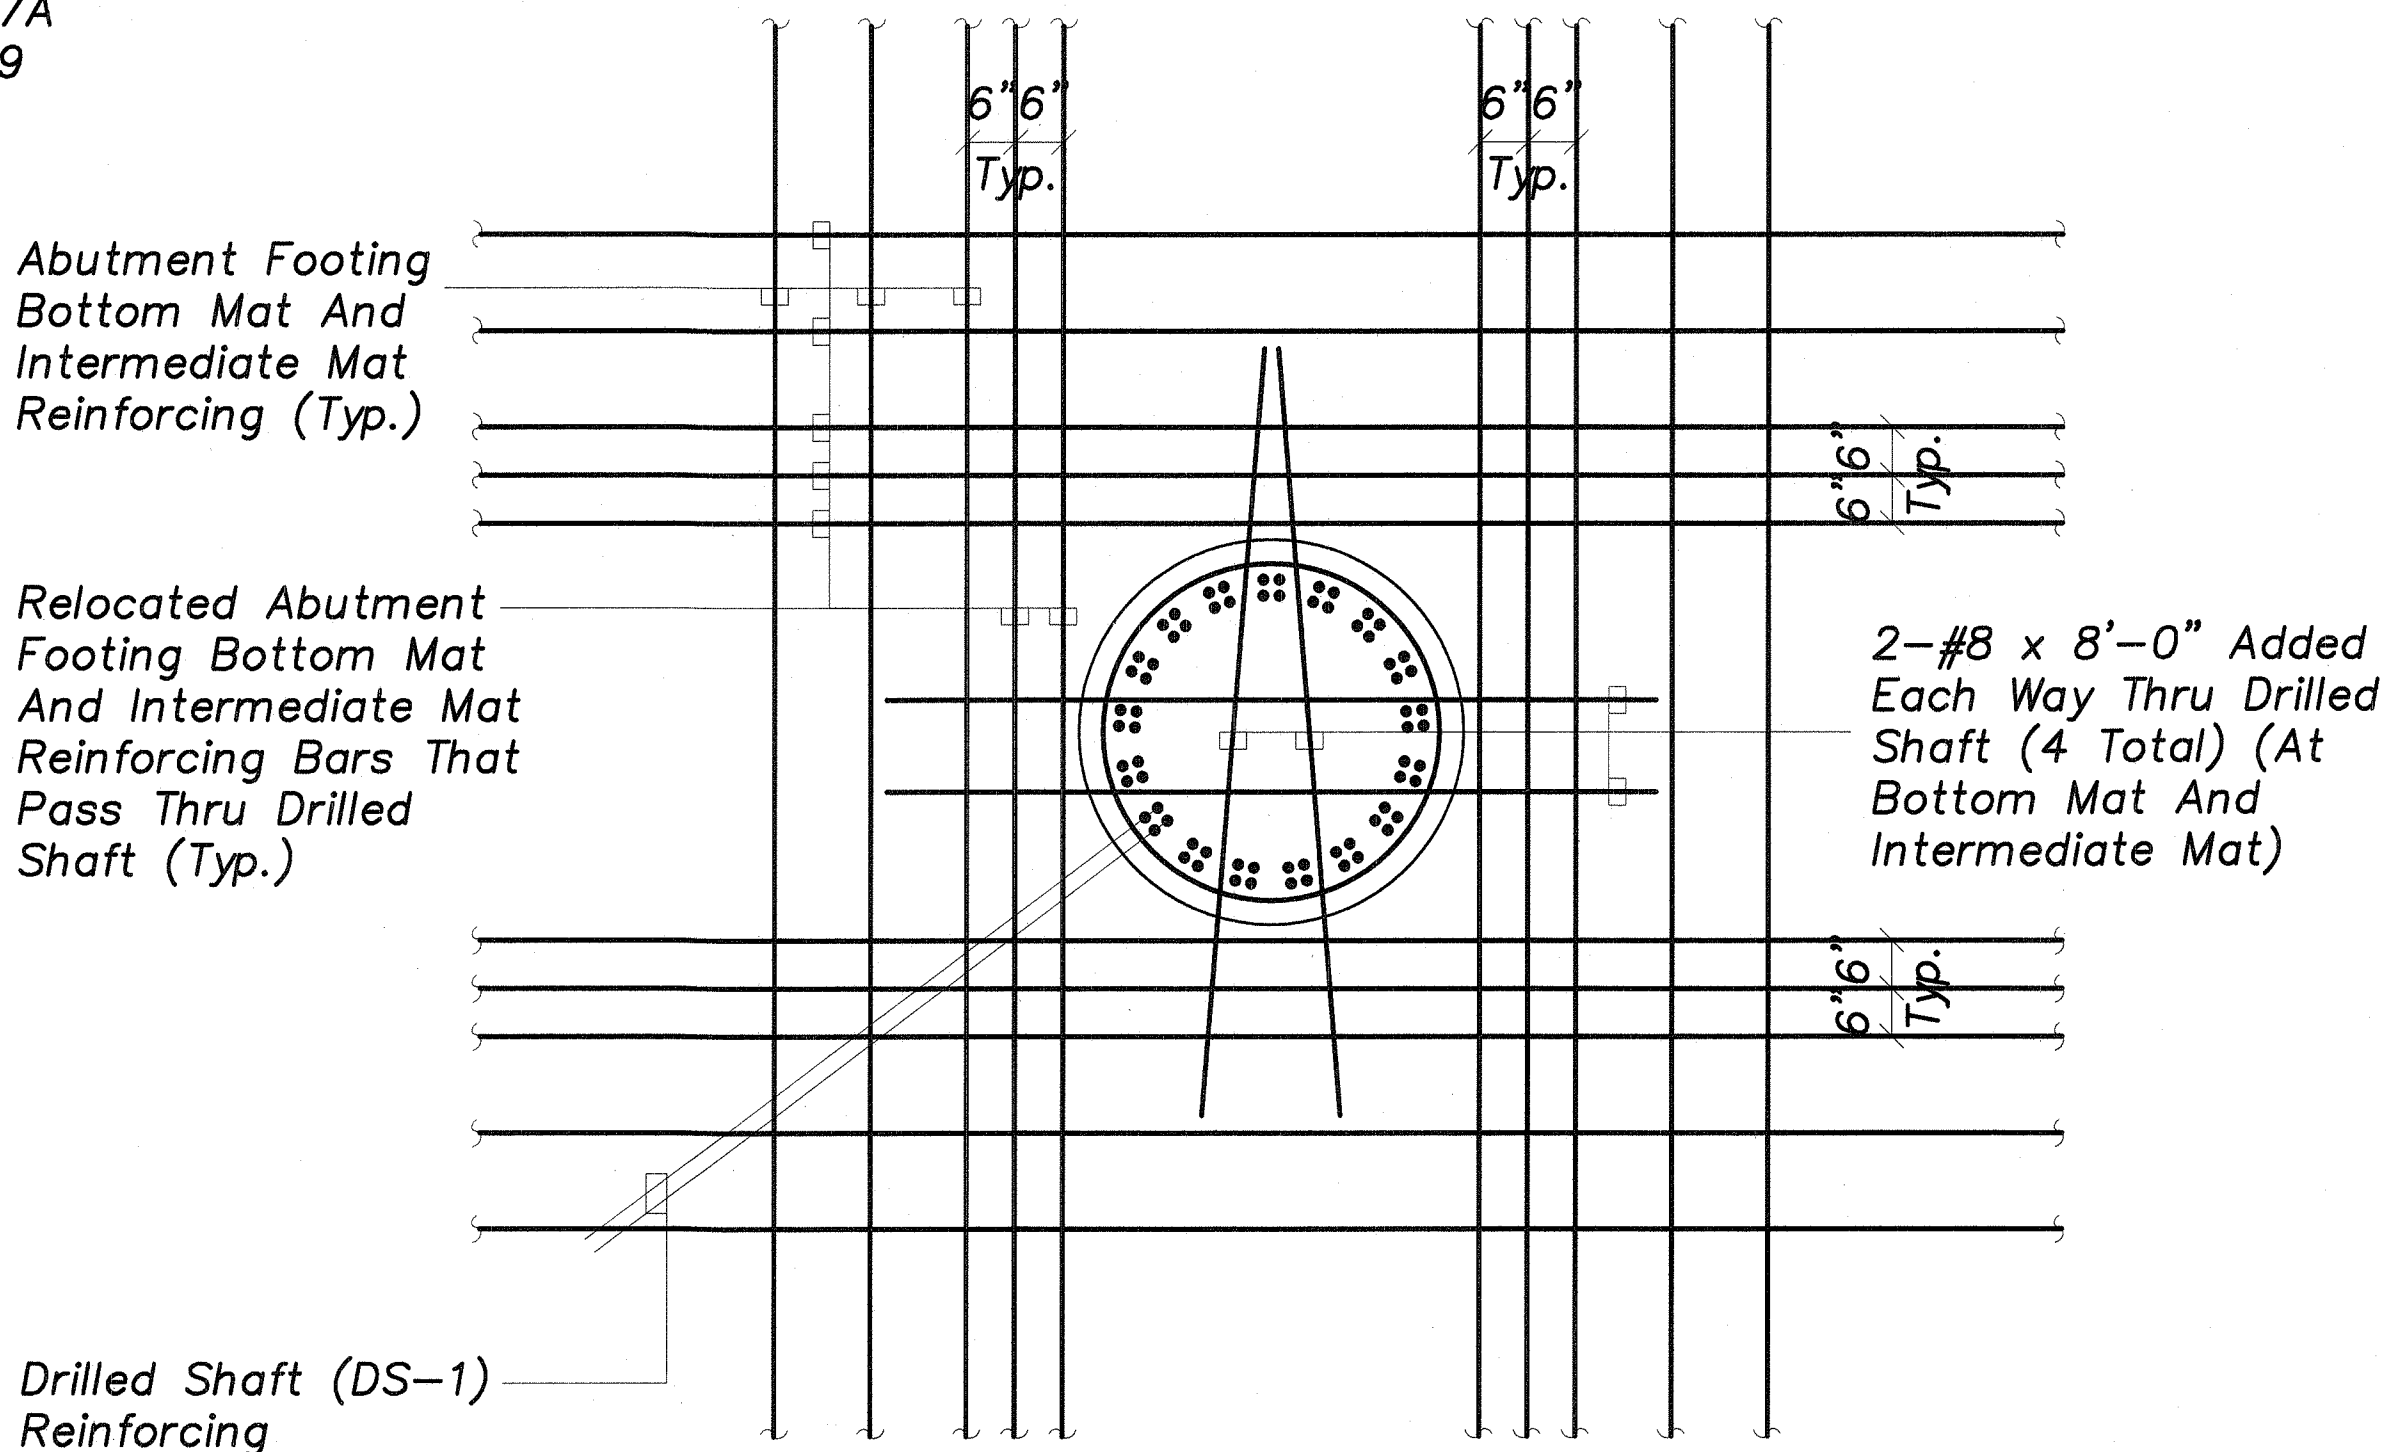

RELOCATED ABUTMENT FOOTING REINFORCING AT DRILLED SHAFT (DS-1)

Scale: 1/2"=1'-0"
S-10 S-9A
S-11, S-14

GRAPHIC SCALES

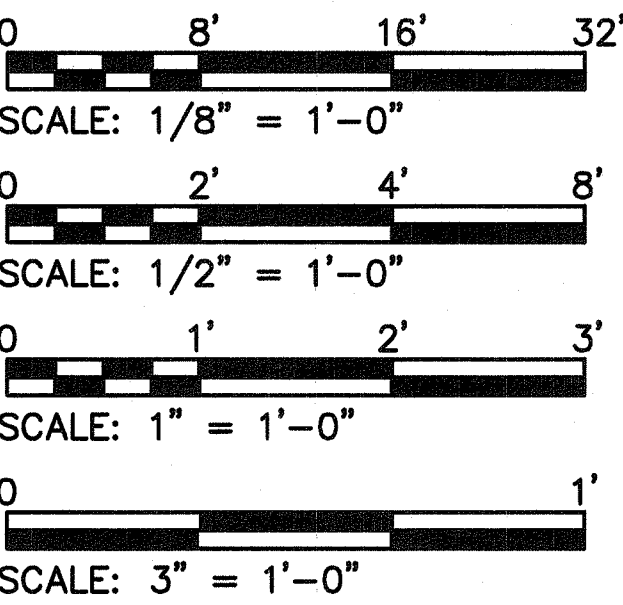

Note:
This Tracing Prepared During
"As-Built" Posting.

DATE	REVISION
	STATE OF HAWAII DEPARTMENT OF TRANSPORTATION HIGHWAYS DIVISION NEW RAILING PLAN AND DETAILS, FOOTING REINFORCING AT DS-1 HAWAII BELT ROAD KUPAPAUUA BRIDGE WIDENING HAMAKUA DISTRICT Federal Aid Project No. BR-019-2(38) Scale: As Noted Date: June 23, 2003 SHEET No. S-9A OF 36 SHEETS


SURVEY PLOTTED BY	DATE
DESIGNED BY	
TRACED BY	
NOTED BY	
QUANTITIES BY	
CHECKED BY	
ORIGINAL PLAN	
NO.	



Path: L:\WOA\6670-01 Kupuauulua Bridge\Struct\NEW-1	Filename: S12	Plot date: Sep 25, 2006-07:52:23pm	CAD User: skidani	Xref Filename:	Border	AUTODAT
---	---------------	------------------------------------	-------------------	----------------	--------	---------




FED. ROAD DIST. NO.	STATE	FED. AID PROJ. NO.	FISCAL YEAR	SHEET NO.	TOTAL SHEETS
HAWAII	HAW.	BR-019-2(38)	2002	55A S-1	79

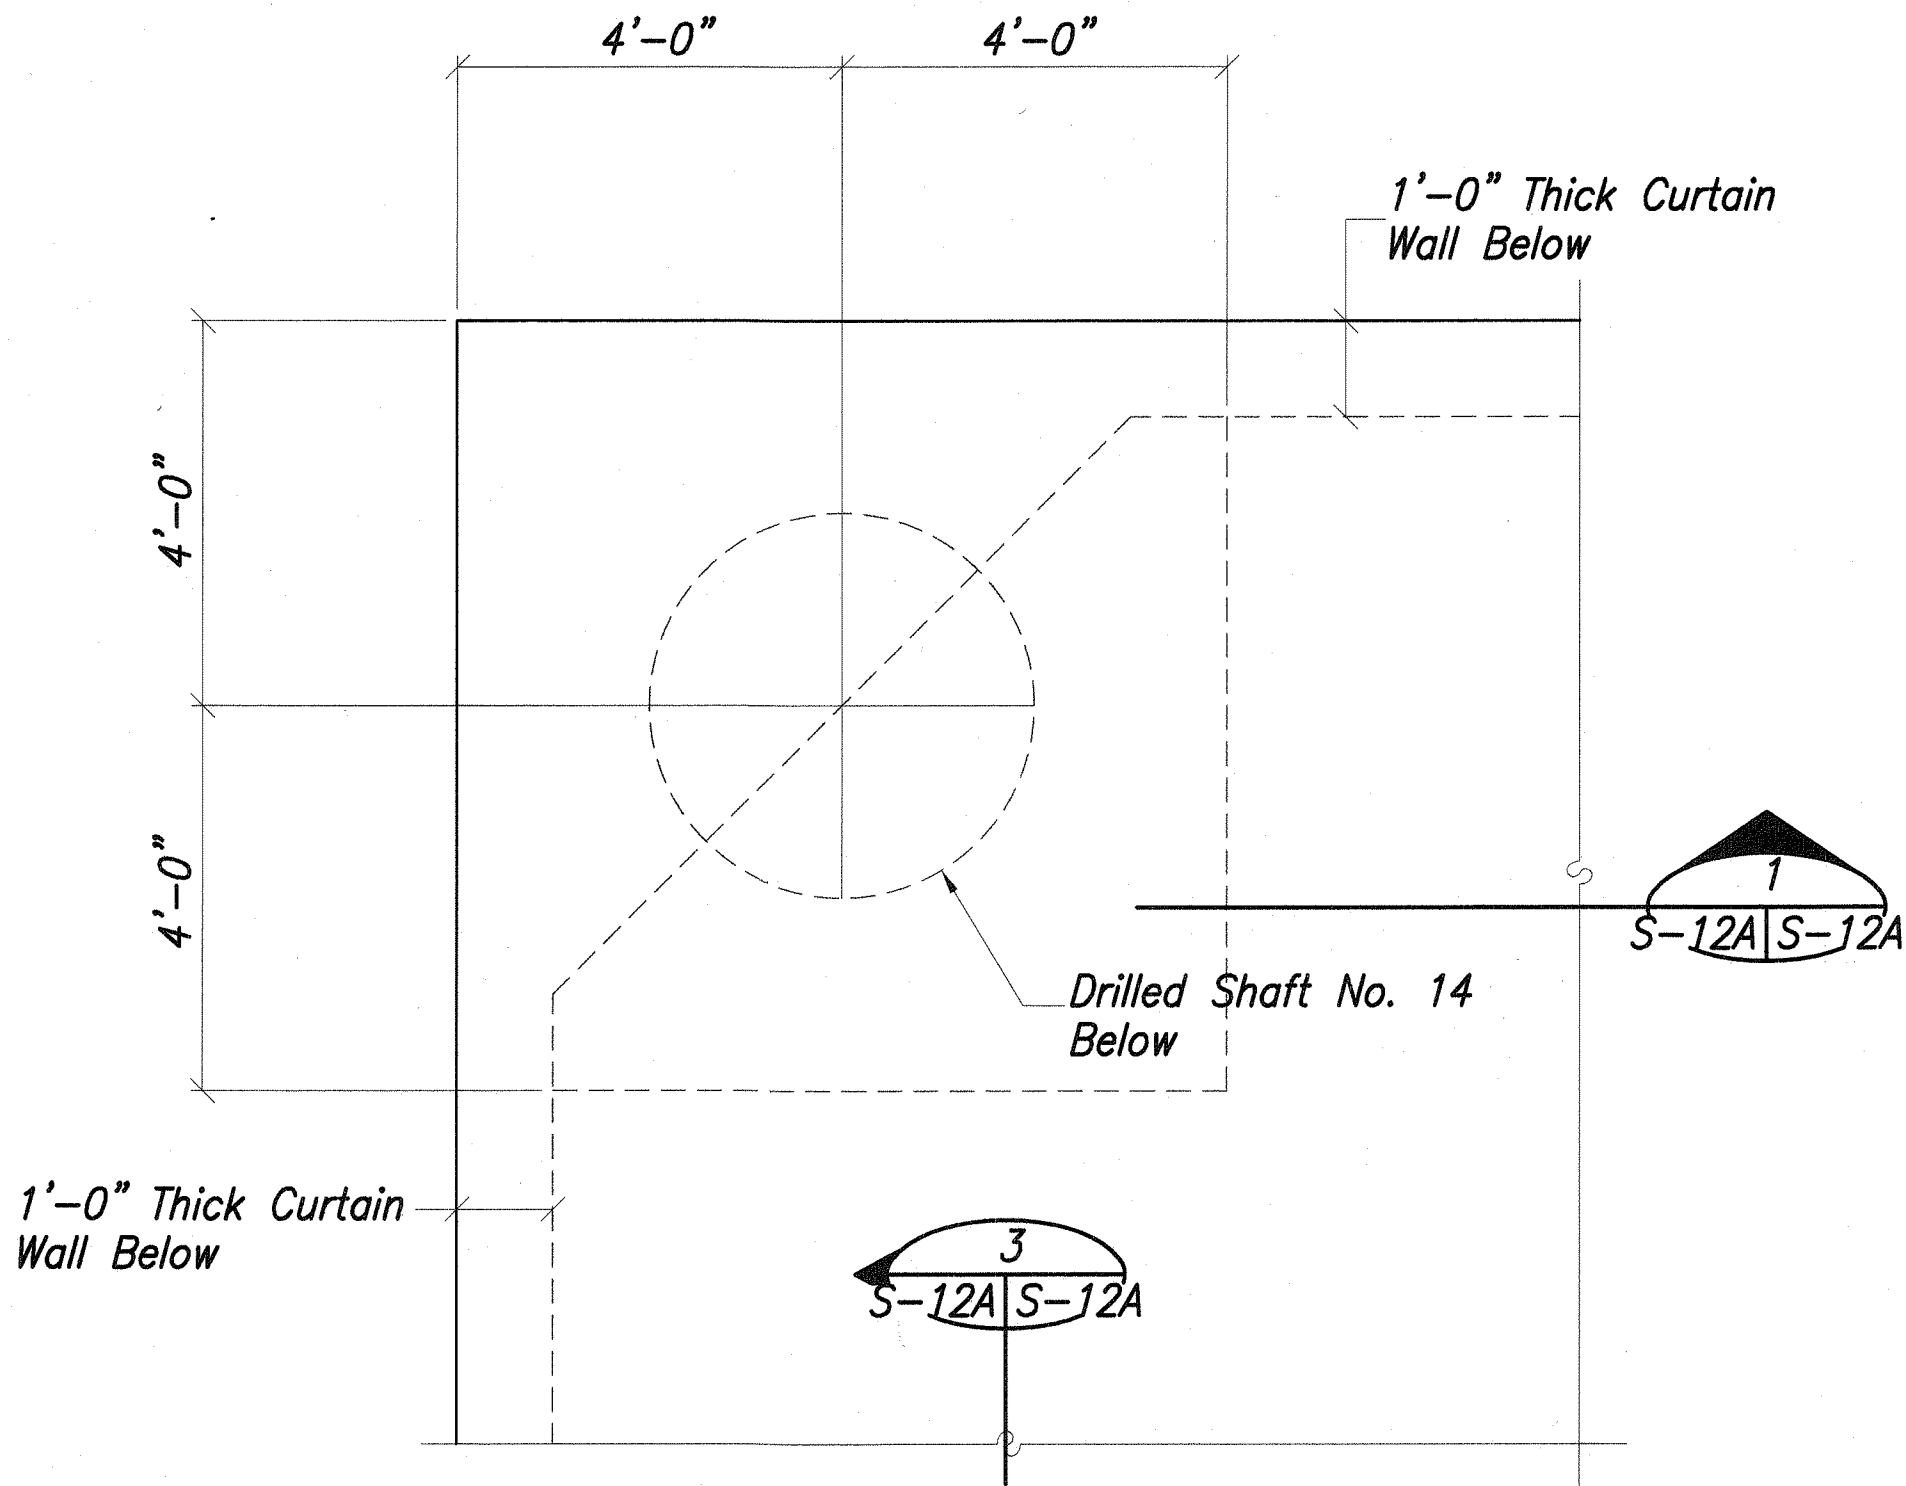


REVISED FOOTING AT ABUTMENT NO. 2 DRILLED SHAFT NO. 14


Scale: 1/2"=1'-0"

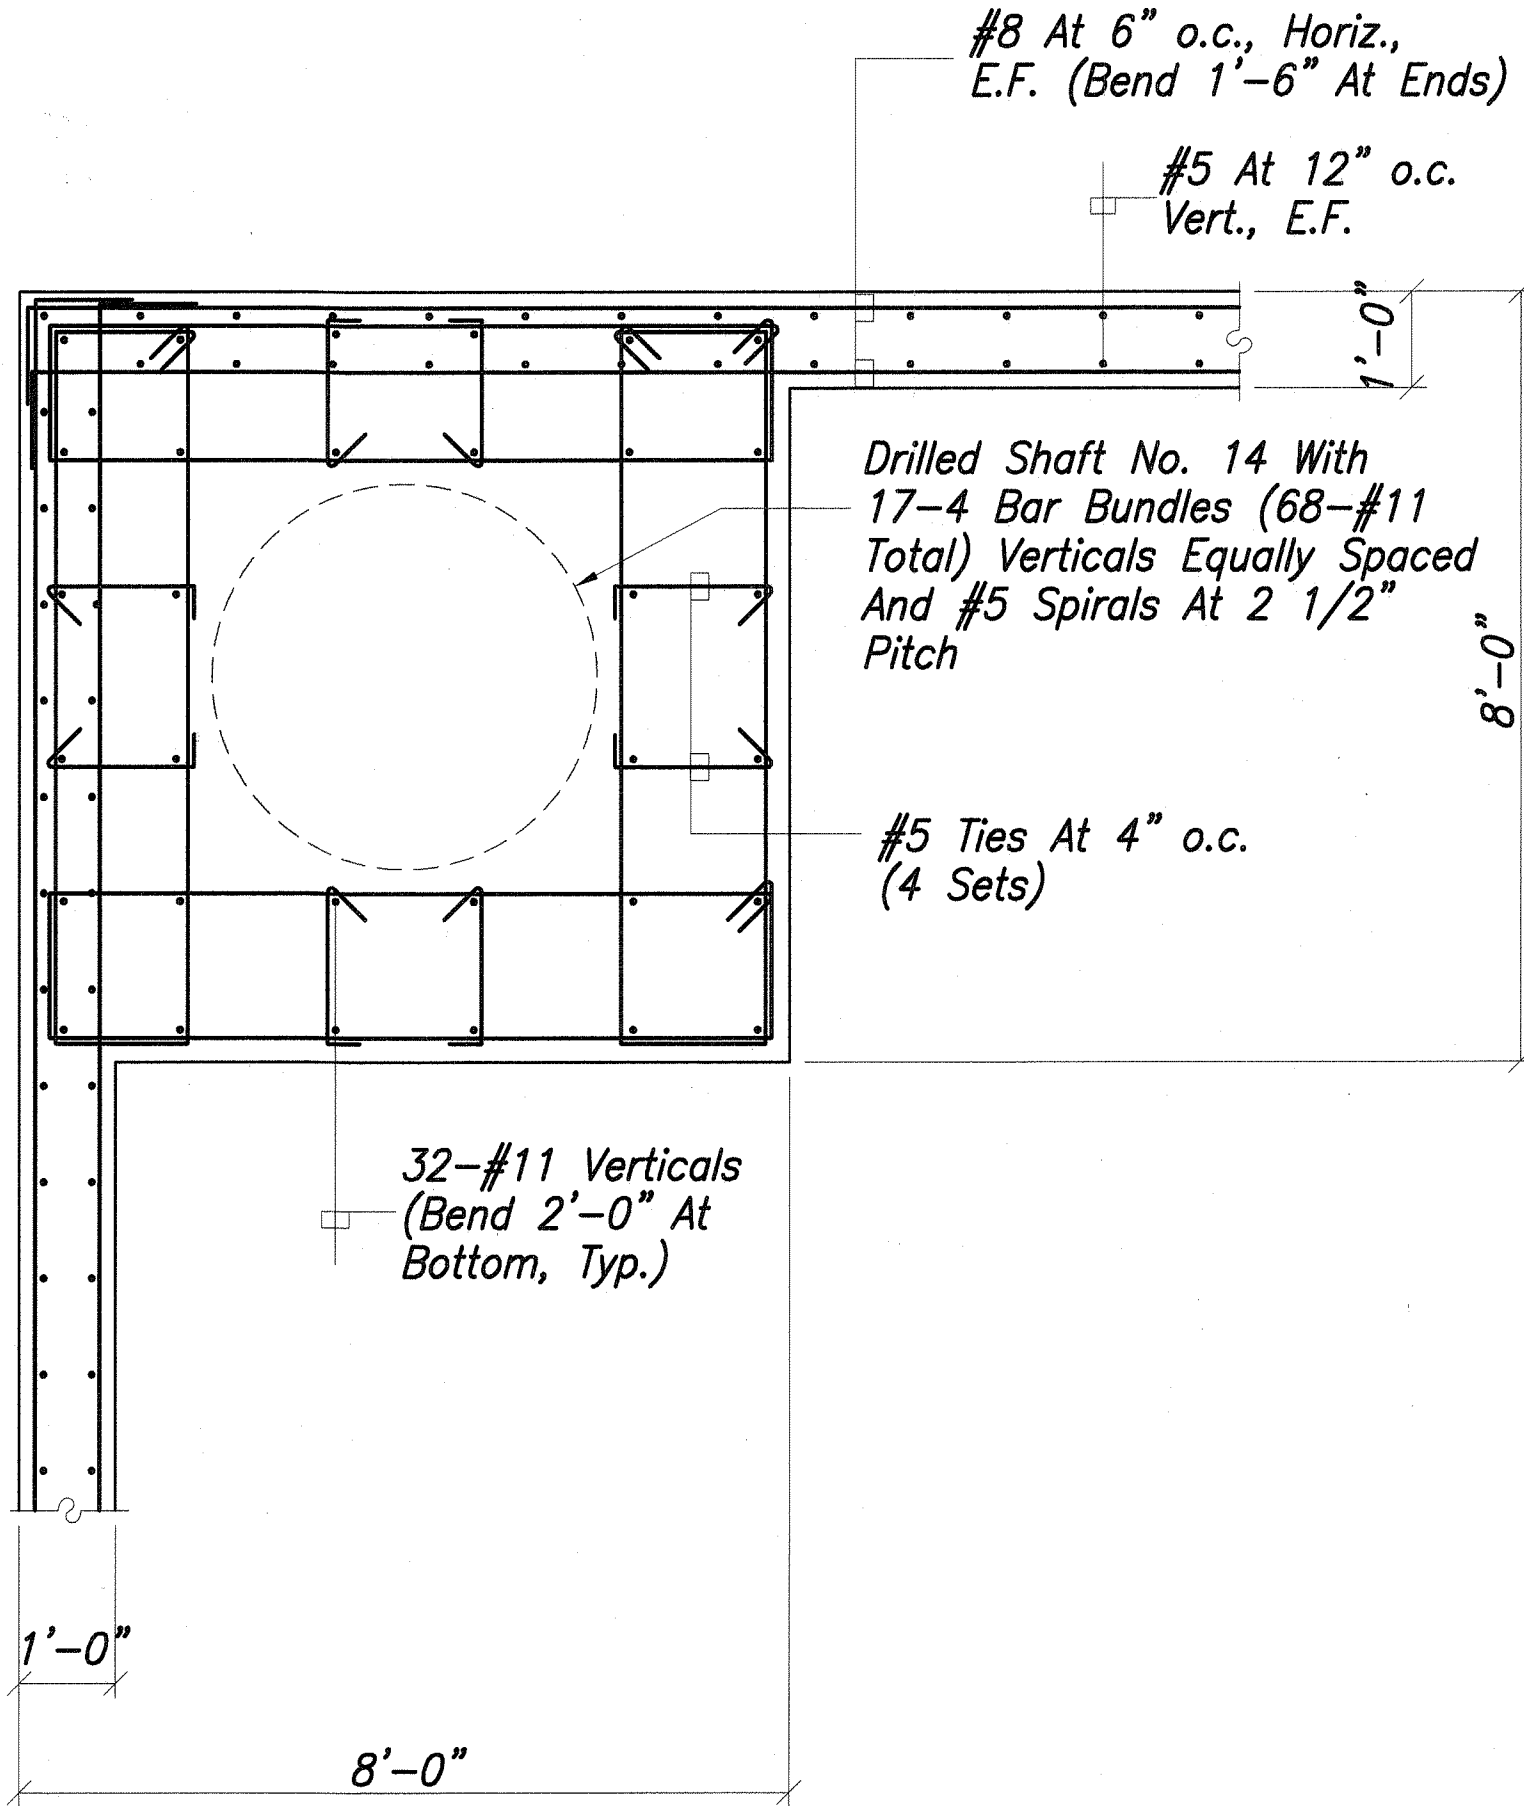


SECTION S-12A S-12A Scale: 1/2"=1'-0"

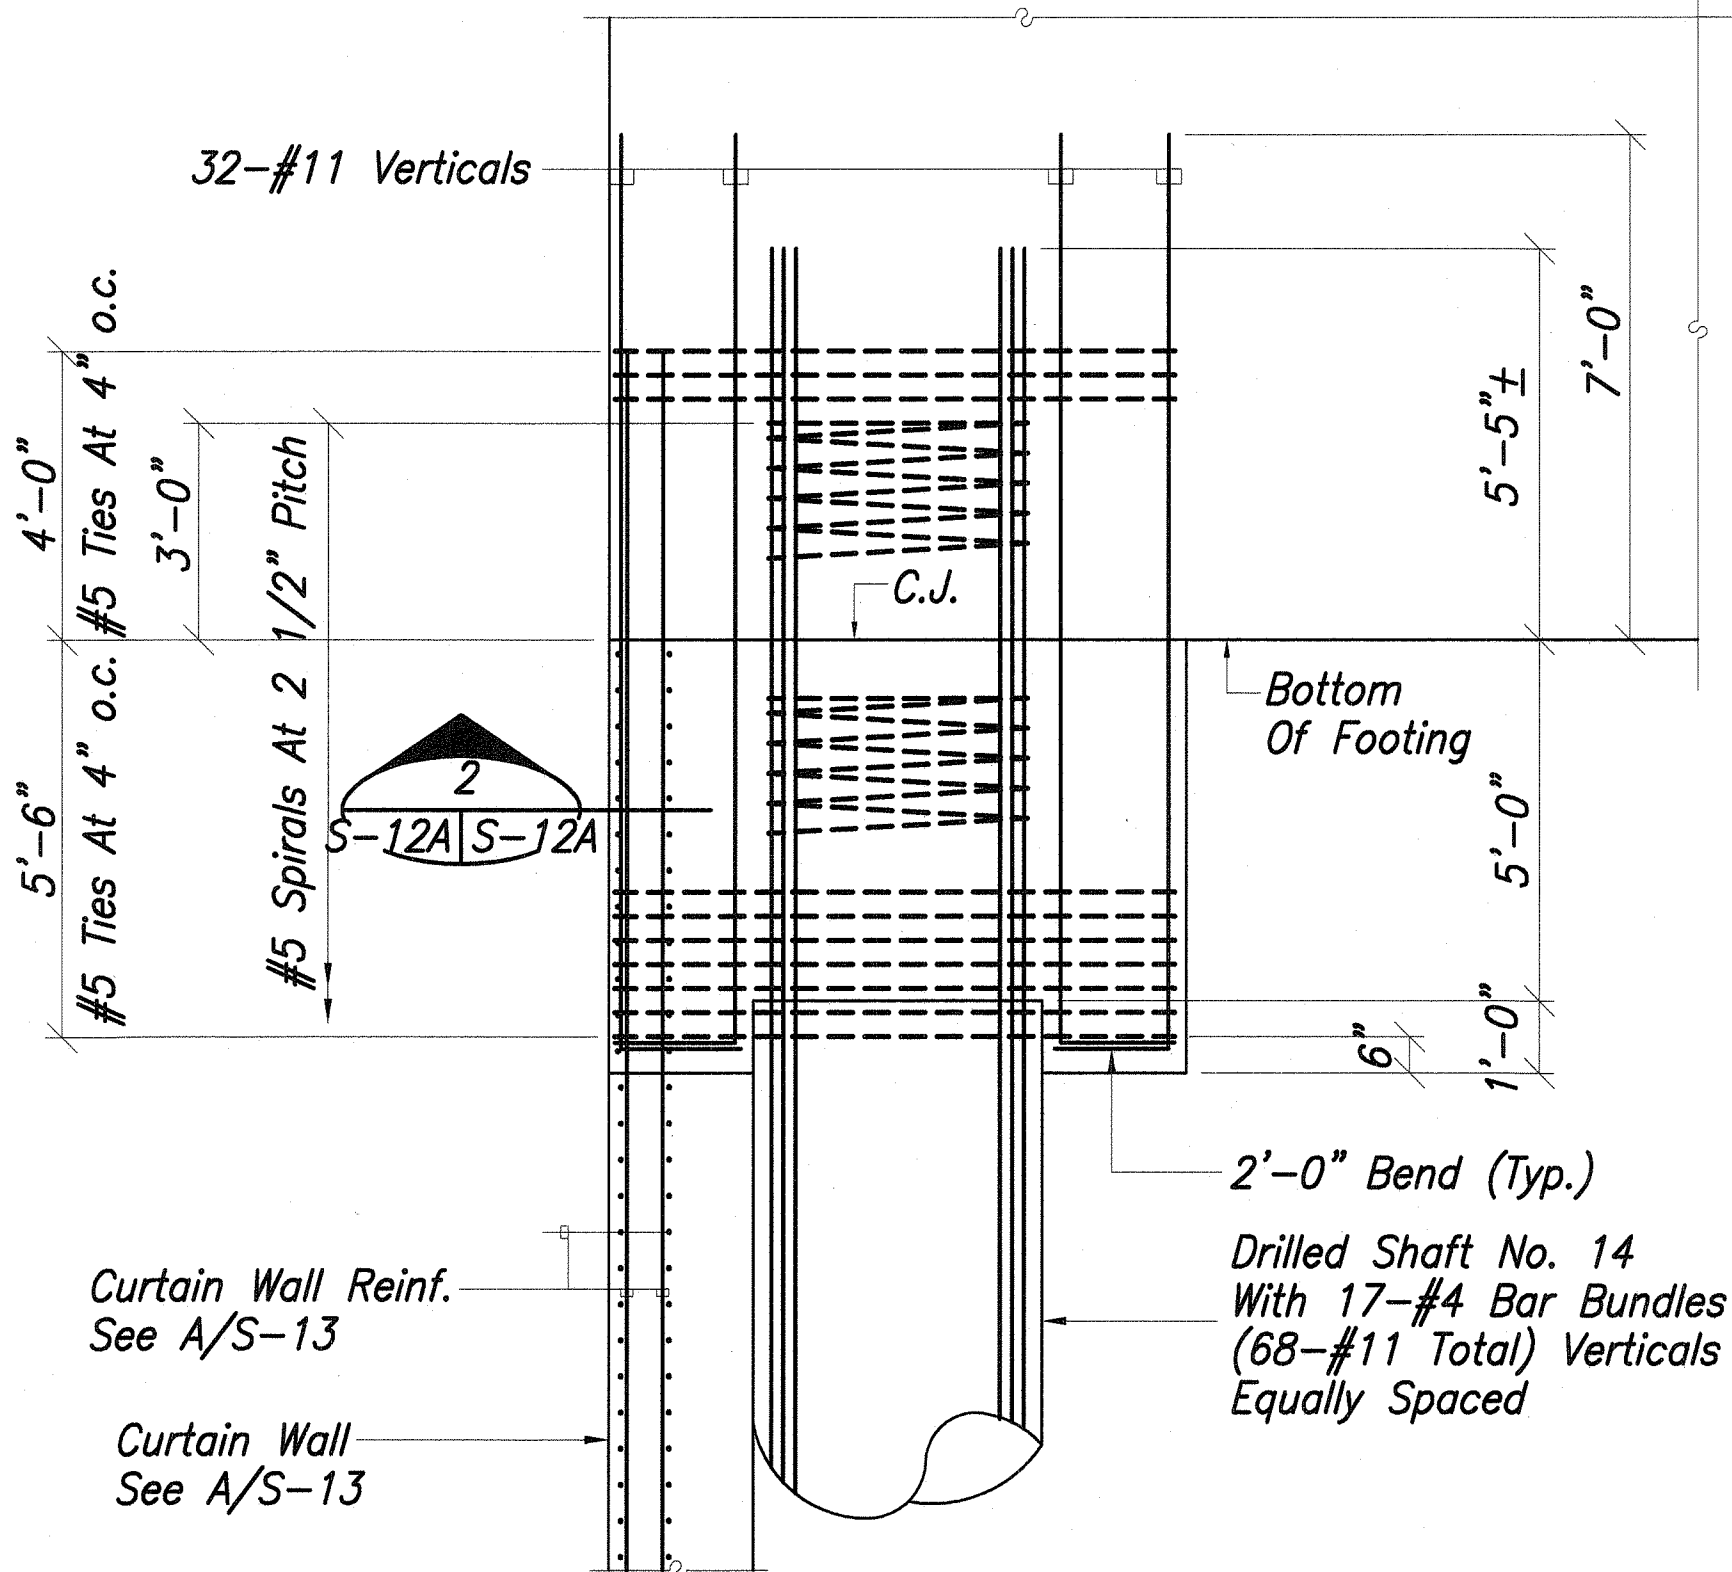

SECTION S-12A, S-14 S-12A Scale: 3/8"=1'-0"

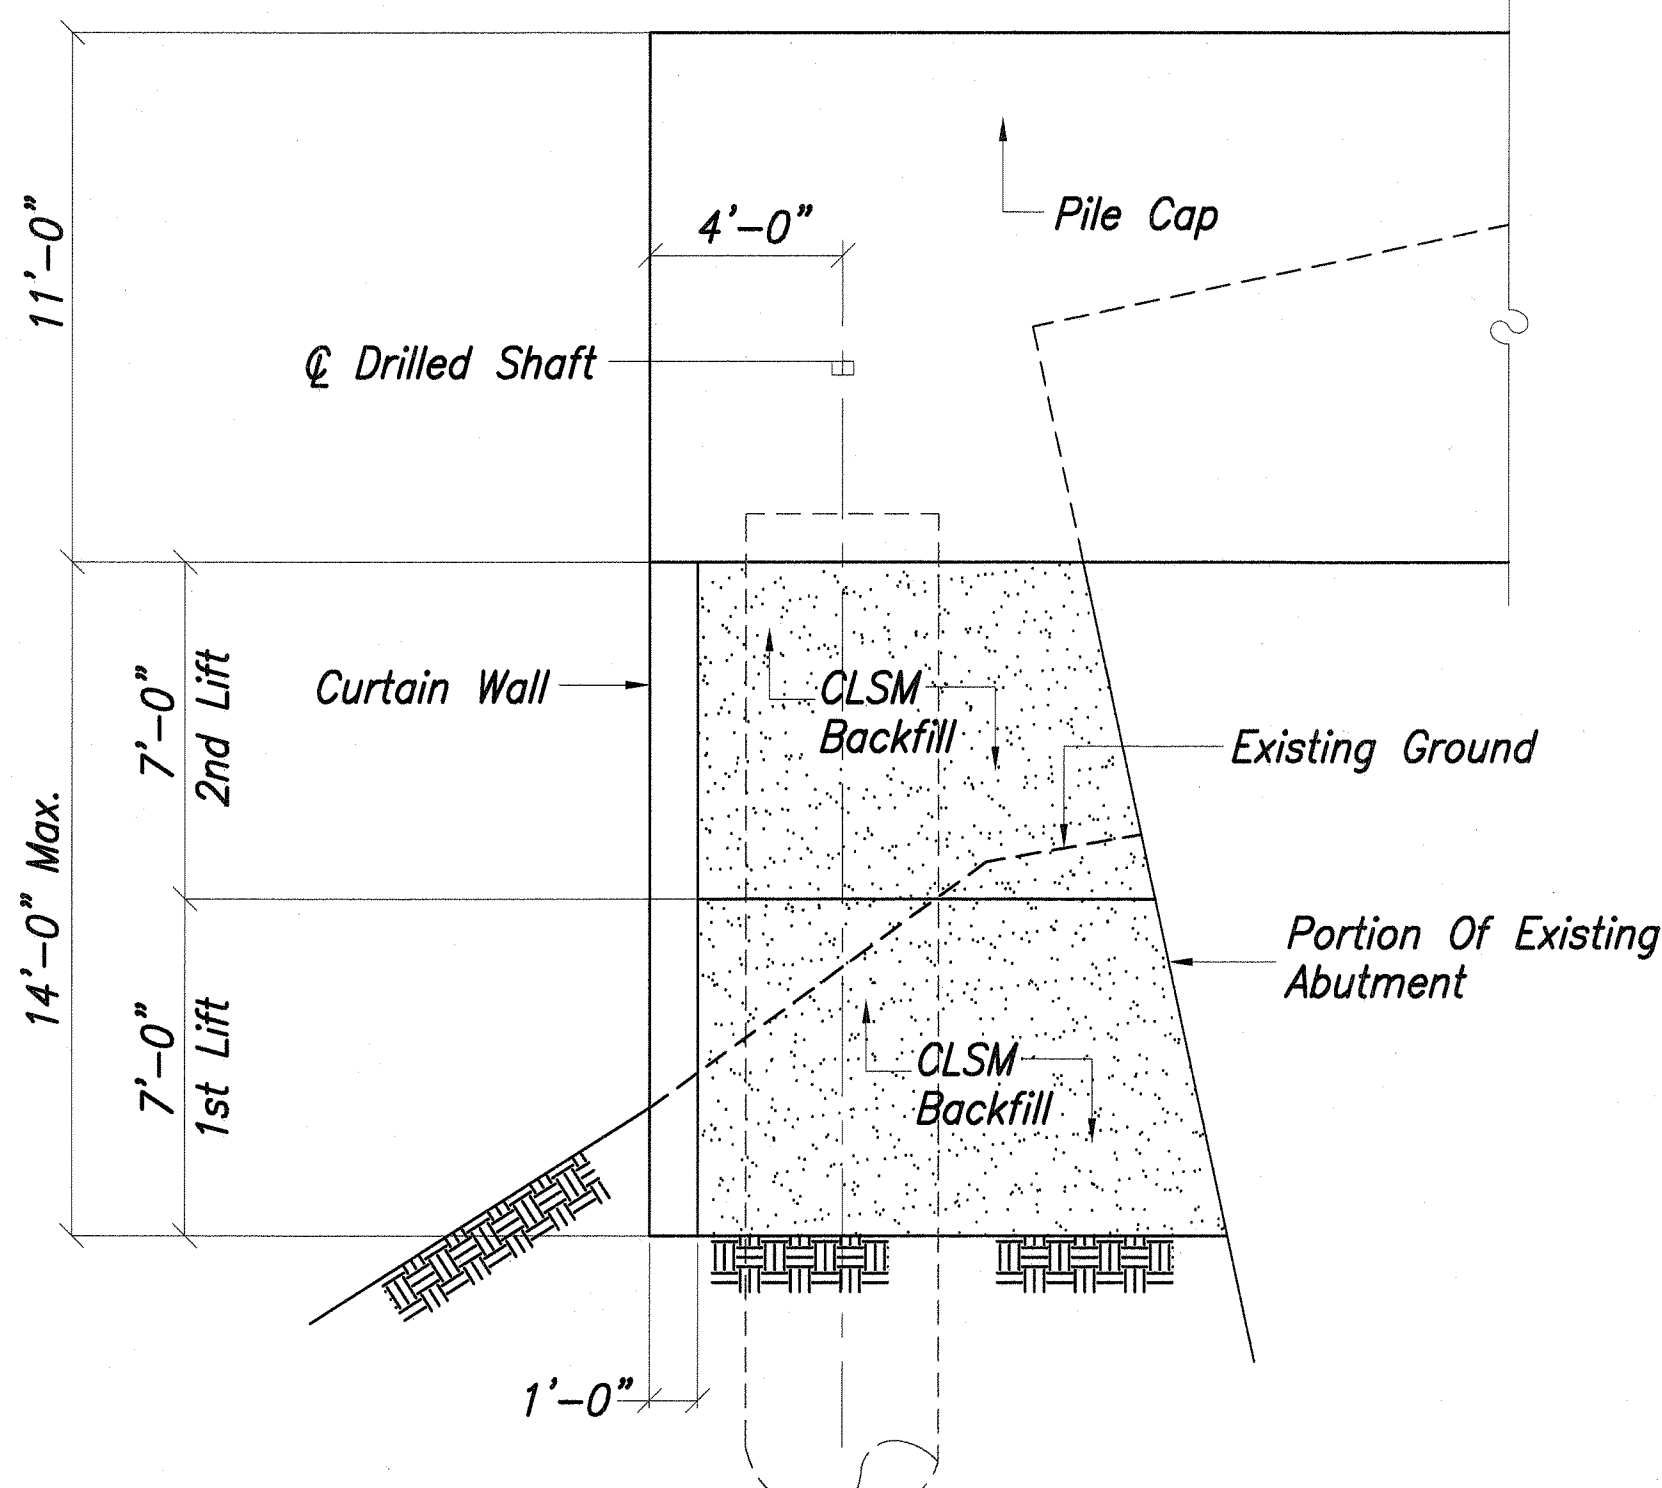


ABUTMENT NO. 2 CURTAIN WALL BACKFILL S-12A, S-14 S-12A Scale: 1/4"=1'-0"

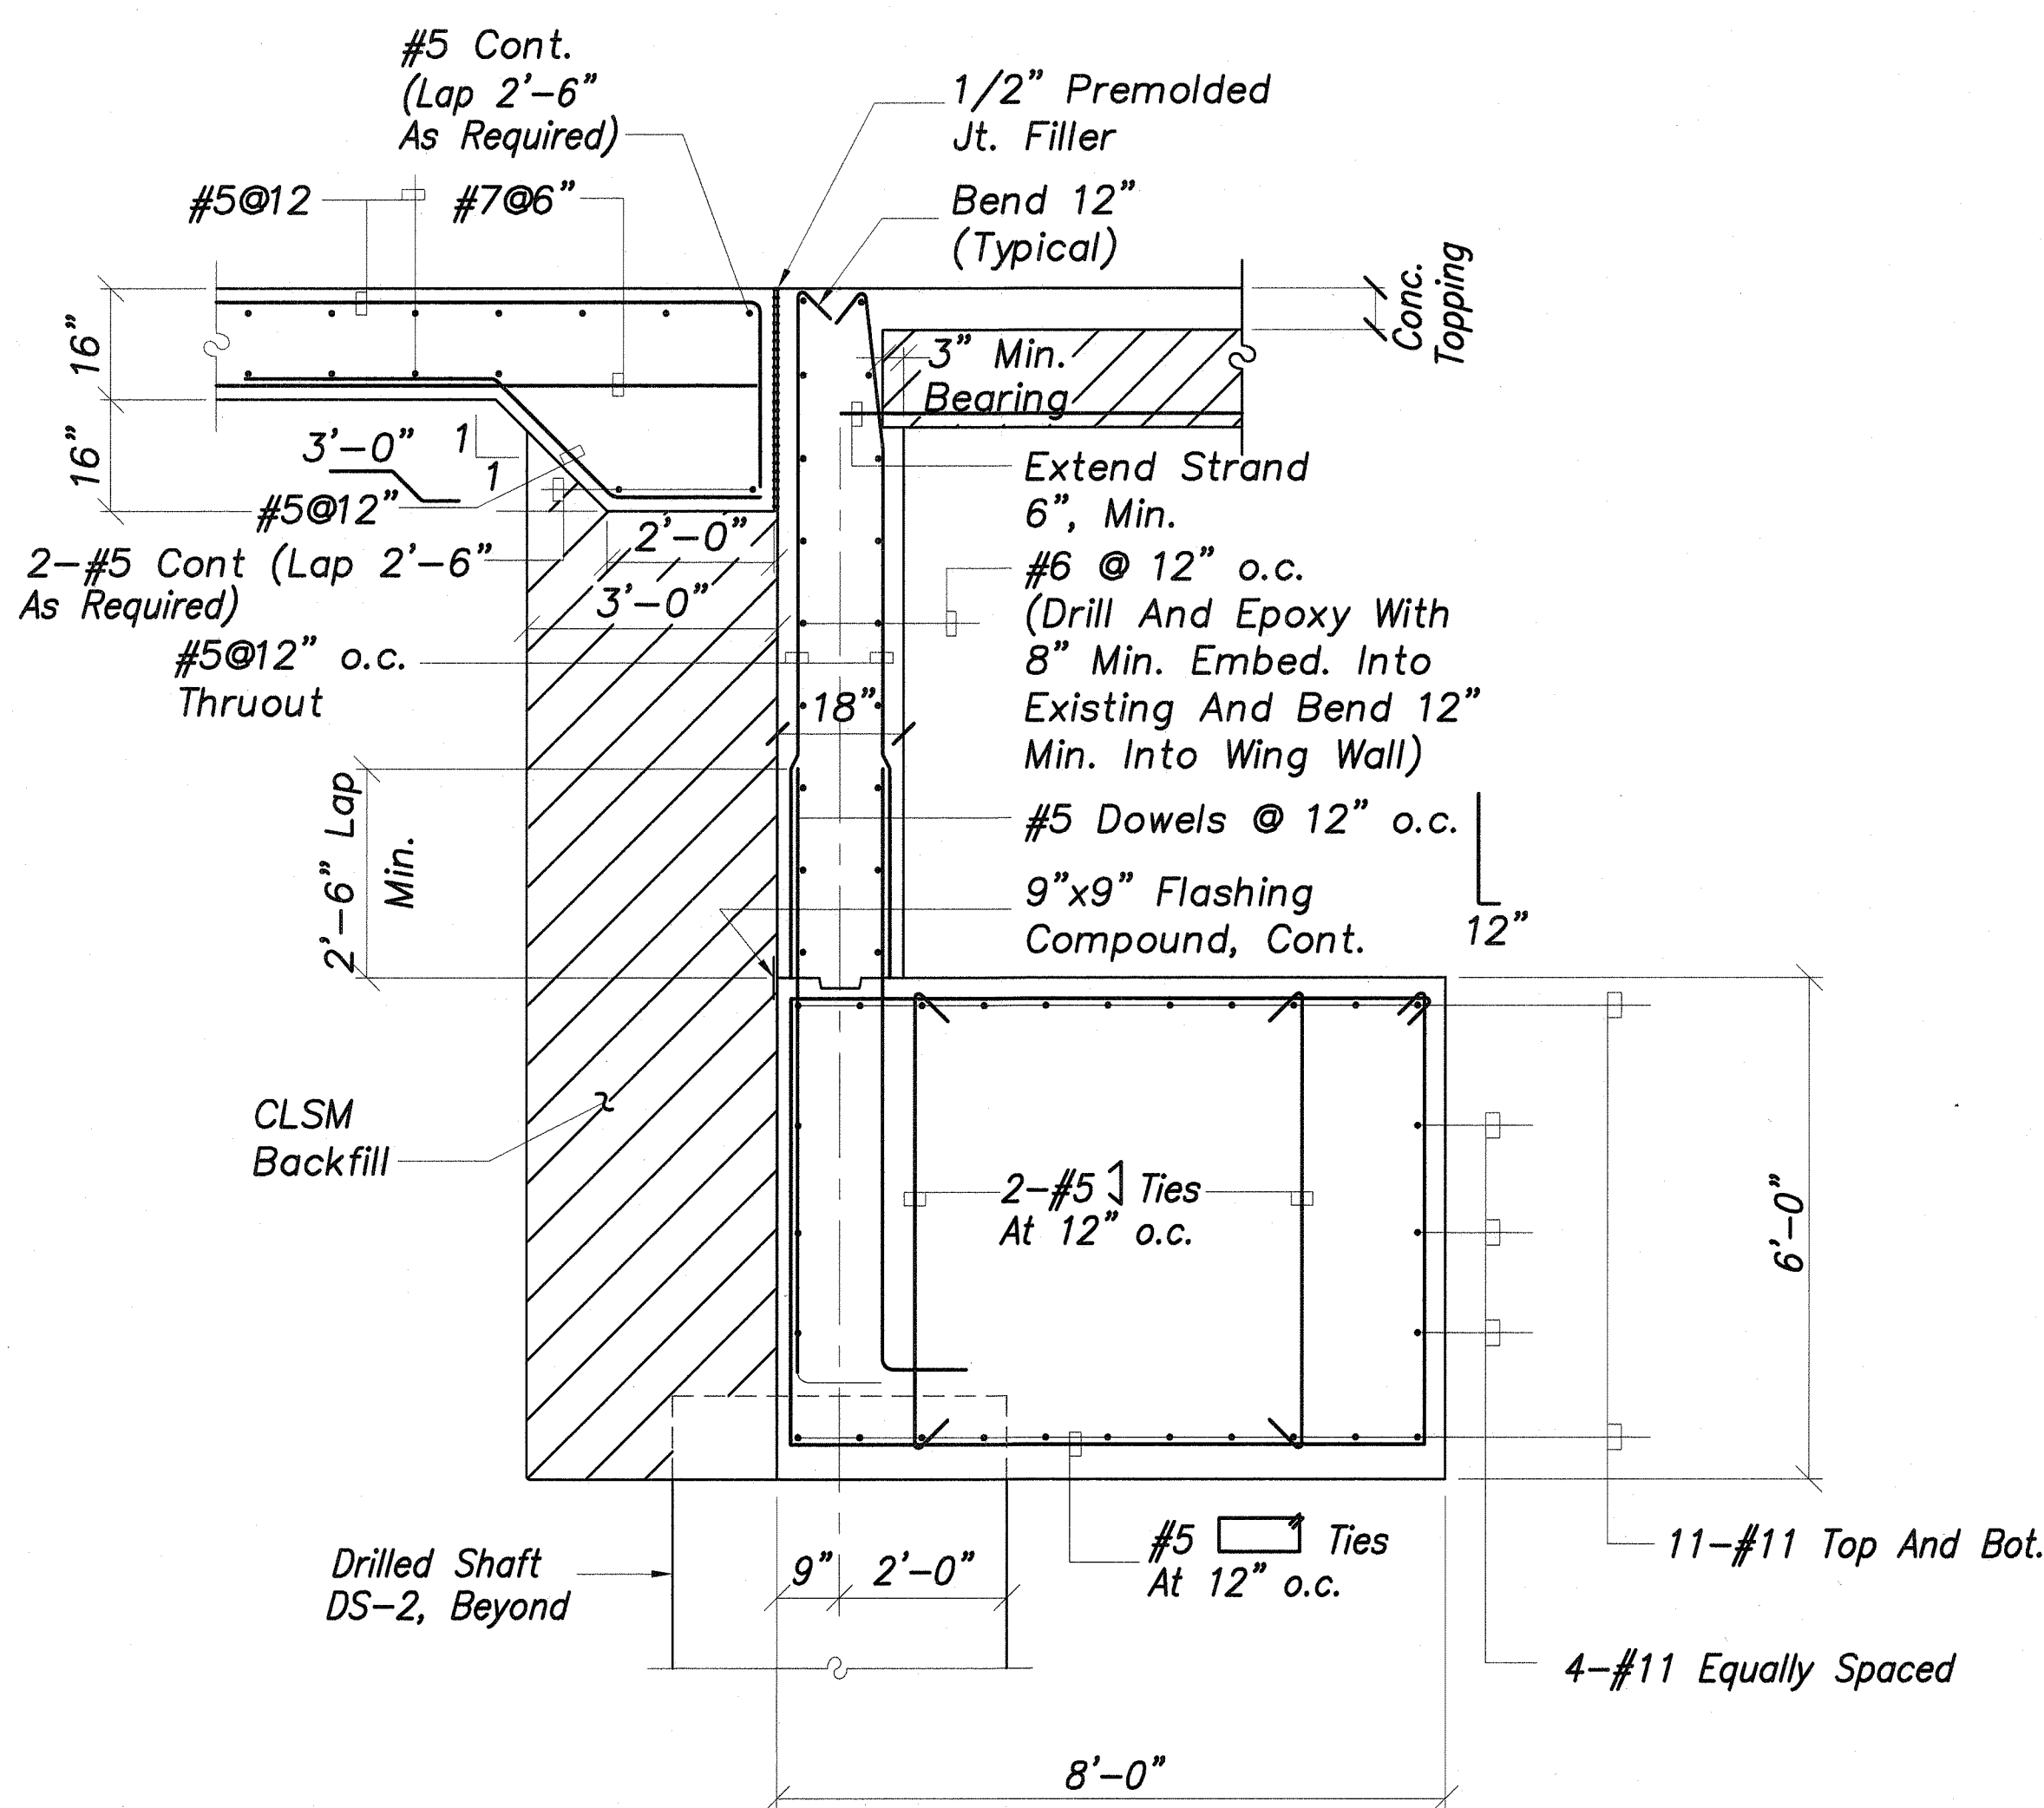

SECTION S-11, S-14 S-12A Scale: 1/2"=1'-0"

Note:
This Tracing Prepared During
"As-Built" Posting.


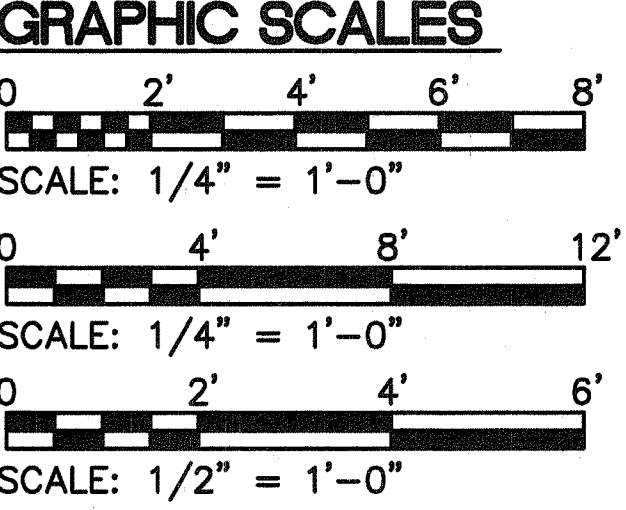


DATE	REVISION
STATE OF HAWAII DEPARTMENT OF TRANSPORTATION HIGHWAYS DIVISION	
FOUNDATION SECTIONS AND DETAILS	
HAWAII BELT ROAD KUPAPULUA BRIDGE WIDENING HAMAKUA DISTRICT	
Federal Aid Project No. BR-019-2(38)	
Scale: As Noted	Date: June 23, 2003
SHEET No. S-12A OF 36 SHEETS	


"AS-BUILT"

55A S-1

FED. ROAD DIST. NO.	STATE	FED. AID PROJ. NO.	FISCAL YEAR	SHEET NO.	TOTAL SHEETS
HAWAII	HAW.	BR-019-2(38)	2001	56	73

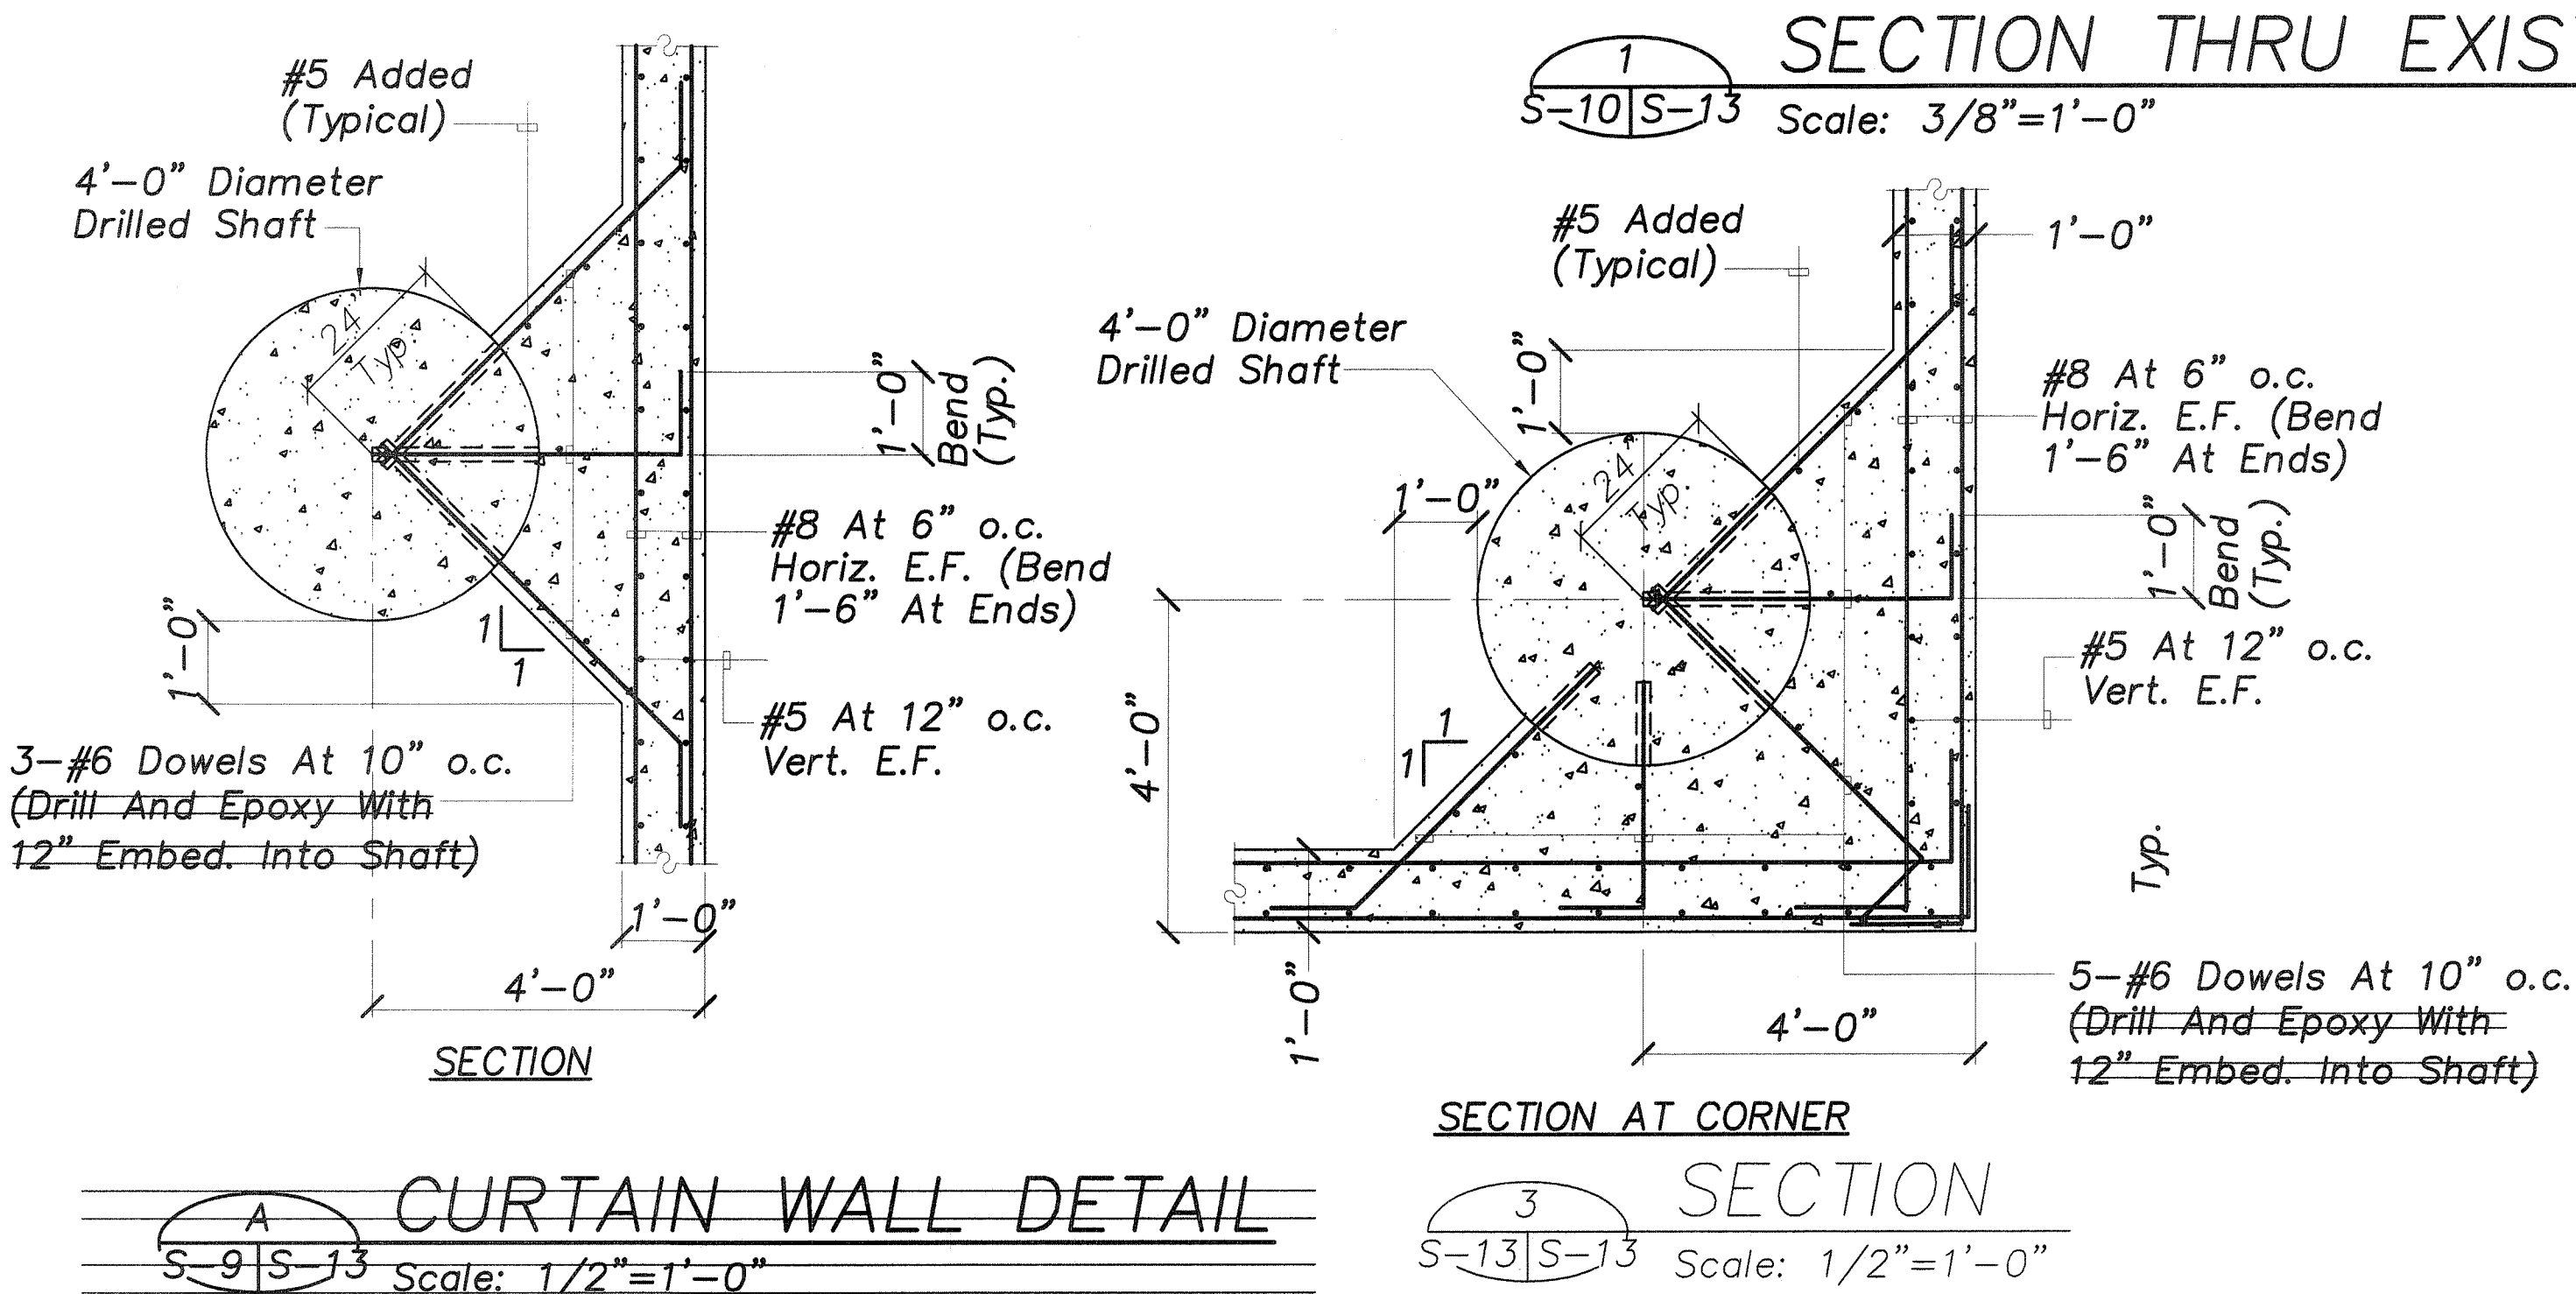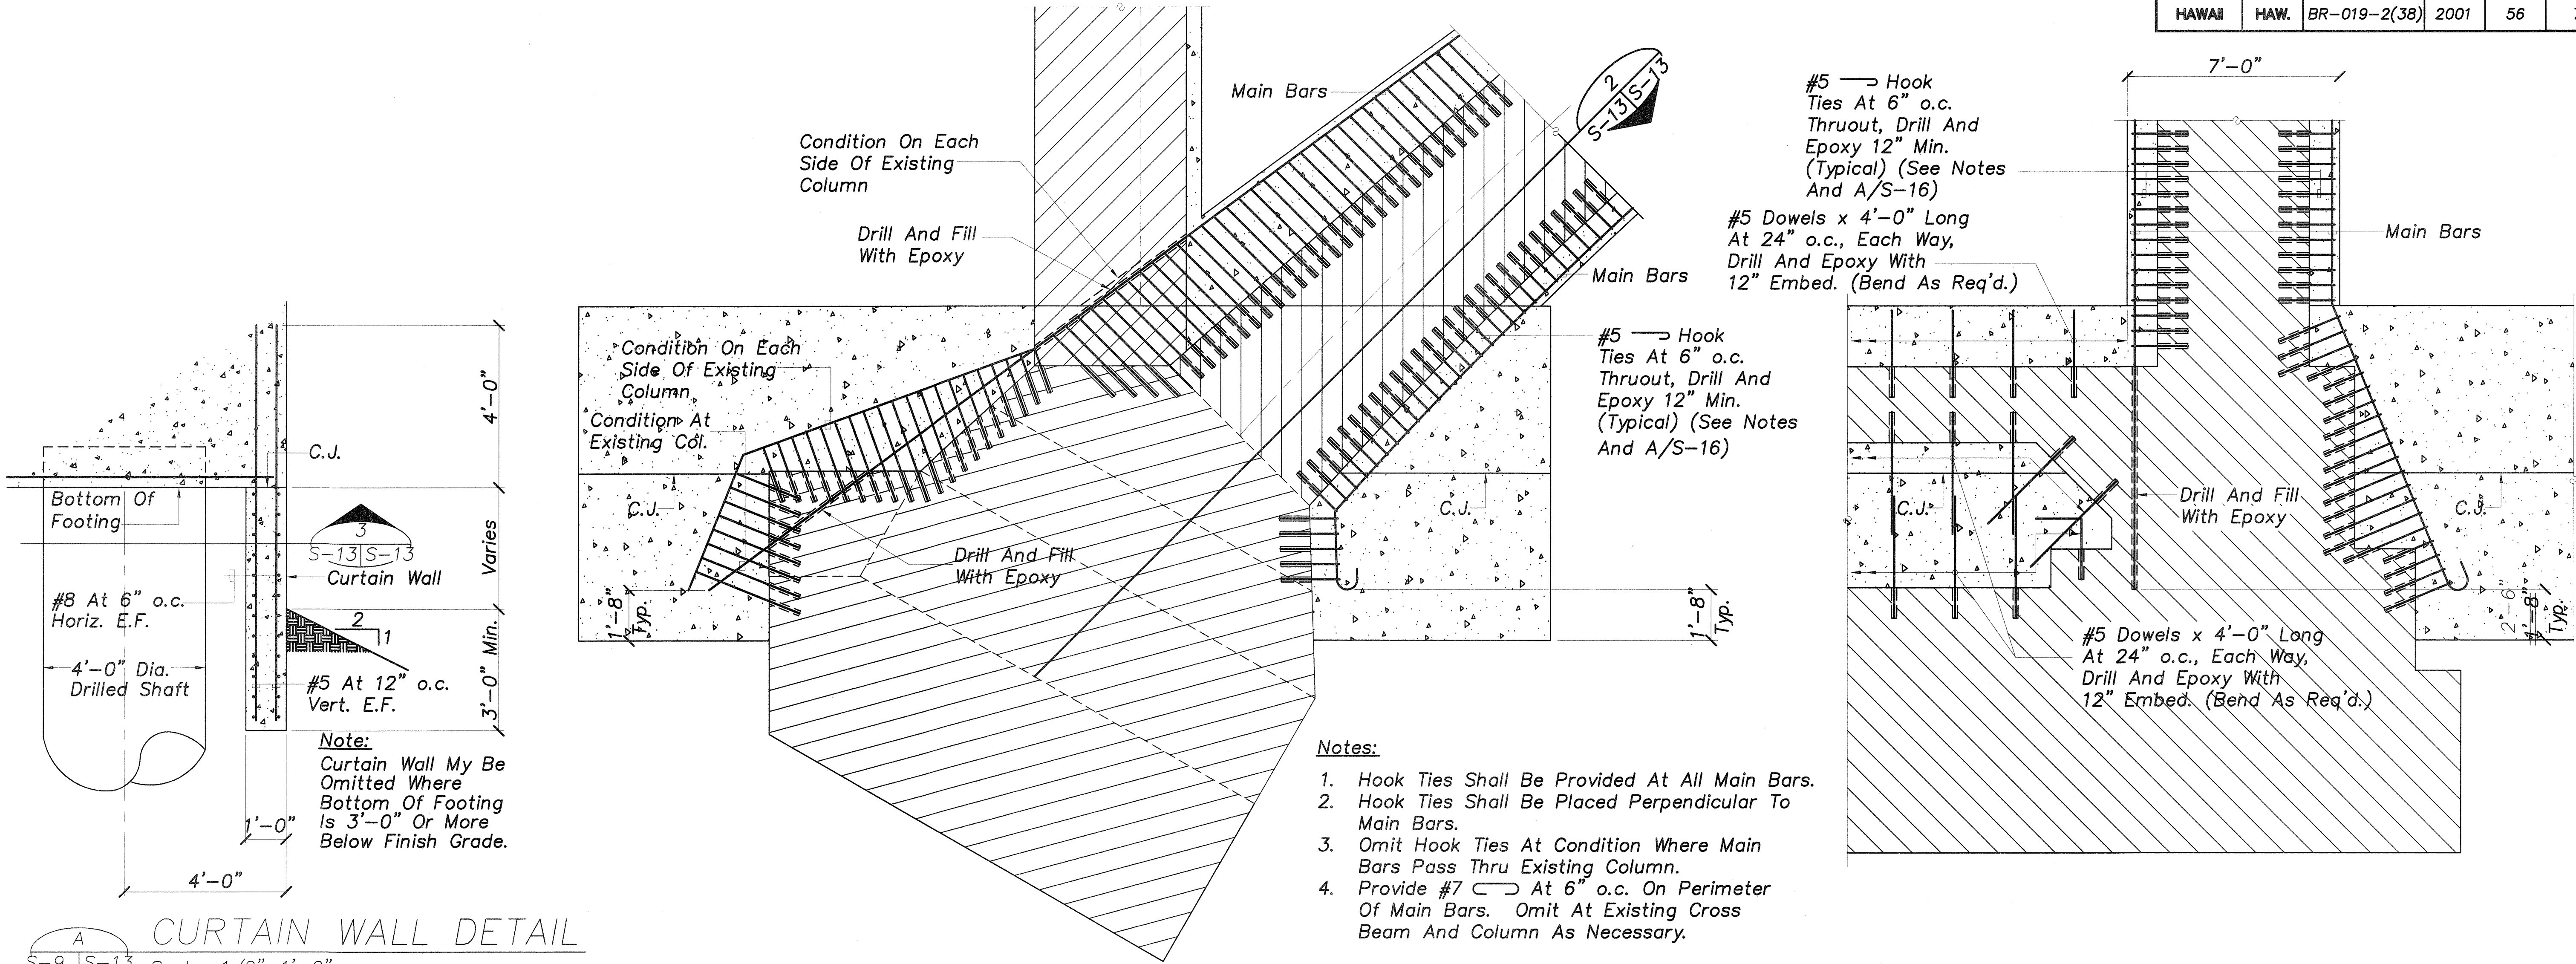


GRAPHIC SCALES

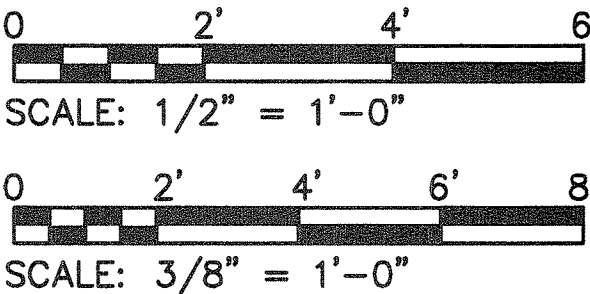

LEGEND FOR AS-BUILT POSTINGS


- Squiggly line for as-built deletion
- Double line for as-built deletion
- Text for as-built posting

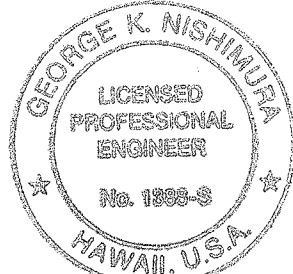

STATE OF HAWAII
DEPARTMENT OF TRANSPORTATION
HIGHWAYS DIVISION
FOUNDATION SECTIONS AND DETAILS
HAWAII BELT ROAD
KUPAPAUHUA BRIDGE WIDENING
HAMAKUA DISTRICT
Federal Aid Project No. BR-019-2(38)
SCALE: AS NOTED DATE: OCT., 2001
SHEET No. S-13 OF 30 SHEETS


Path: L:\WQA\6670-01 Kupapaulua Bridge\Struct\NEW-1 File Name: S14 Plot Date: Sep 25, 2006 07:52:48pm CAD User: skidani Xref File Name: | Border | AUTODATE |

FED. ROAD DIST. NO.	STATE	FED. AID PROJ. NO.	FISCAL YEAR	SHEET NO.	TOTAL SHEETS
HAWAII	HAW.	BR-019-2(38)	2002	57A	79

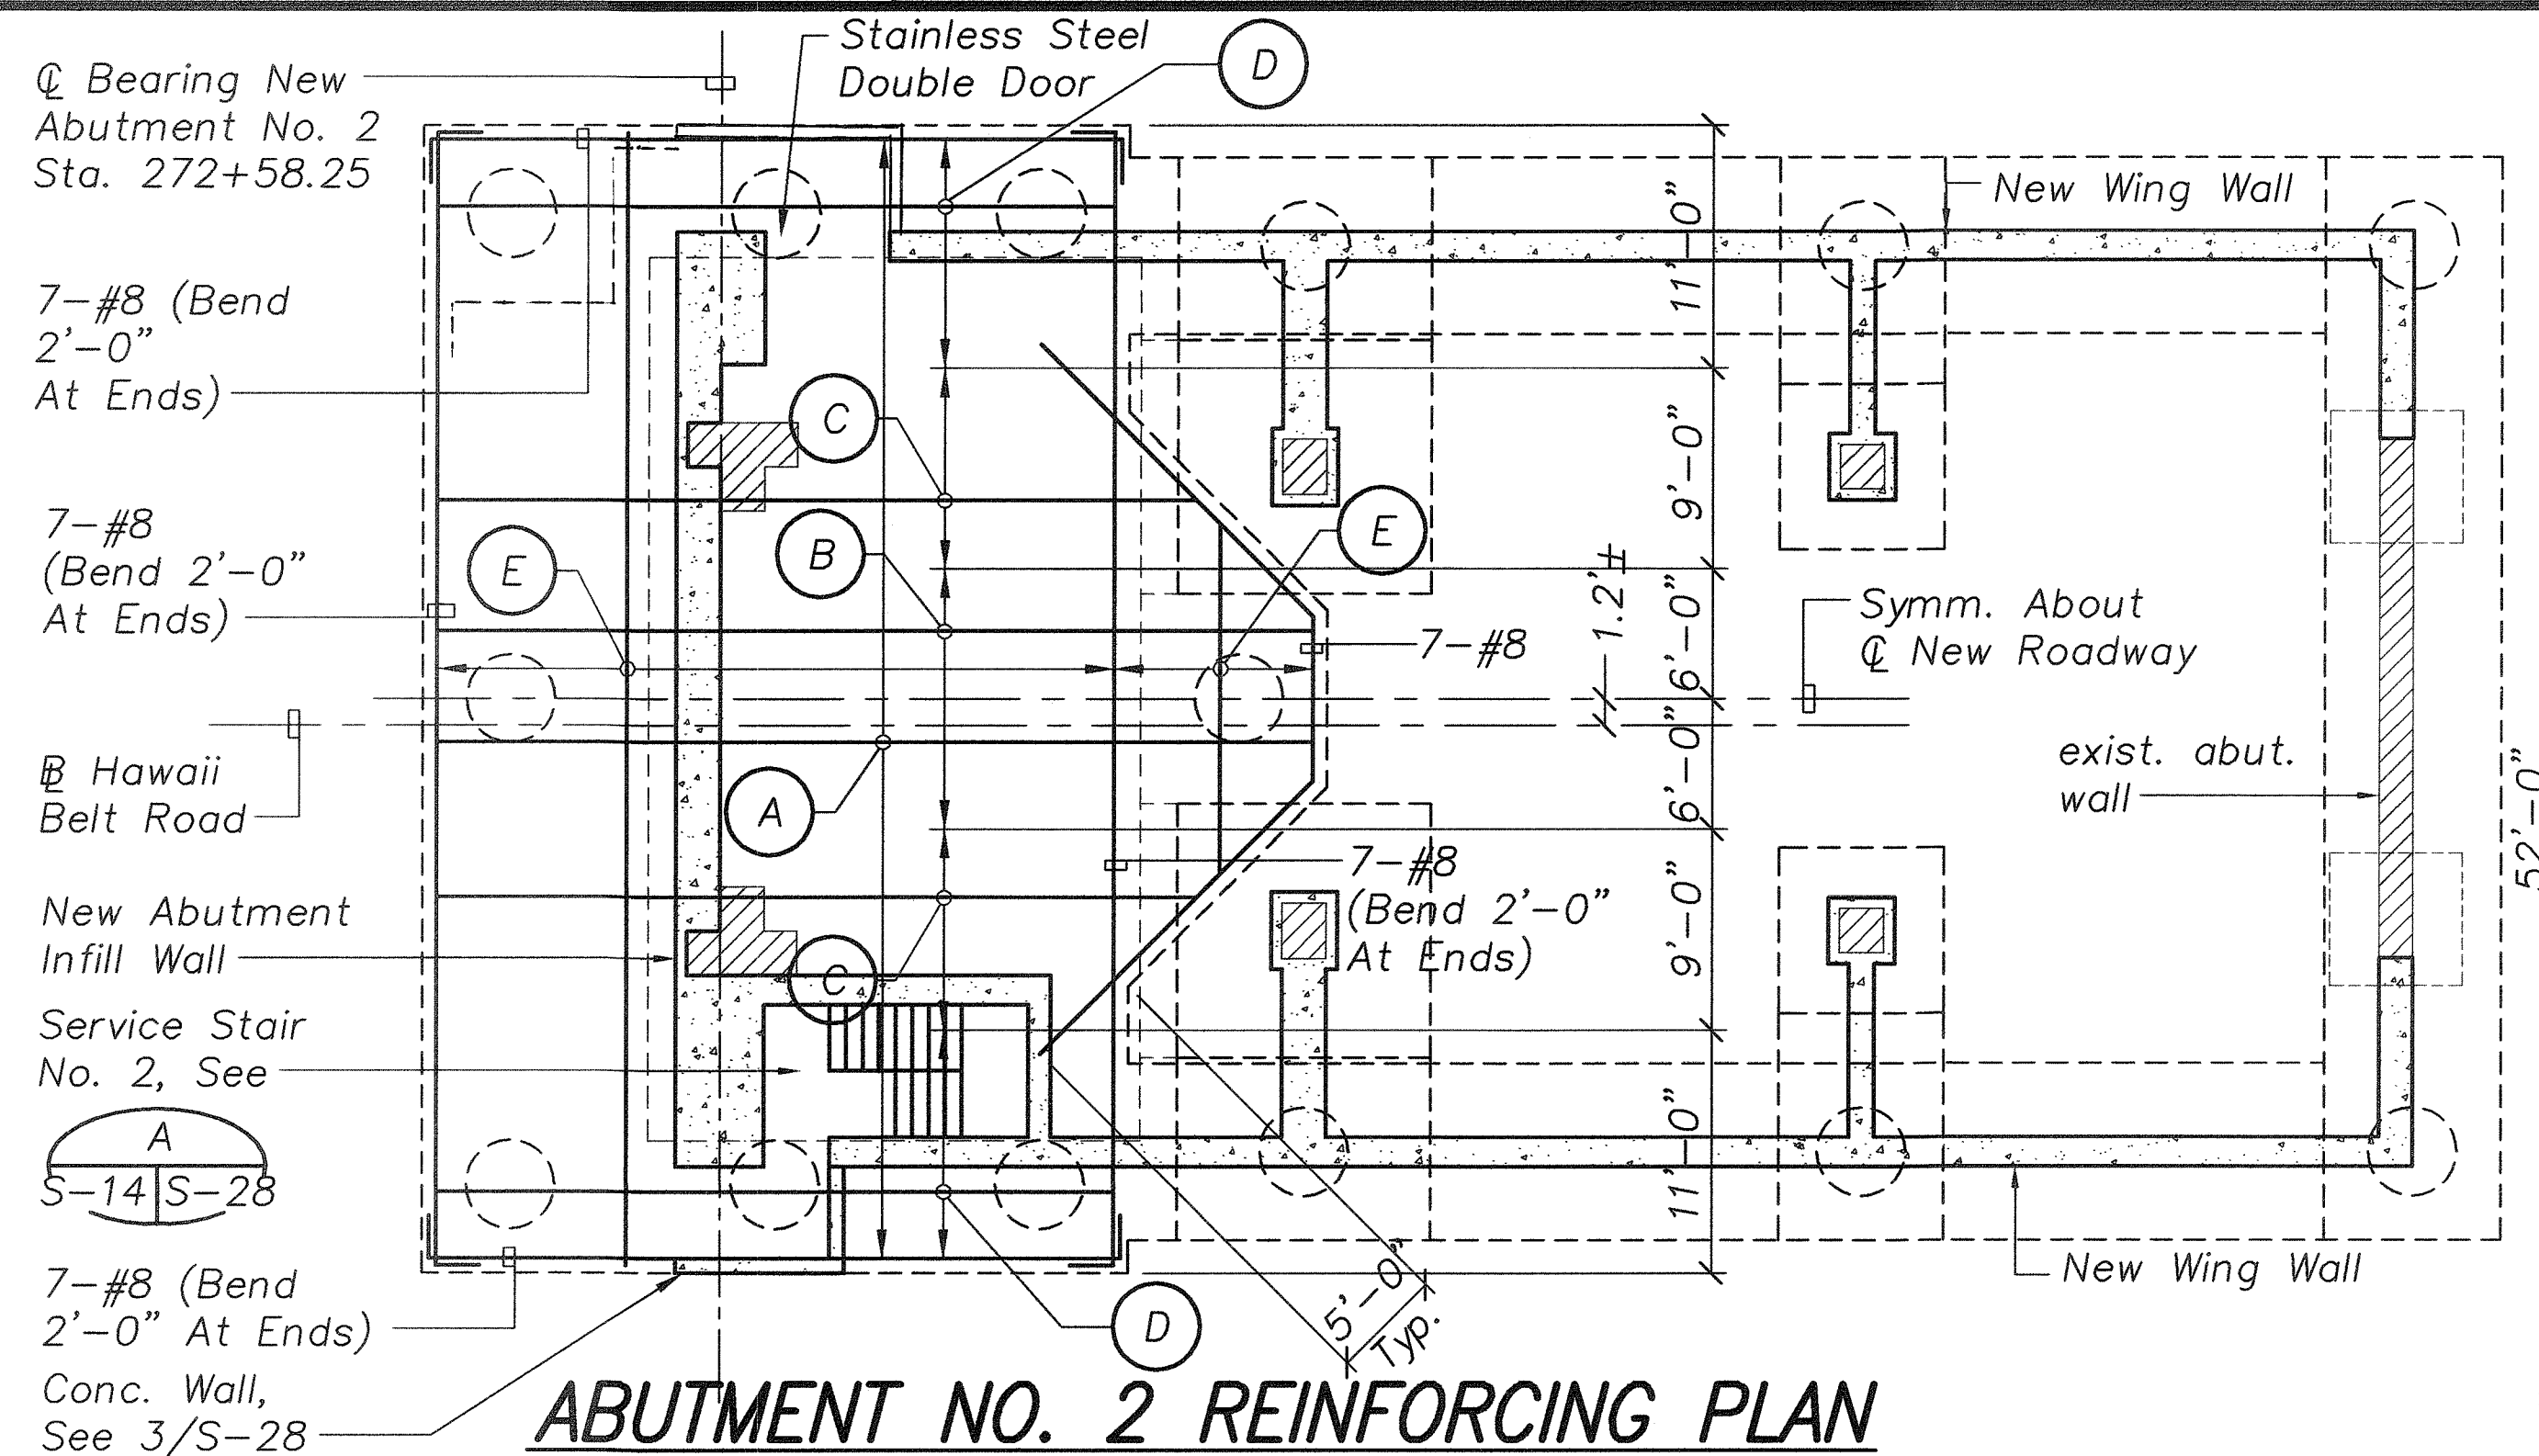


ABUTMENT NO. 2 REINFORCING PLAN

Scale: 1/8"=1'-0"

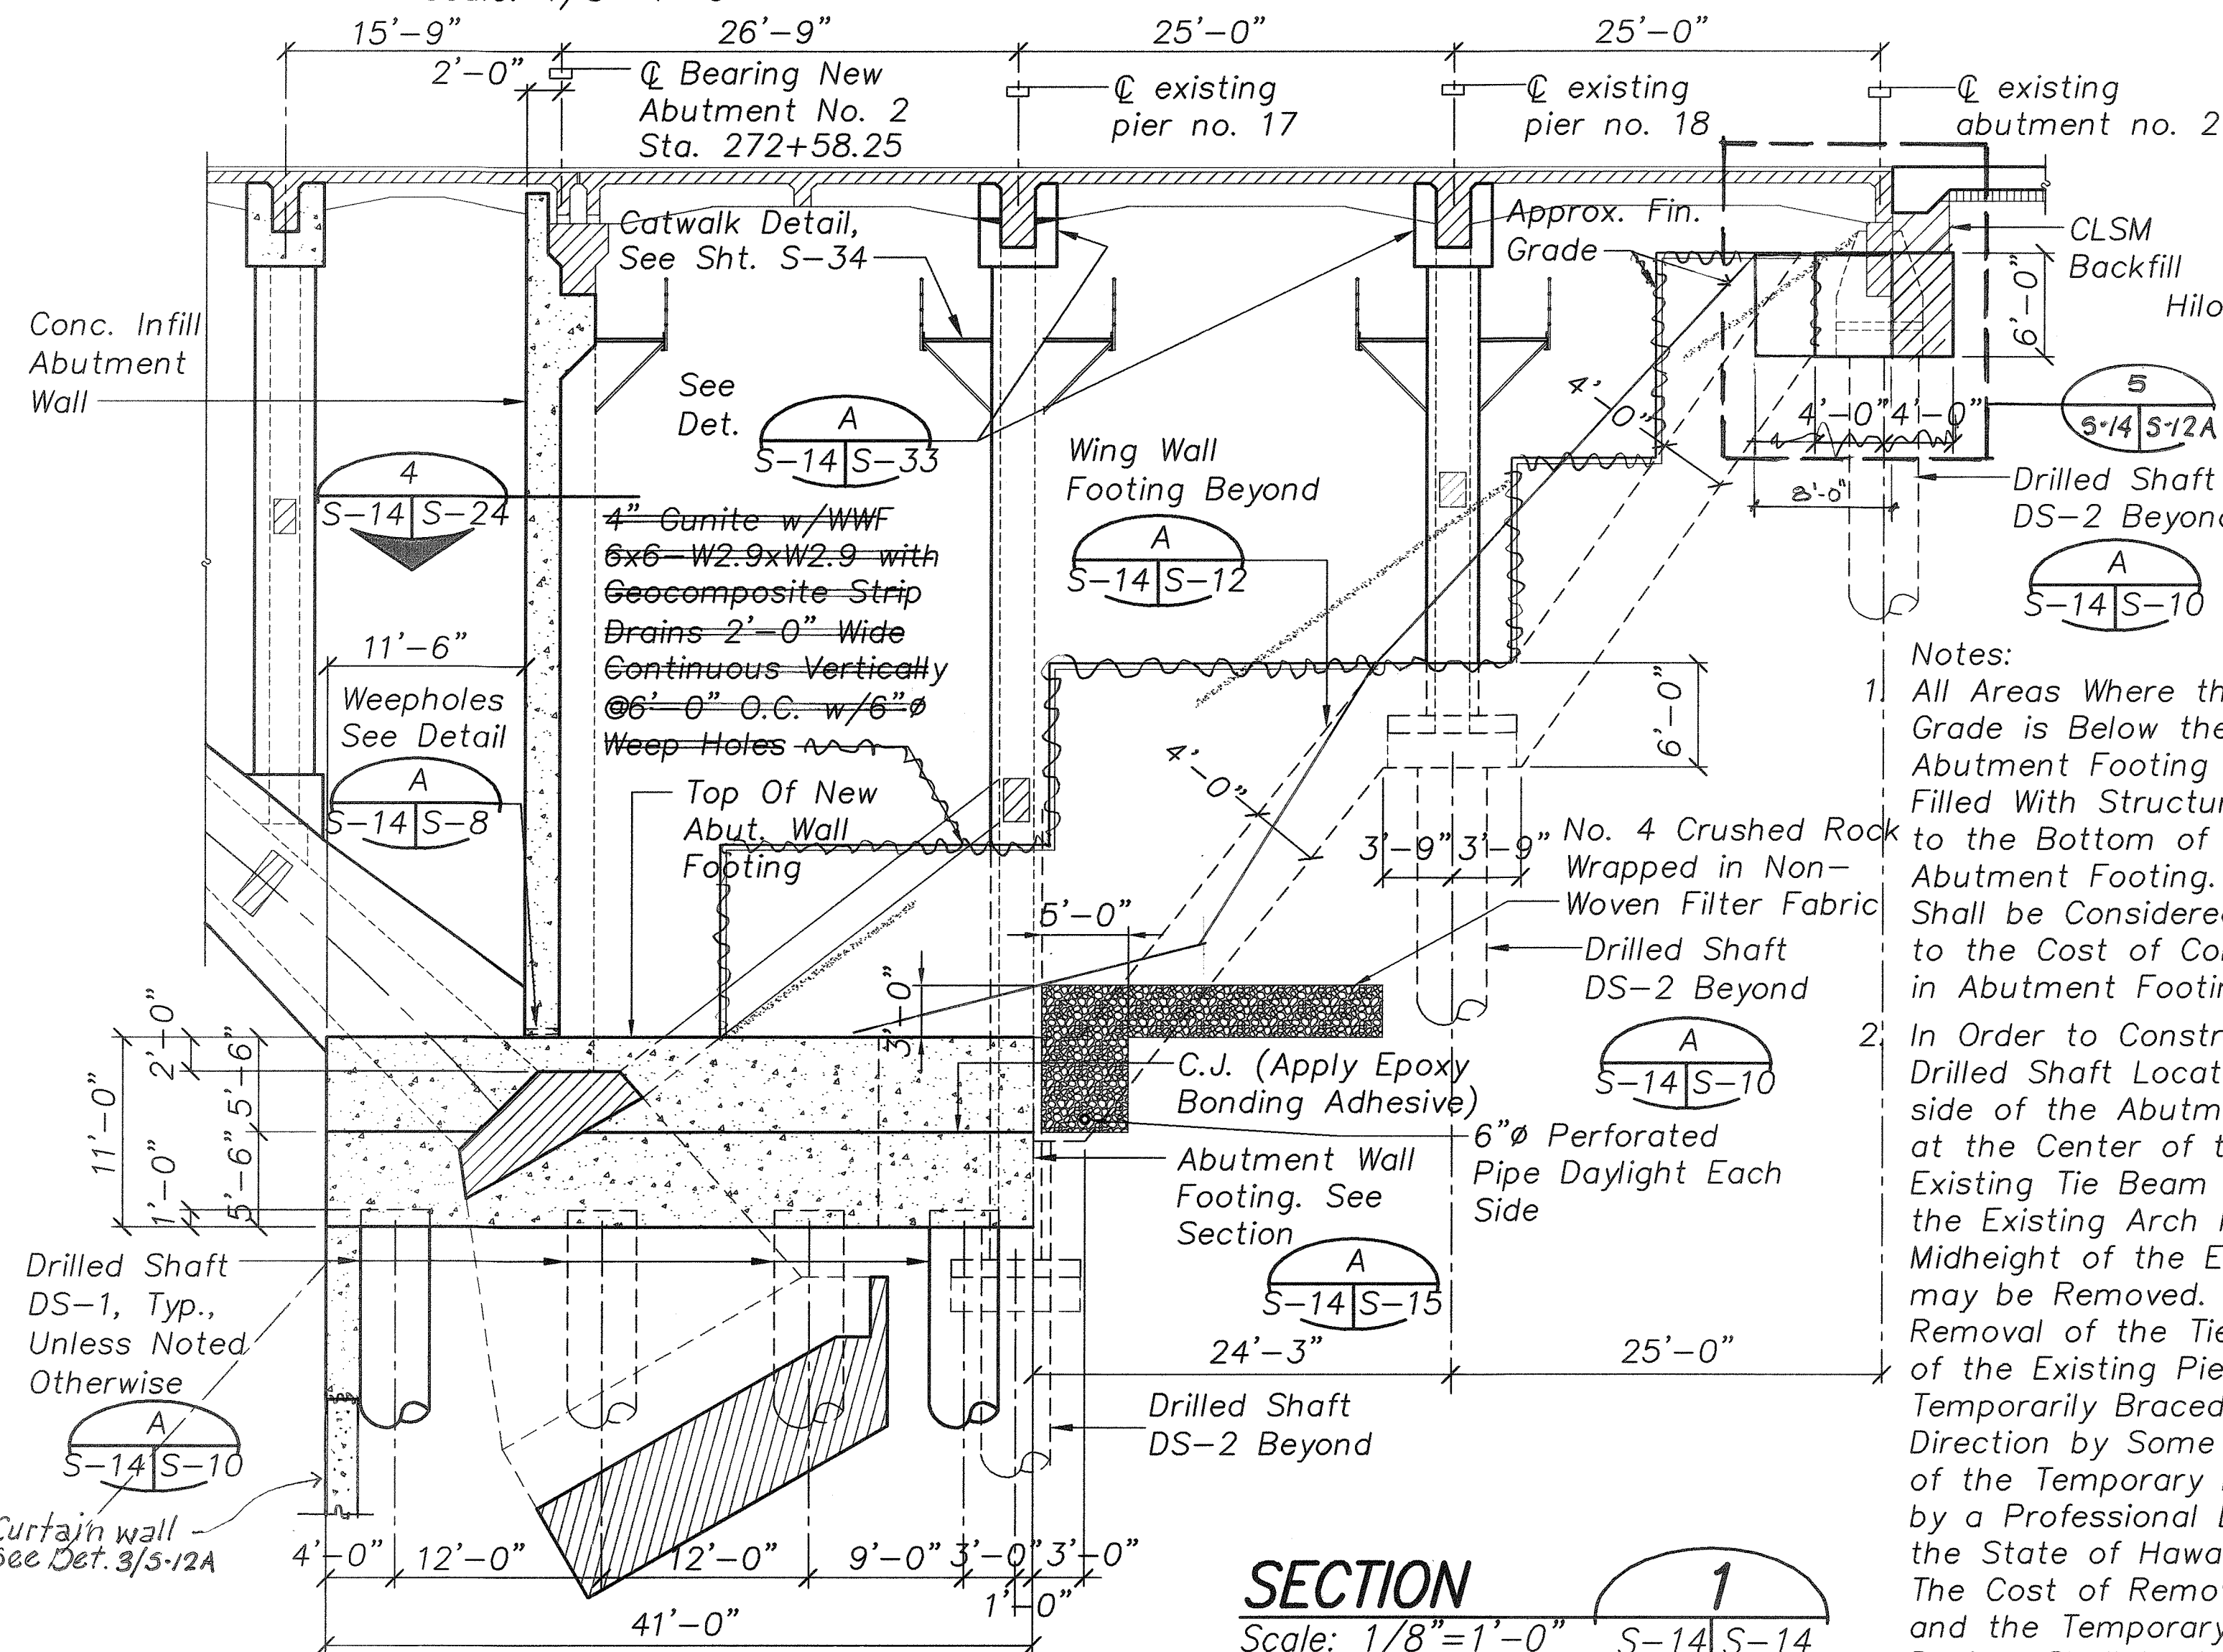

SECTION 1

Scale: 1/8"=1'-0"

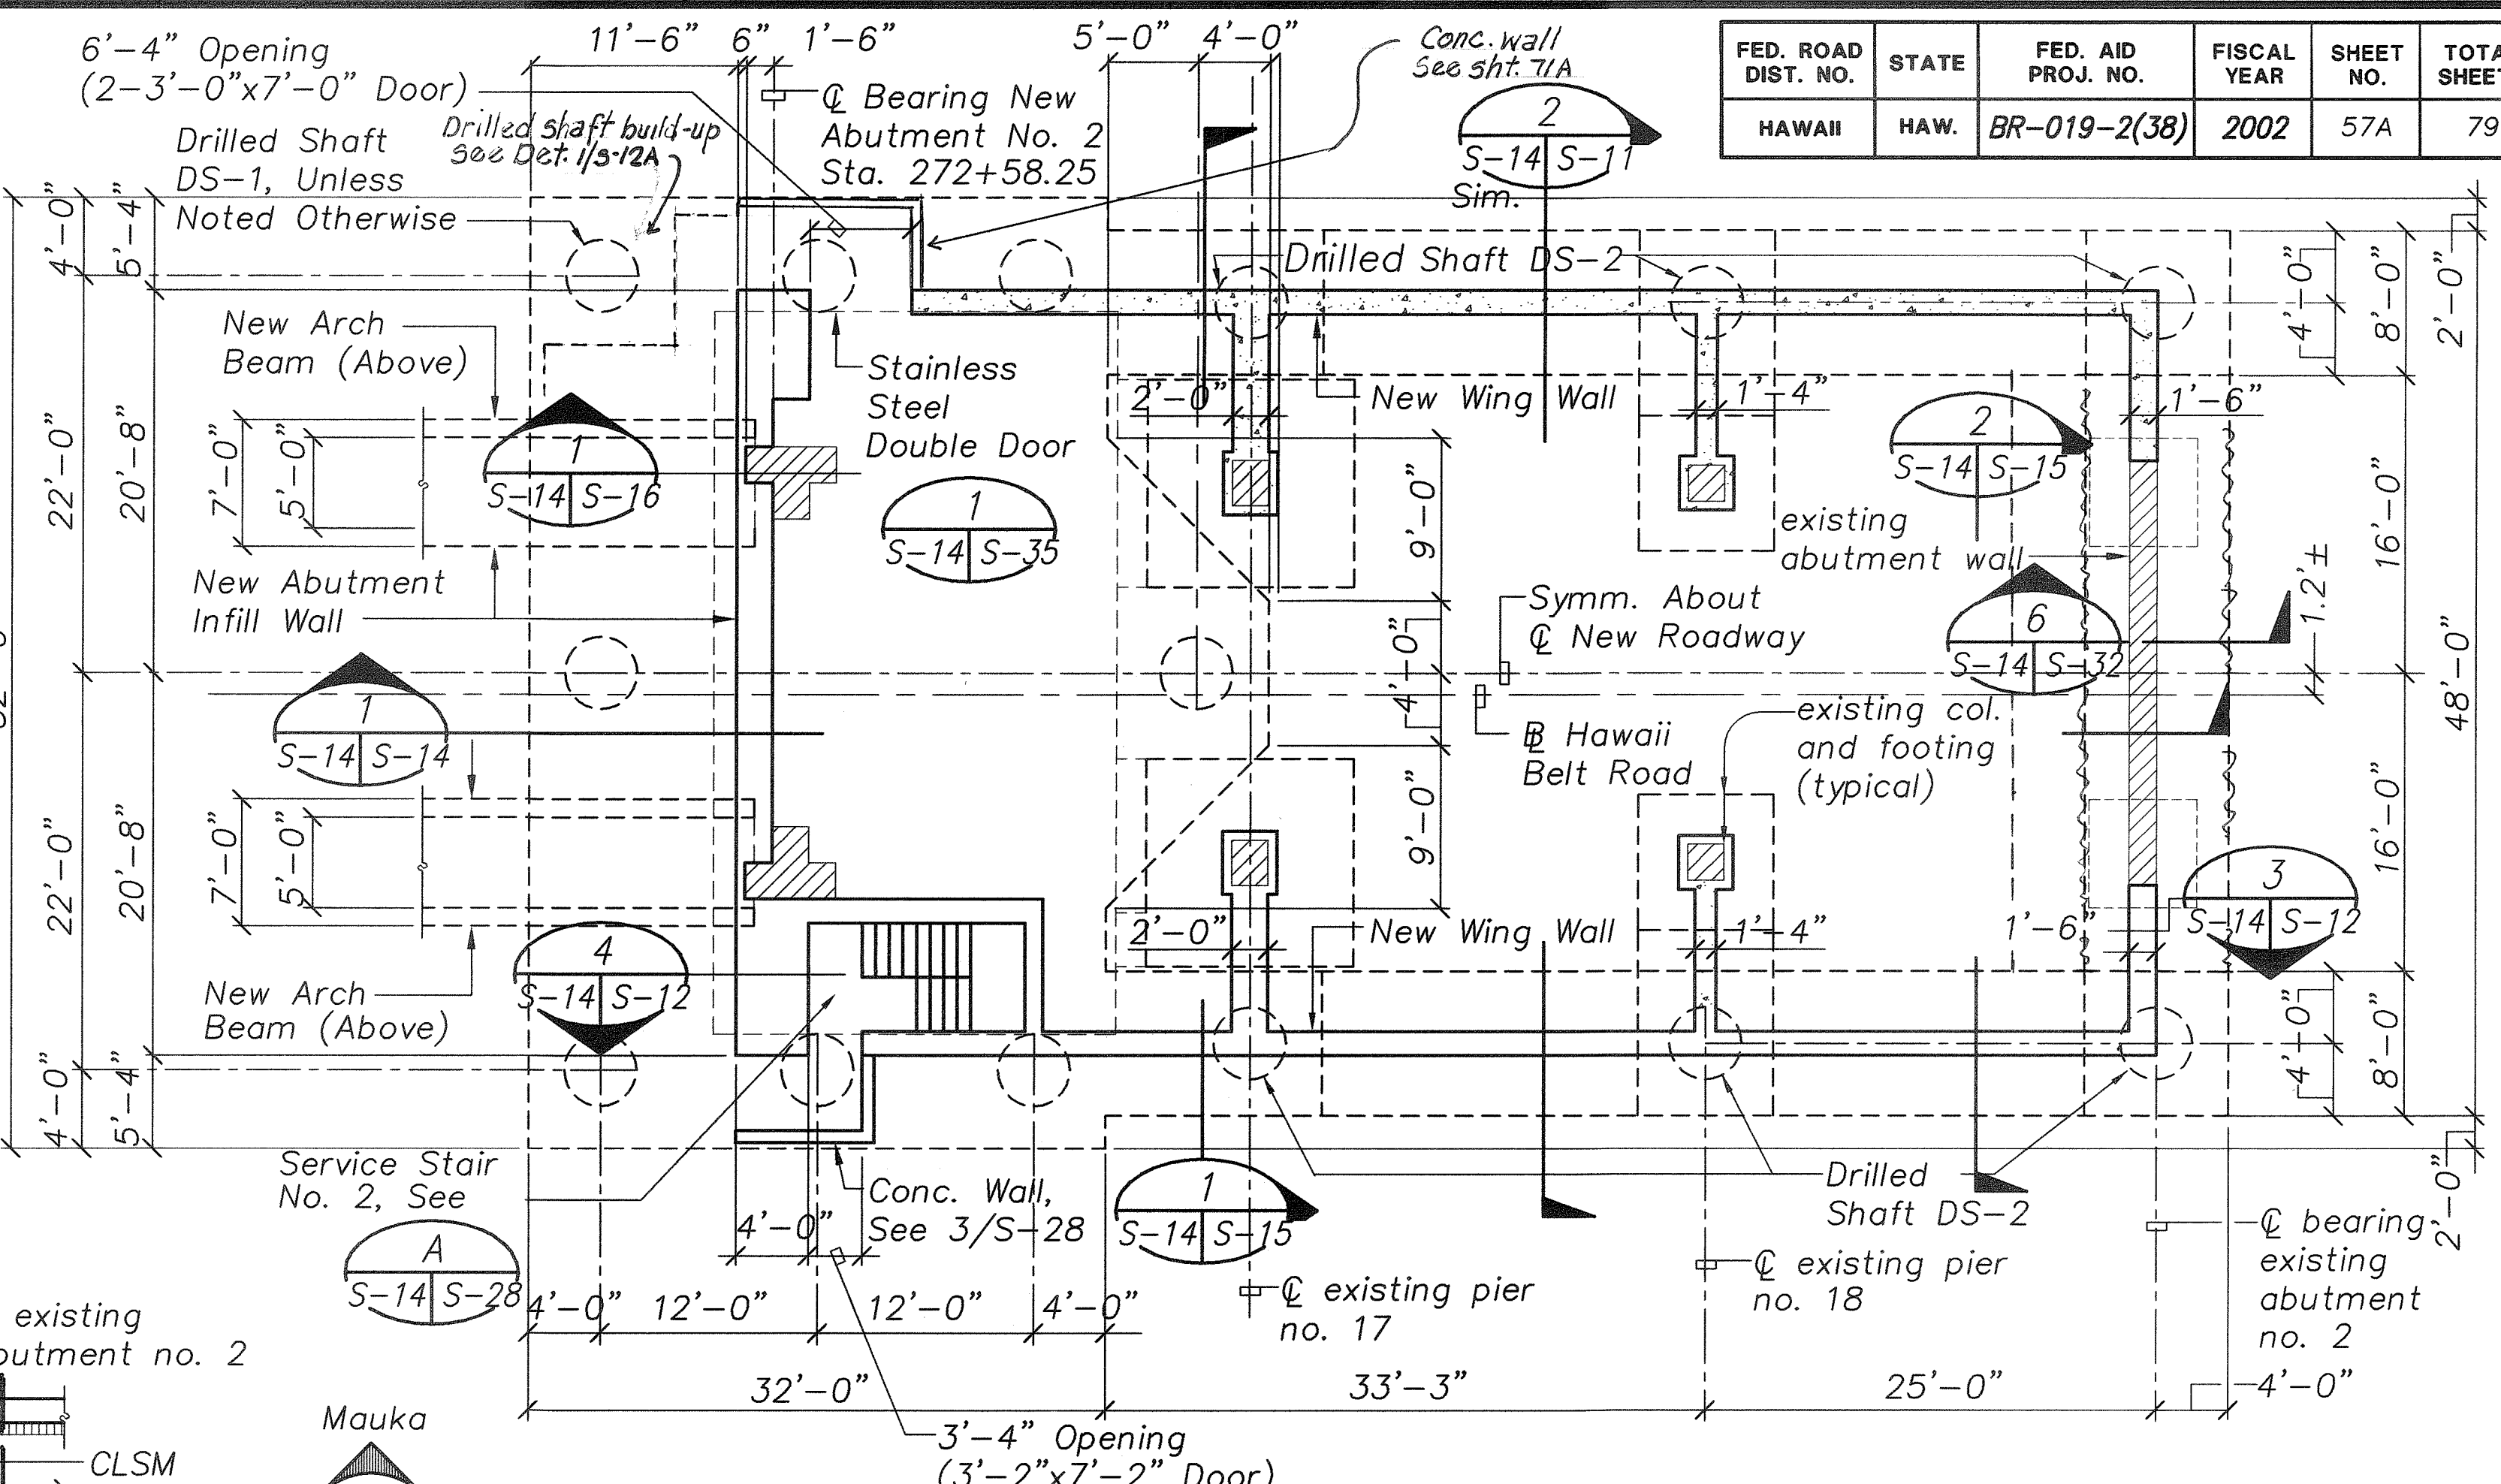

ABUTMENT NO. 2 FOUNDATION PLAN

Scale: 1/8"=1'-0"


REINFORCING SCHEDULE

Mark	Reinforcement	Remarks
(A)	#7 At 12" o.c. Top	Drill And Epoxy With 16" Embedment At Existing Column And Arch Beam
(B)	3-#11 Bundles at 9" o.c. Bottom #18 @ 7 1/2" o.c. Bottom	
(C)	2-#11 Bundles At 18" o.c. Bottom #18 @ 23" o.c. Bottom	Drill Thru Existing Footing And Fill With Epoxy
(D)	#11 At 9" o.c. Bottom	
(E)	2-#11 Bundles At 18" o.c. #18 @ 23" o.c. Top And Bottom	Drill Thru Existing Footing As Required And Fill With Epoxy
(F)	#11 At 9" o.c. Top And Bottom	

Notes:

- All Areas Where the Existing Grade is Below the New Abutment Footing Shall be Filled With Structural Backfill to the Bottom of the New Abutment Footing. The Cost Shall be Considered Incidental to the Cost of Concrete in Abutment Footings.
- In Order to Construct the Center Drilled Shaft Located on the Back-side of the Abutment No. 2 Footing at the Center of the Roadway, the Existing Tie Beam that Extends From the Existing Arch Footing to the Midheight of the Existing Pier No. 17 may be Removed. However, Prior to Removal of the Tie Beam, the Midheight of the Existing Pier No. 17 Shall be Temporarily Braced in the Longitudinal Direction by Some Other Means. Design of the Temporary Brace Shall be Prepared by a Professional Engineer Licensed in the State of Hawaii for Acceptance. The Cost of Removal of the Tie Beam and the Temporary Brace, Including Design, Shall be Incidental to the Cost for Drilled Shaft.

GRAPHIC SCALES

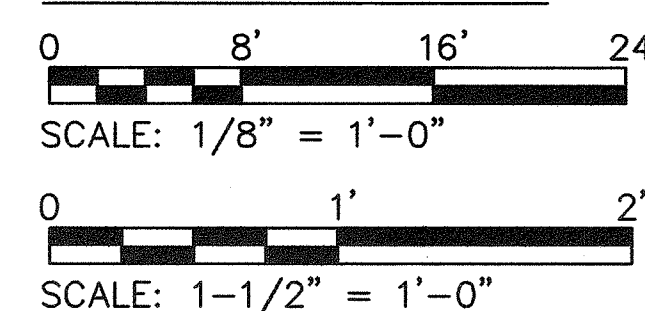


THIS WORK WAS PREPARED BY ME OR UNDER MY SUPERVISION

Myron Okubo


DATE	REVISION
STATE OF HAWAII DEPARTMENT OF TRANSPORTATION HIGHWAYS DIVISION ABUTMENT NO. 2 FOUNDATION PLAN, FOUNDATION SECTION HAWAII BELT ROAD KUPAPALUA BRIDGE WIDENING HAMAKUA DISTRICT Federal Aid Project No. BR-019-2(38) Scale: As Noted Date: June 23, 2003	
SHEET No. S-14 OF 36 SHEETS	

"AS-BUILT"


FED. ROAD DIST. NO.	STATE	FED. AID PROJ. NO.	FISCAL YEAR	SHEET NO.	TOTAL SHEETS
HAWAII	HAW.	BR-019-2(38)	2002	58A	79

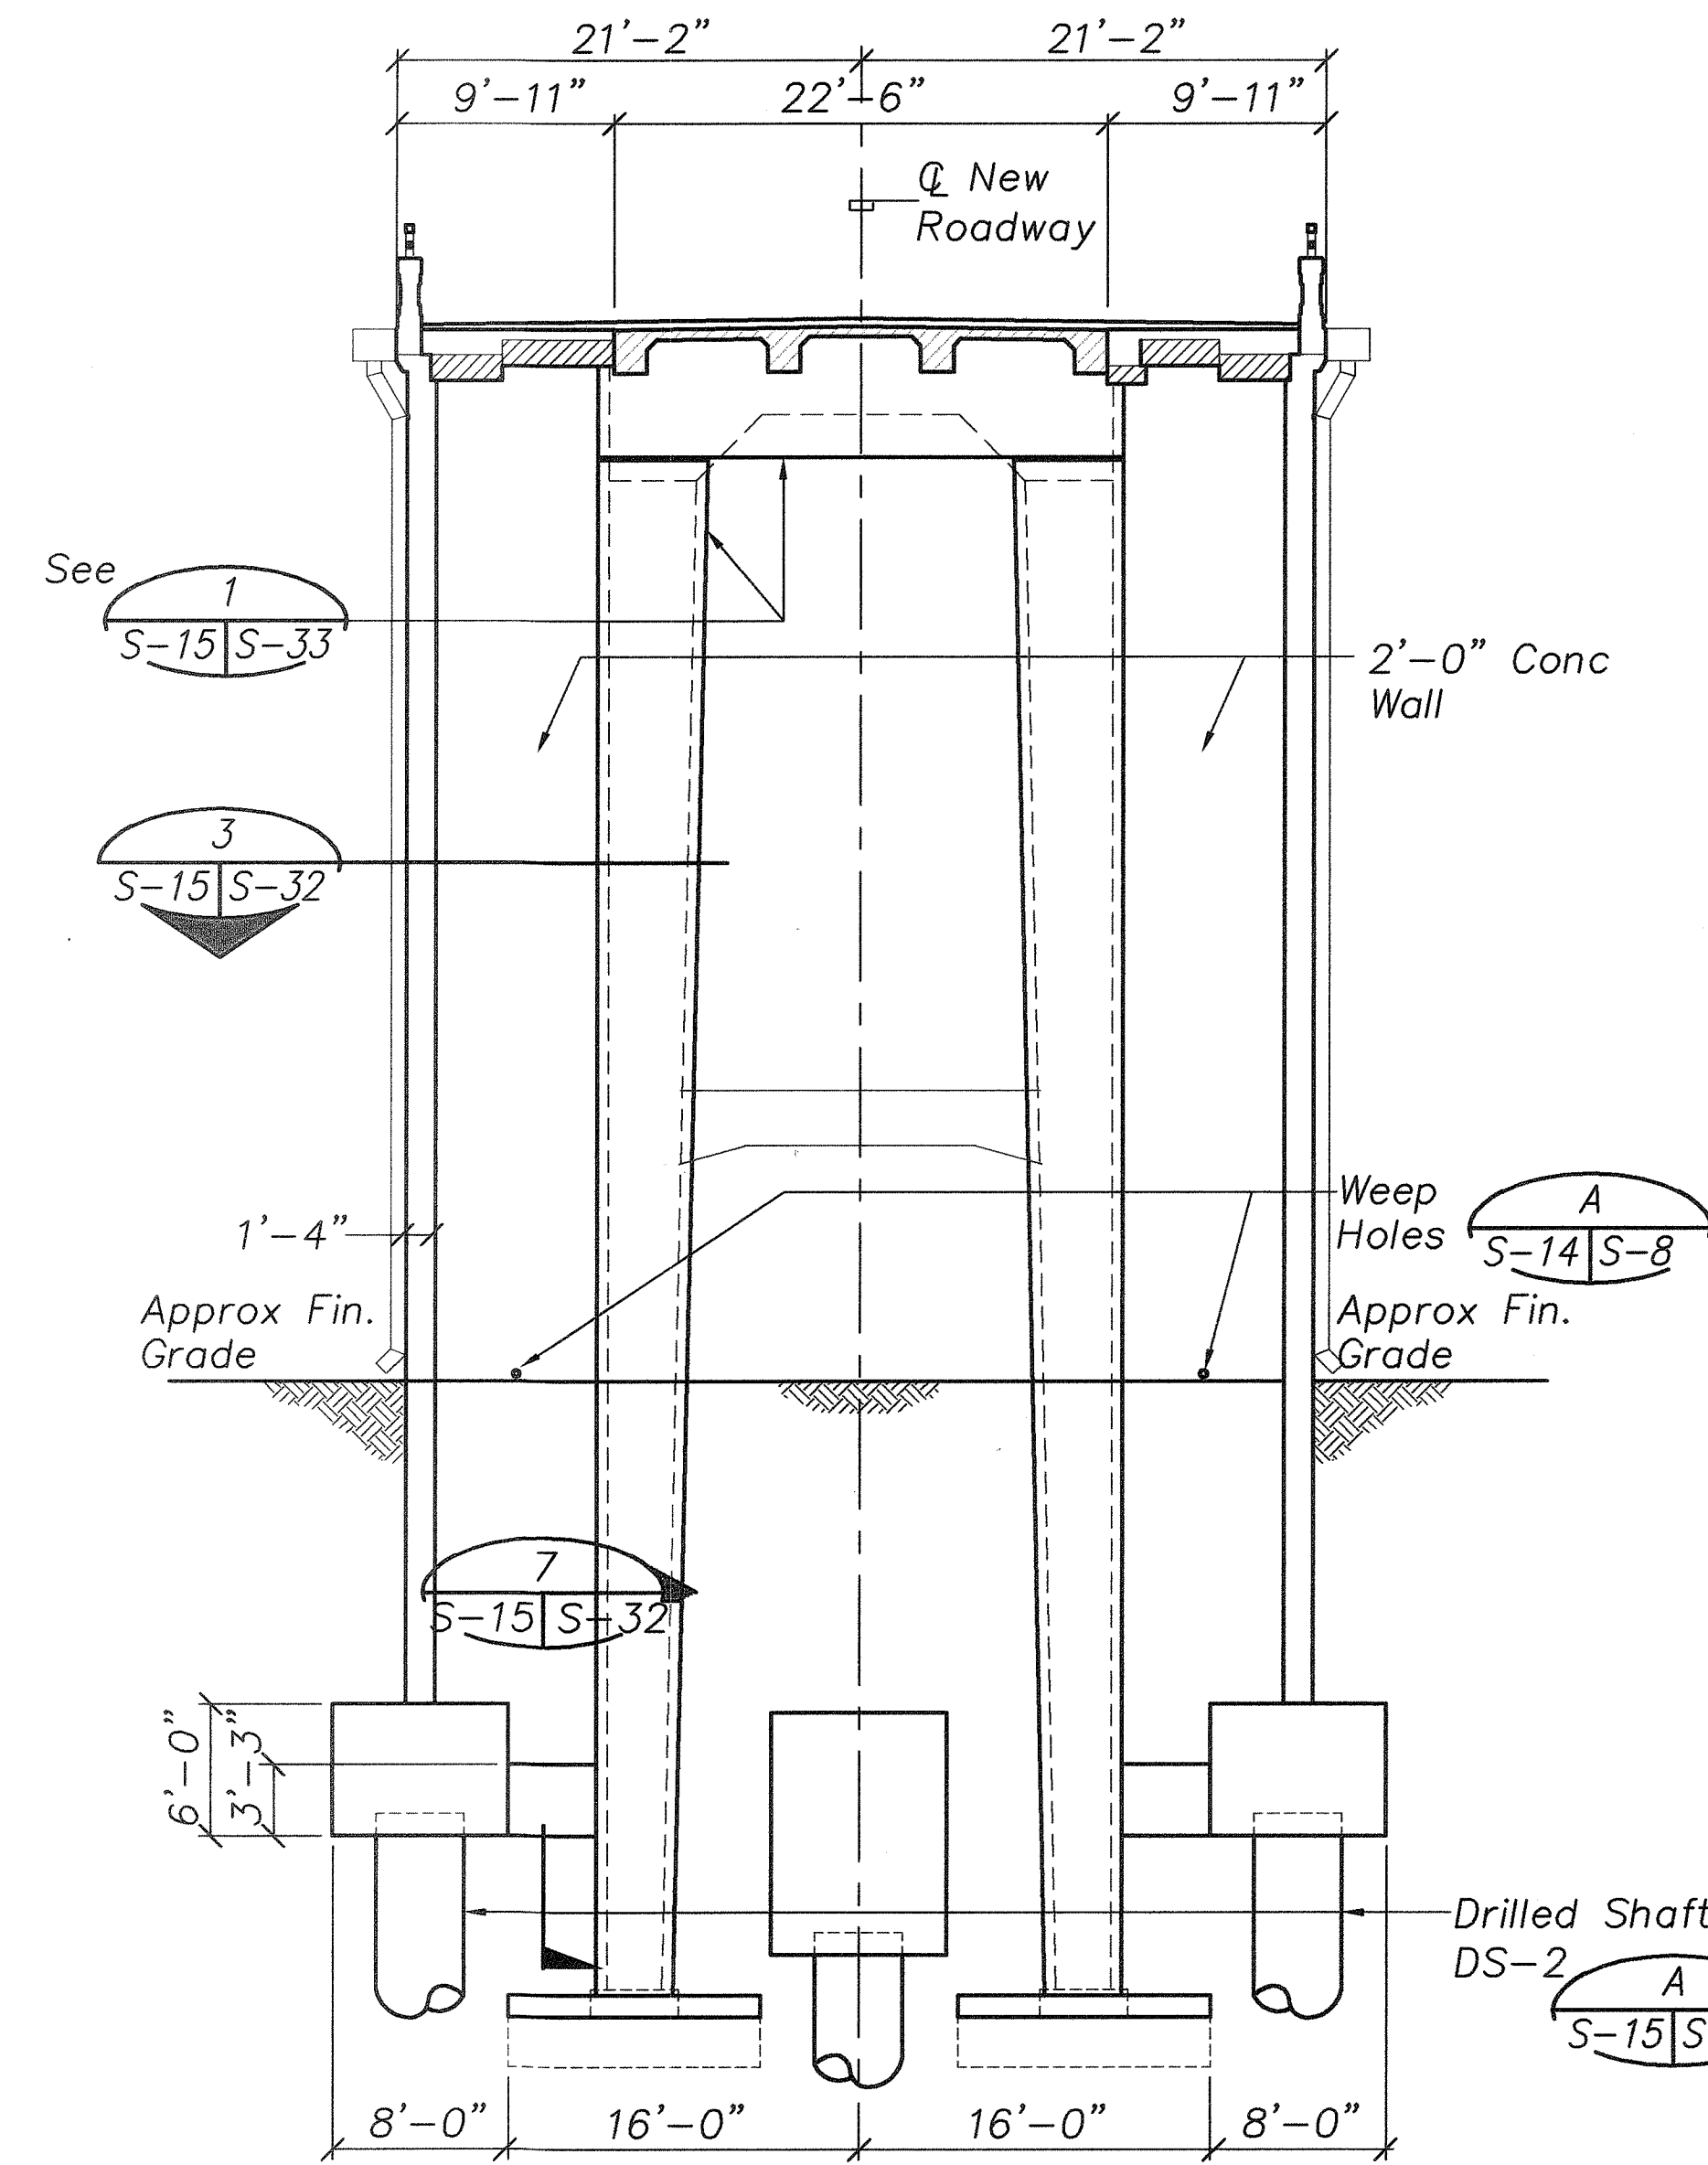

SECTION 1
S-14 S-15 Scale: 1/8"=1'-0"

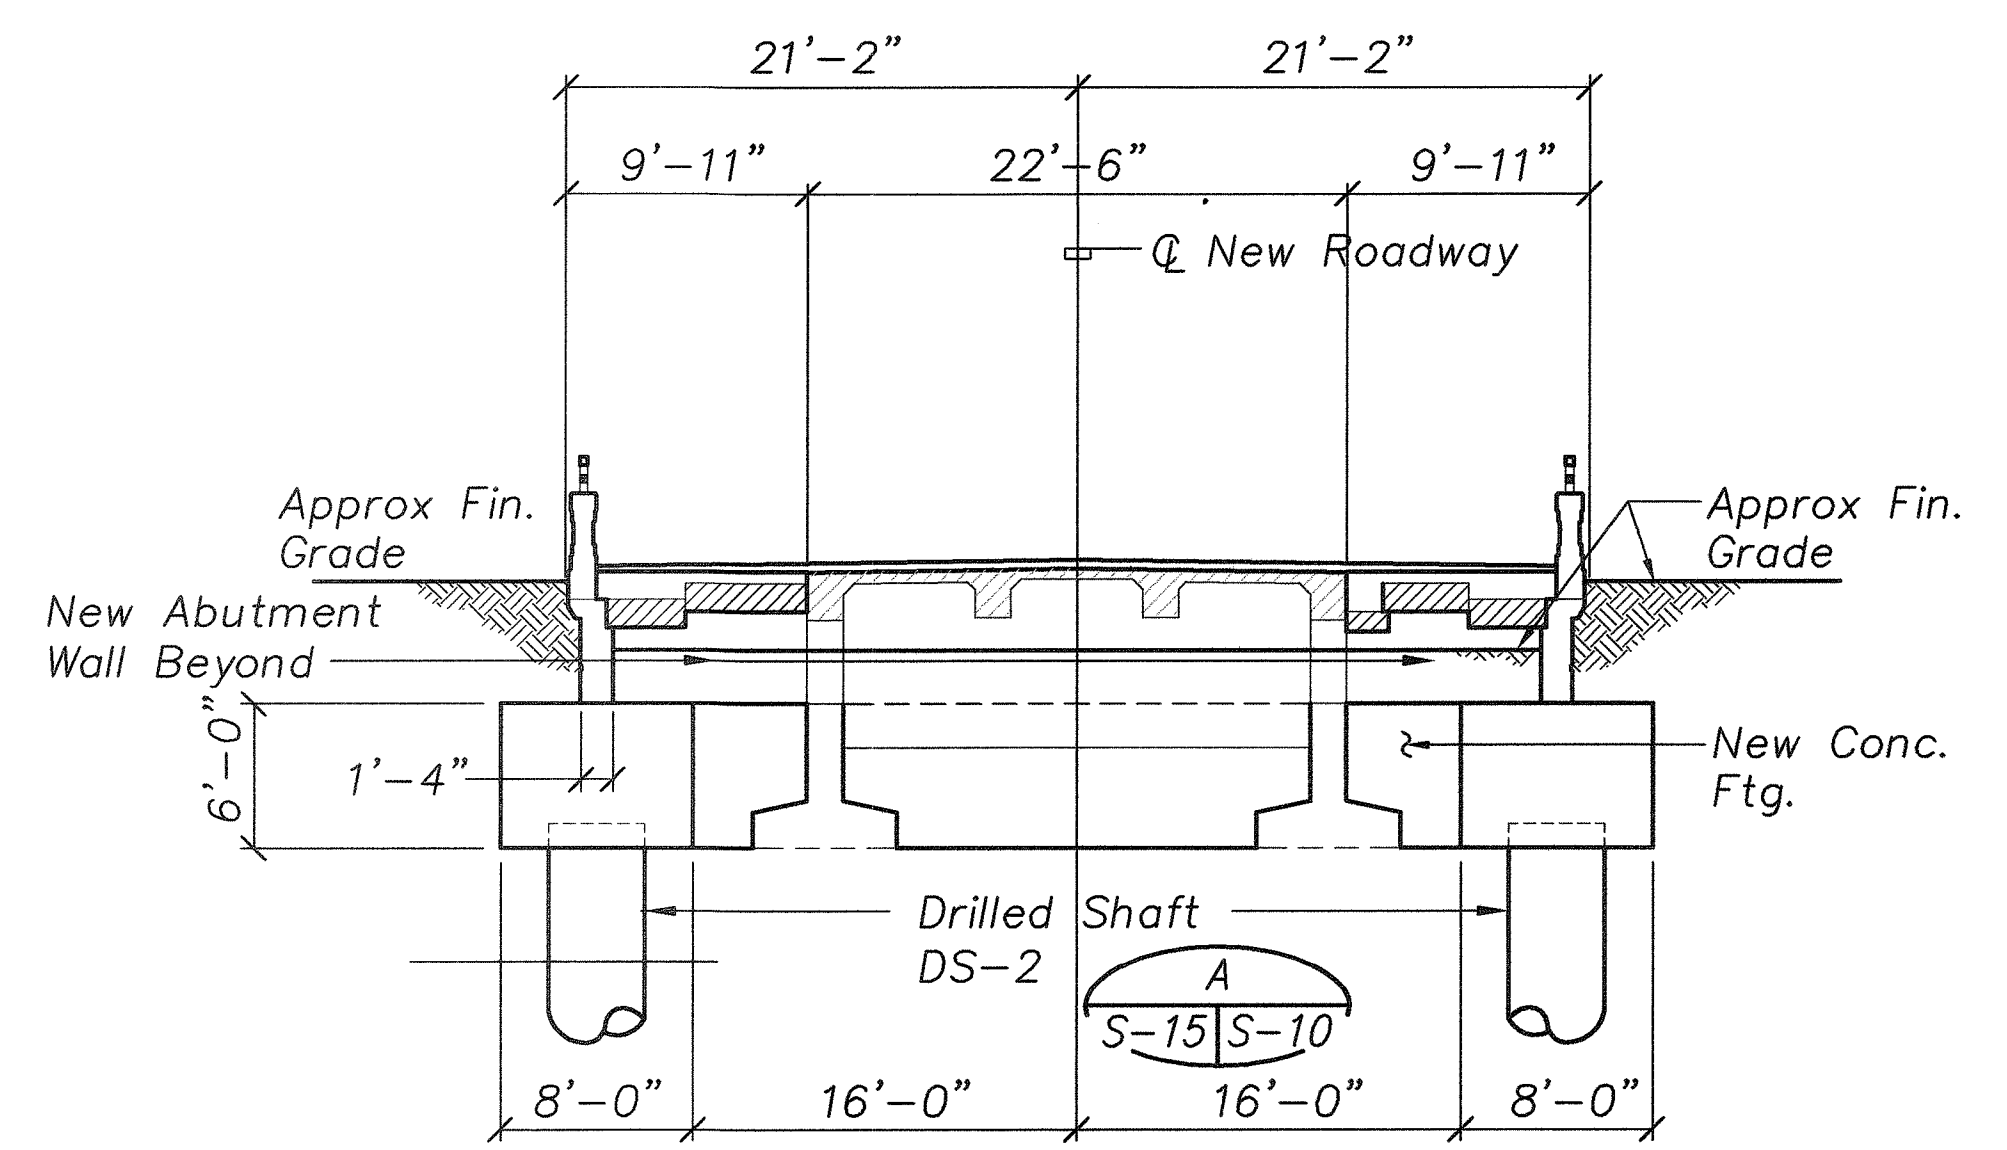


SECTION 2
S-14 S-15 Scale: 1/8"=1'-0"

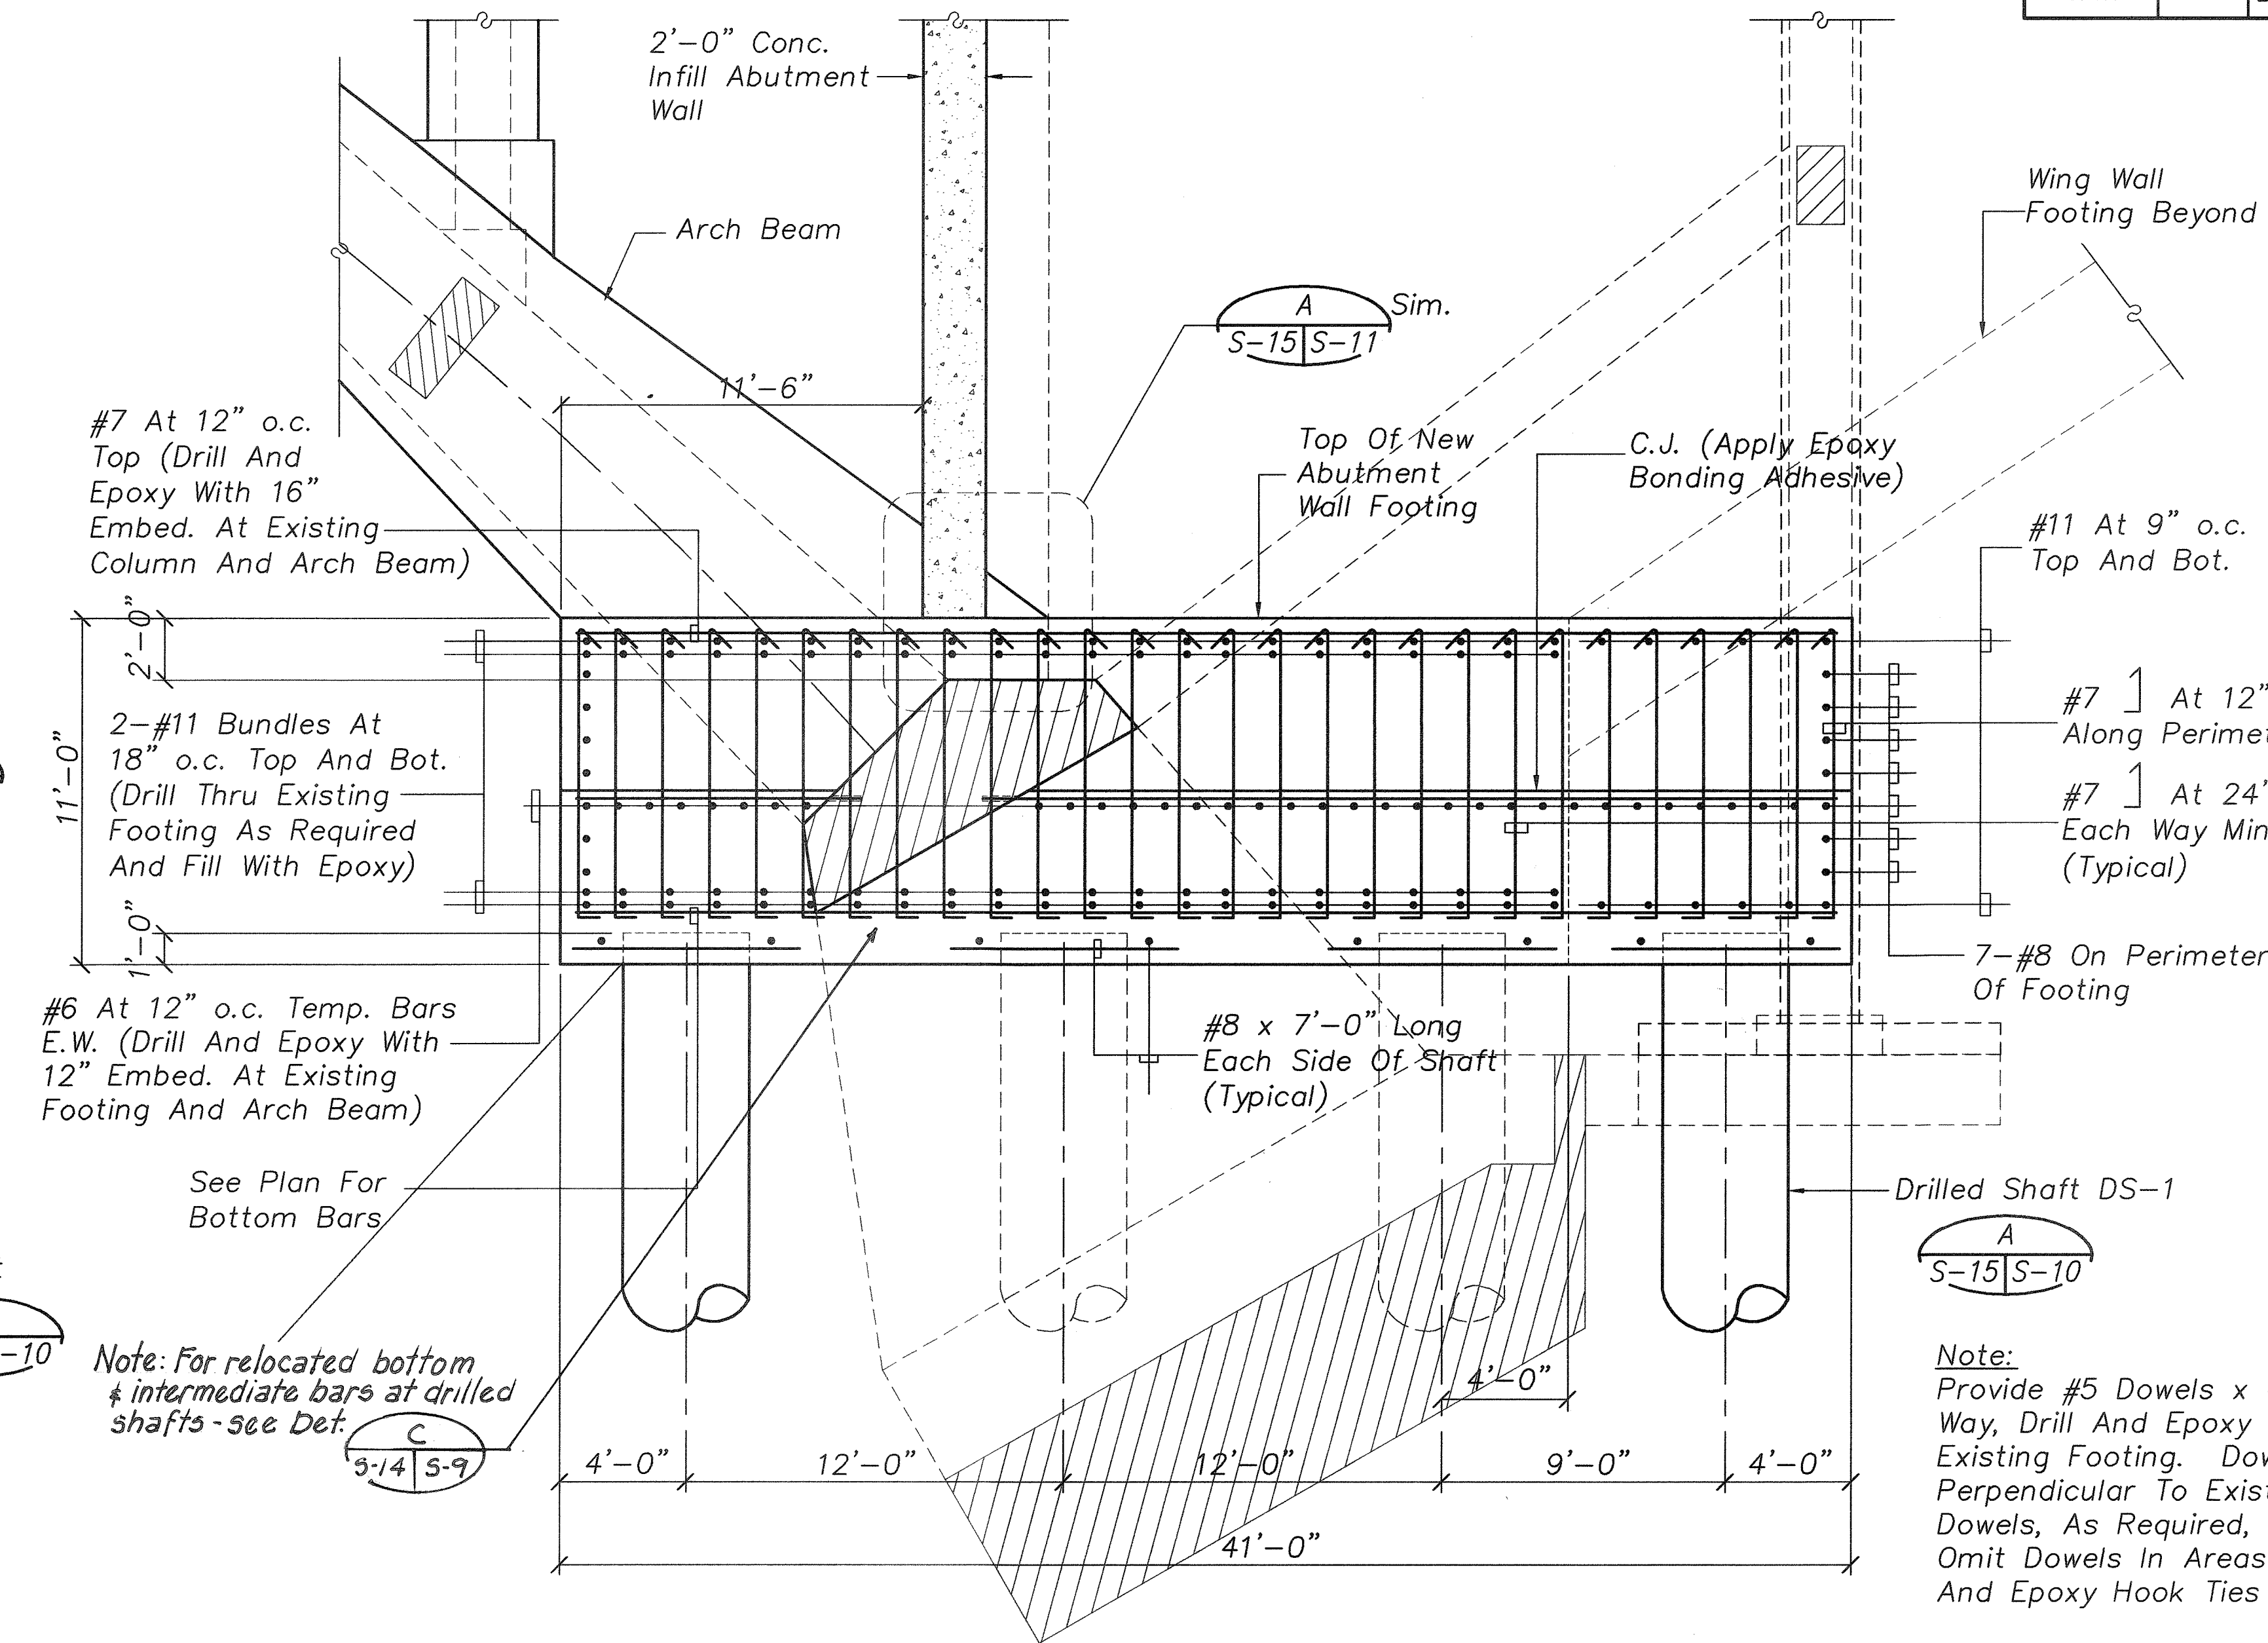

ABUTMENT NO. 2 WALL FOOTING SECTION
S-14 S-15 Scale: 1/4"=1'-0"

GRAPHIC SCALES

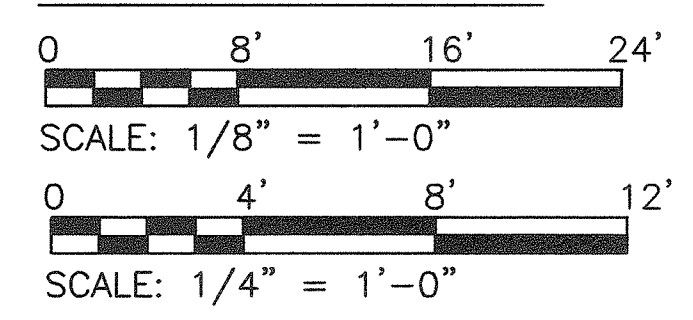

THIS WORK WAS PREPARED BY ME OR UNDER MY SUPERVISION
Myron Okubo


DATE	REVISION
	STATE OF HAWAII DEPARTMENT OF TRANSPORTATION HIGHWAYS DIVISION FOUNDATION SECTIONS AND DETAILS HAWAII BELT ROAD KUPAPAUUA BRIDGE WIDENING HAMAKUA DISTRICT Federal Aid Project No. BR-019-2(38) Scale: As Noted Date: June 23, 2003 SHEET No. S-15 OF 36 SHEETS

"AS-BUILT"


Path: L:\W04\6670-01 Kupapaulua Bridge\Drawings File Name: S15 Plot Date: Sep 25, 2006-07:53:19pm CAD User: skiddoni Xref File Name: | Border | AUTODATE |

SURVEY PLOTTED BY	DATE
DRAWN BY	
DESIGNED BY	
CHECKED BY	
ORIGINAL PLAN	
NOTEBOOK	
No.	


FED. ROAD DIST. NO.	STATE	FED. AID PROJ. NO.	FISCAL YEAR	SHEET NO.	TOTAL SHEETS
HAWAII	HAW.	BR-019-2(38)	2002	59	73

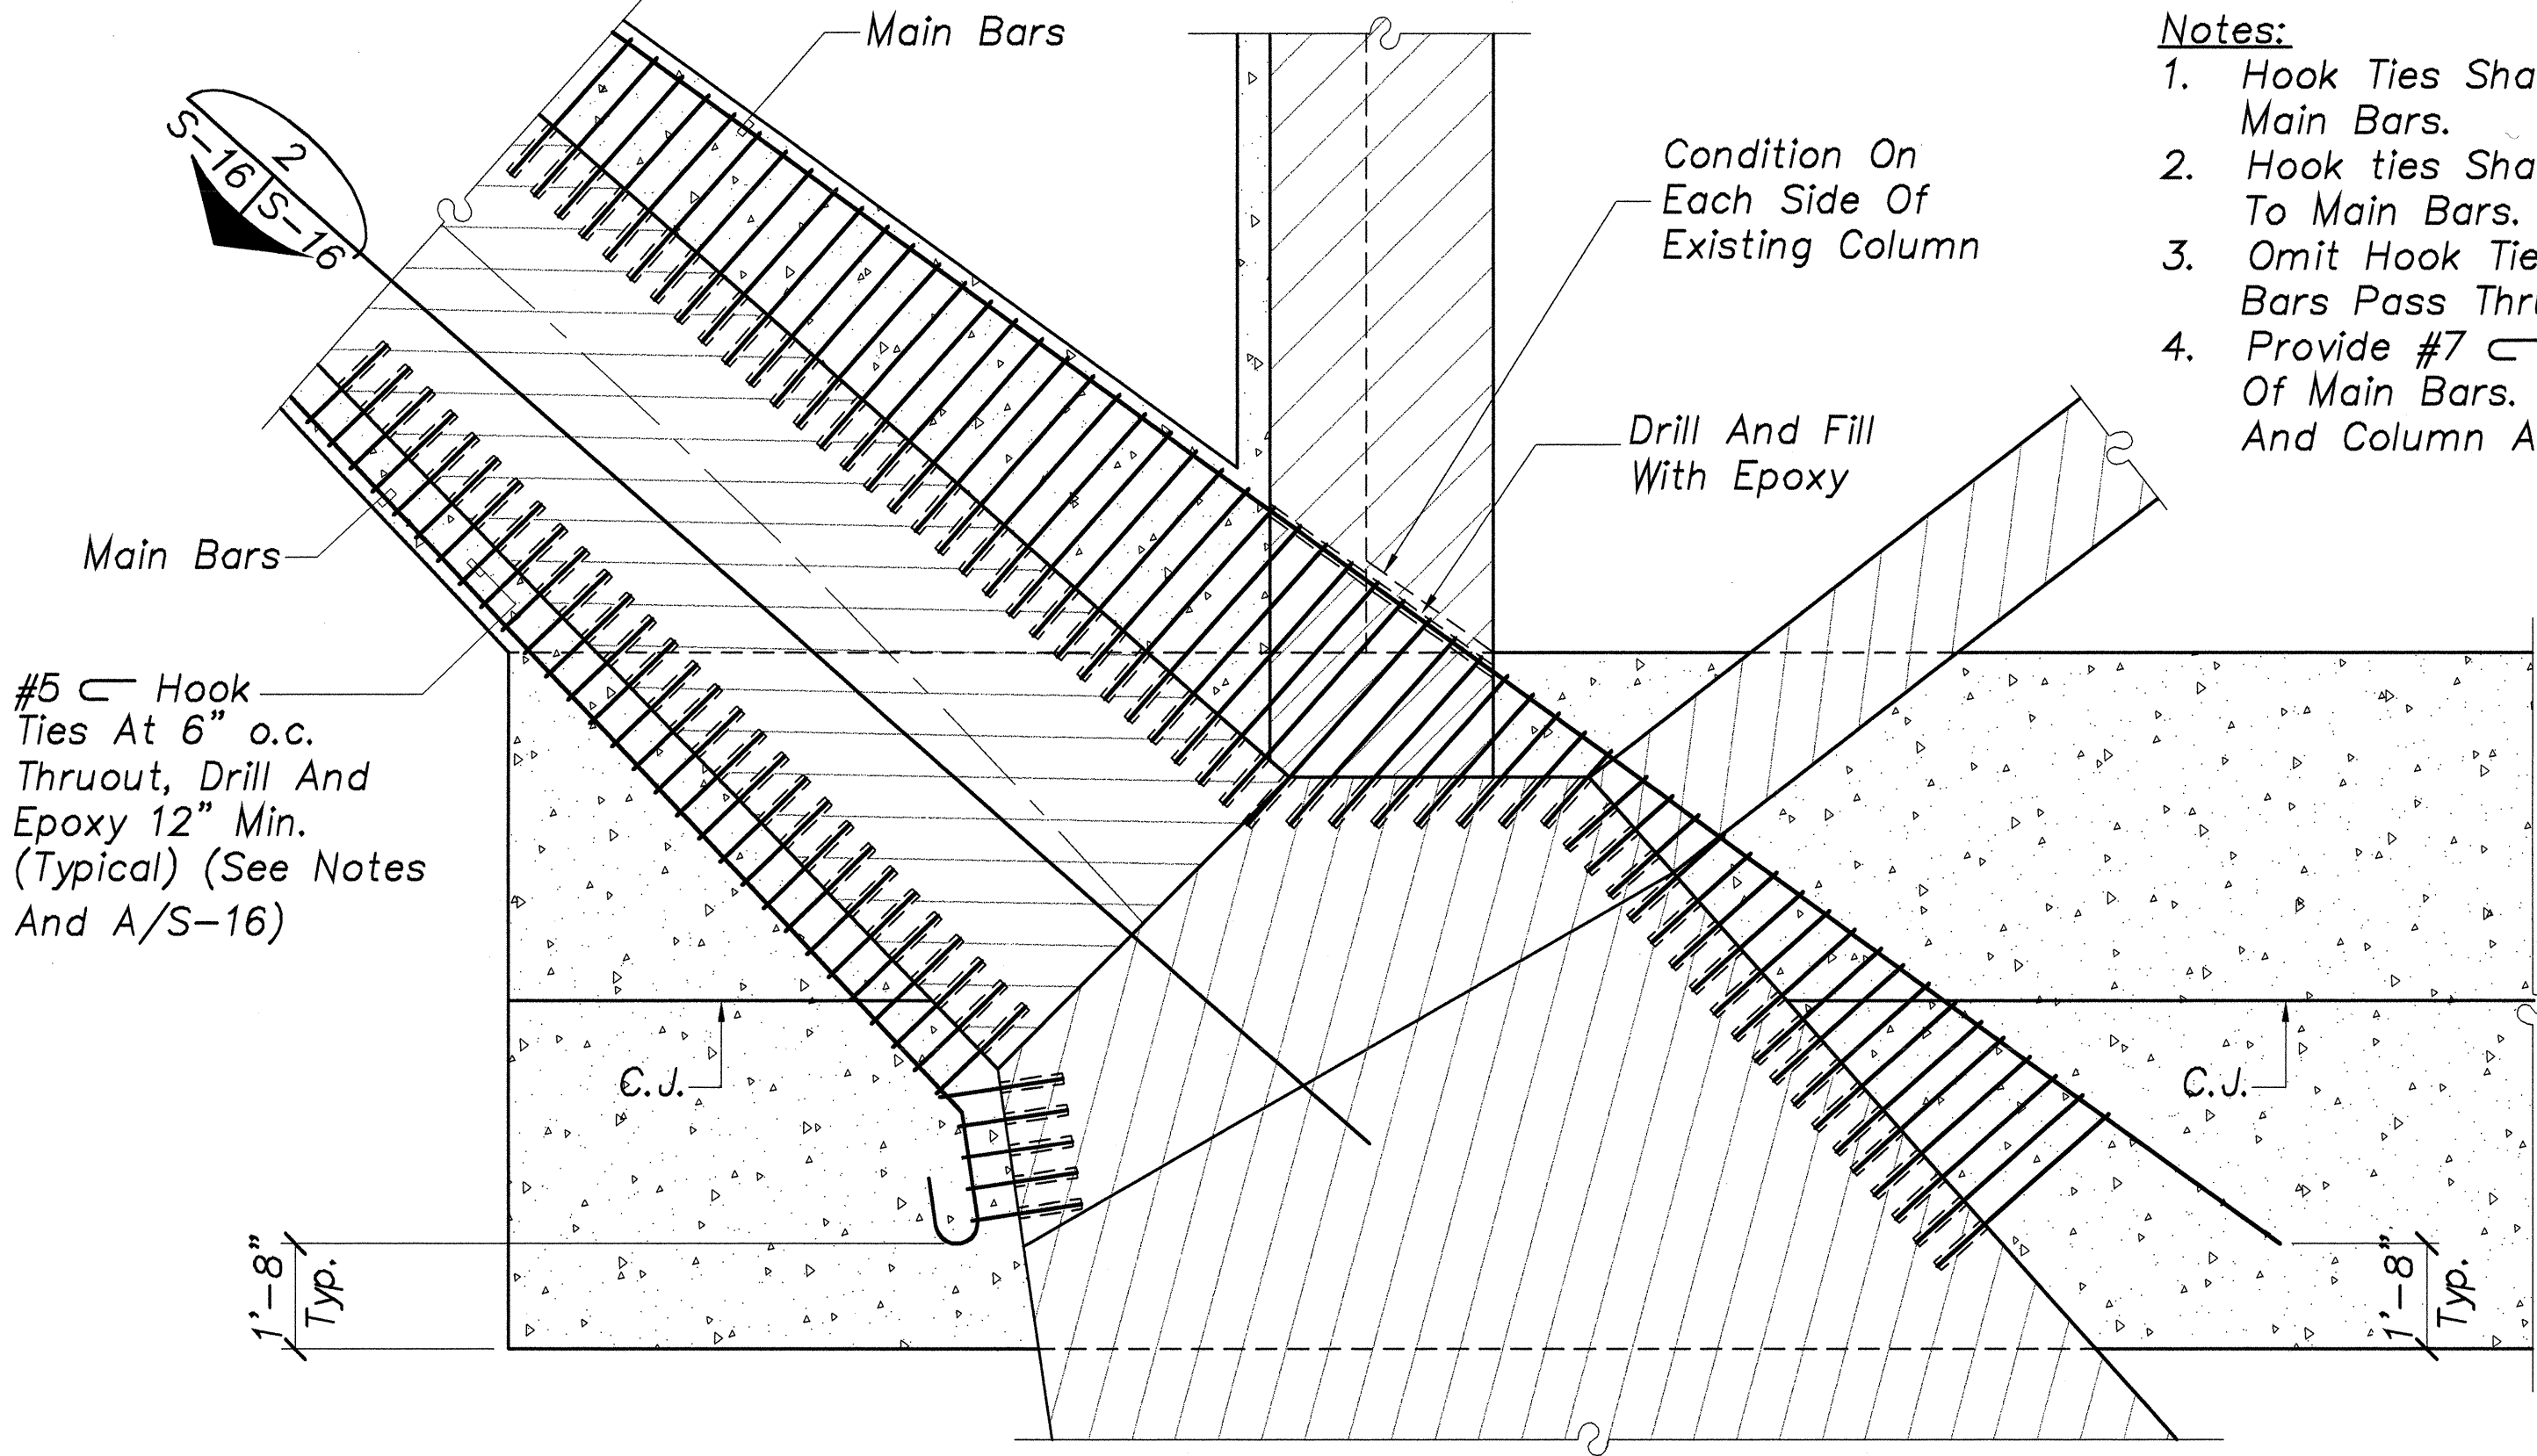



1
S-14|S-16 SECTION THRU EXISTING FOOTING
Scale: 3/8"=1'-0"

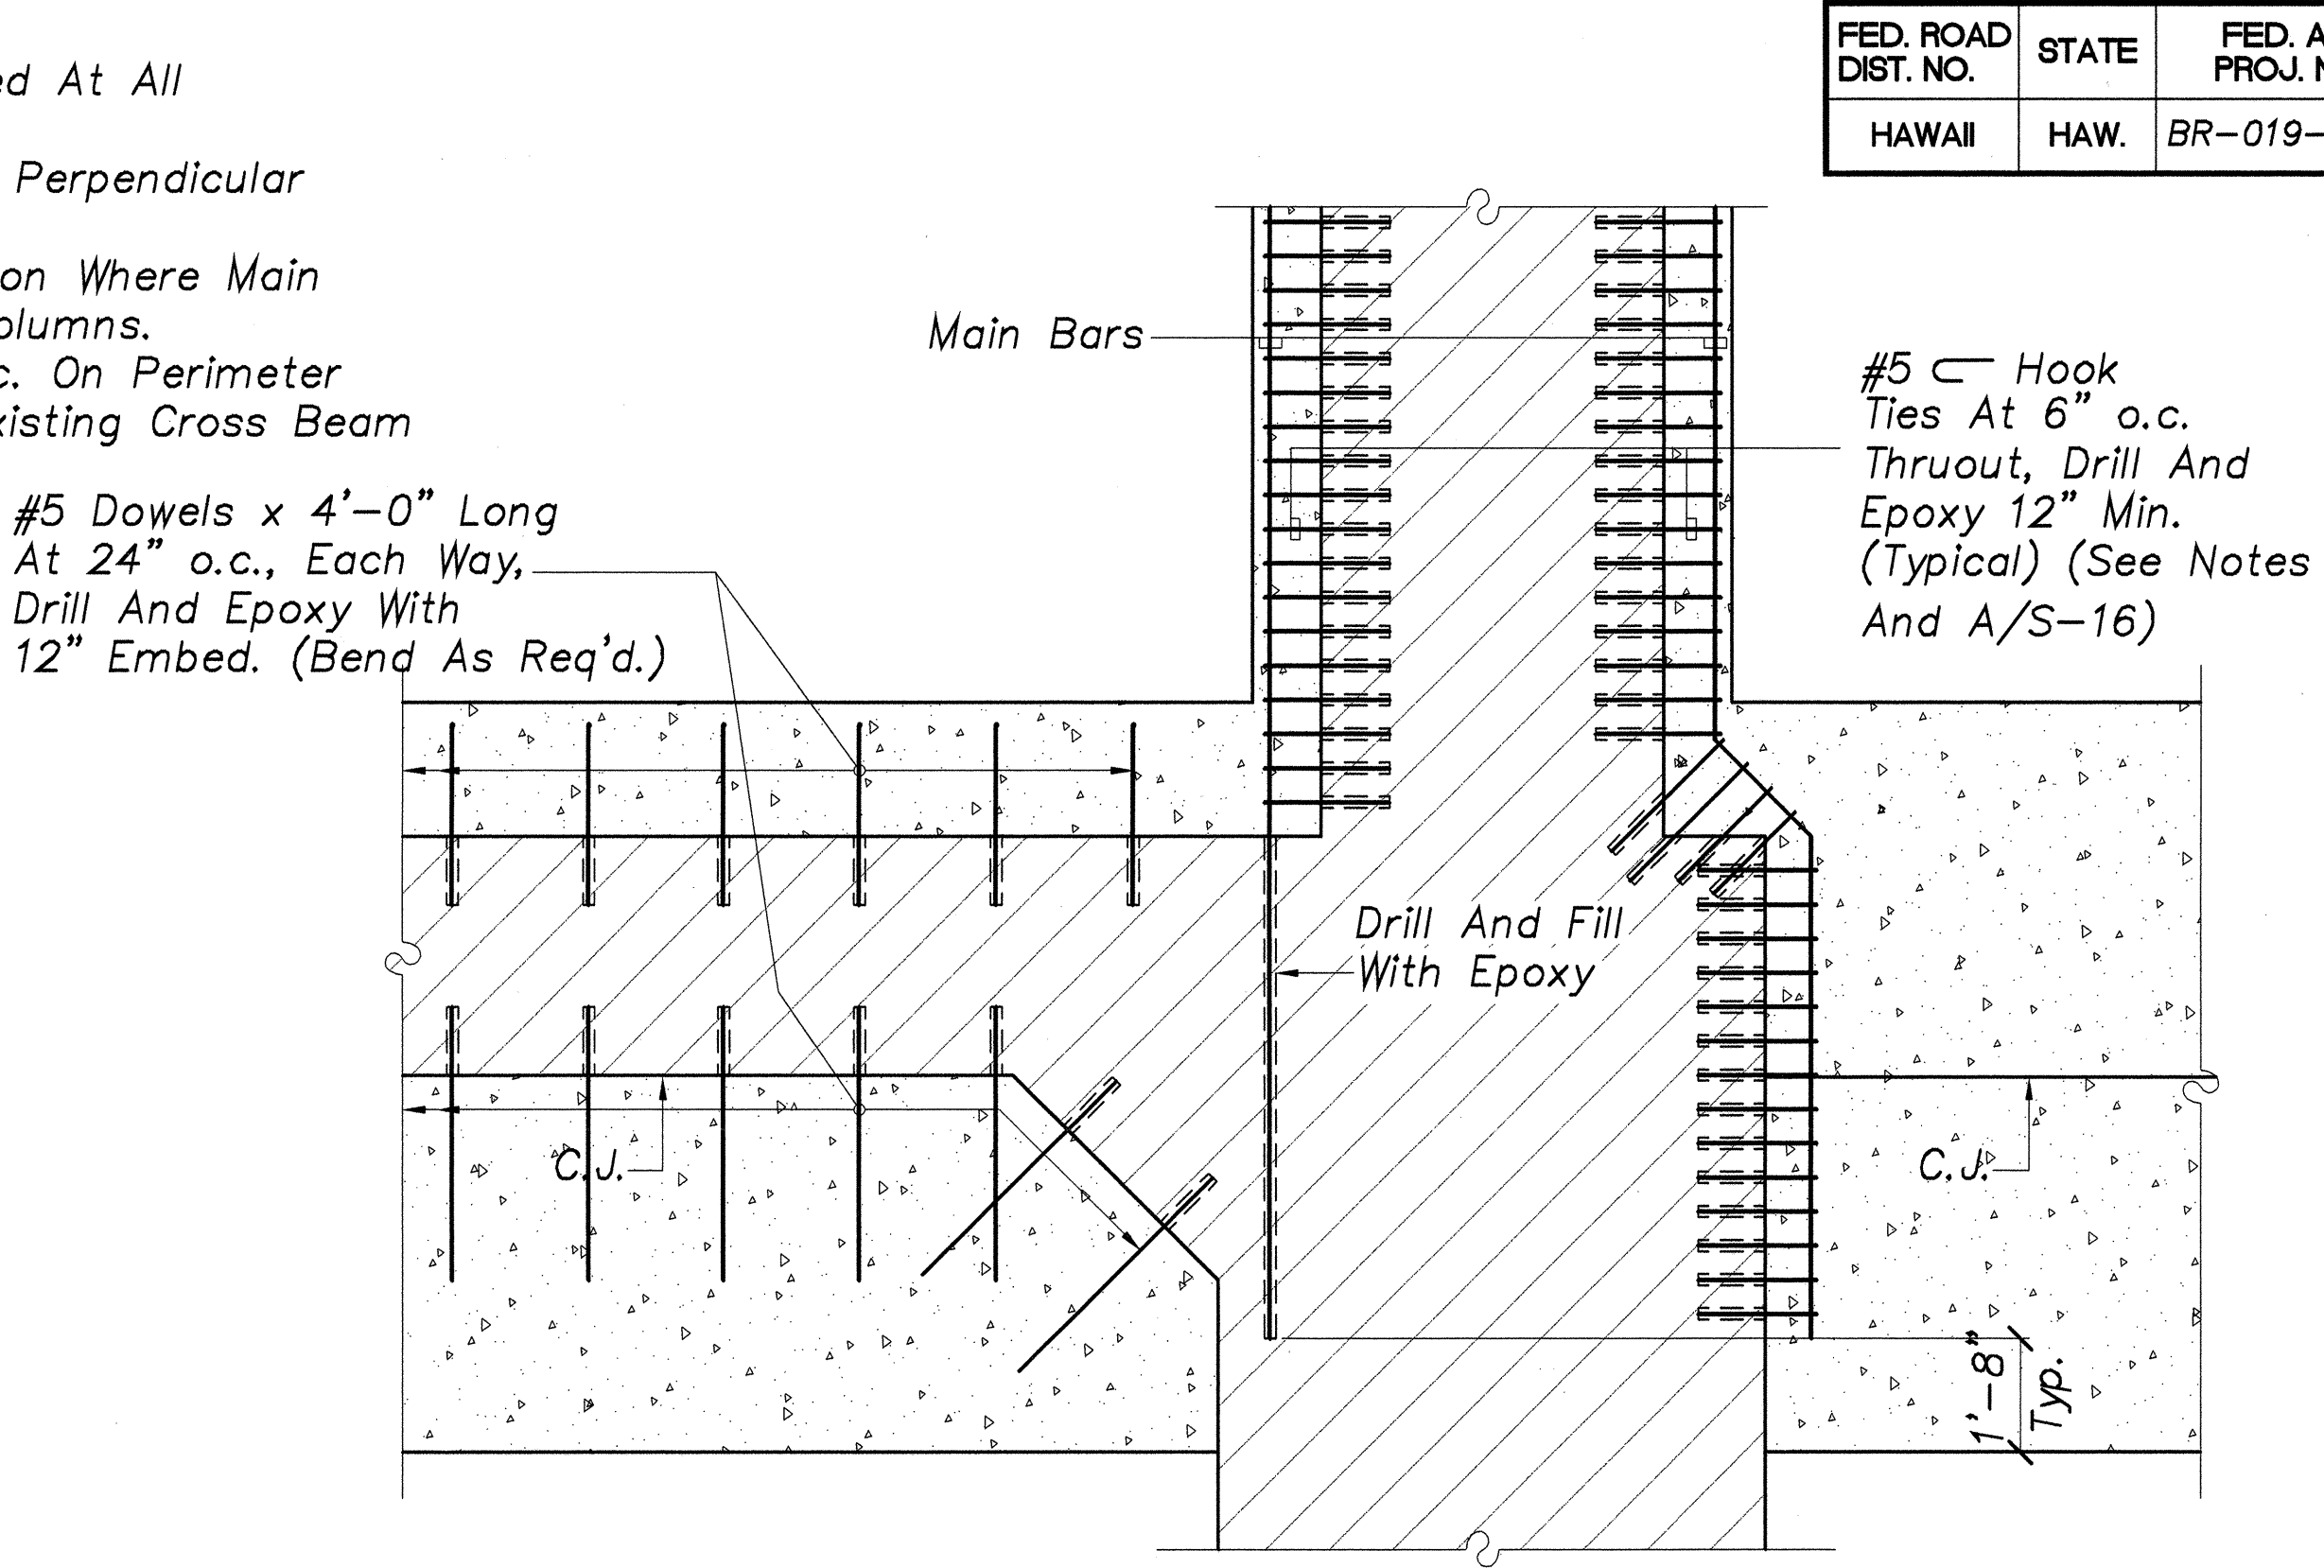

2
S-16|S-16 SECTION THRU EXISTING FOOTING
Scale: 3/8"=1'-0"

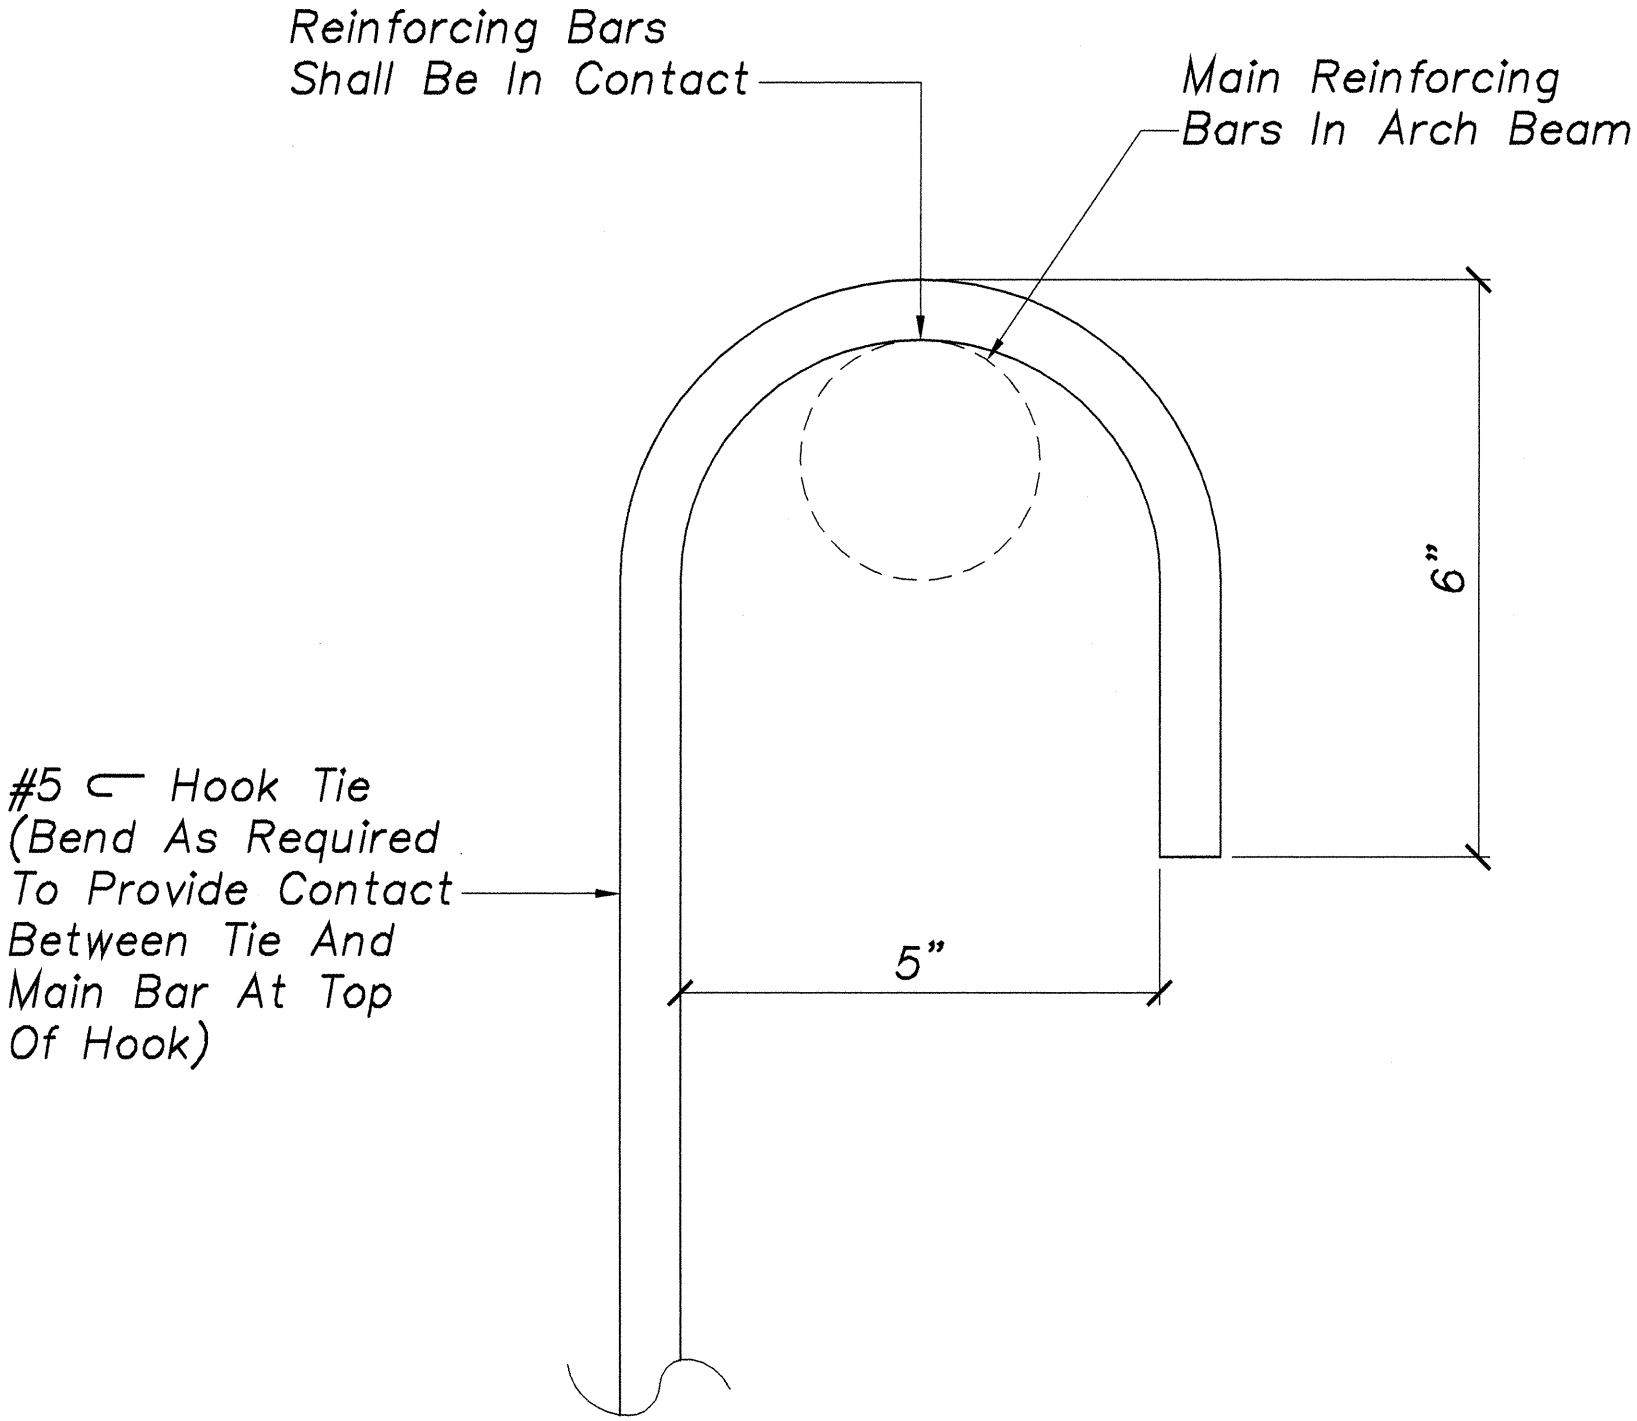

S-2, S-13, S-16, S-18, S-19|S-16 TYPICAL TIE DETAIL
Not To Scale

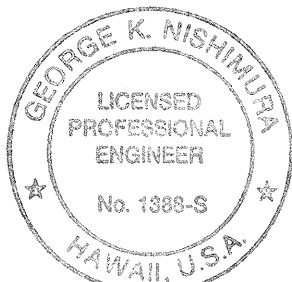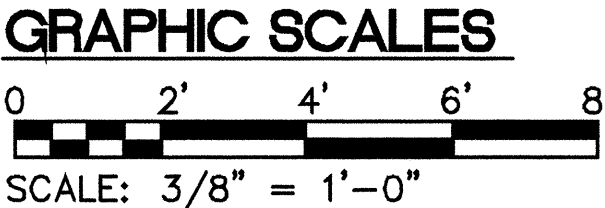


STATE OF HAWAII
DEPARTMENT OF TRANSPORTATION
HIGHWAYS DIVISION
FOUNDATION SECTIONS

HAWAII BELT ROAD
KUPAPAU LUA BRIDGE WIDENING
HAMAKUA DISTRICT
Federal Aid Project No. BR-019-2(38)


SCALE: AS NOTED
DATE: OCT., 2001
SHEET No. S-16 OF 30 SHEETS

SURVEY PLOTTED BY	DATE
DRAWN BY	
CHECKED BY	
ORIGINAL PLAN	
NOTE BOOK	
No.	


FED. ROAD DIST. NO.	STATE	FED. AID PROJ. NO.	FISCAL YEAR	SHEET NO.	TOTAL SHEETS
HAWAII	HAW.	BR-019-2(38)	2002	61	73

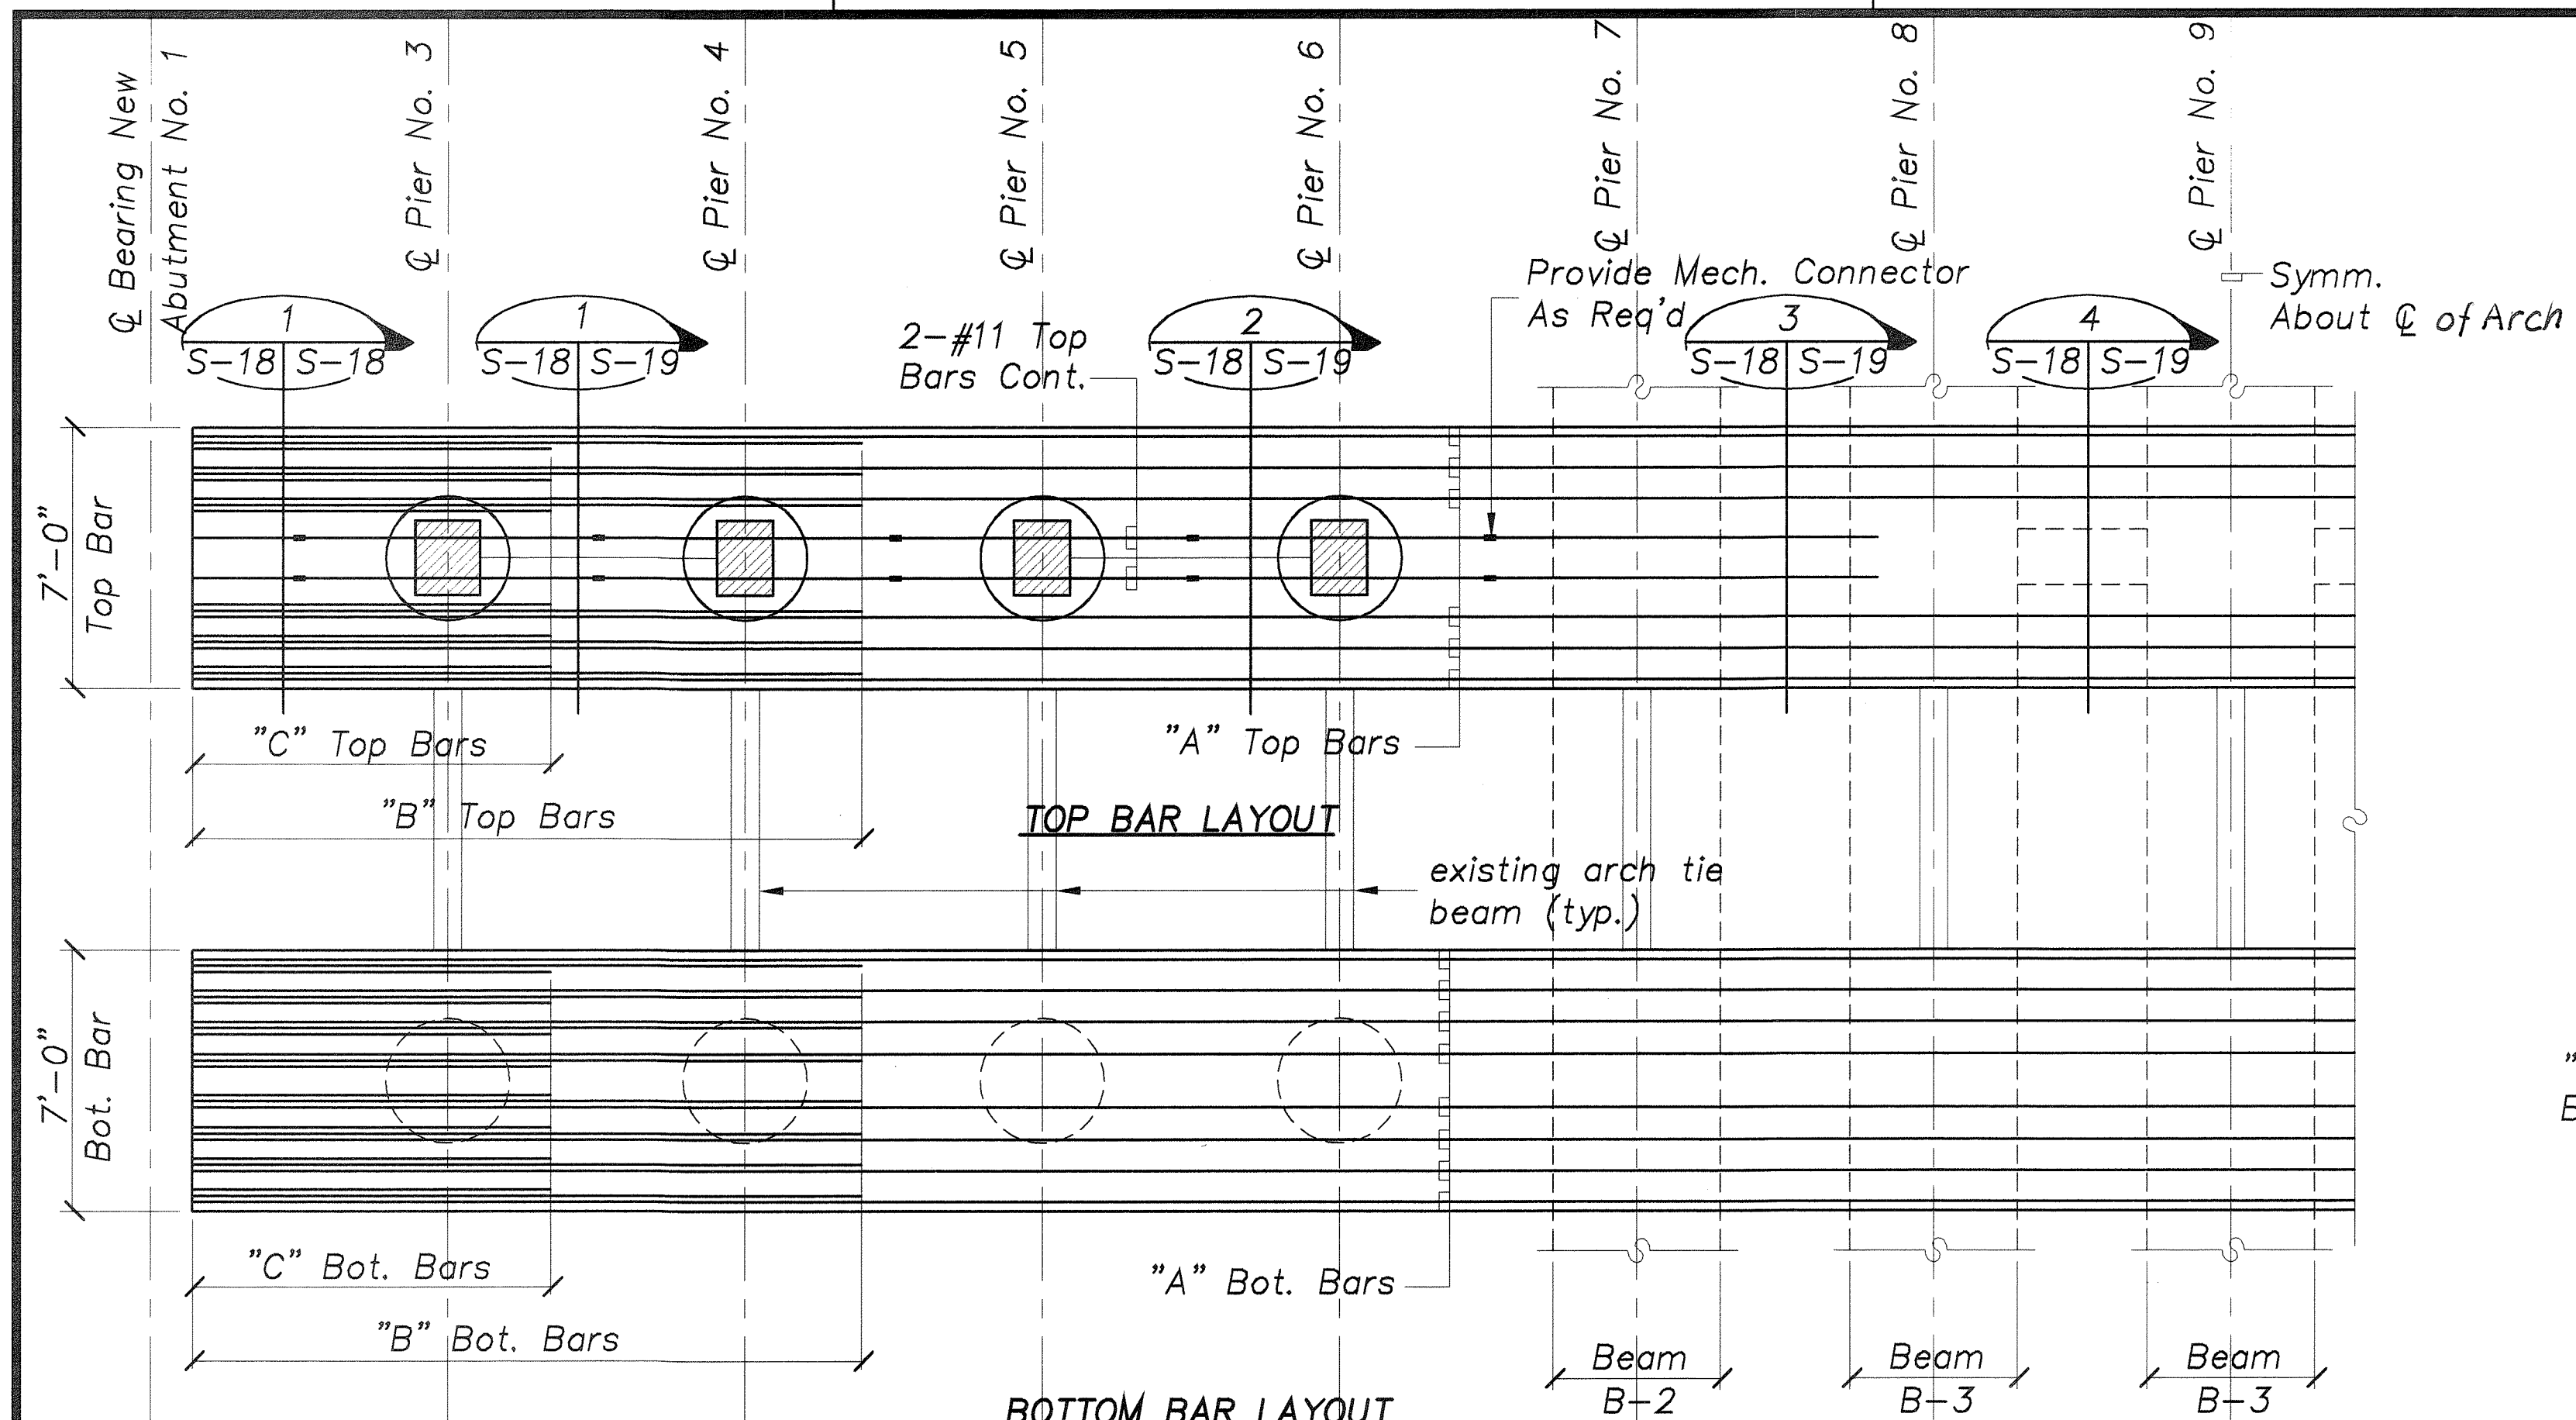


ARCH BEAM PLAN
Not To Scale

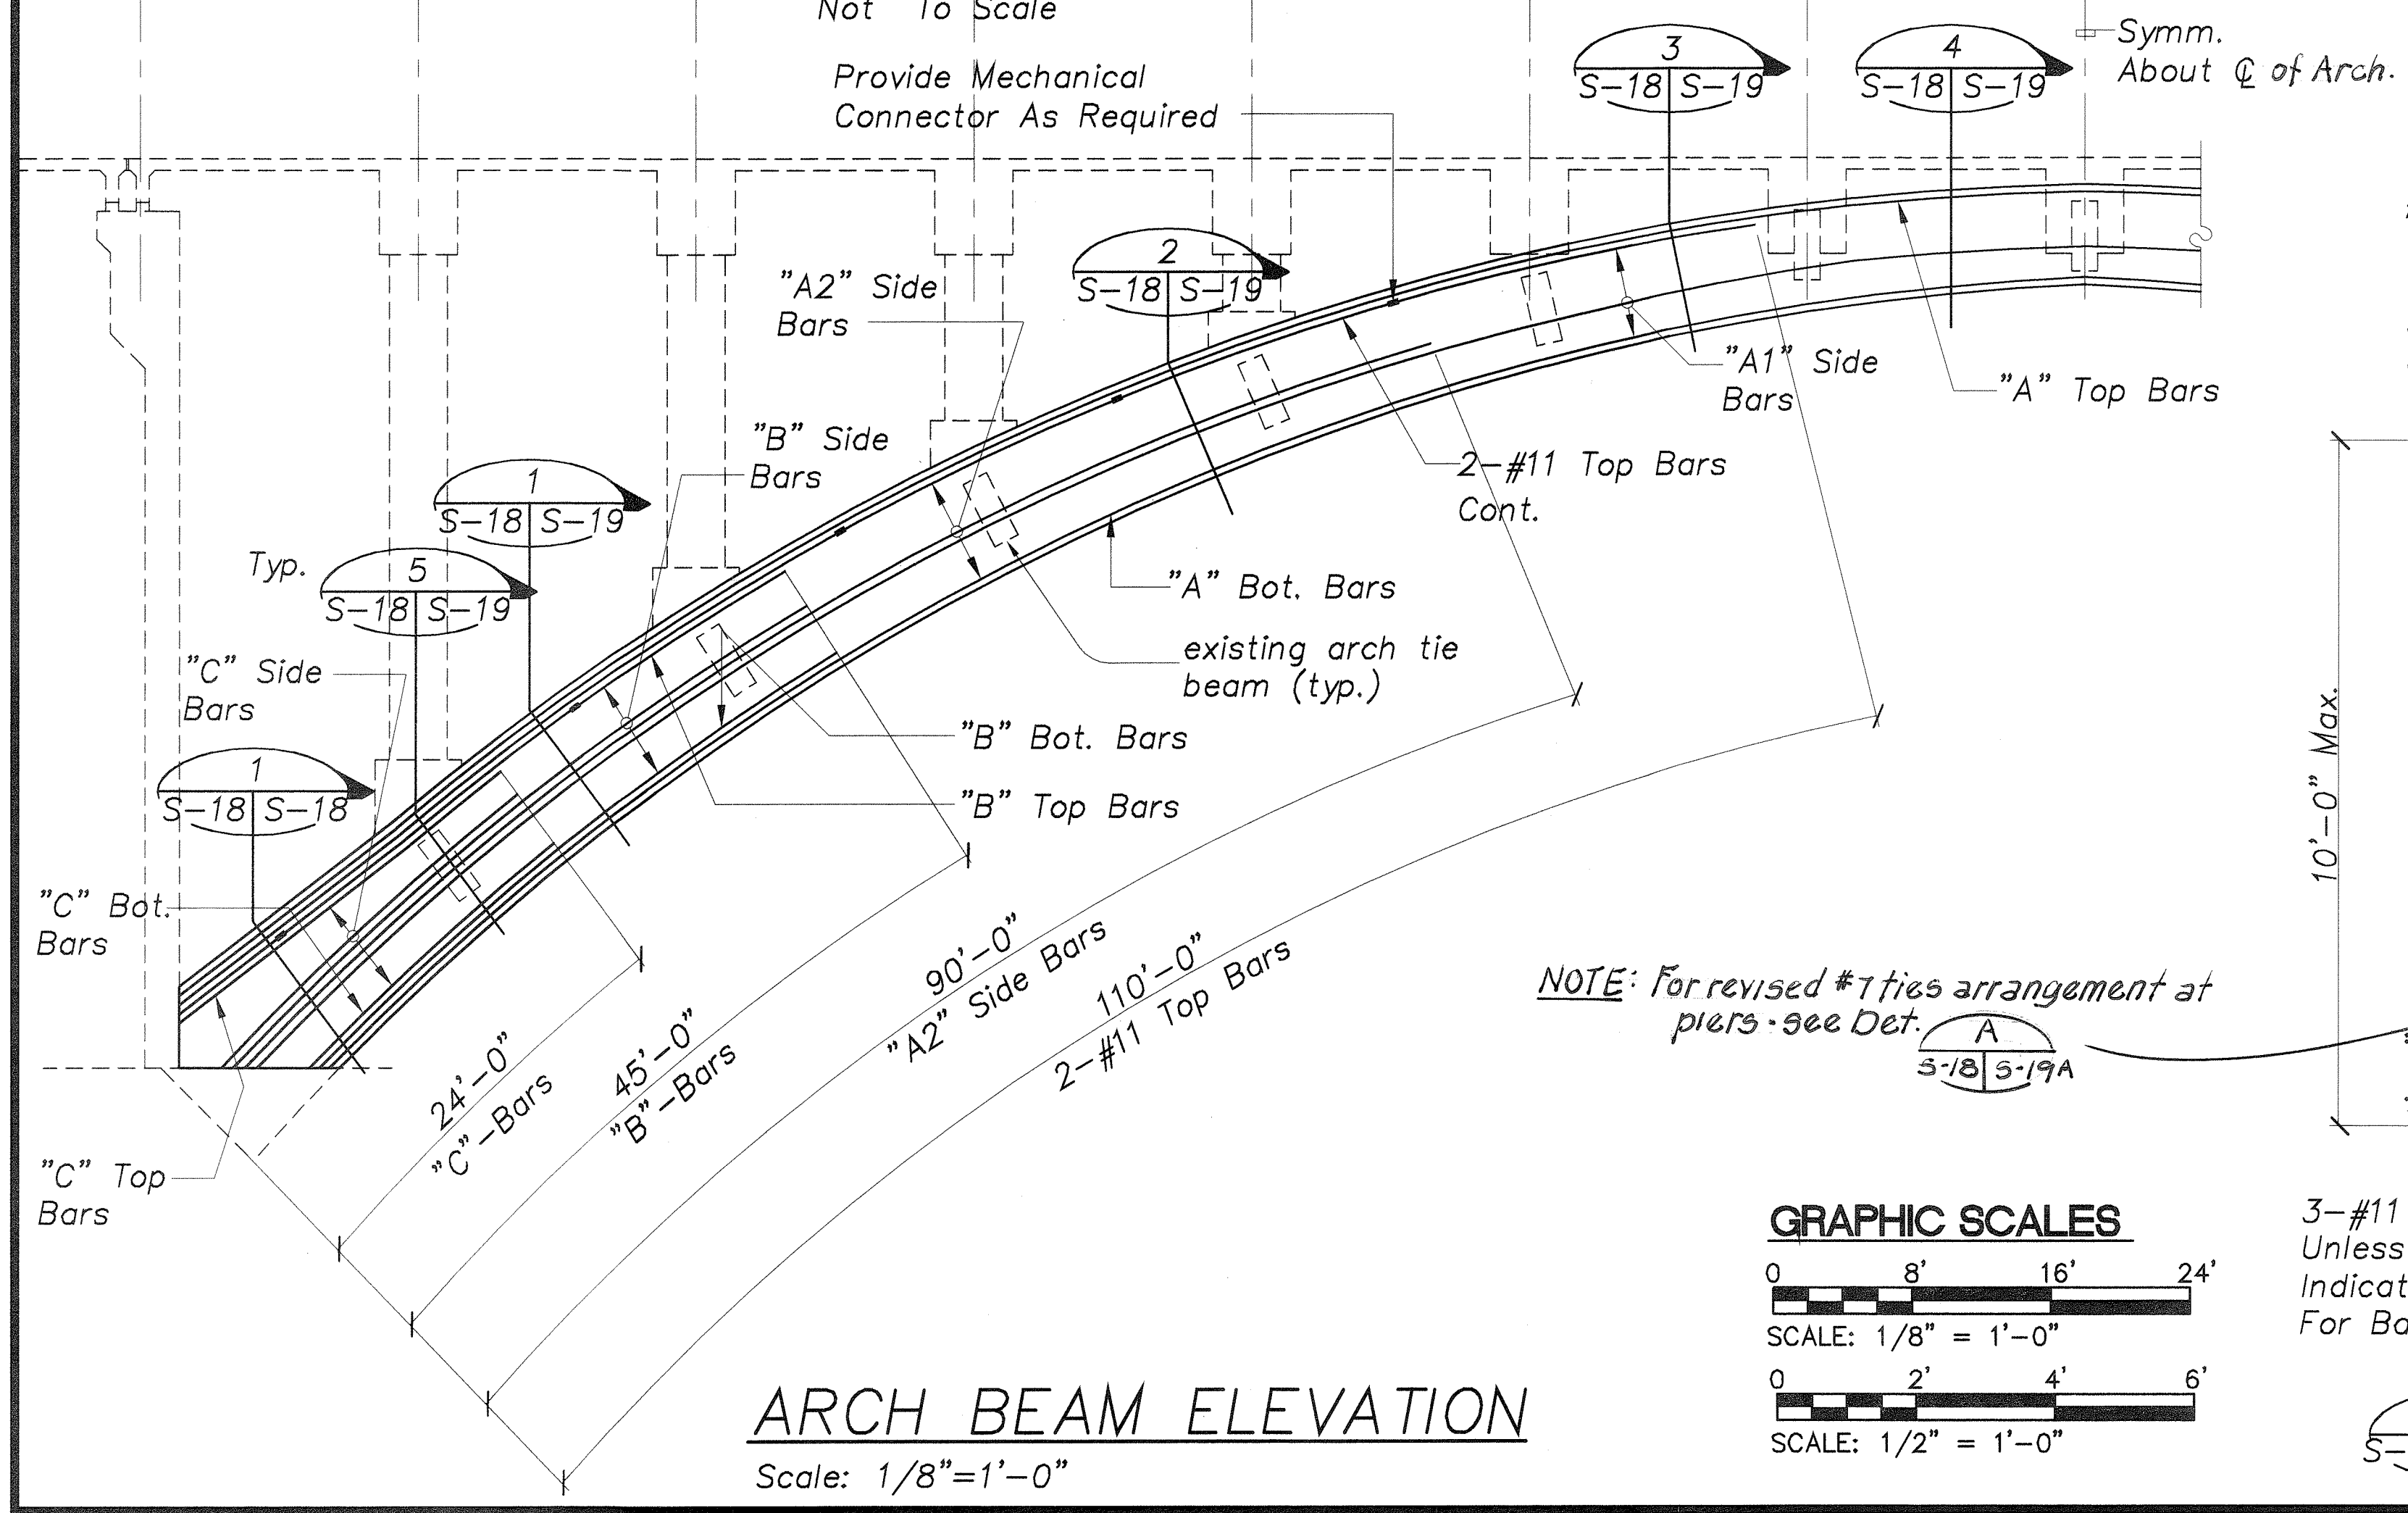


ARCH BEAM ELEVATION
Scale: 1/8"=1'-0"

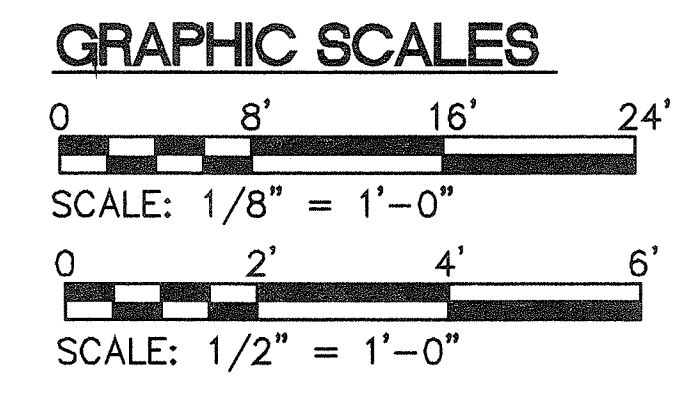


NOTE: For revised #7 ties arrangement at piers - see Det. A

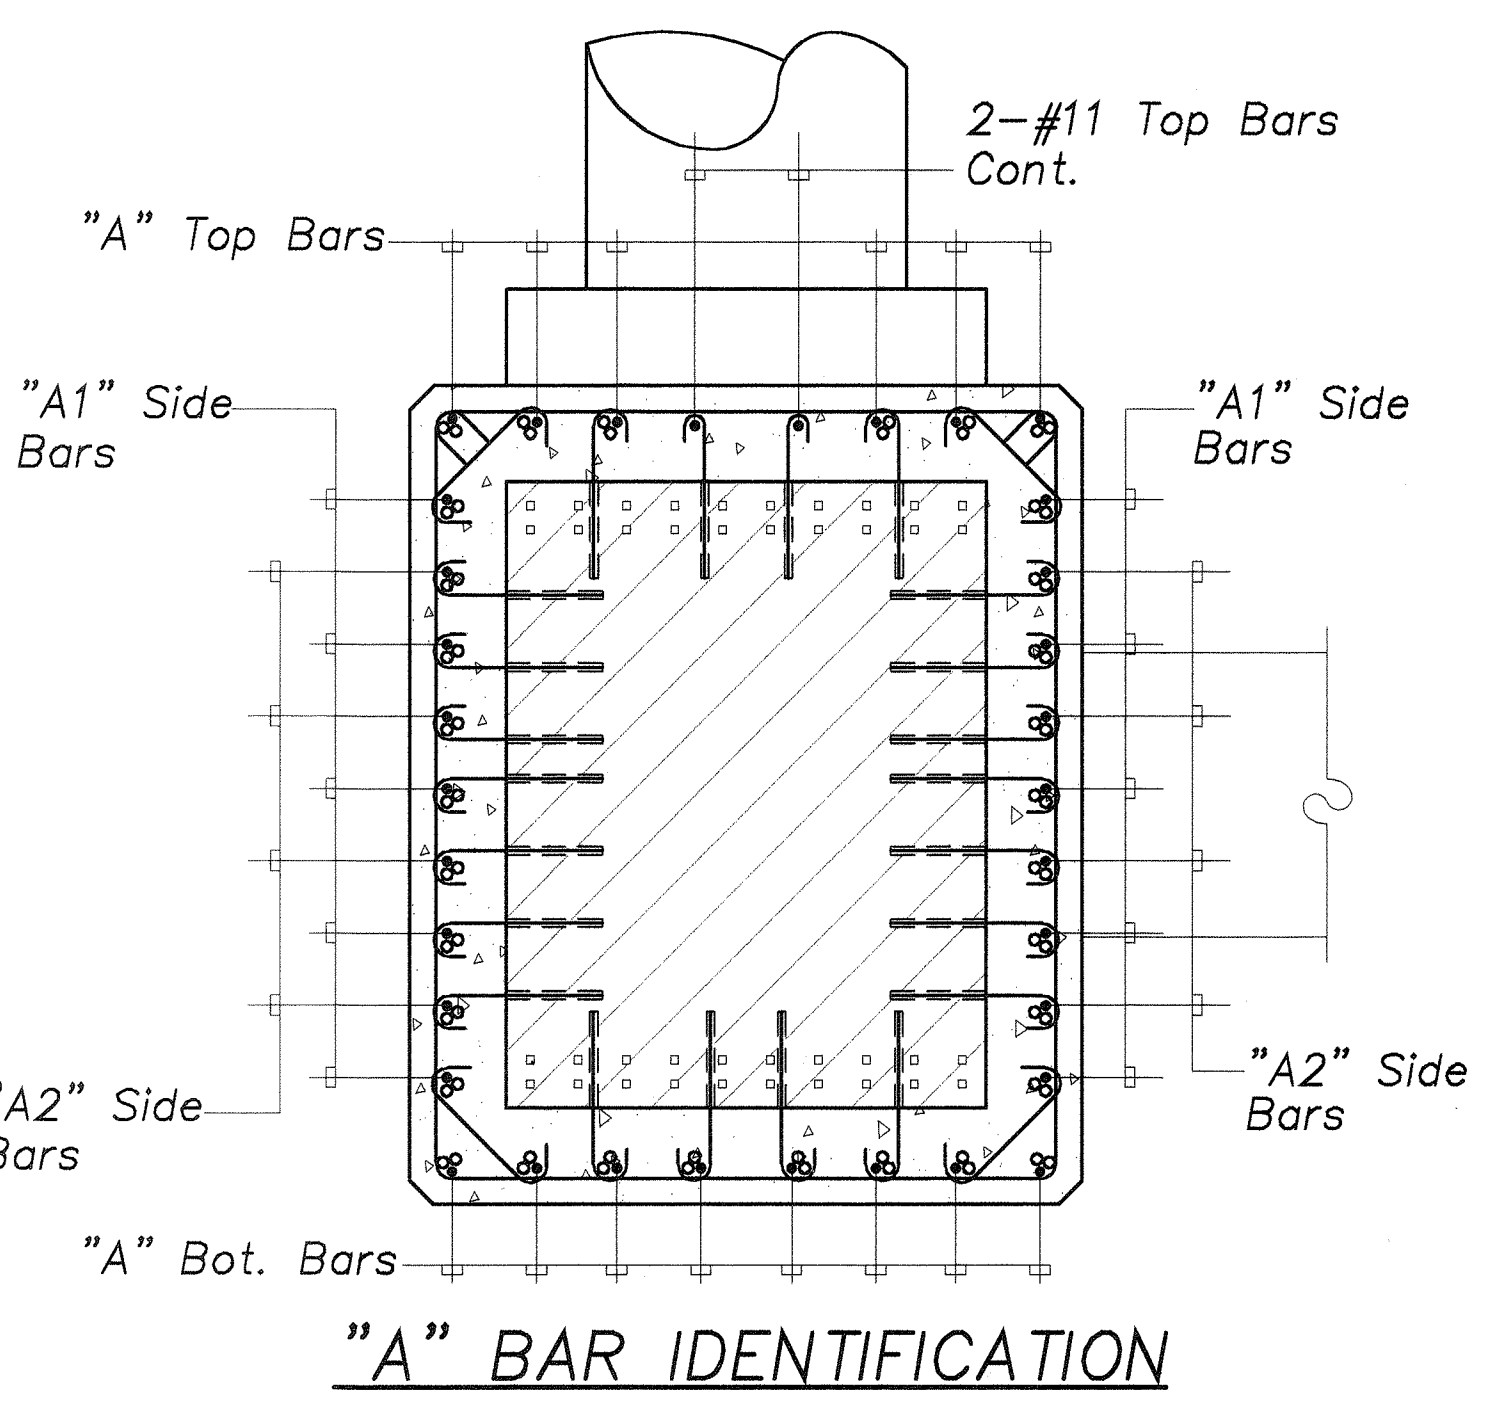


"A" BAR IDENTIFICATION

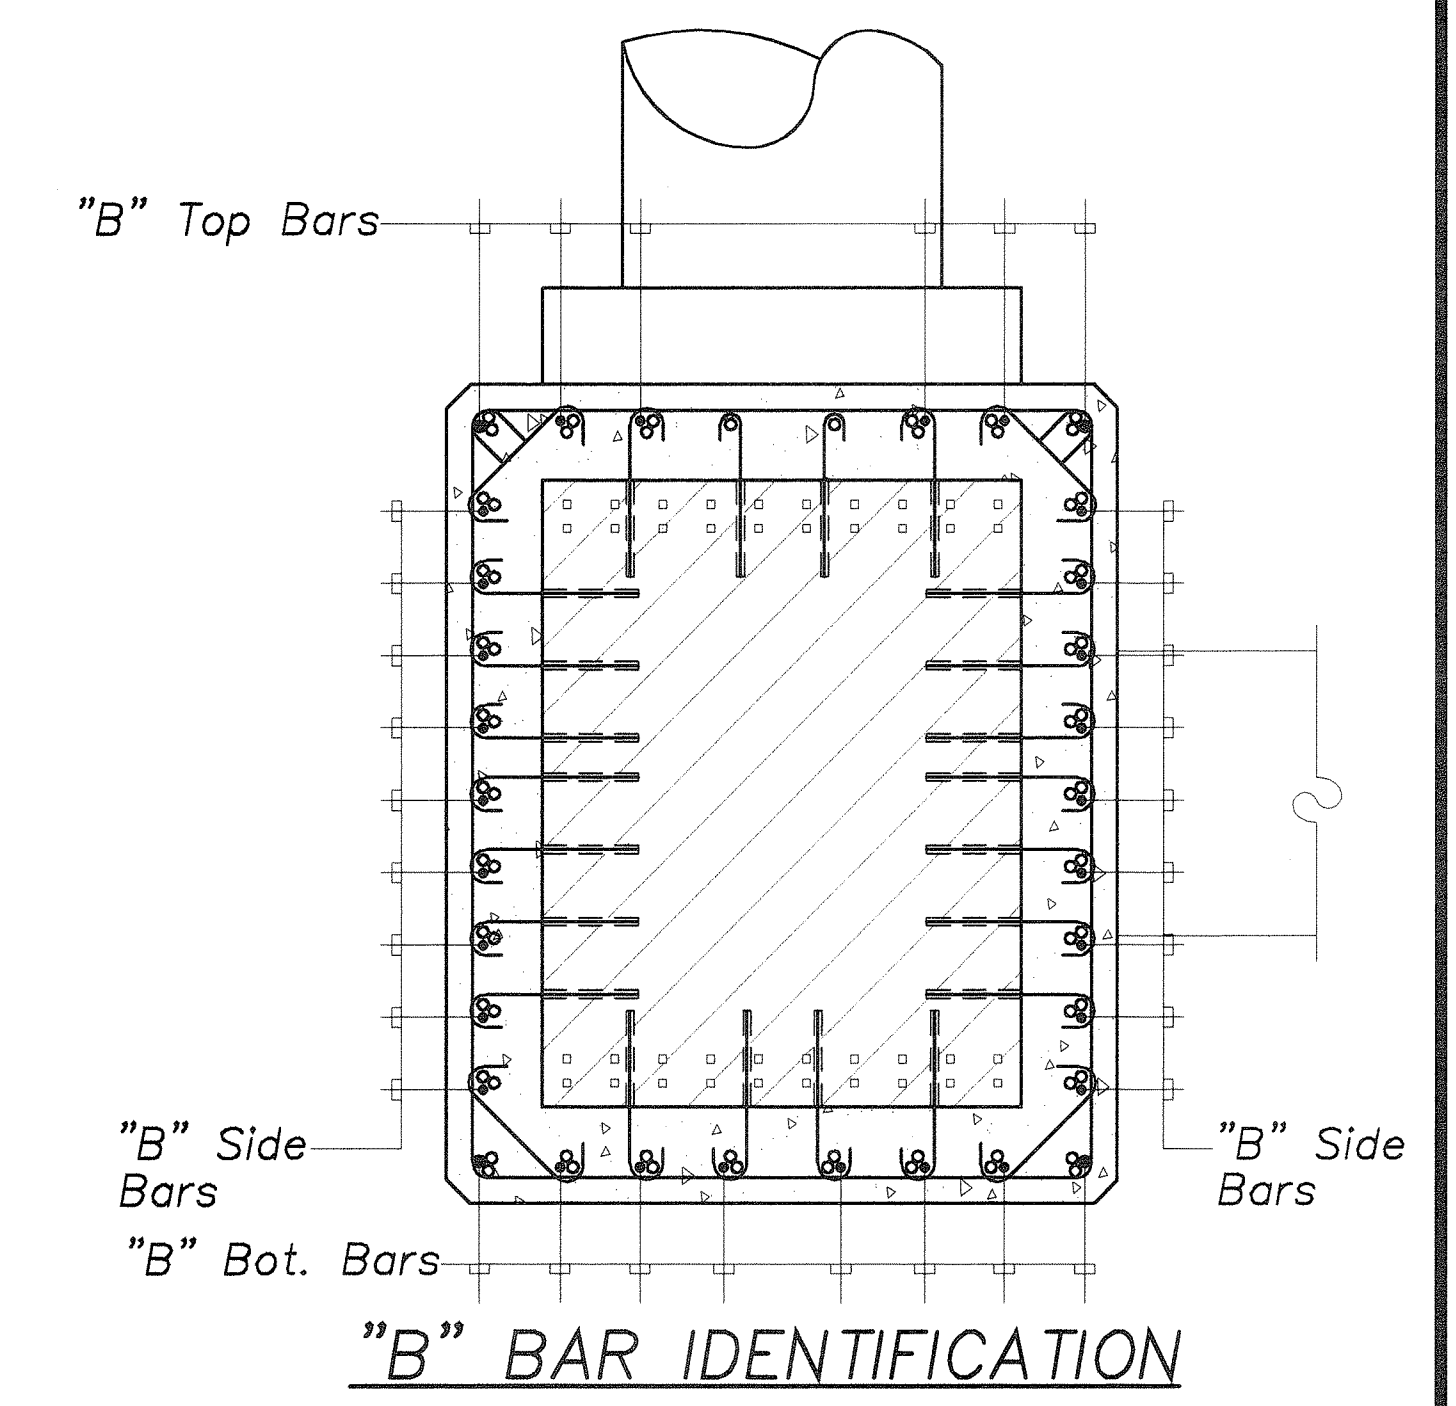

"B" BAR IDENTIFICATION

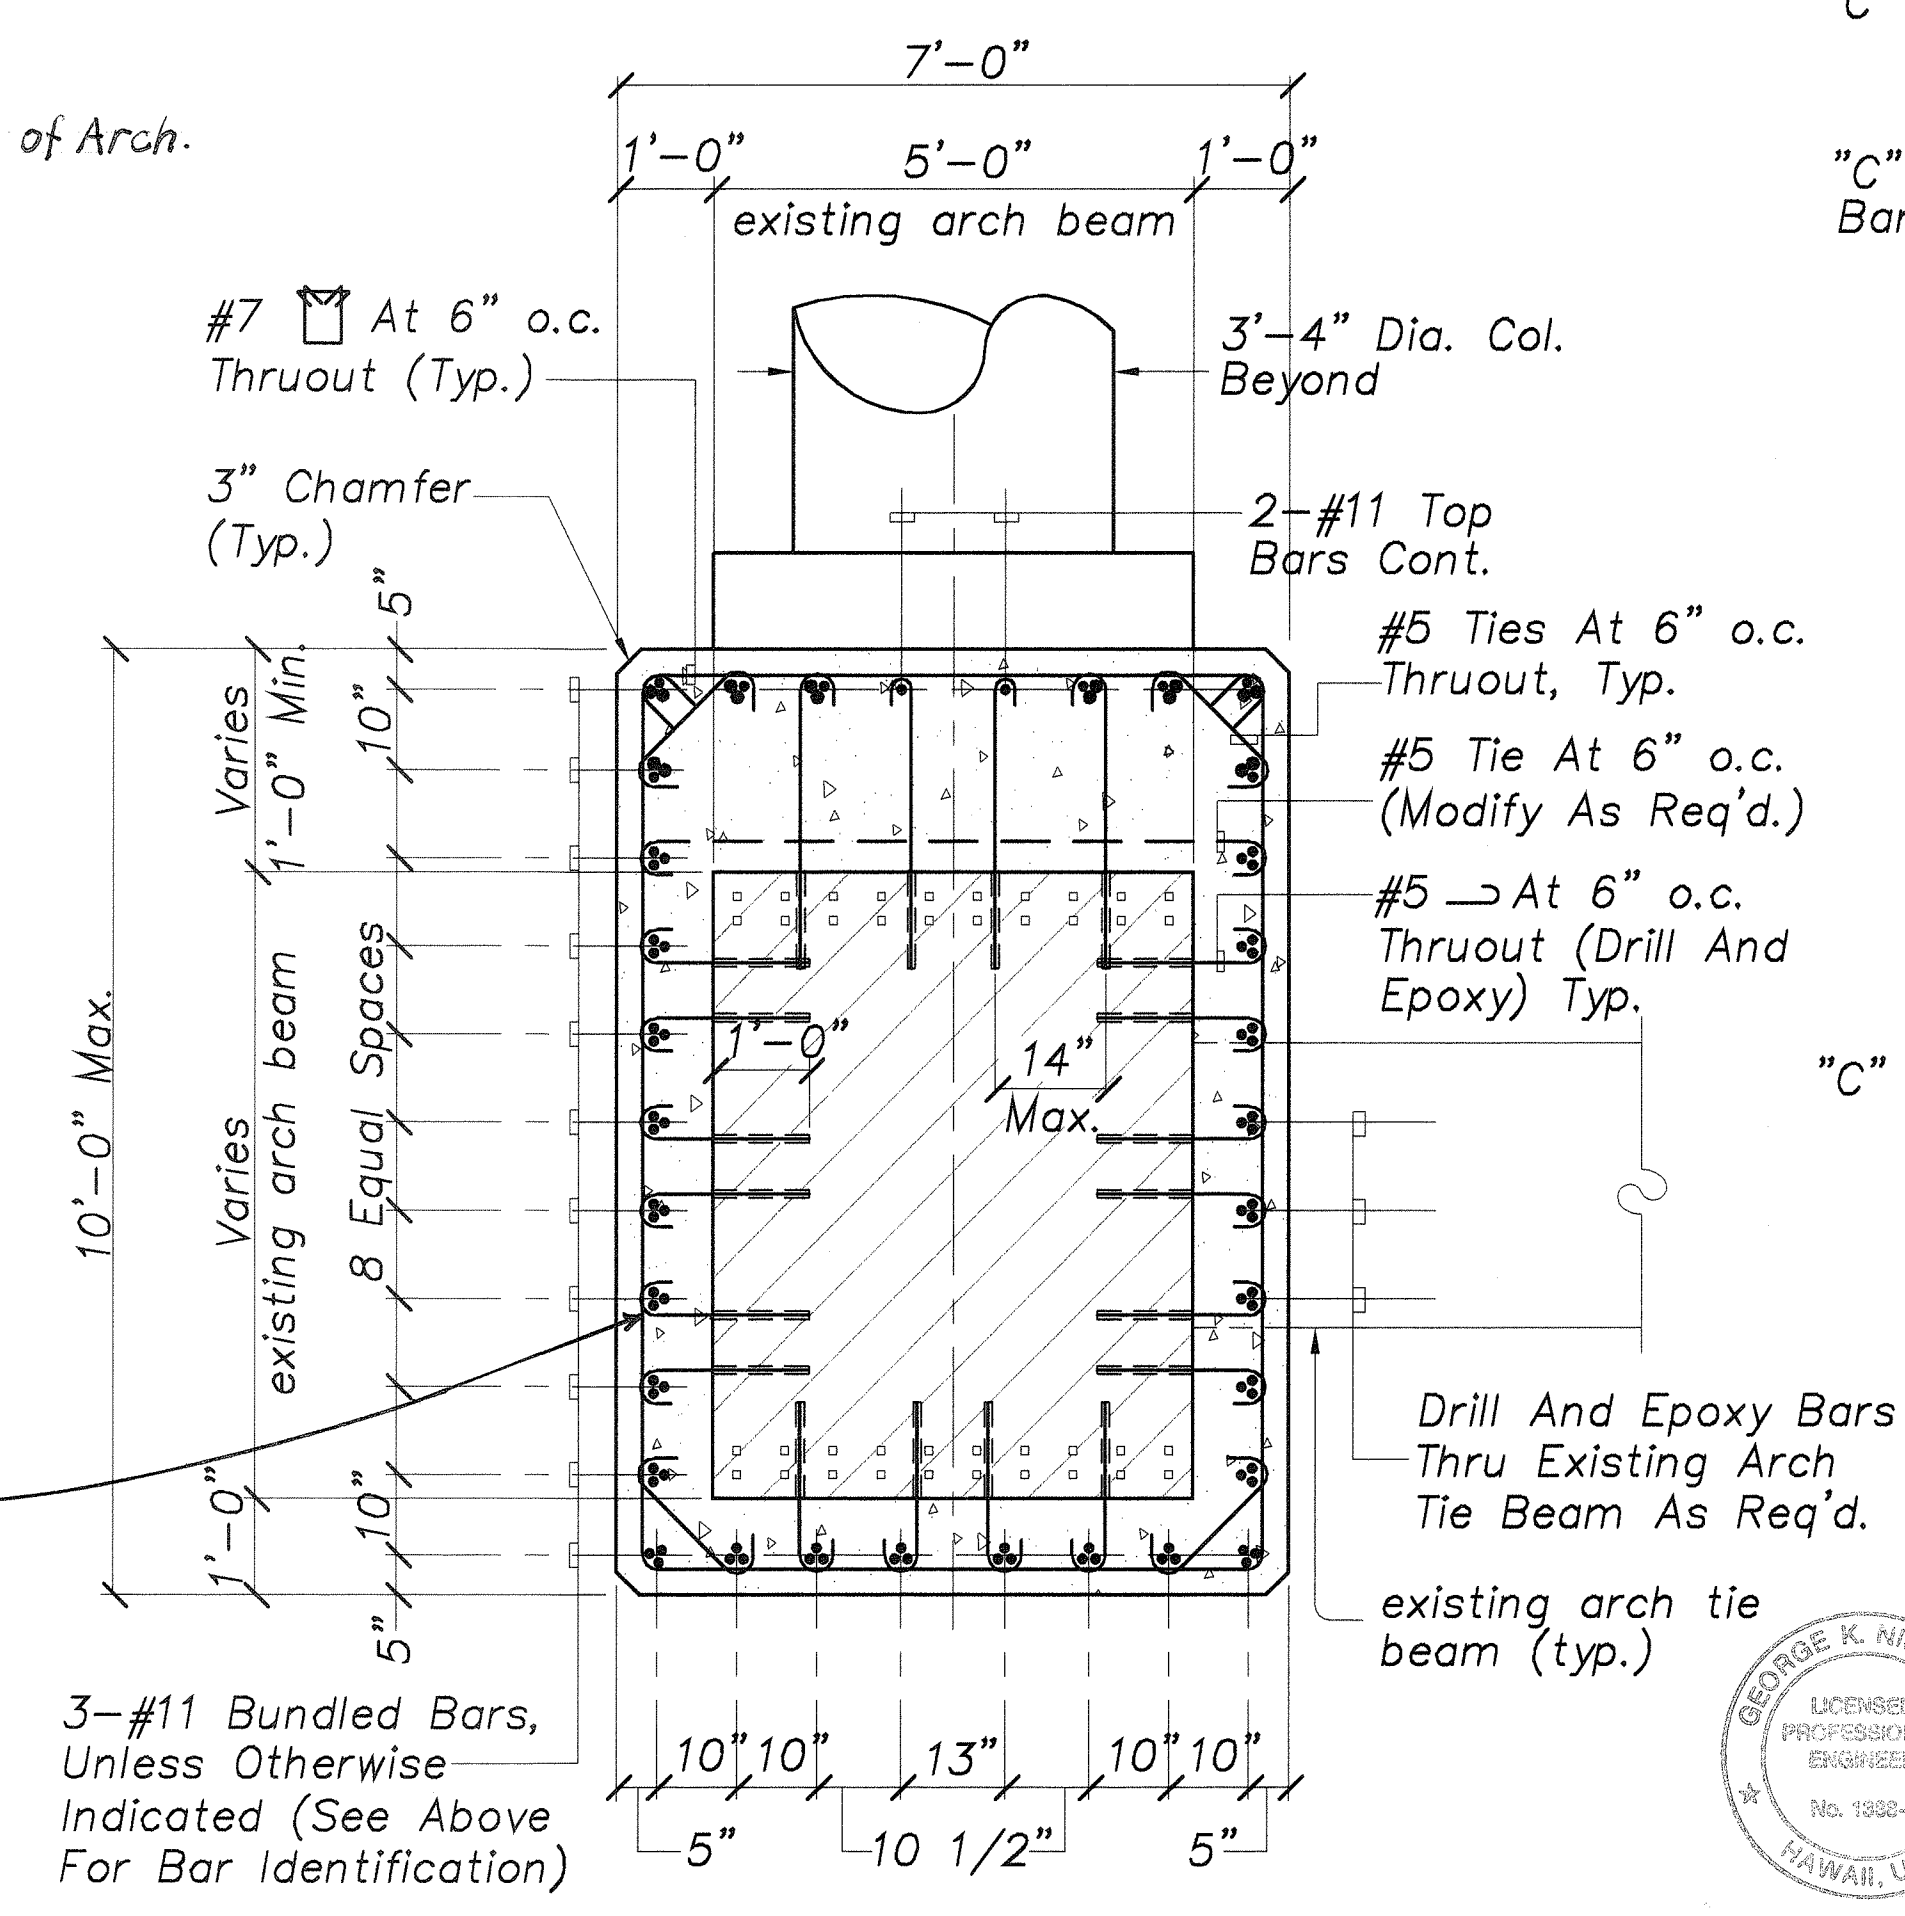

ARCH BEAM SECTION
Scale: 1/2"=1'-0"

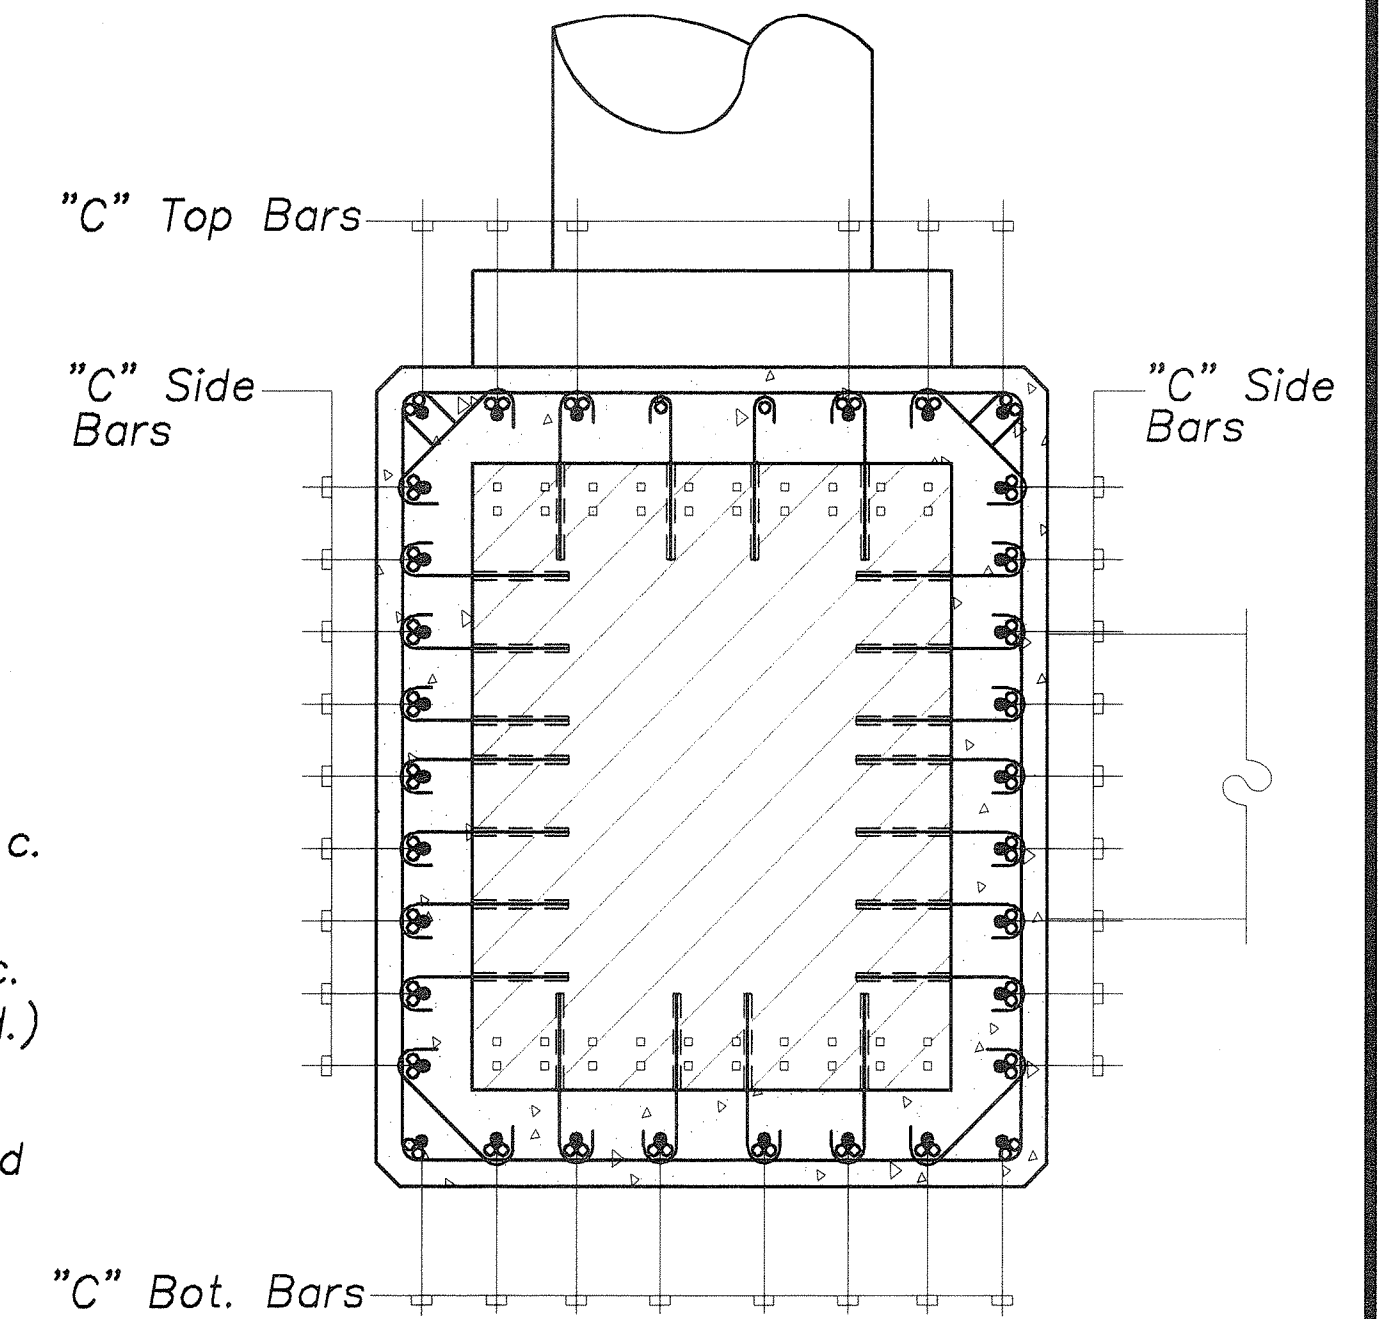

"C" BAR IDENTIFICATION

Note: Refer To "Typical Tie Detail" A/S-16 For Clarification of Tie Placement


THIS WORK WAS PREPARED BY
MECHANICAL ENGINEER
No. 1382-S
HAWAII, U.S.A.

STATE OF HAWAII
DEPARTMENT OF TRANSPORTATION
HIGHWAYS DIVISION
ARCH BEAM PLAN, ARCH BEAM
ELEVATION, ARCH BEAM SECTIONS

HAWAII BELT ROAD
KUPAPAUOLA BRIDGE WIDENING
HAMAKUA DISTRICT
Federal Aid Project No. BR-019-2(38)
SCALE: AS NOTED DATE: OCT., 2001
SHEET No. S-18 OF 30 SHEETS


SURVEY PLOTTED BY: _____
DATE: _____
DRAWN BY: _____
DESIGNED BY: _____
NOTE BOOK: _____
CHECKED BY: _____
No. _____

FED. ROAD DIST. NO.	STATE	FED. AID PROJ. NO.	FISCAL YEAR	SHEET NO.	TOTAL SHEETS
HAWAII	HAW.	BR-019-2(38)	2002	62	73

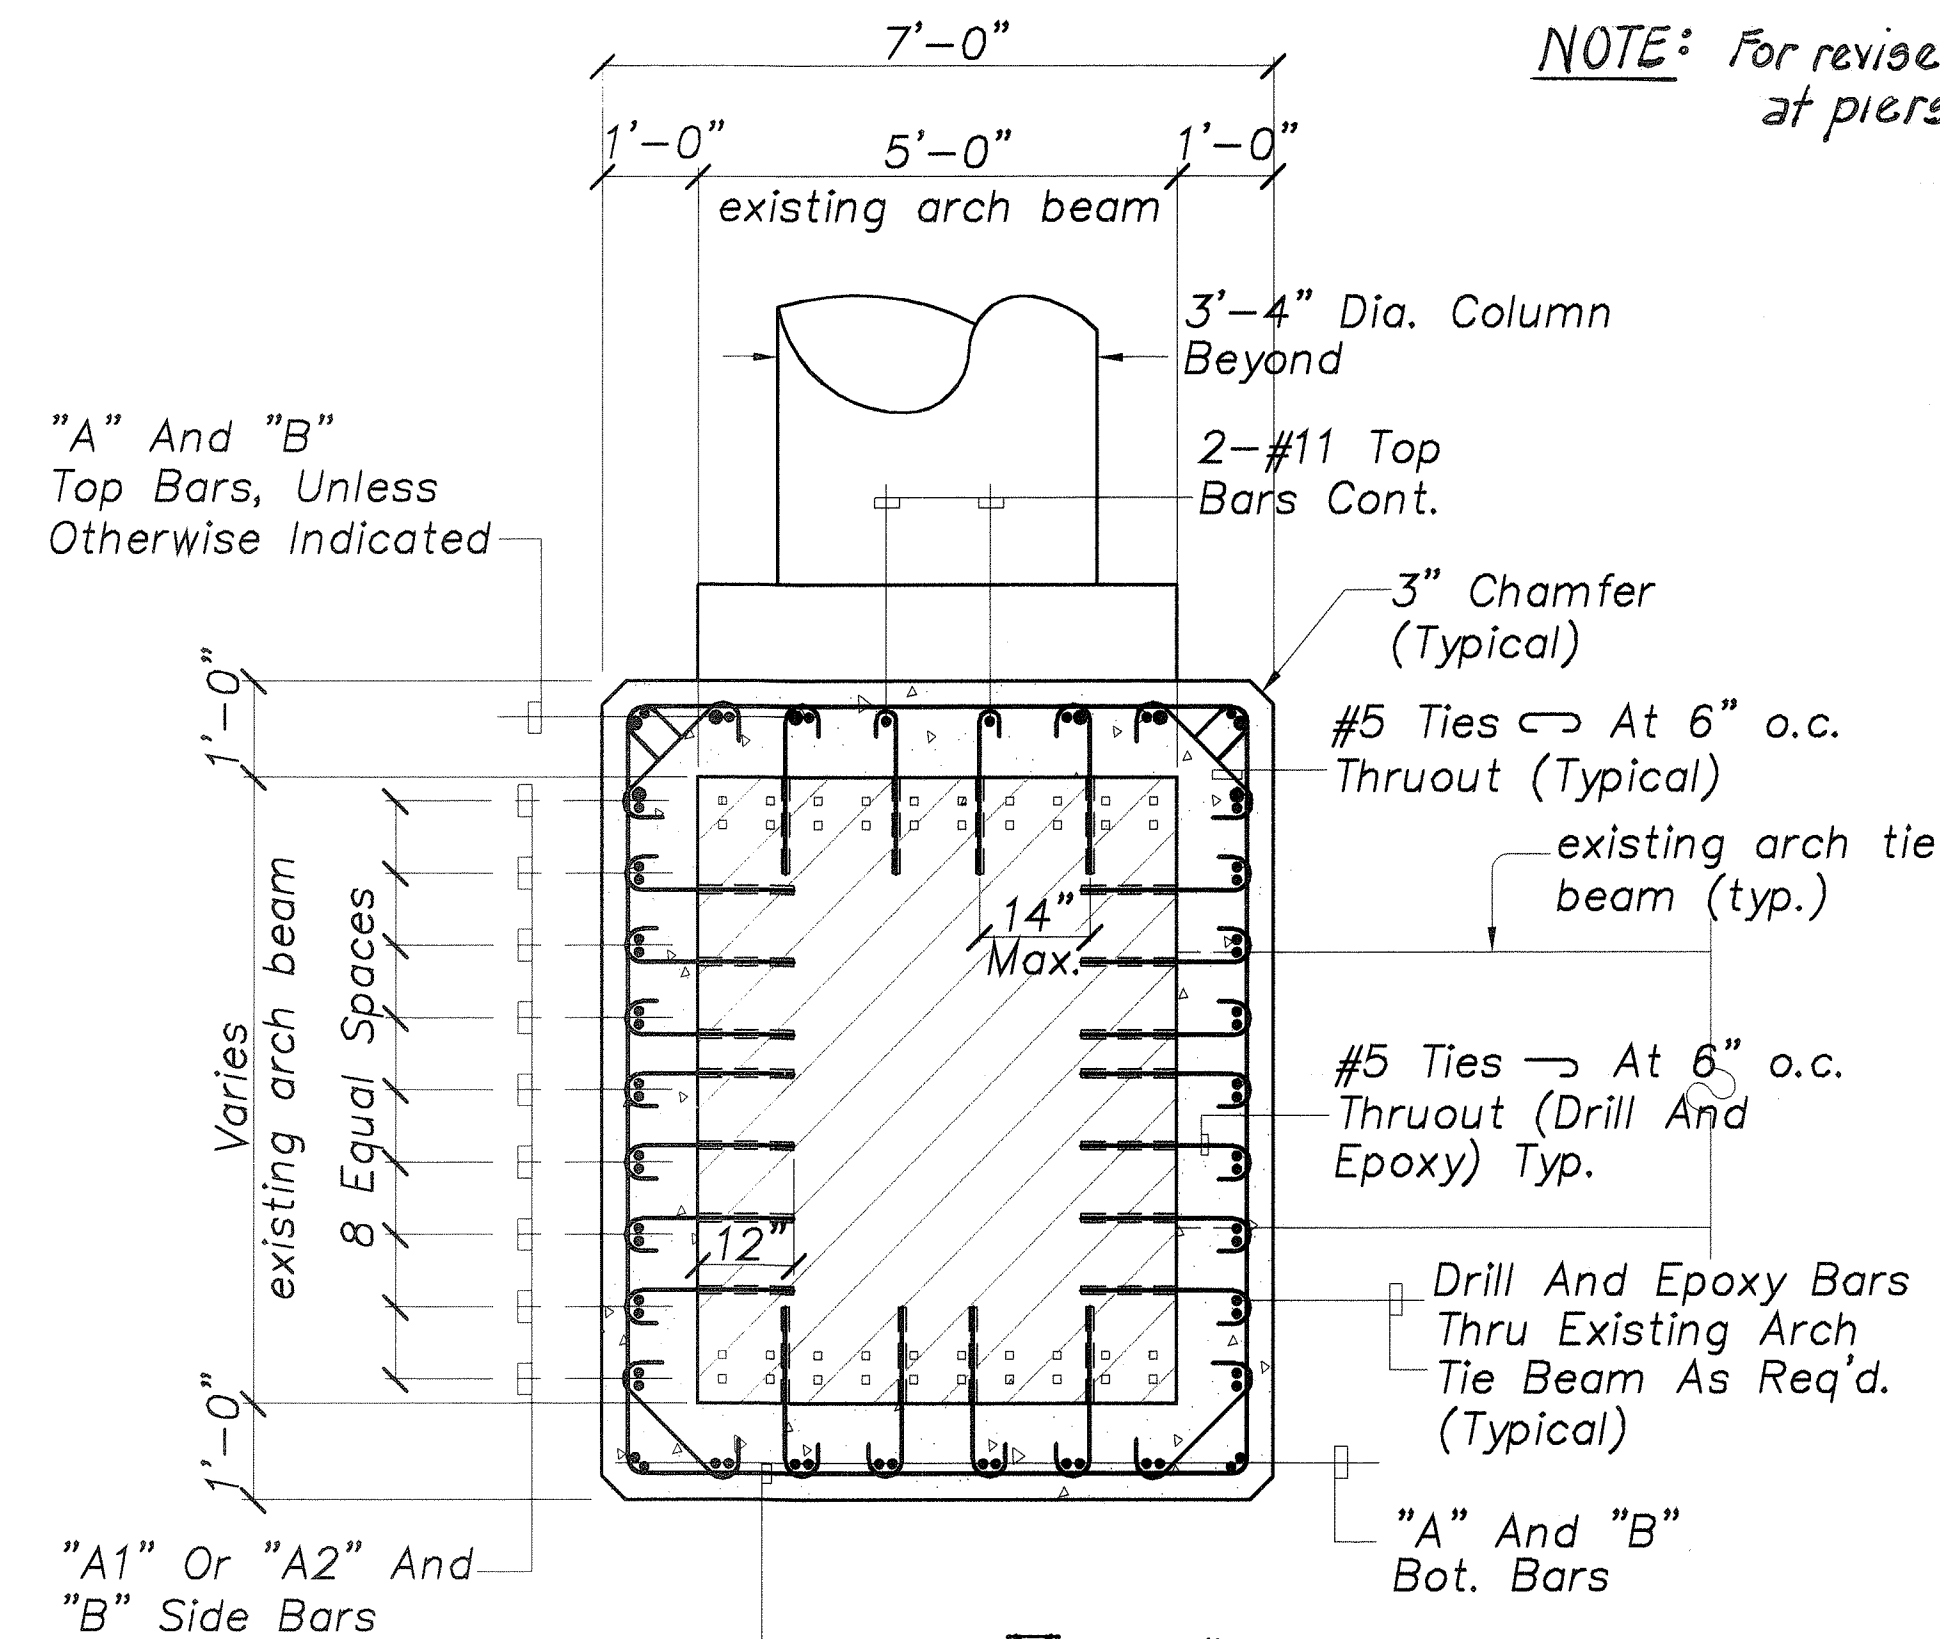


Note:
Refer To "Typical Tie Detail"
A/S-16 For Clarification Of
Tie Placement

1 ARCH BEAM SECTION
S-18/S-19 Scale: 1/2"=1'-0"

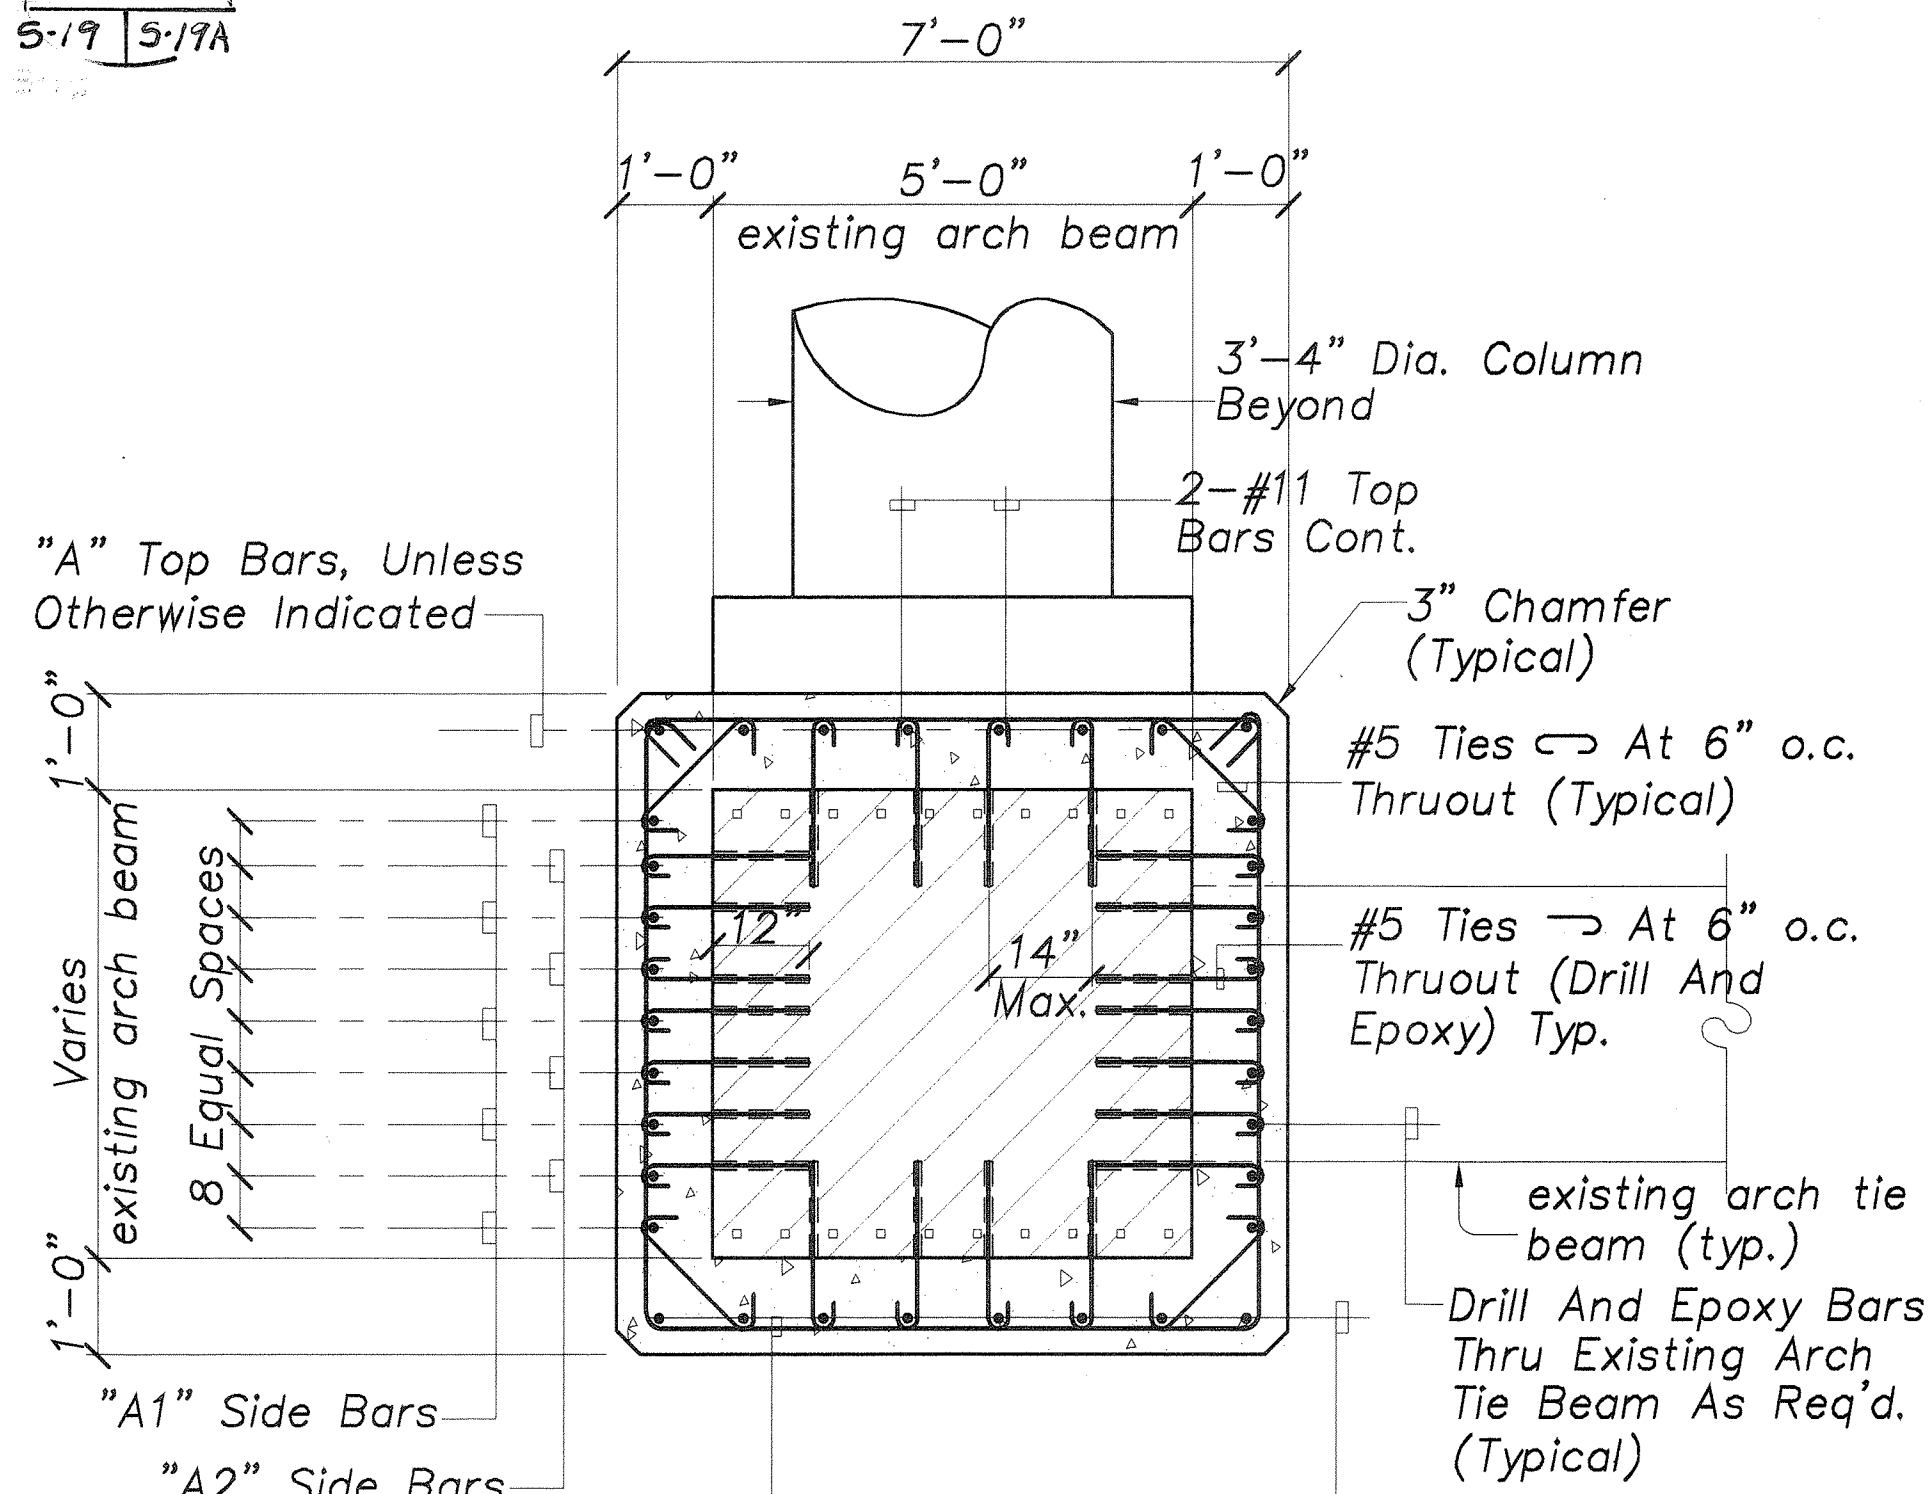


Note:
Refer To "Typical Tie Detail"
A/S-16 For Clarification Of
Tie Placement

2 ARCH BEAM SECTION
S-18/S-19 Scale: 1/2"=1'-0"

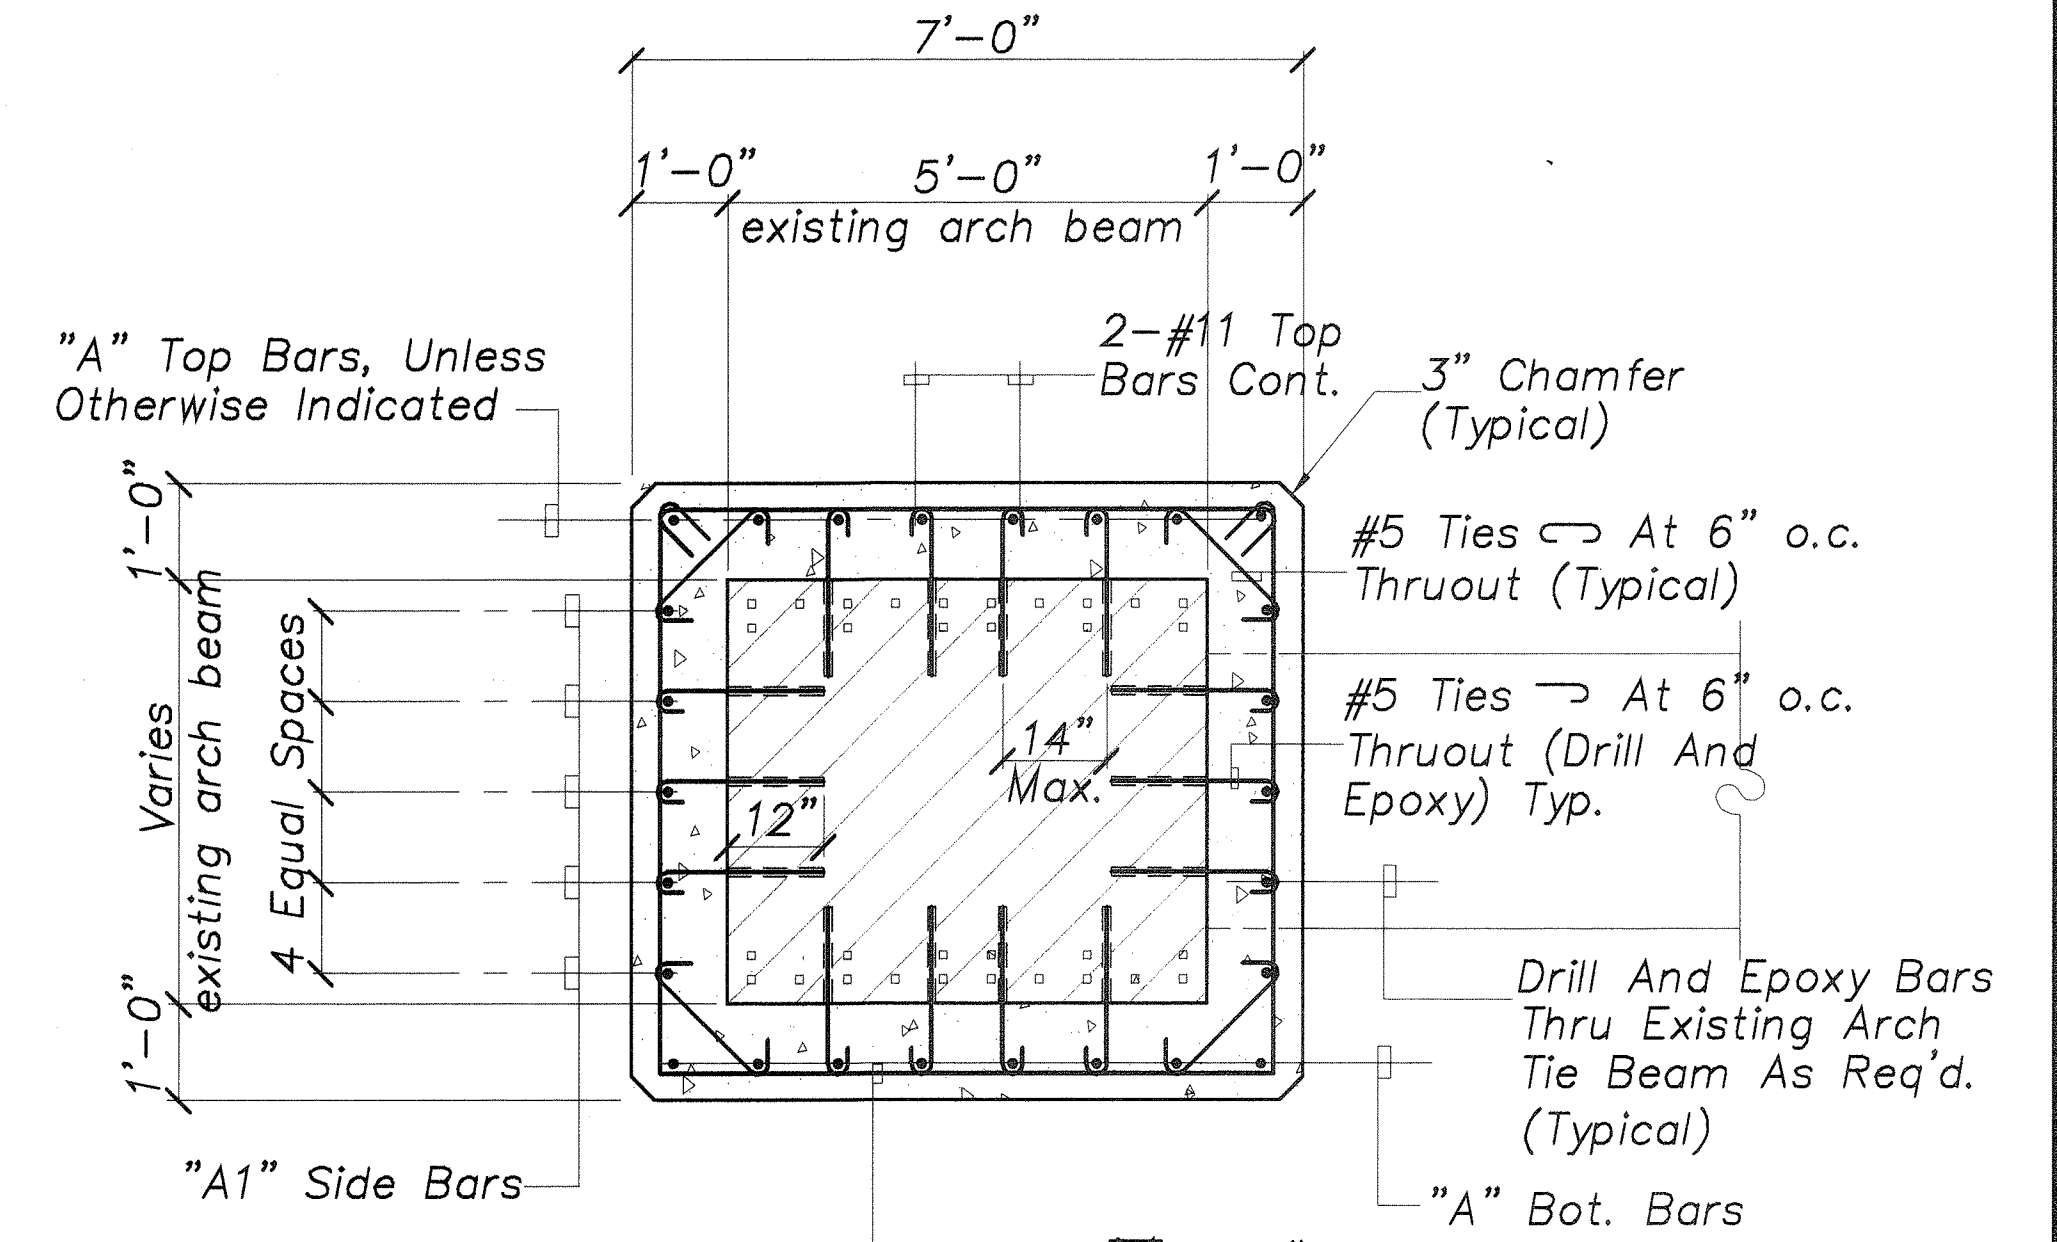


Note:
Refer To "Typical Tie Detail"
A/S-16 For Clarification Of
Tie Placement

3 ARCH BEAM SECTION
S-18/S-19 Scale: 1/2"=1'-0"

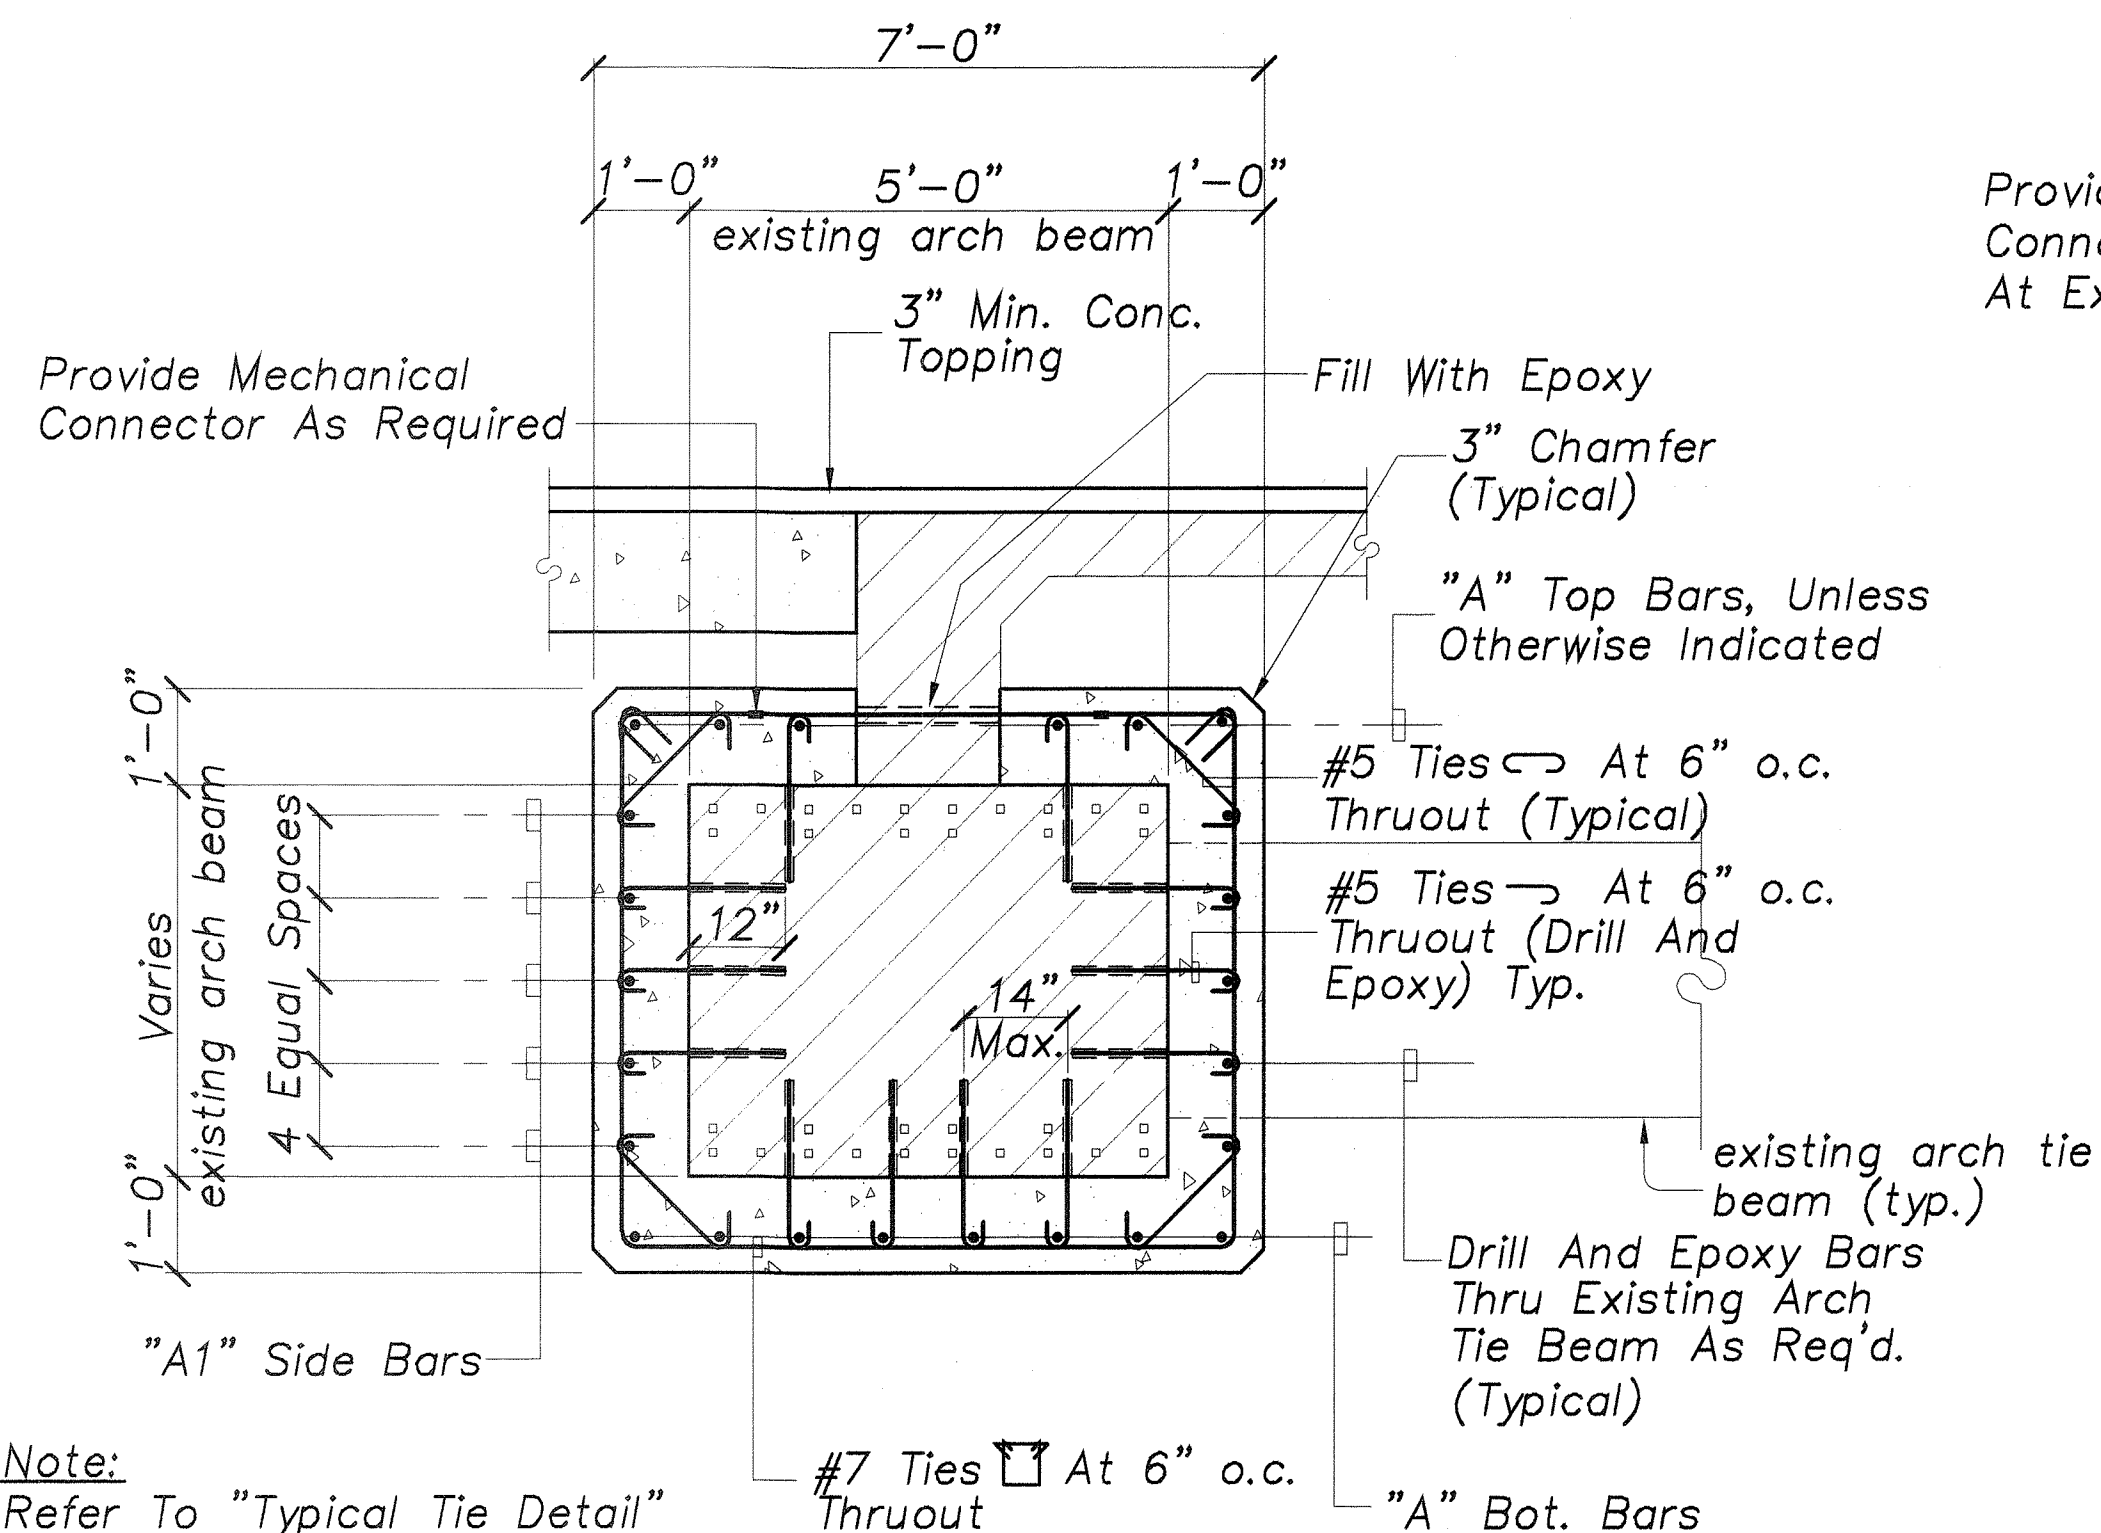



Note:
Refer To "Typical Tie Detail"
A/S-16 For Clarification Of
Tie Placement

4 ARCH BEAM SECTION
S-18/S-19 Scale: 1/2"=1'-0"

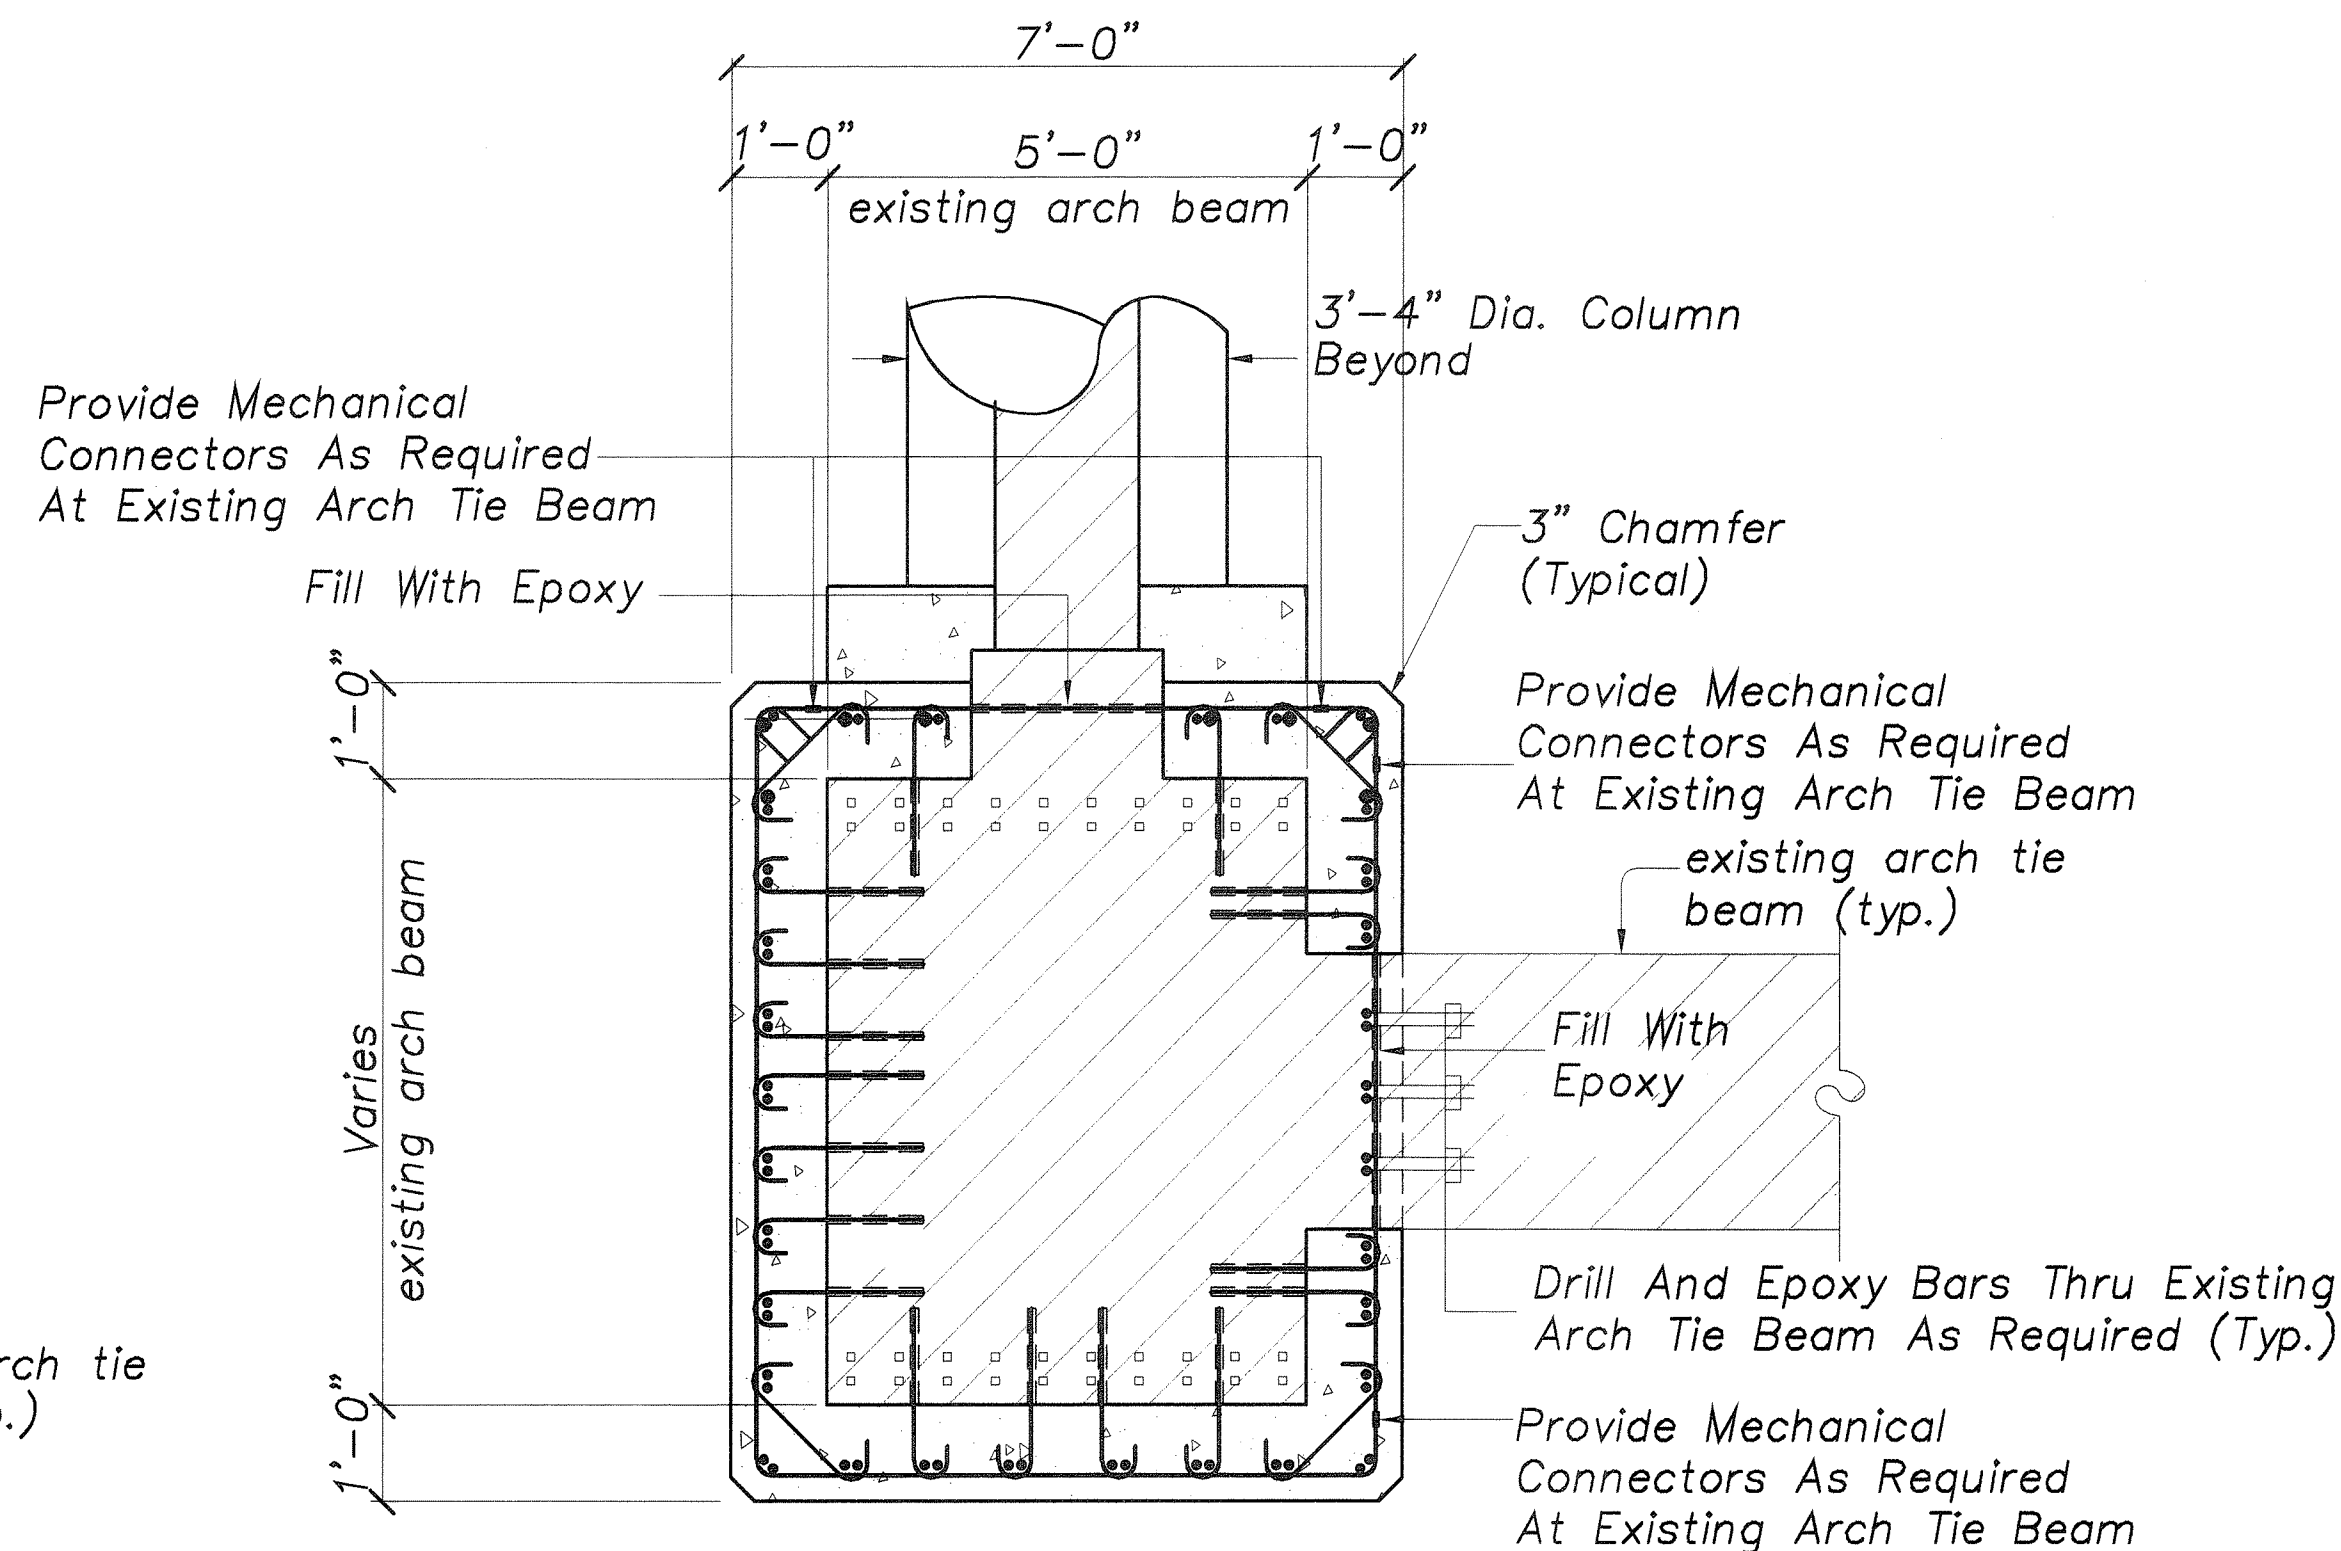

Note:
1. Hook Ties May Be Omitted Where Placement Is Not Possible At Existing Arch Tie Beam.
2. Refer To "Typical Tie Detail" A/S-16 For Clarification Of Tie Placement

5 ARCH BEAM / TIE BEAM SECTION
S-18/S-19 Scale: 1/2"=1'-0"

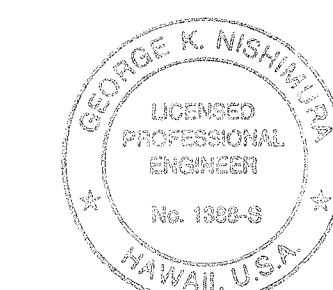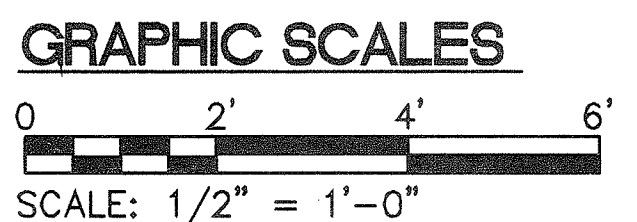


THIS WORK WAS PREPARED BY
AND IS THE PROPERTY OF
HAWAIIAN ENGINEERING, INC.

STATE OF HAWAII
DEPARTMENT OF TRANSPORTATION
HIGHWAYS DIVISION
ARCH BEAM SECTIONS

HAWAII BELT ROAD
KUPAPAUHUA BRIDGE WIDENING
HAMAKUA DISTRICT
Federal Aid Project No. BR-019-2(38)


SCALE: AS NOTED DATE: OCT., 2001
SHEET No. S-19 OF 30 SHEETS

FED. ROAD DIST. NO.	STATE	FED. AID PROJ. NO.	FISCAL YEAR	SHEET NO.	TOTAL SHEETS
HAWAII	HAW.	BR-019-2(38)	2001	62 S-1	73

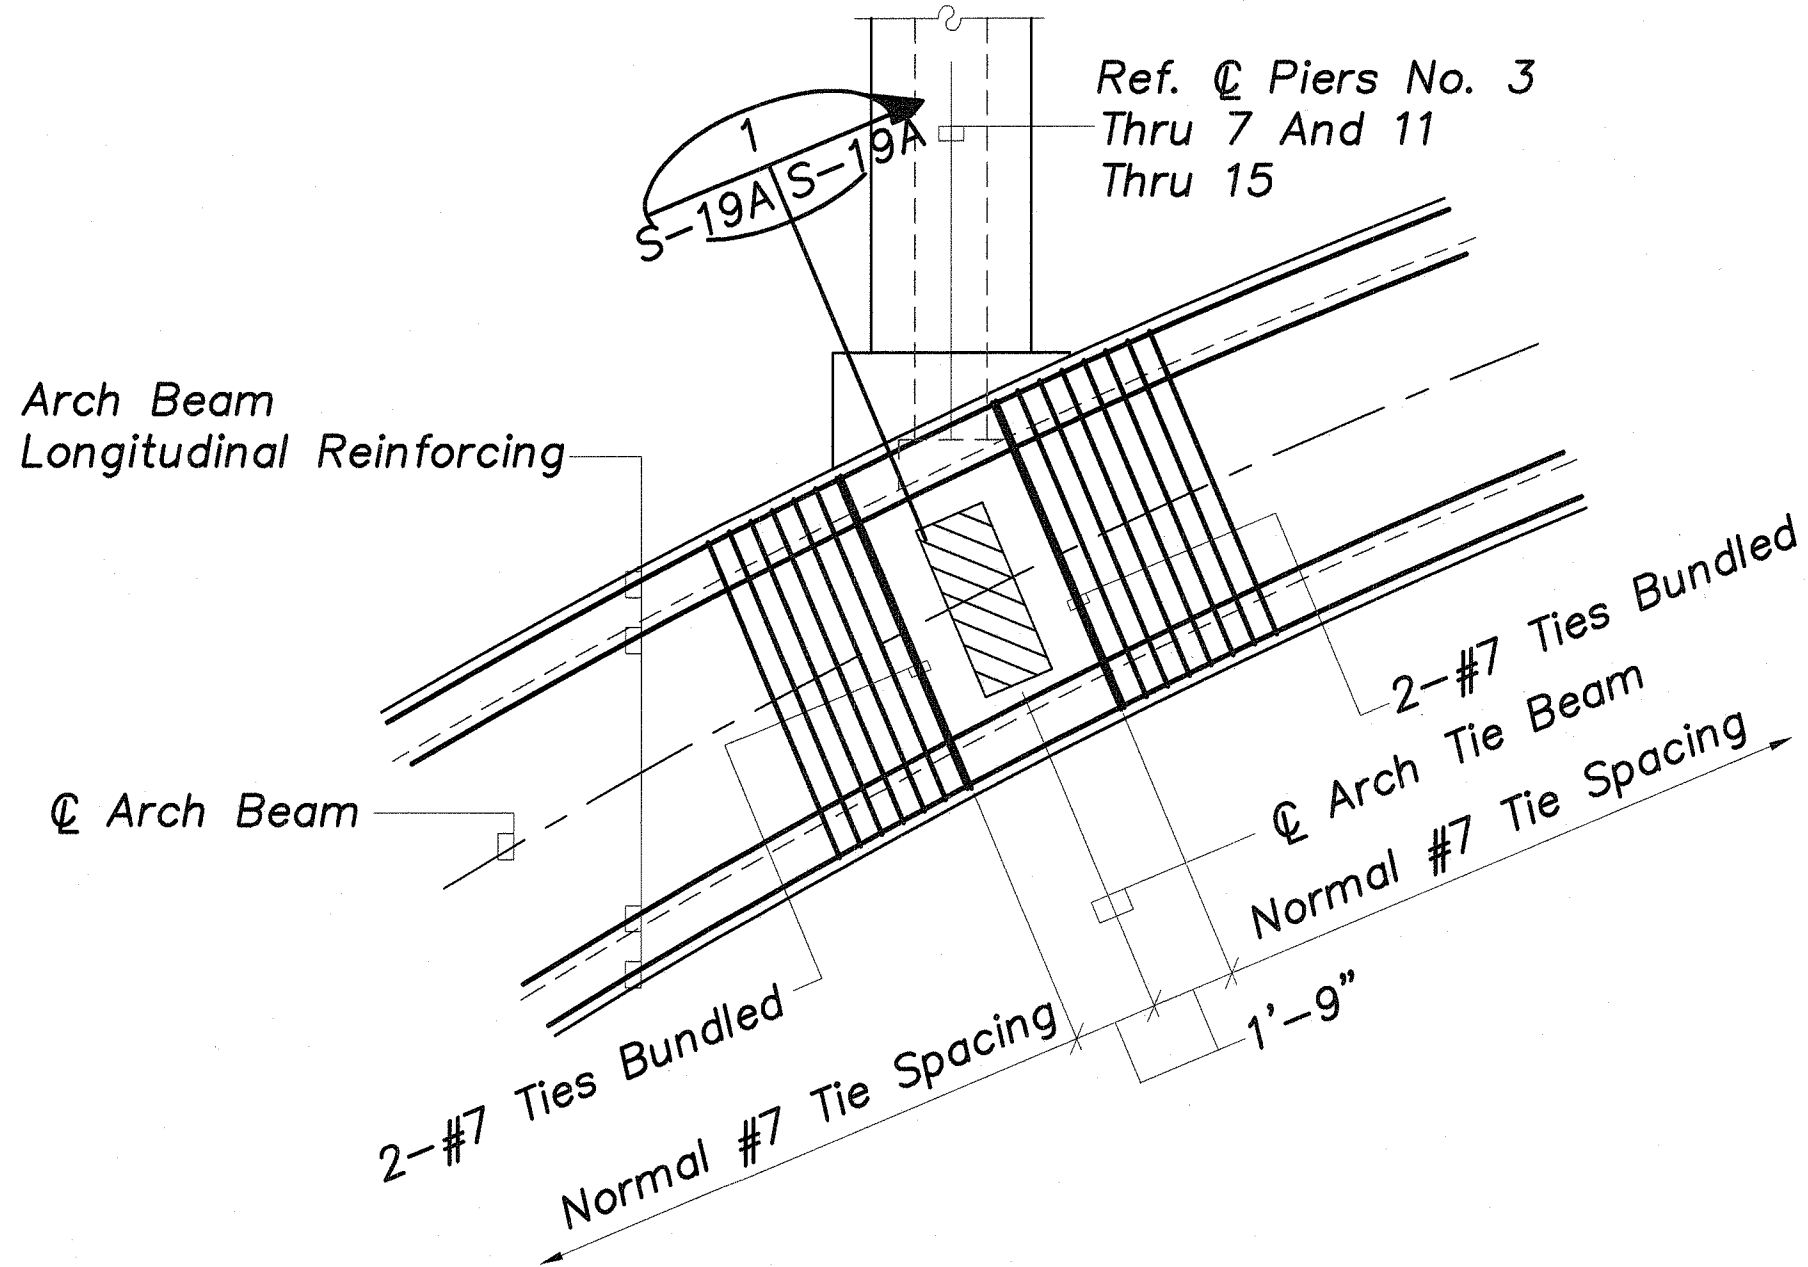

PARTIAL ELEVATION
Scale: 1/4"=1'-0"

Note:
Complete Arch Beam
Reinf. Not Shown. Refer
To Contract Drawings For
Longitudinal Reinf. And
#5 Hook Ties

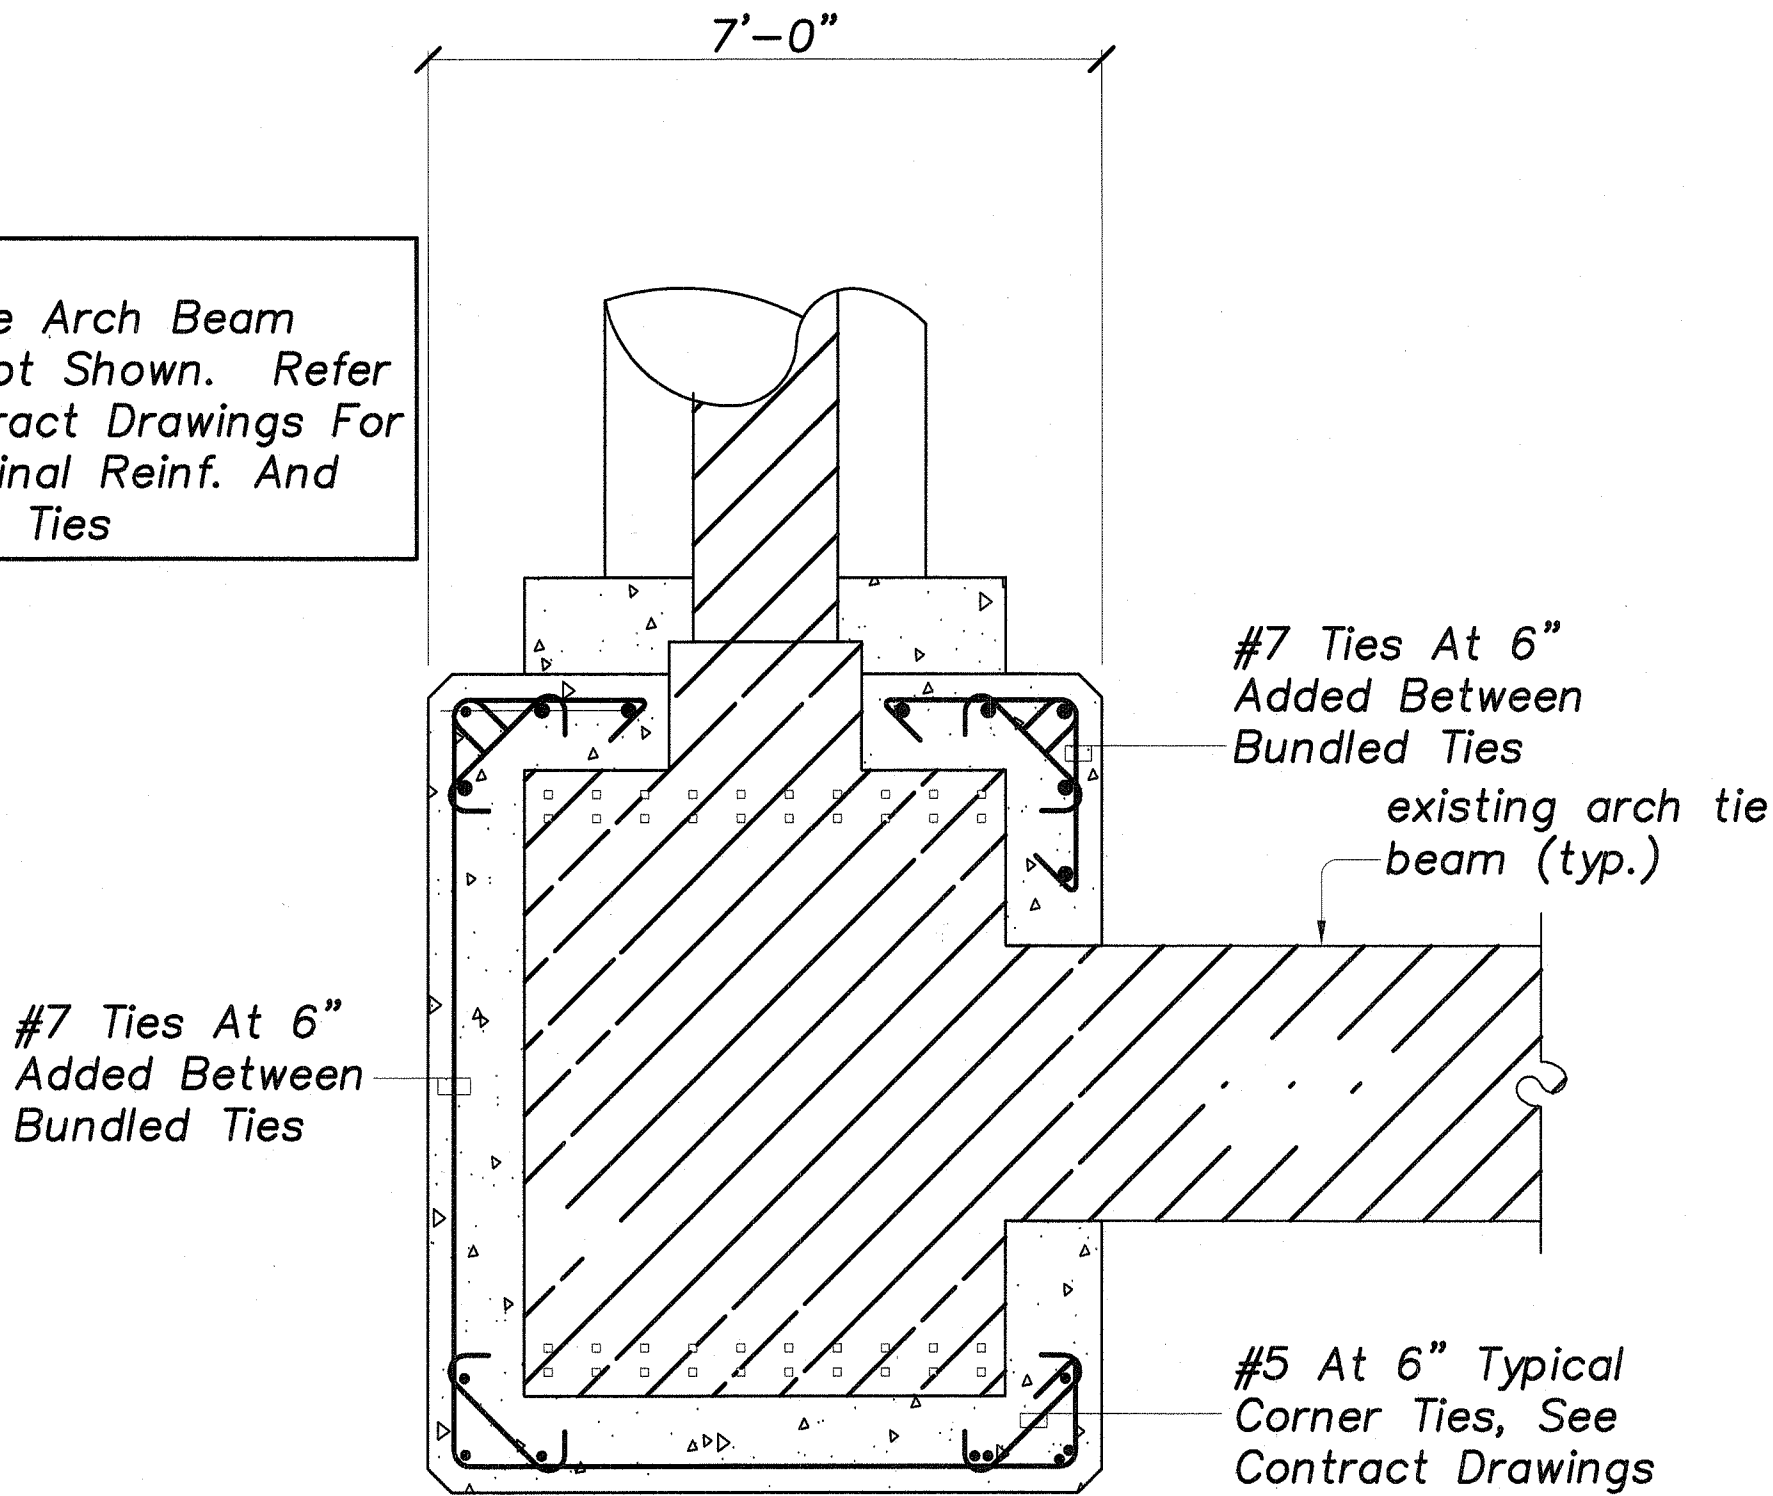


SECTION
Scale: 1/2"=1'-0"

REVISE #7 TIES ARRANGEMENT IN ARCH BEAM AT PIERS
Scale: As Noted

DESIGNED BY	DATE
DRAWN BY	
CHECKED BY	
NOTED BY	
NO.	

Note:
This Tracing Prepared During
"As-Built" Posting

GRAPHIC SCALES

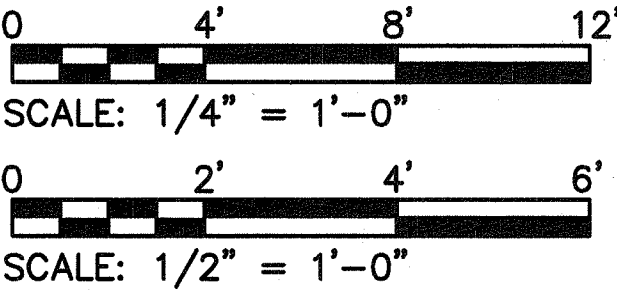

STATE OF HAWAII
DEPARTMENT OF TRANSPORTATION
HIGHWAYS DIVISION
ARCH BEAM SECTIONS AT PIERS


HAWAII BELT ROAD
KUPAPAPUA BRIDGE WIDENING
HAMAKUA DISTRICT
Federal Aid Project No. BR-019-2(38)

SCALE: AS NOTED
DATE: OCT., 2001


FED. ROAD DIST. NO.	STATE	FED. AID PROJ. NO.	FISCAL YEAR	SHEET NO.	TOTAL SHEETS
HAWAII	HAW.	BR-019-2(38)	2002	63A	79

Note:
Pier No. Refers To Existing Identification Number.


Type "P" Manhole Frame And Cover. Access To Service Stair No. 1

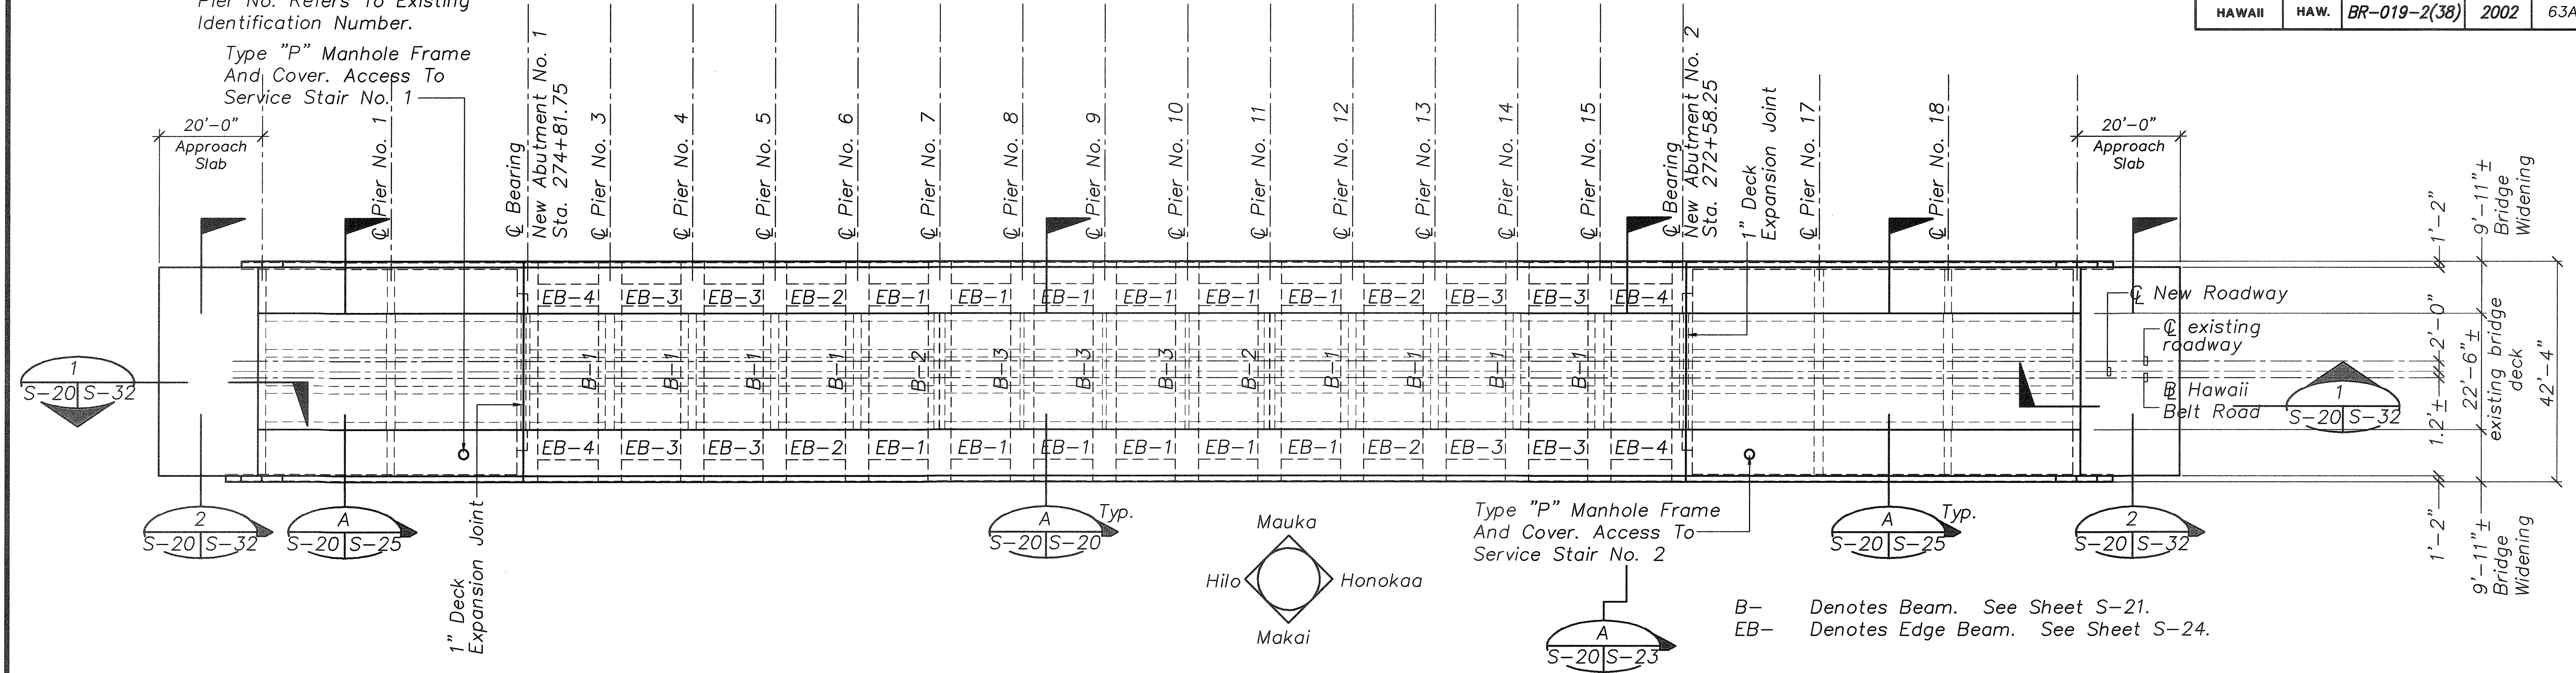

BRIDGE DECK FRAMING PLAN
Scale: 1/16"=1'-0"

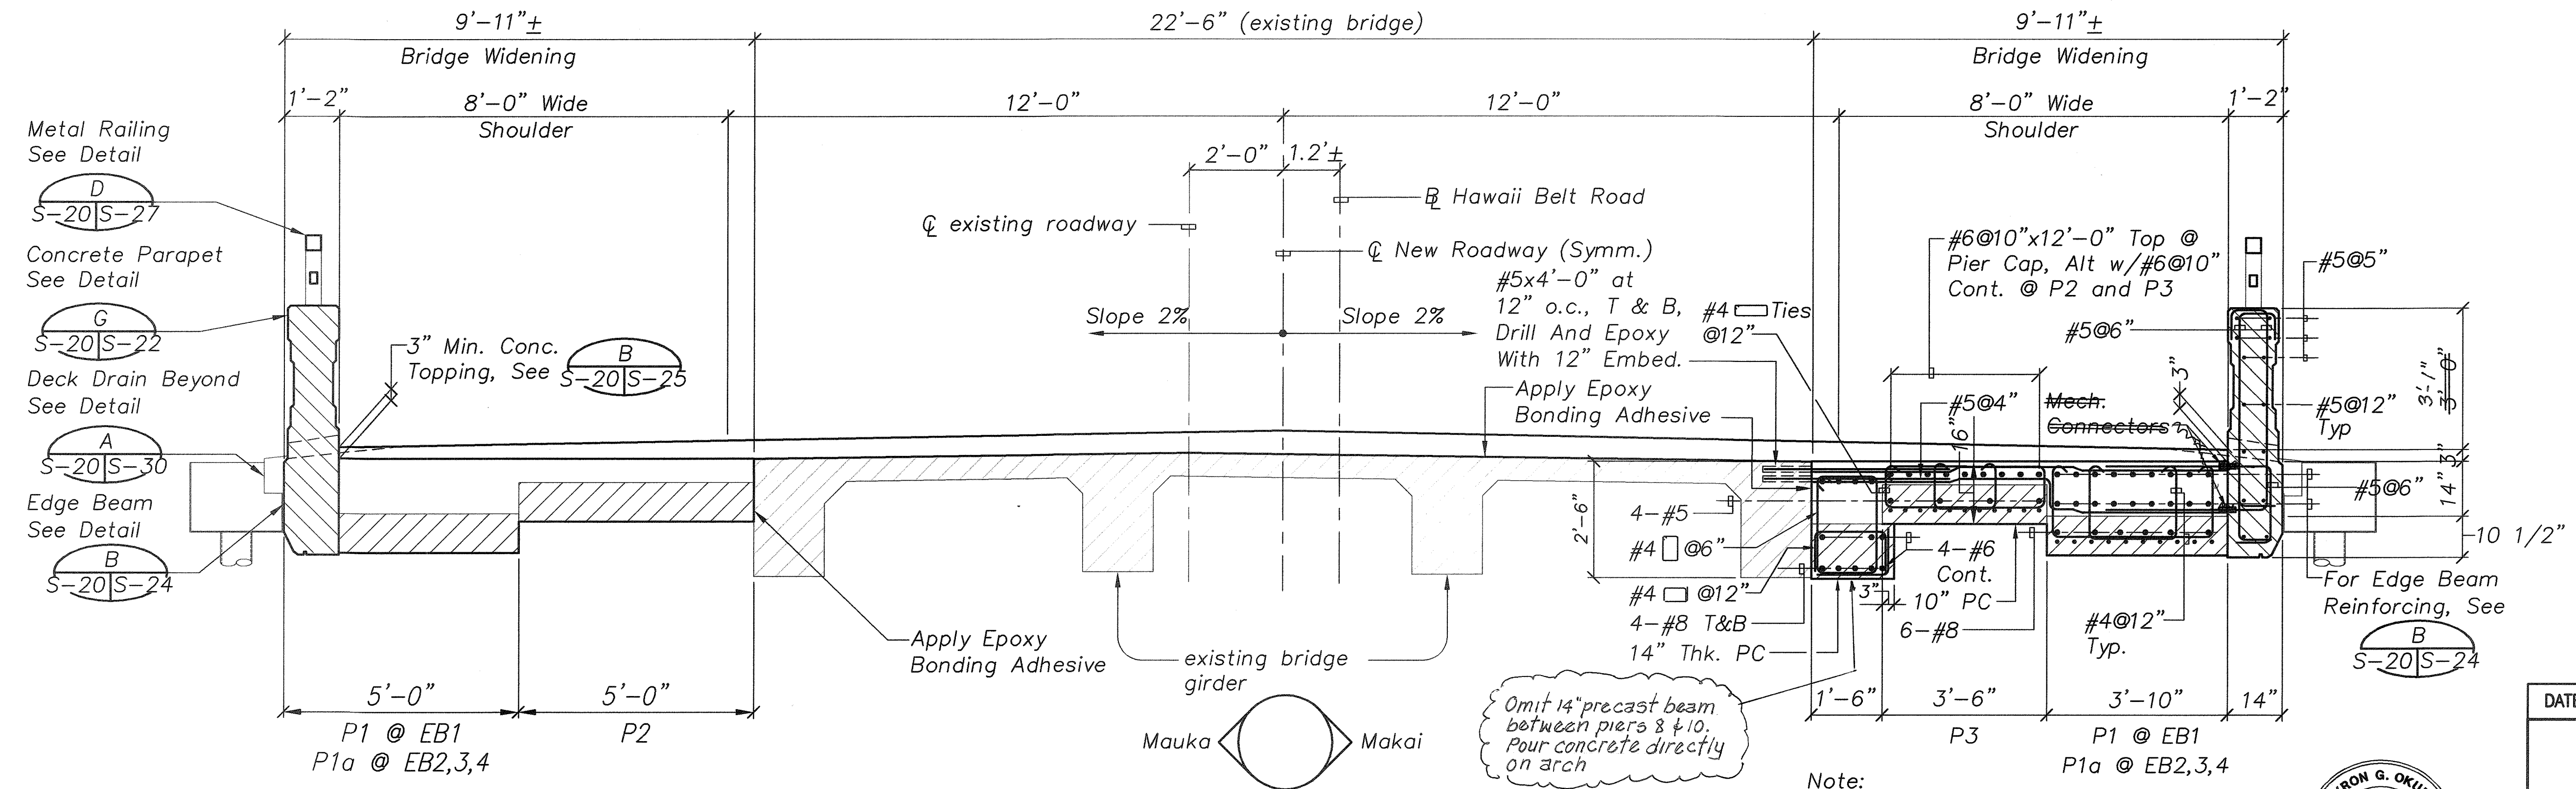

TYPICAL DECK SECTION
Scale: 1/2"=1'-0"

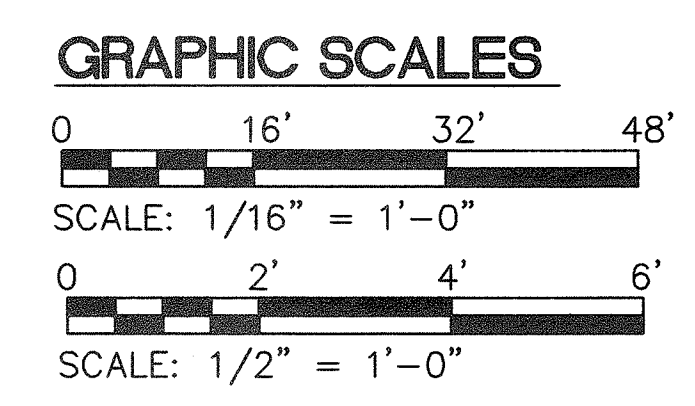

Note:
For Plank Notes, Camber, and Reinforcing,
See Sheet S-31.



THIS WORK WAS PREPARED BY ME OR UNDER MY SUPERVISION

Myron Okubo


DATE	REVISION
	STATE OF HAWAII DEPARTMENT OF TRANSPORTATION HIGHWAYS DIVISION BRIDGE DECK FRAMING PLAN, TYPICAL DECK SECTION HAWAII BELT ROAD KUPAPULUA BRIDGE WIDENING HAMAKUA DISTRICT Federal Aid Project No. BR-019-2(38) Scale: As Noted Date: June 23, 2003

SHEET No. S-20 OF 36 SHEETS


Path: L:\W04\6670-01 Kupapula Bridge\Drawings File Name: S20 Plot Date: Sep 25, 2006-07:54:24pm CAD User: skidoni Xref File Name: | Border | AUTODATE |

ORIGINAL PLAN	SURVEY PLOTTED BY	DATE
NOTEBOOK	DRAWN BY	
	DESIGNED BY	
	QUANTITIES BY	
	CHECKED BY	


FED. ROAD DIST. NO.	STATE	FED. AID PROJ. NO.	FISCAL YEAR	SHEET NO.	TOTAL SHEETS
HAWAII	HAW.	BR-019-2(38)	2002	65A	79

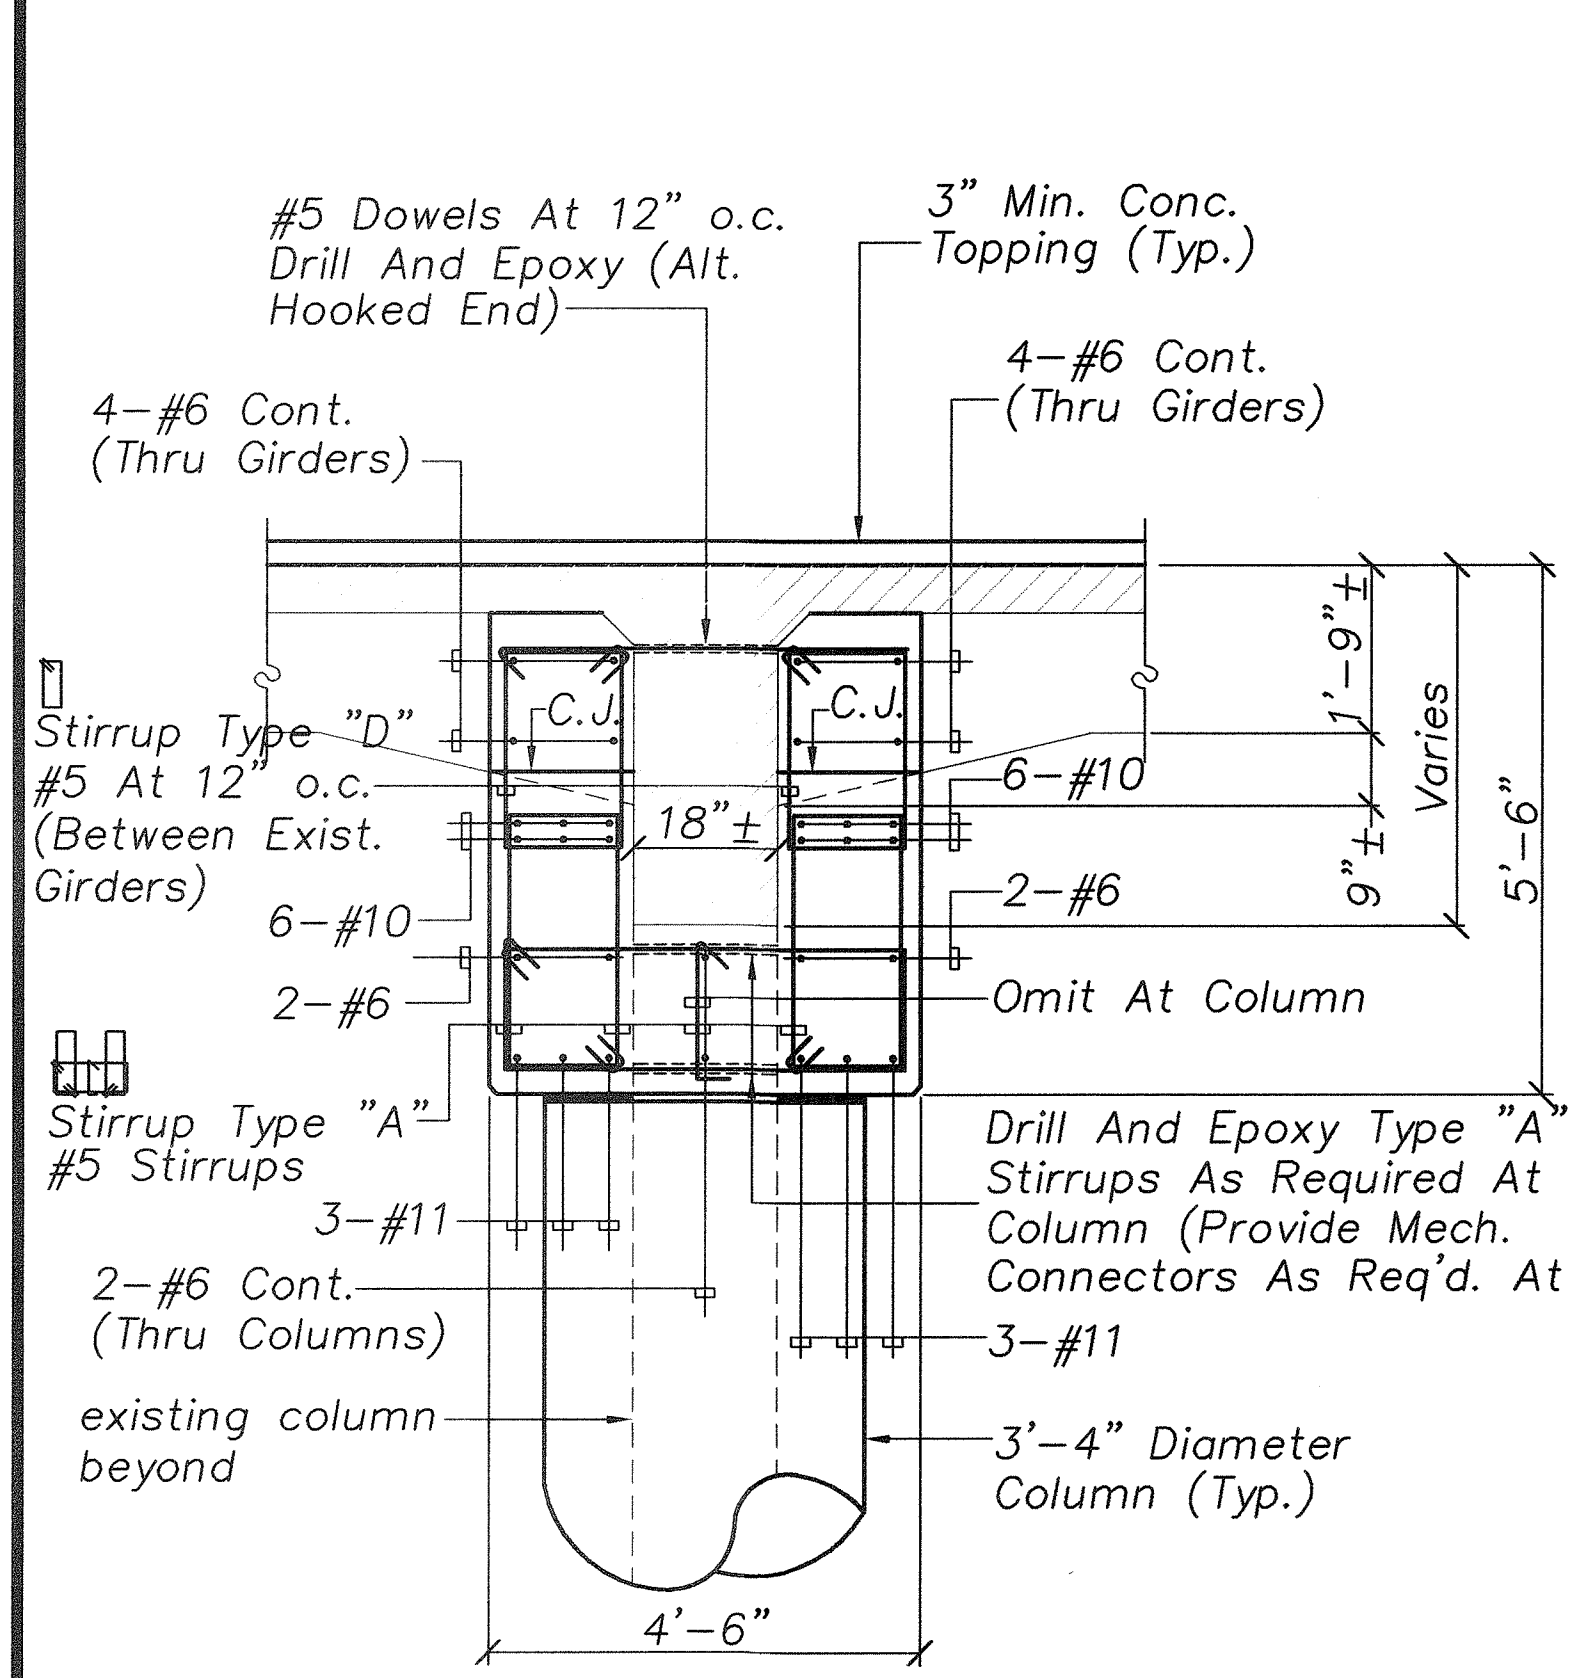


SECTION A
S-21|S-22 Scale: 1/2"=1'-0"

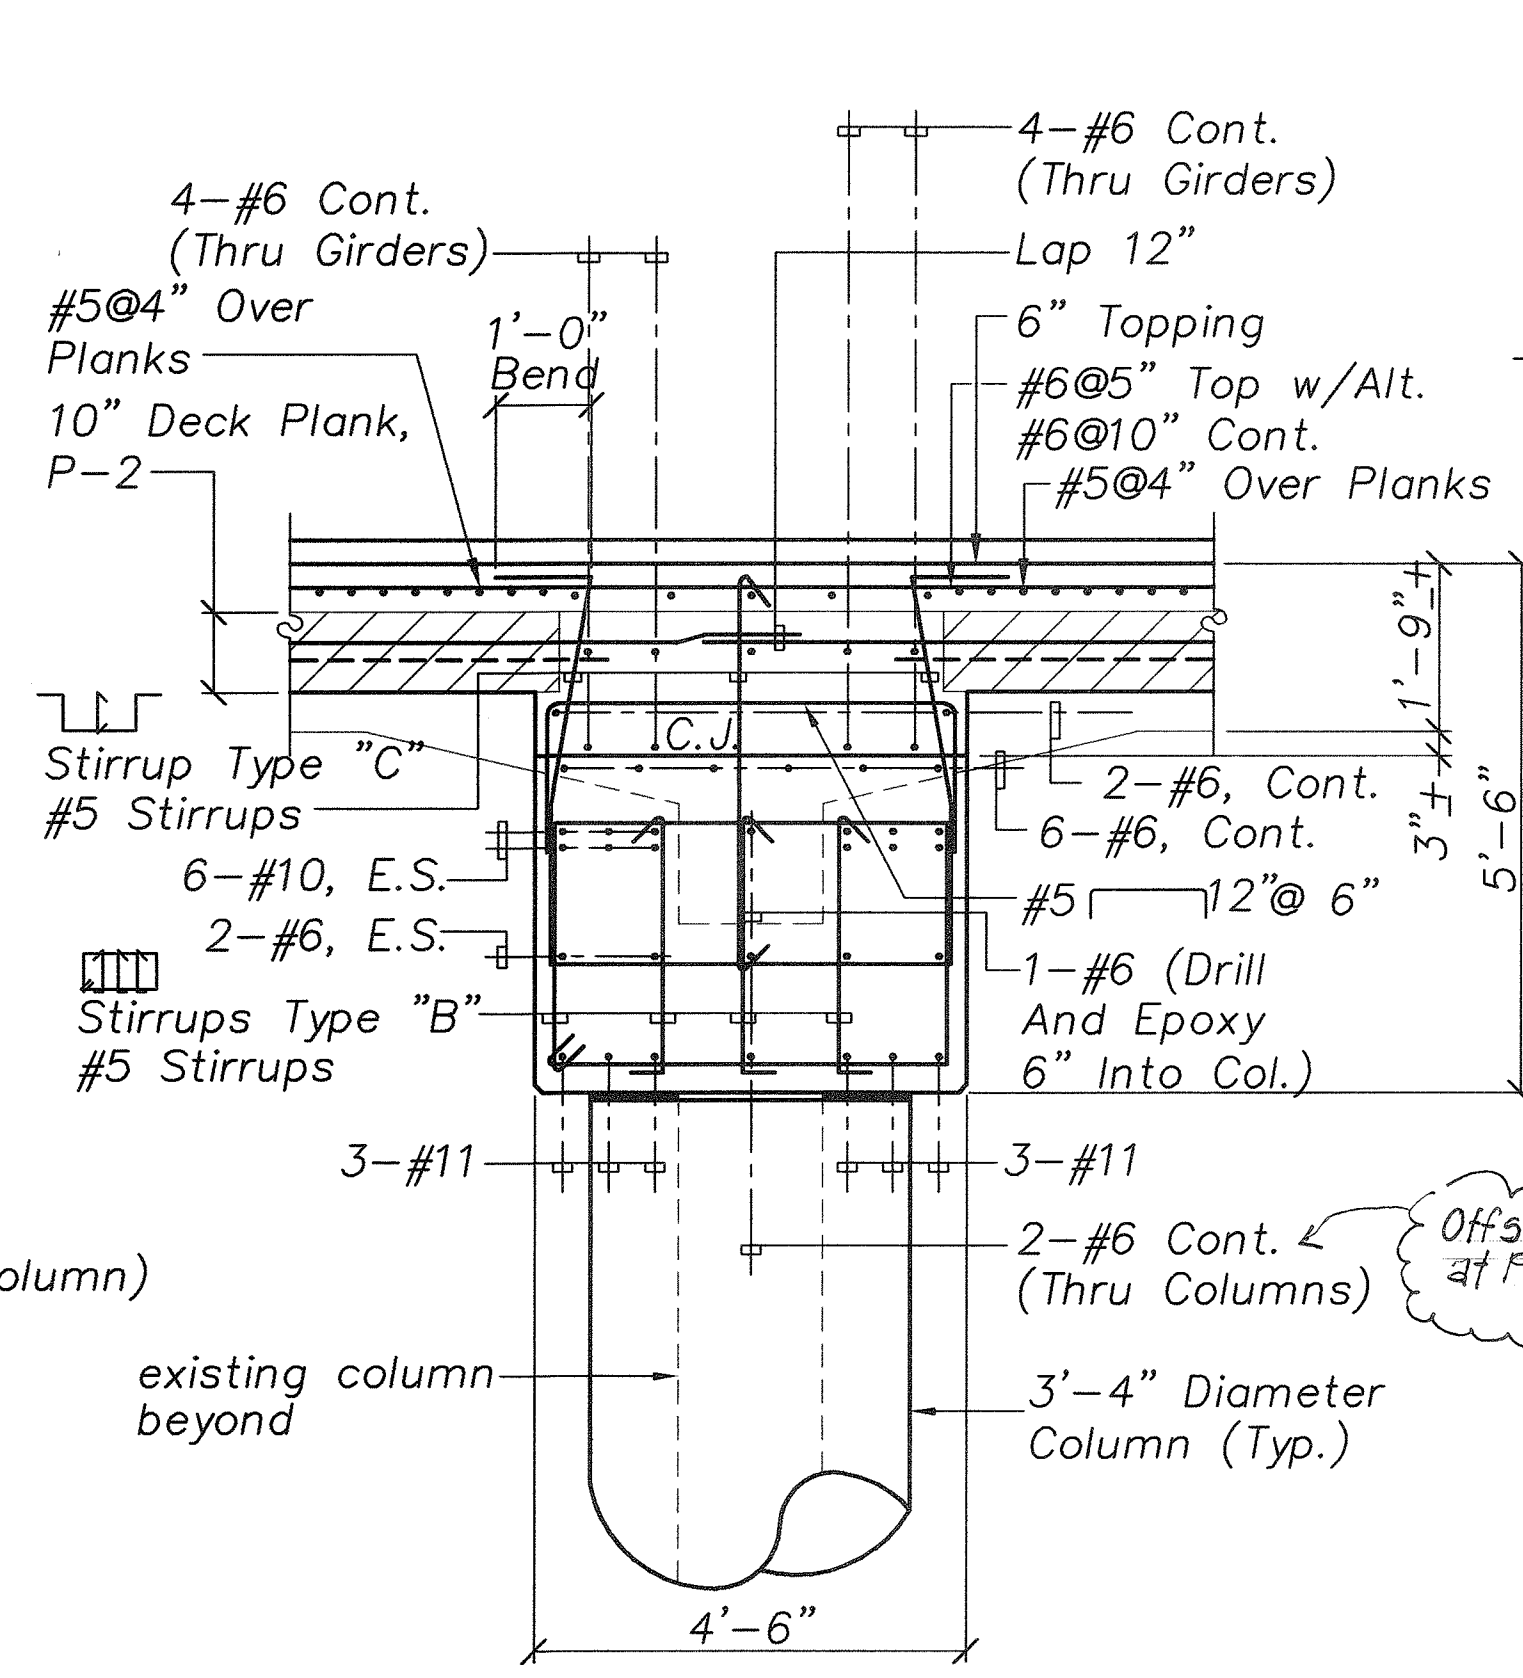


SECTION B
S-21|S-22 Scale: 1/2"=1'-0"

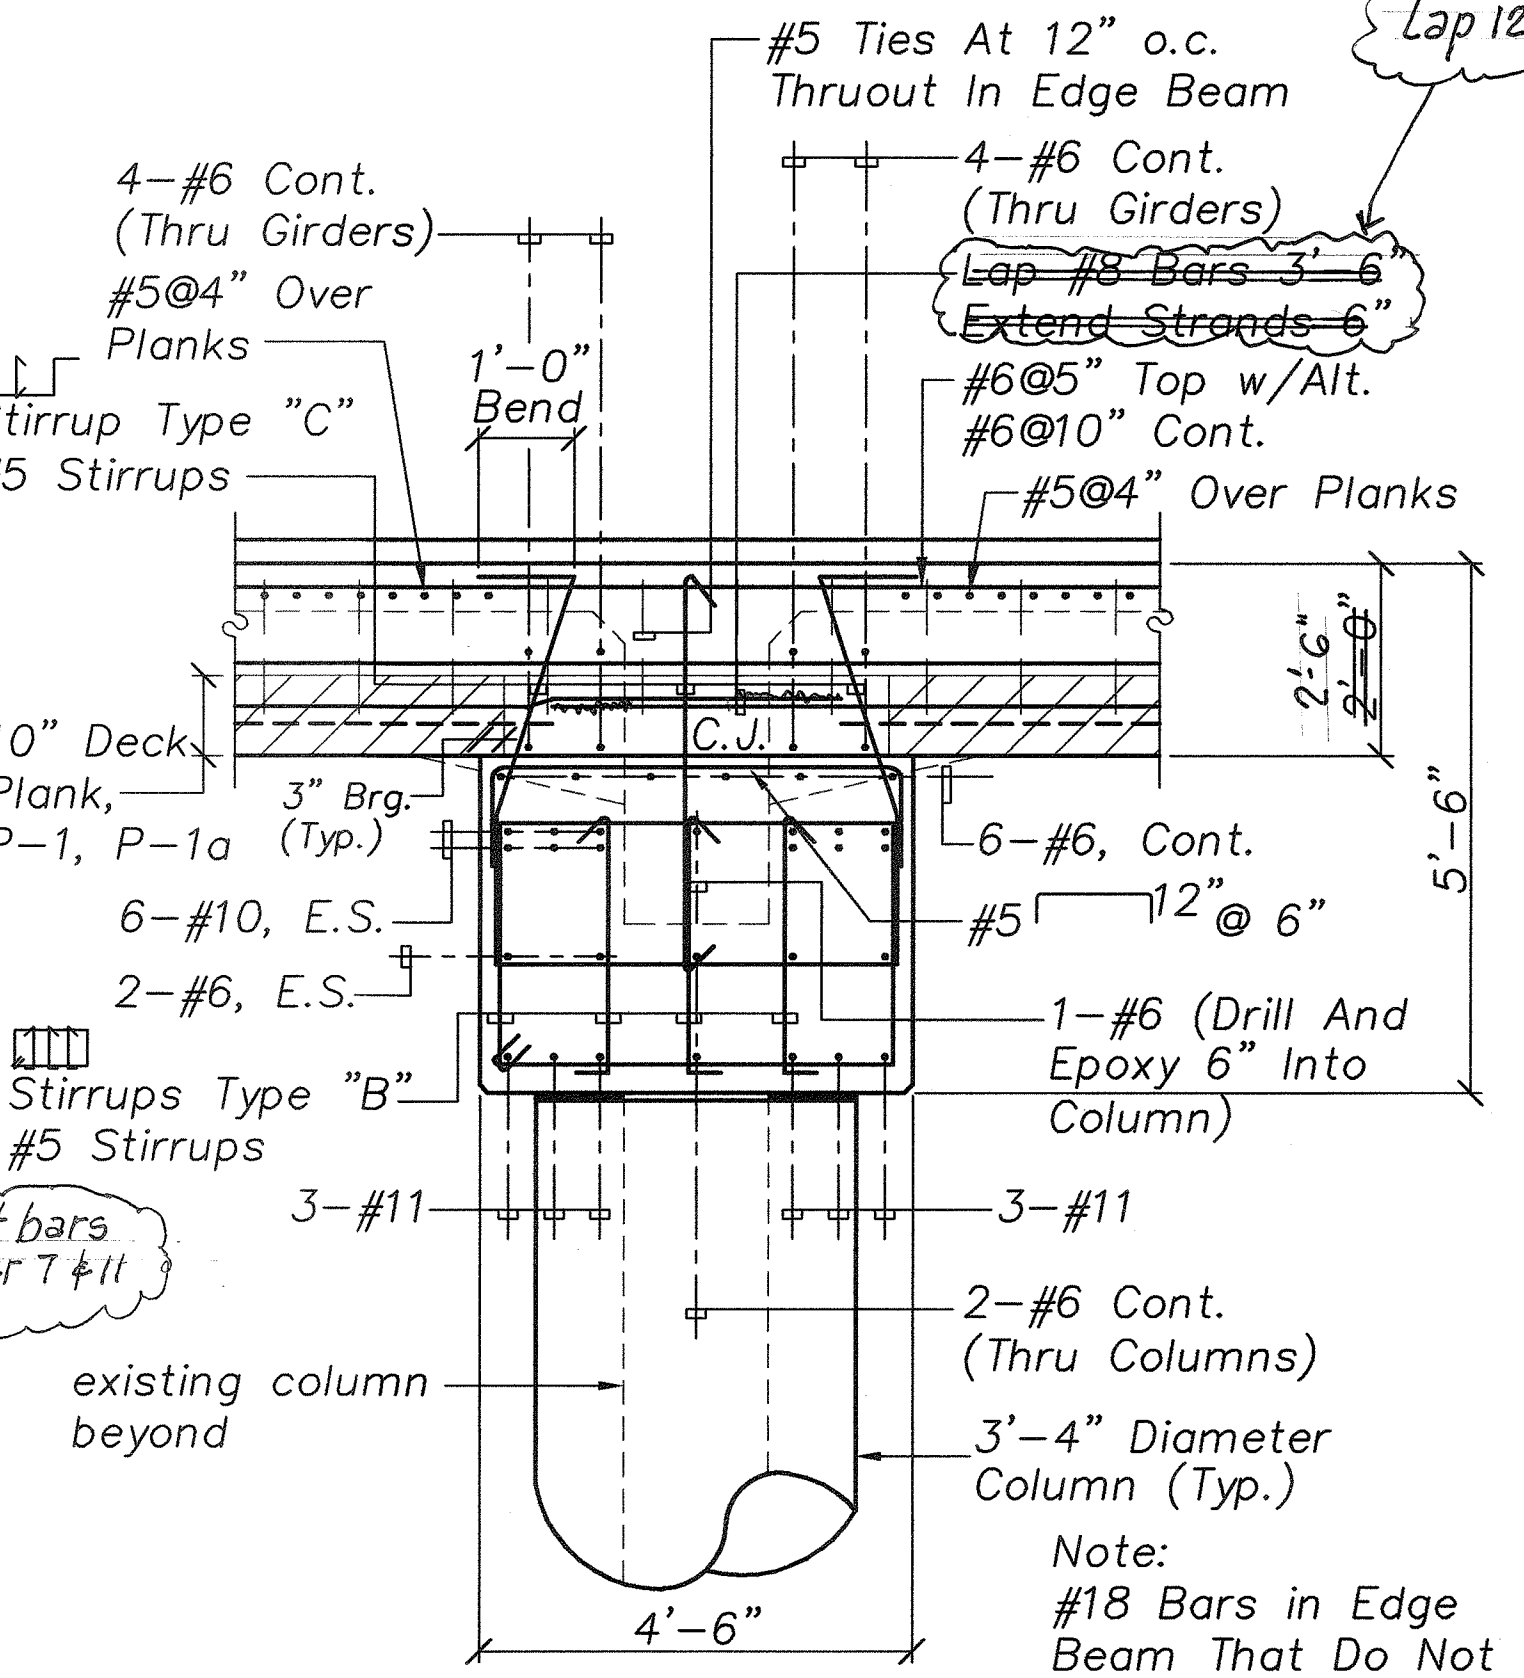


SECTION C
S-21|S-22 Scale: 1/2"=1'-0"

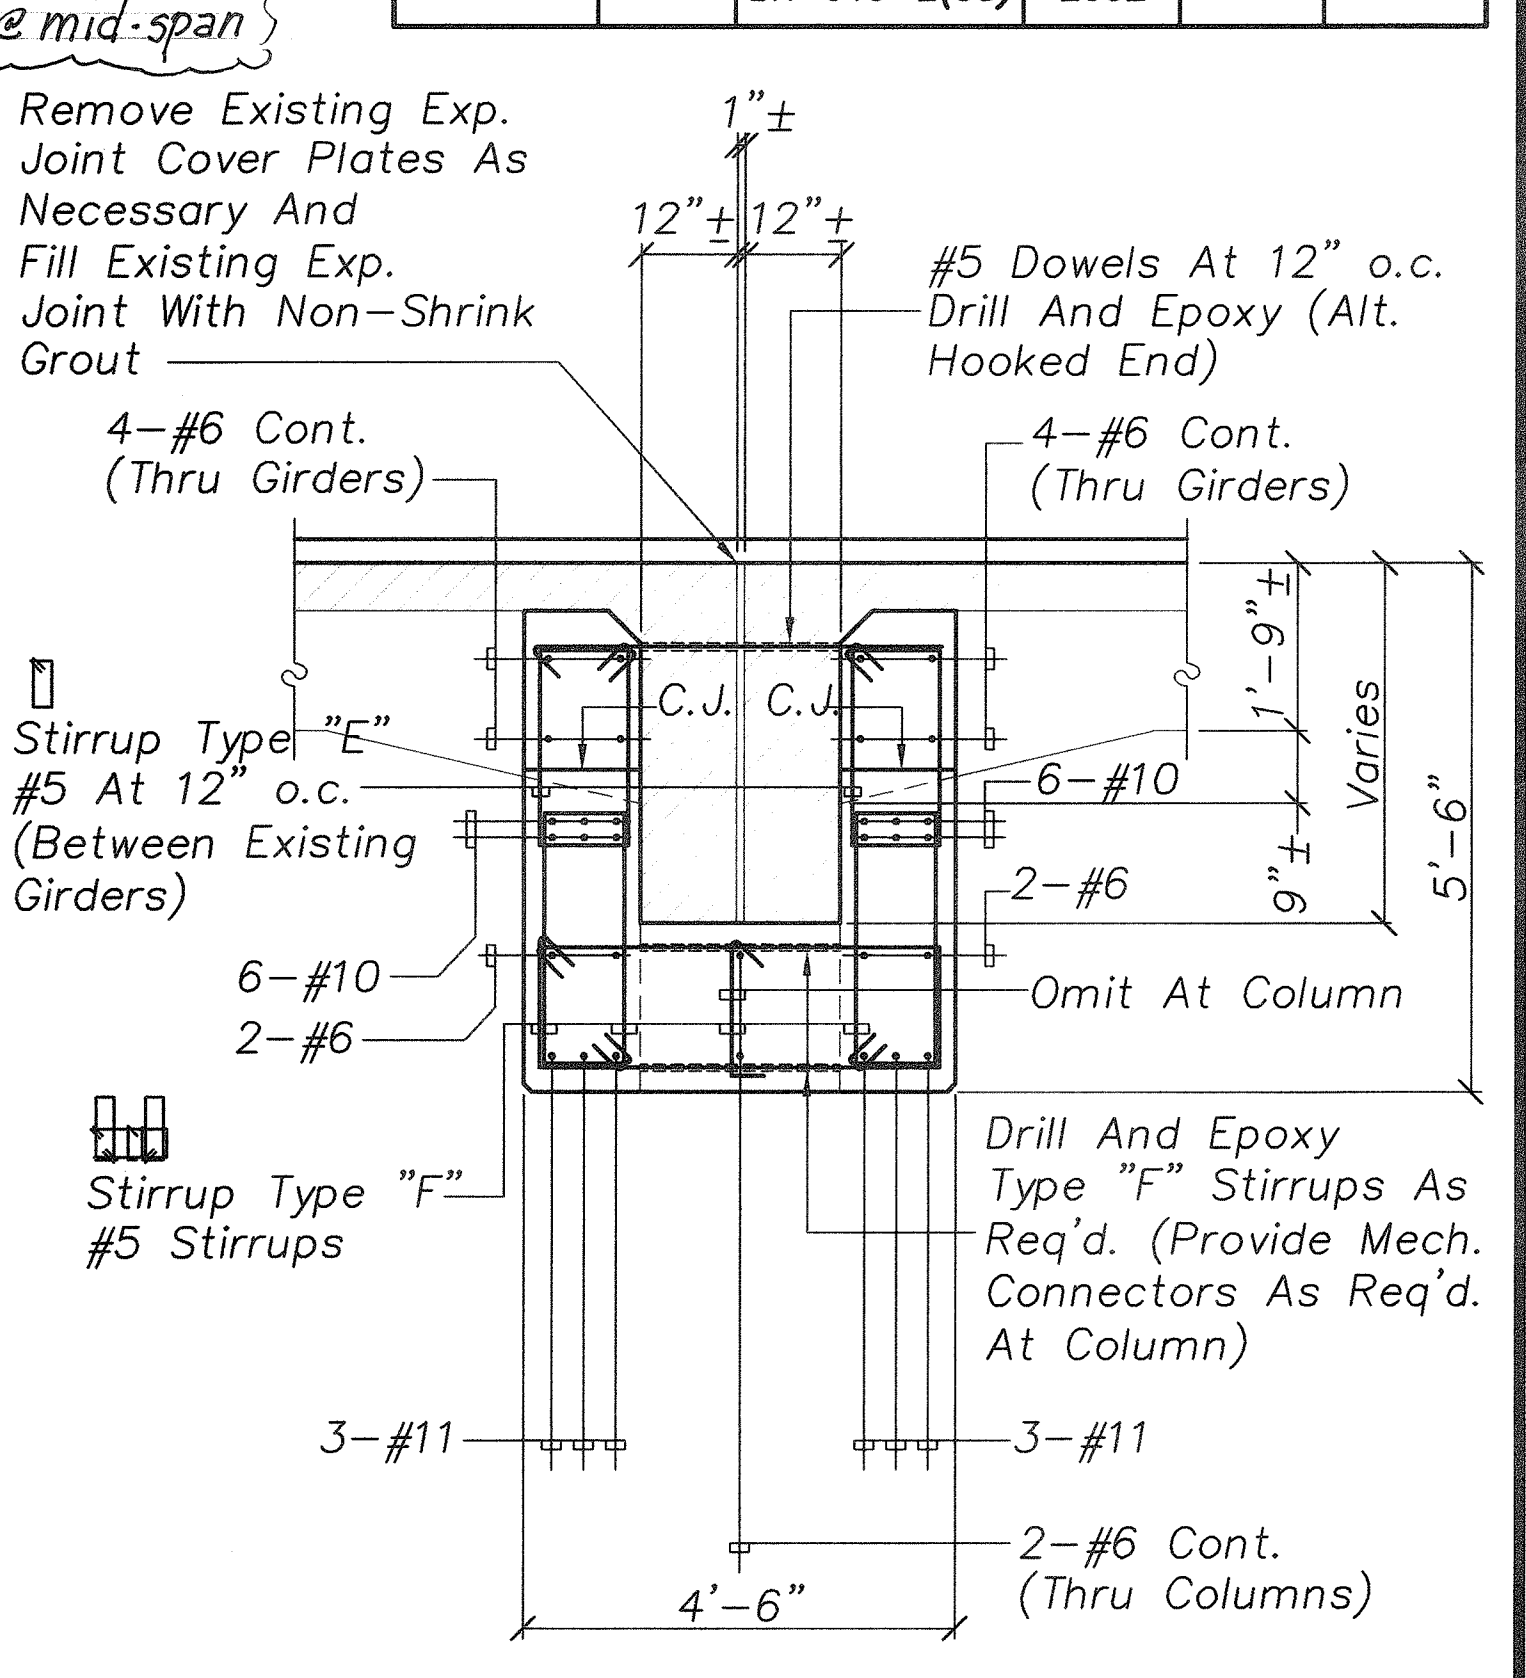


SECTION D
S-21|S-22 Scale: 1/2"=1'-0"

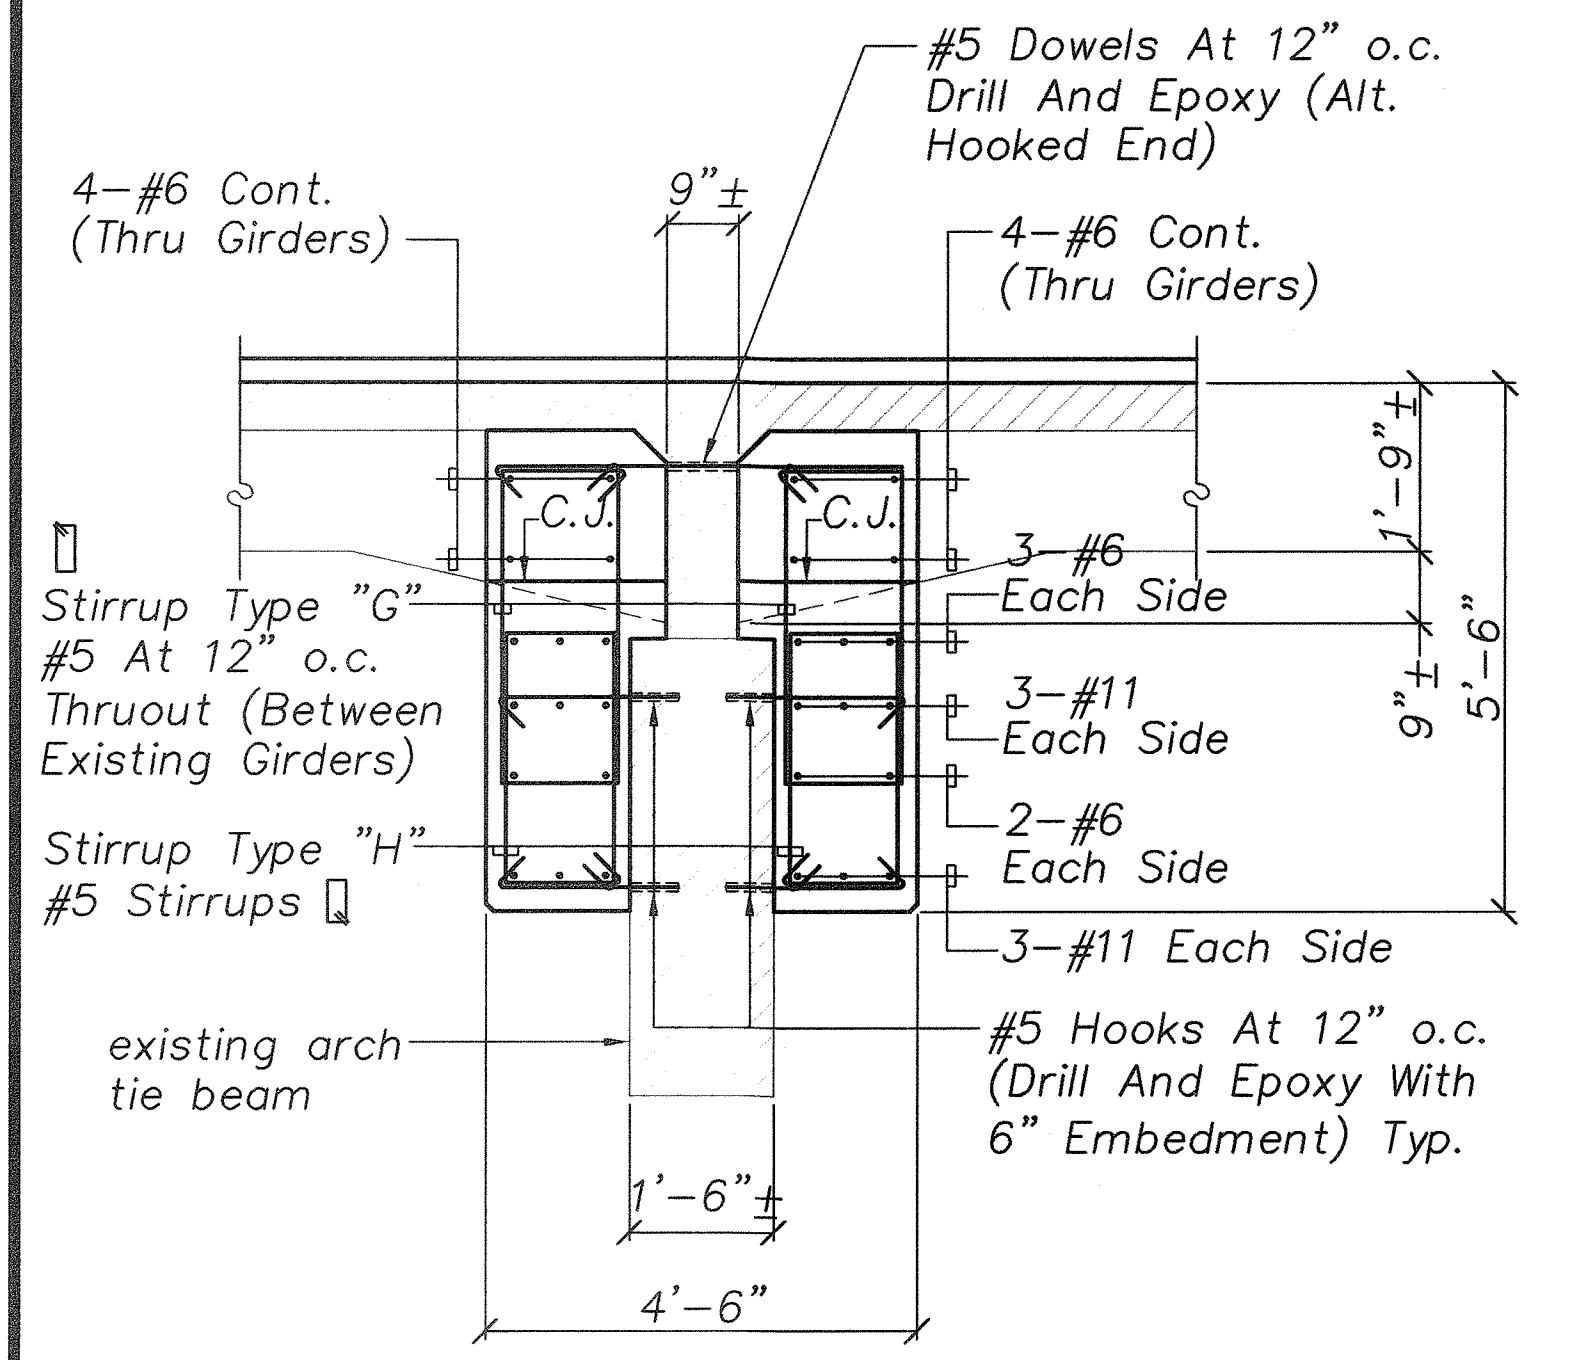


SECTION E
S-21|S-22 Scale: 1/2"=1'-0"

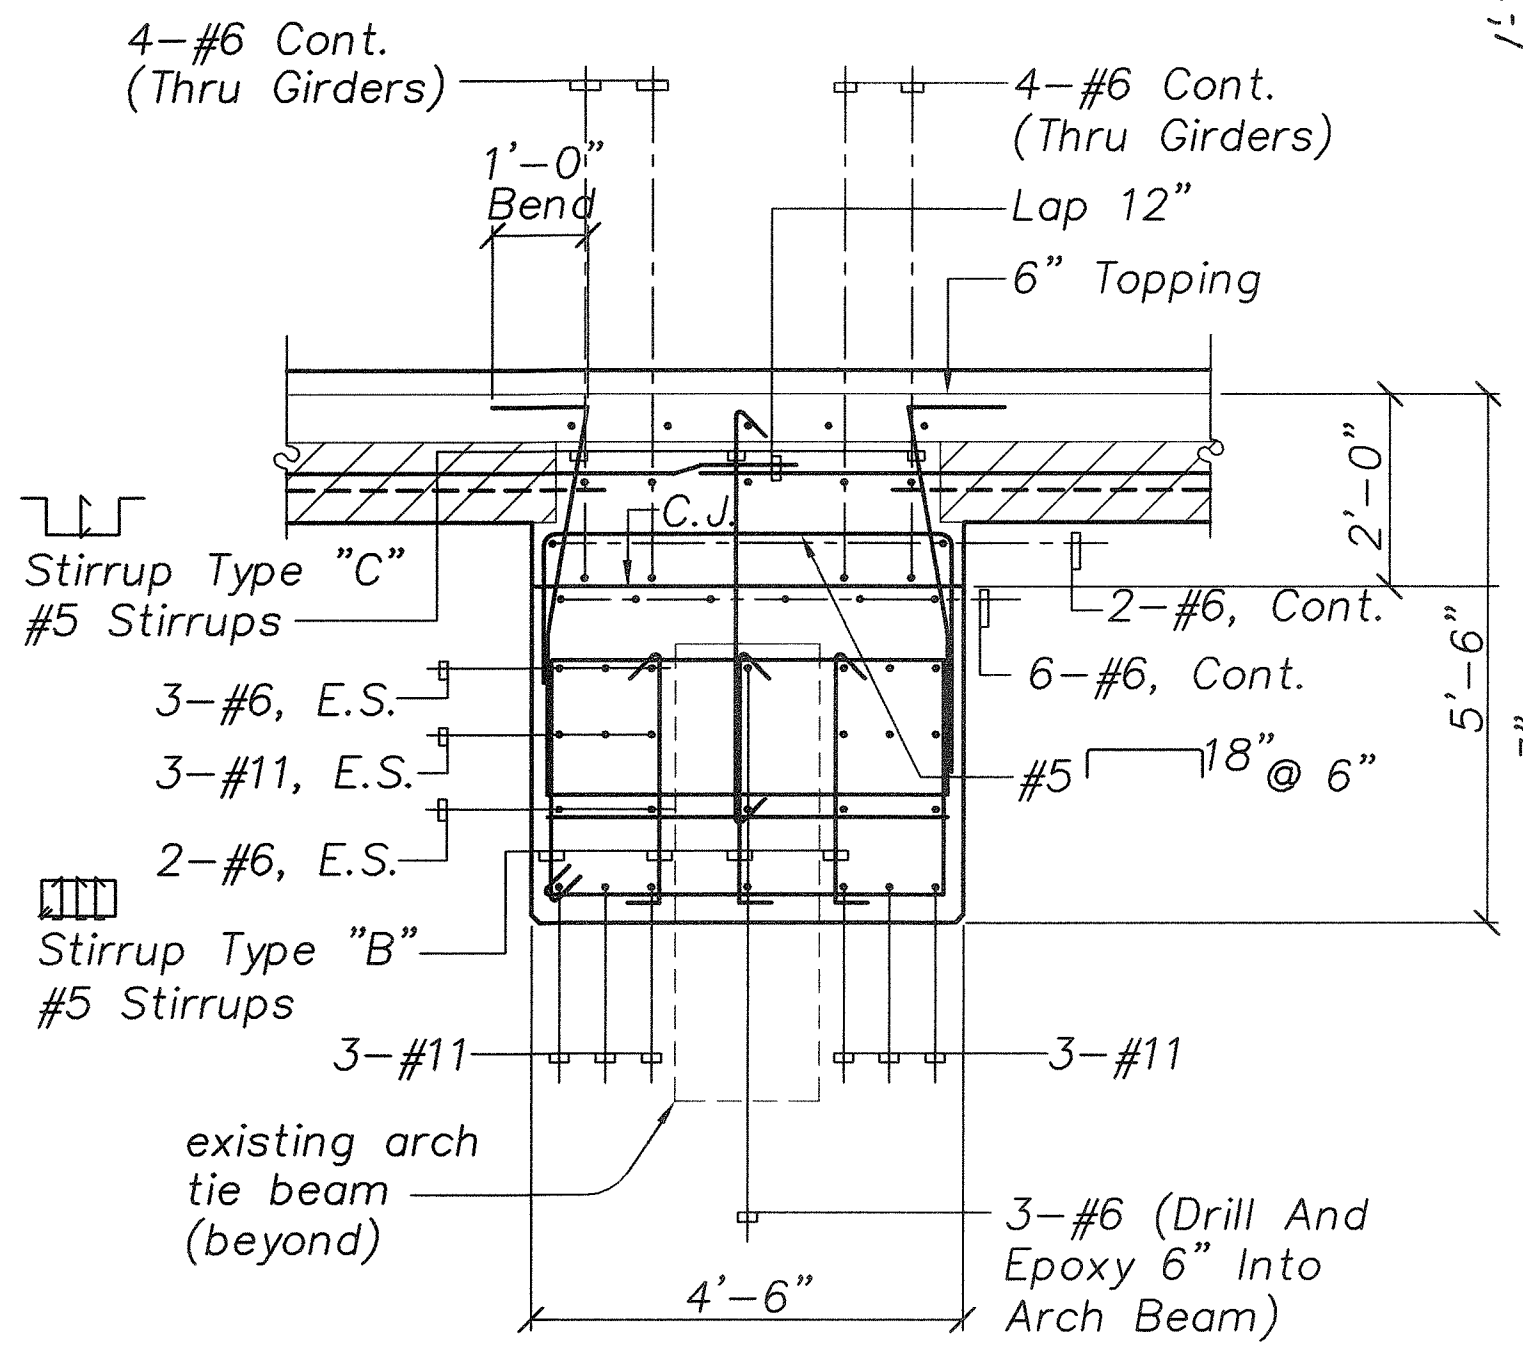


SECTION F
S-21|S-22 Scale: 1/2"=1'-0"

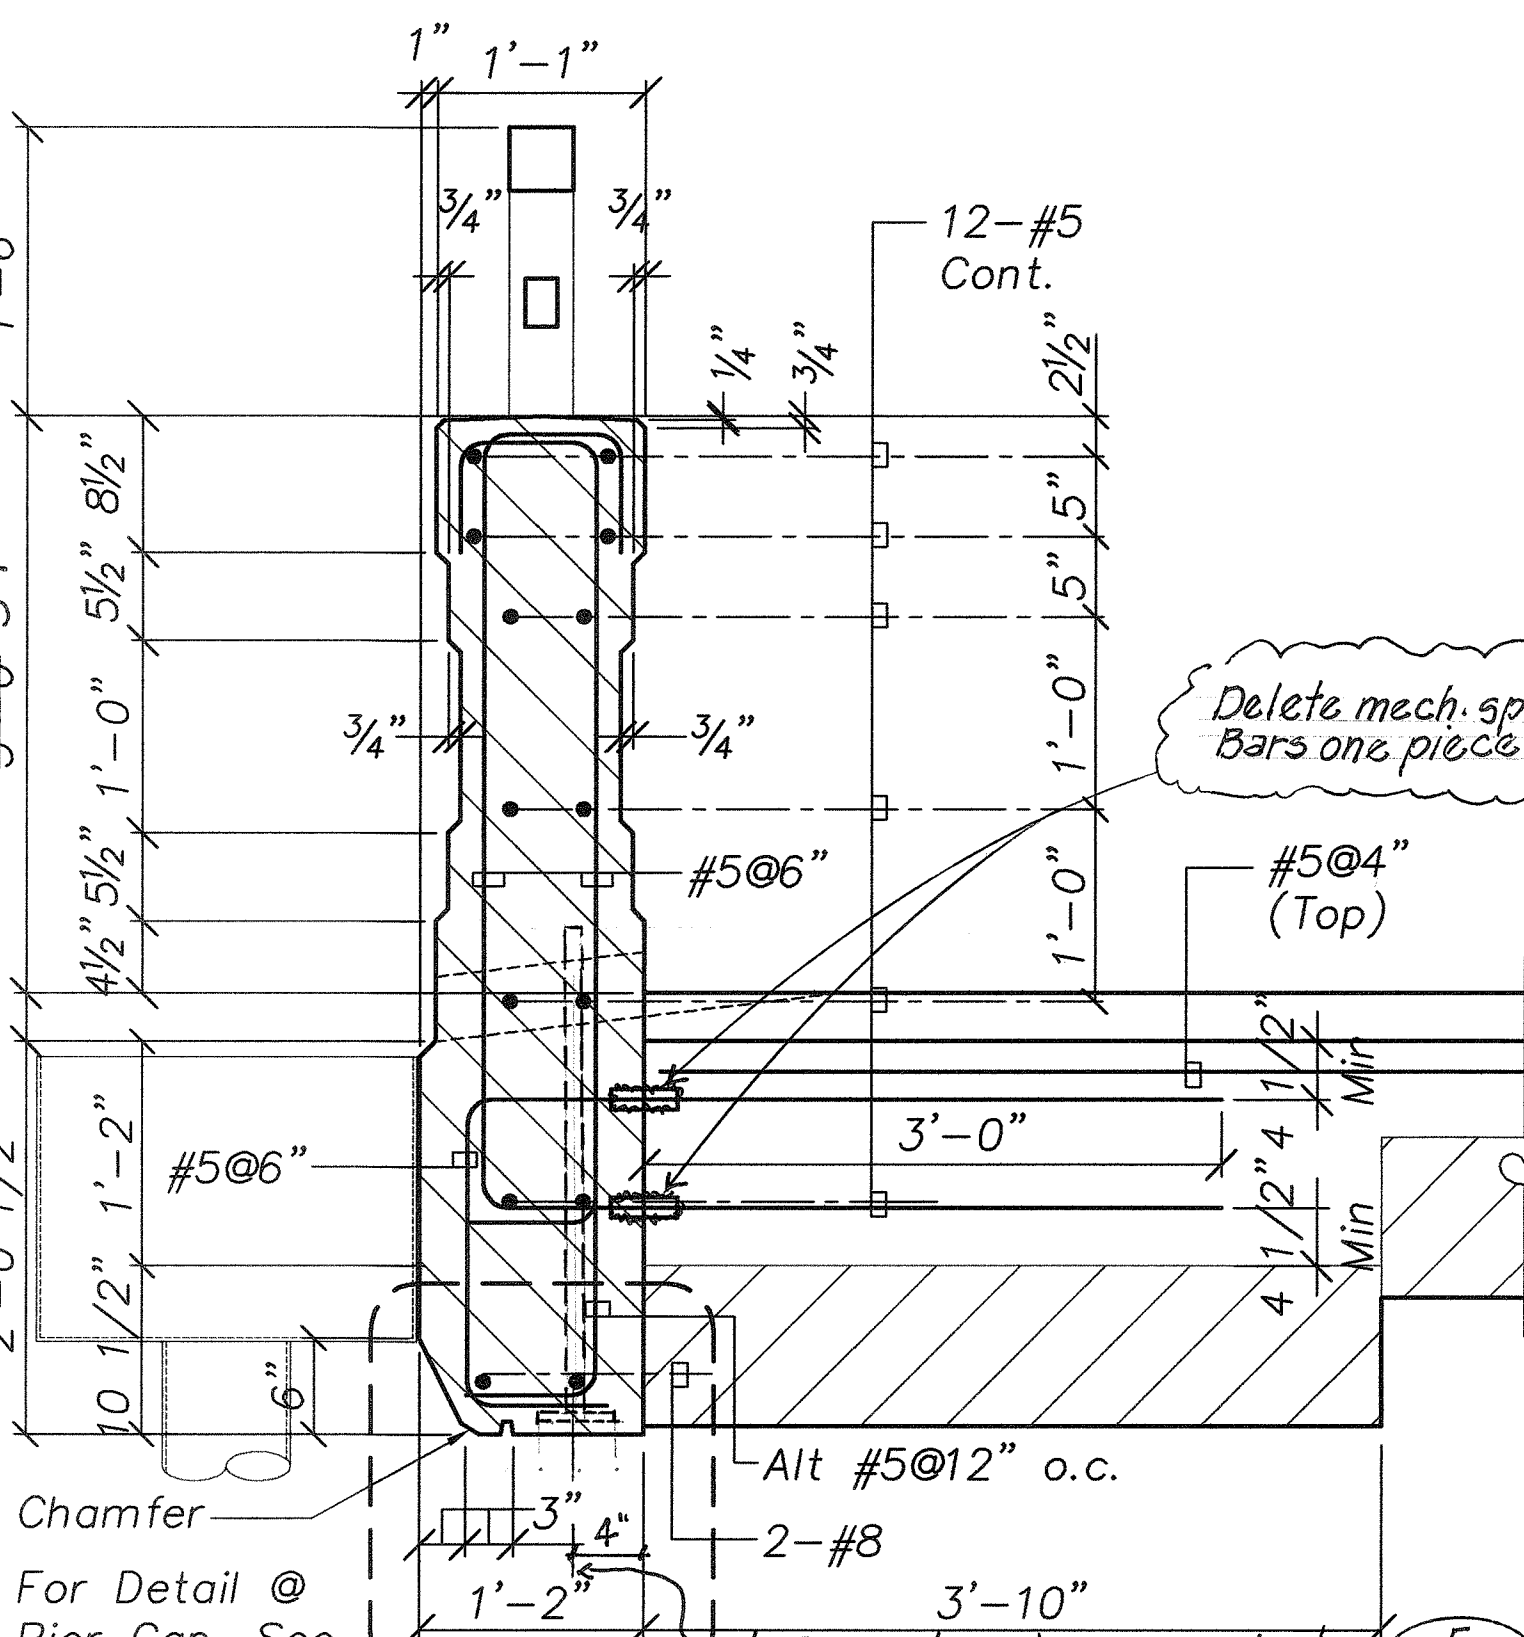

PRECAST CONCRETE PARAPET SECTION
S-20, S-21, S-25|S-22 Scale: 1"=1'-0"

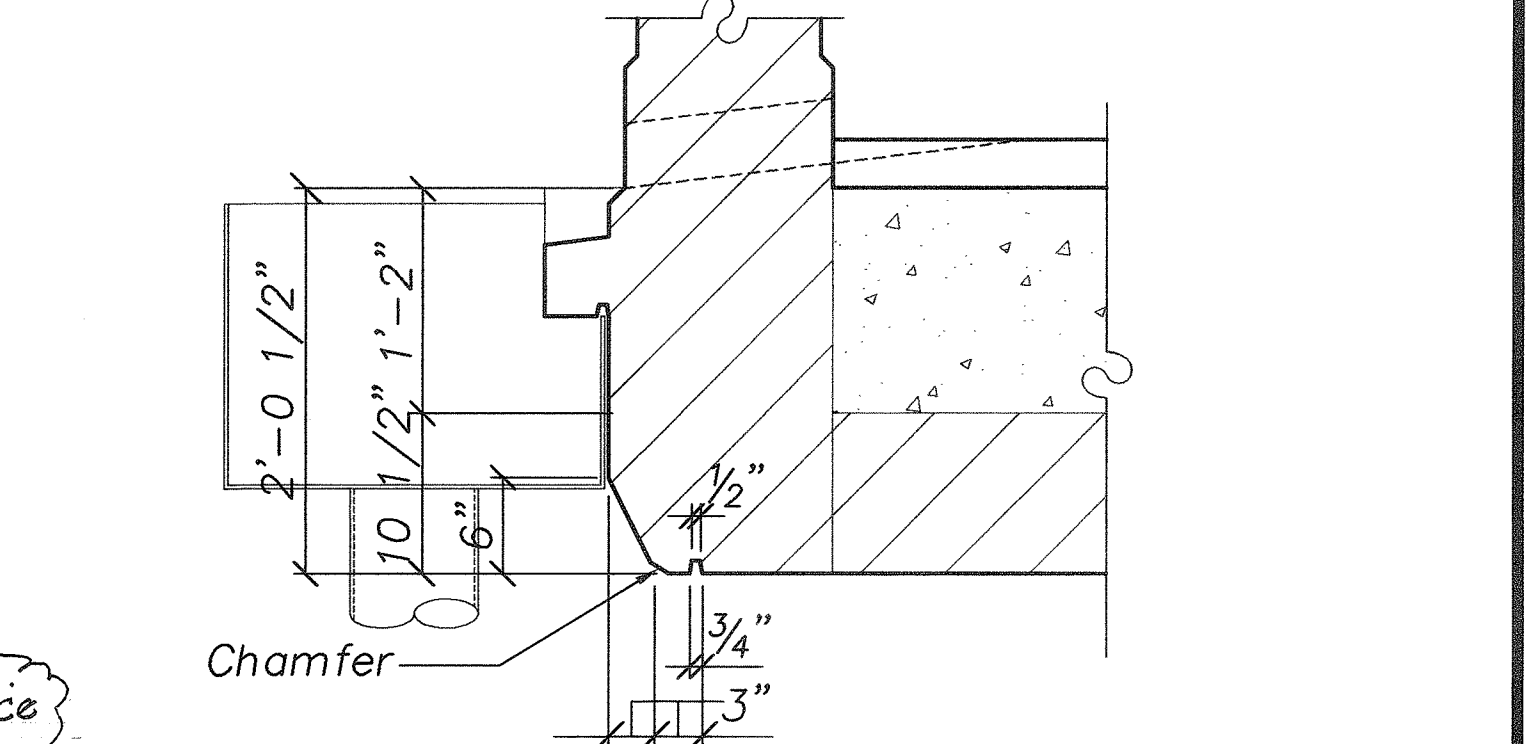


CONT. DRIP DETAIL
S-24, S-22|S-22 Scale: 1"=1'-0"

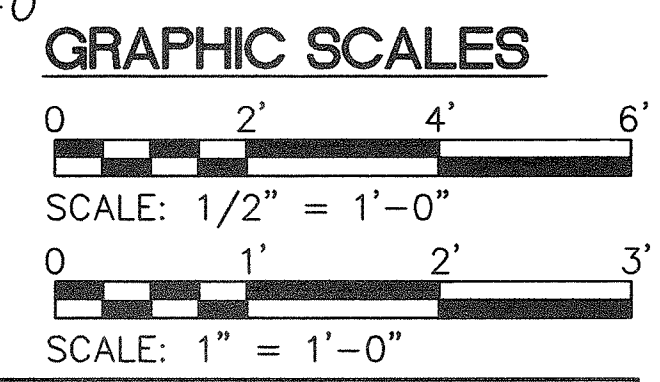

DATE	REVISION

STATE OF HAWAII
DEPARTMENT OF TRANSPORTATION
HIGHWAYS DIVISION
BEAM SECTIONS, CONCRETE PARAPET, AND DRIP DETAIL
HAWAII BELT ROAD
KUPAPULUA BRIDGE WIDENING
HAMAKUA DISTRICT
Federal Aid Project No. BR-019-2(38)
Scale: As Noted Date: June 23, 2003

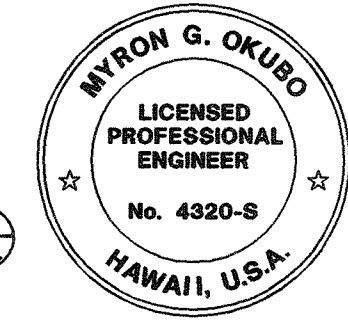



THIS WORK WAS PREPARED BY ME OR UNDER MY SUPERVISION

Myron Okubo

Path: L:\W04\6670-01 Kupapula Bridge\Downsp Filename: S22 Plot date: Sep 25, 2006-07:57:22pm CAD User: skidoni. Xref Filename: | Border | AUTODATE |

Path: L:\MOA\6670-01 Kupaupua Bridge\Downsp File: 623 Plot date: Sep 25, 2006-07:57:47pm CAD User: skidoni. Xref Filename: | Border | AUTODATE |

FED. ROAD DIST. NO.	STATE	FED. AID PROJ. NO.	FISCAL YEAR	SHEET NO.	TOTAL SHEETS
HAWAII	HAW.	BR-019-2(38)	2002	66A	79

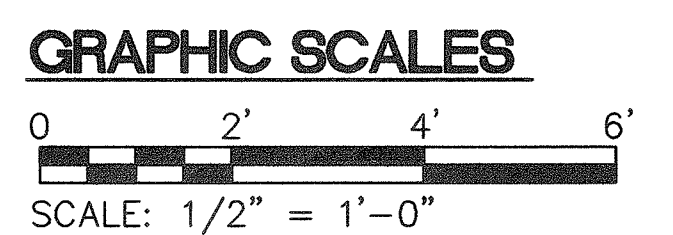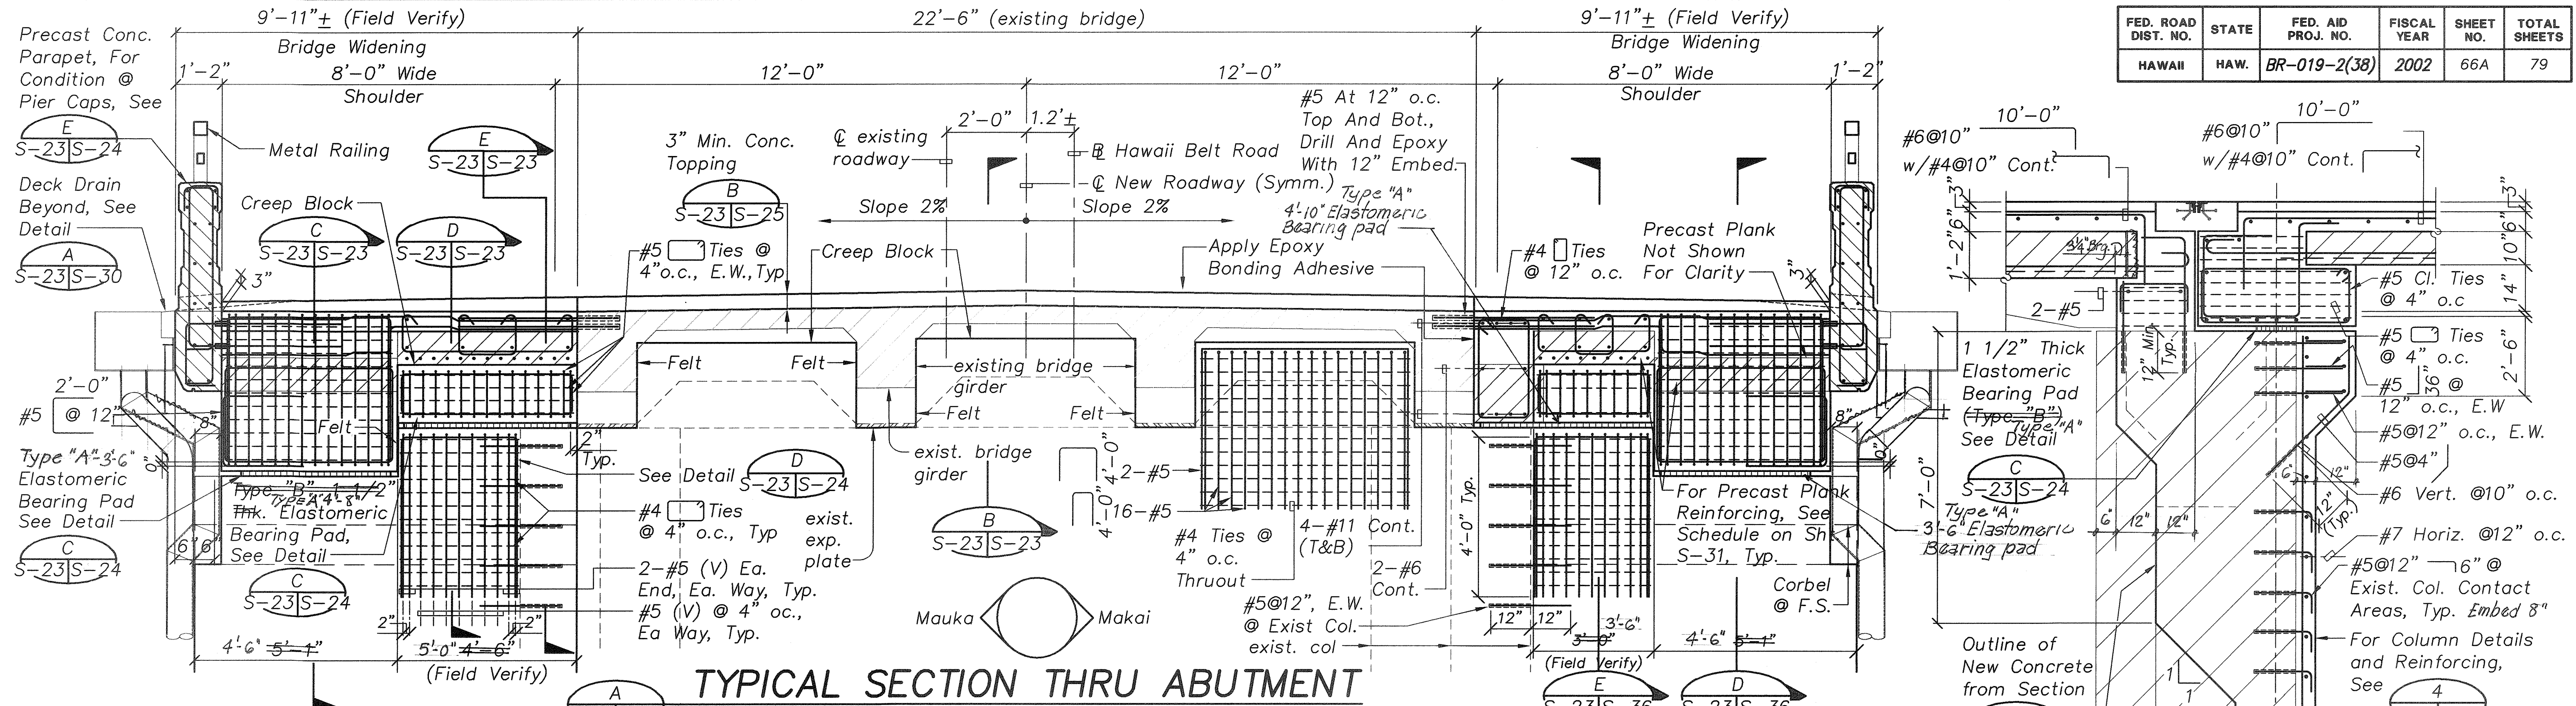

DATE	REVISION

STATE OF HAWAII
DEPARTMENT OF TRANSPORTATION
HIGHWAYS DIVISION
ABUTMENT WALL SECTIONS
HAWAII BELT ROAD
KUPAPAUUA BRIDGE WIDENING
HAMAKUA DISTRICT
Federal Aid Project No. BR-019-2(38)
Scale: As Noted Date: June 23, 2003
SHEET No. S-23 OF 36 SHEETS






THIS WORK WAS PREPARED BY ME OR UNDER MY SUPERVISION

Myron Okubo


SURVEY PLOTTED BY	DATE
DRAWN BY	
TRACED BY	
DESIGNED BY	
QUANTITIES BY	
CHECKED BY	

ORIGINAL PLAN	No.
NOTES	
QUANTITIES	
CHECKED BY	

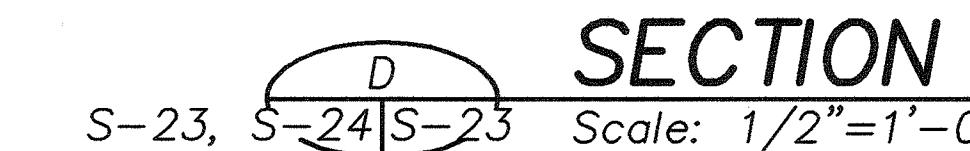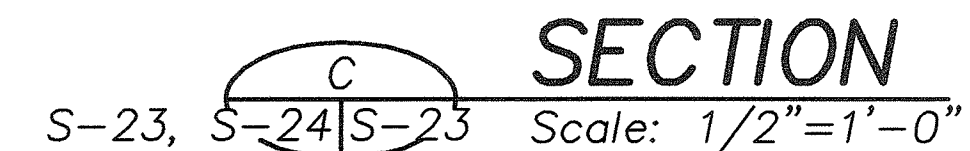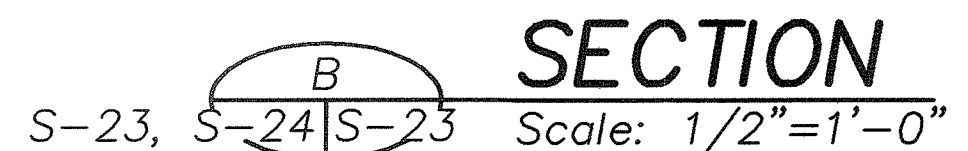


"AS-BUILT"

FED. ROAD DIST. NO.	STATE	FED. AID PROJ. NO.	FISCAL YEAR	SHEET NO.	TOTAL SHEETS
HAWAII	HAW.	BR-019-2(38)	2002	67A	79

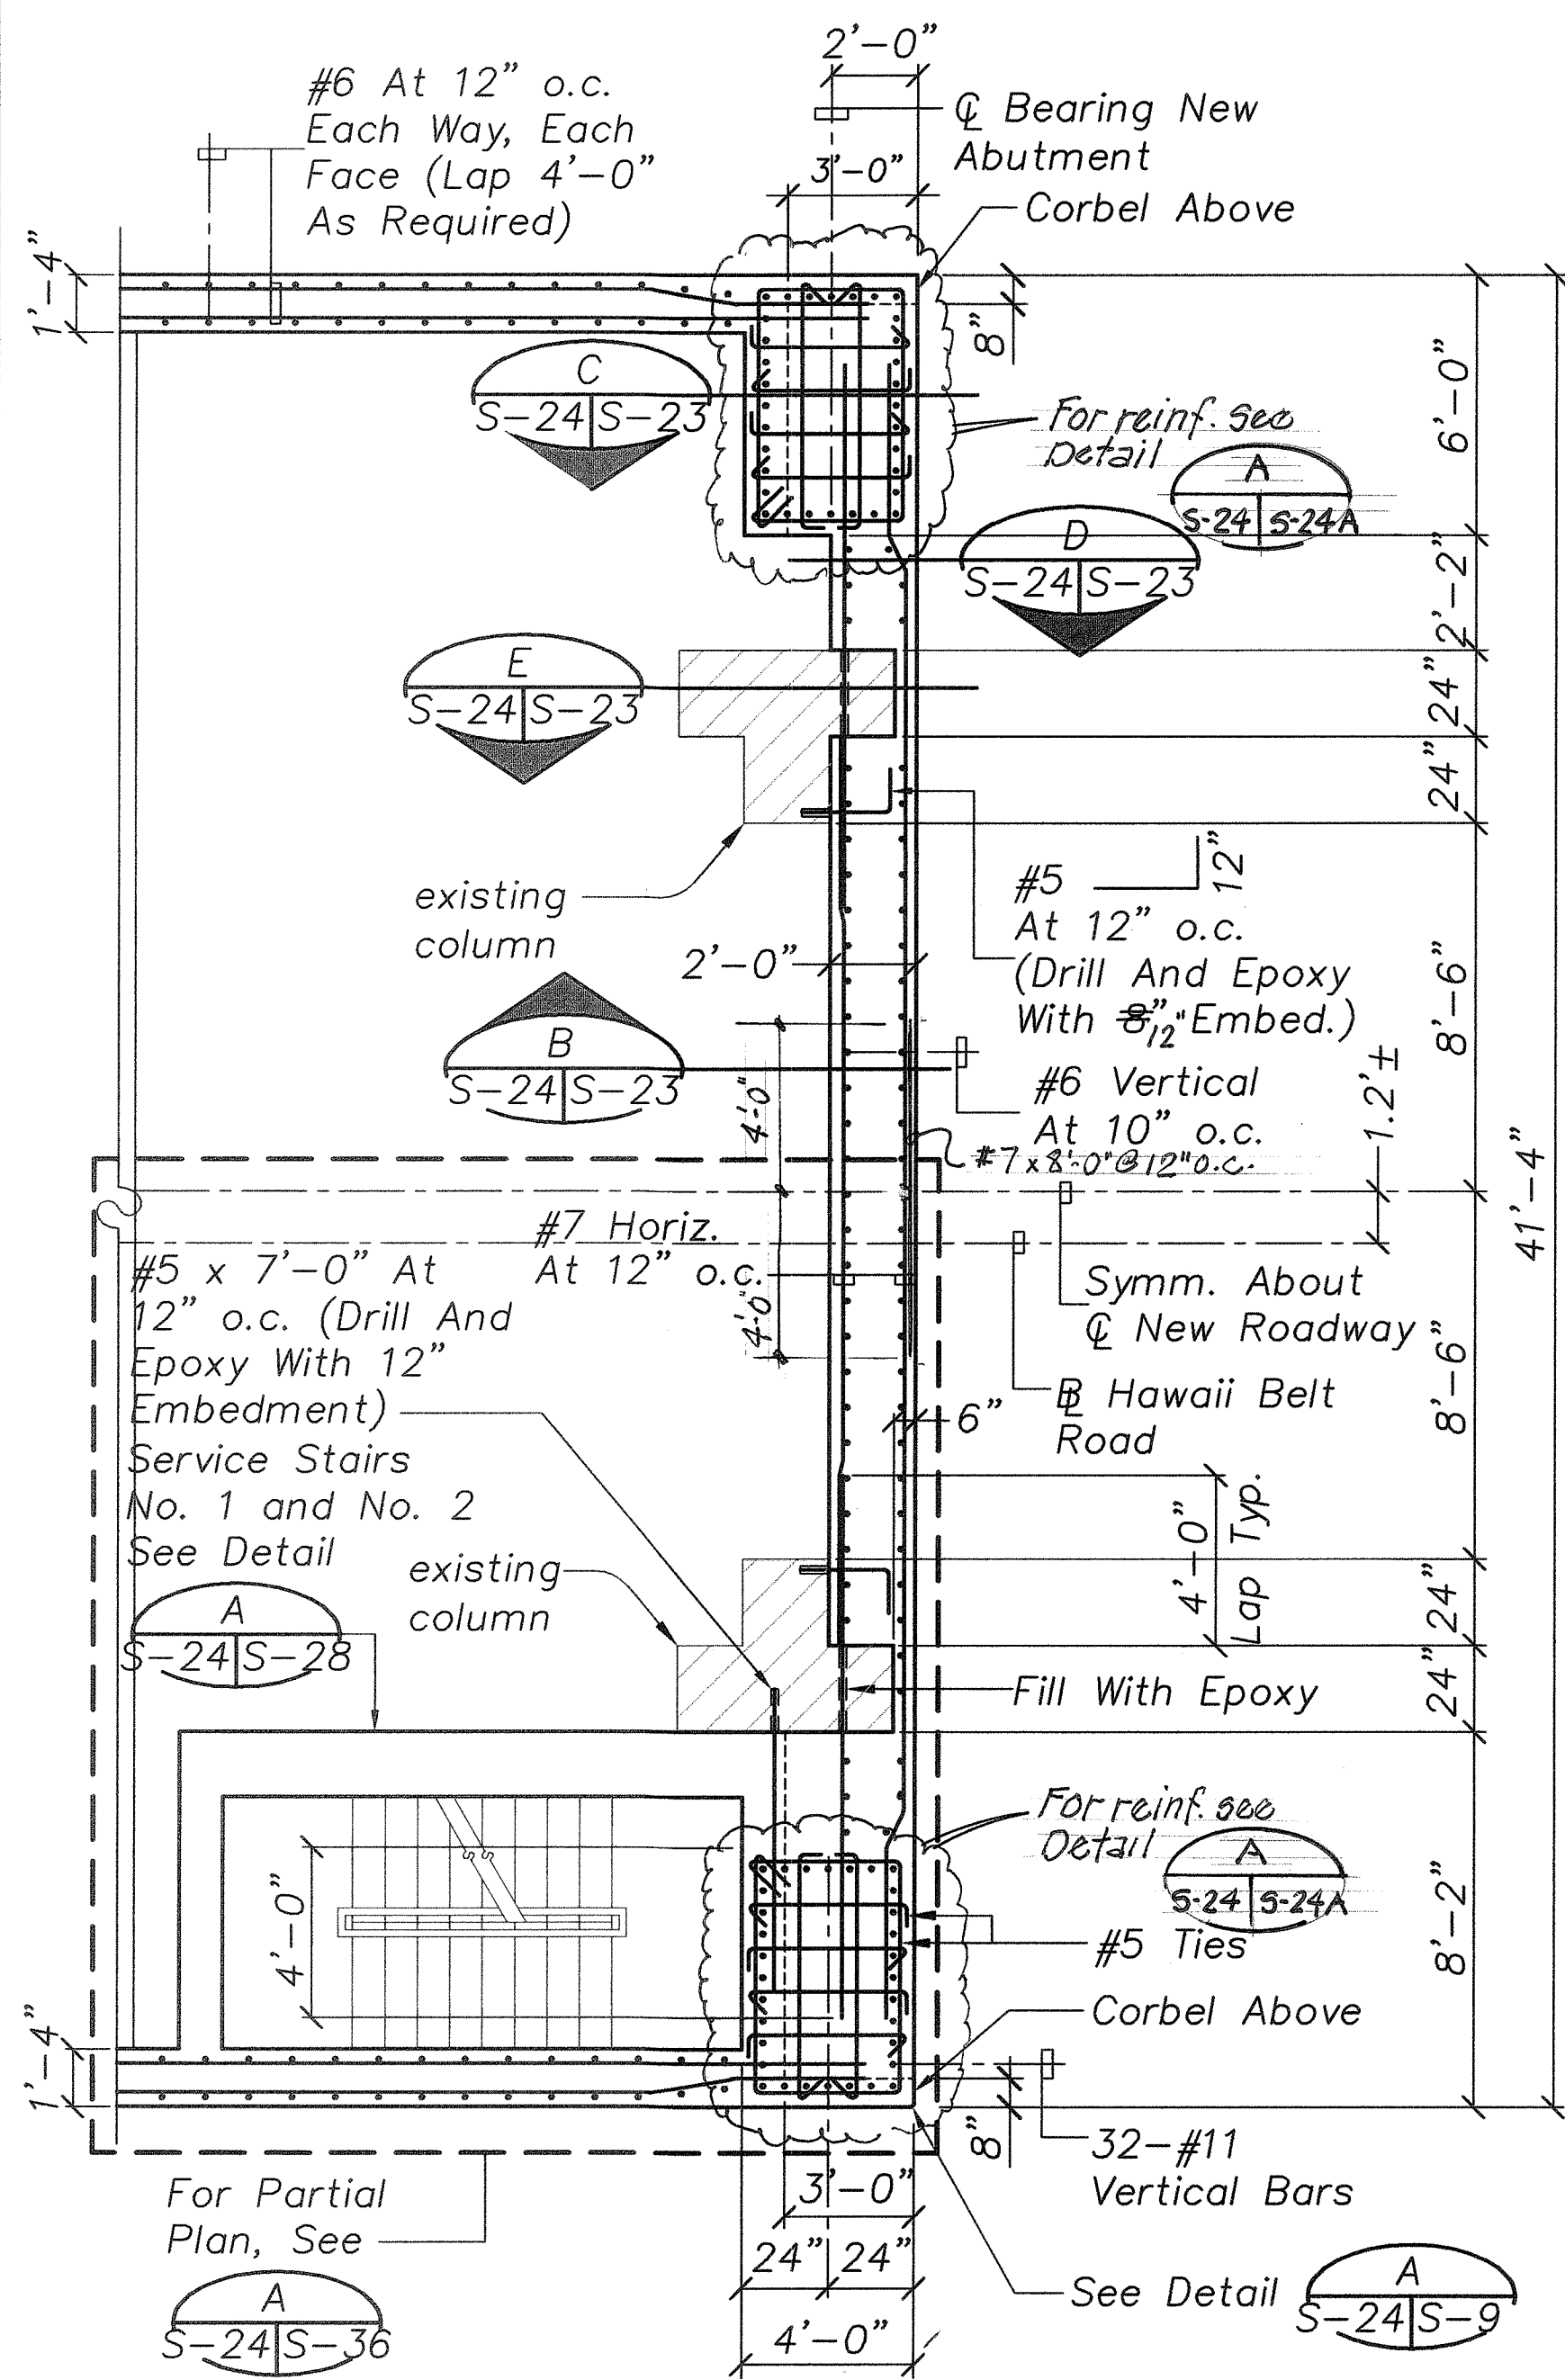


ABUT. WALL SECTION

S-11, S-12, S-14, S-17, S-29, S-24 Scale: 1/4"=1'-0"

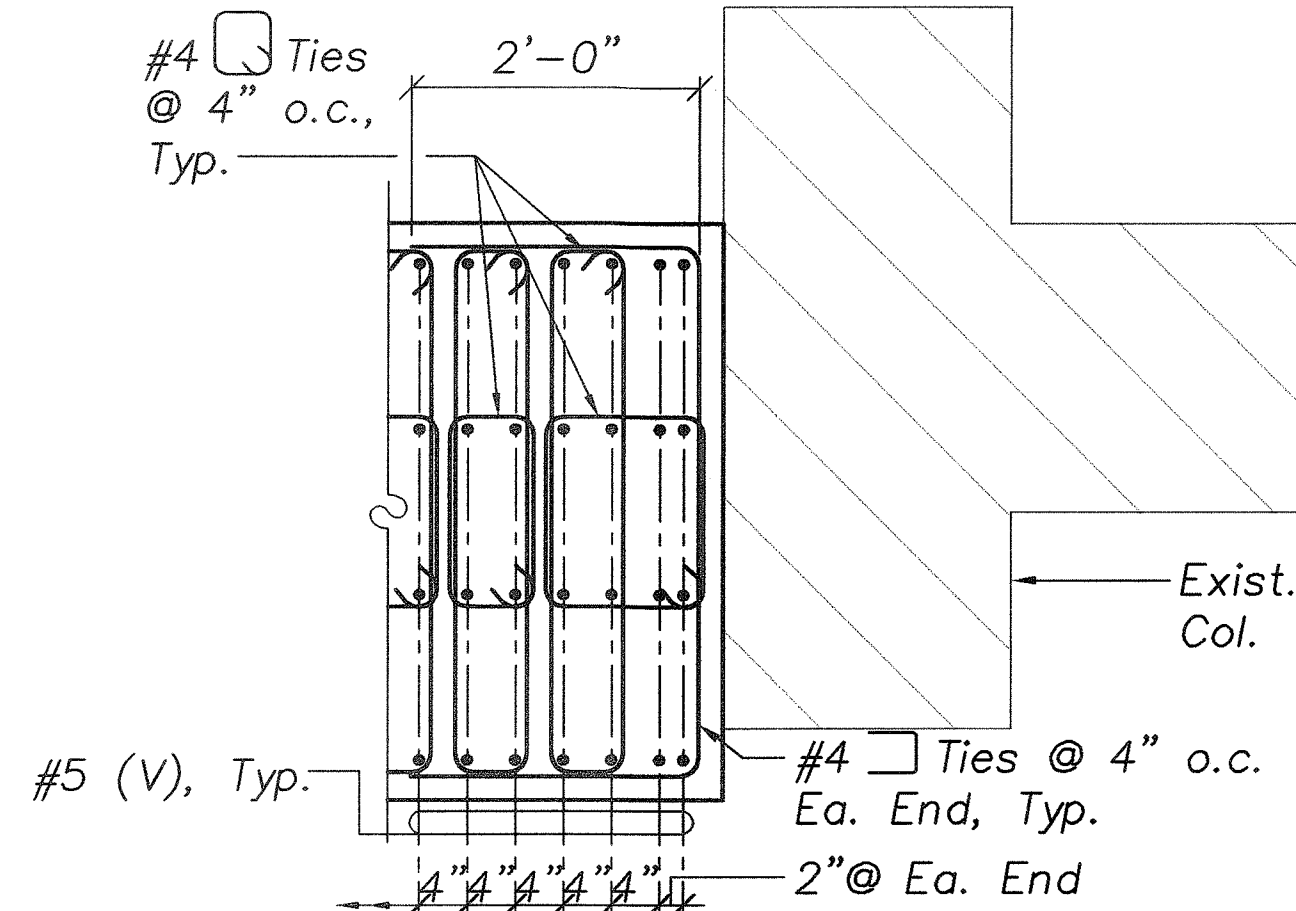

PLAN - DETAIL

S-23, S-24 Scale: 3/4"=1'-0"

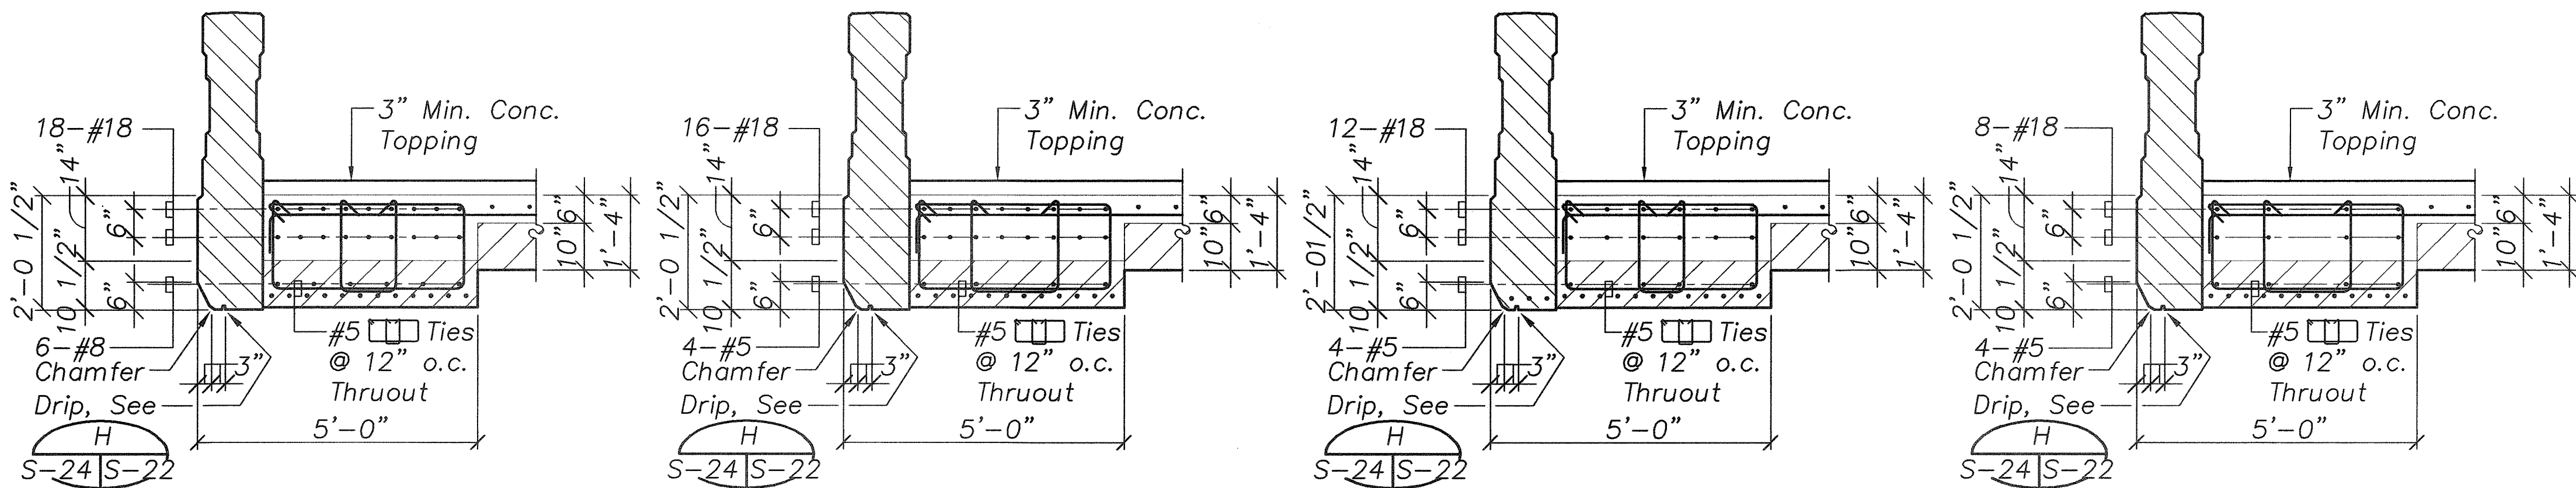

EDGE BEAM EB-1

EDGE BEAM EB-2


EDGE BEAM EB-3

EDGE BEAM EB-4

EDGE BEAM DETAIL

S-20, S-24 Scale: 1/2"=1'-0"

Note:
Refer To Section C/S-22 For Stop Location
Of #18 Bars That Do Not Continue.

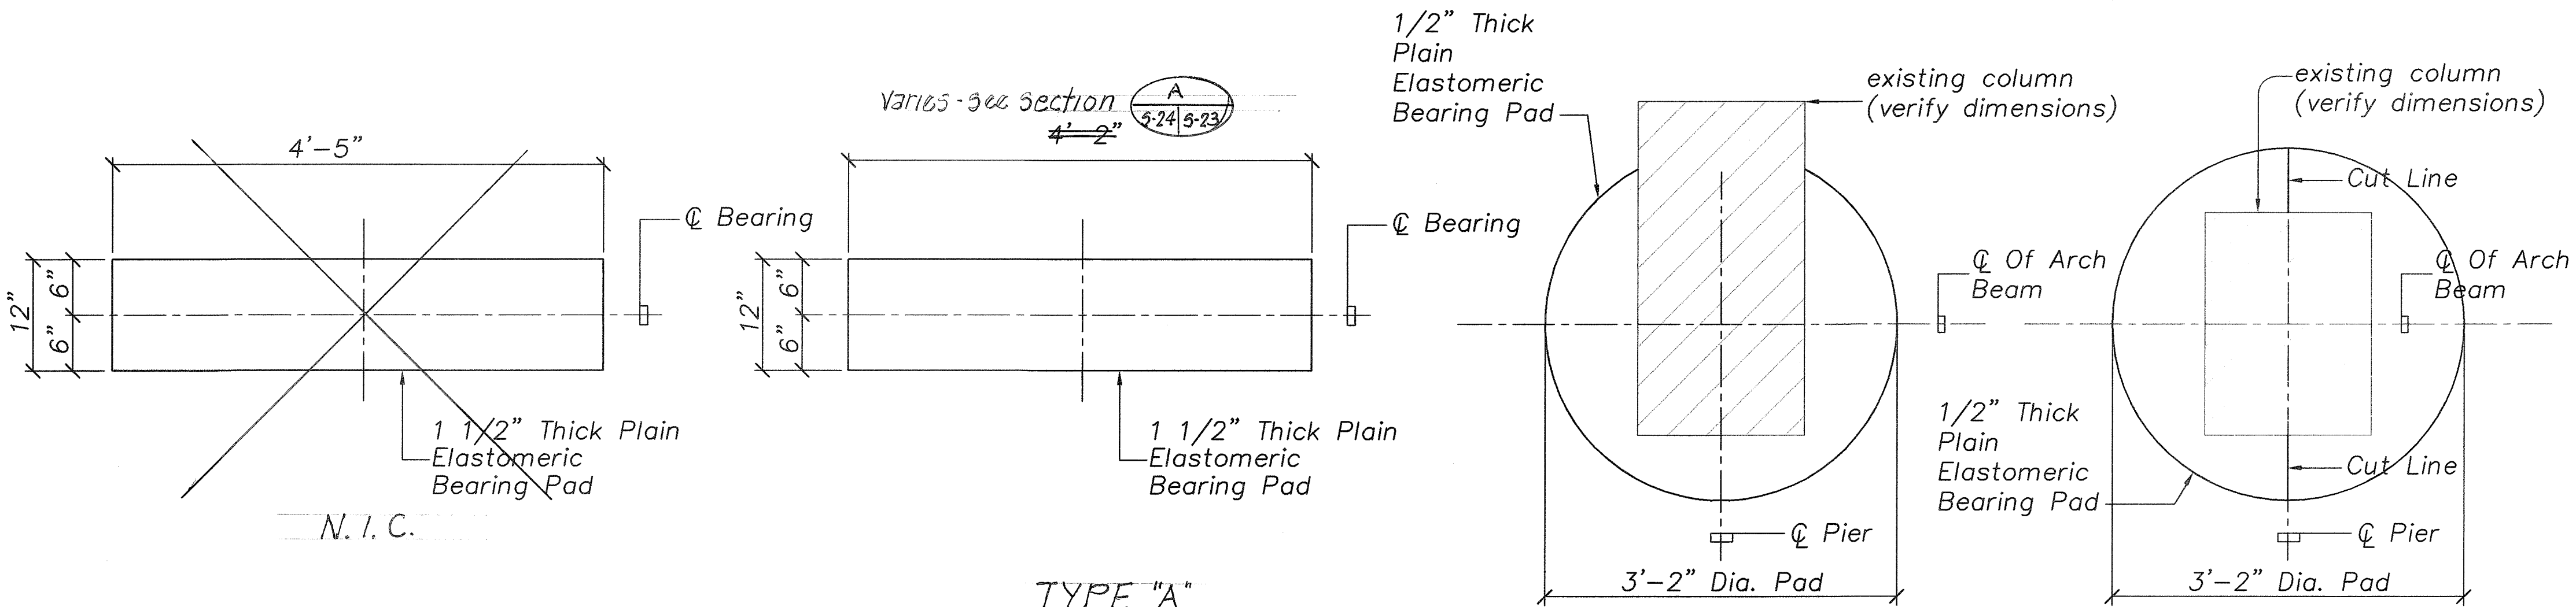



TYPE "A"

TYPE "B"

TYPE "C"

TYPE "D"

GRAPHIC SCALES

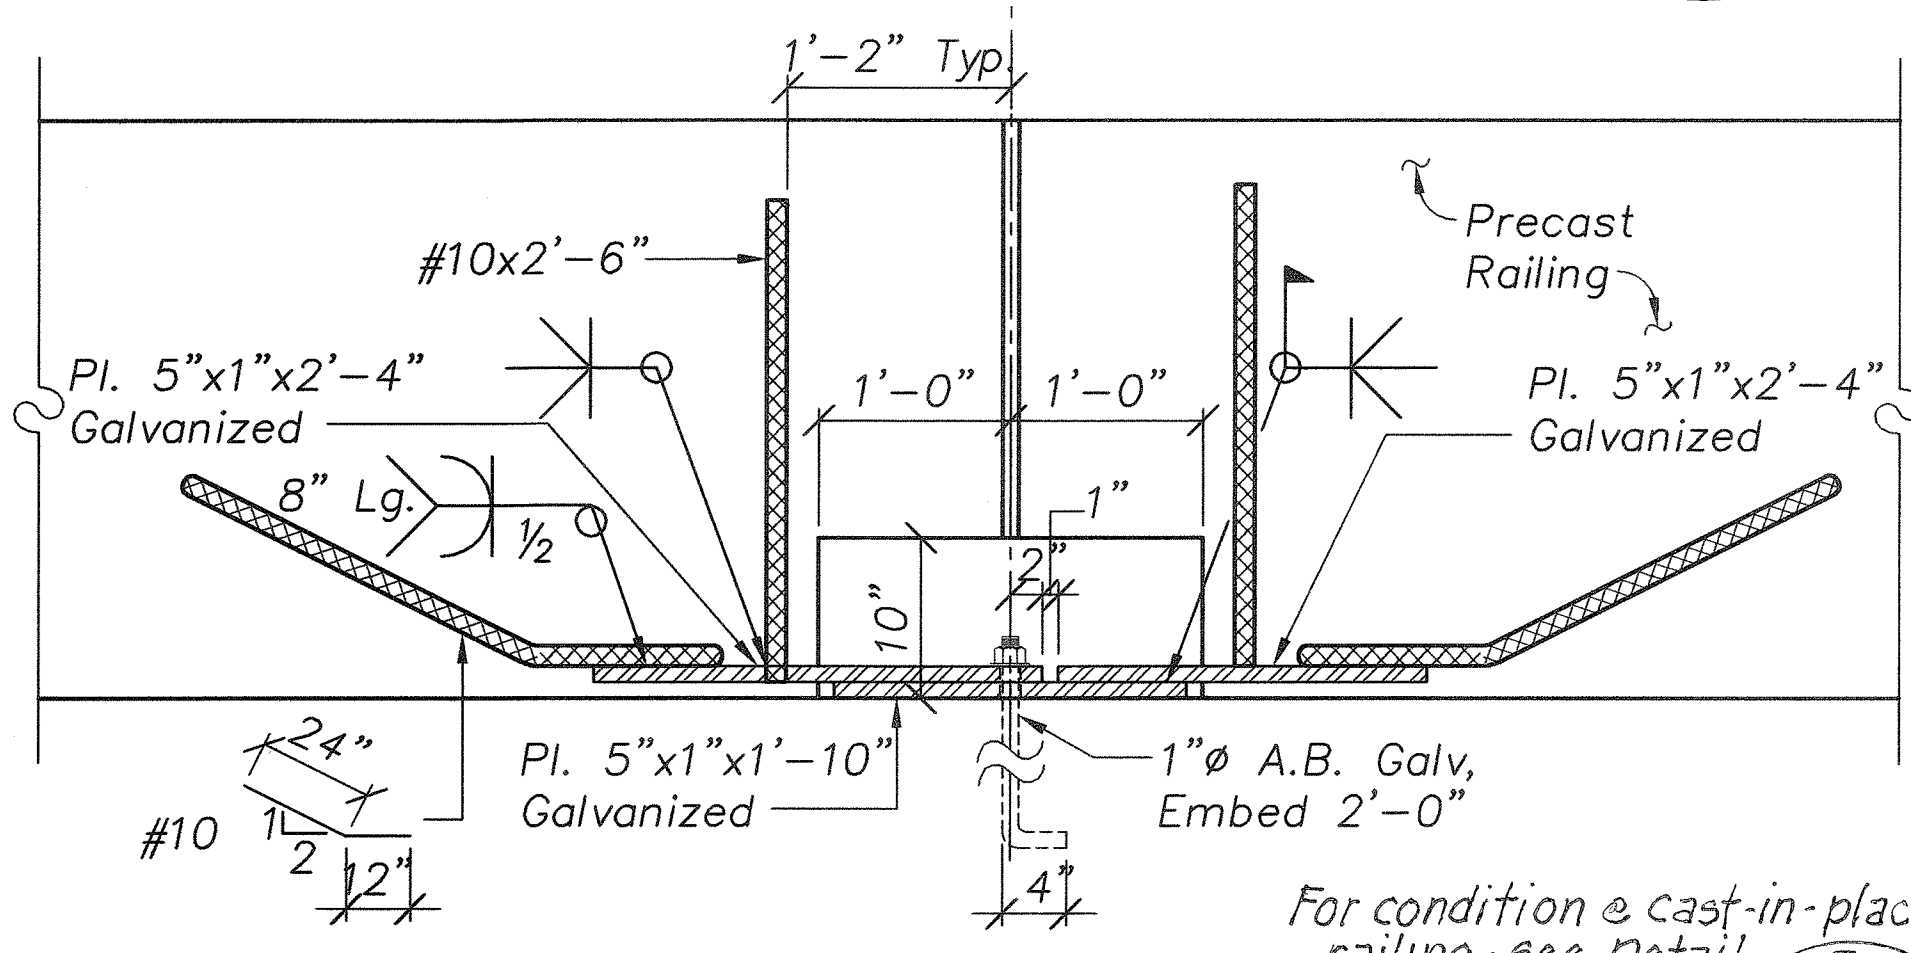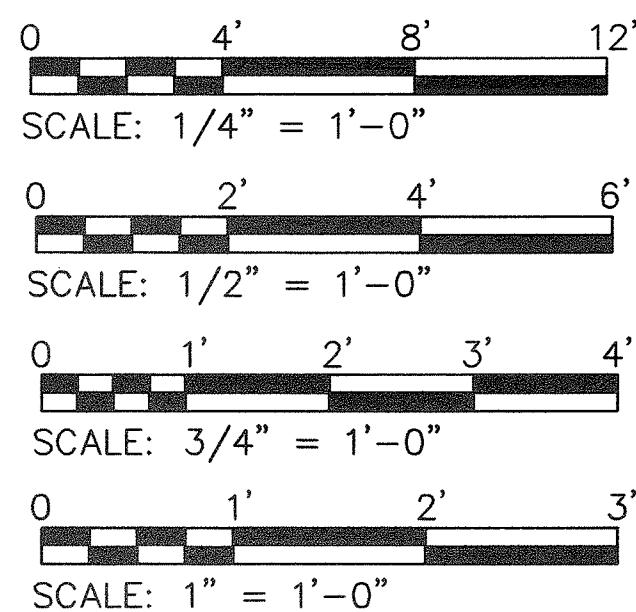


DETAIL

S-23, S-24 Scale: 1"=1'-0"

ELASTOMERIC BEARING PAD DETAILS

S-17, S-21, S-23, S-24 Scale: 1"=1'-0"

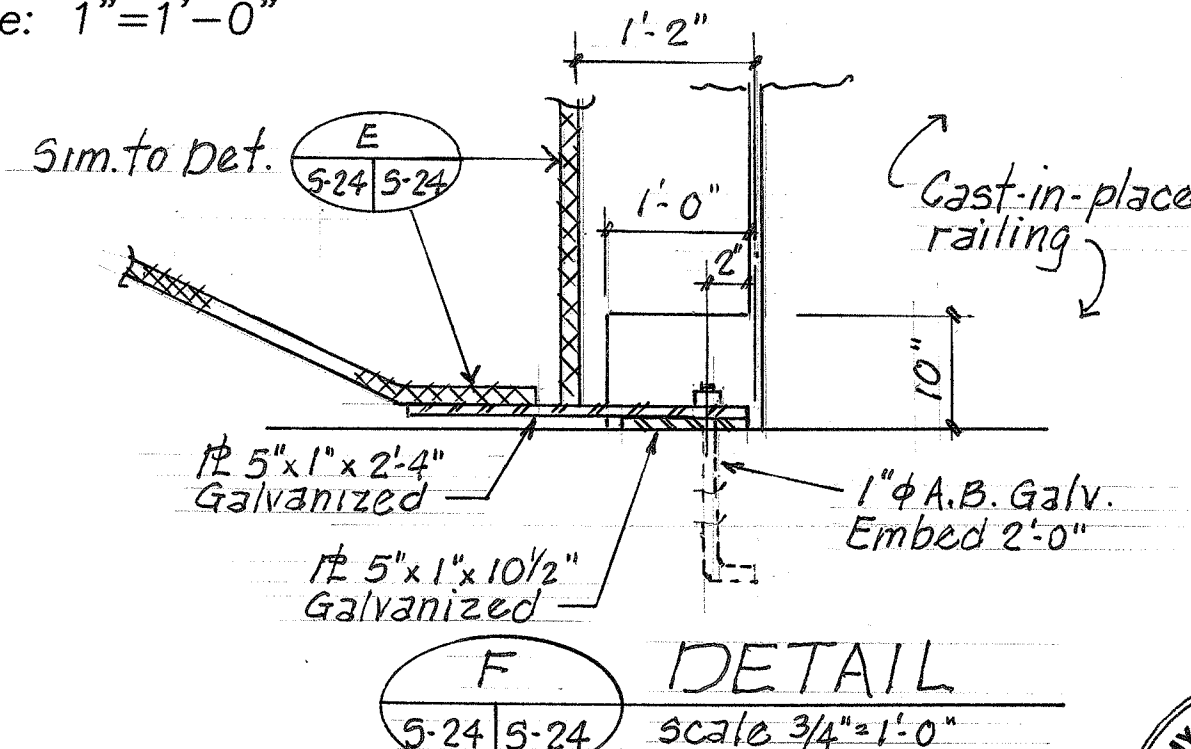

DETAIL

S-24, S-24 Scale: 3/4"=1'-0"

NOTE:

1. Welded Reinforcing Steel Shall Conform to ASTM A706.
2. Patch Opening after Attaching Precast Railings to Deck.




THIS WORK WAS PREPARED BY ME OR UNDER MY SUPERVISION

Myron Okuro


DATE	REVISION
STATE OF HAWAII DEPARTMENT OF TRANSPORTATION HIGHWAYS DIVISION	
ABUT. WALL SECTION, EDGE BEAM DETAILS & ELASTIMERIC BEARING PAD DETAILS	
HAWAII BELT ROAD KUPAPULUA BRIDGE WIDENING HAMAKUA DISTRICT	
Federal Aid Project No. BR-019-2(38)	
Scale: As Noted	Date: June 23, 2003
SHEET No. S-24 OF 36 SHEETS	

FED. ROAD DIST. NO.	STATE	FED. AID PROJ. NO.	FISCAL YEAR	SHEET NO.	TOTAL SHEETS
HAWAII	HAW.	BR-019-2(38)	2002	67A S-1	79

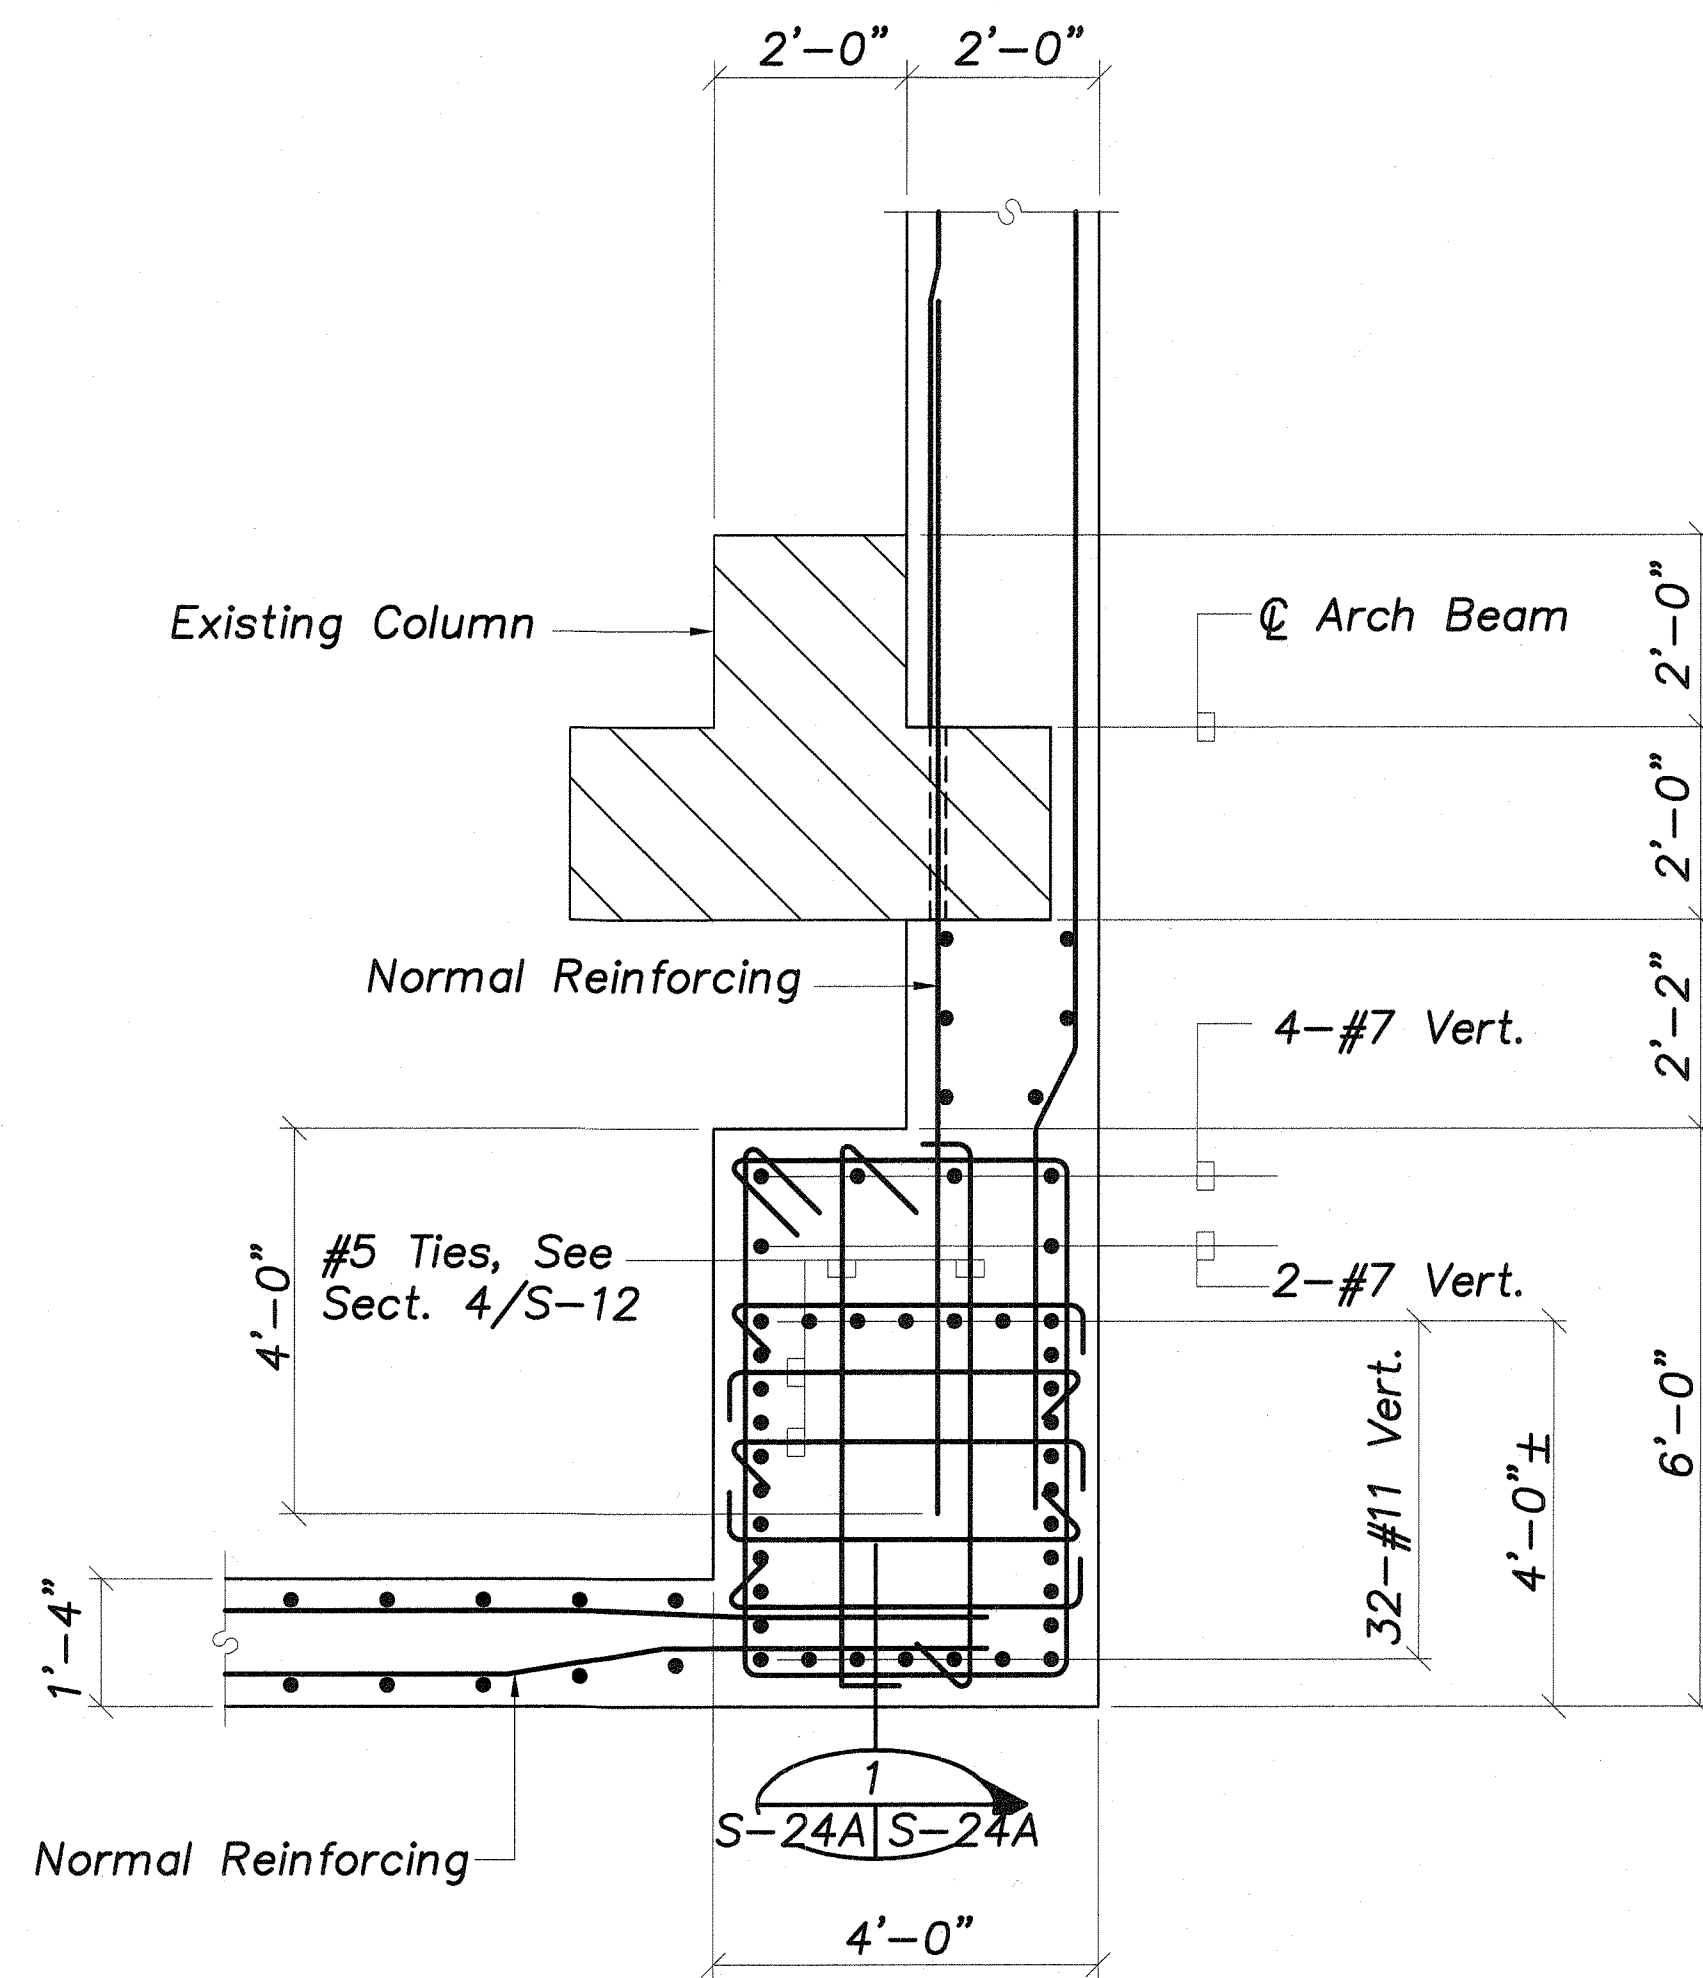

PARTIAL ABUTMENT PLAN/SECTION
SHOWING REVISED REINF. AT CORNER COL.


S-24A A S-24A Scale: 1/2"=1'-0"

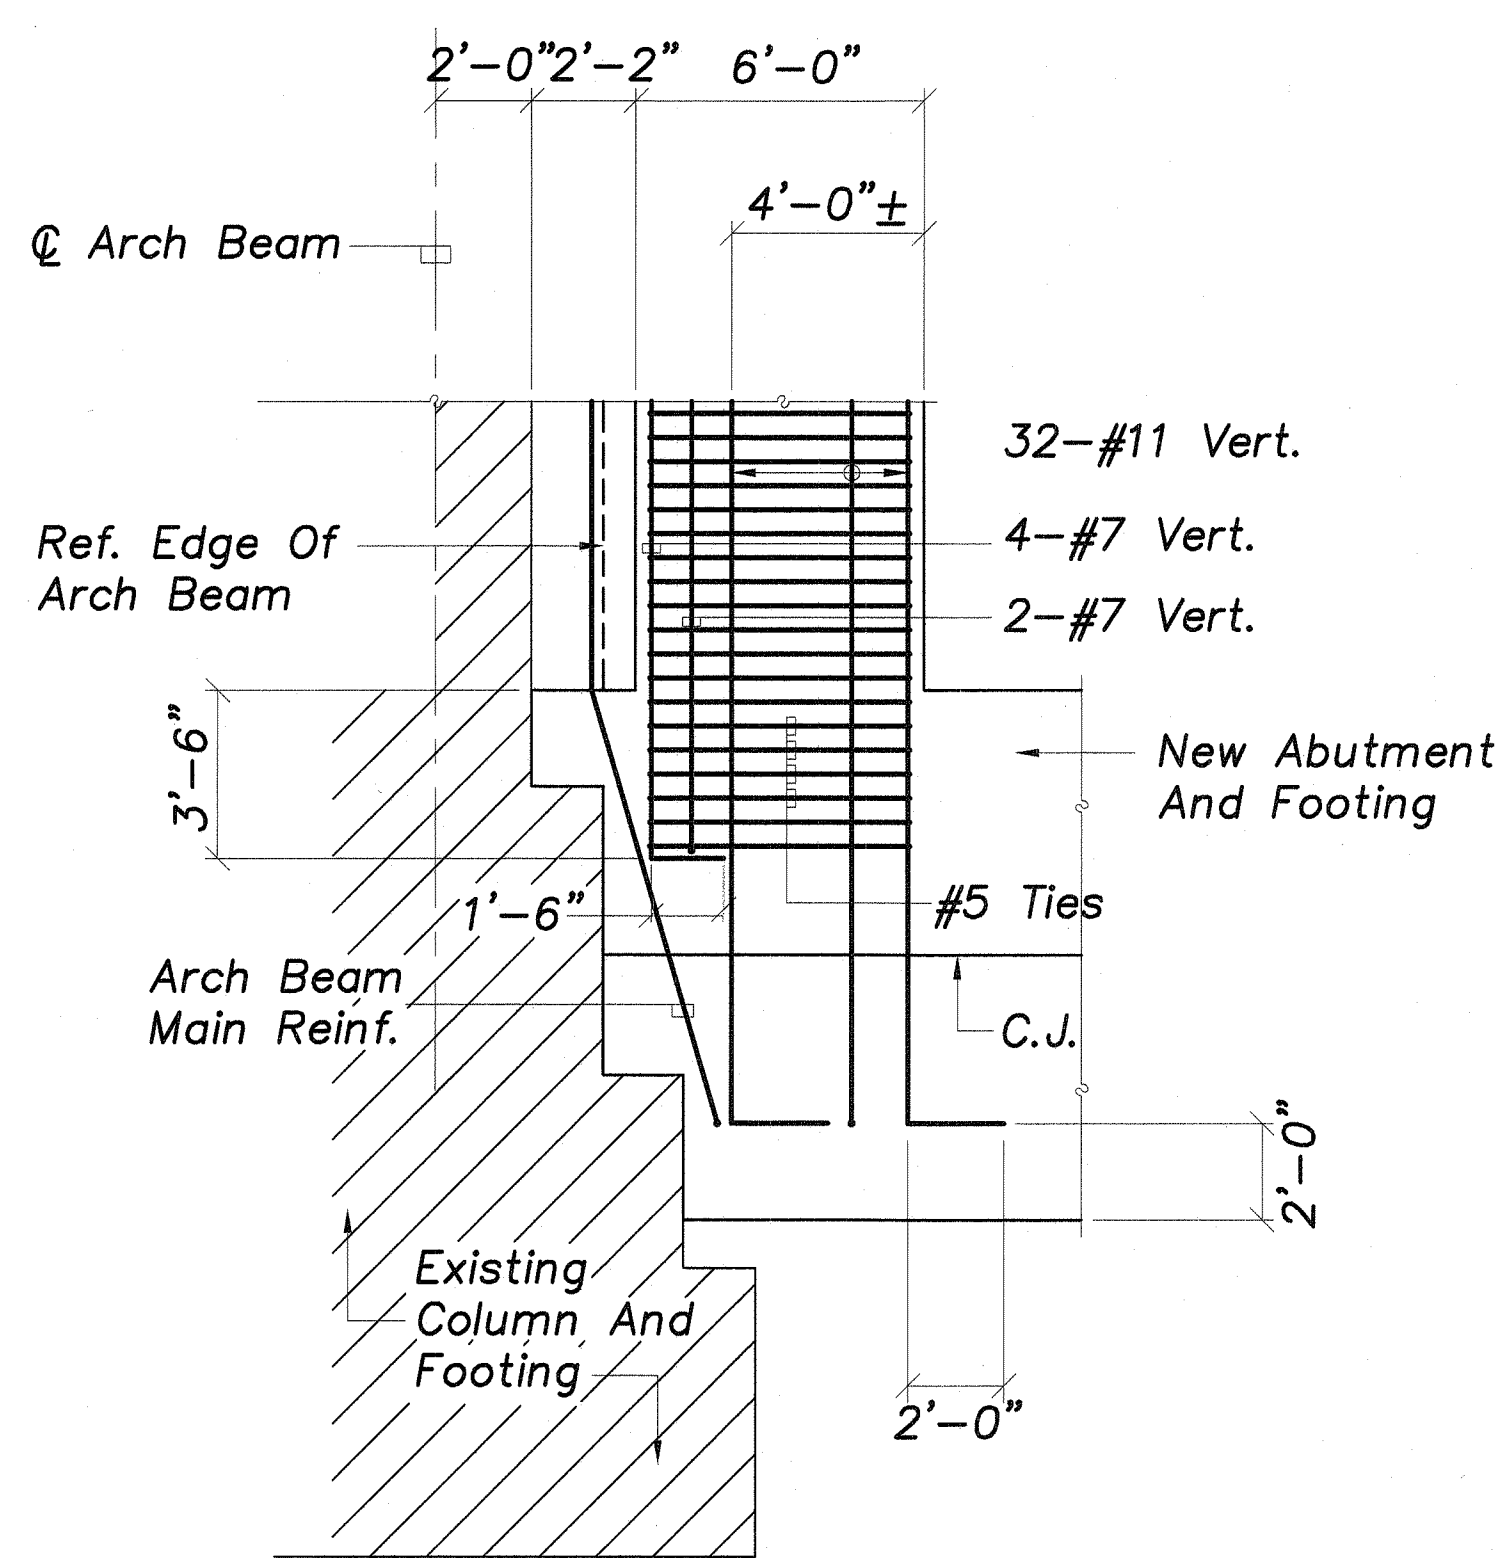

PARTIAL ABUTMENT SECTION AT
CORNER COLUMN REVISED REINFORCING

1 S-24A S-24A Scale: 1/4"=1'-0"

GRAPHIC SCALES

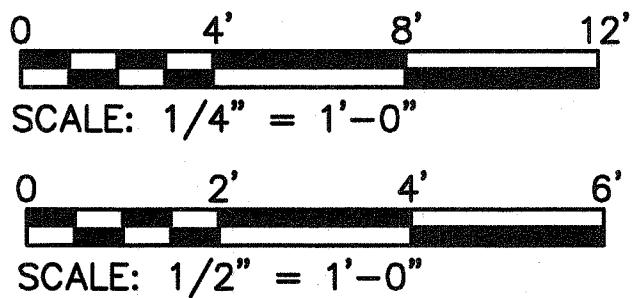

Note:
This Tracing Prepared During
"As-Built" Posting.

SURVEY PLOTTED BY	DATE
DRAWN BY	
TRACED BY	
DESIGNED BY	
CHECKED BY	
ORIGINAL PLAN	
NO.	

DATE	REVISION
STATE OF HAWAII DEPARTMENT OF TRANSPORTATION HIGHWAYS DIVISION	
PARTIAL ABUTMENT PLAN / SECTION AT CORNER COLUMN HAWAII BELT ROAD KUPAPAPUA BRIDGE WIDENING HAMAKUA DISTRICT Federal Aid Project No. BR-019-2(38) Scale: As Noted Date: June 23, 2003	
SHEET No. S-24A OF 36 SHEETS	

2-5/8" ϕ 6"

SS Bolts in
Drilled Holes
w/Epoxy Adhesive
Grout

3/16" 3/16"


2 1/2" x 1/4" SS
Plate Strap @10'
OC, Max

8" Downspout

L3" x 2" x 1/4" x
0'-2 1/2" SS

6"

Face of Conc
Column

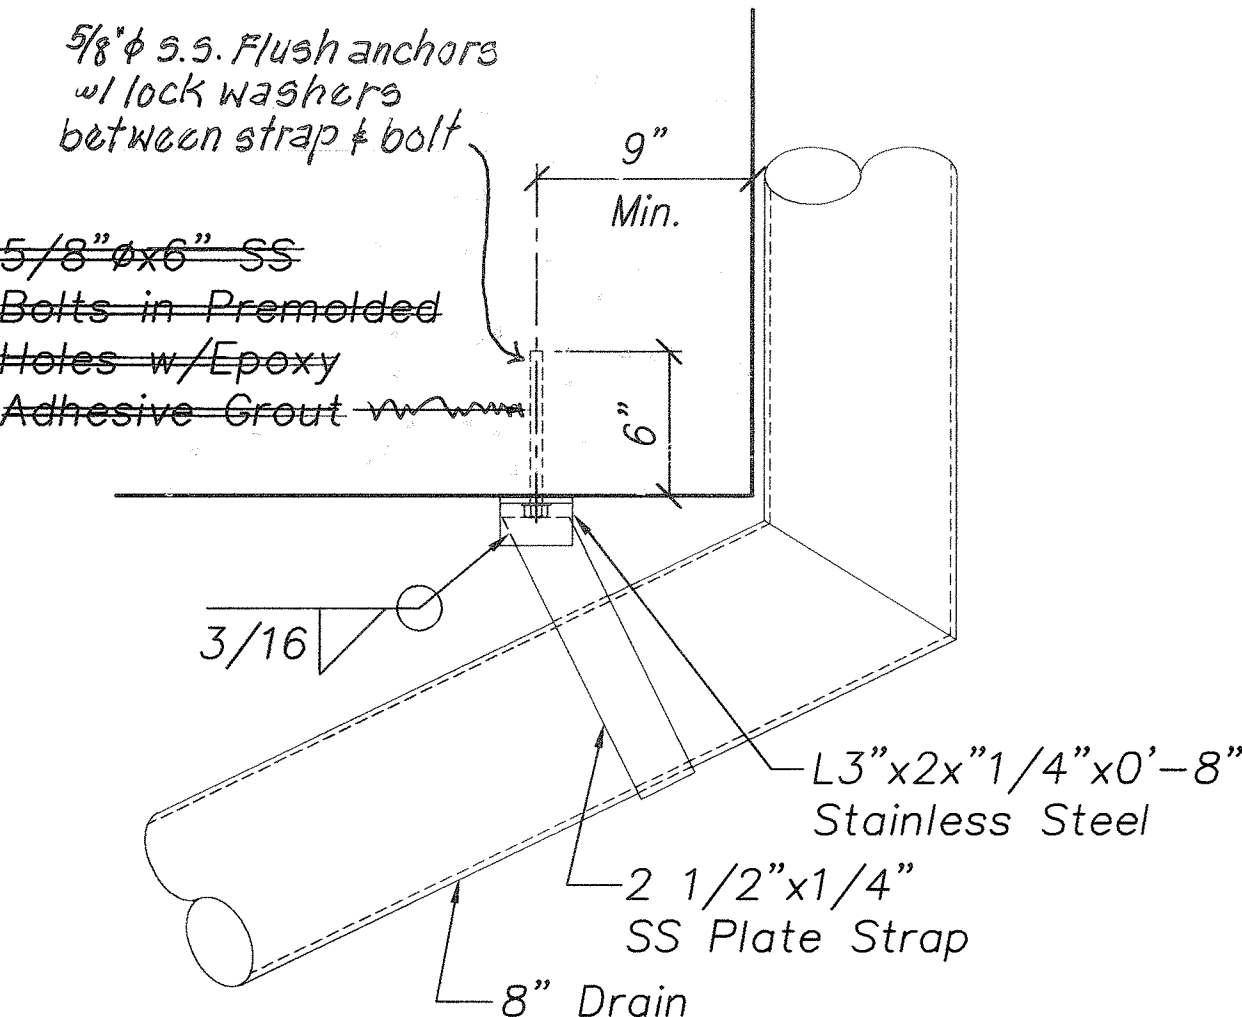

GRAPHIC SCALES

0 4 8
SCALE: $1/4" = 1'-0"$

0 2' 4'
SCALE: $1/2" = 1'-0"$





Myron Okubo

[illegible]


 **DETAIL**
S-25 | S-25 Scale: 1 1/2" = 1'-0"

Path: L:\WOA\6670-01 Kupapaulua Bridge\Downsp Filename: S25 Plot date: Sep 25, 2006-07:58:53pm CAD User: skidani Xref Filename: Border AUTODATE

FED. ROAD DIST. NO.	STATE	FED. AID PROJ. NO.	FISCAL YEAR	SHEET NO.	TOTAL SHEETS
HAWAII	HAW.	BR-019-2(38)	2002	69A	79

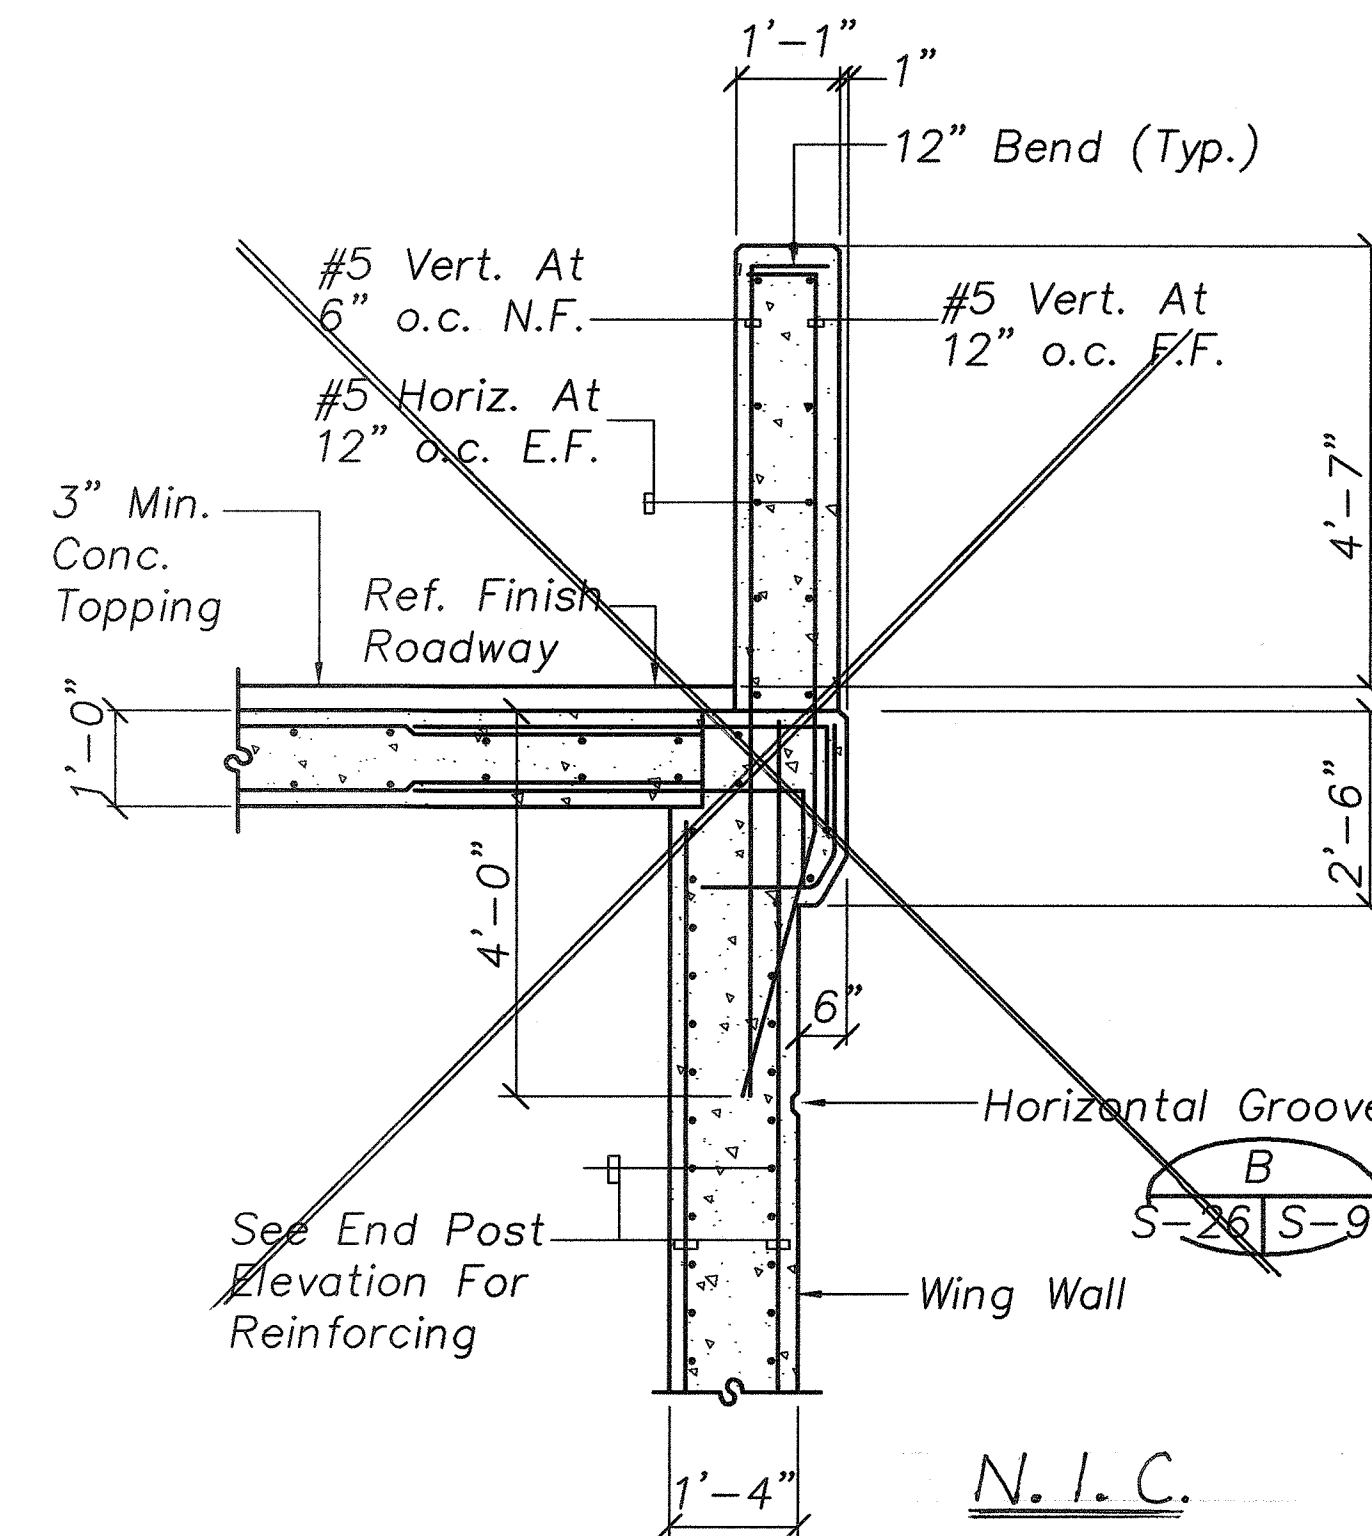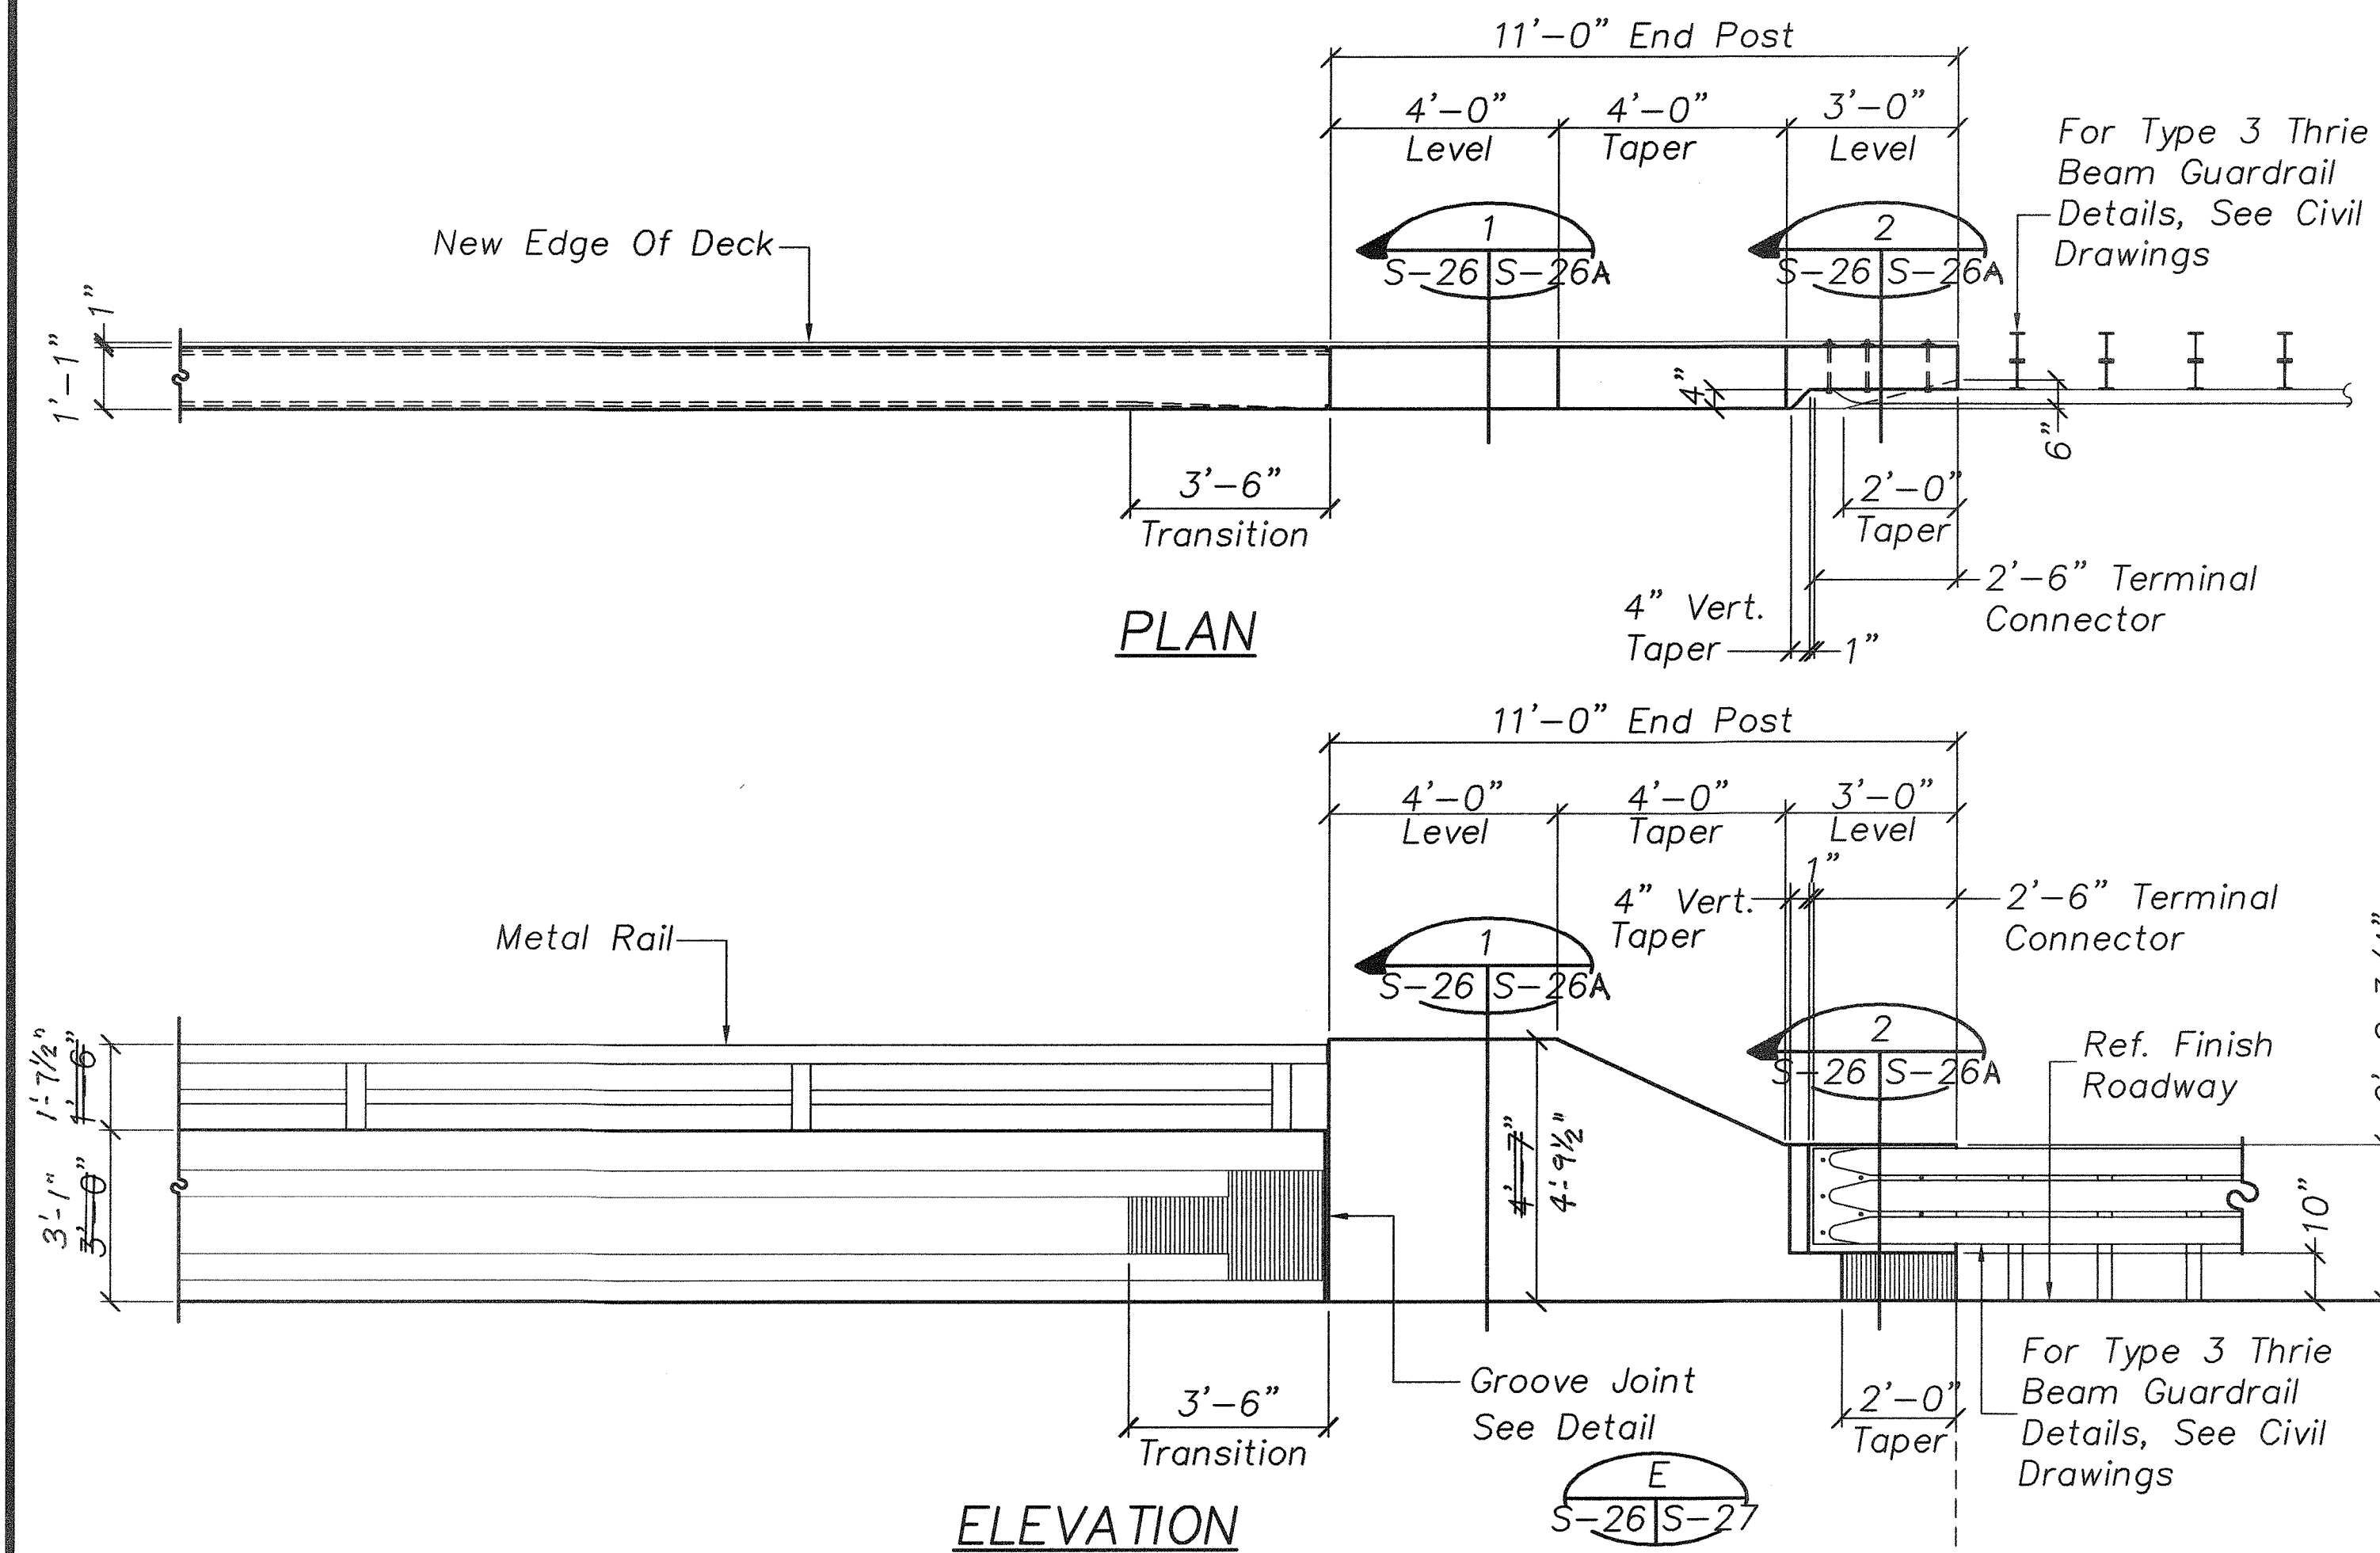


1 SECTION AT END POST
S-26|S-26 Scale: 1/2"=1'-0"

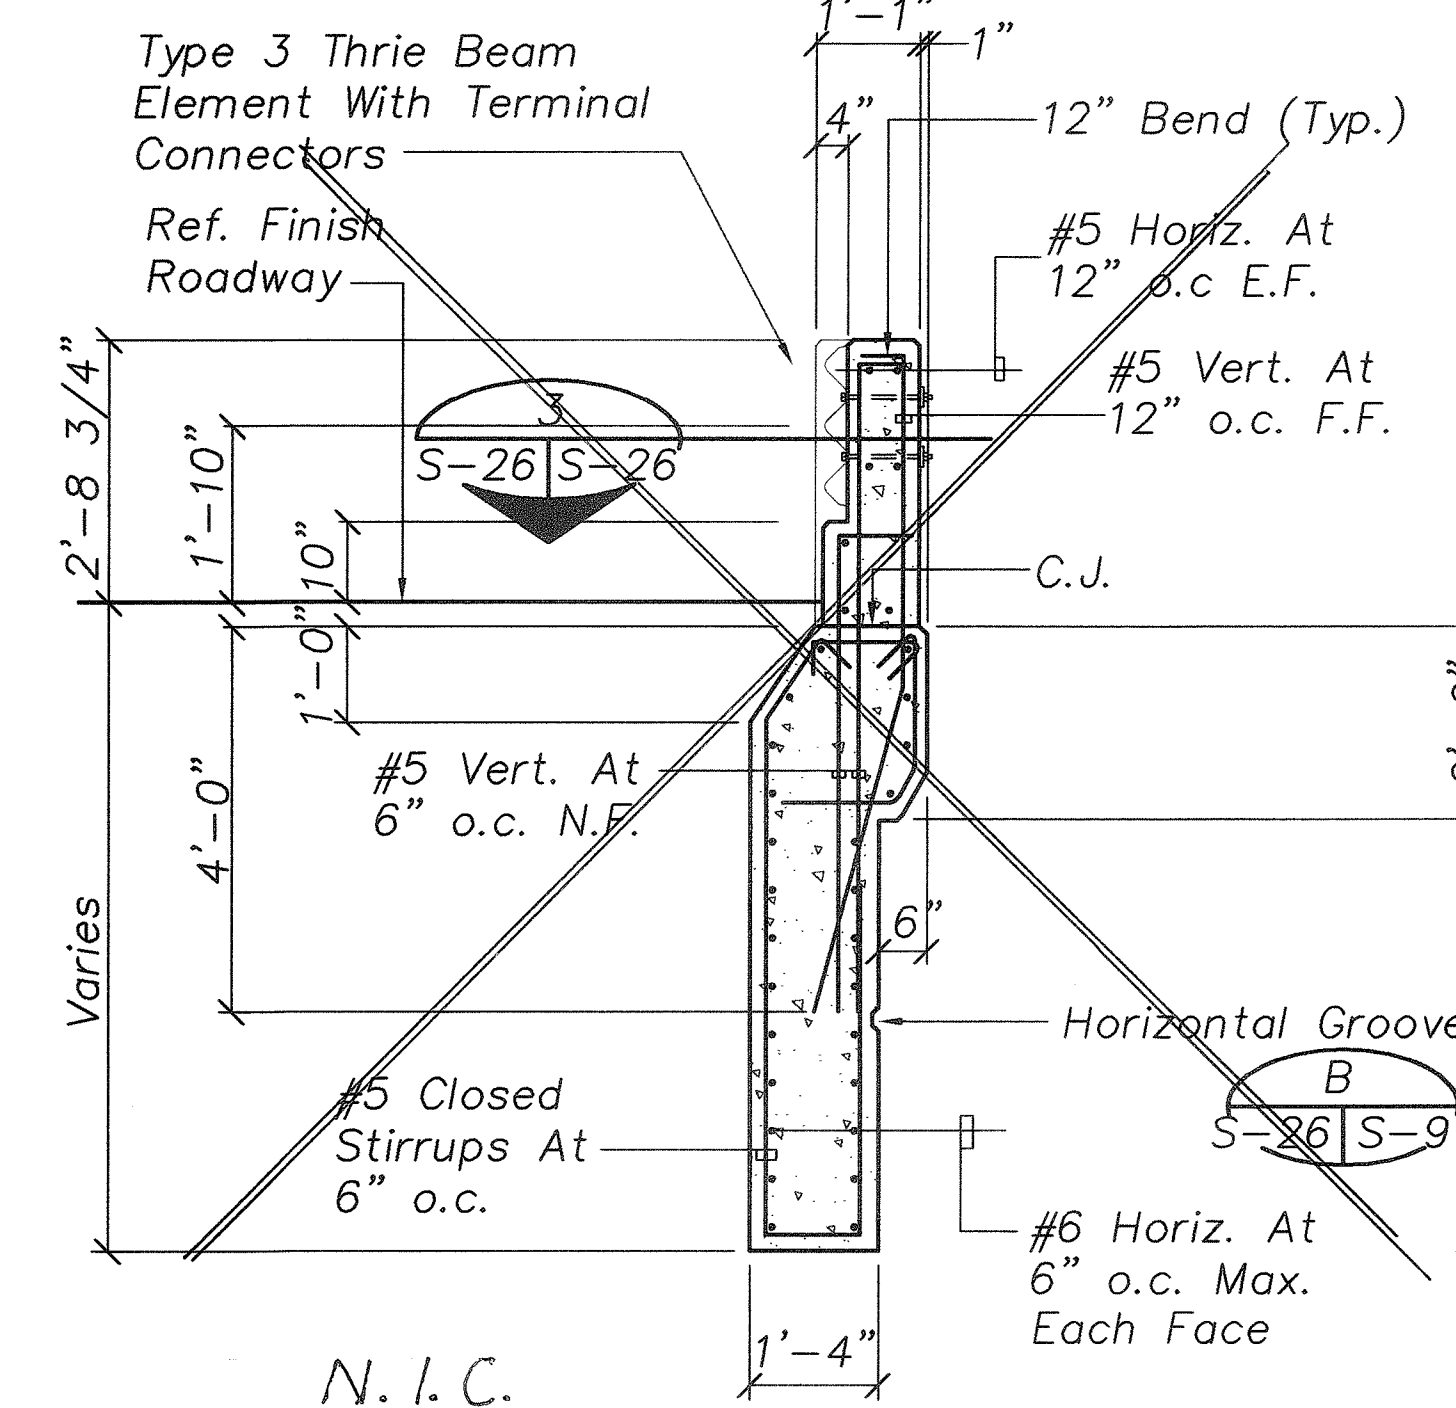


2 SECTION AT TERMINAL CONNECTOR
S-26|S-26 Scale: 1/2"=1'-0"

A TYPICAL GUARDRAIL TO END POST CONNECTION DET.
S-7, S-9|S-26 Scale: 3/8"=1'-0"

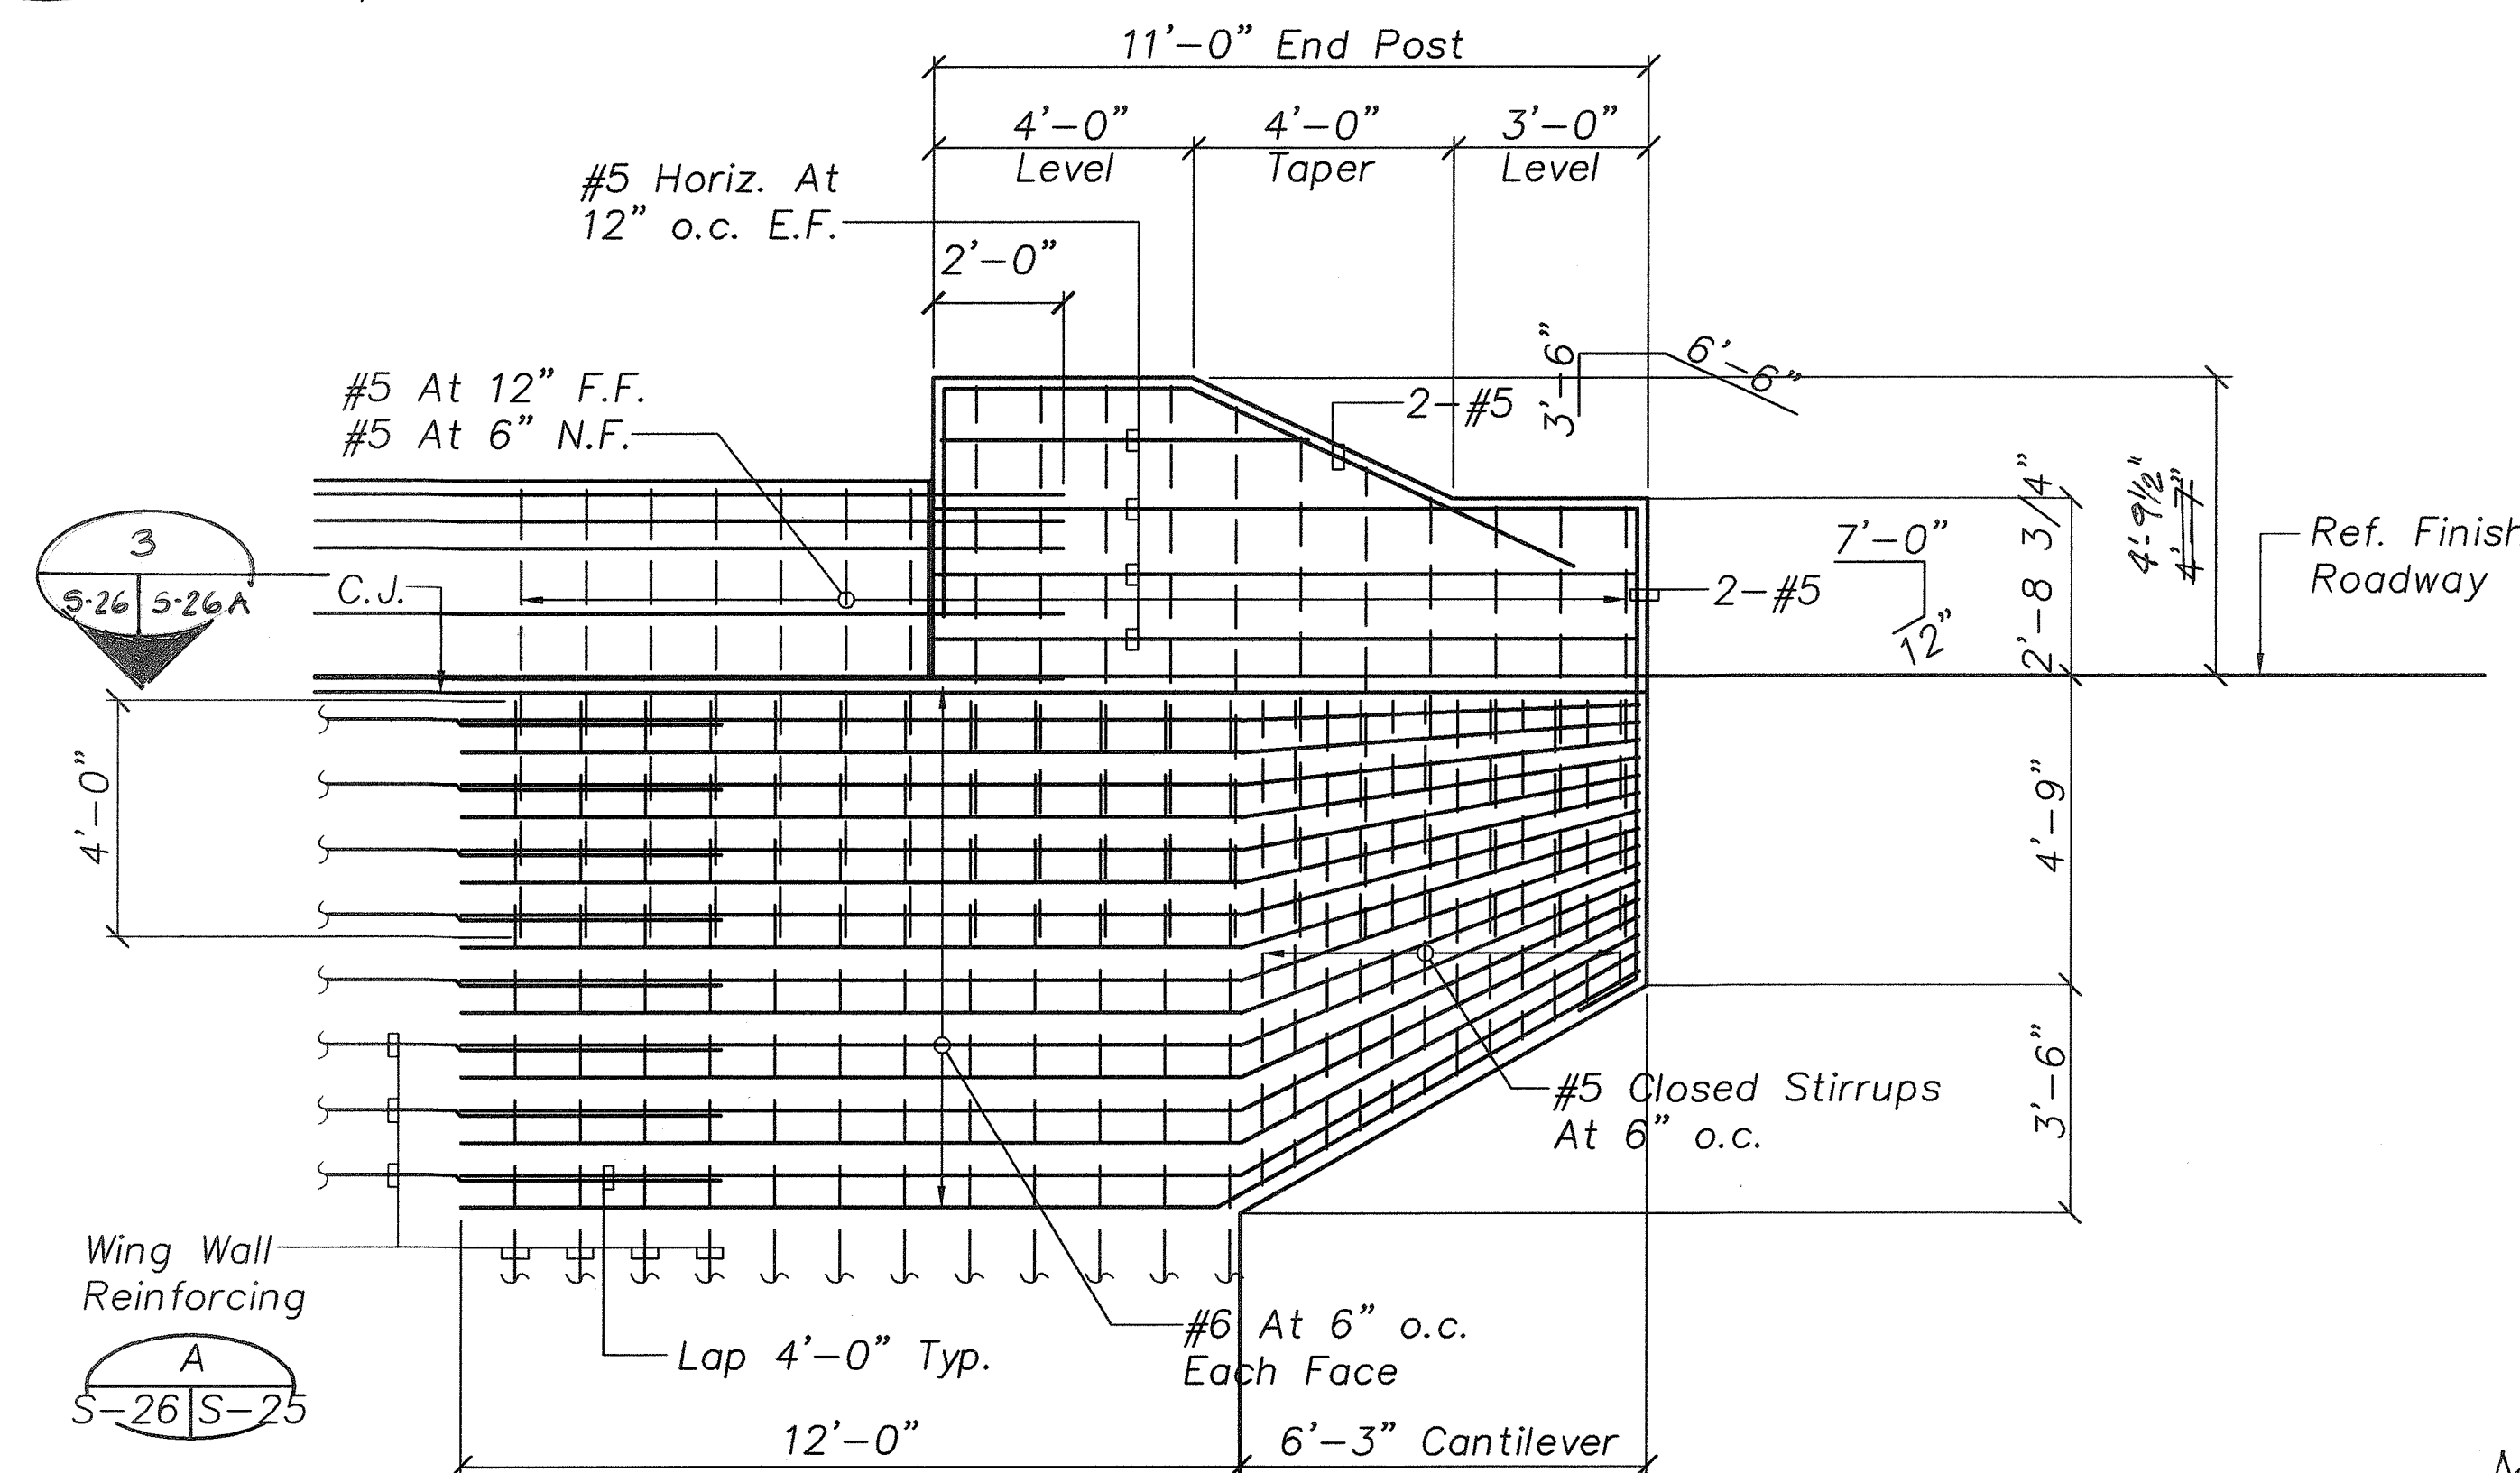


B TYPICAL END POST ELEVATION - ABUTMENT No. 1
S-7, S-9|S-26 Scale: 3/8"=1'-0"

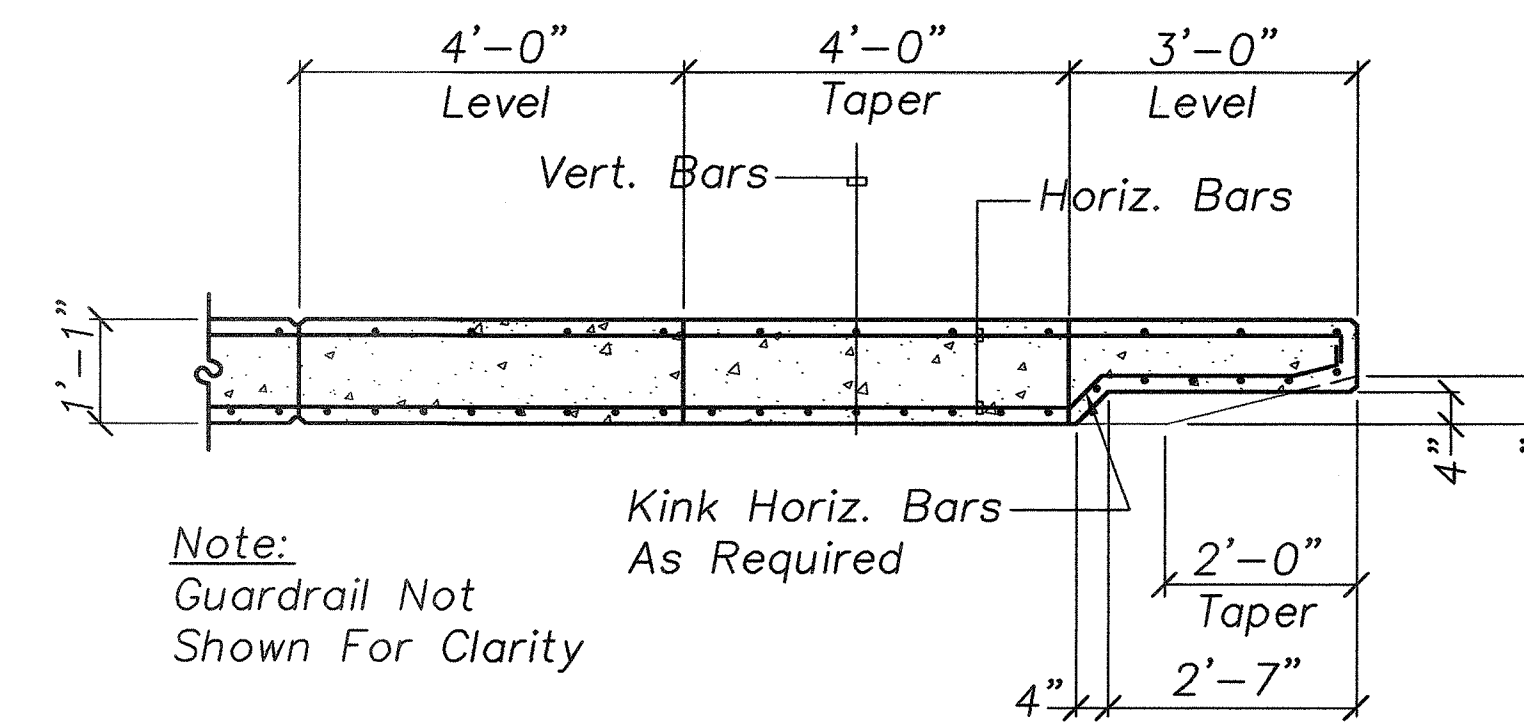

3 SECTION AT END POST
S-26|S-26 Scale: 1/2"=1'-0"

GRAPHIC SCALES

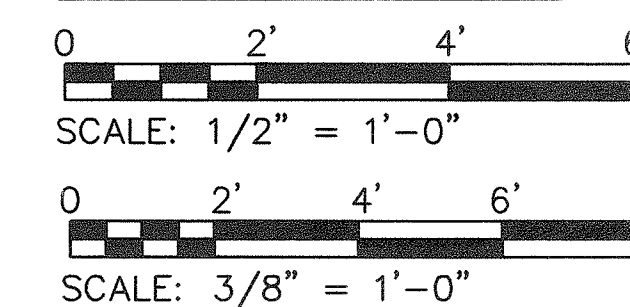


THIS WORK WAS PREPARED BY ME OR UNDER MY SUPERVISION

Myron Okubo

DATE	REVISION
STATE OF HAWAII DEPARTMENT OF TRANSPORTATION HIGHWAYS DIVISION TYPICAL GUARDRAIL TO END POST CONNECTION DETAIL HAWAII BELT ROAD KUPAPULUA BRIDGE WIDENING HAMAKUA DISTRICT Federal Aid Project No. BR-019-2(38) Scale: As Noted Date: June 23, 2003	
SHEET No. S-26 OF 36 SHEETS	

ORIGINAL PLAN	SURVEY PLOTTED BY	DATE
NOTED	DRAWN BY	
NOTED	TRACED BY	
NOTED	DESIGNED BY	
NOTED	CHECKED BY	
NOTED	QUANTITIES BY	
NOTED	CHECKED BY	

FED. ROAD DIST. NO.	STATE	FED. AID PROJ. NO.	FISCAL YEAR	SHEET NO.	TOTAL SHEETS
HAWAII	HAW.	BR-019-2(38)	2002	69A S-1	79

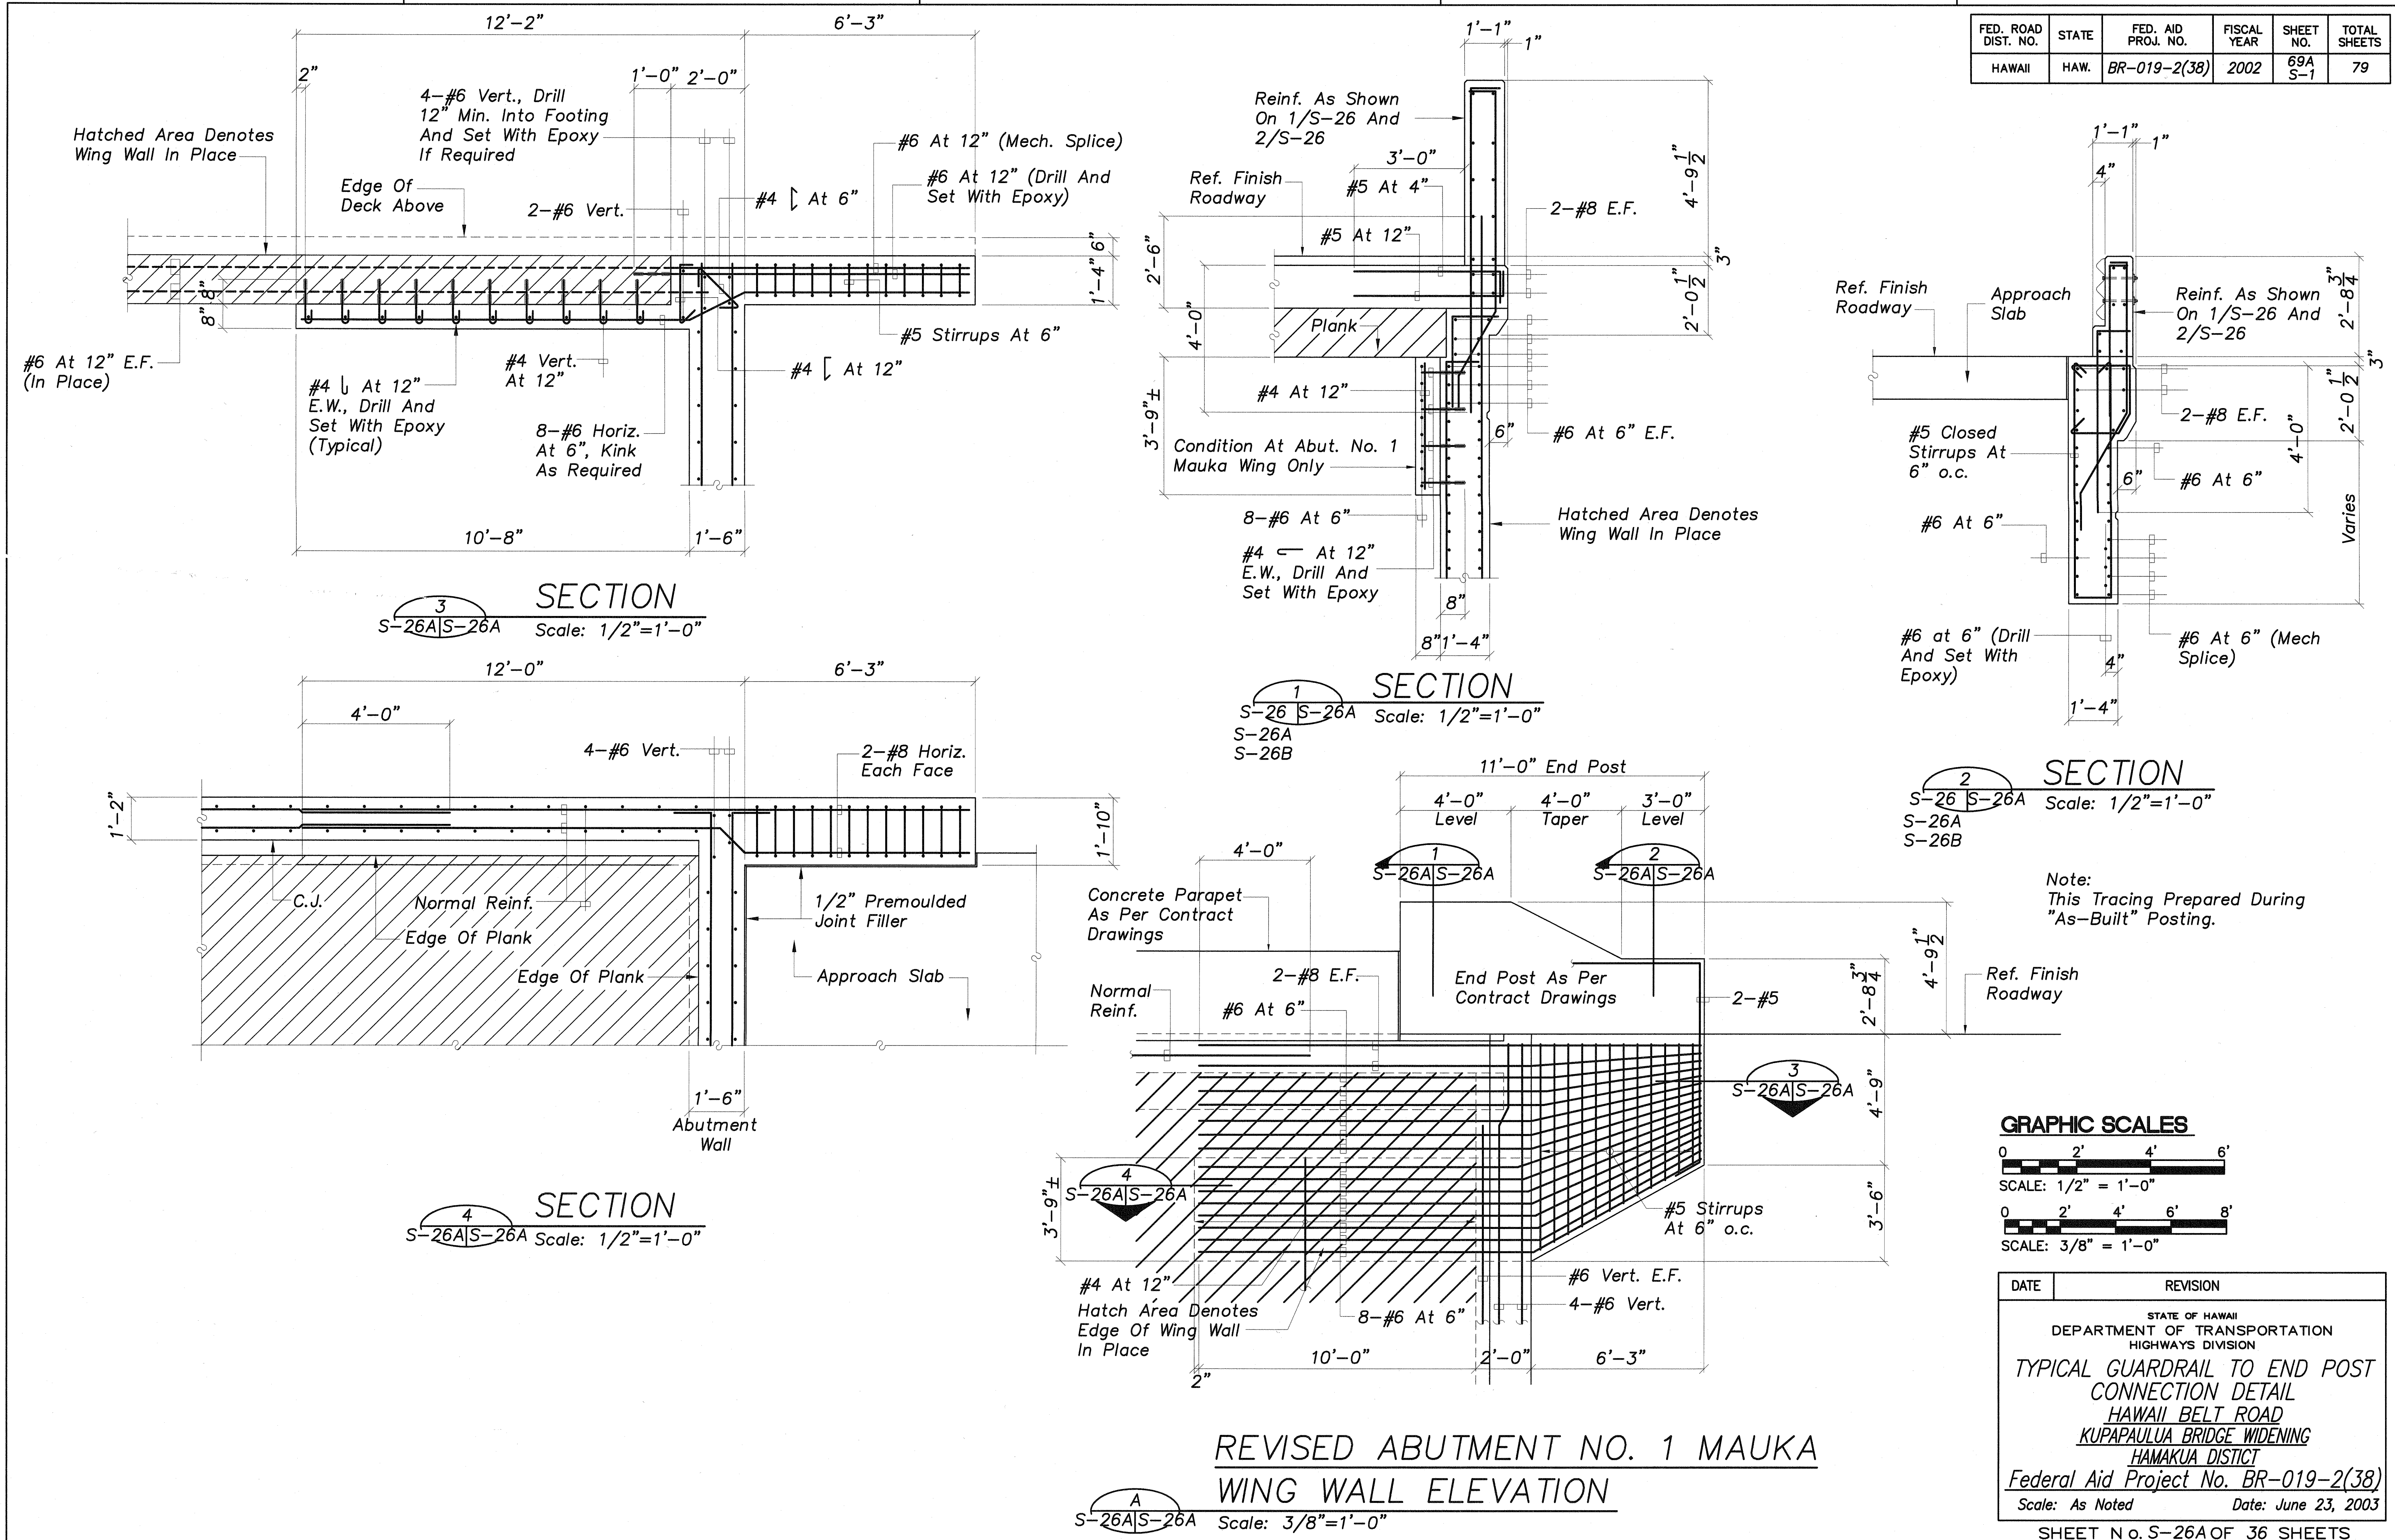


SURVEY PLOTTED BY	DATE
DRAWN BY	
CHECKED BY	
DESIGNED BY	
QUANTITIES BY	
CHECKED BY	
ORIGINAL PLAN	
NOTEBOOK	
NO.	


"AS-BUILT"

69A S-1

FED. ROAD DIST. NO.	STATE	FED. AID PROJ. NO.	FISCAL YEAR	SHEET NO.	TOTAL SHEETS
HAWAII	HAW.	BR-019-2(38)	2002	69A S-2	79

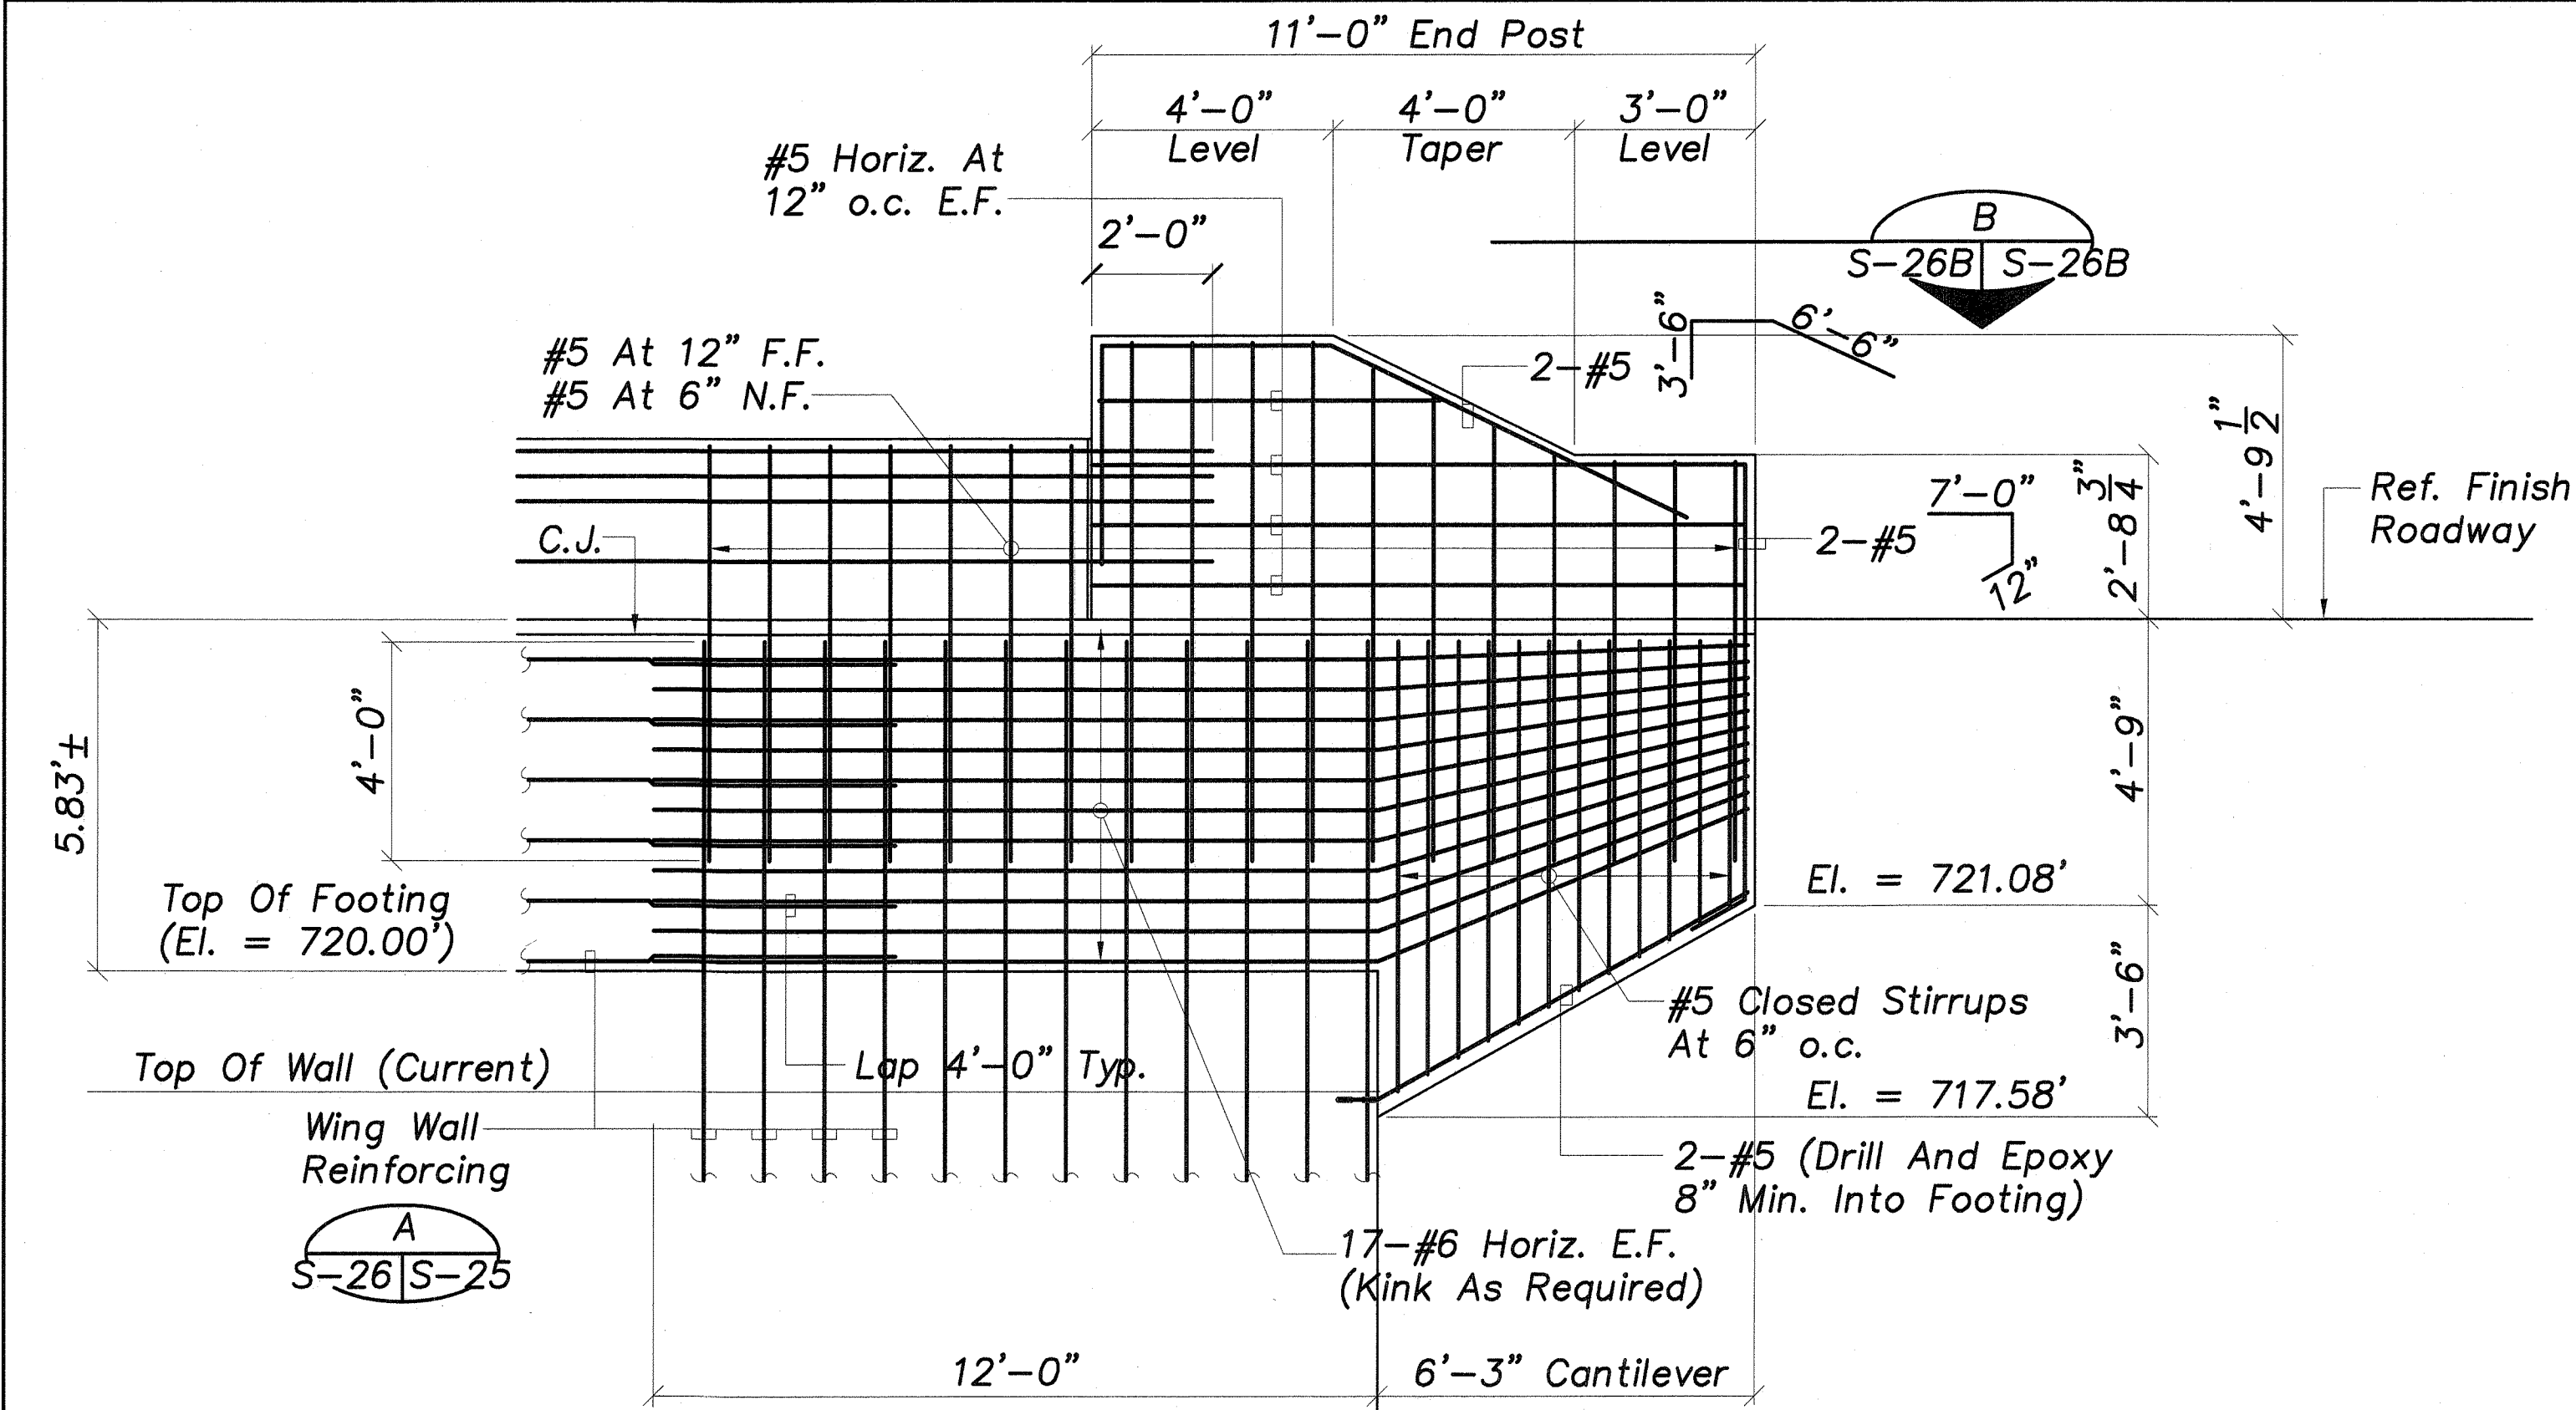


TYPICAL END POST ELEVATION (Abutment No. 2 Mauka And Makai)
 Scale: 3/8"=1'-0"

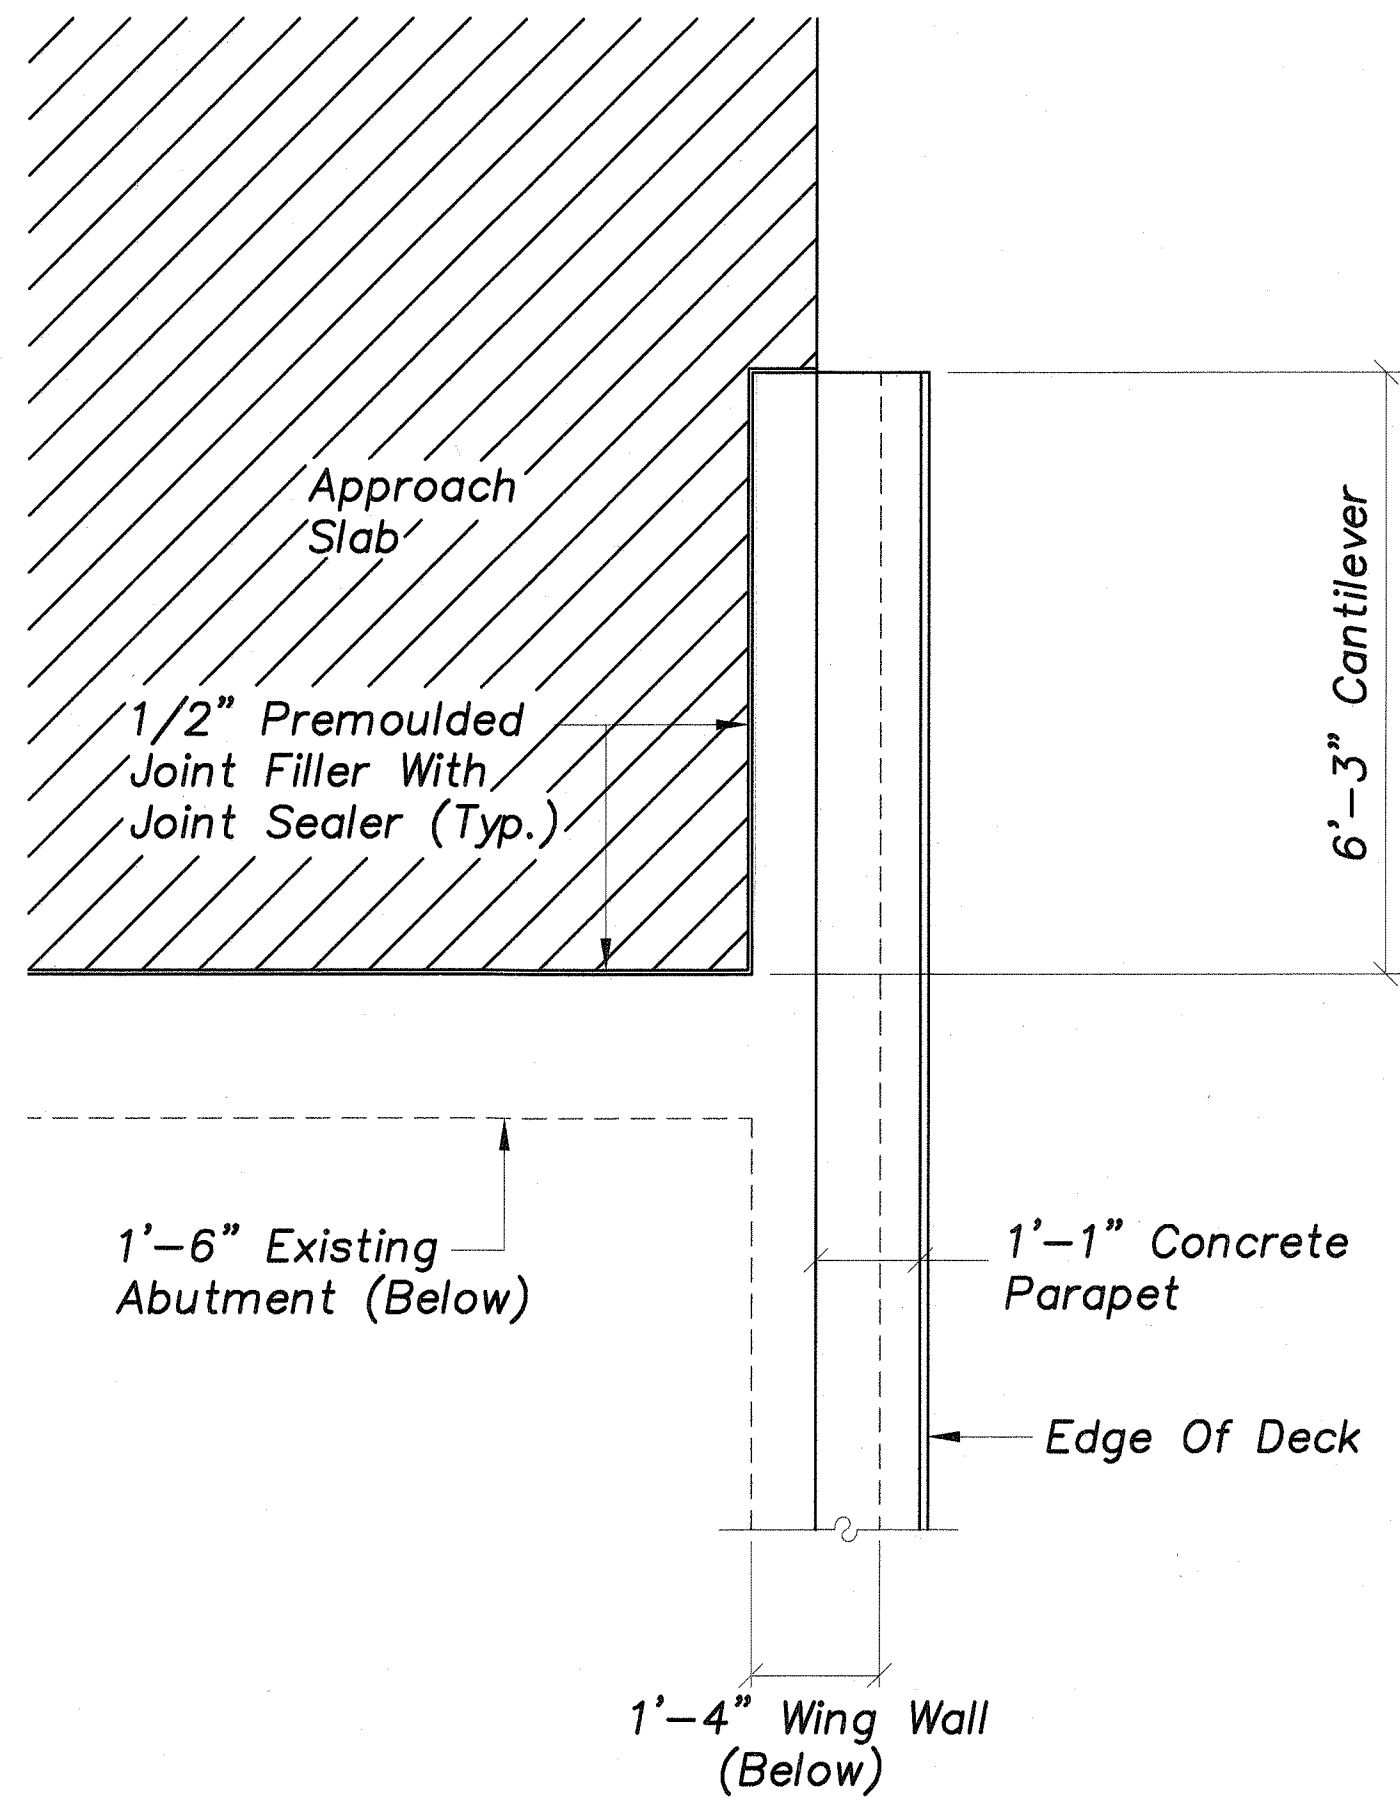

PLAN VIEW
 Scale: 1/2"=1'-0"

Note:
 This Tracing Prepared During
 "As-Built" Posting


GRAPHIC SCALES

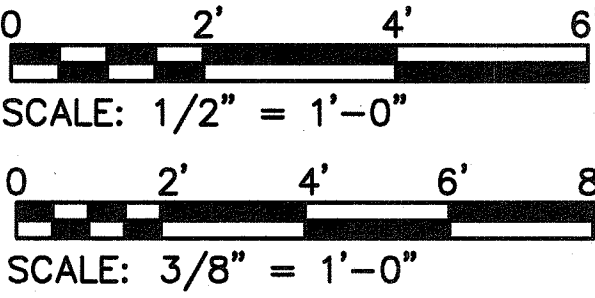


DATE	REVISION
	STATE OF HAWAII DEPARTMENT OF TRANSPORTATION HIGHWAYS DIVISION TYPICAL GUARDRAIL TO END POST CONNECTION DETAIL HAWAII BELT ROAD KUPAPAU LUA BRIDGE WIDENING HAMAKUA DISTRICT Federal Aid Project No. BR-019-2(38) Scale: As Noted Date: June 23, 2003 SHEET No. S-26B OF 36 SHEETS

DESIGNED BY	DATE
DRAWN BY	
CHECKED BY	
NOTED BY	
QUANTITIES BY	
NO.	


FED. ROAD DIST. NO.	STATE	FED. AID PROJ. NO.	FISCAL YEAR	SHEET NO.	TOTAL SHEETS
HAWAII	HAW.	BR-019-2(38)	2002	71A S-1	79

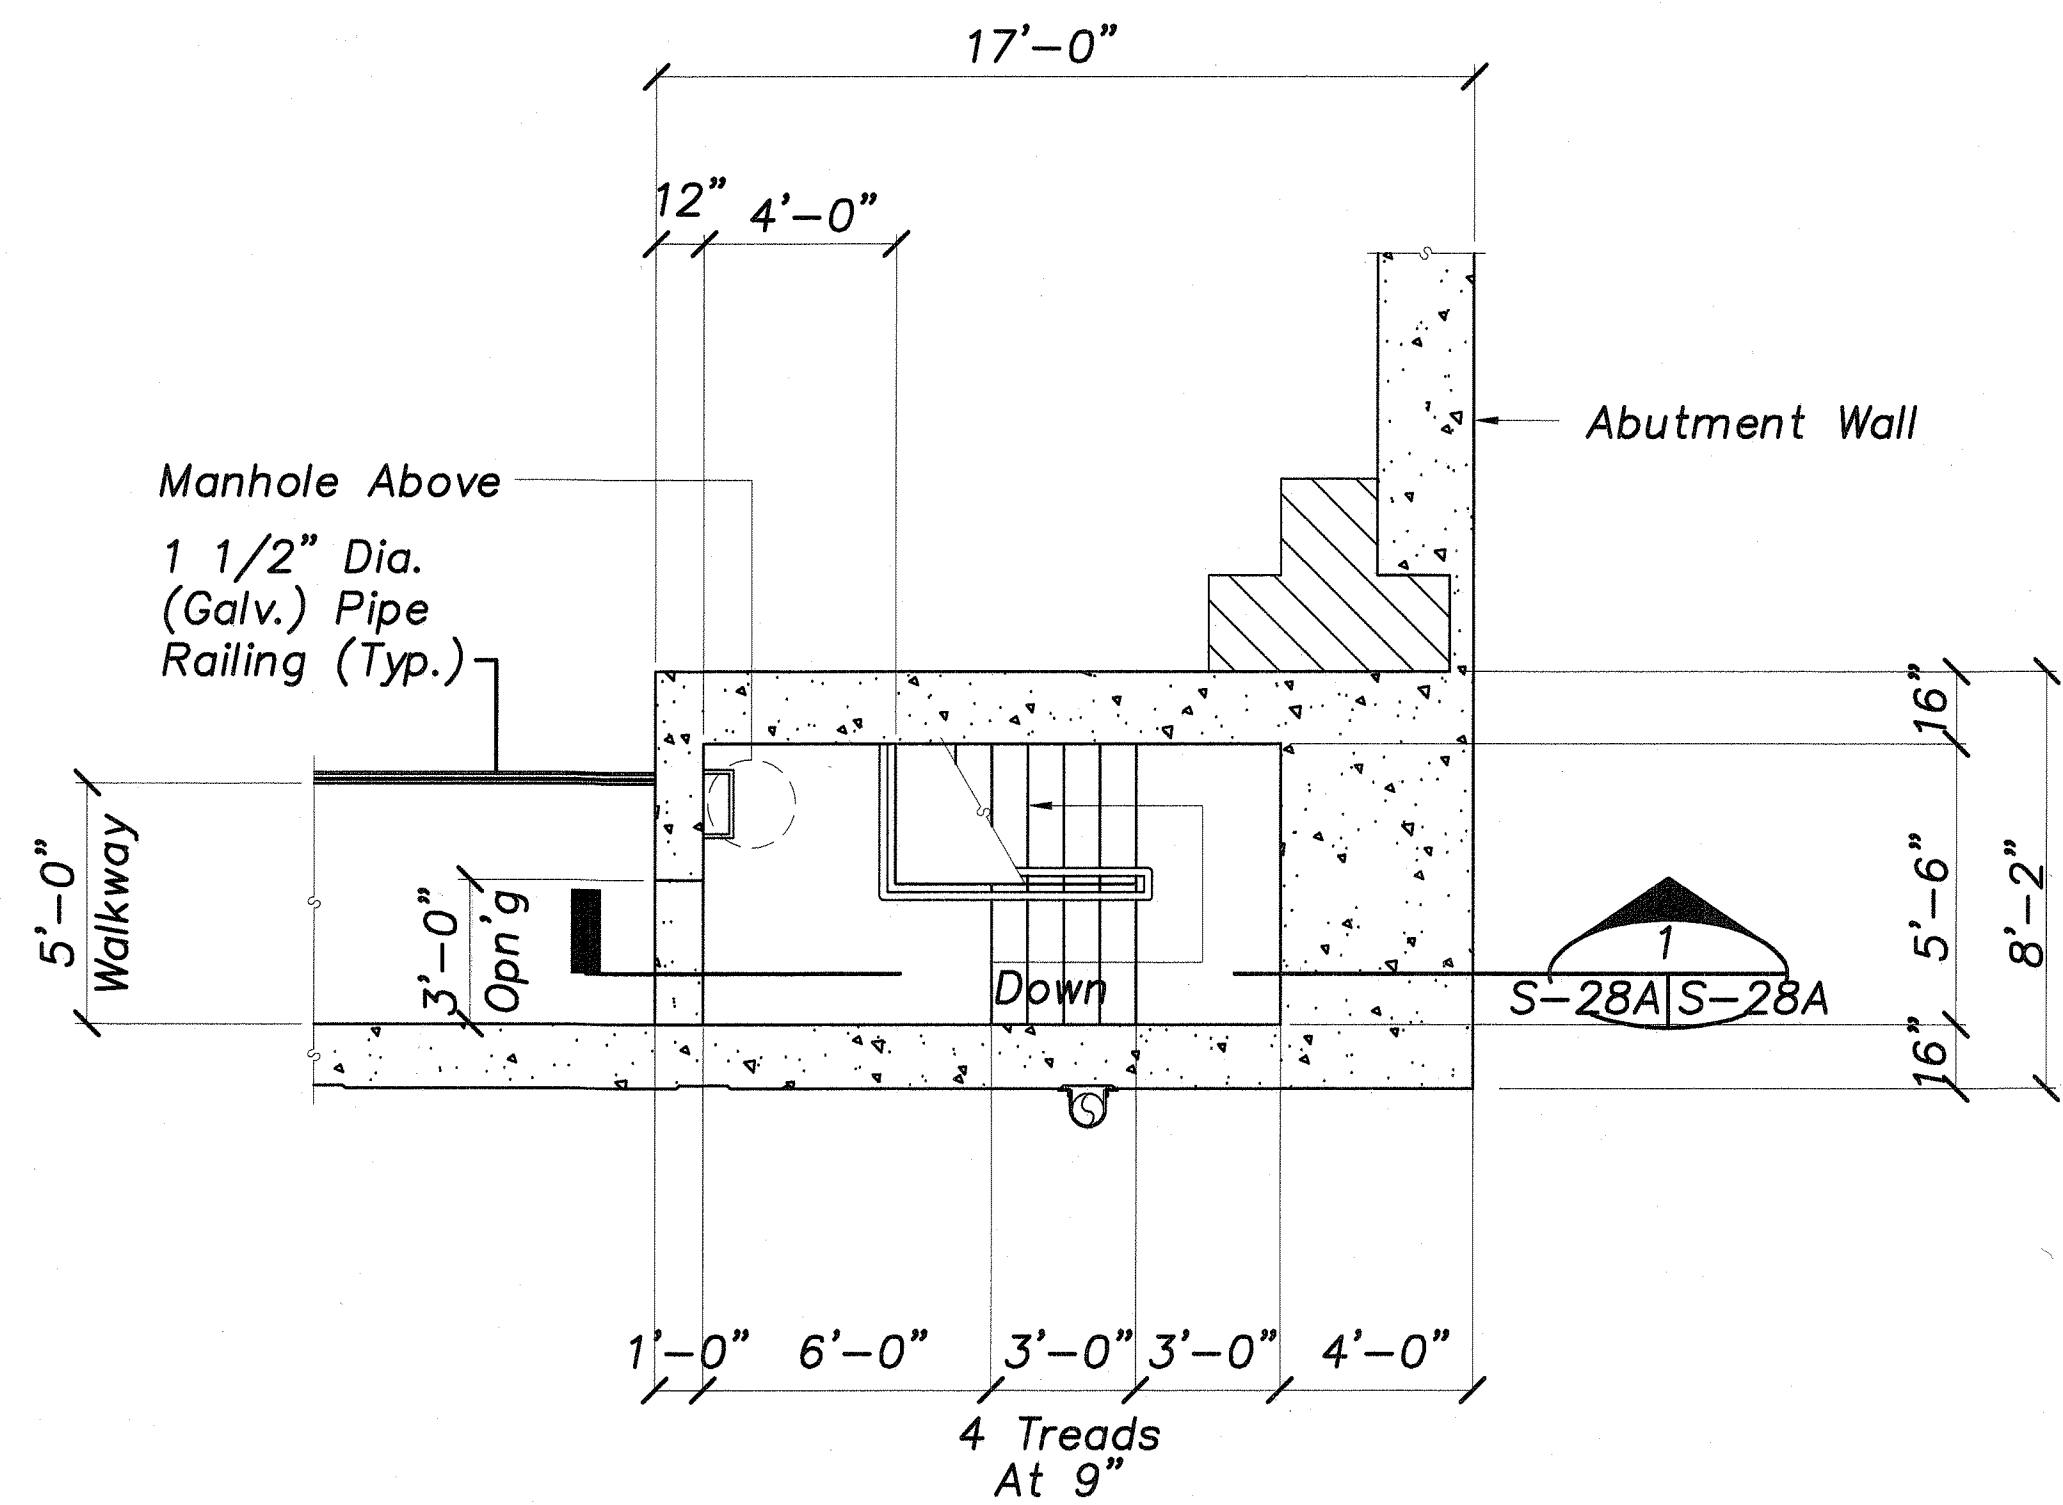


REVISED SERVICE STAIRS TOP LEVEL LANDING
 Scale: 1/2"=1'-0"
 (At Abutment No. 1)

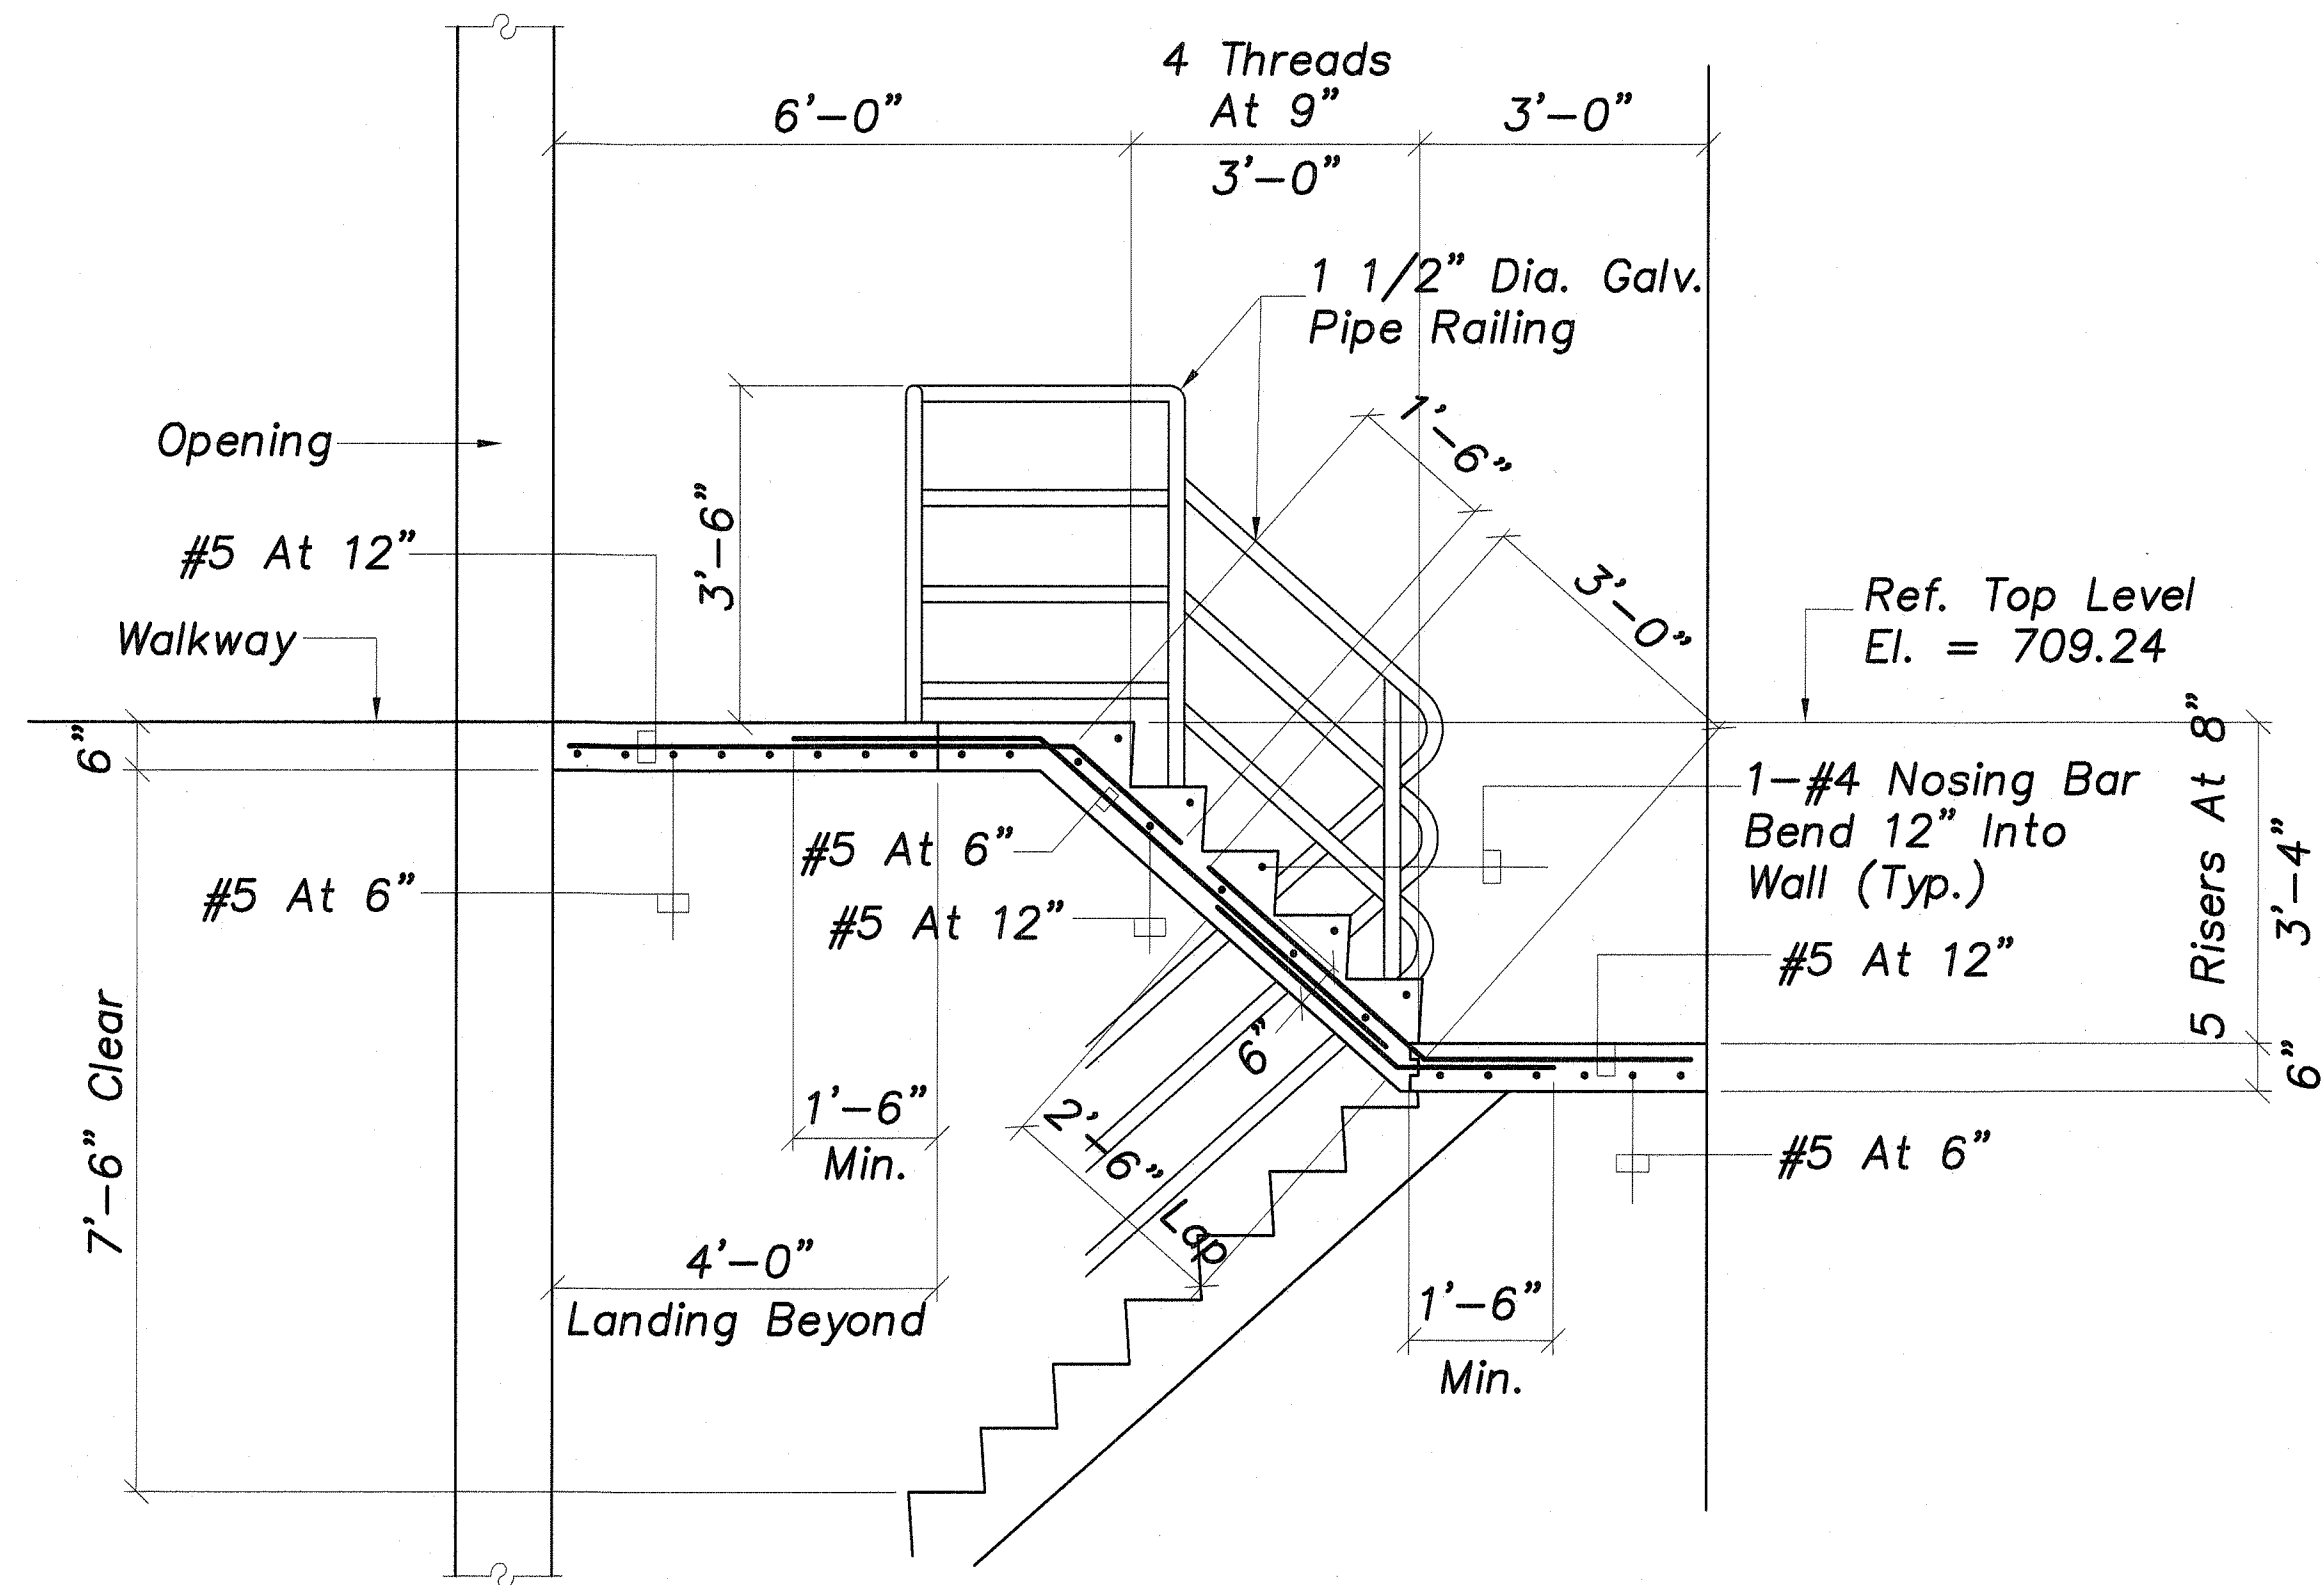

SECTION
 Scale: 1/2"=1'-0"

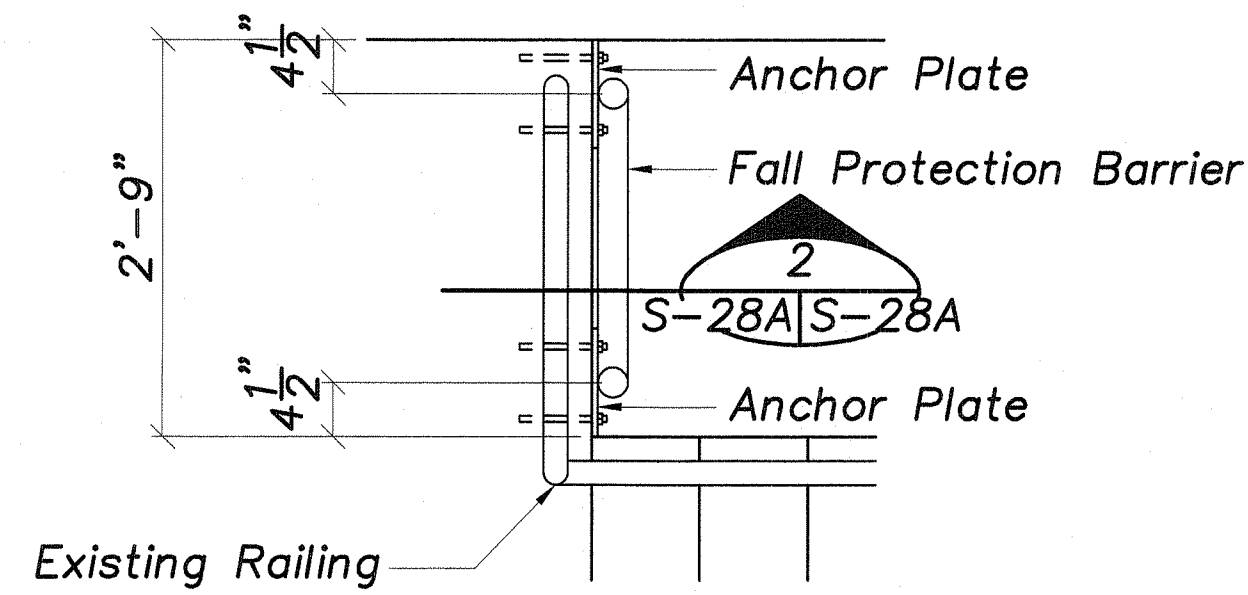

PARTIAL PLAN
 Scale: 3/4"=1'-0"


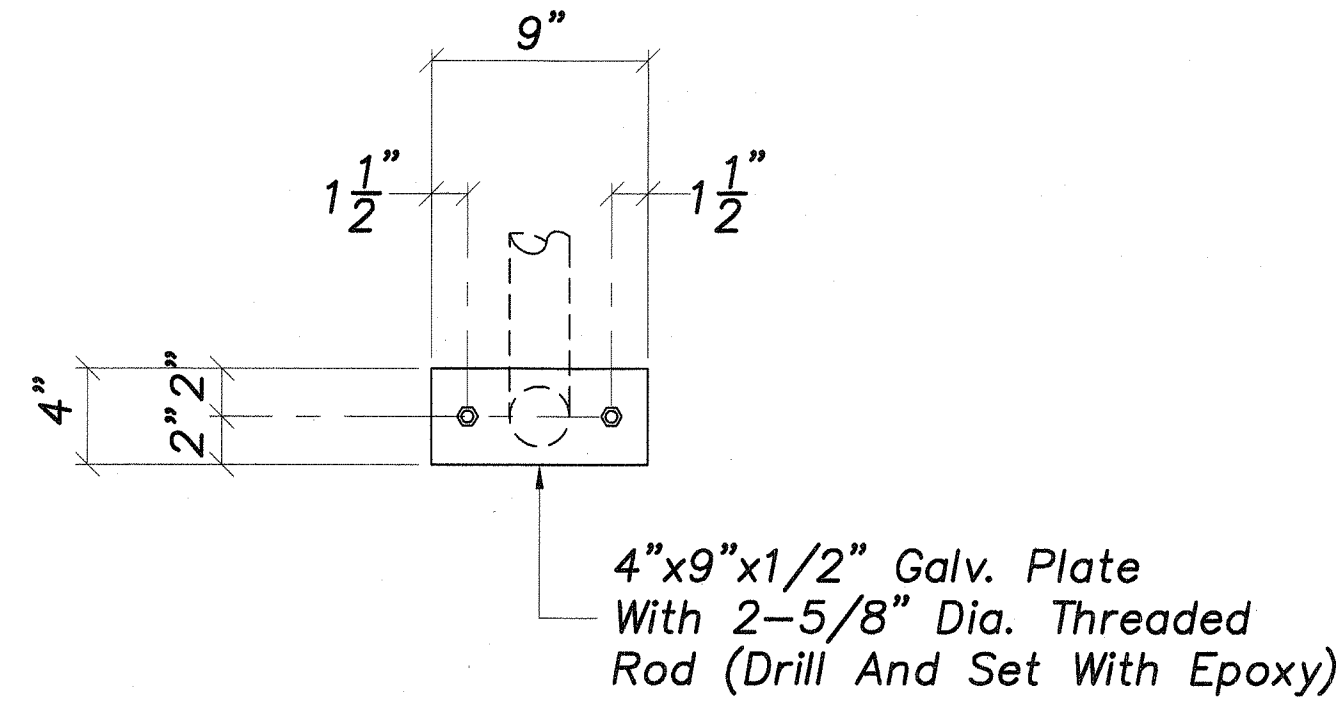


ANCHOR PLATE DETAIL
 Scale: 1-1/2"=1'-0"

- Note:
- Chain Link Fabric Shall Be Galvanized No. 9 Gage 2" Mesh.
 - Fabric Shall Be Fastened To End Post By Stretcher Bar And Bands At 12" o.c.
 - Fabric Shall Be Fastened To Top And Bottom Rail With No. 9 Gage Galvanized Wire At 6" o.c.

FALL PROTECTION BARRIER AT SERVICE STAIRS
 Scale: As Noted

Note:
 This Tracing Prepared During
 "As-Built" Posting.

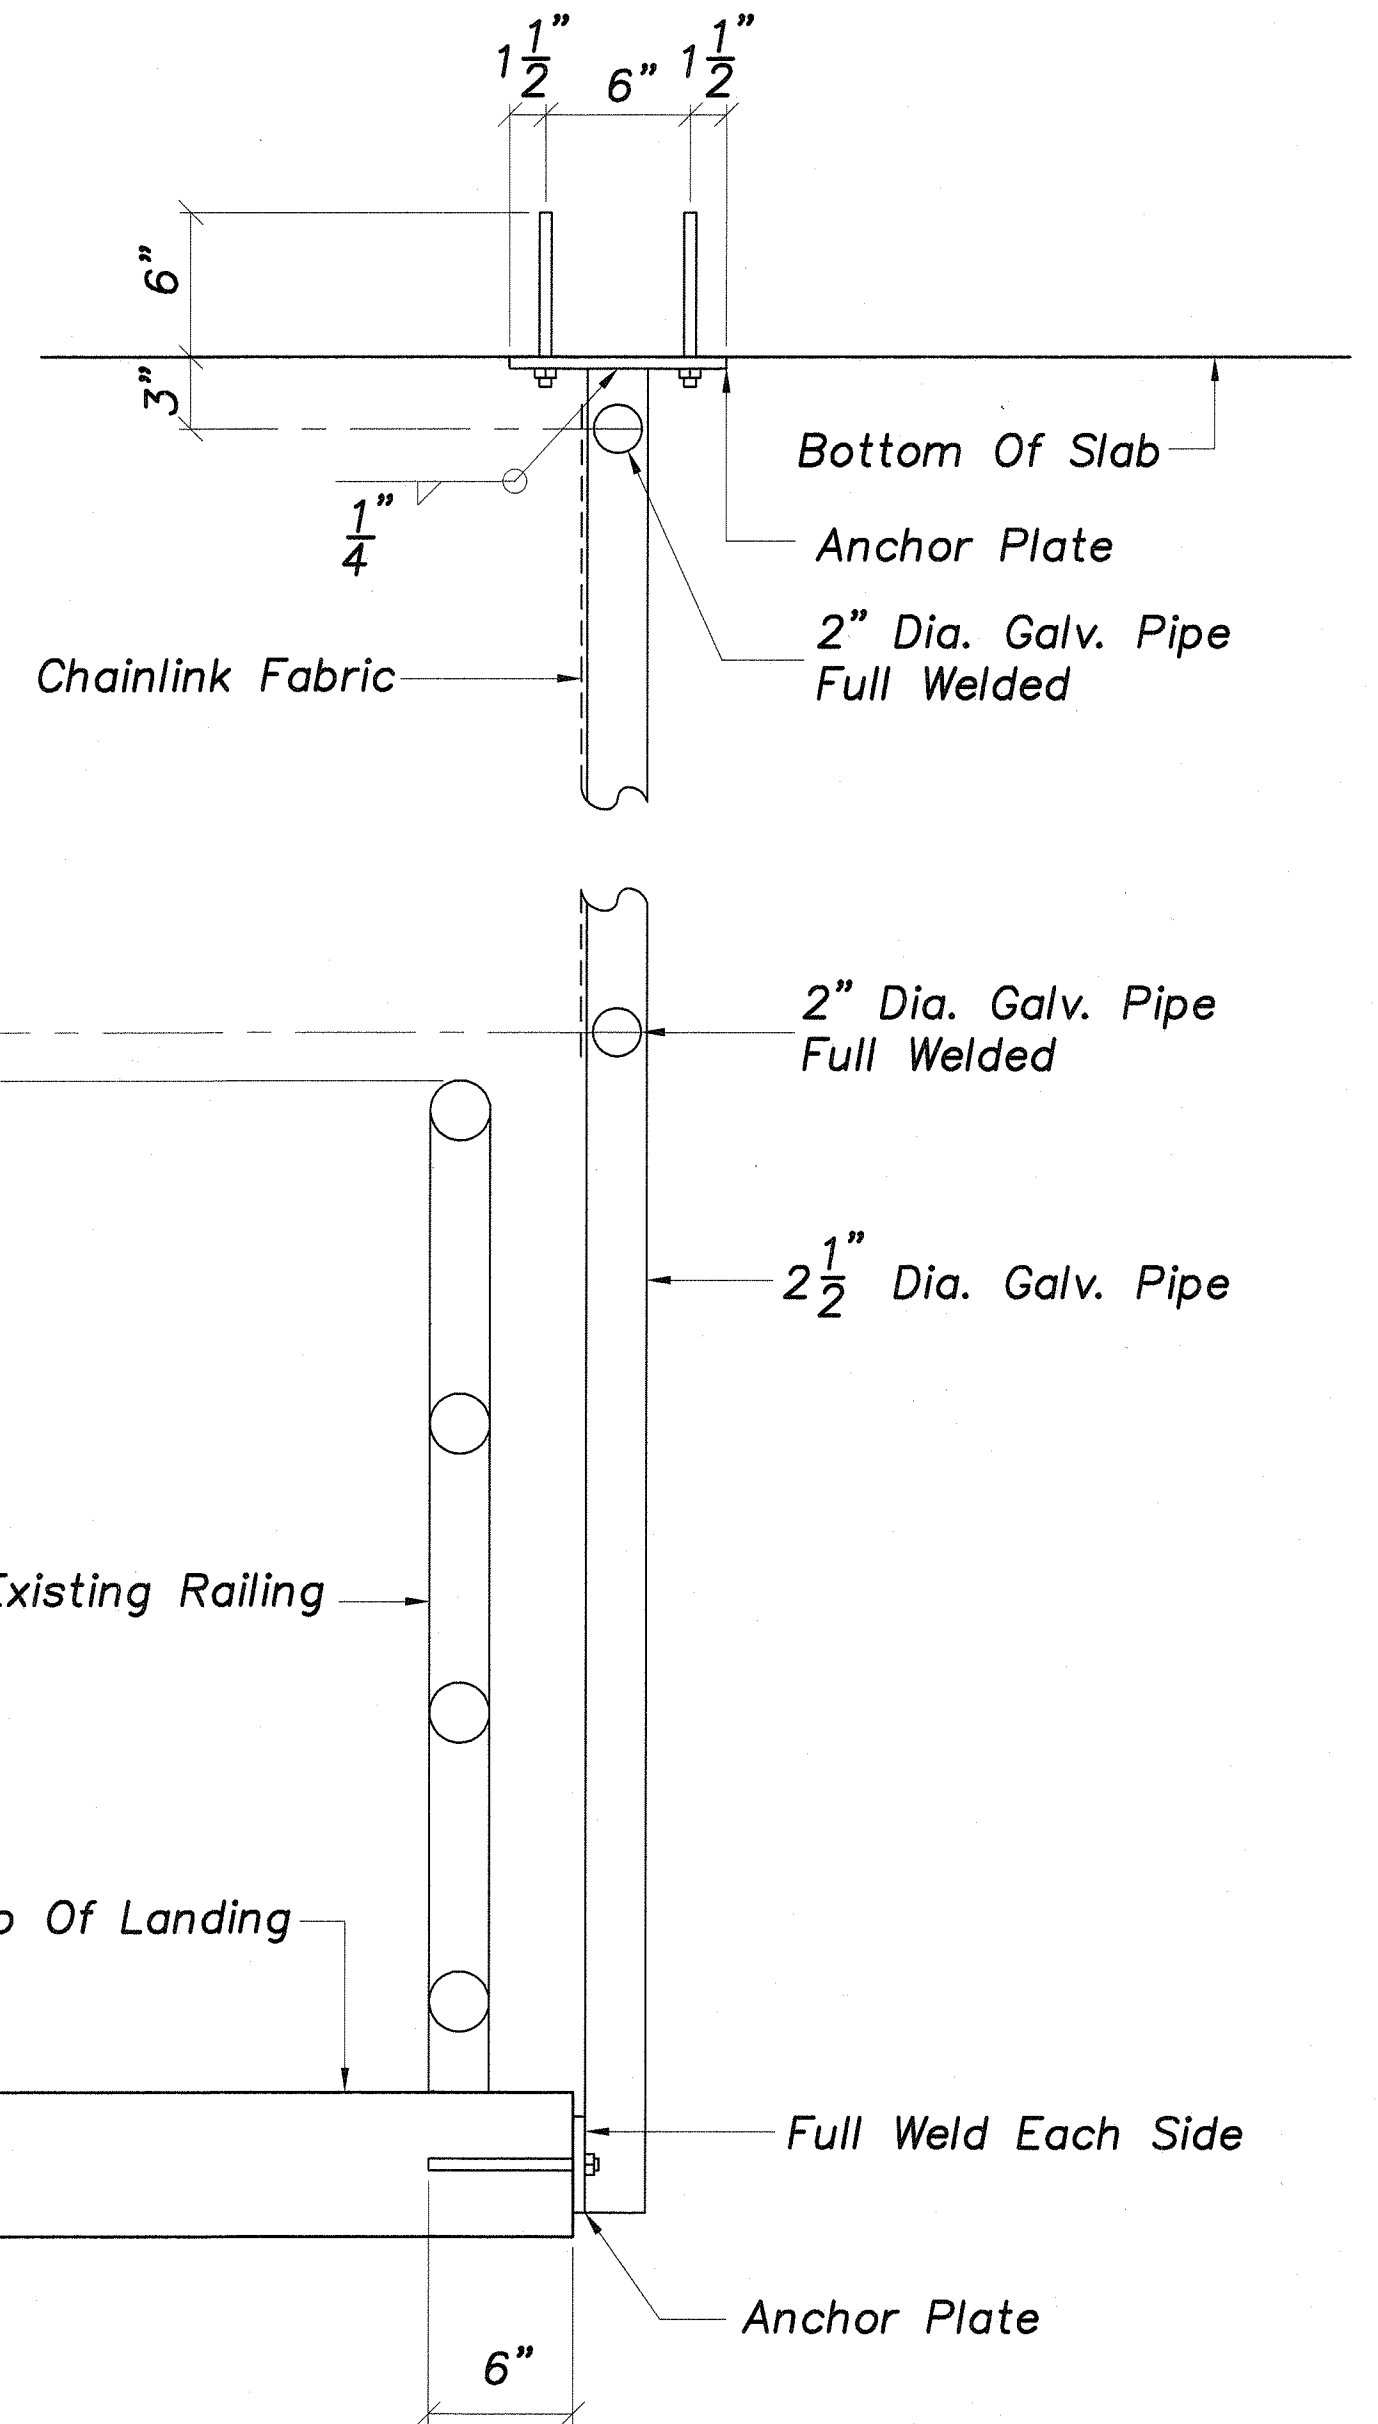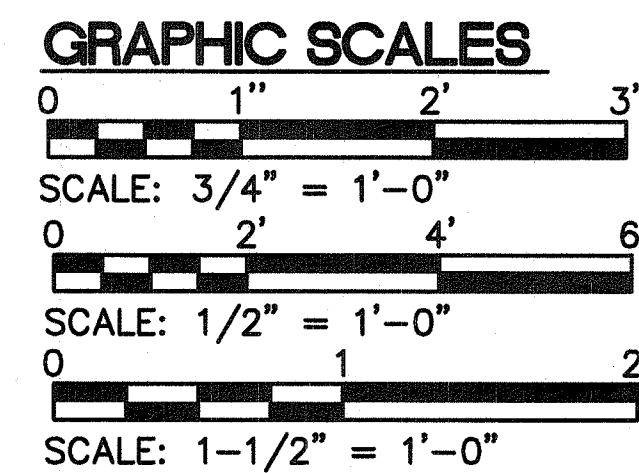


SECTION
 Scale: 1-1/2"=1'-0"


SURVEY PLOTTED BY	DATE
DRAWN BY	
TRACED BY	
QUANTITIES BY	
CHECKED BY	
ORIGINAL PLAN	
NOTEBOOK	
No.	

DATE	REVISION
	STATE OF HAWAII DEPARTMENT OF TRANSPORTATION HIGHWAYS DIVISION SERVICE STAIR DETAILS AND FALL PROTECTION BARRIER HAWAII BELT ROAD KUPAPULUA BRIDGE WIDENING HAMAKUA DISTRICT Federal Aid Project No. BR-019-2(38) Scale: As Noted Date: June 23, 2003 SHEET No. S-28A OF 36 SHEETS


FED. ROAD DIST. NO.	STATE	FED. AID PROJ. NO.	FISCAL YEAR	SHEET NO.	TOTAL SHEETS
HAWAII	HAW.	BR-019-2(38)	2002	72A	79

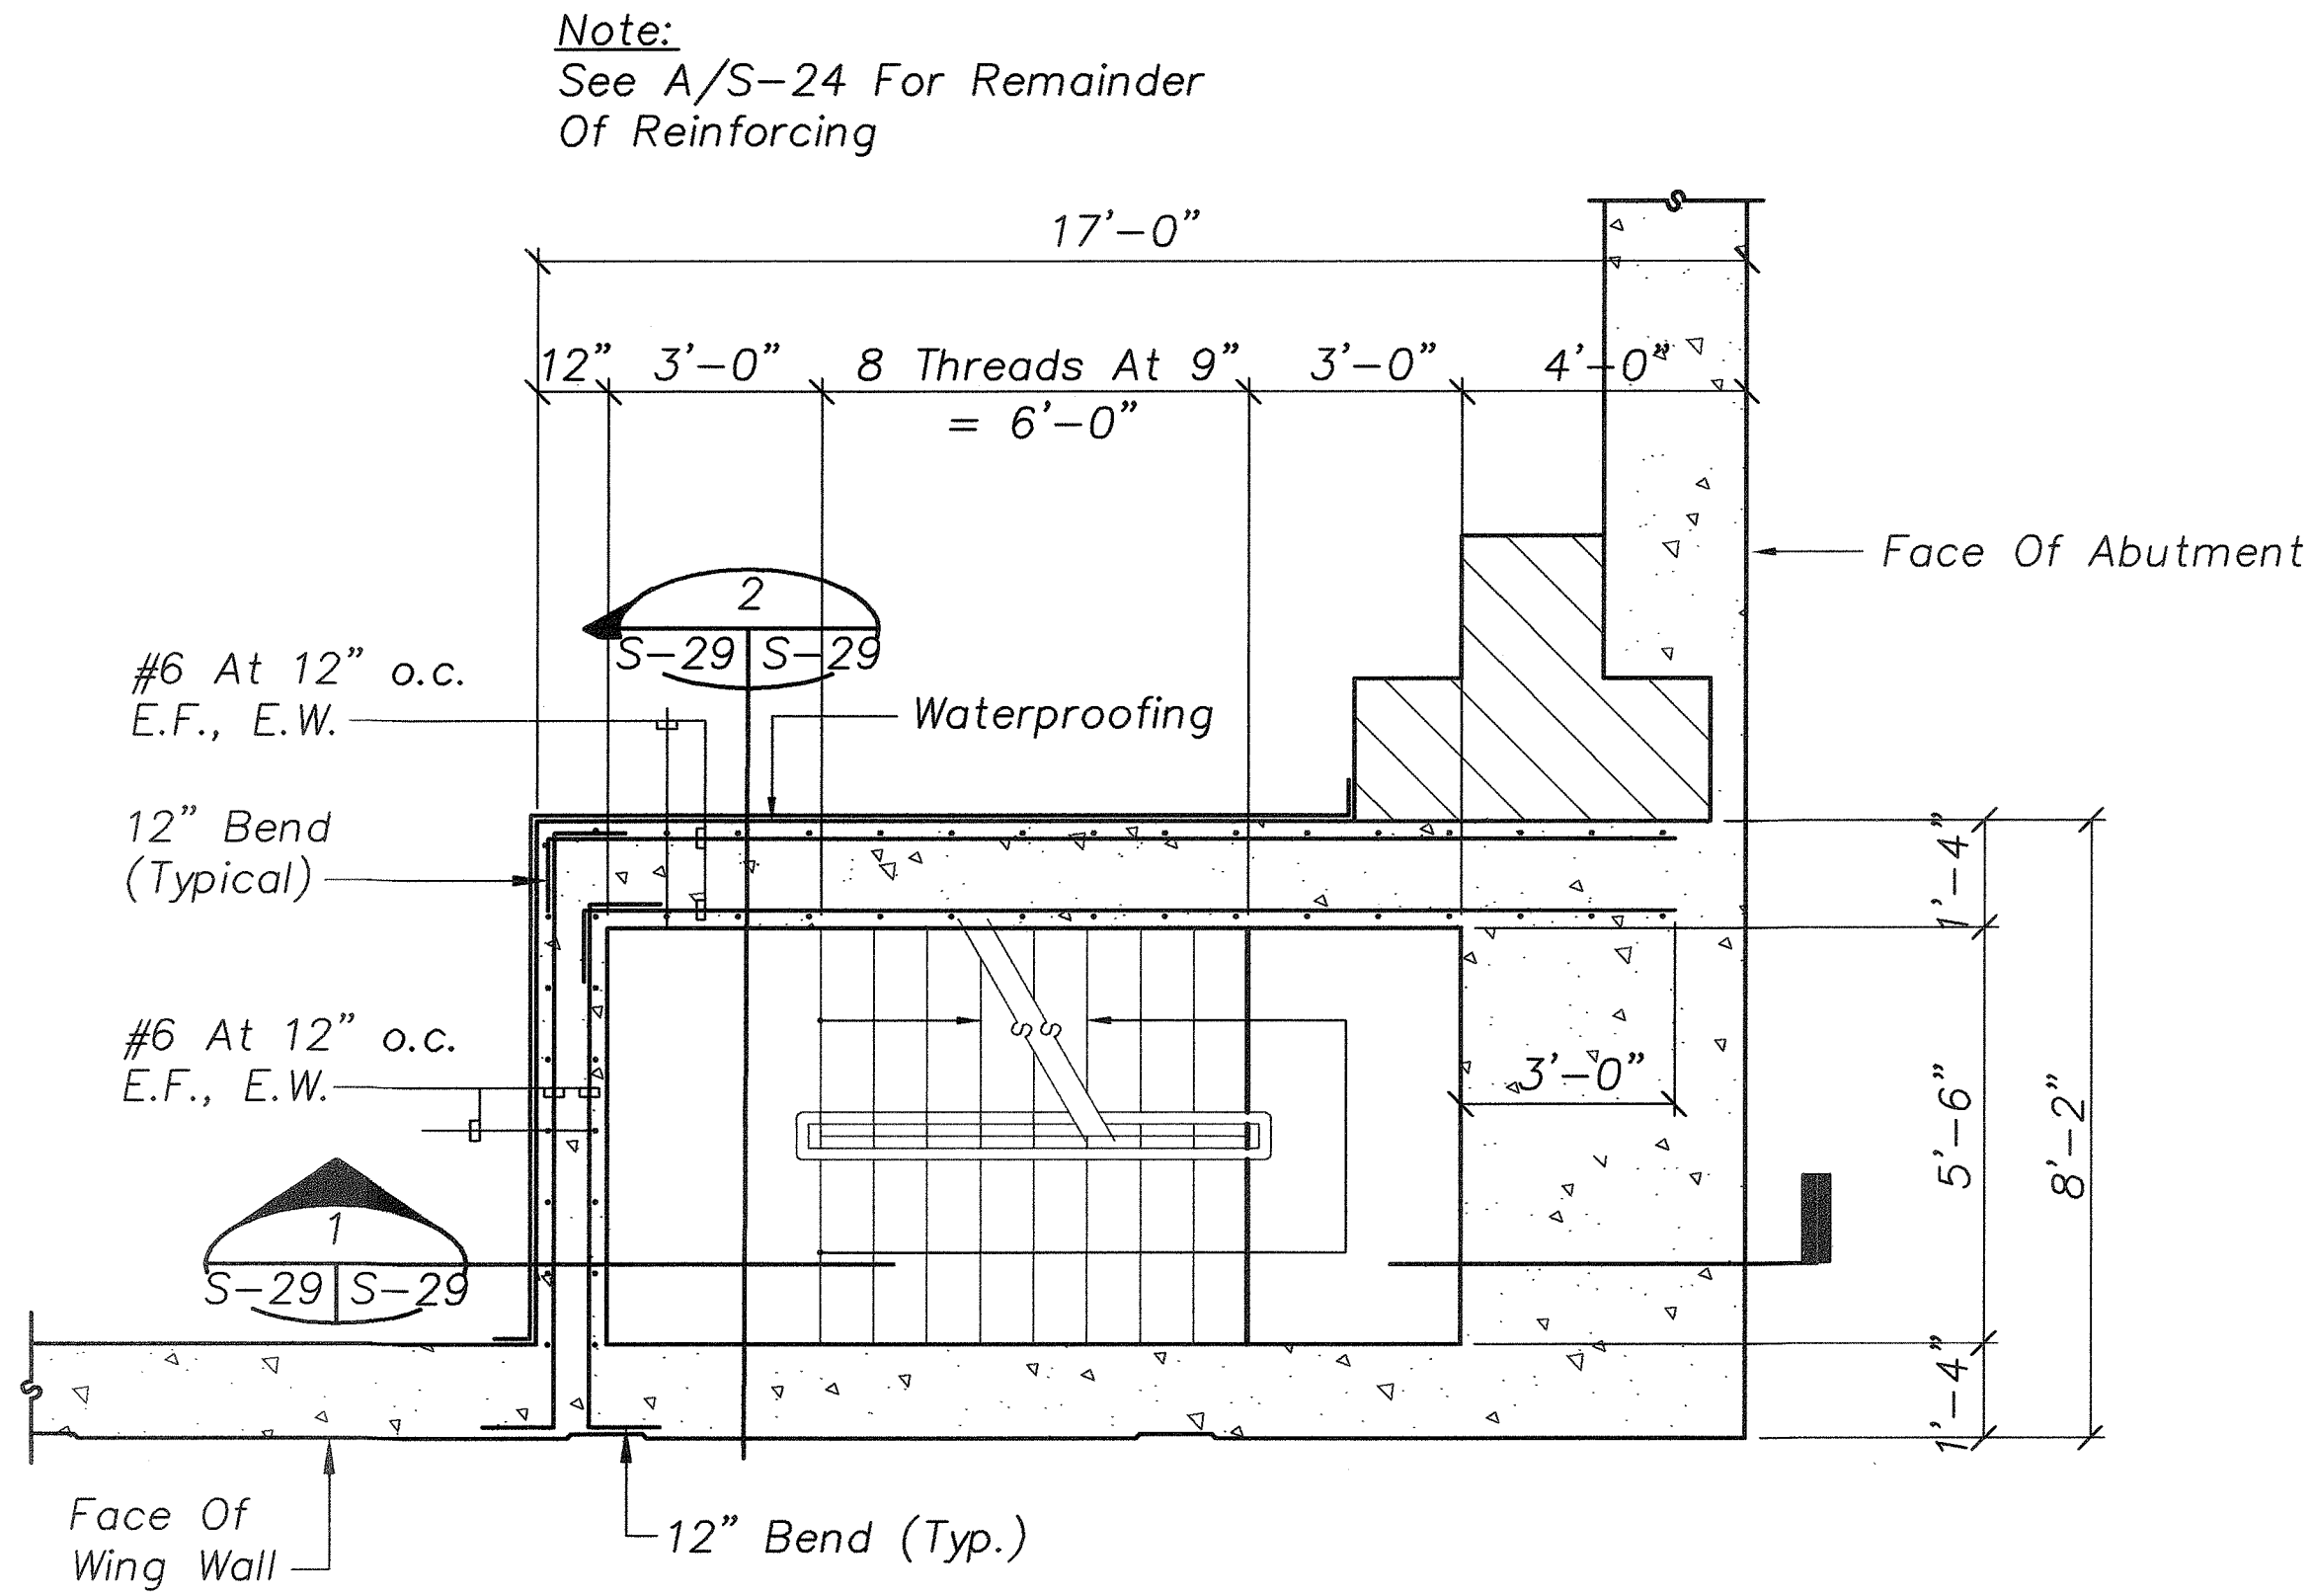


WALL REINFORCING PLAN AT SERVICE STAIRS
S-28|S-29 Scale: 3/8"=1'-0"

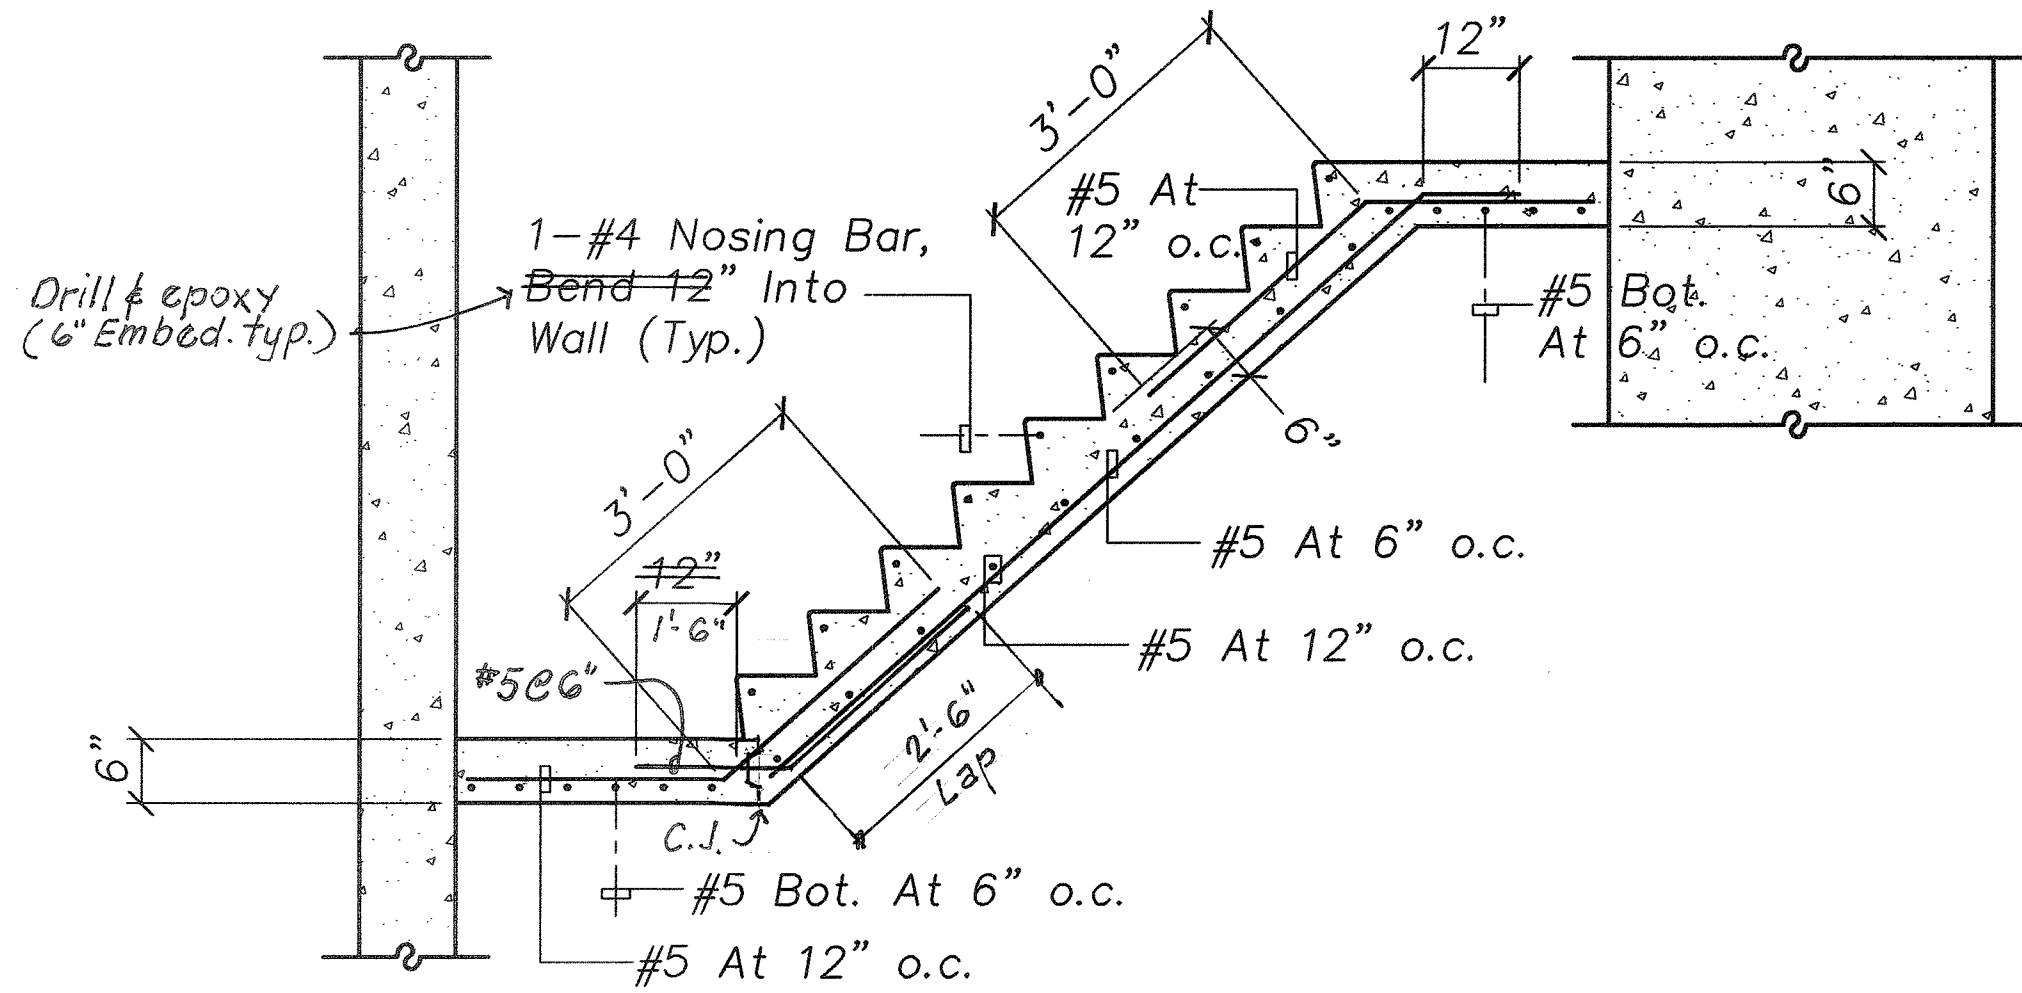


SECTION THRU STAIR
S-29|S-29 Scale: 1/2"=1'-0"

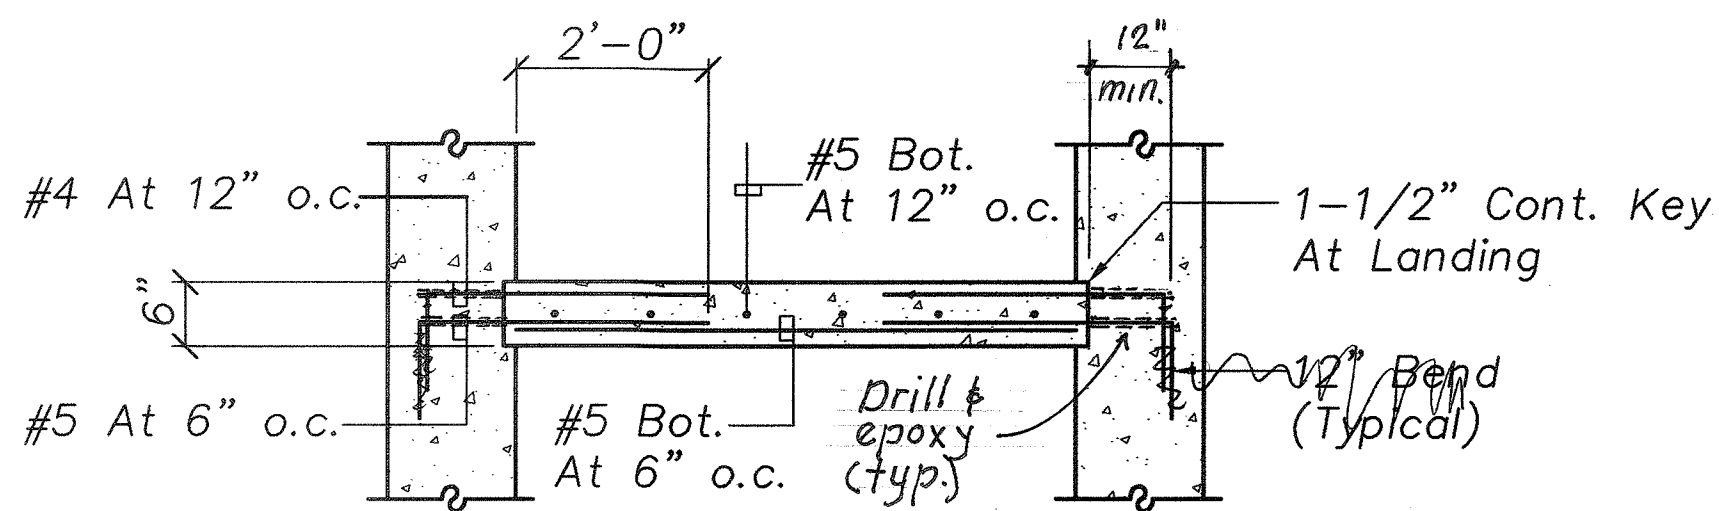

SECTION THRU LANDING
S-29|S-29 Scale: 1/2"=1'-0"

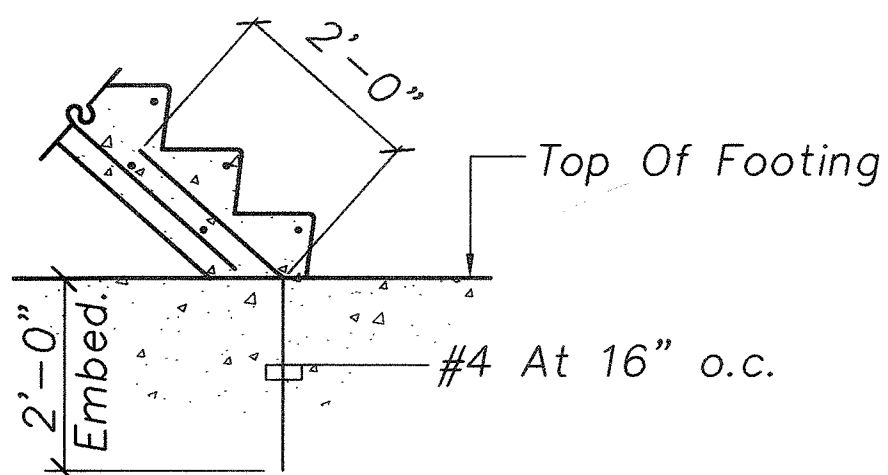


SECTION
S-28|S-29 Scale: 1/2"=1'-0"

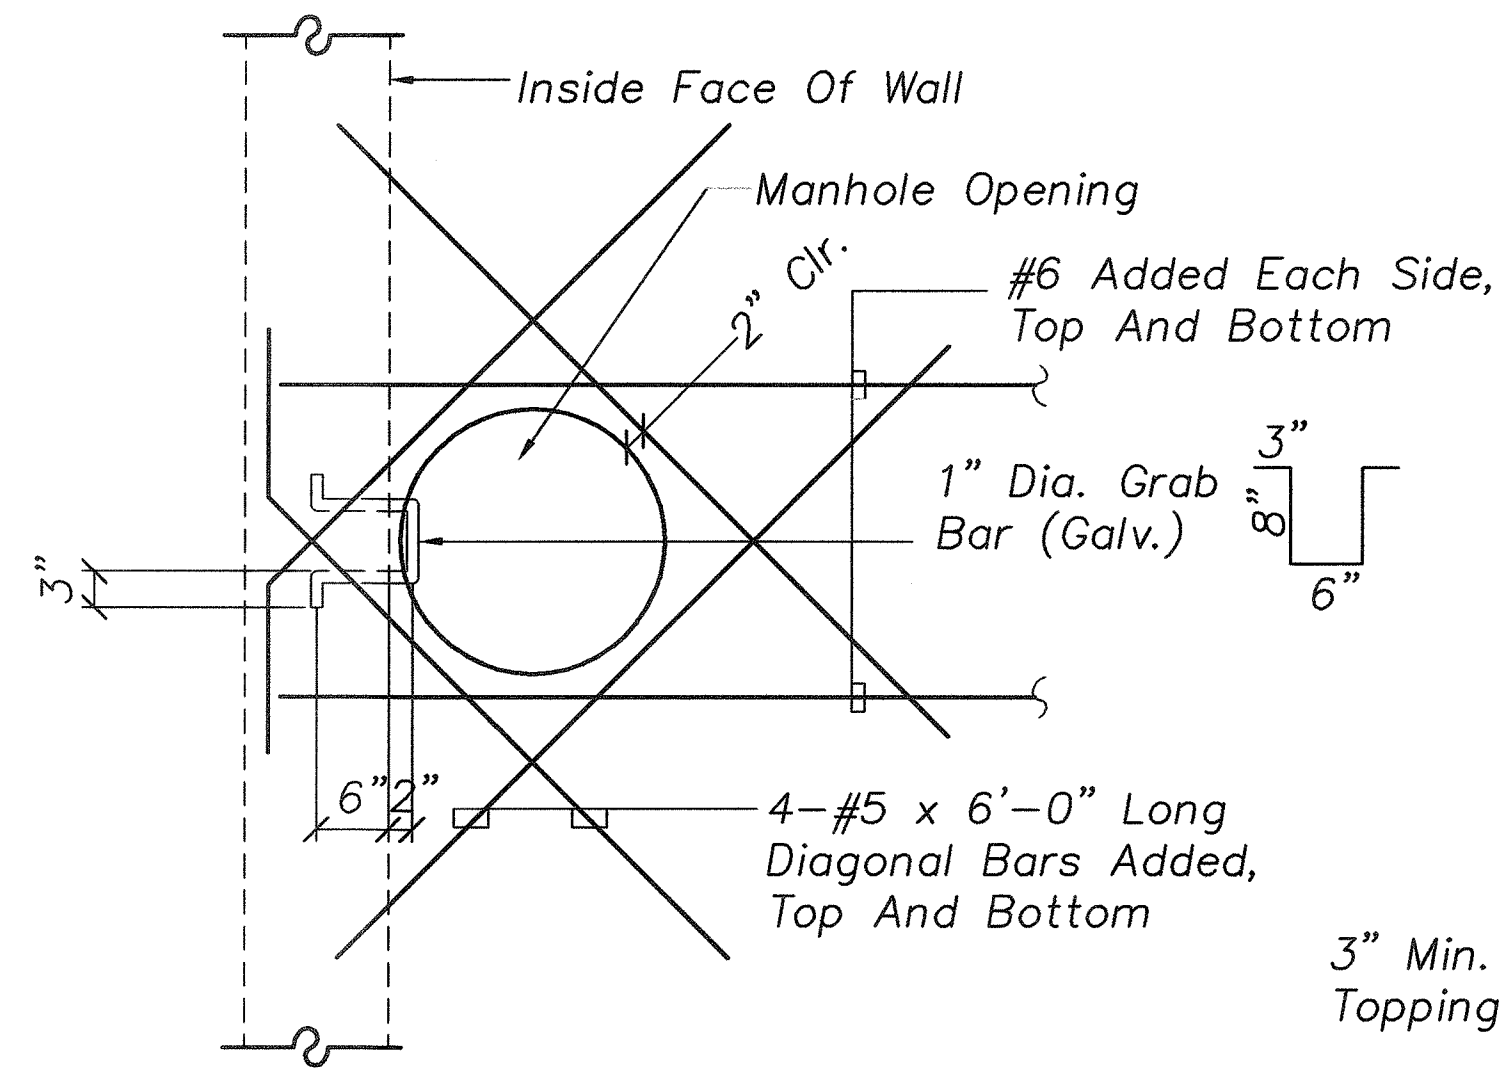


PLAN VIEW

Note:
Manhole Frame And Cover Shall Be Type "P" Cast Iron. See State DOT Standard Plan H-08.
Identification On Top View Of Cover Shall Be "Service DOT."

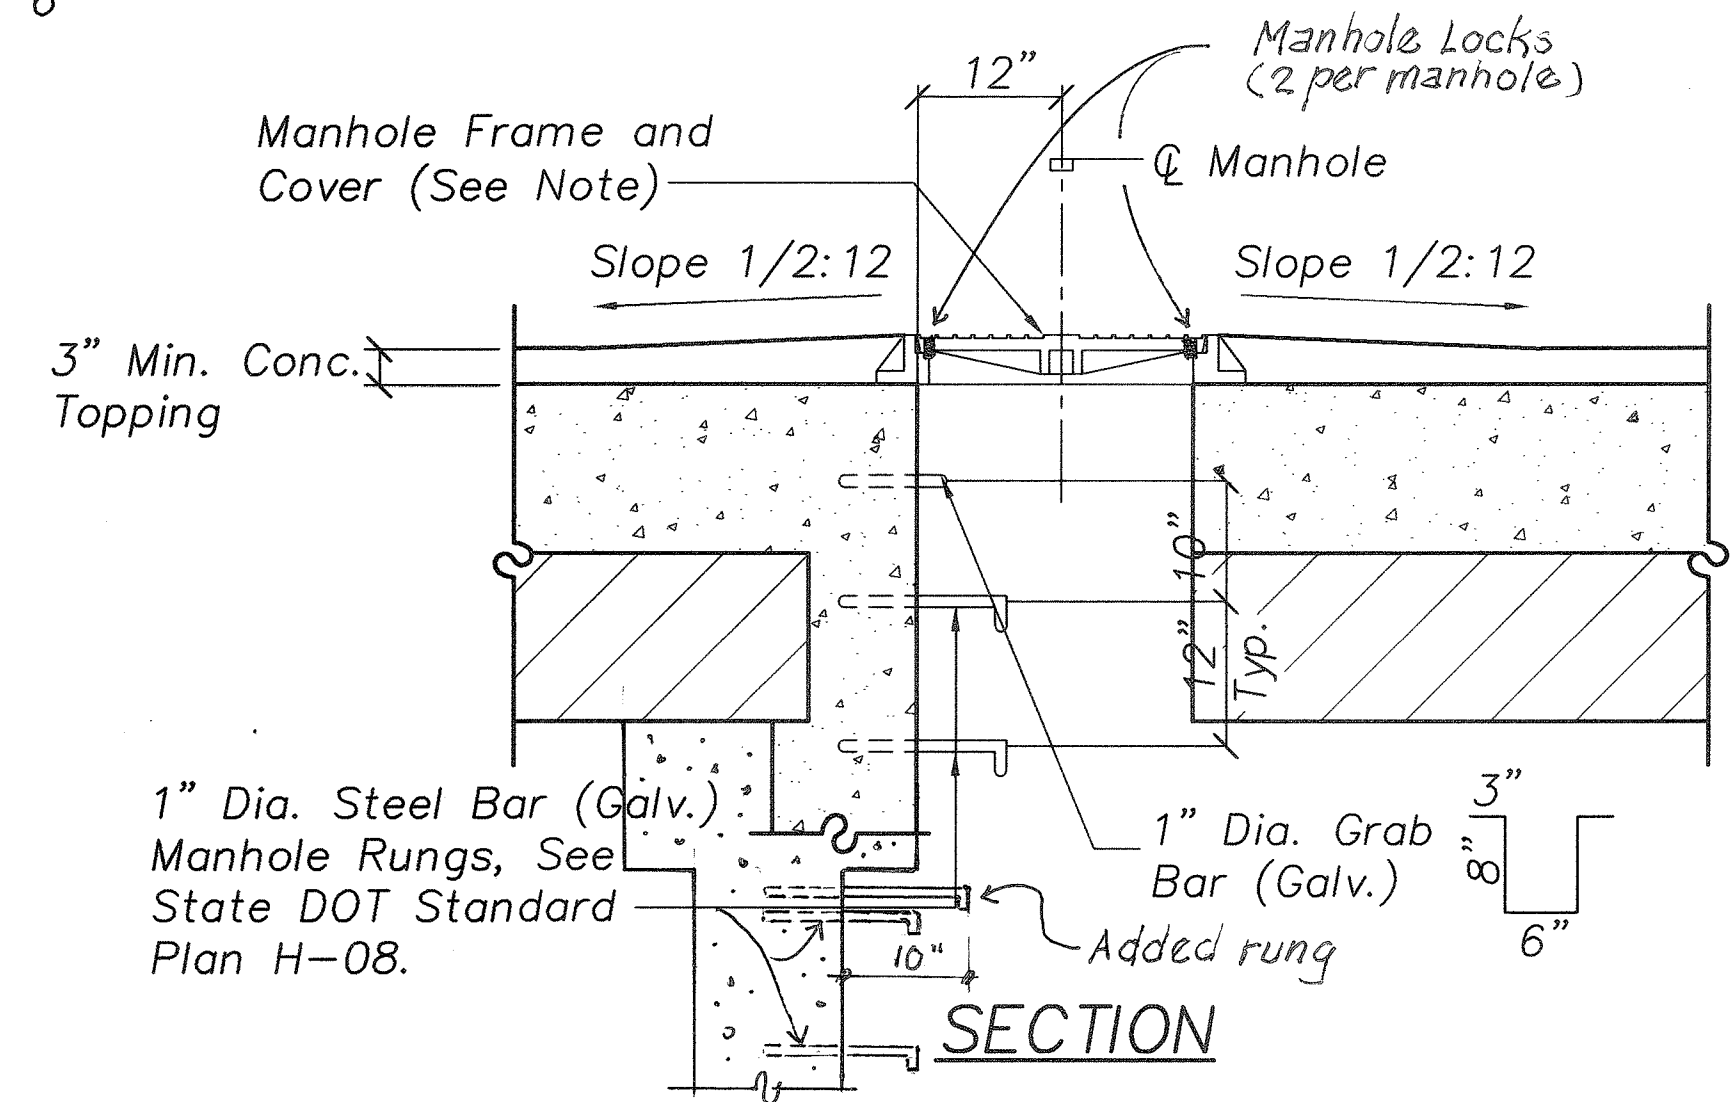

MANHOLE OPENING DETAIL
S-28, S-36|S-29 Scale: 3/4"=1'-0"

GRAPHIC SCALES

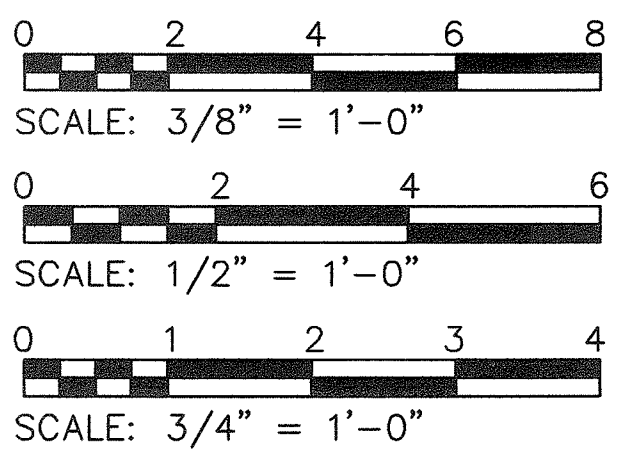

THIS WORK WAS PREPARED BY
ME OR UNDER MY SUPERVISION

Myron Okubo

DATE	REVISION
	STATE OF HAWAII DEPARTMENT OF TRANSPORTATION HIGHWAYS DIVISION SERVICE STAIR DETAILS HAWAII BELT ROAD KUPAPAUUA BRIDGE WIDENING HAMAKUA DISTRICT Federal Aid Project No. BR-019-2(38) Scale: As Noted Date: June 23, 2003 SHEET No. S-29 OF 36 SHEETS

"AS-BUILT"

SURVEY PLOTTED BY	DATE
DRAWN BY	
DESIGNED BY	
QUANTITIES BY	
CHECKED BY	
ORIGINAL PLAN	
NO.	

Path: L:\WQA\6670-01 Kupapaulua Bridge\Struct\NEW-1 File name: S31 Plot date: Sep 25, 2006-08:06:13pm CAD User: skidari Xref File name: | Border | AUTODATE |

FED. ROAD DIST. NO.	STATE	FED. AID PROJ. NO.	FISCAL YEAR	SHEET NO.	TOTAL SHEETS
HAWAII	HAW.	BR-019-2(38)	2002	74A	79


PRESTRESSED PLANK NOTES:

- Concrete shall have a Minimum Ultimate 28 Day Compressive Strength of 6000 PSI. Minimum Compressive Strength before Release of Strands is 4000 PSI.
- Prestressing Stands are One-half Inch Diameter, 7 Wire Low-Relaxation Steel Strands (Area = 0.1531 in²) with an Ultimate Strength of 270 KSI, and shall Conform to ASTM A416.
- Total Long Term Losses due to Creep, Shrinkage, Elastic Shortening and Relaxation of Steel Determined per AASHTO LRFD, Bridge Design Specifications, Second Edition, 1998, Section 5.9.5.
- Strands shall be Released in Such a Manner as to Minimize Lateral Eccentricity.
- Care shall be taken during Curing, Transportation and Erection to Avoid any Lateral Deflection of the Deck Plank.
- Lifting Devices or Other Embedded Items used to Lift and Transport the Deck Plank shall be Located as Close as Possible to the Plank Centerline of Bearing. The Deck Plank Supplier shall Submit Details Indicating the Adequate Type, and Location of Lifting Devices for Approval. Approval by the Engineer does not Relieve the Contractor of His Responsibilities if the Deck Plank is Damaged due to Failure of the Lifting Devices.
- Reinforcing to Conform to ASTM A615, Grade 60.

- Strand Pattern shall be Symmetrical About the Longitudinal Centerline of the Deck Planks.
- The Contractor shall Submit His Proposed Strand Pattern and Releasing Sequence to the Engineer for Approval.
- The Contractor shall Incorporate all Holes, Inserts, and other Embedded Items Required in Deck Planks during Fabrication of the Deck Planks.
- For Prestressed Concrete Deck Planks, the Contractor shall Measure and Record Slippage of Strands. Slippage is the Amount of Movement that a Point on the Strand at the End of the Girder Recedes into the Member after Detensioning. For Slippage Monitoring Purposes, Prior to Detensioning, Reference Marks shall be made on the Strands not more than Two Inches from the Surface of the Member End. The Movement of the Reference Mark shall be Measured to One-sixteenth of an Inch.
- After Detensioning, the Strand Reference Marks shall be Preserved to Permit Measurements of Strand Movement to the Time the Strands are made Flush with the Member. The Contractor shall Submit His Proposed Method of Strand Slippage Measurement with the Shop Drawings. The Engineer will Monitor the Contractor's Method of Measurement and the Slippage Values Obtained.
- Minimum Bearing for Precast Plank shall be 3".
- Extend Prestressing Strands 6" past end of Plank.

PLANK CAMBER NOTES:

- The Calculated Camber Includes the Effect of the Initial Prestress Force and the Weight of the Deck Plank after Removal from the Bed. Negative Values Shown for Calculated Camber Indicate a Net Upward Deflection. The Calculated Camber Value has been Multiplied by Applicable Factors Provided in PCI Handbook Table 4.6.2. to Approximate the Effect of Camber Growth and Concrete Creep. The Actual Camber shall not Exceed the Calculated Camber by more than One-half inch.
- The Dead Load Deflection Includes the Multipliers of PCI Table 4.6.2.. See Prestressed Plank Table I this Sheet. The Dead Load Deflection has added the Camber and the Net Deflection is Shown in Table I.
- Contractor shall Camber the Deck Plank with Cribbing Support During Storage to Account for the Calculated Dead Load Deflection in Order to Provide the Specified Finish Deck Elevations.
- All Cambers and Deflections are in Inches.

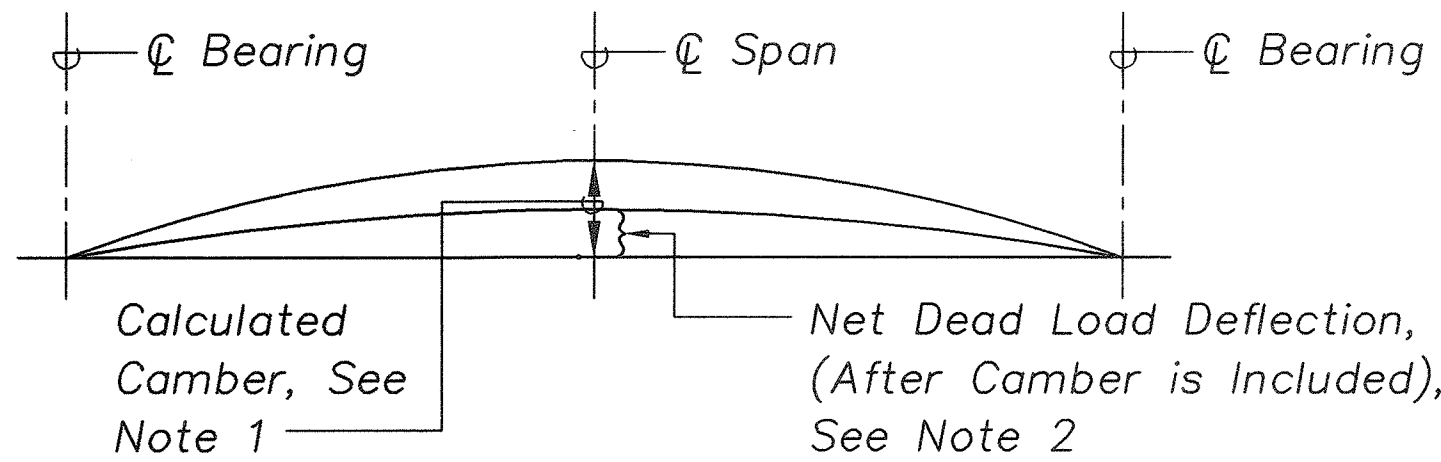

PLANK CAMBER DIAGRAM

Scale: None


PRESTRESSED PLANK TABLE I

Deck Plank Mark	Size (b x d)	Topping	Length ϕ to ϕ of Pier (1)	CGS (From Bot. of Plank) (inches)	Fe (kips)	Calculated Camber (+ Down)	Dead Load Deflection (+ Down)	Bottom Reinforcing (See Note 2)	Stirrups (@ 12")	Remarks
P1	46 x 10	14"	16'-0"	3.50	277	-0.13	0.14	6-#8	#5	Exterior Plank, See EB1, Sht. S-20
P1a	46 x 10	14"	16'-0"	3.50	277	-0.13	0.14	6-#8 4-#5	#5	Exterior Plank, See EB2,3,4, Sht. S-20
P2	60 x 10	6"	16'-0"	3.44	361	-0.14	-0.09	4-#5	#4	Interior Plank, See Sht. S-20
P3	42 X 10	6"	16'-0"	3.44	296	-0.28	-0.13	4-#5	#4	Interior Plank, See Sht. S-20
P4	48 x 14	14"	25'-0"	4.69	578	-0.23	0.26	4-#5	#4	Exterior Plank, See Sht. S-25
P4a	48 x 14	14"	25'-0"	4.69	578	-0.23	0.26	4-#5	#4	Exterior Plank, See Sht. S-25
P5	36 x 14	6"	25'-0"	4.69	327	-0.18	0.01	4-#5	#4	Interior Plank, See Sht. S-25
P6	54 x 14	6"	25'-0"	4.67	503	-0.20	-0.02	4-#5	#4	Interior Plank, See Sht. S-25
P7	48 x 14	14"	11'-0"	4.69	145	-0.01	-0.00	4-#5	#4	Exterior Plank, See Sheet S-36
P8	36 x 14	6"	11'-0"	4.69	101	-0.01	-0.01	4-#5	#4	Interoir Plank, See Sheet S-36

Notes:

- Refer to Pier Details to Determine Distance from ϕ Pier to End of Deck Plank.
- Refer to Pier Detail for Extension of 6-#8 Bottom Reinforcing beyond Ends at Deck Plank.
- Refer to Deck Plank Section for Layout Arrangement of Reinforcing.
- Fe in Prestressed Plank Table I is After all Losses.

ORIGINAL PLAN	SURVEY PLOTTED BY	DATE
	DRAWN BY	
	TRACED BY	
	DESIGNED BY	
NOTEBOOK	QUANTITIES BY	
	CHECKED BY	
No.		







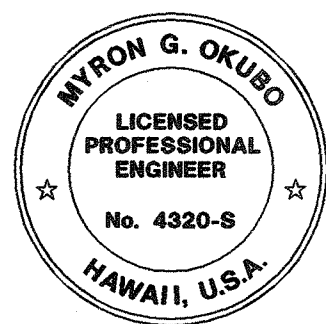


THIS WORK WAS PREPARED BY ME OR UNDER MY SUPERVISION

Myron Okubo

DATE	REVISION
STATE OF HAWAII DEPARTMENT OF TRANSPORTATION HIGHWAYS DIVISION PRESTRESSED PLANK NOTES HAWAII BELT ROAD KUPAPAPULUA BRIDGE WIDENING HAMAKUA DISTRICT Federal Aid Project No. BR-019-2(38) Scale: As Noted Date: June 23, 2003	
SHEET No. S-31 OF 36 SHEETS	

FED. ROAD DIST. NO.	STATE	FED. AID PROJ. NO.	FISCAL YEAR	SHEET NO.	TOTAL SHEETS
HAWAII	HAW.	BR-019-2(38)	2002	75A	79

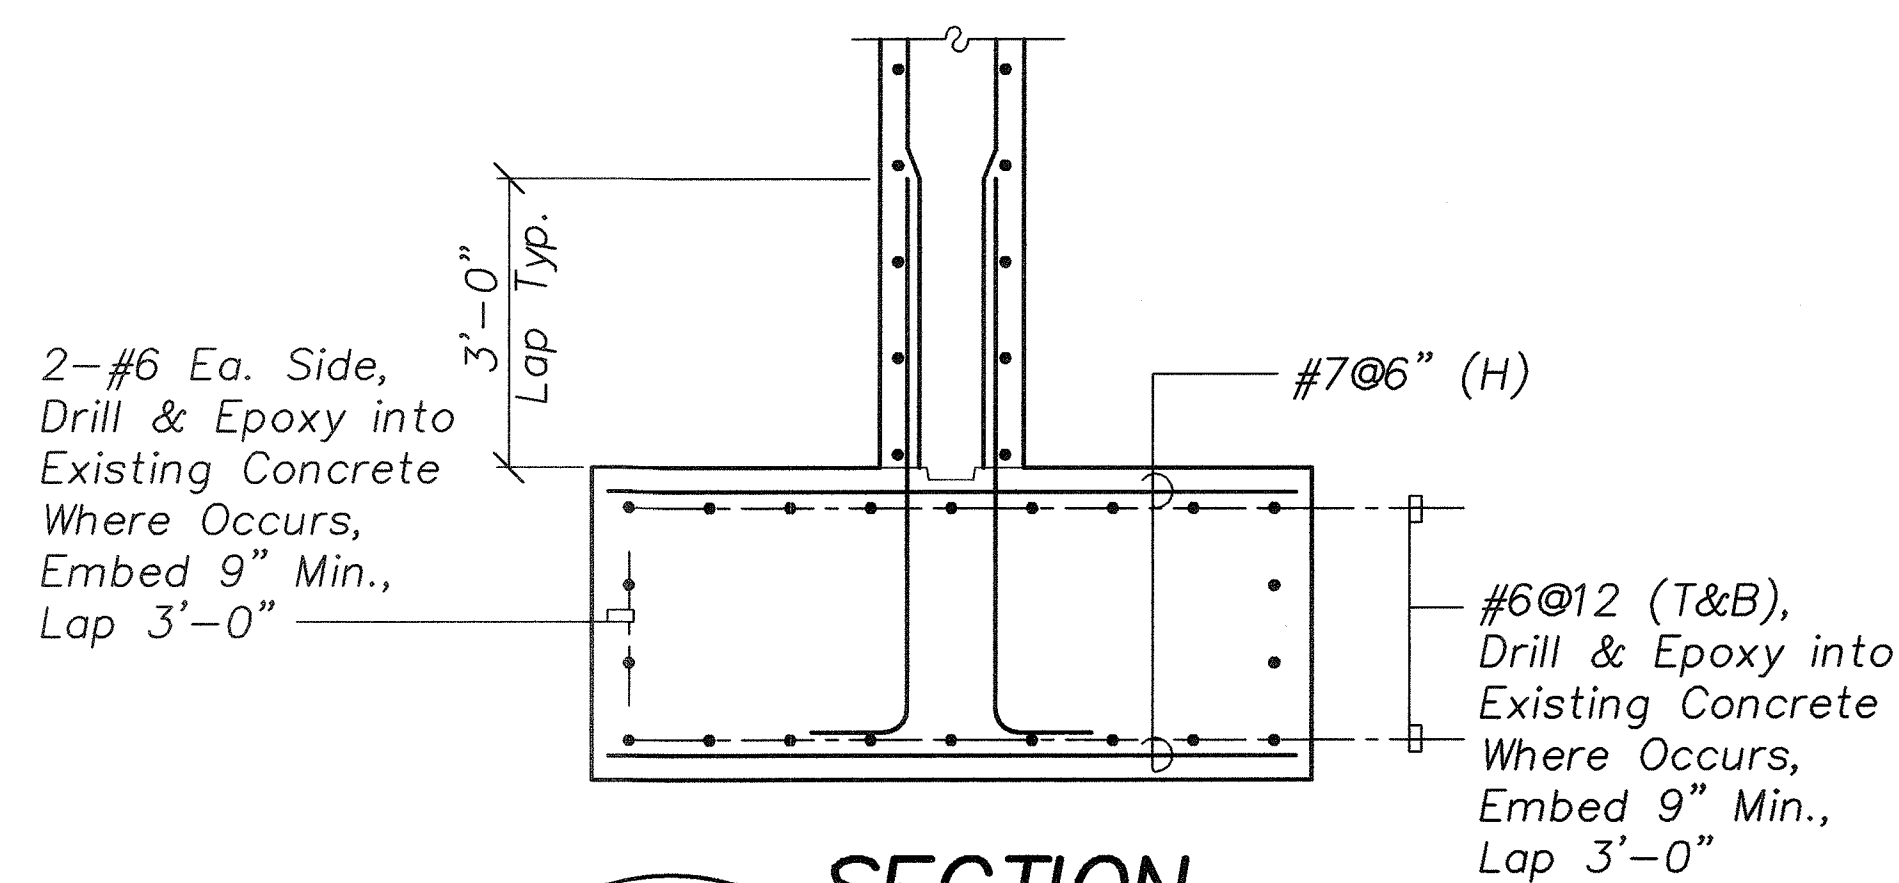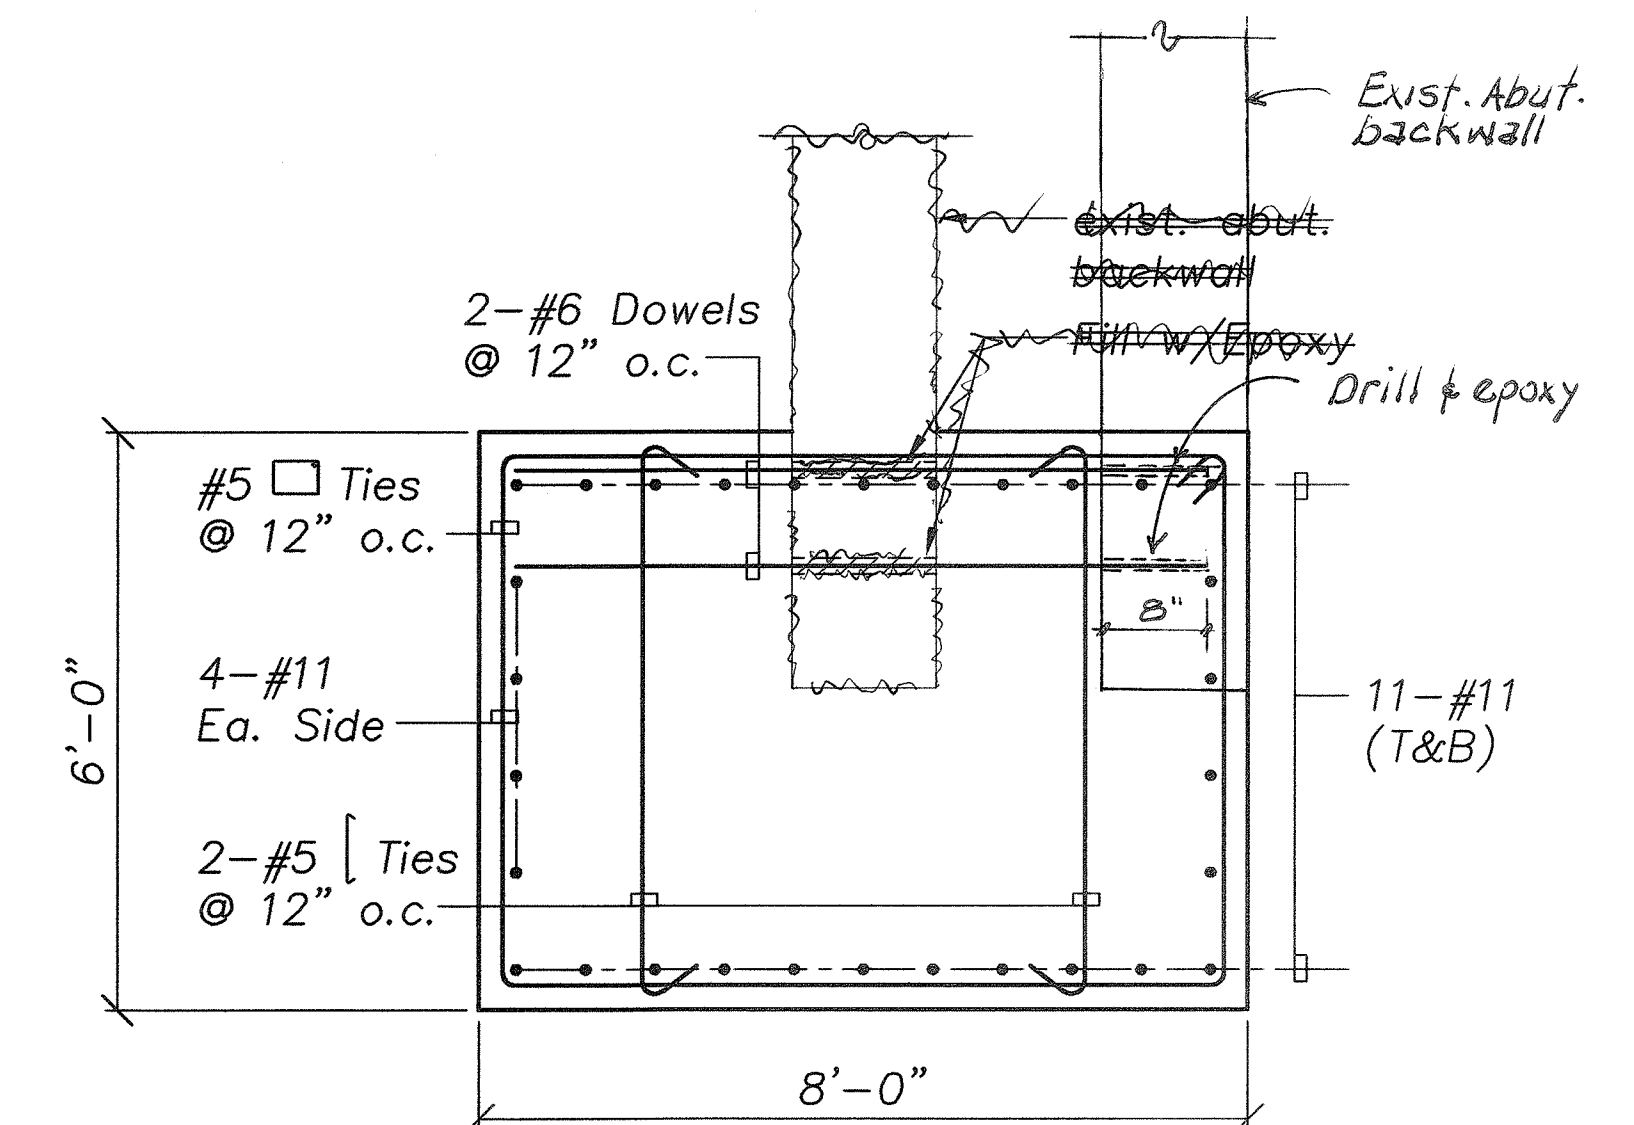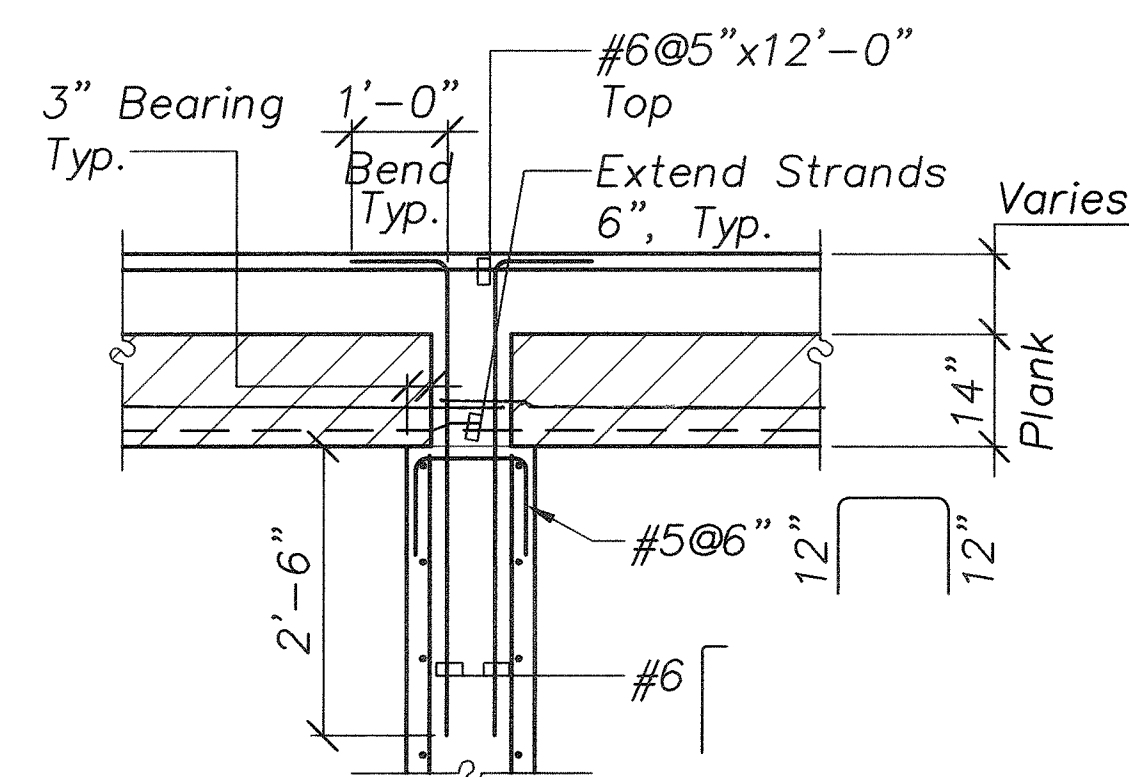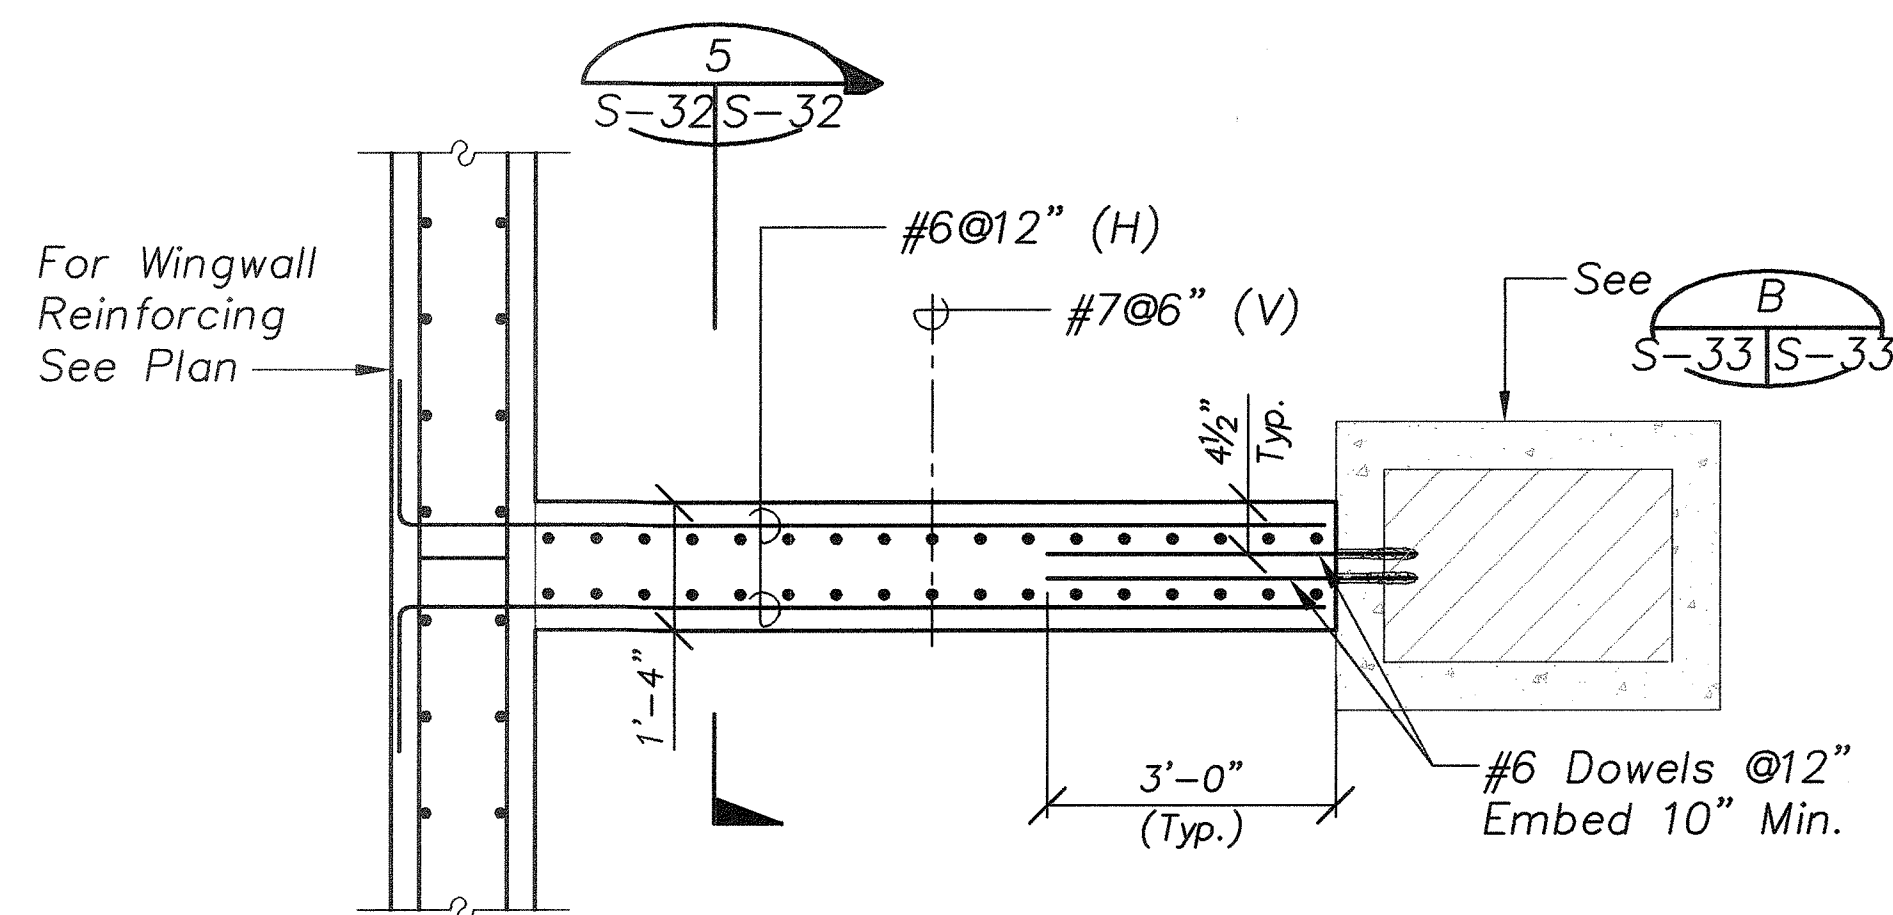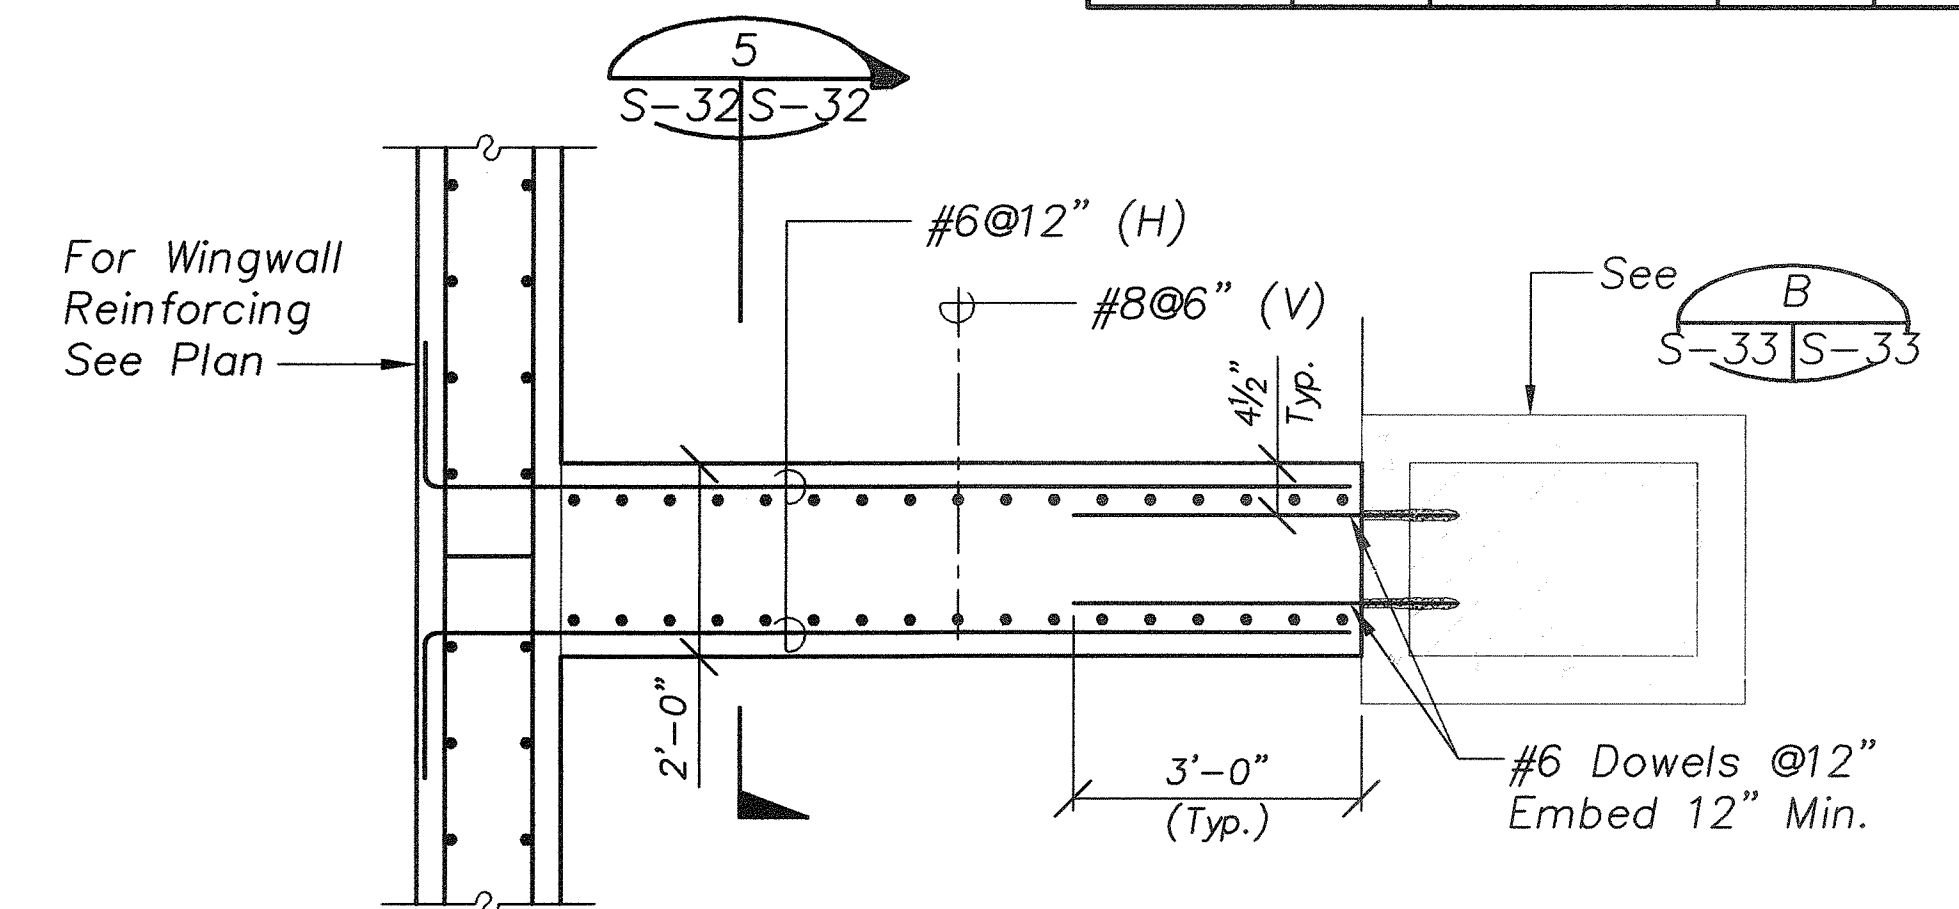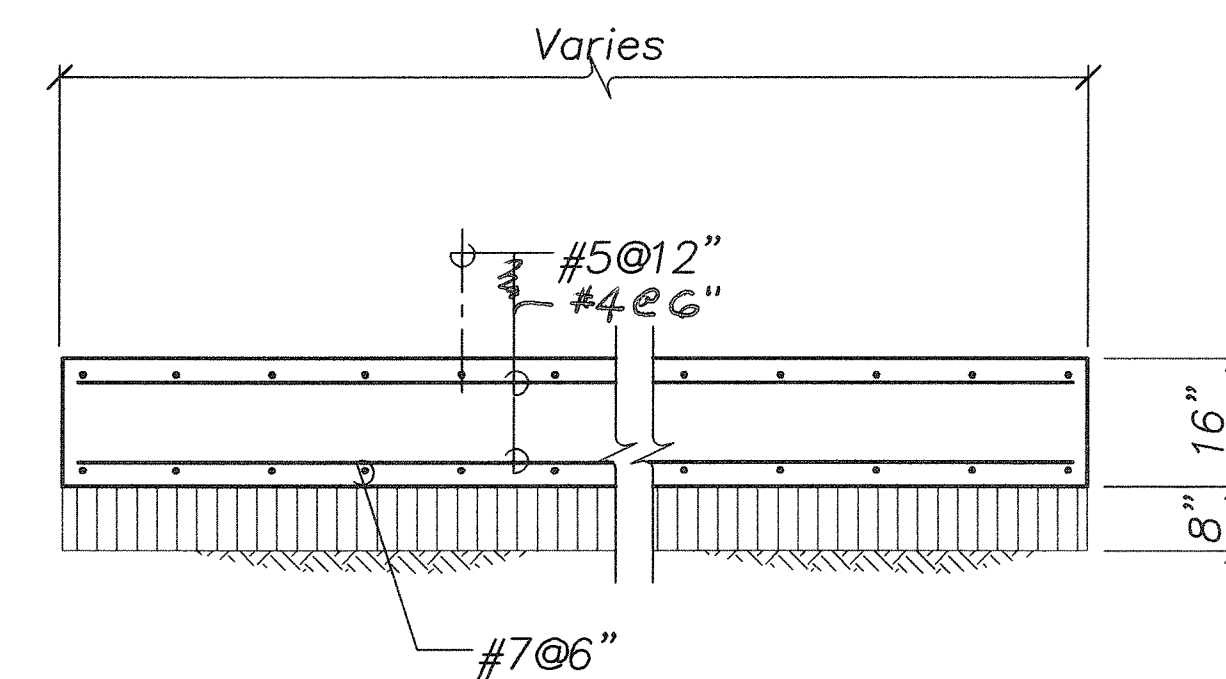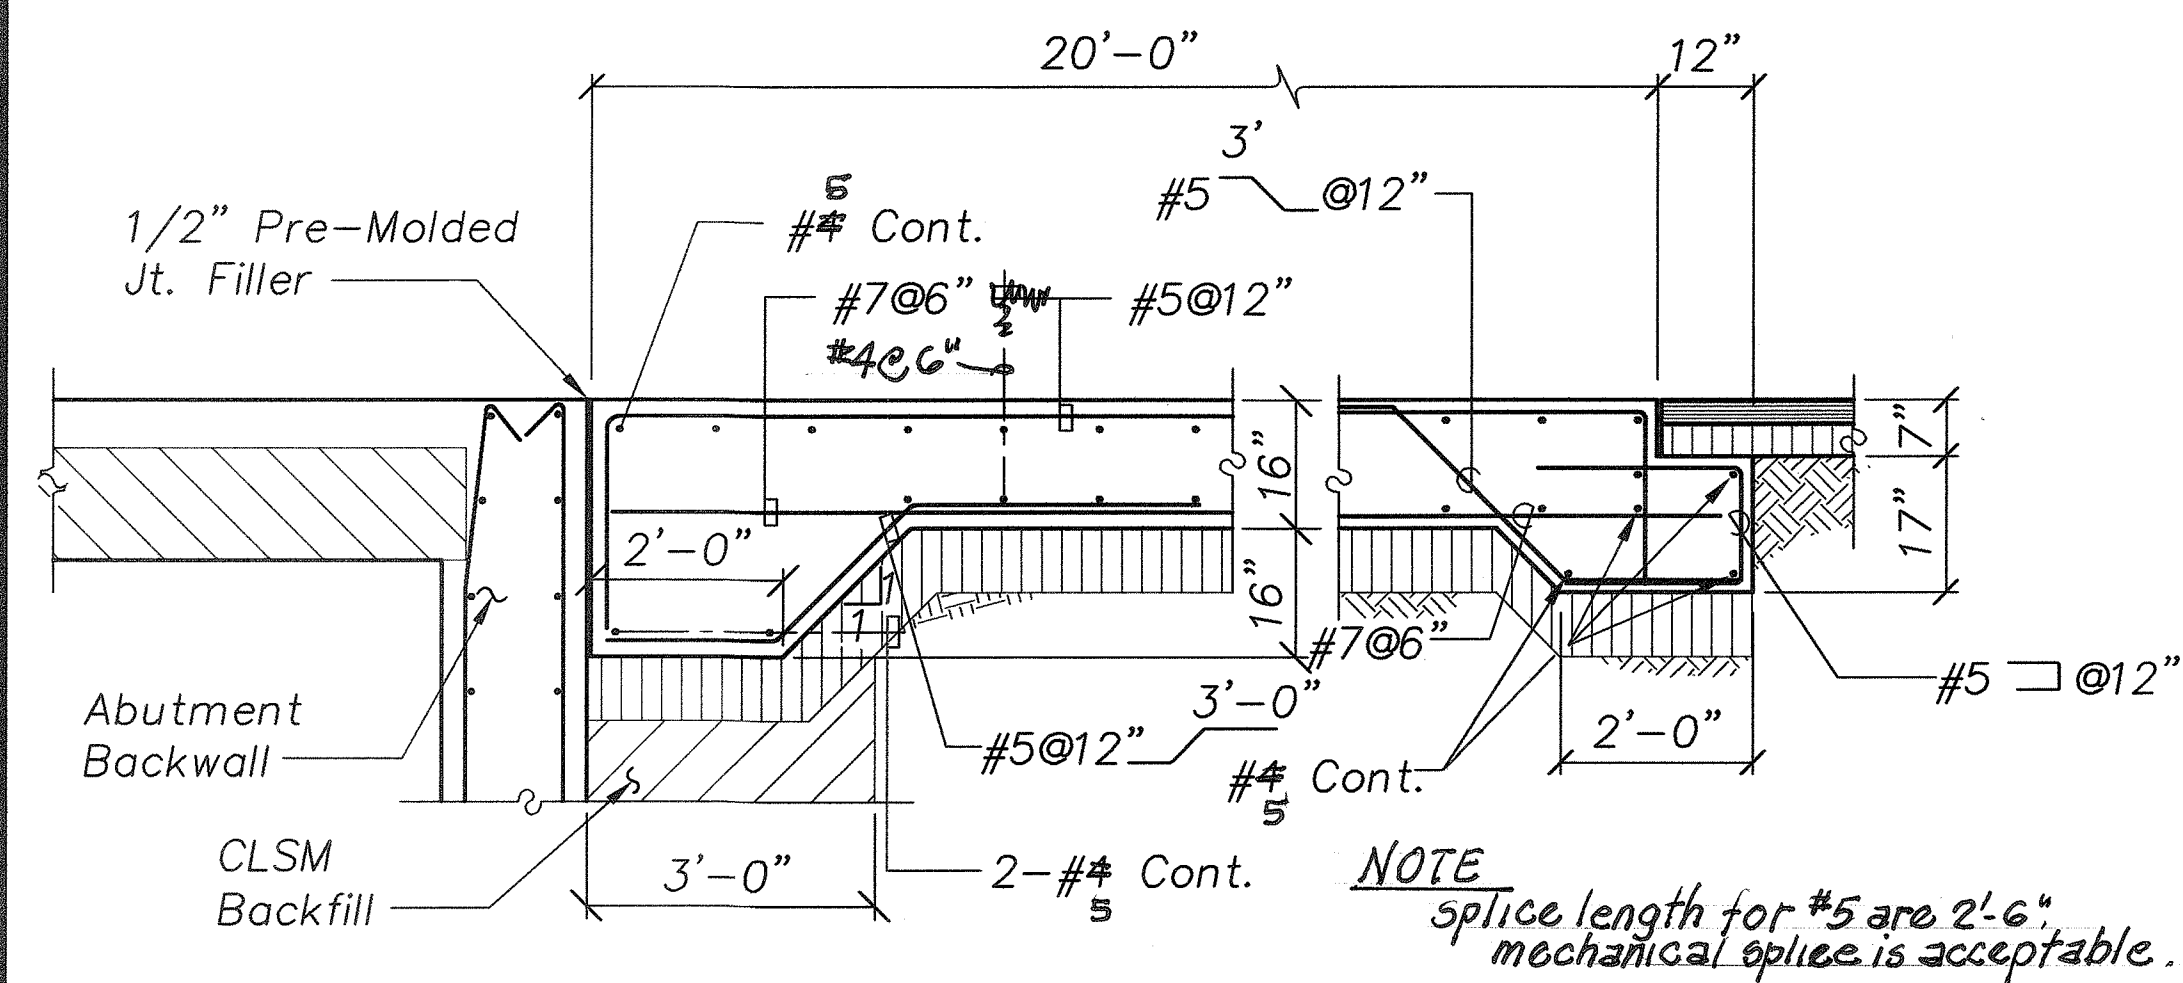

GRAPHIC SCALES

DATE	REVISION
STATE OF HAWAII DEPARTMENT OF TRANSPORTATION HIGHWAYS DIVISION MISCELLANEOUS DETAILS <u>HAWAII BELT ROAD</u> <u>KUPAPAAULUA BRIDGE WIDENING</u> <u>HAMAKUA DISTRICT</u> <u>Federal Aid Project No. BR-019-2(38)</u> Scale: As Noted Date: June 23, 2003	

THIS WORK WAS PREPARED BY
ME OR UNDER MY SUPERVISION


Myron Okubo

SHEET No. S-32 OF 36 SHEETS

"AS-BUILT"

75A


FED. ROAD DIST. NO.	STATE	FED. AID PROJ. NO.	FISCAL YEAR	SHEET NO.	TOTAL SHEETS
HAWAII	HAW.	BR-019-2(38)	2002	76A	79

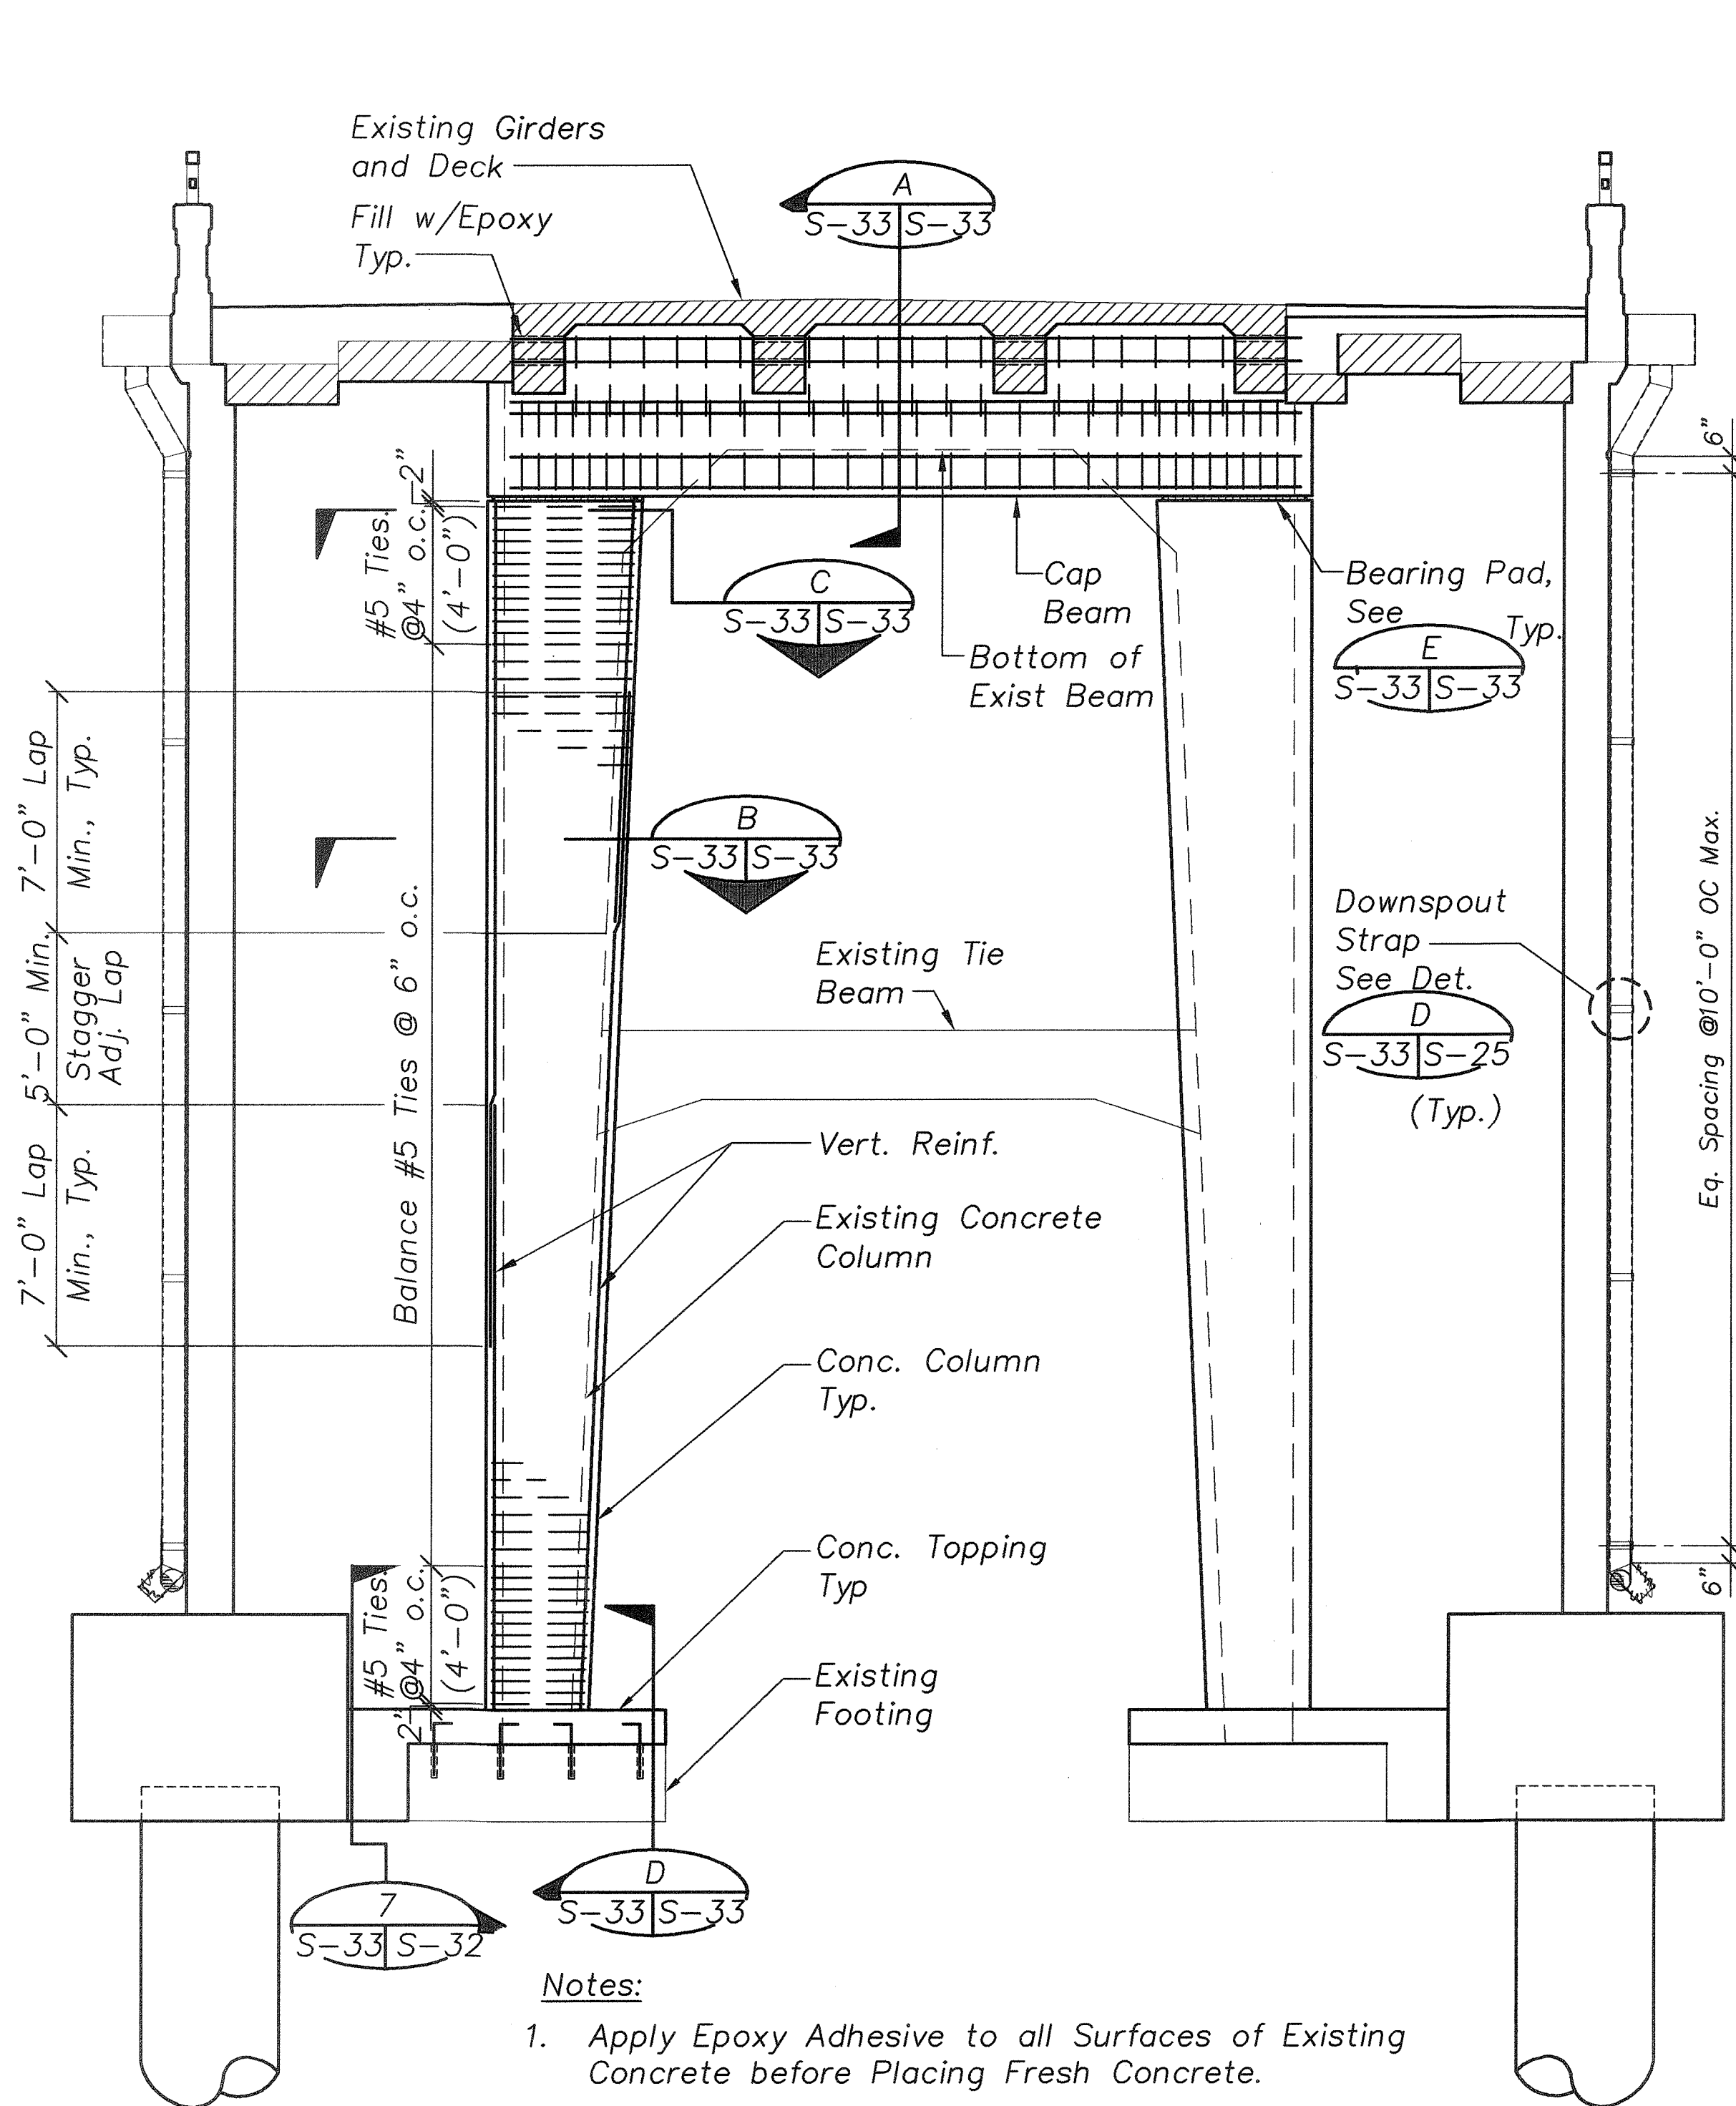


Notes:

1. Apply Epoxy Adhesive to all Surfaces of Existing Concrete before Placing Fresh Concrete.
2. Placement of Reinforcing Ties in Existing Columns:
 - A. Placement of Reinforcing Ties shall be such that the Bend in the Ties are in Contact with the Main Reinforcing Bars of the Column.
 - B. Only One (1) Face of Existing Column shall be Drilled at a Time for Placement for Reinforcing Ties.
 - C. Drilled Holes in Existing Columns shall be Cleaned, Filled with Epoxy, and Reinforcing Ties Set in Place Within an Eight (8) Hour Work Day.


PIER NO. 1 ELEVATION
S-33 S-33 Scale: 1/4"=1'-0" (Pier No. 17 and 18 Similar)

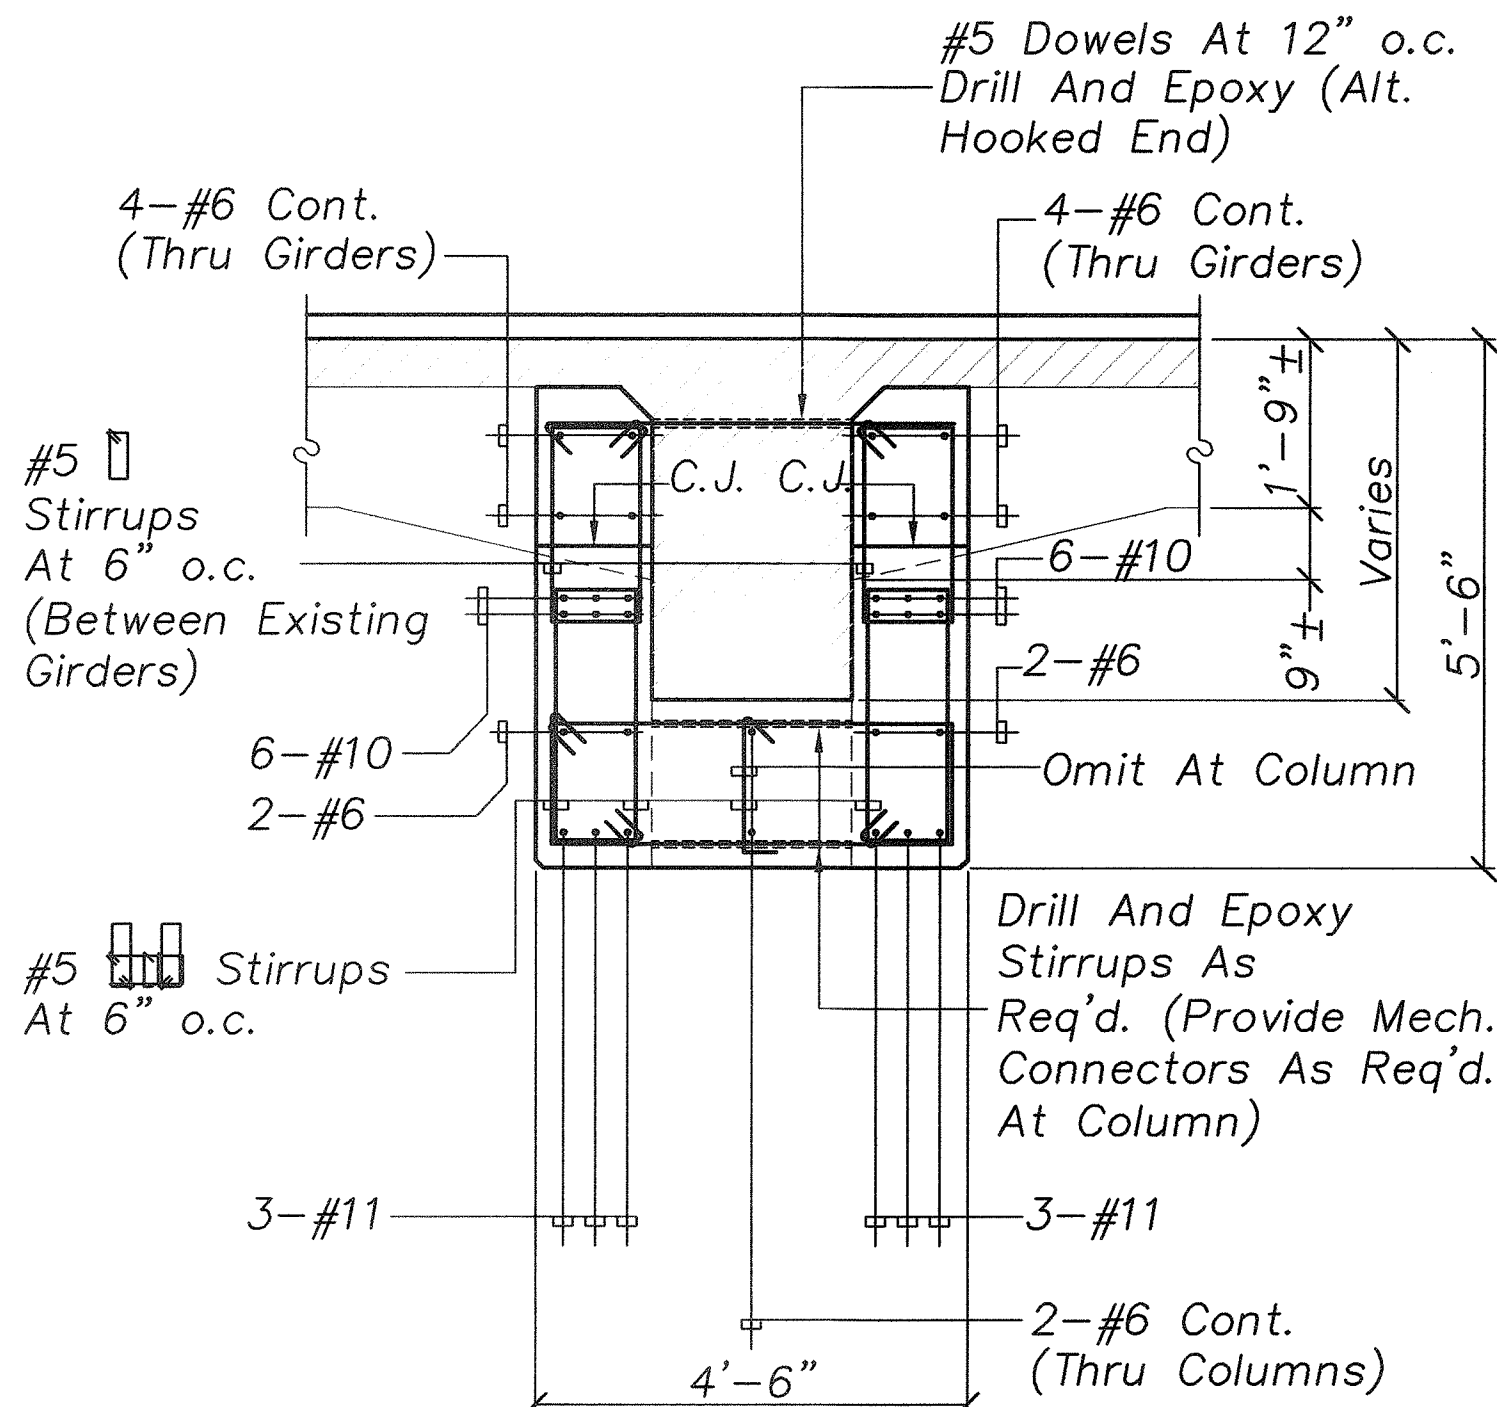


SECTION A-A
S-33 S-33 Scale: 1/2"=1'-0"

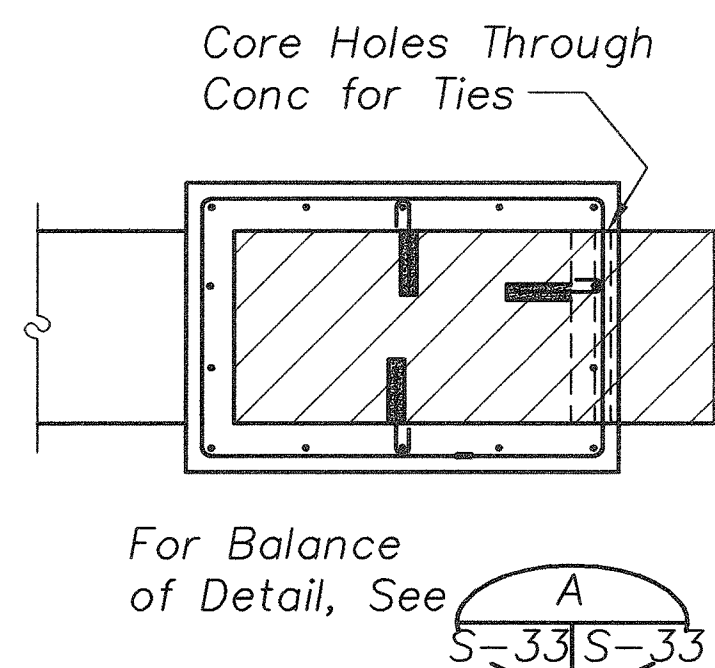


SECTION C-C
S-33 S-33 Scale: 1/2"=1'-0"

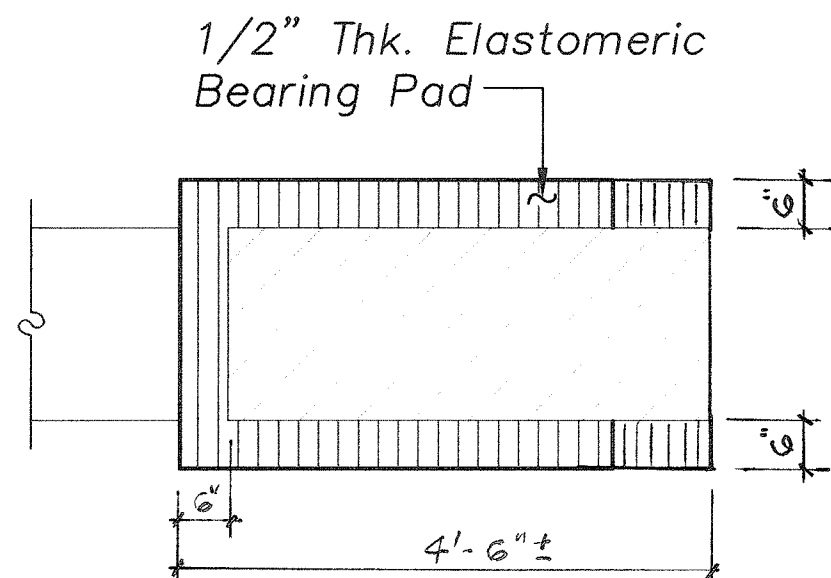

DETAIL E
S-33 S-33 Scale: 1/2"=1'-0"


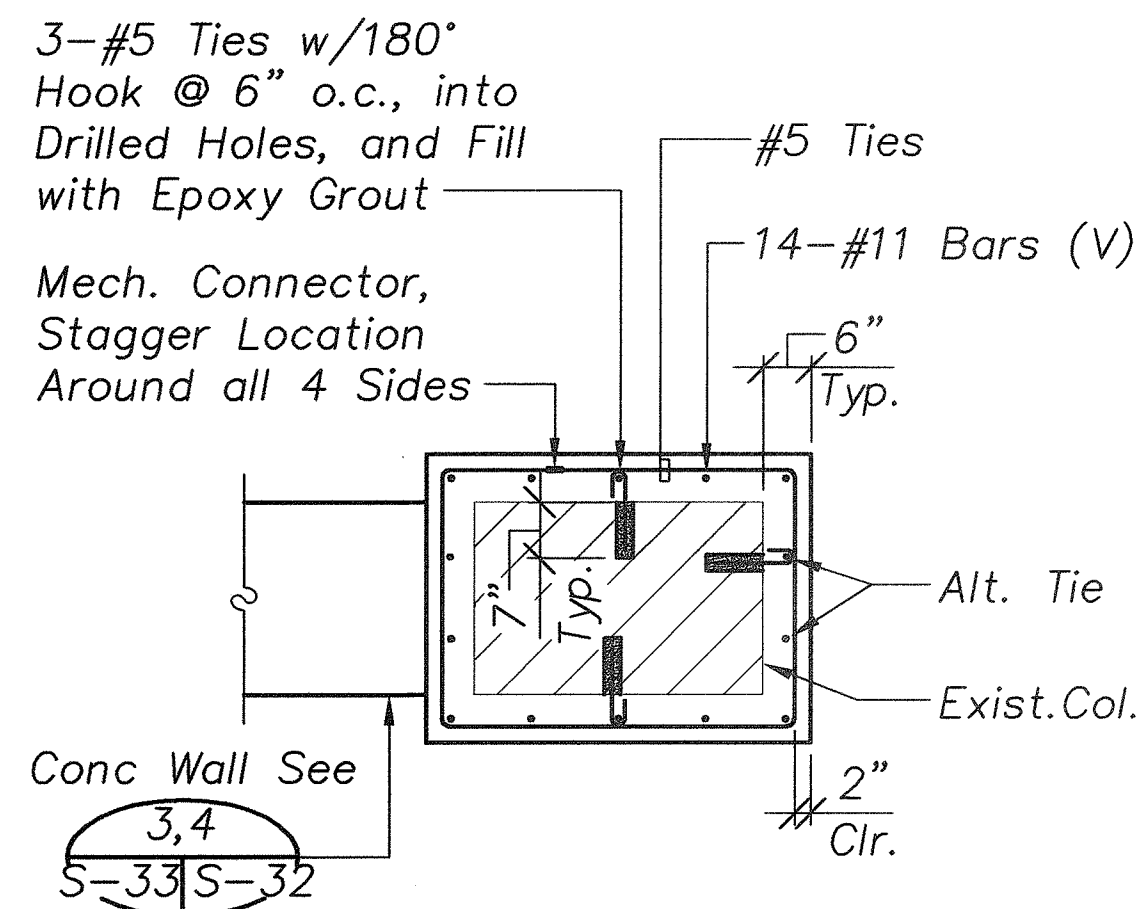


SECTION B-B
S-33 S-33 Scale: 1/2"=1'-0"

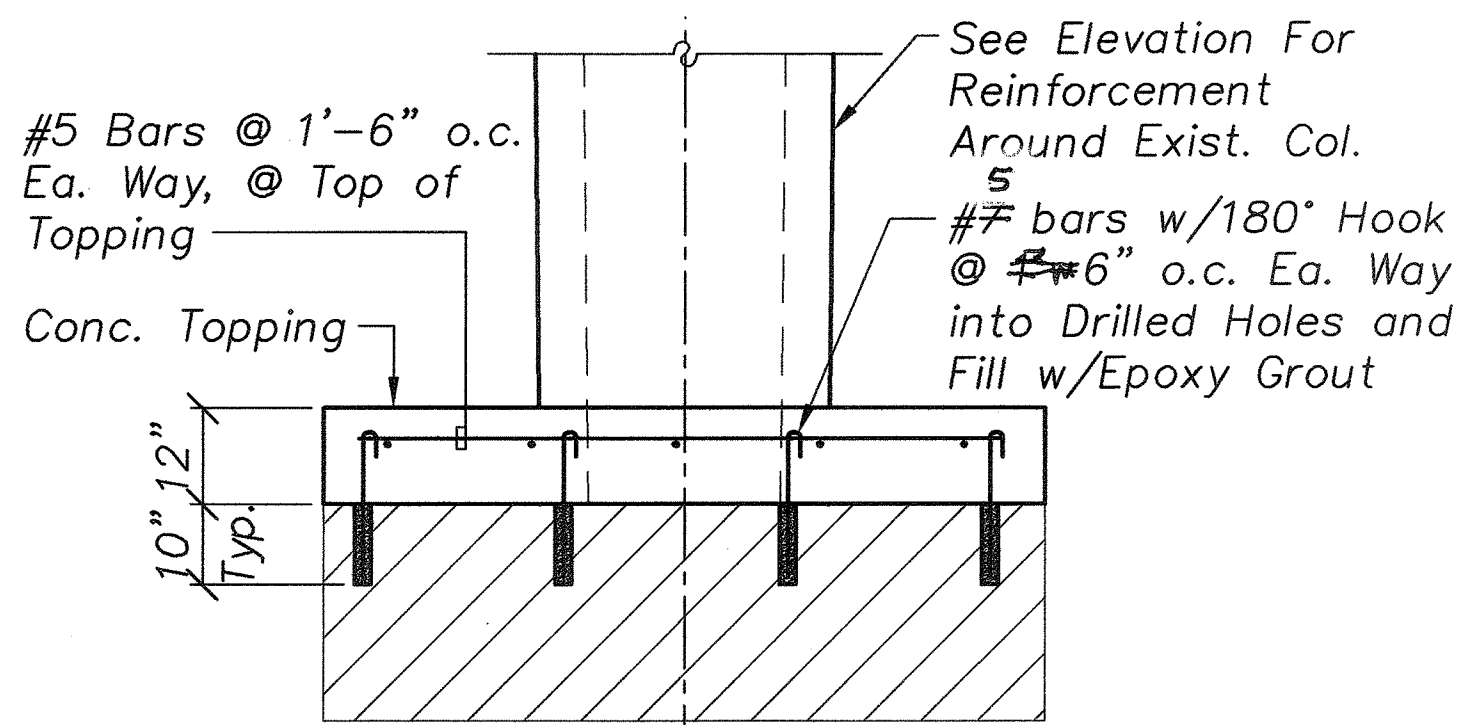

SECTION D-D
S-33 S-33 Scale: 1/2"=1'-0"

GRAPHIC SCALES

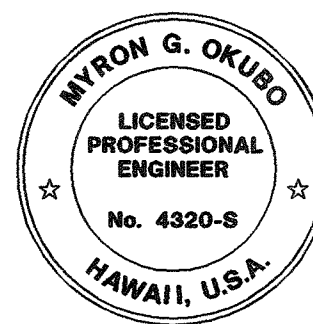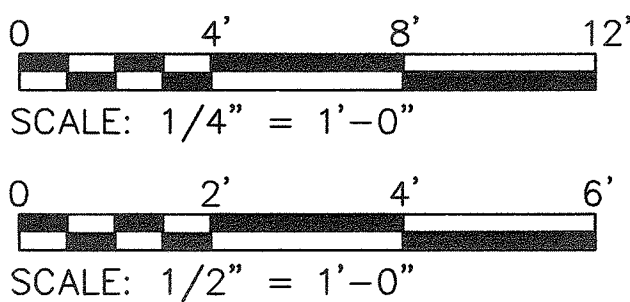

THIS WORK WAS PREPARED BY ME OR UNDER MY SUPERVISION

Myron Okubo

DATE	REVISION
STATE OF HAWAII DEPARTMENT OF TRANSPORTATION HIGHWAYS DIVISION FOUNDATION SECTIONS AND DETAILS HAWAII BELT ROAD KUPAPAUUA BRIDGE WIDENING HAMAKUA DISTRICT Federal Aid Project No. BR-019-2(38) Scale: As Noted Date: June 23, 2003 SHEET No. S-33 OF 36 SHEETS	


Path: L:\WOA\6670-01 Kupapaulua Bridge\Struct\NEW-1	Filename: S35	Plot date: Sep 25, 2006-08:07:27pm	CAD User: skidani	Xref Filename:	Border	AUTODATE
---	---------------	------------------------------------	-------------------	----------------	--------	----------

ELEVATION



Notes:

1. Wall Reinforcing not Shown for Clarity.
2. U-Bolt Anchors to be Placed 6'-0" Above Finished Floor.

 **ELEVATION**
Scale: 3/4"=1'-0"

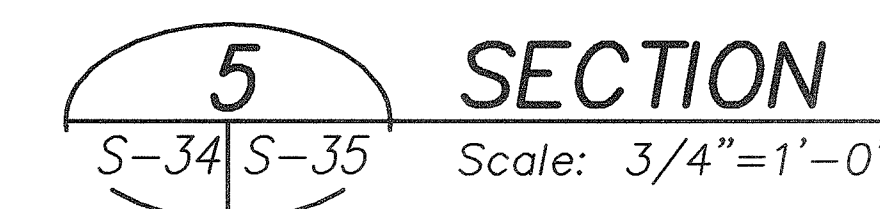


GRAPHIC SCALES

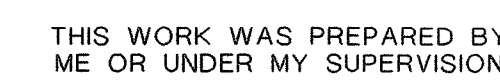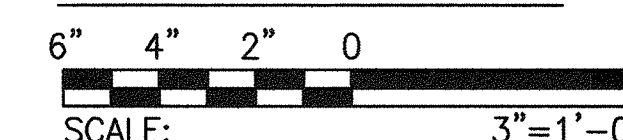


Myra Okubo

AS-BUILT

FED. ROAD DIST. NO.	STATE	FED. AID PROJ. NO.	FISCAL YEAR	SHEET NO.	TOTAL SHEETS
HAWAII	HAW.	BR-019-2(38)	2002	36	79

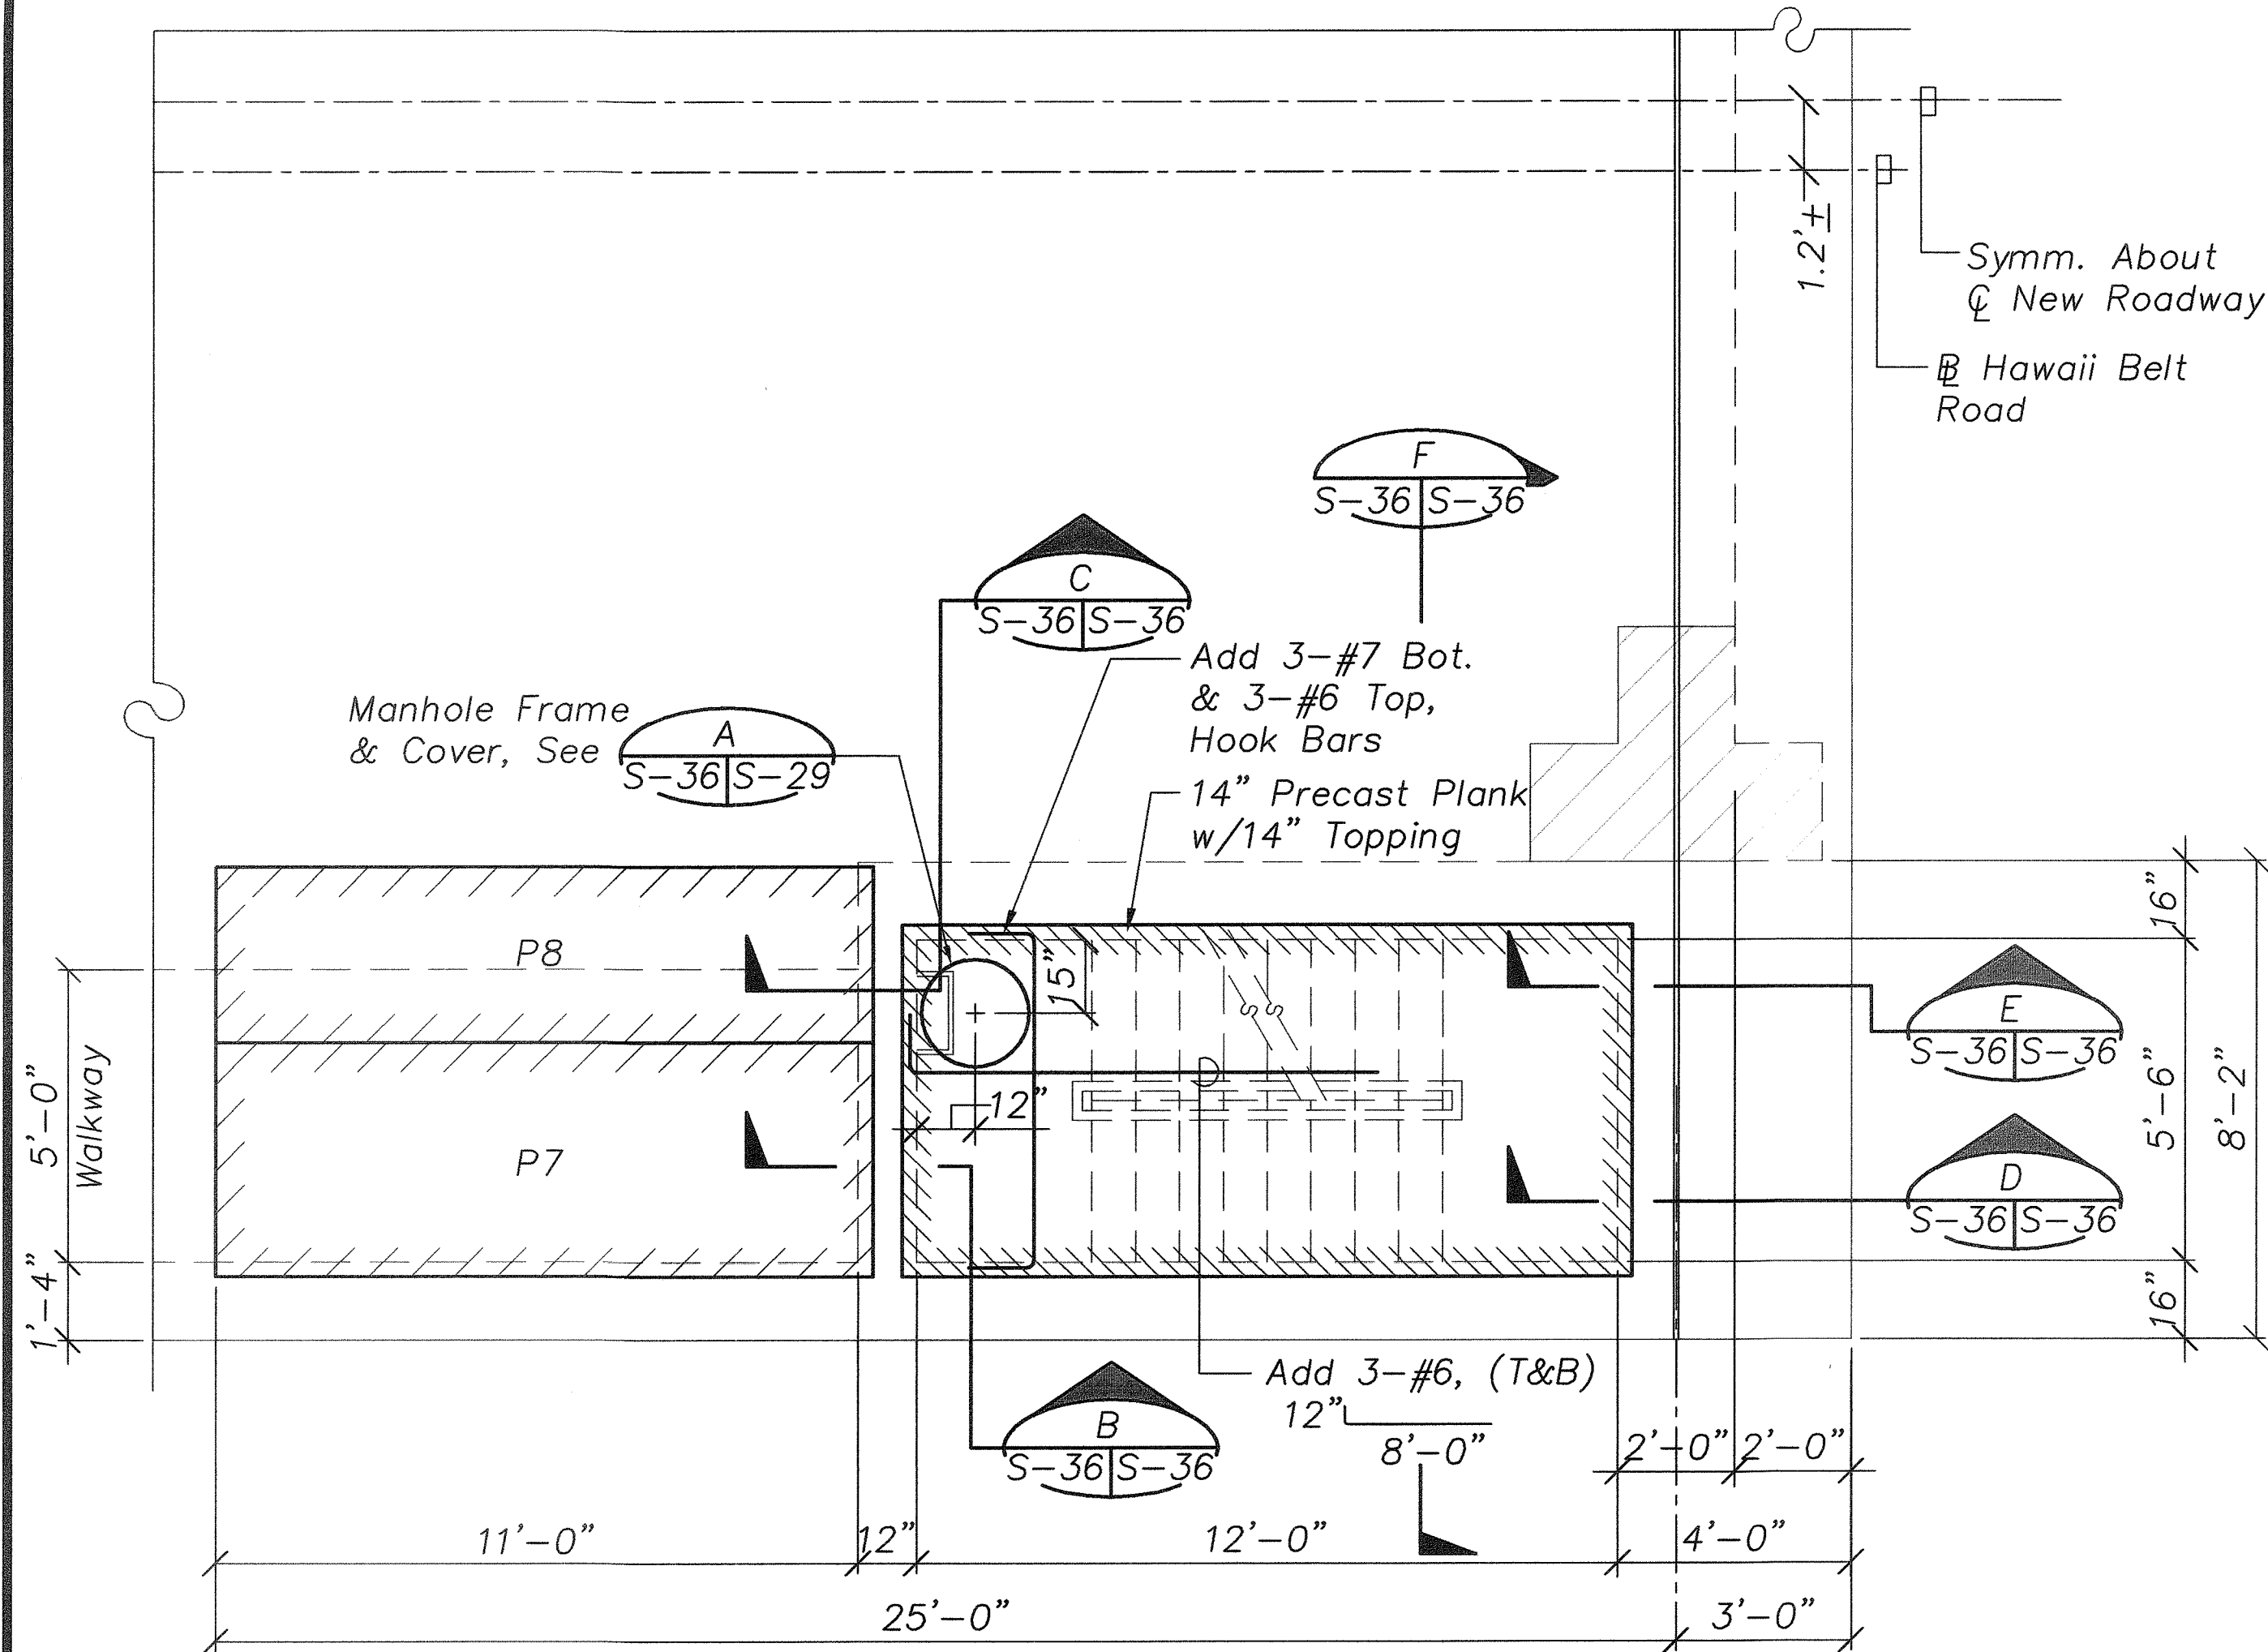


PARTIAL PLAN
Scale: 3/8"=1'-0"

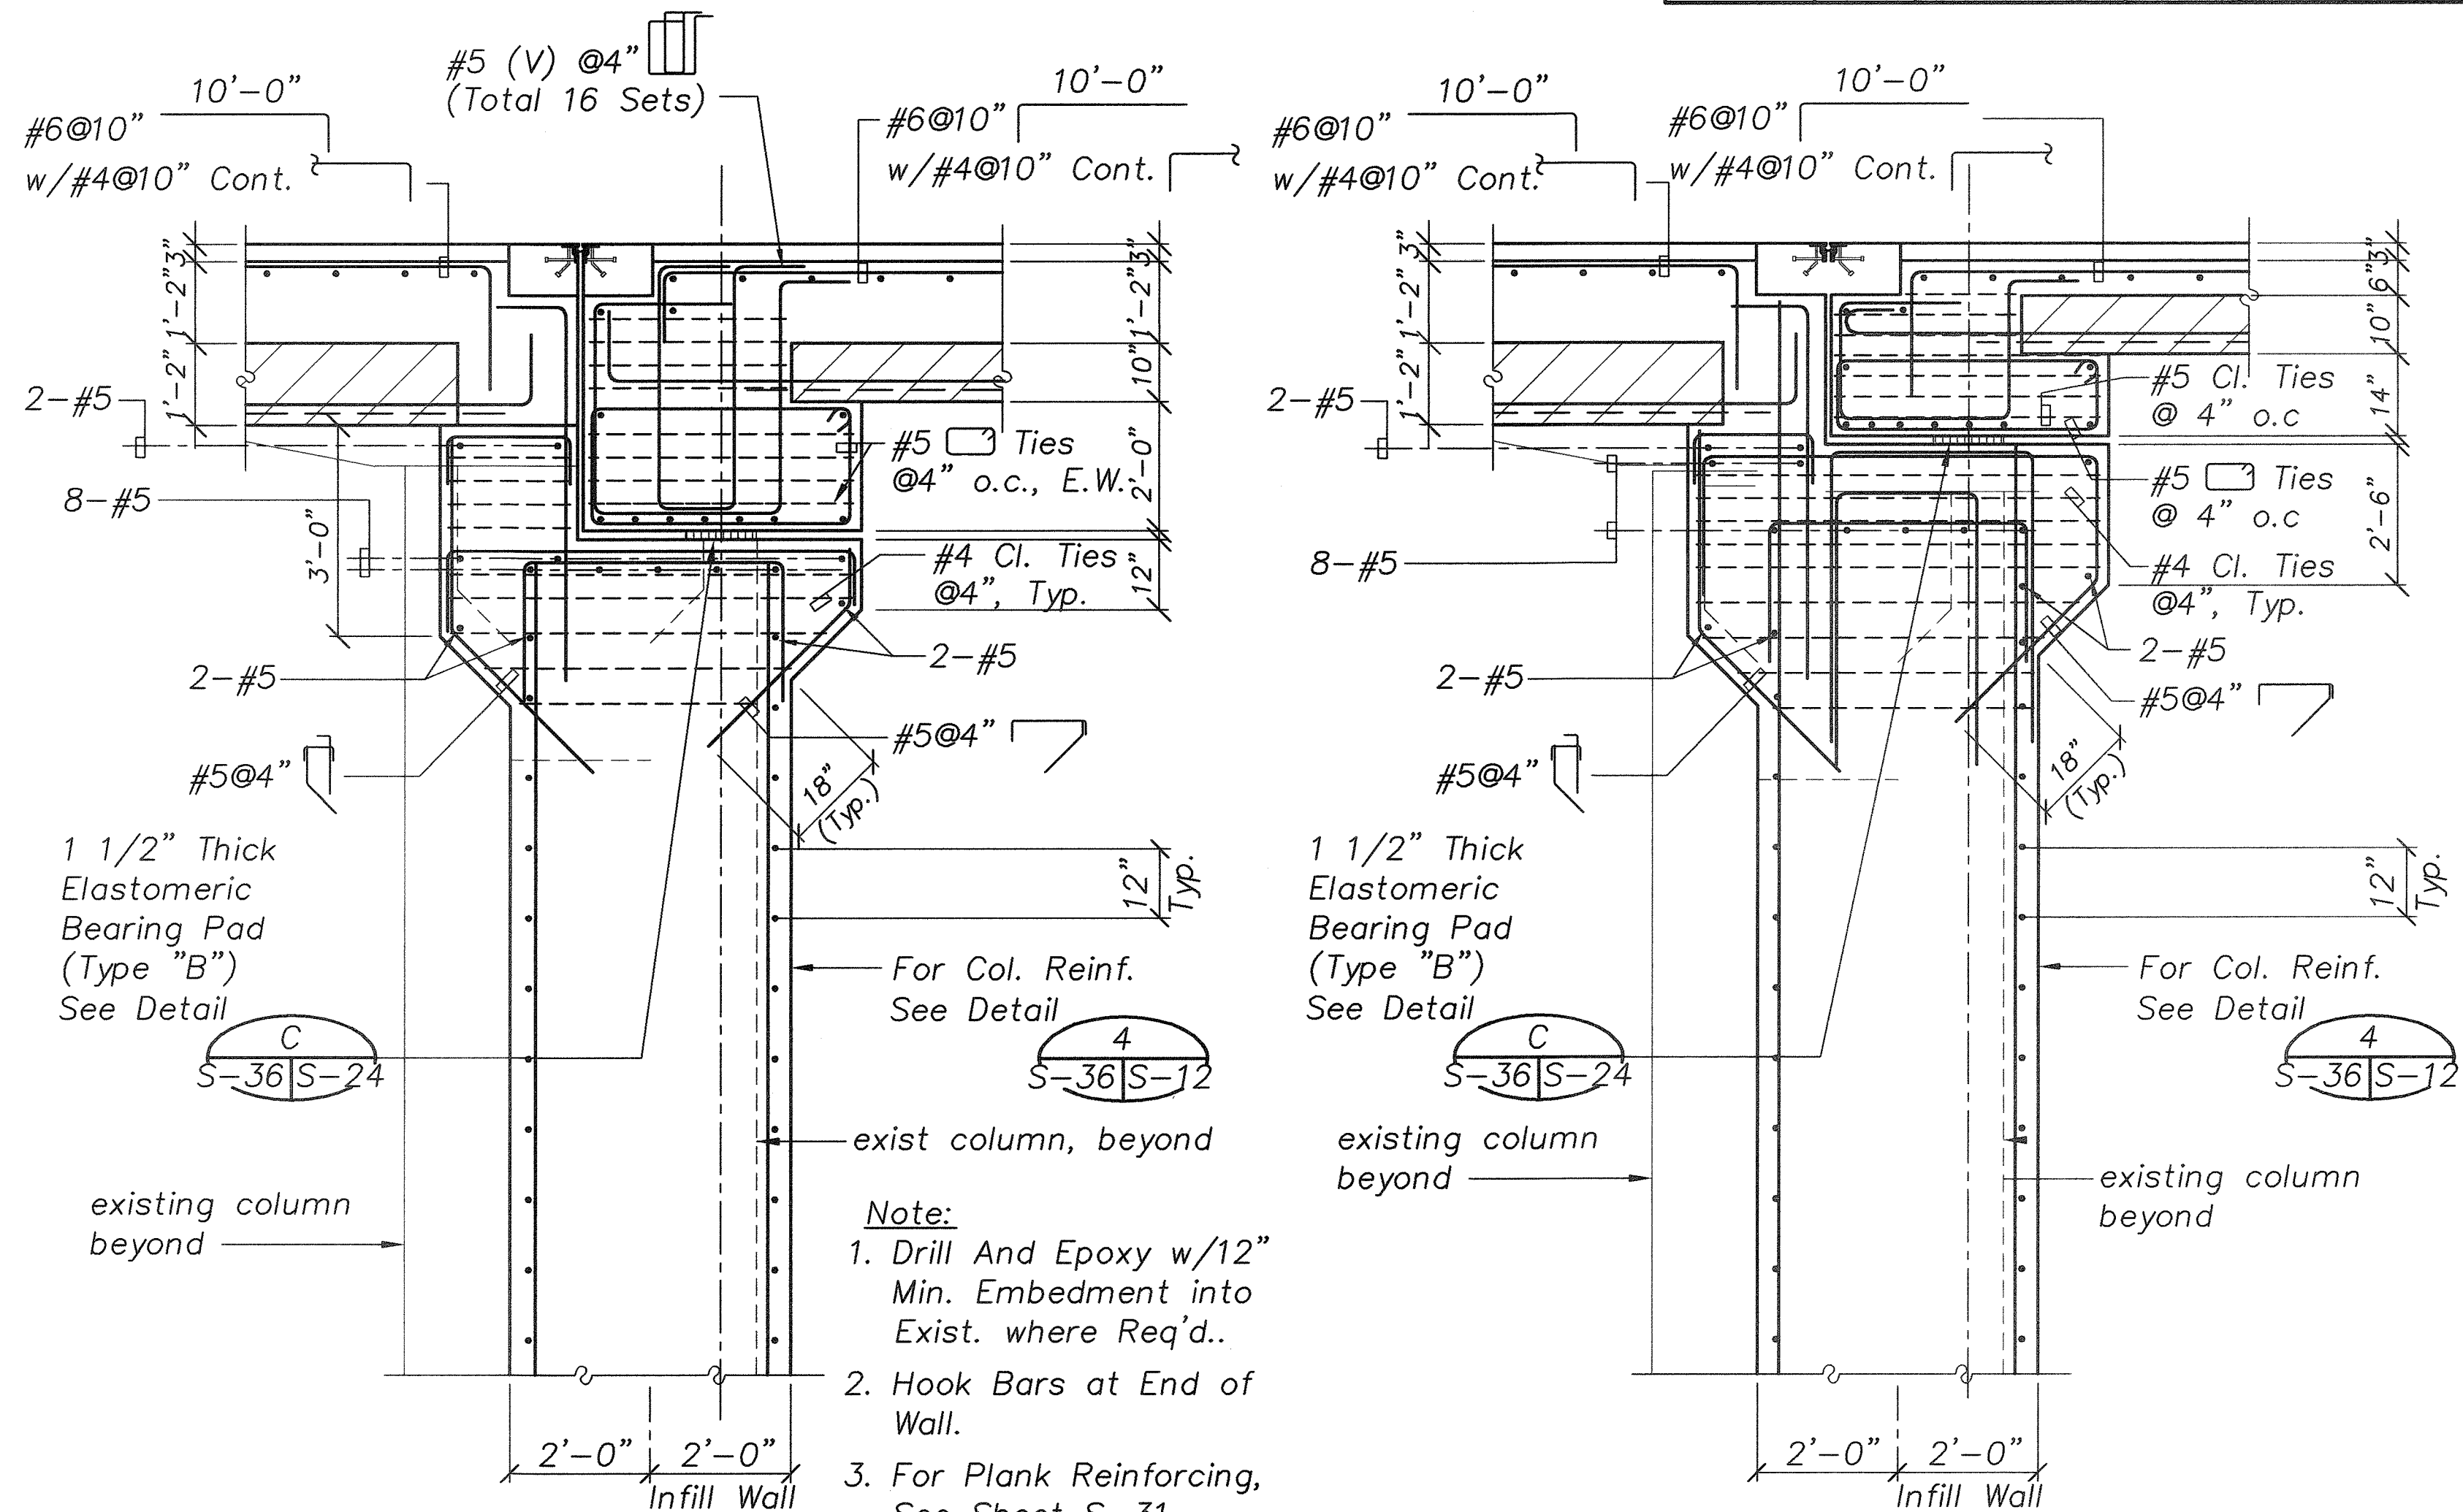


SECTION
Scale: 1/2"=1'-0"


SECTION
Scale: 1/2"=1'-0"

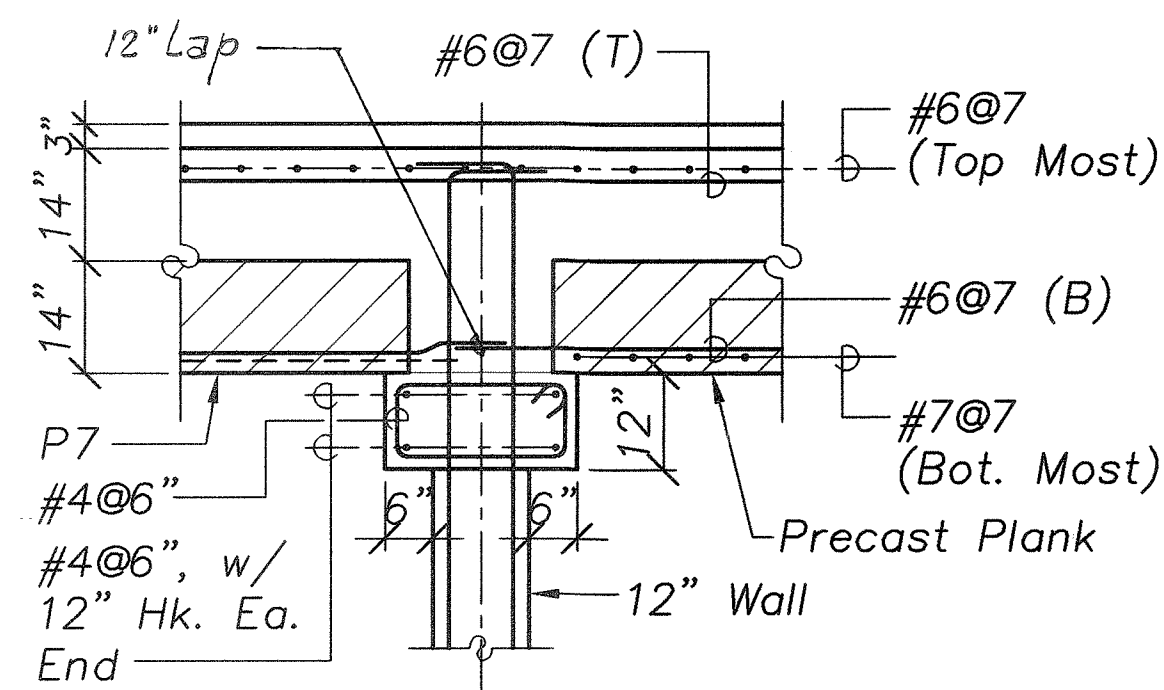

DETAIL
Scale: 1/2"=1'-0"

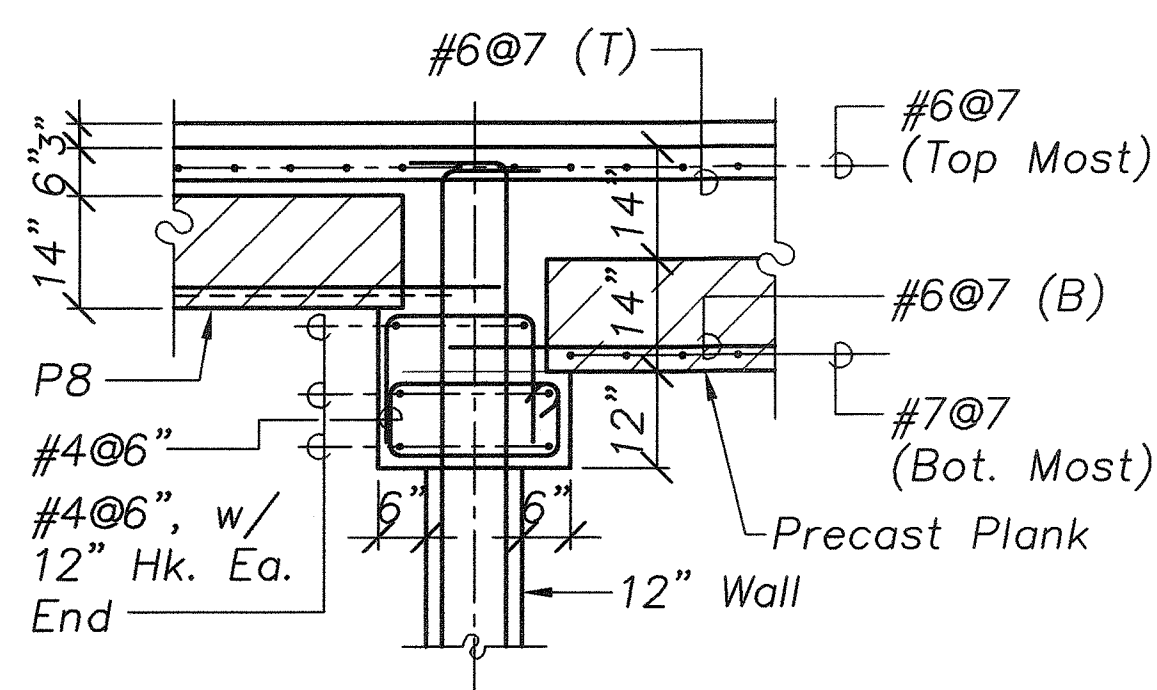


DETAIL
Scale: 1/2"=1'-0"

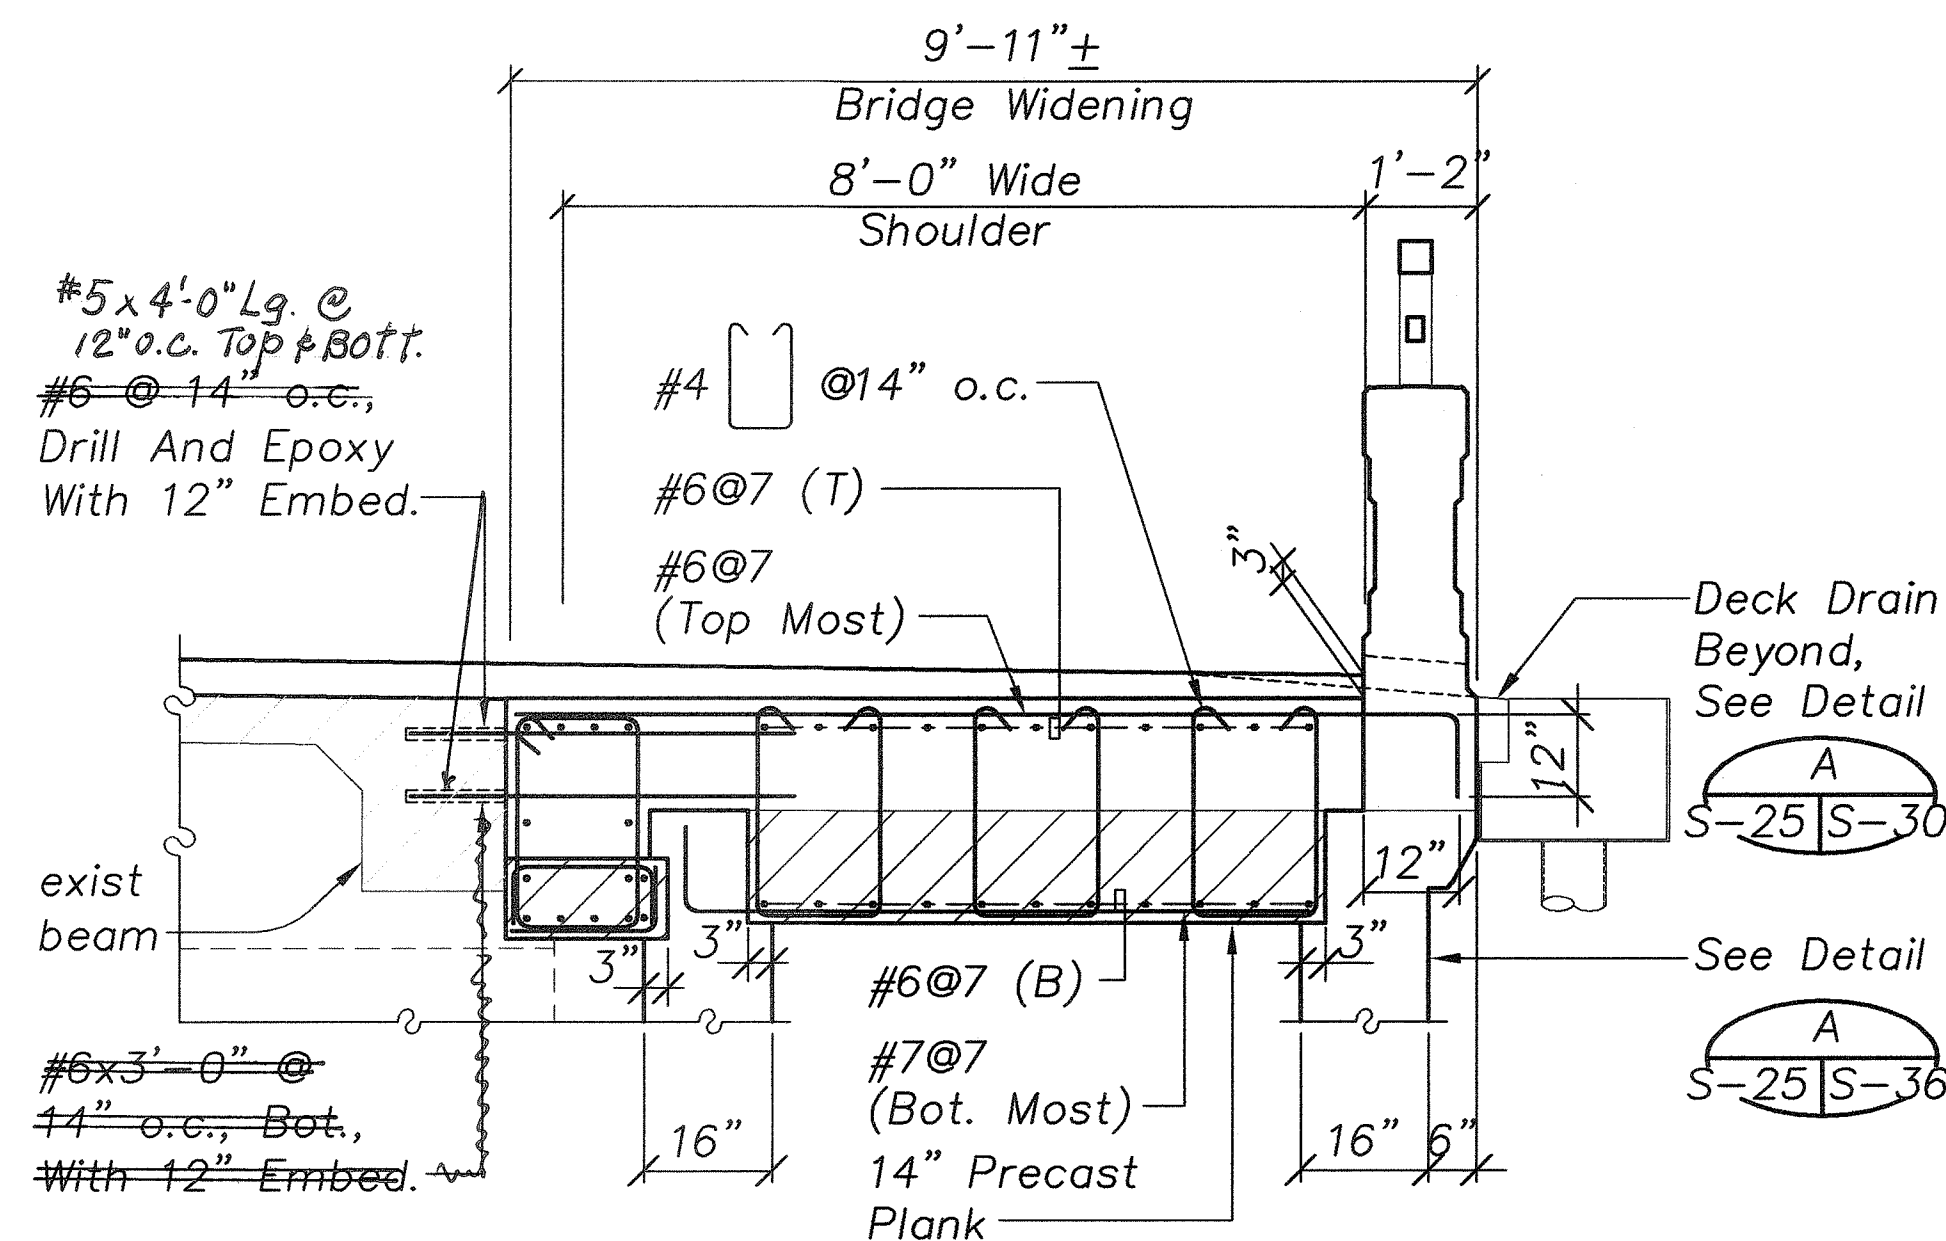

DETAIL
Scale: 1/2"=1'-0"

GRAPHIC SCALES

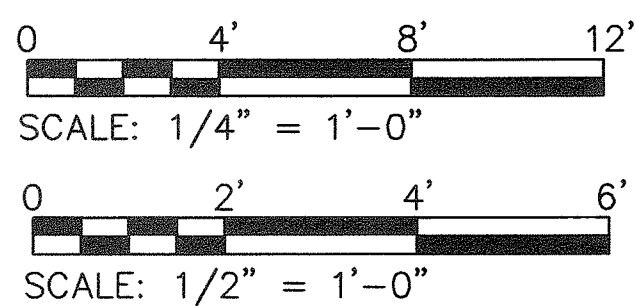


THIS WORK WAS PREPARED BY ME OR UNDER MY SUPERVISION


Myron Okubo

DATE	REVISION
STATE OF HAWAII DEPARTMENT OF TRANSPORTATION HIGHWAYS DIVISION PARTIAL PLAN, SECTIONS, AND DETAILS HAWAII BELT ROAD KUPAPAUHUA BRIDGE WIDENING HAMAKUA DISTRICT Federal Aid Project No. BR-019-2(38) Scale: As Noted Date: June 23, 2003	
SHEET No. S-36 OF 36 SHEETS	


TEL. NO.	STATE	FED. AID PROJ. NO.	SCALE	SHEET NO.	TOTAL SHEETS
HAWAII	HAW.	BR-019-2(38)	2004	79	79

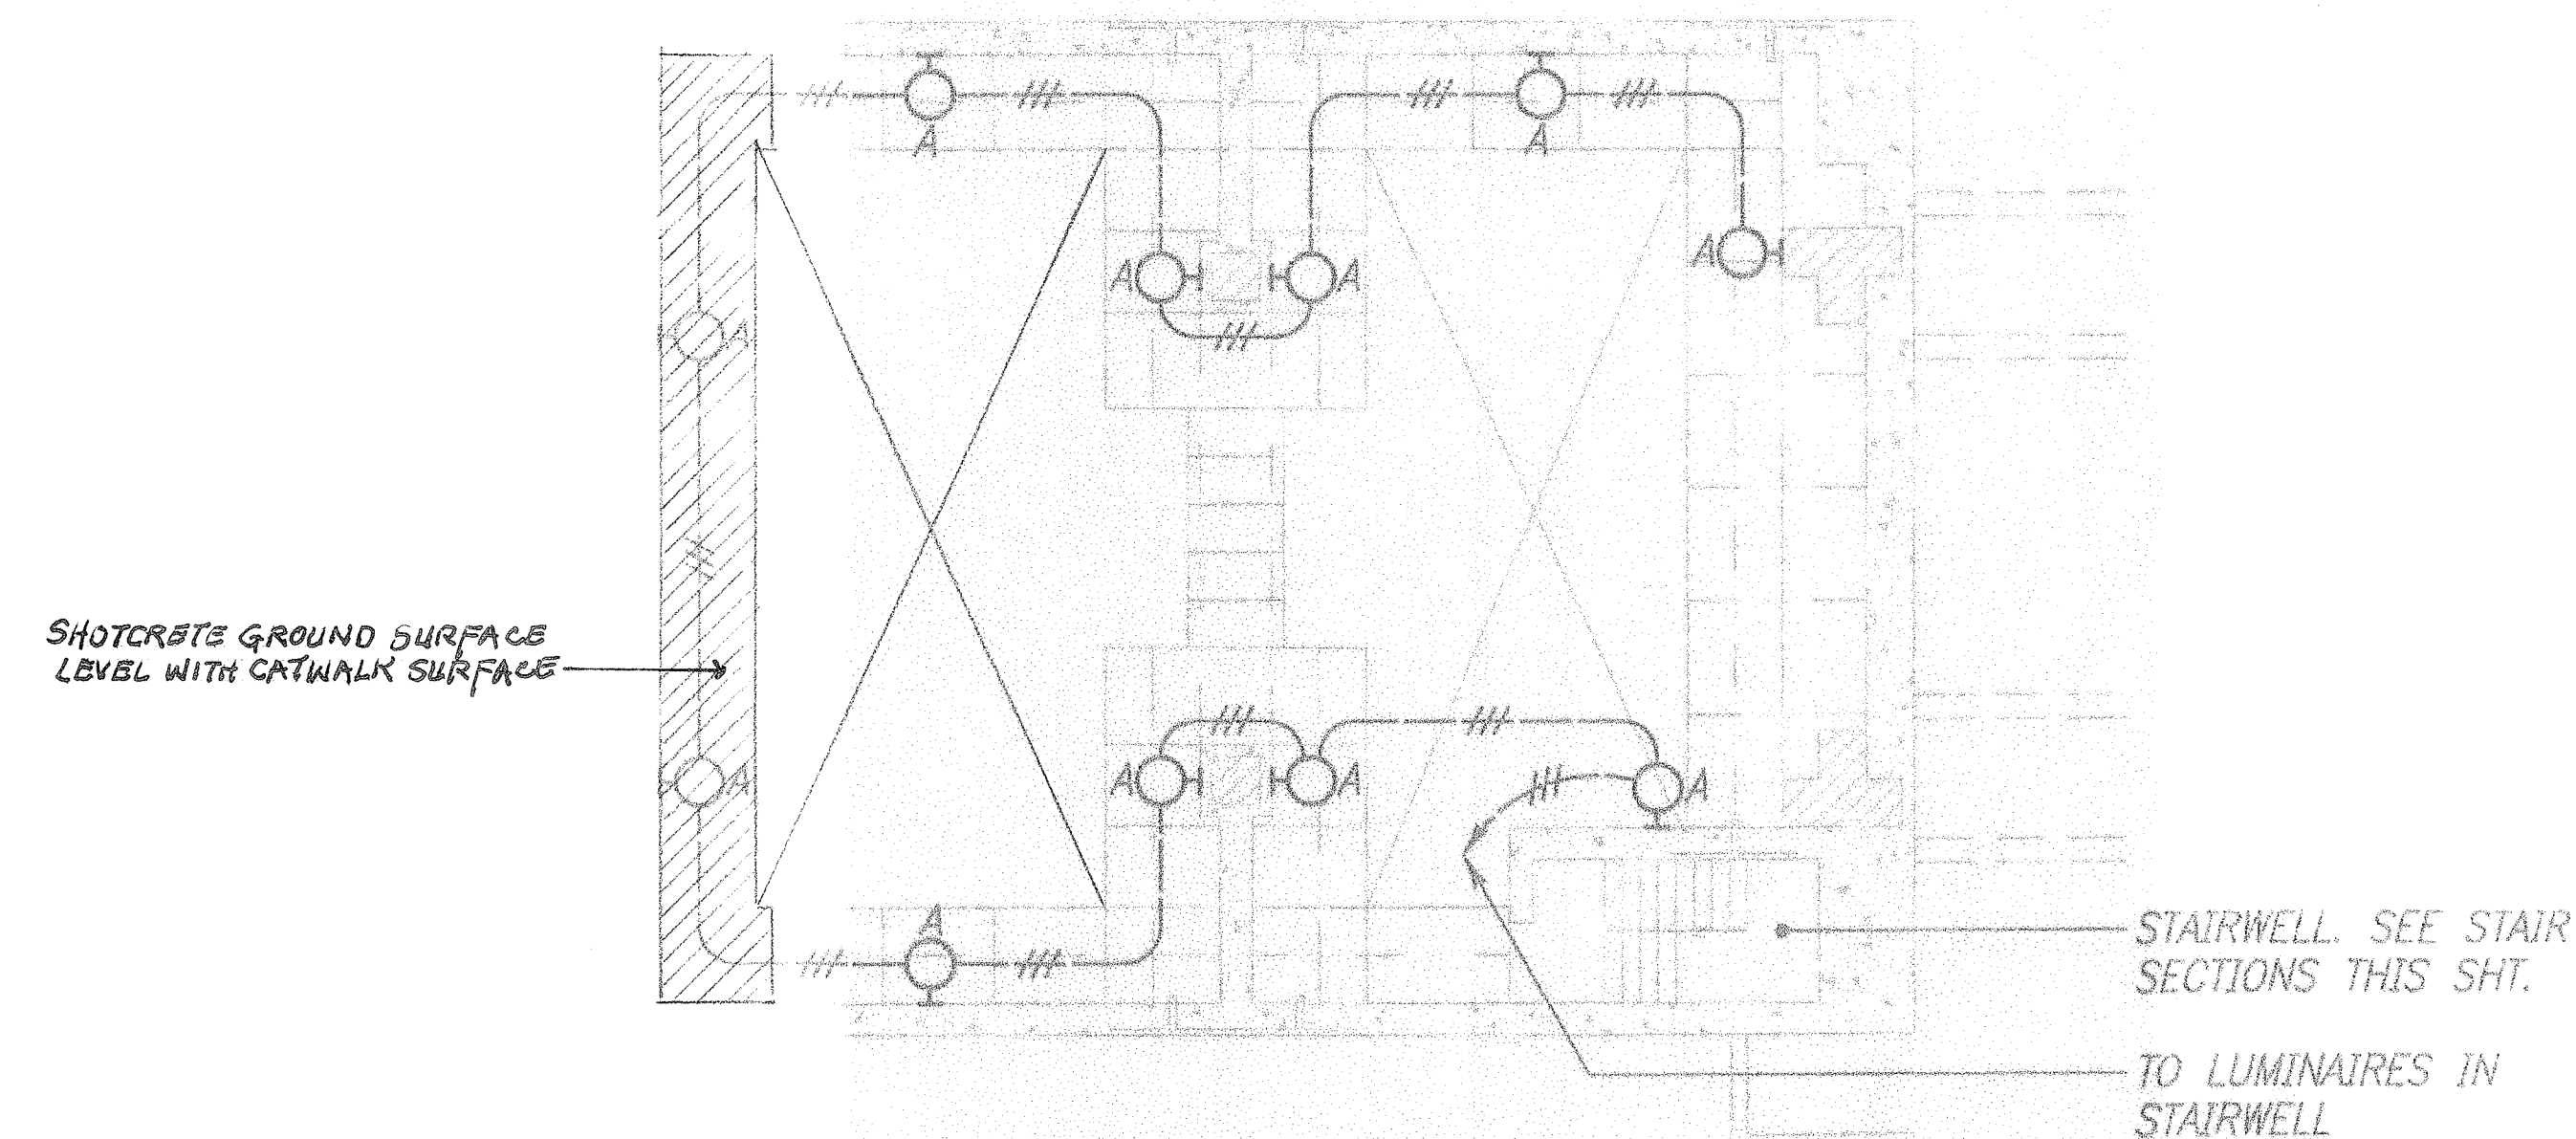


ABUTMENT NO. 1 LIGHTING PLAN
SCALE: 1/8"=1'-0"

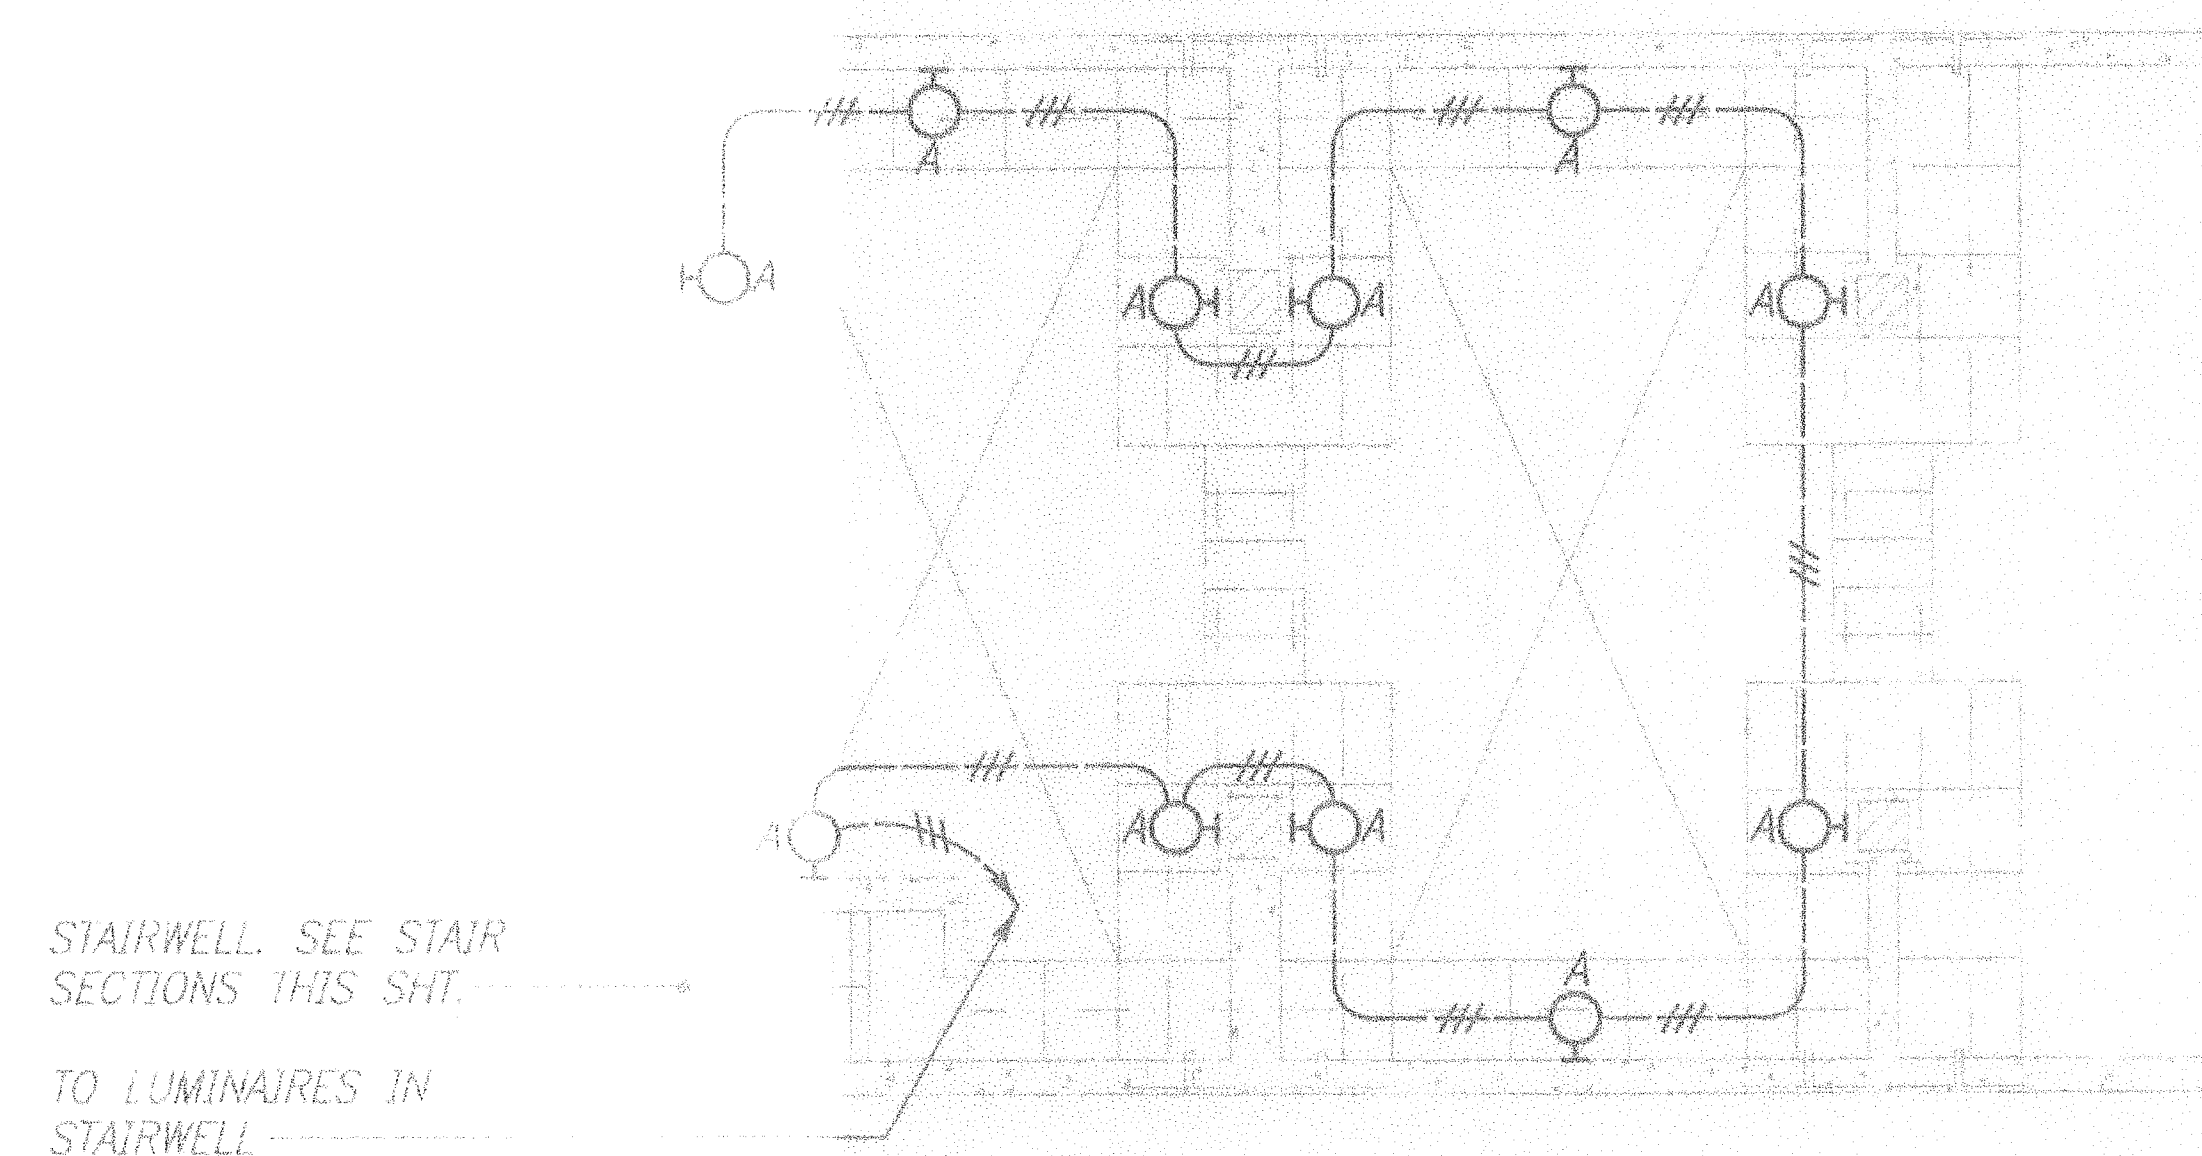

ABUTMENT NO. 2 LIGHTING PLAN
SCALE: 1/8"=1'-0"

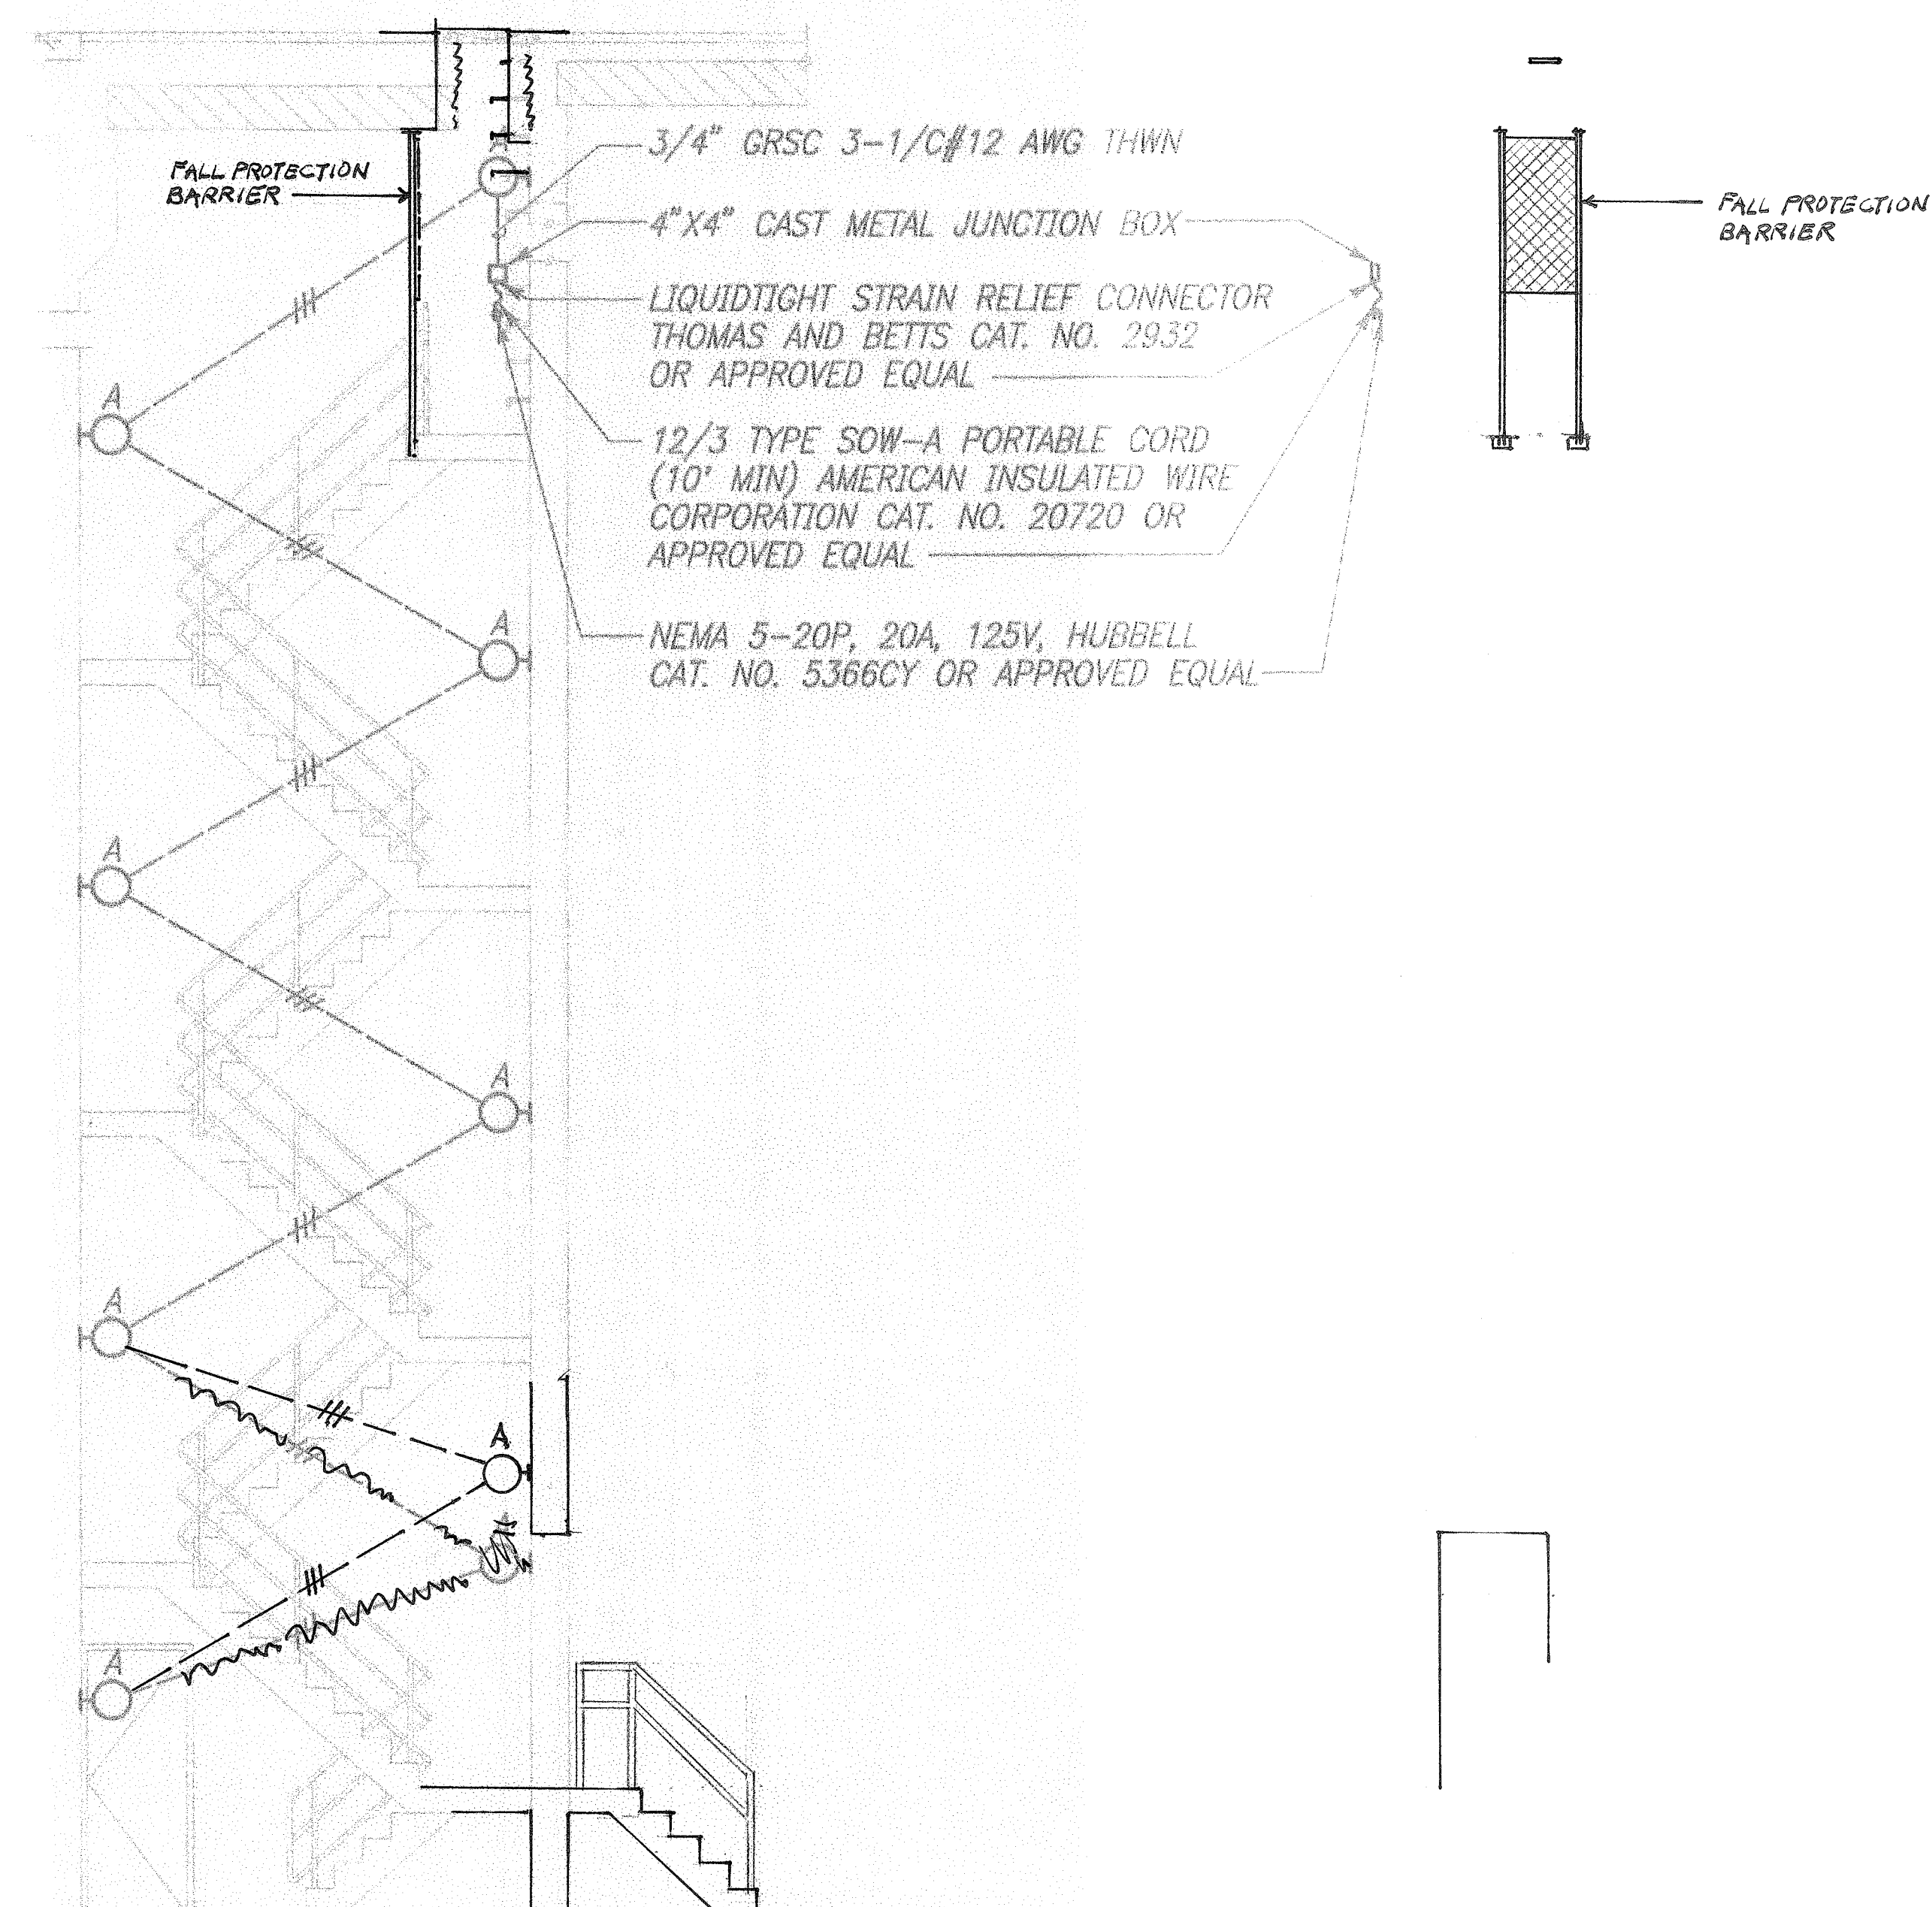

STAIR SECTIONS
SCALE: 1/4"=1'-0"

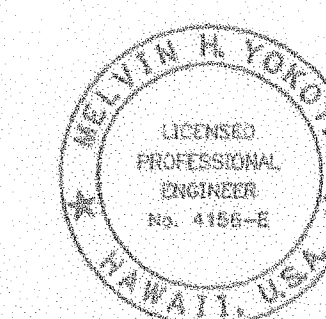

THIS WORK WAS PREPARED BY ME
OR UNDER MY SUPERVISION.
Melvin H. Yokota

DATE	REVISION
STATE OF HAWAII DEPARTMENT OF TRANSPORTATION HIGHWAYS DIVISION LIGHTING PLANS AND SECTIONS HAWAII BELT ROAD KUPAPAUUA BRIDGE WIDENING HAMAKUA DISTRICT Federal Aid Project No. BR-019-2(38) Scale: As Noted Date: January 27, 2004	
SHEET NO. E-2 OF E-2 SHEETS	

"AS-BUILT"