

INDEX TO DRAWINGS	
SHEET NO.	DESCRIPTION
1	TITLE SHEET
2	STANDARD PLANS SUMMARY
3-5	NOTES
6-8	TYPICAL SECTIONS
9	DRAINAGE MAP
10-12	PLAN AND PROFILE - HAWAII BELT ROAD
13-14	GRADING PLANS
15-16	PAVEMENT MARKING AND STRIPING PLAN
17-18	CROSS SECTIONS
19	GUARDRAIL DETAILS AND NOTES
20	STRONG POST W-BEAM GUARDRAIL
21	STRONG POST MODIFIED THRIE-BEAM GUARDRAIL
22-24	TYPE "A" FLARE
25	FLEAT-350 FLARED ENERGY ABSORBING TERMINAL
26-28	TYPE "A" ENDPOST UPGRADE DETAILS
29-32	BORING LOGS
33-43	TRAFFIC CONTROL PLANS
44-73	STRUCTURAL DRAWINGS

DESIGNED BY

NISHIMURA, KATAYAMA
& OKI INC.

DATE

MAY, 2002

PHONE

692-7546

BY

P. S. & E.

DATE

MAY, 2002

PHONE

692-7546

BY

EMILIO BARROGA JR.

STATE OF HAWAII

DEPARTMENT OF TRANSPORTATION

HIGHWAYS DIVISION

HONOLULU, HAWAII

"AS-BUILT"

PLANS FOR


HAWAII BELT ROAD

KUPAPAUlua BRIDGE WIDENING

FEDERAL AID PROJECT NO. BR-019-2(38)

HAMAKUA DISTRICT



ISLAND OF HAWAII

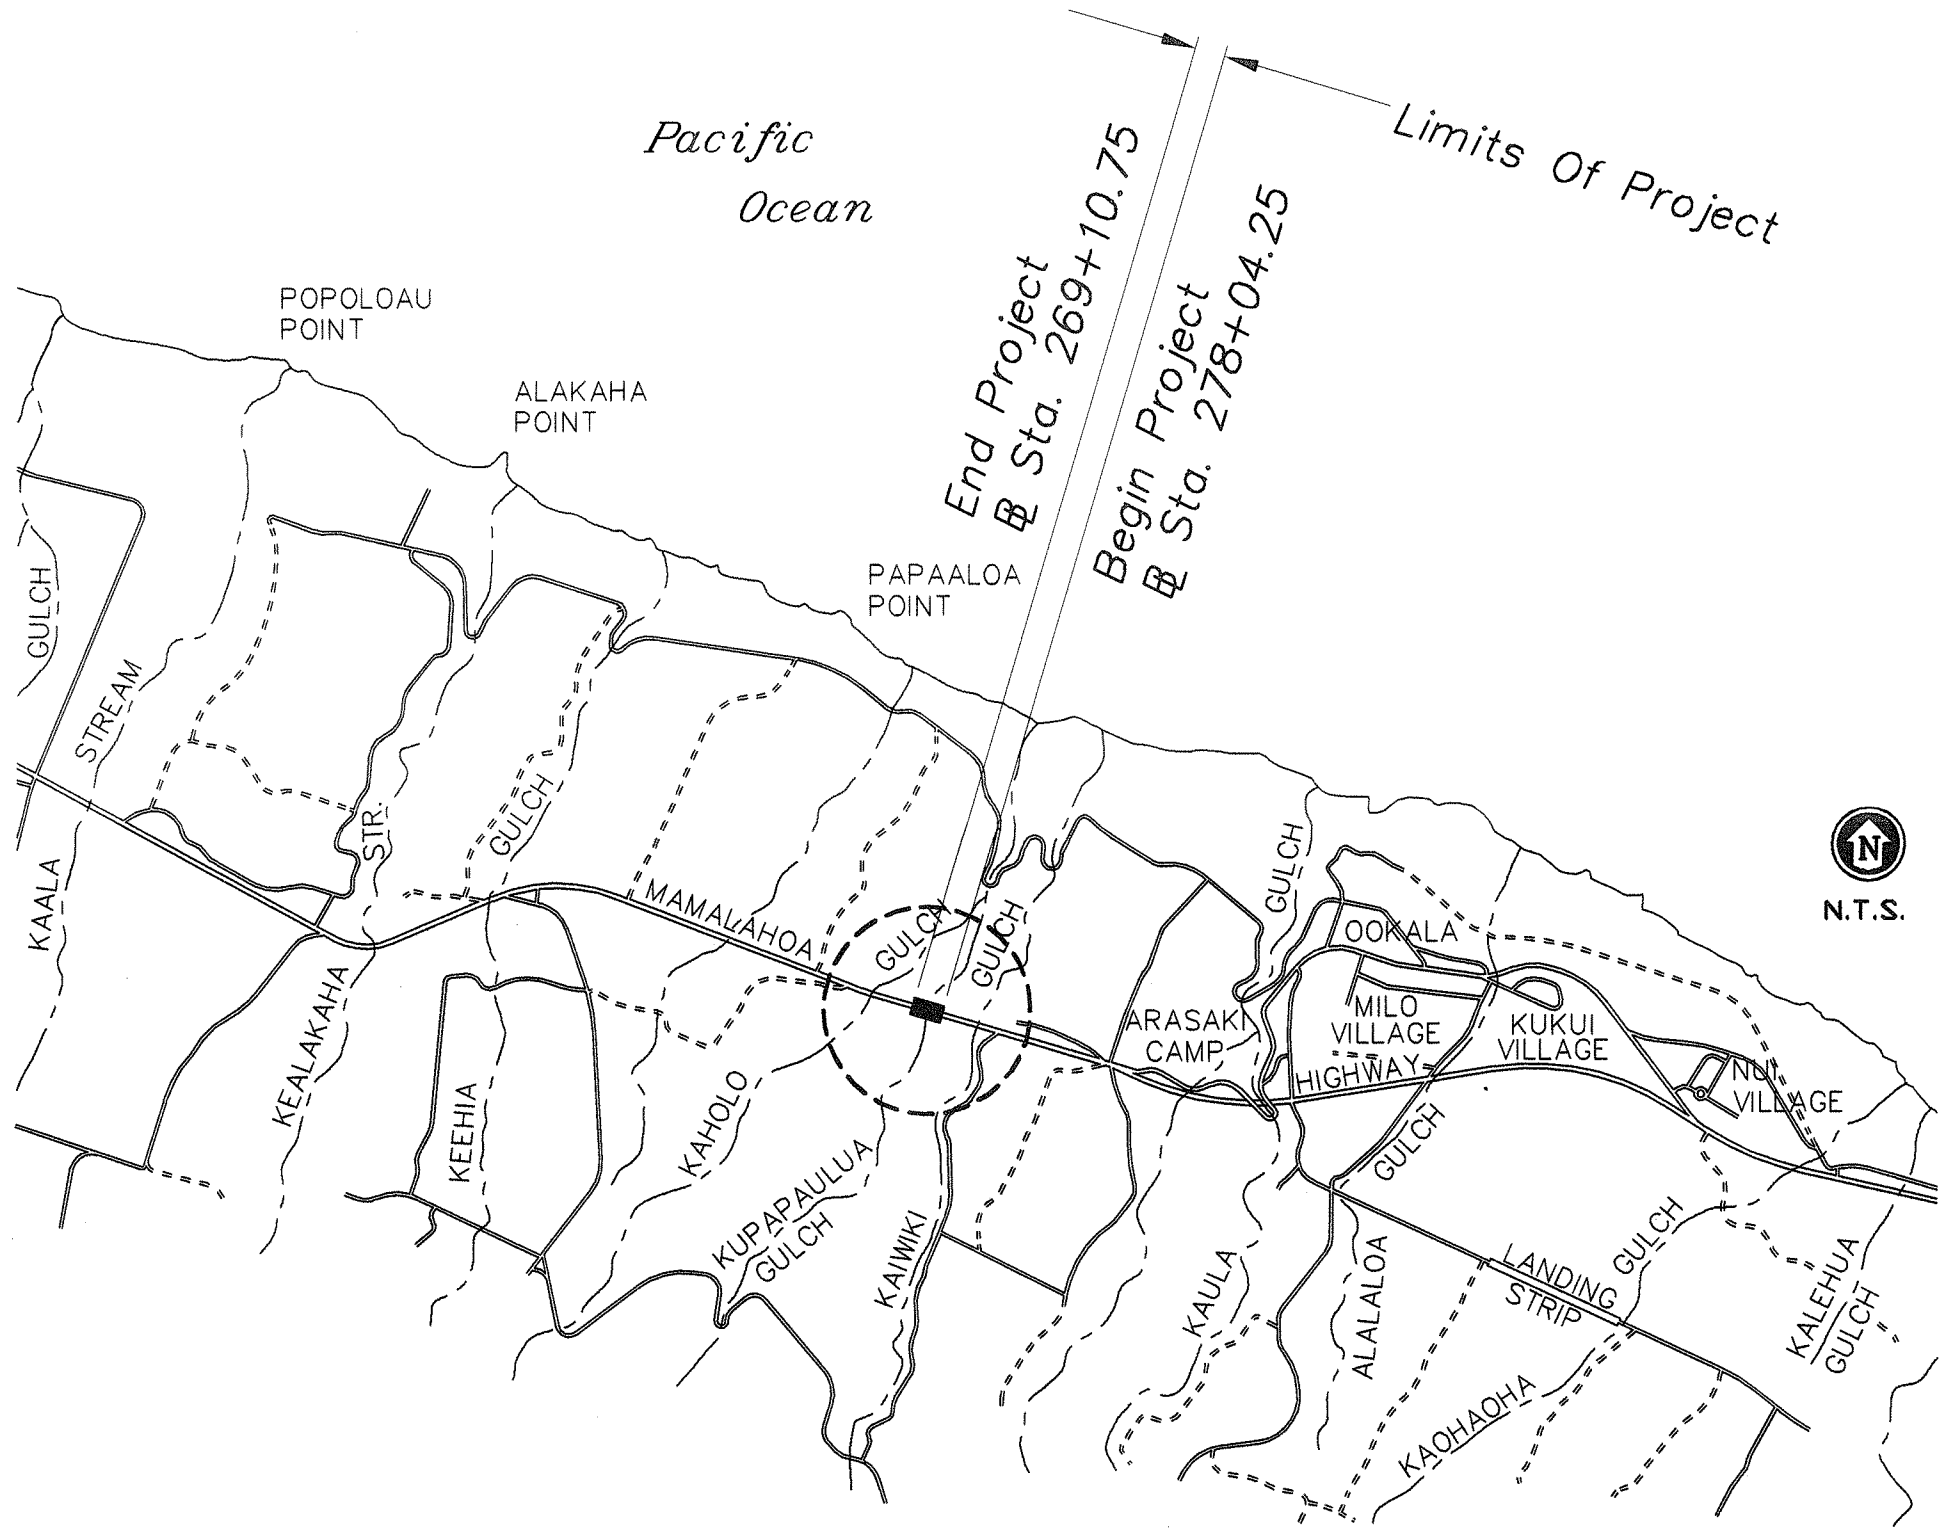

LOCATION MAP

Not To Scale

FED. ROAD DIST. NO.	STATE	FED. AID PROJ. NO.	FISCAL YEAR	SHEET NO.	TOTAL SHEETS
HAWAII	HAW.	BR-019-2(38)	2002	1	73

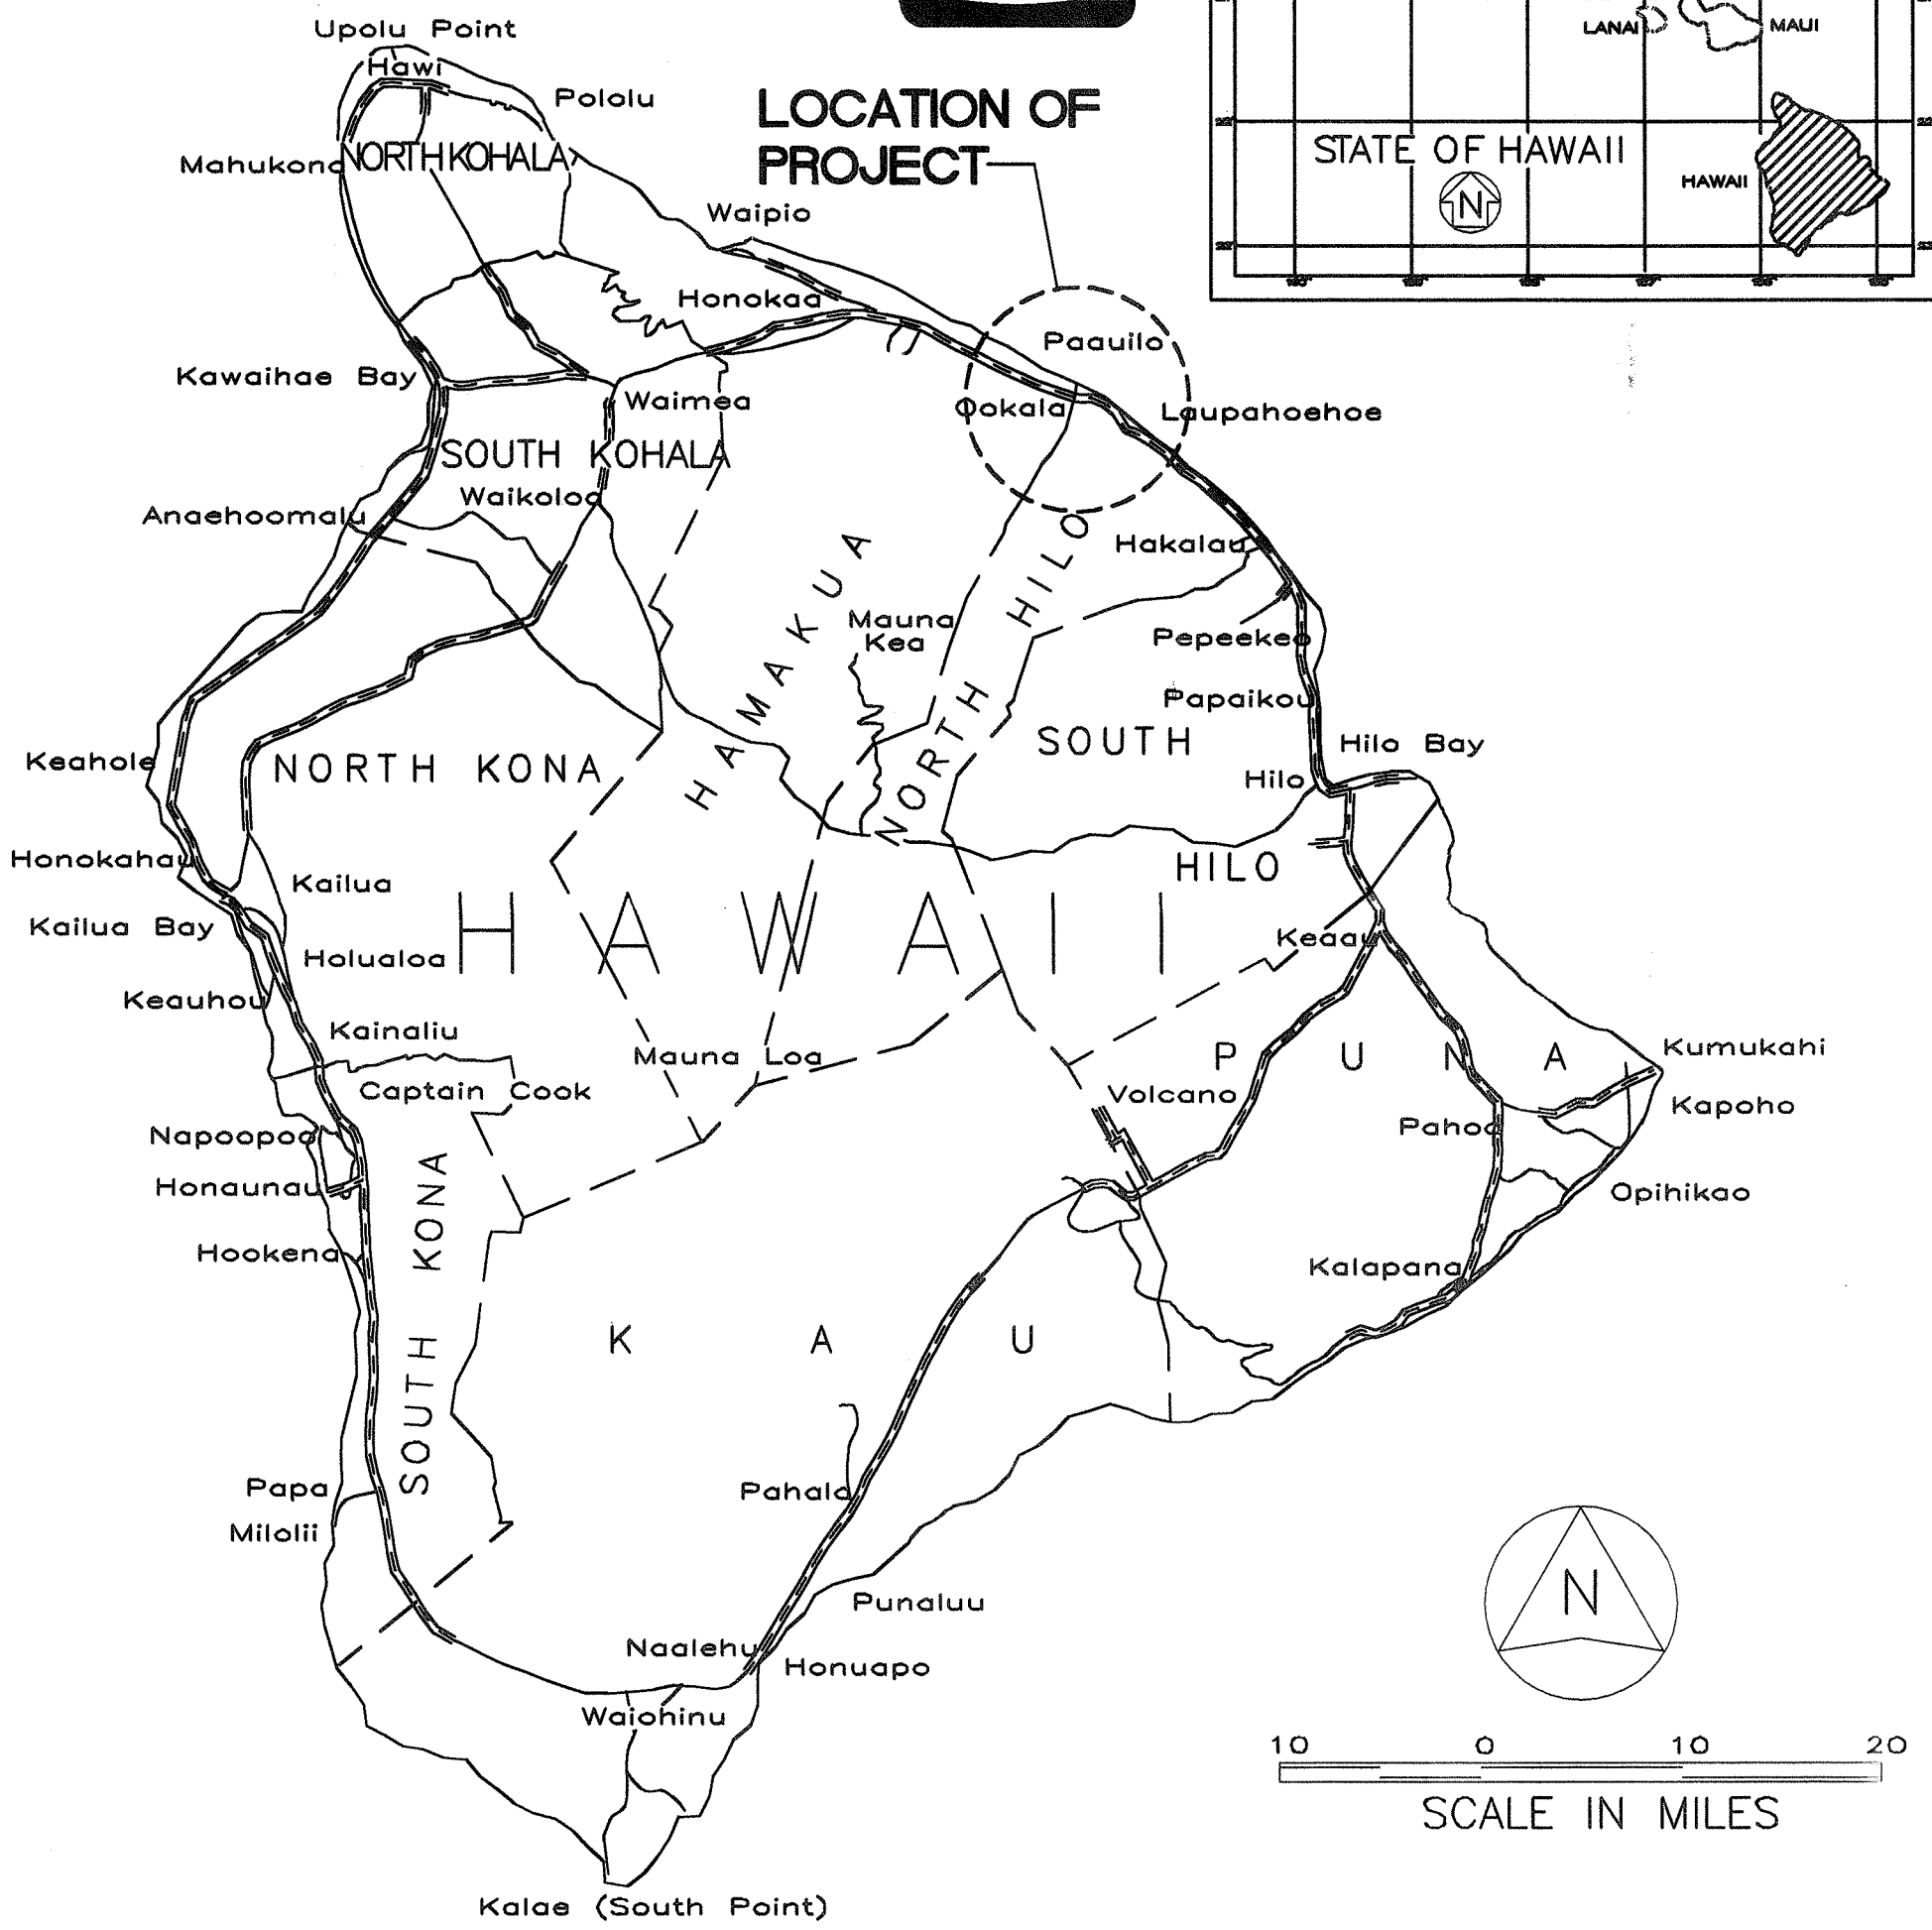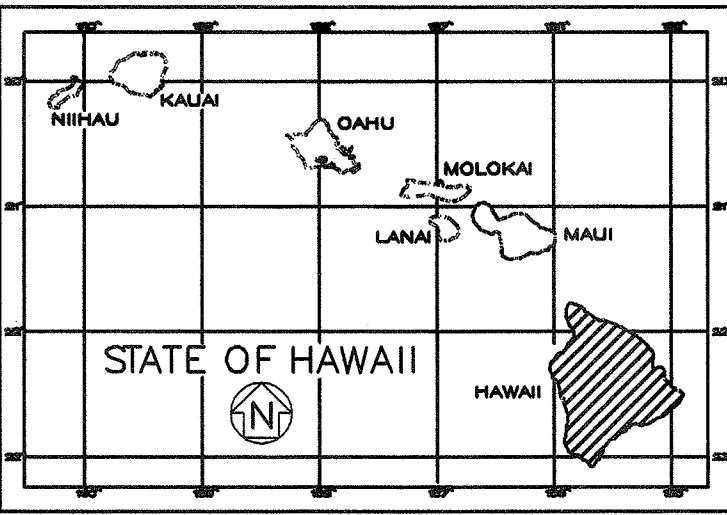

MILE POST 30.70 TO MILE POST 30.87

CHANGES MADE DURING CONSTRUCTION HAVE BEEN INCORPORATED ON THESE PLANS EXCEPT CHANGES IN THE ORIGINAL THEORETICAL QUANTITIES. FOR ACTUAL QUANTITIES, REFER TO PROJECT LEDGER AND/OR COMPLETION BOOK.

2-11-09

9-24-09

RESIDENT ENGINEER

DATE

DESIGN DESIGNATION	
CURRENT ADT (1999)	4,800
DESIGN ADT (2019)	6,000
DHV	510
D	50/50
T	6.0%
T ₂₄	8.5%
V	60 MPH

DEPARTMENT OF TRANSPORTATION STATE OF HAWAII	
APPROVED:	
<i>[Signature]</i>	3-2-02
DIR. OF TRANSPORTATION	DATE